
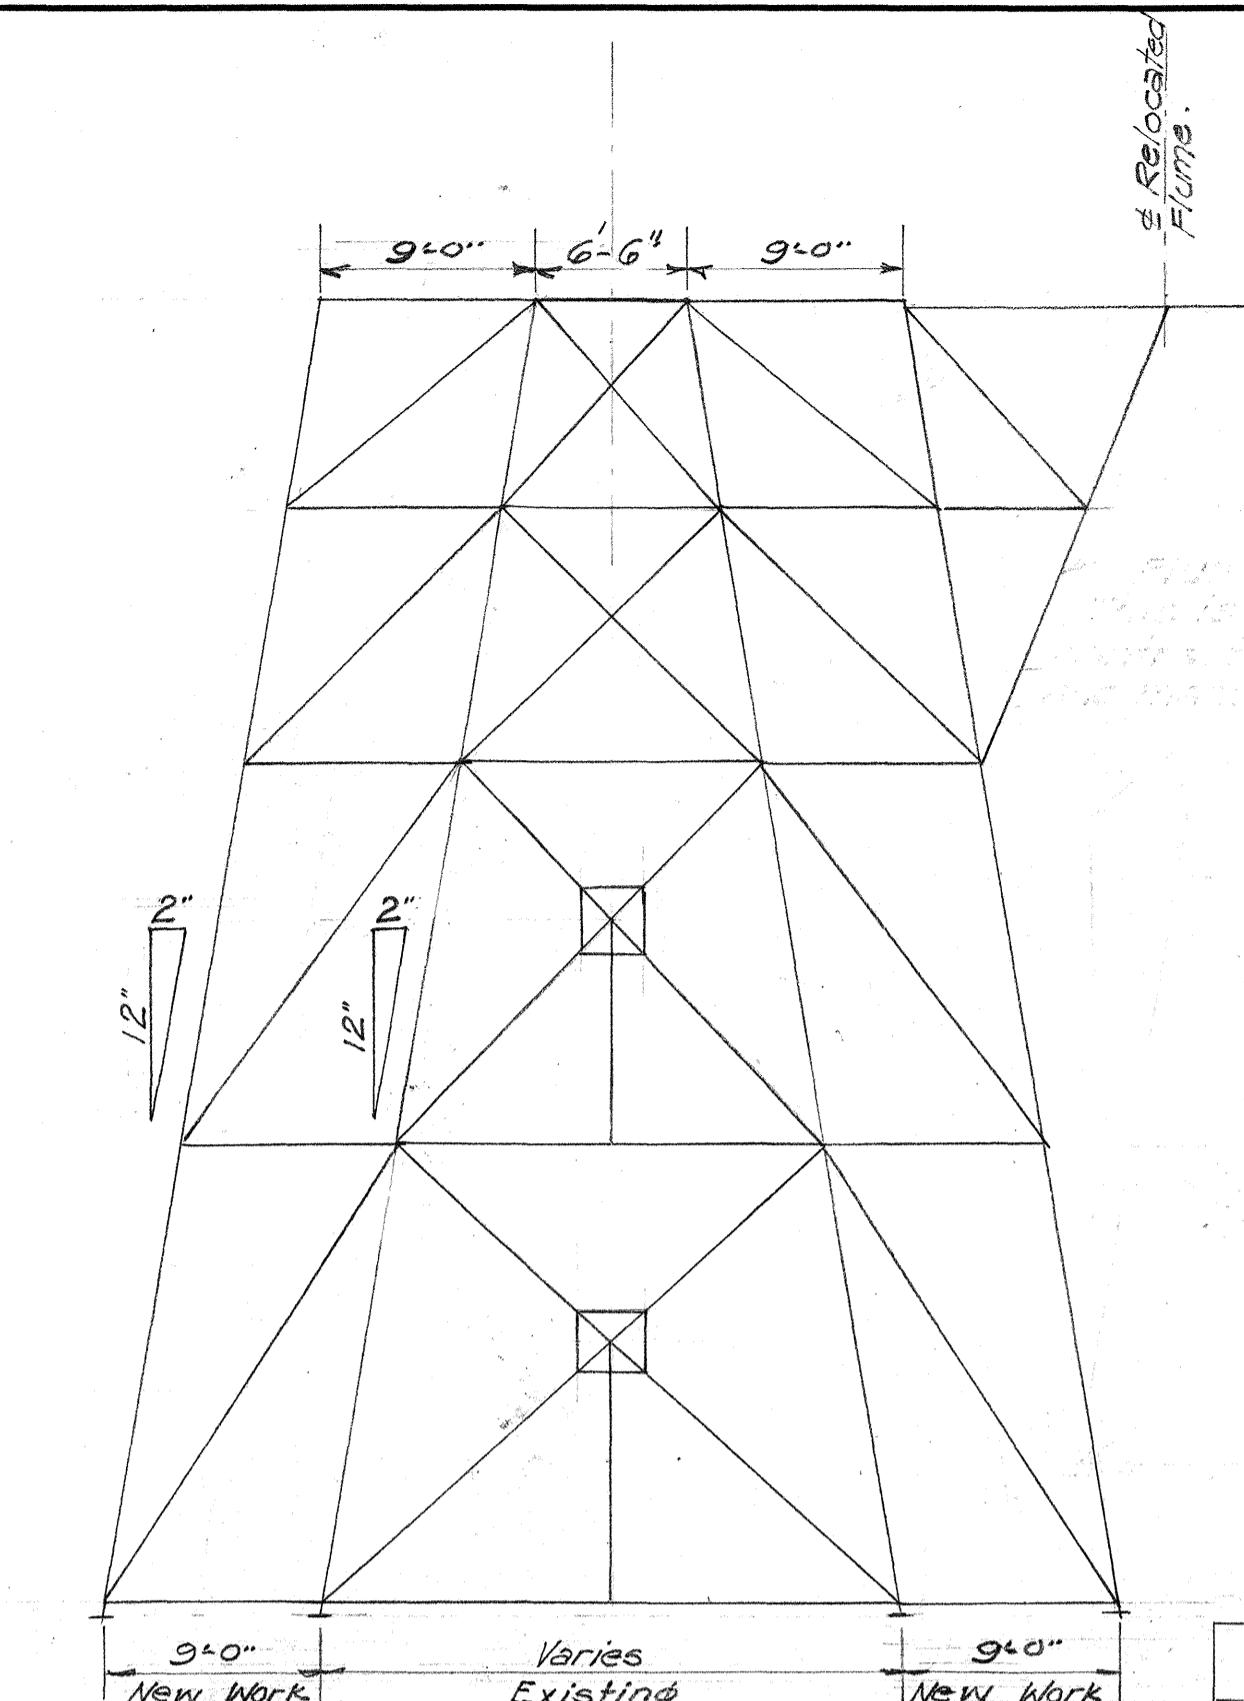
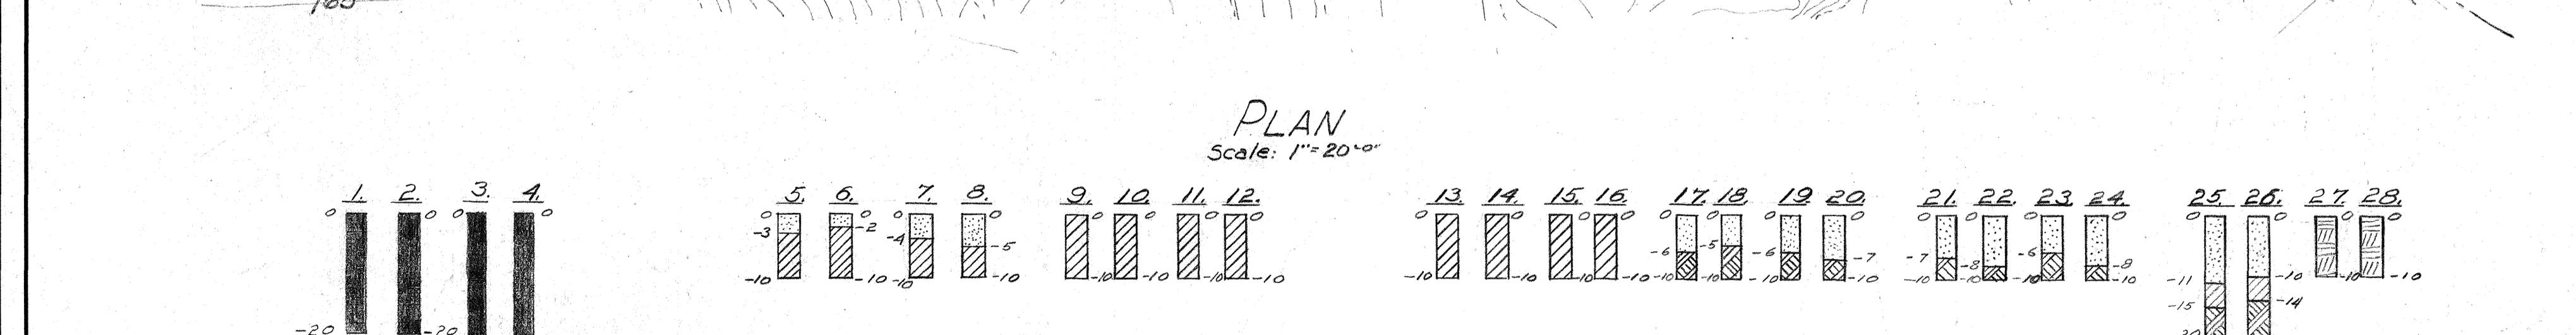
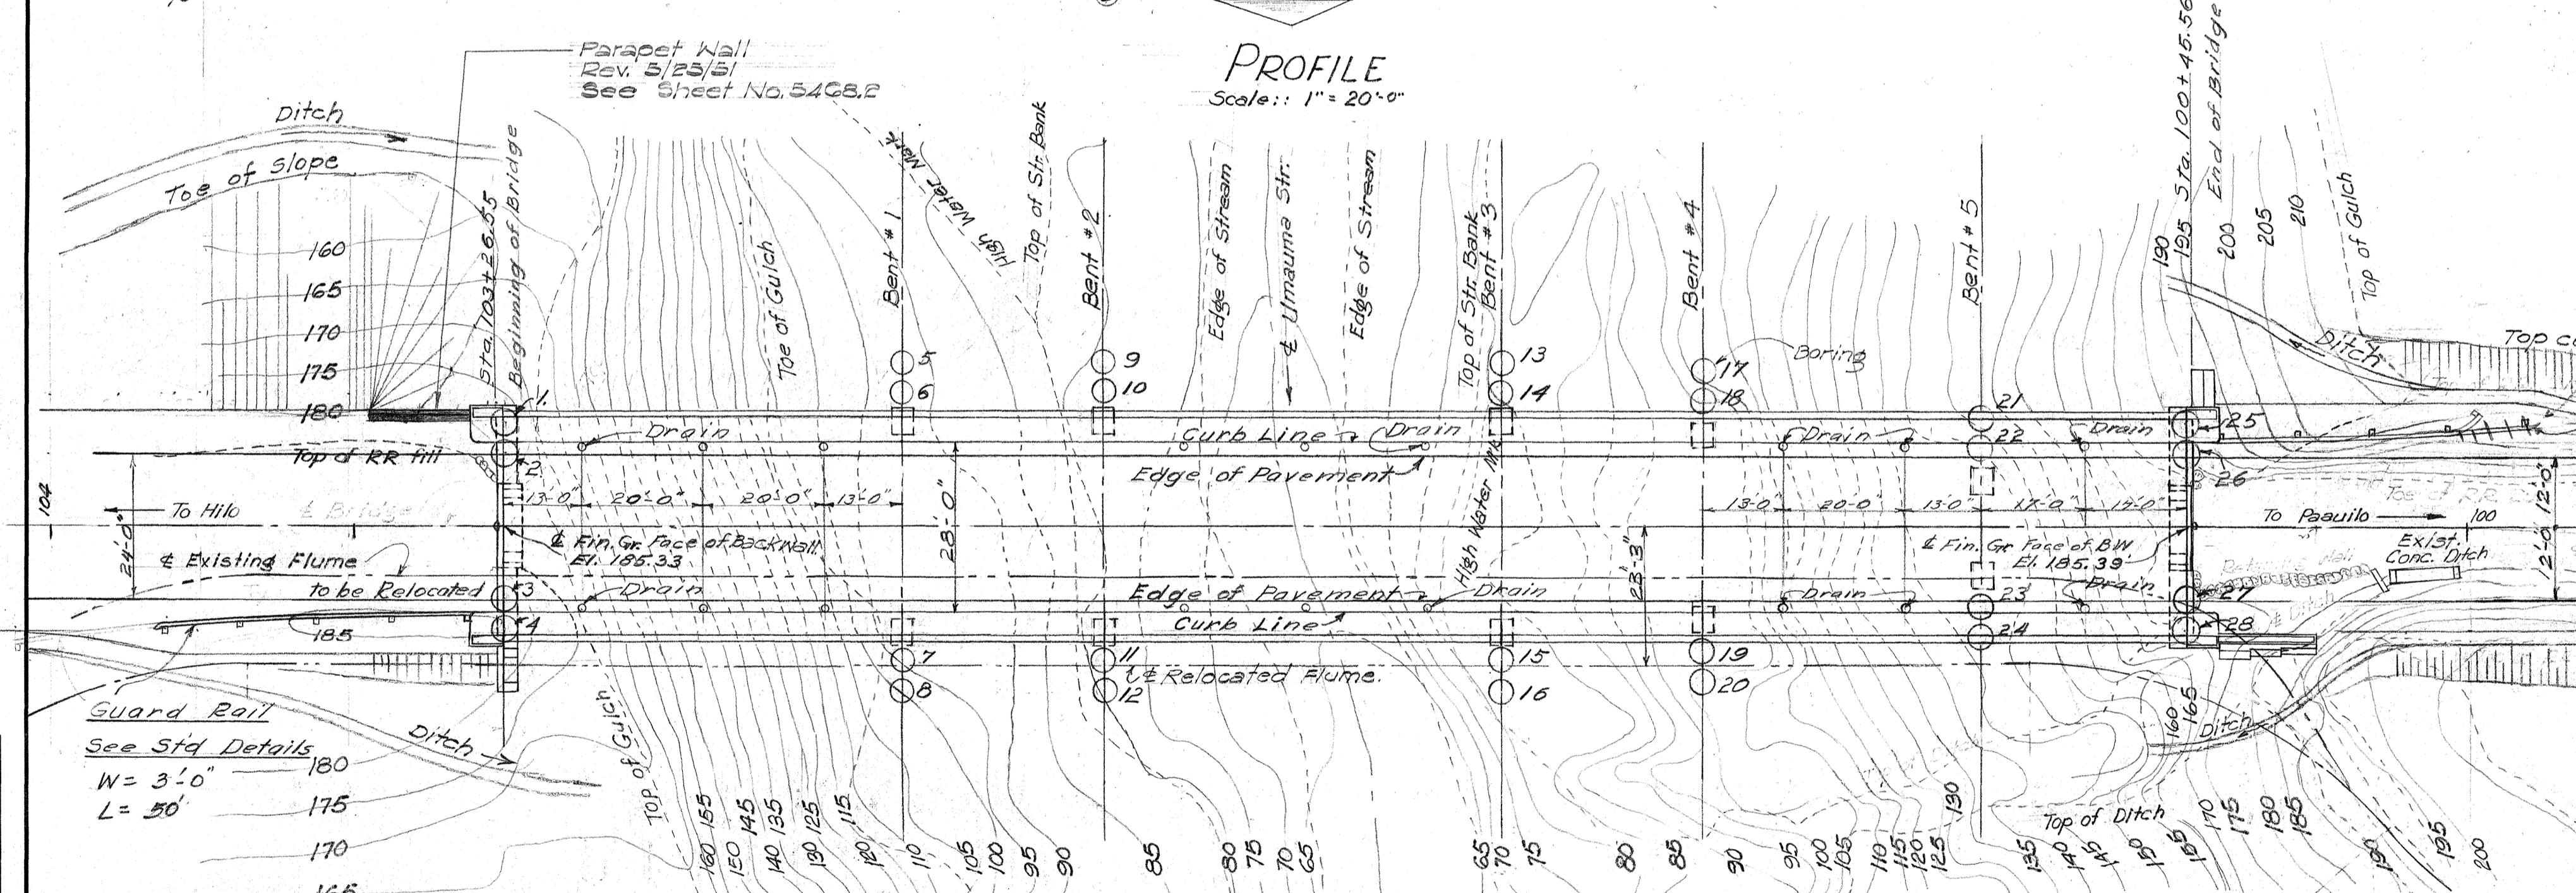


FED. ROAD DIST.	STATE	FED. AID PROJ. NO.	FISCAL YEAR	SHEET NO.	TOTAL SHEETS
HAWAII HEM		SDR 3(13)	1950	143	304

11/8/50  
1/5/51  
Revision: 4-5-51. Quantity for cleaning, fabricating and erecting salvaged steel changed.

Revision: 5-16-51. Reinf. Steel Quant. changed. Hooks eliminated. Bottom rail reinf. rev. All bar deformations must conform to ASTM-A305. End parapet wall added at Abut. #1 Left.

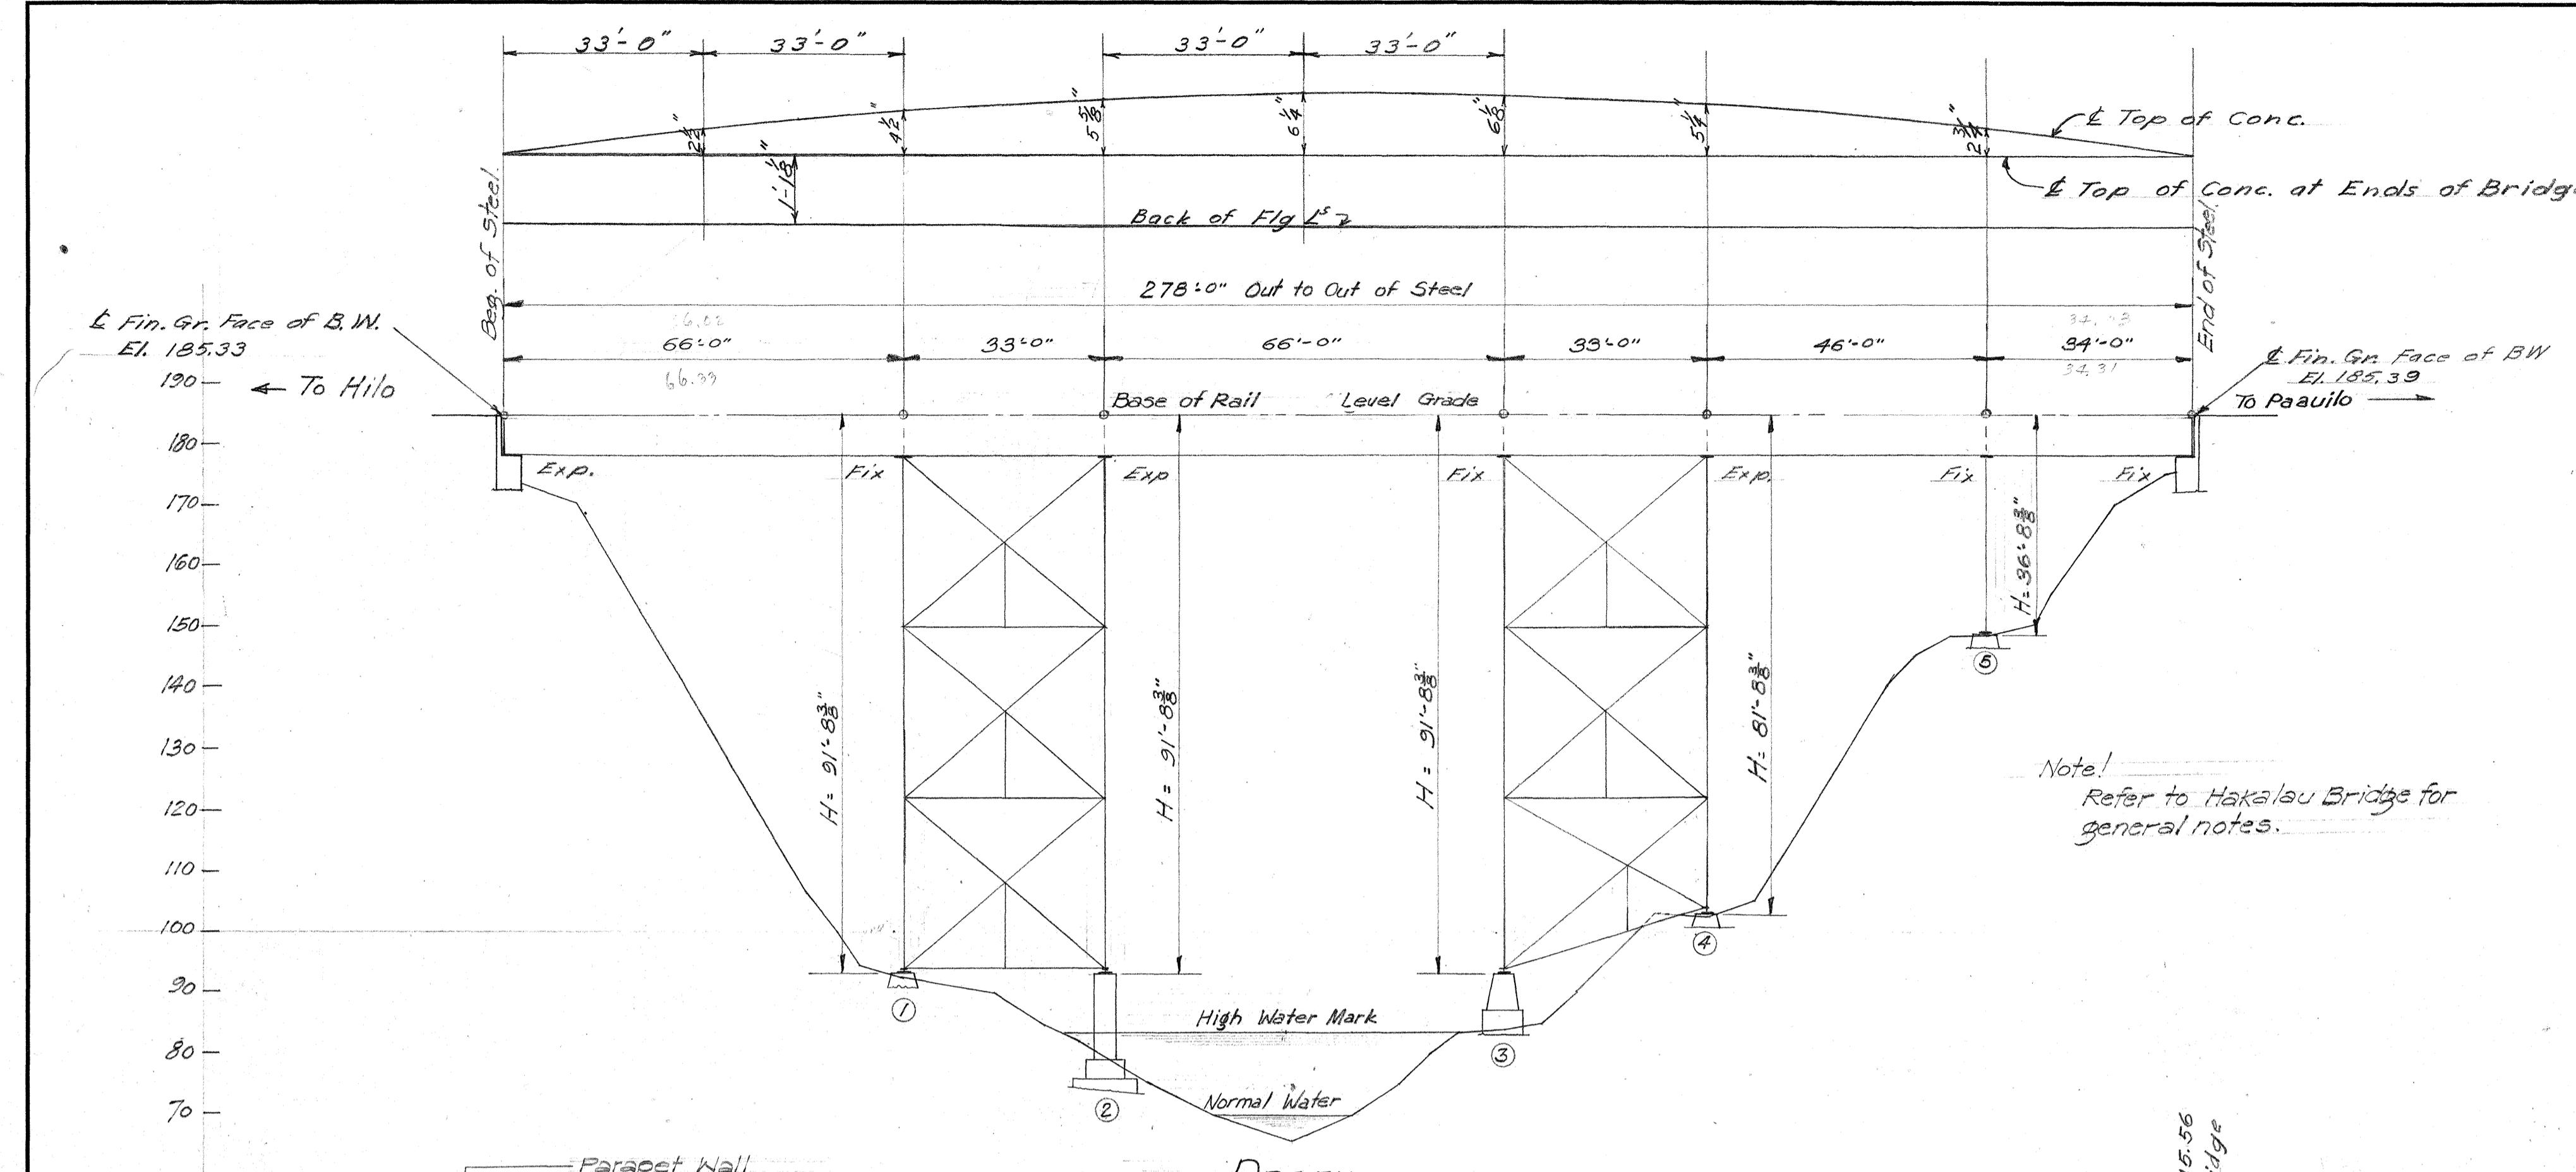

### TYPICAL BENT ELEVATION

Scale: 1/8" = 1'-0"


REV. 4-5-51

### ESTIMATED QUANTITIES

Item	Total
Furnishing, fabricating and erecting new steel	119,650#
Cleaning, fabricating and erecting salvaged steel	289,100#
Cleaning and applying 1st coat of paint to steel in existing P.P. bridge	343,000#
Painting entire structure with two field coats of paint	Lump sum
Removing and replacing 3/8" x 2 1/2" (Av) rivets in tower bracing system	2000 pc's.
Removing and replacing 3/8" x 3 1/4" (Av) rivets	4600 pc's.
Removing damaged members from towers	1027#

### ESTIMATED QUANTITIES (Continued)

Item	Super-Structure	Railing & End Posts	Abutments		PIERS	TOTAL
			No 1	No 2		
Class A-1 Conc.	321 cu.yds.	38 cu.yds.	112 cu.yds.	112 cu.yds.	471 cu.yds.	489 cu.yds.
Class B-2 Conc.					196 cu.yds.	196 cu.yds.
Class C-1 Conc.					50 cu.yds.	50 cu.yds.
Class C-1 Cyclopean Concrete					73 cu.yds.	73 cu.yds.
Struct. Ex.			448 cu.yds.	200 cu.yds.	344 cu.yds.	992 cu.yds.
Reinf. Steel	59,147 lbs.	6,753 lbs.	18,302 lbs.	1,188 lbs.	88,441 lbs.	81,574 lbs.
Dry Rubble Masonry					7,500 cu.yds.	6 cu. yds. 13,500 cu.yds.
Hard placed rock fill					20 cu.yds.	8.5 cu.yds. 28.5 cu.yds.
A.C. Paving	43.79					43.79 Tons
Reinf. Steel	56,465 lbs.	6,762 lbs.	10,899 lbs.	1,087 lbs.	2,244 lbs.	77,257 lbs.

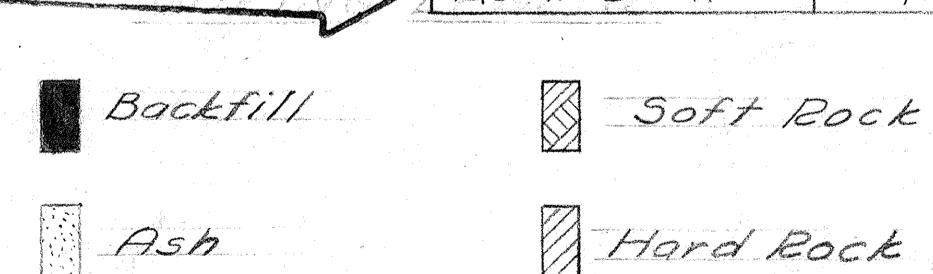

### BORING LEGEND

Note: Zero (0) shown on the borings is the ground surface elevation of each boring.

TERRITORIAL HIGHWAY DEPARTMENT  
TERRITORY OF HAWAII

UMAUMA BRIDGE


Sta. 100+45.56 to 103+26.55

HAWAII BELT ROAD SDR 3(13)

Apr. 1949

SHEET NO. 1 OF 12 SHEETS

546S.143

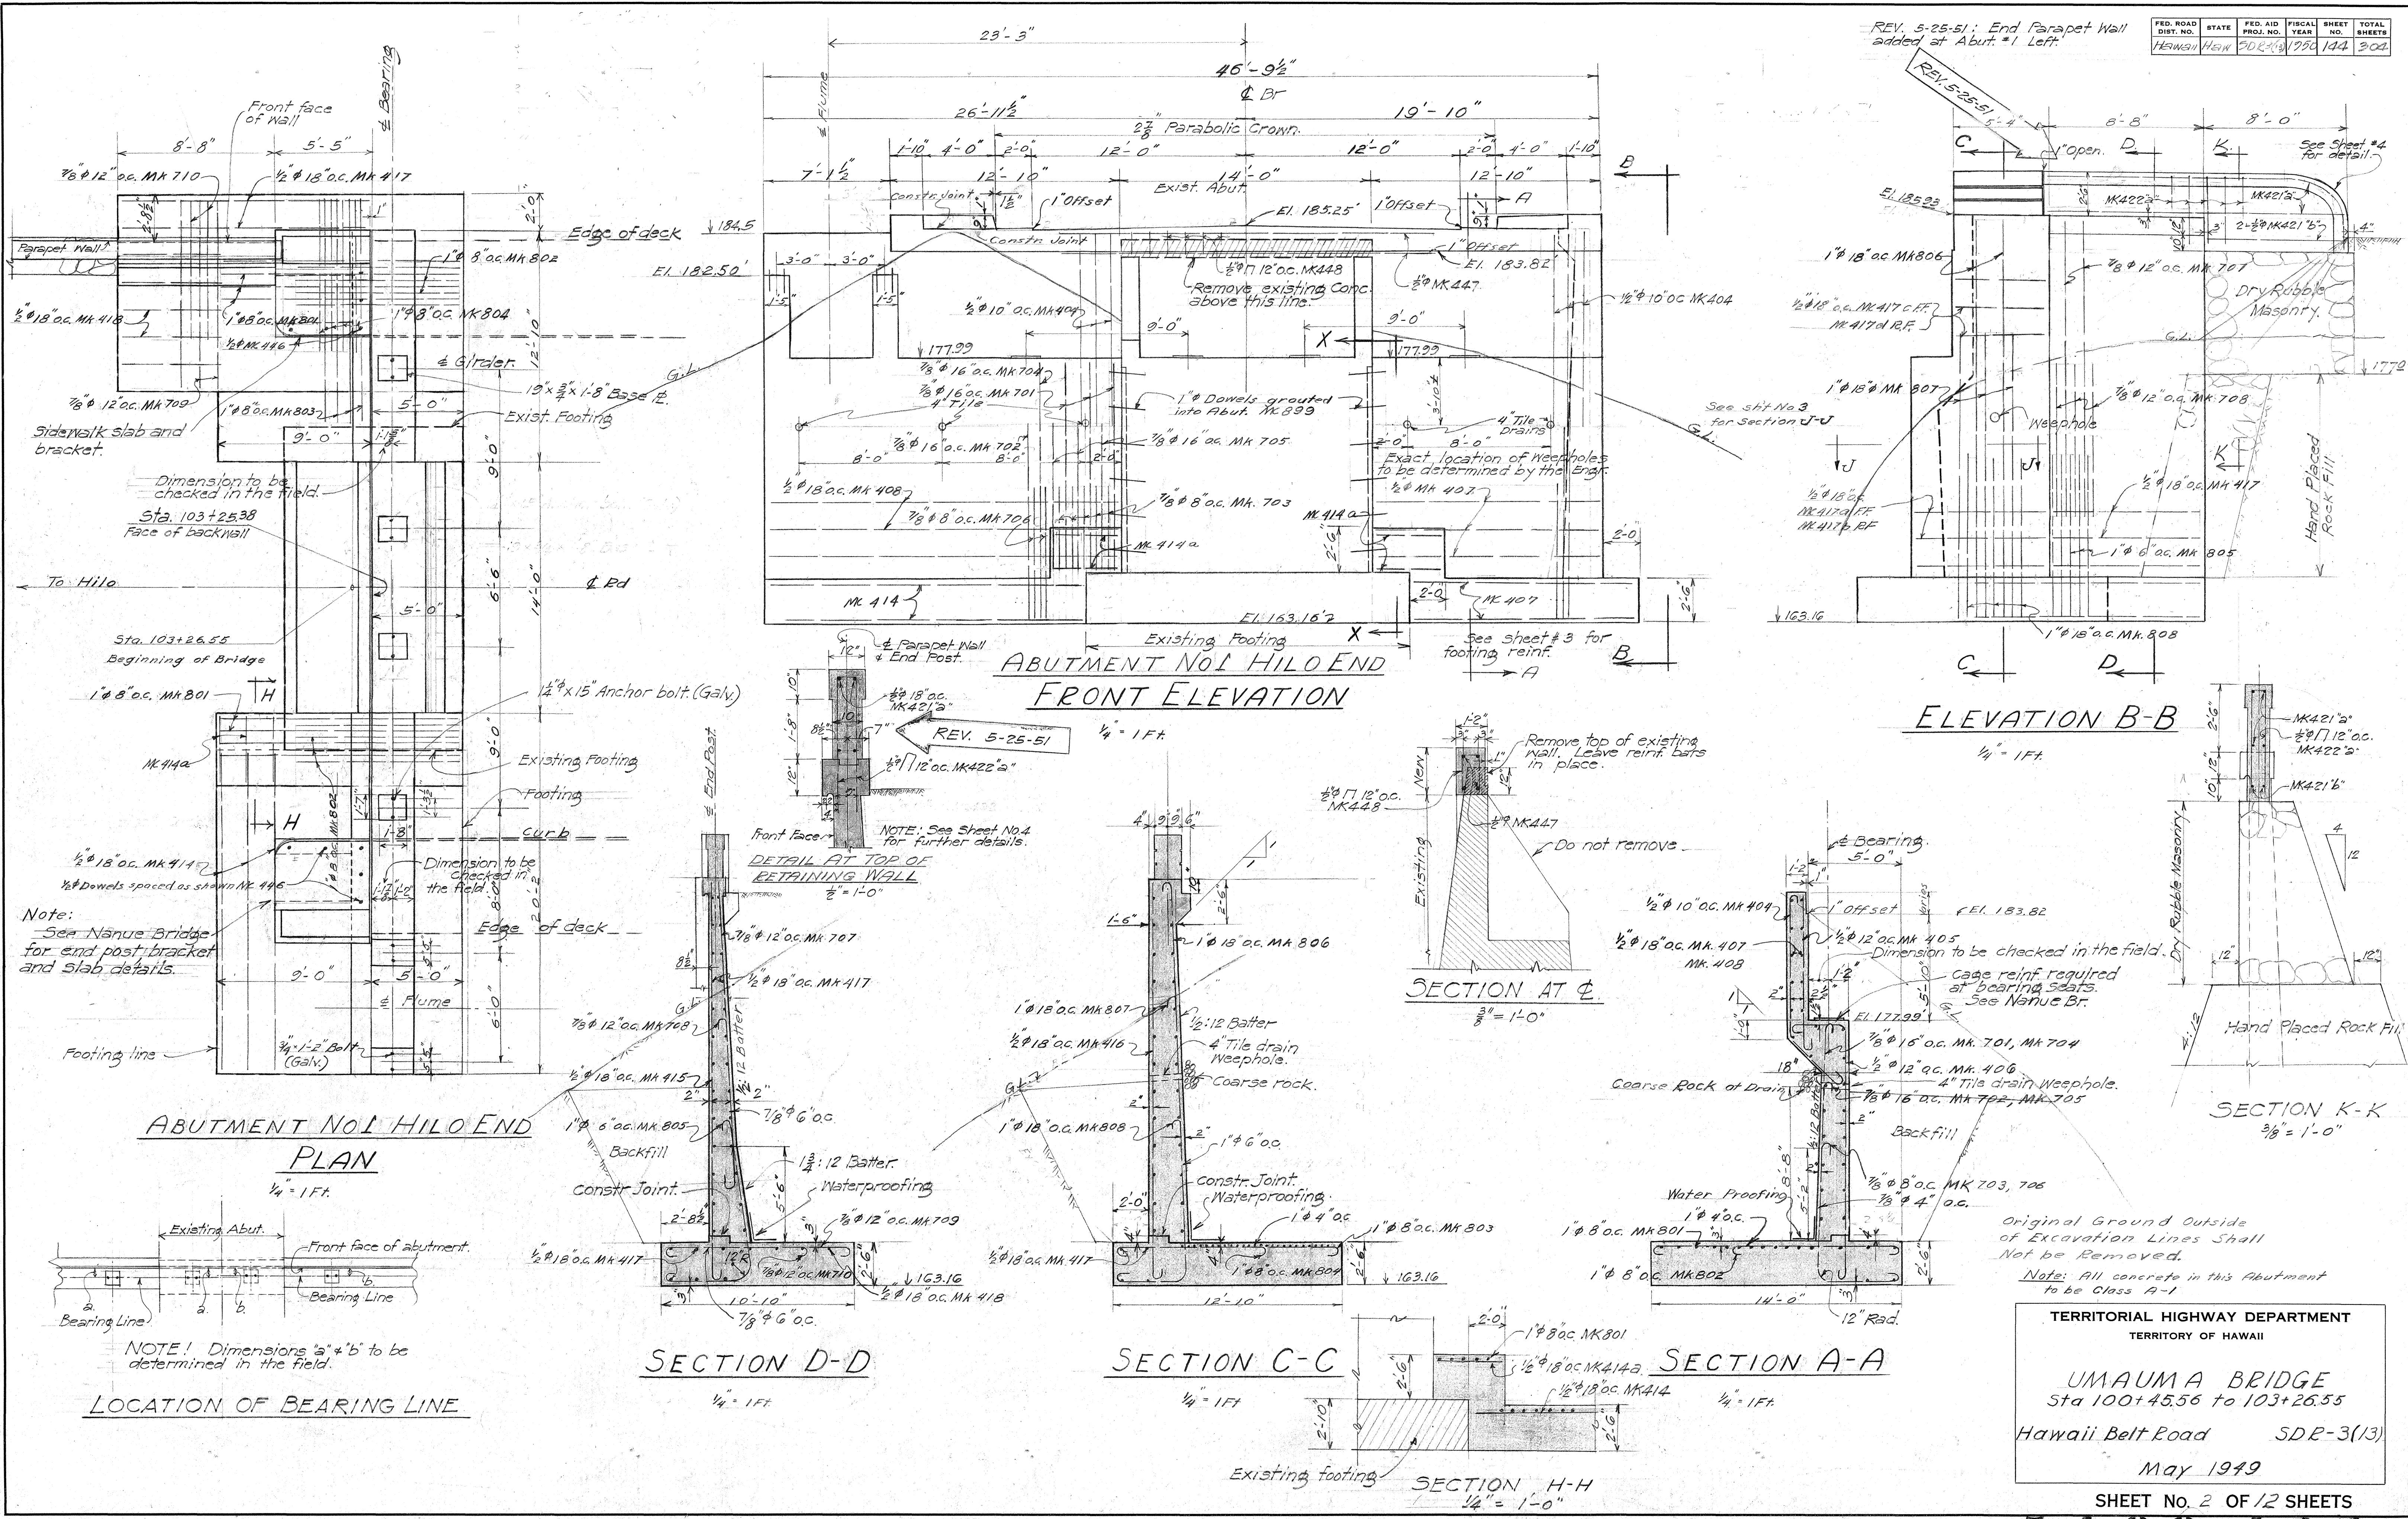


**TERITORIAL HIGHWAY DEPARTMENT  
TERRITORY OF HAWAII**


UMAUMA BRIDGE  
Sta 100+45.56 to 103+26.55  
Hawaii Belt Road SDR-3(13)

May 1949


HEET NO. 2 OF 12 SHEETS

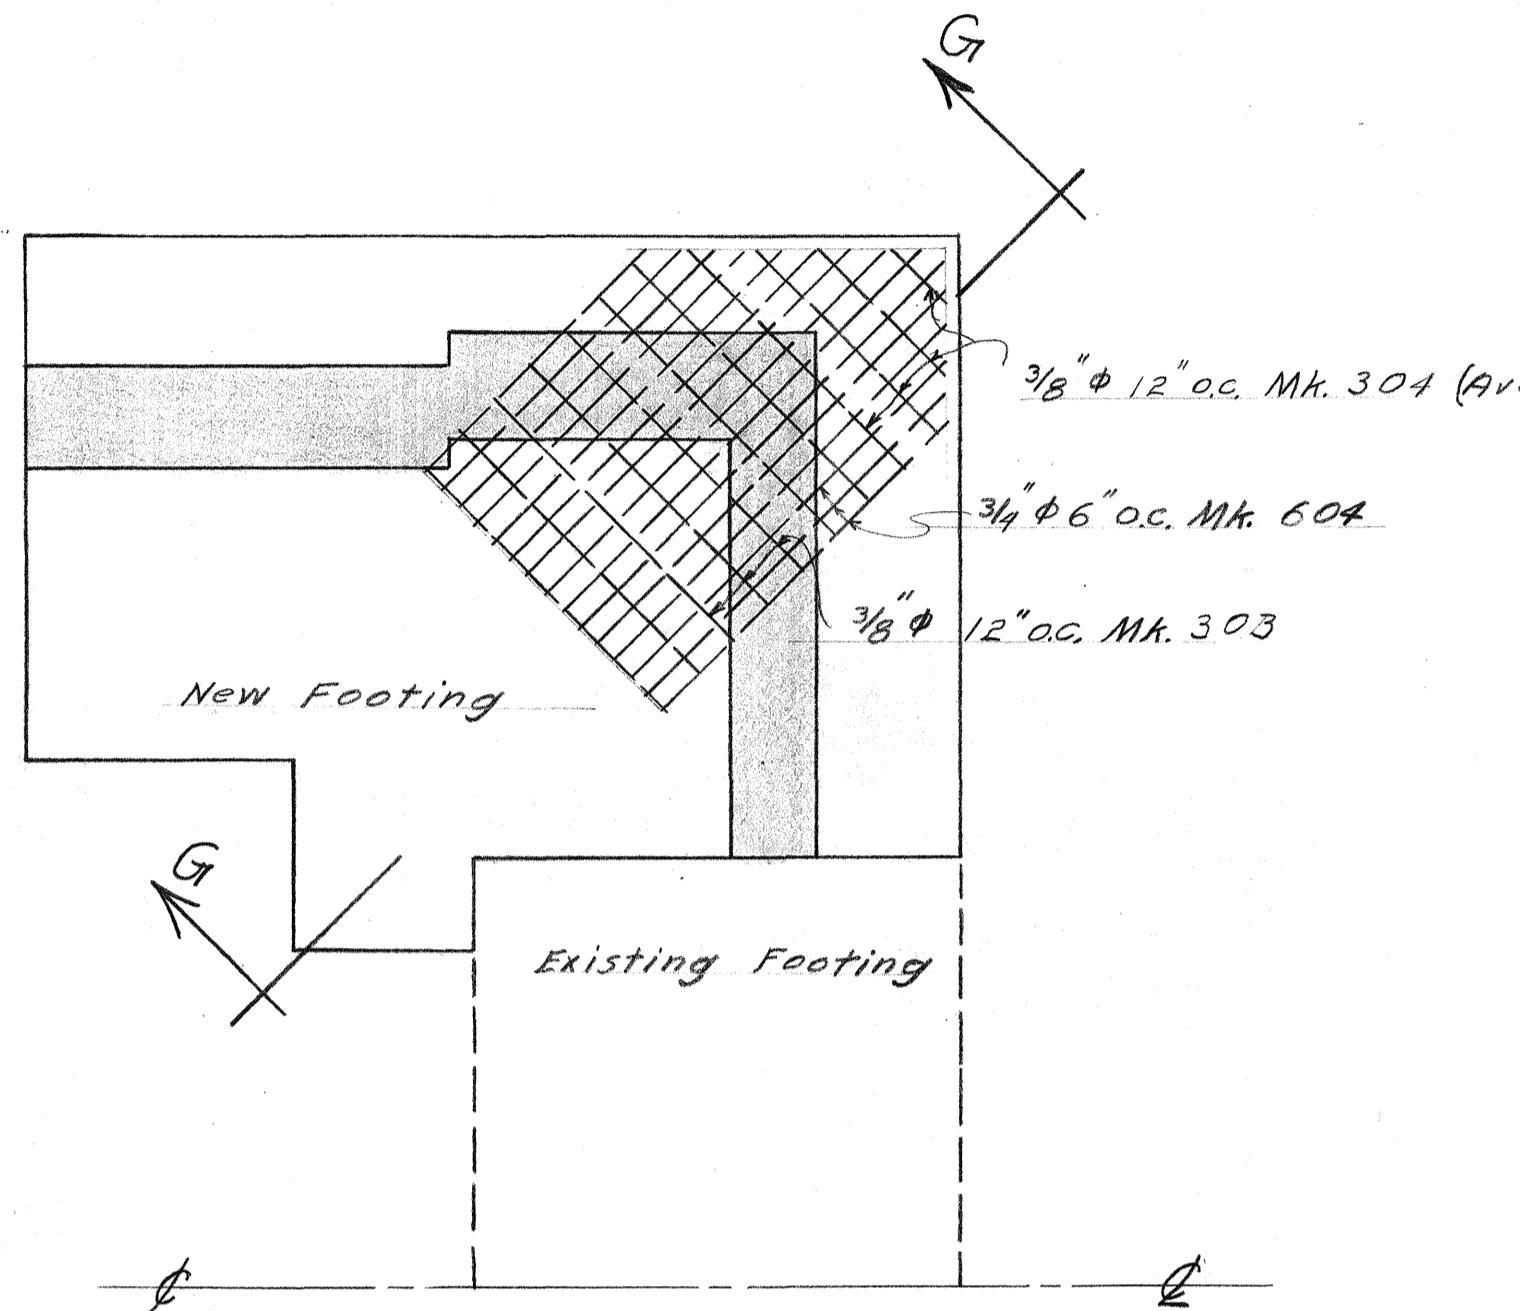

SECTION H-H

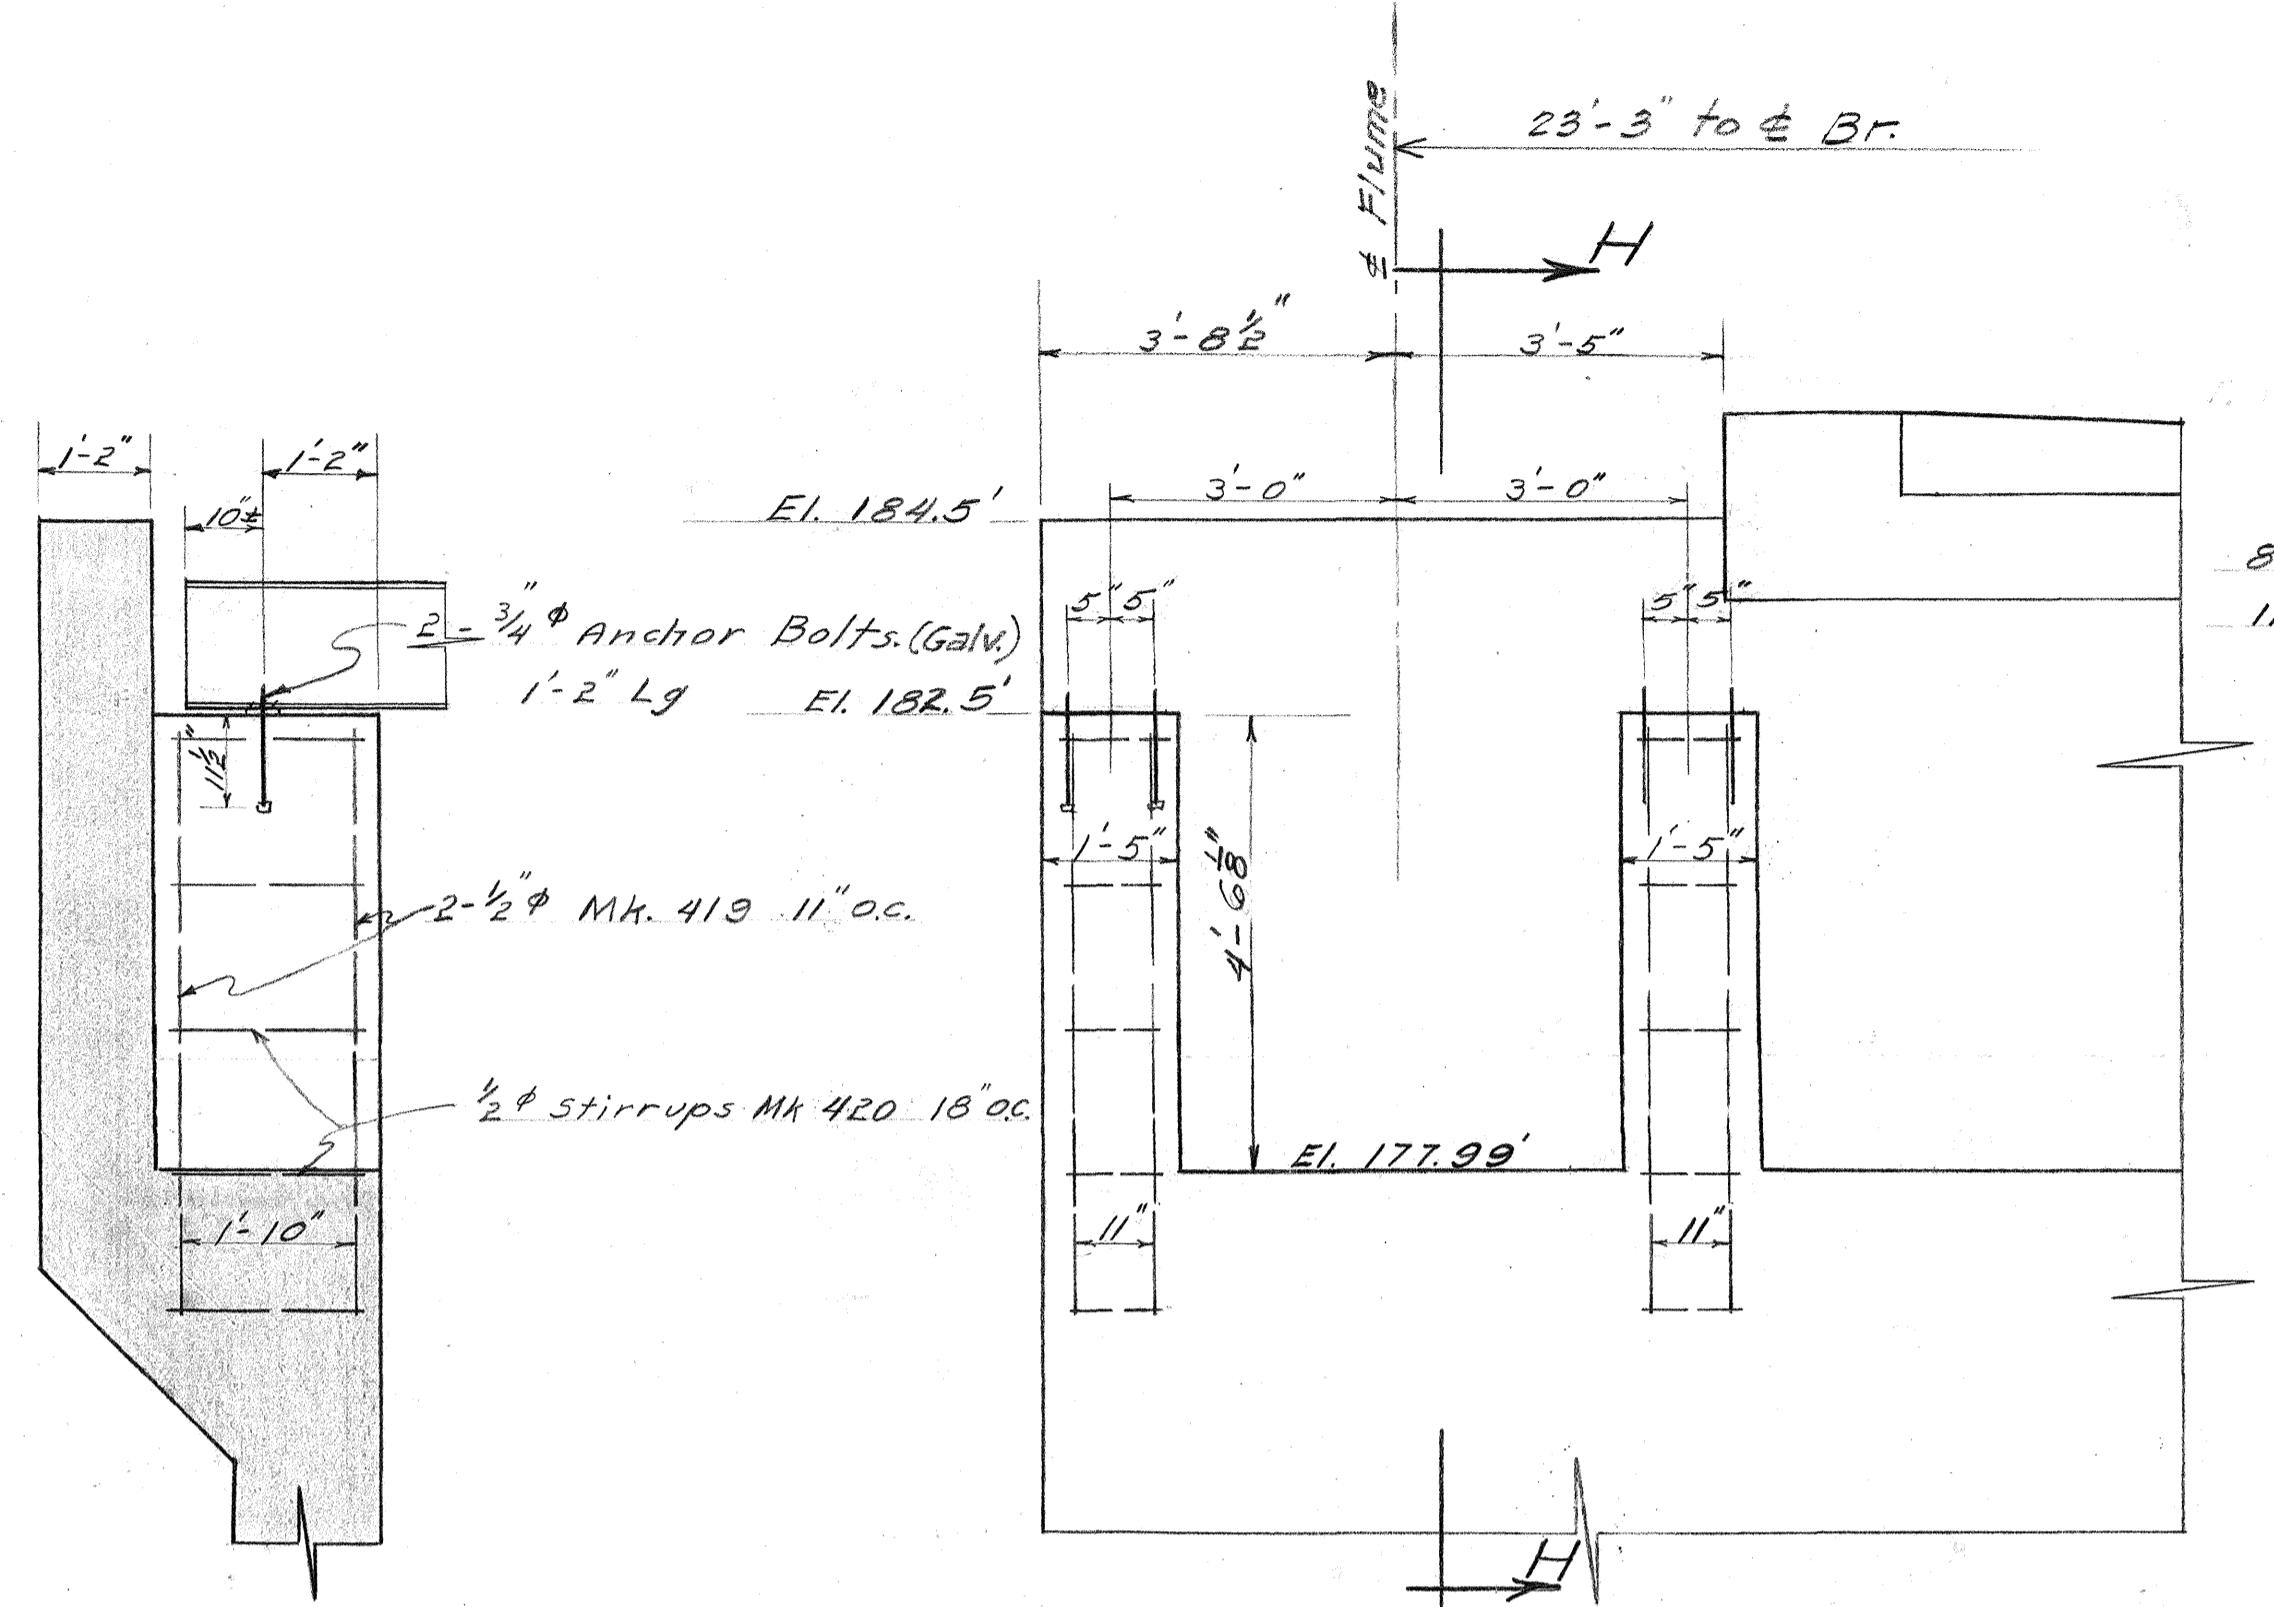


FRONT ELEVATION

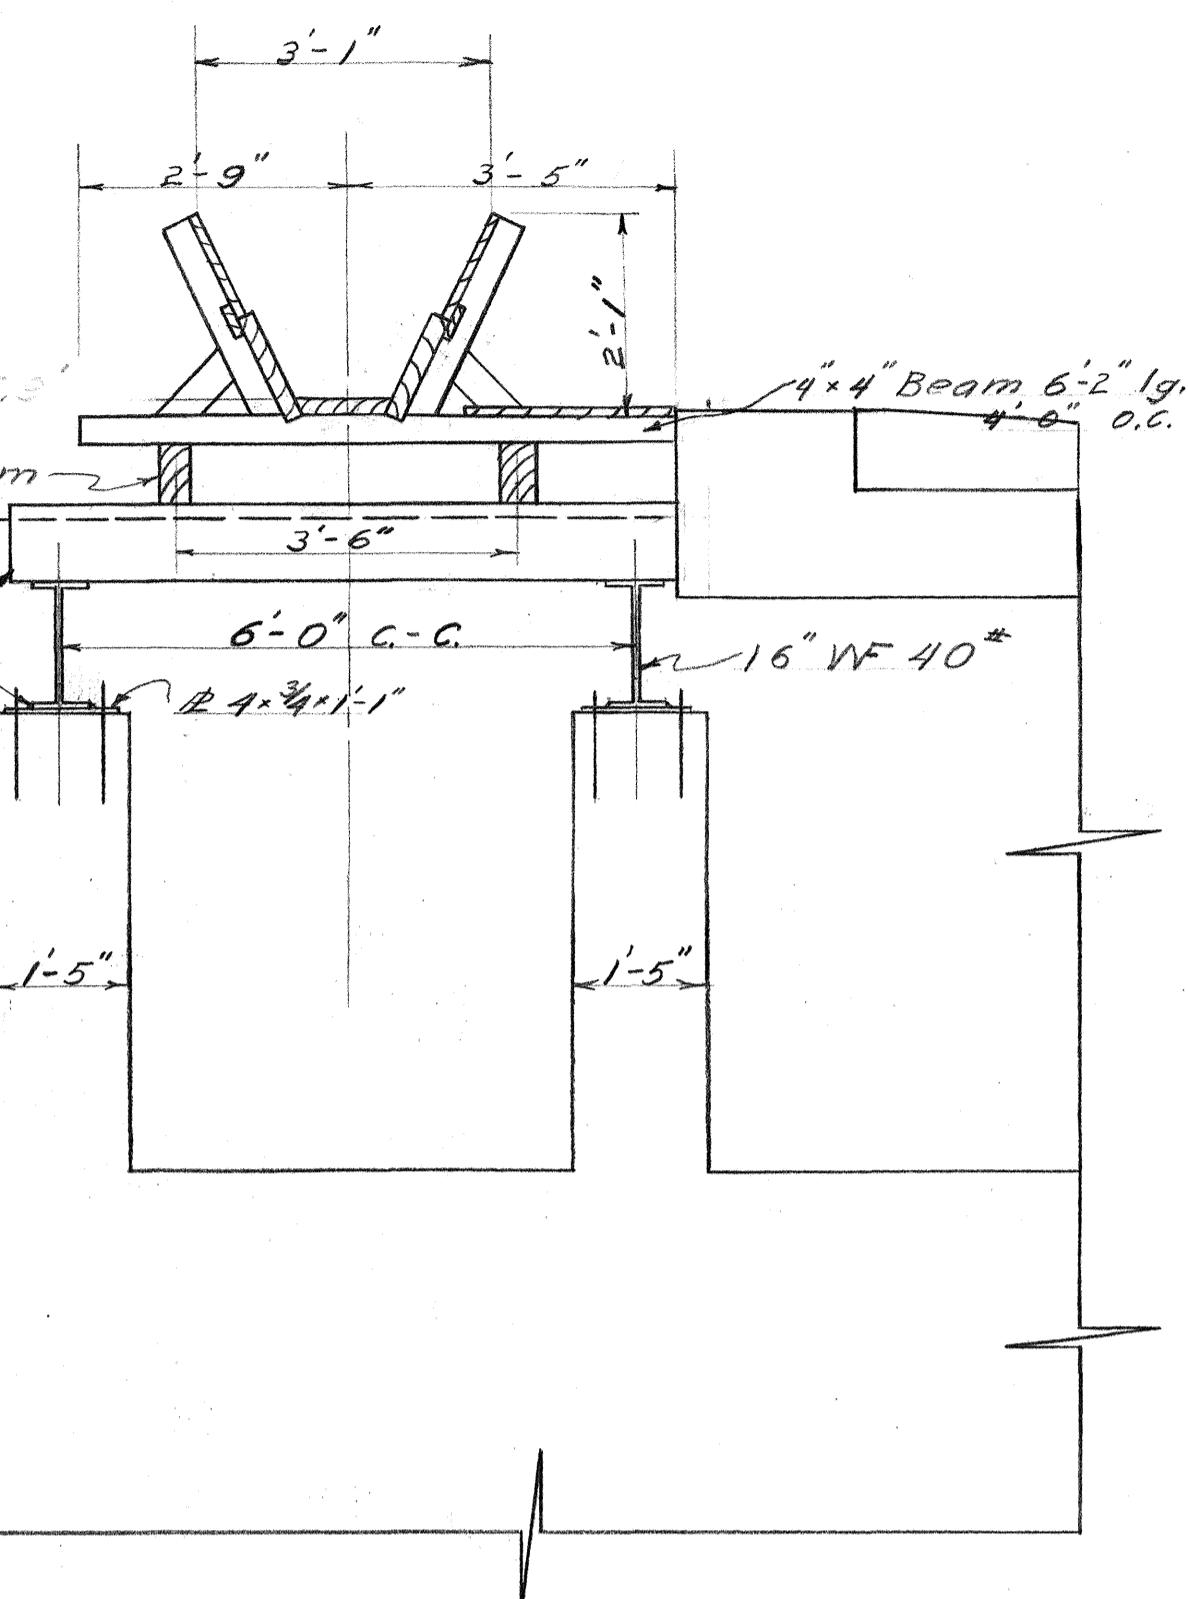


CANE FLUME DETAIL

HALF PLAN OF FOOTING ABUT. NO. 1.  
SHOWING BOTTOM FACE REINFORCING.

$\frac{1}{4}$ " = 1 FT.

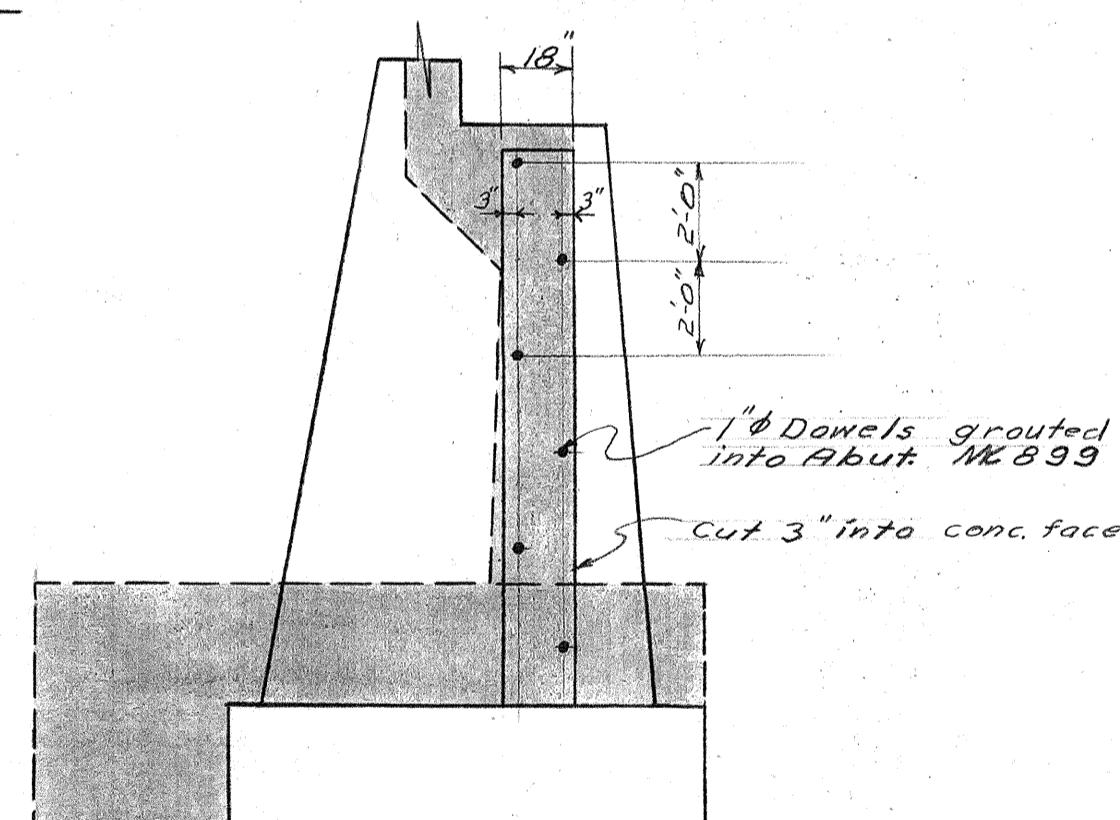


SECTION X-X (see Sht. #2)

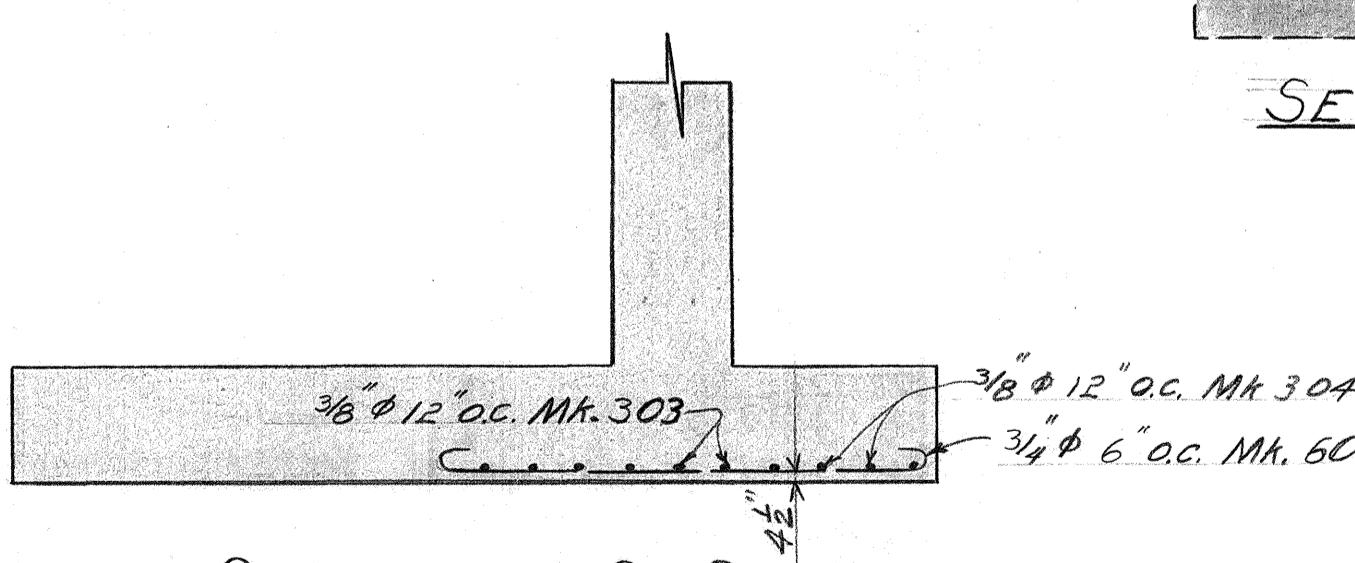

SECTION G-G


$\frac{1}{4}$ " = 1 FT.

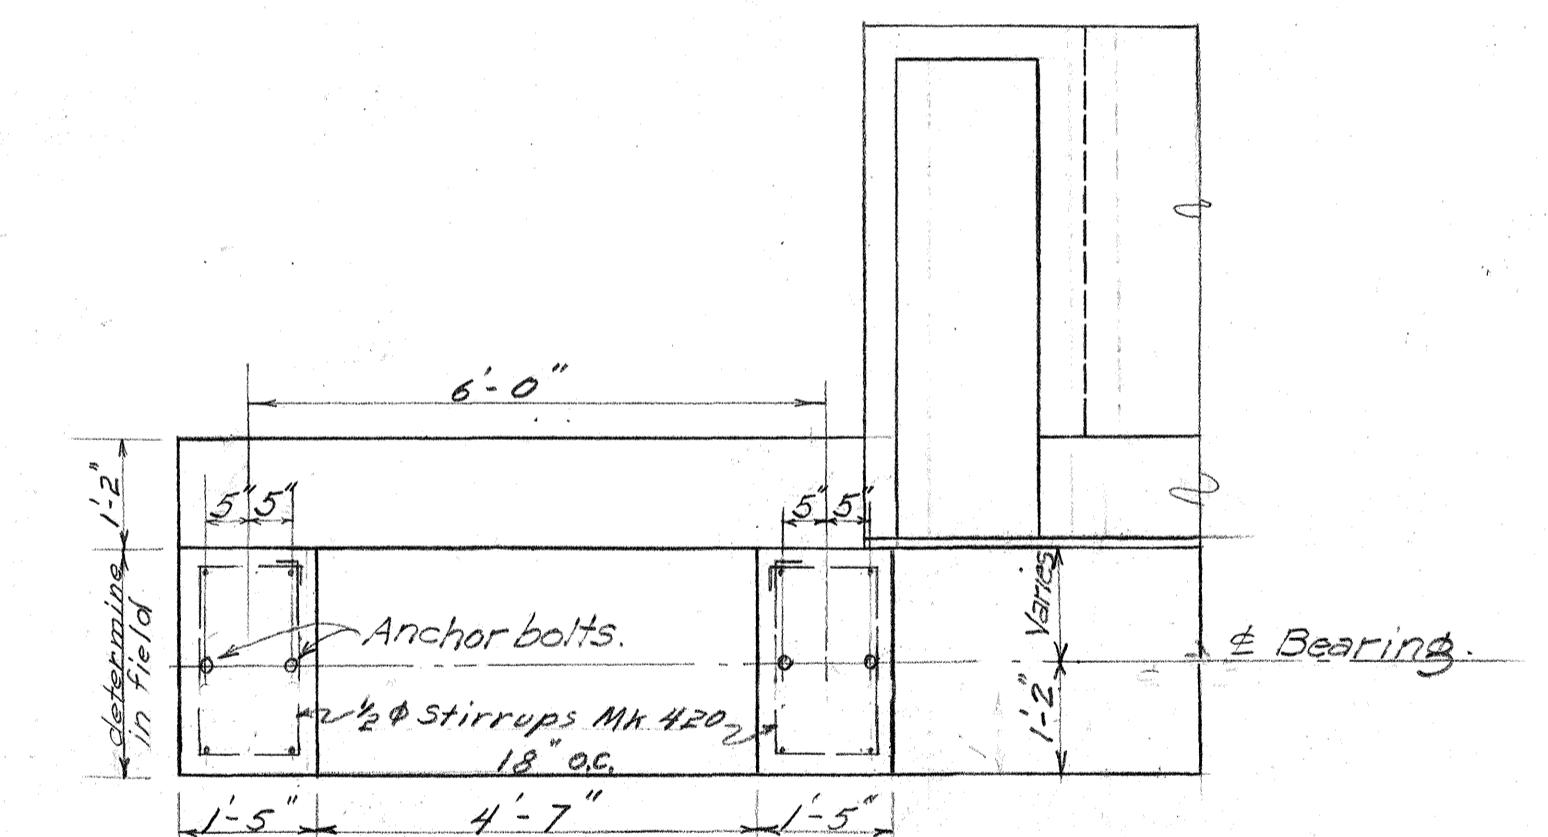

PLAN

DETAILS OF ANCHORAGE  
FOR CANE FLUME GIRDERS

$\frac{1}{2}$ " = 1 FT.

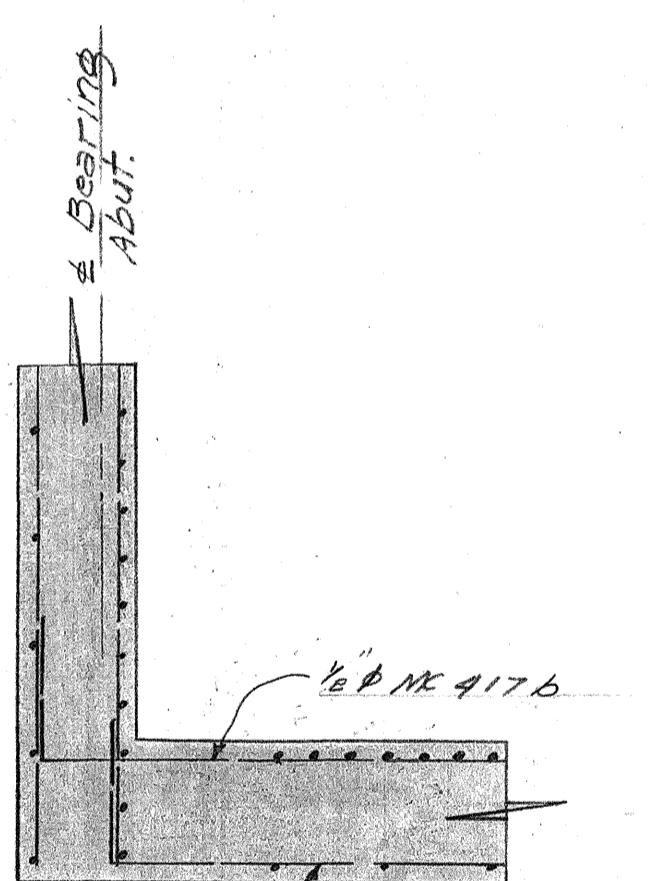

SECTION J-J (See Sht. #2)

$\frac{3}{8}$ " = 1 FT.

TERRITORIAL HIGHWAY DEPARTMENT  
TERRITORY OF HAWAII

UMAUMA BRIDGE  
Sta. 100+45.56 to 103+26.55


Hawaii Belt Road

SDR-3(1/3)

May 1949

SHEET NO. 3 OF 12 SHEETS

5468.145

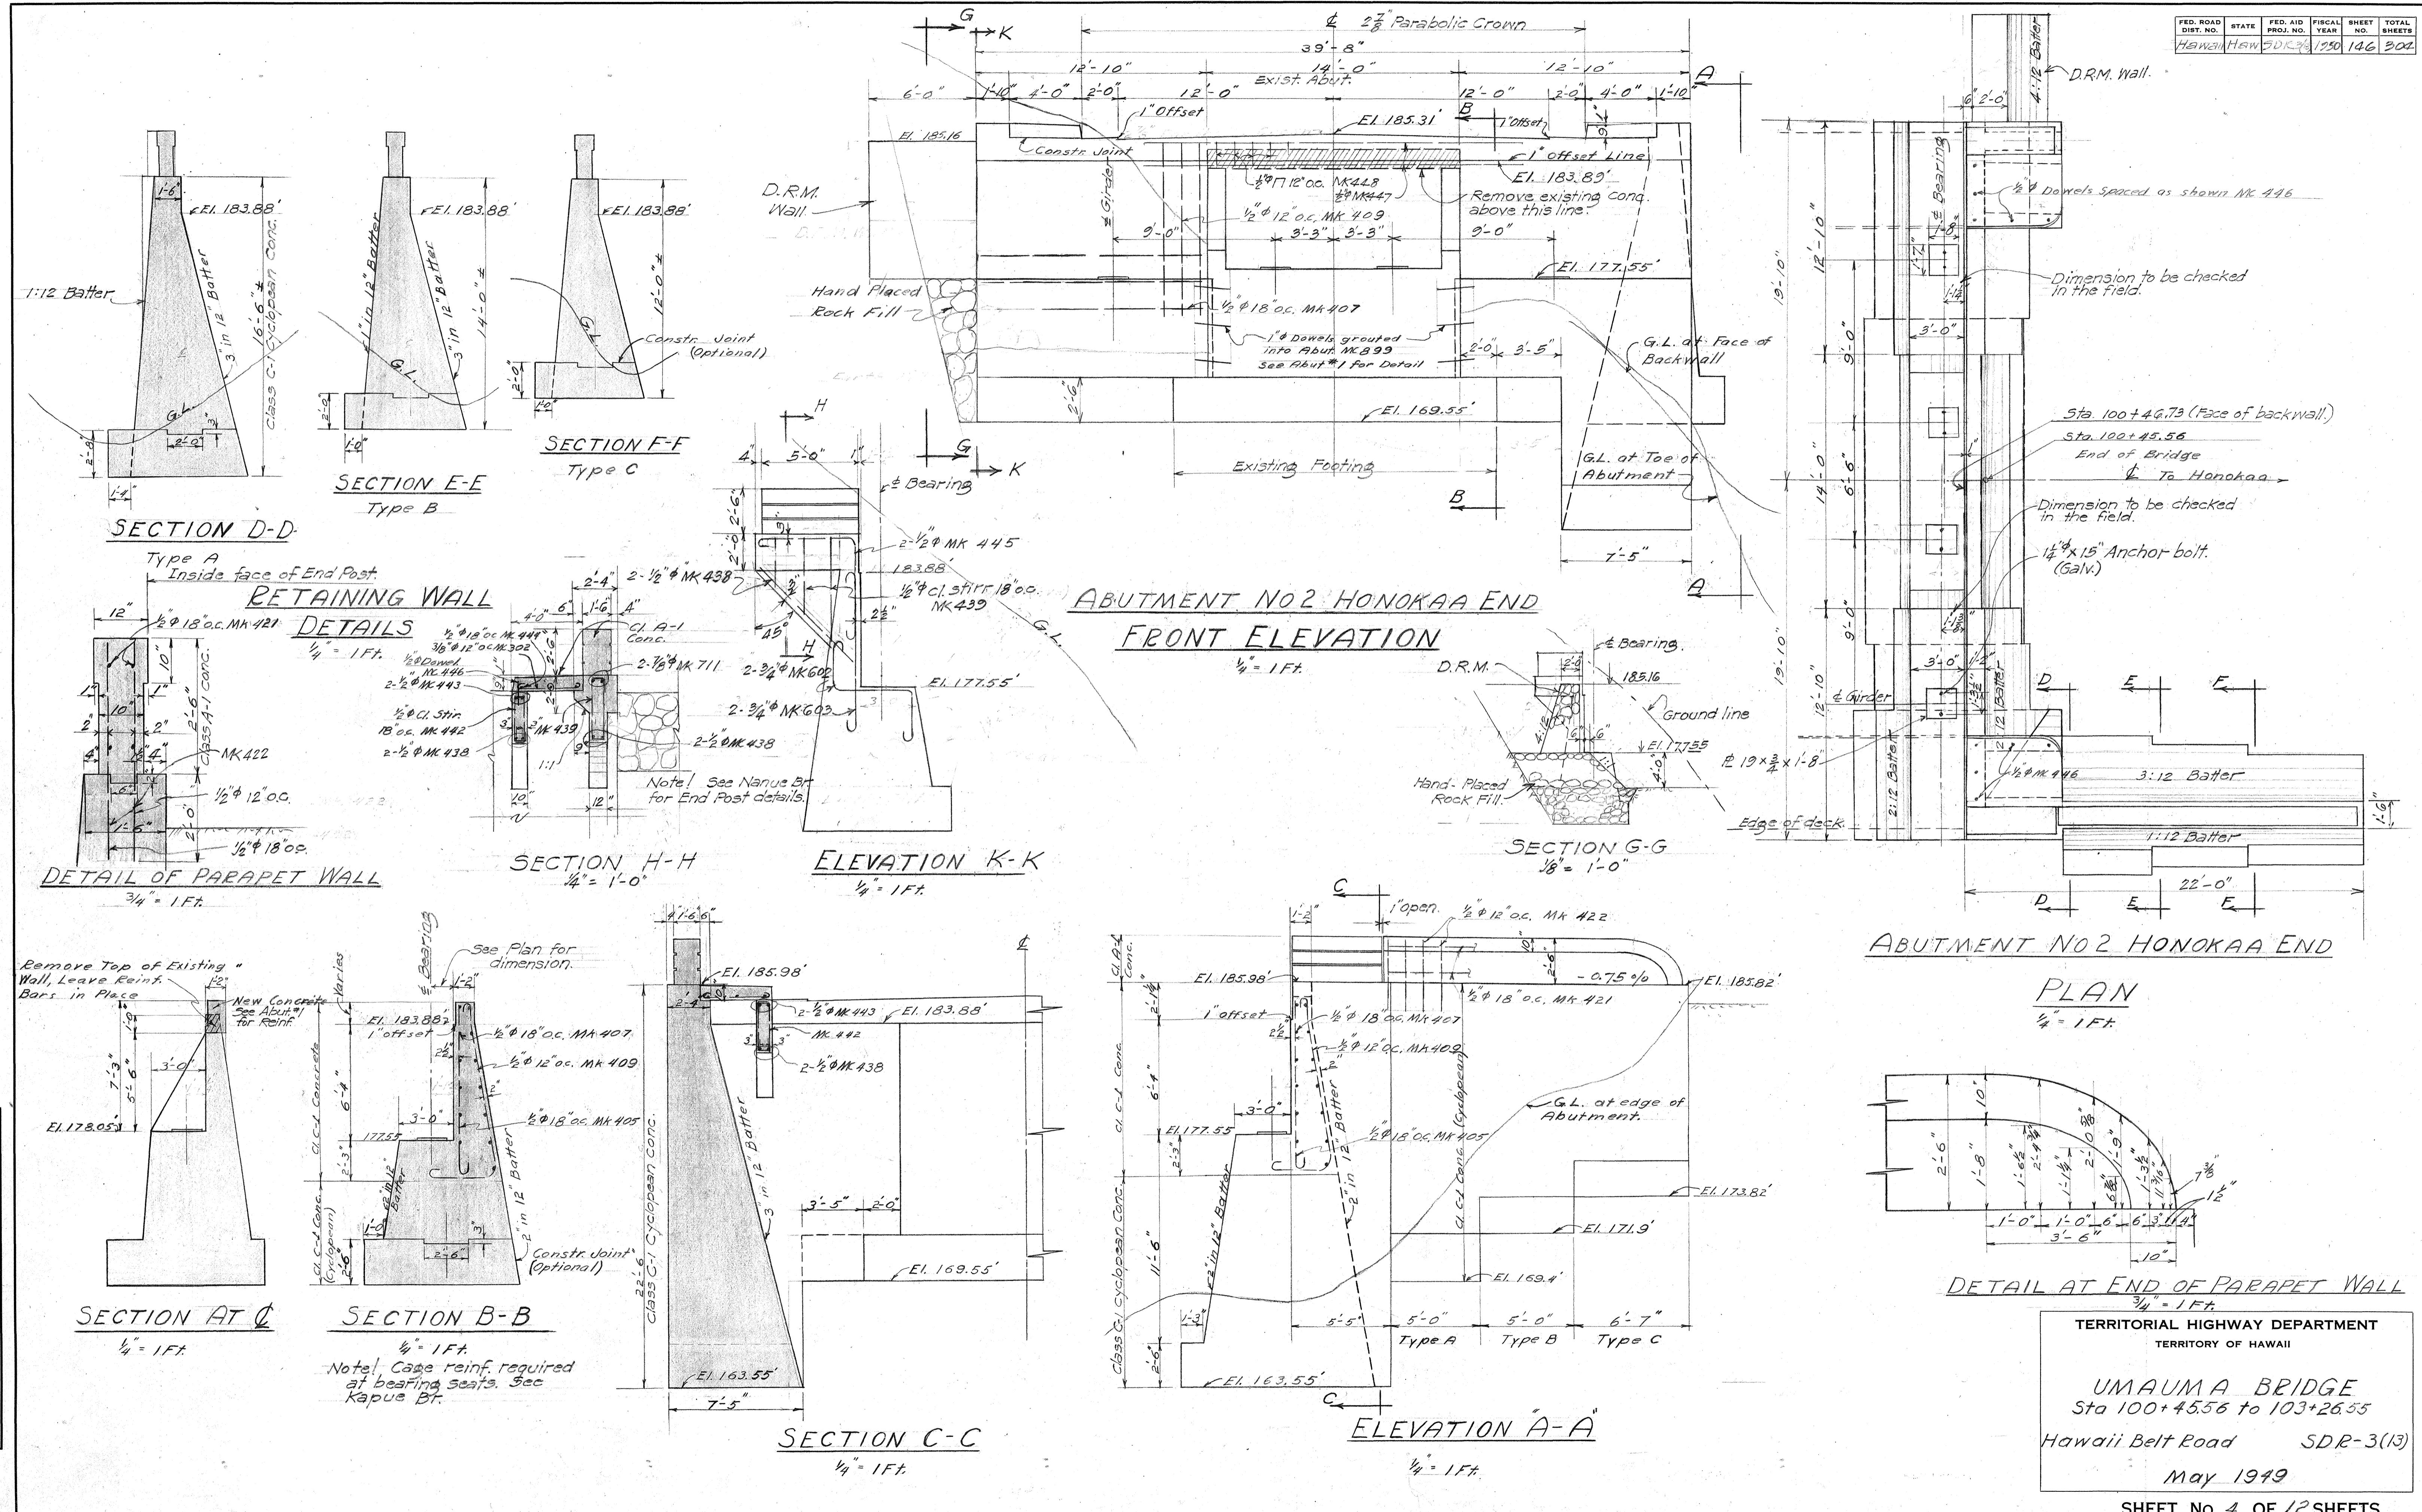

**TERRITORIAL HIGHWAY DEPARTMENT**  
**TERRITORY OF HAWAII**

## PERIODICITY OF VIBRATION

UMAUMA BRIDGE  
7 100 + 45.56 to 103 + 26.55

16-B-115-1-1 2500

111 Belt Road SDR-3(13)

May 1949

SHEET No. 4 OF 12 SHEETS



68 146

E 0 S. 1 F 0



146

FED. ROAD DIST. NO.	STATE	FED. AID PROJ. NO.	FISCAL YEAR	SHEET NO.	TOTAL SHEETS
HANNAH	HAWAII	SDR-3(13)	1950	147	302


REV. 5-16-51 : Railing Posts shortened 2".  
Bottom Rail revised.

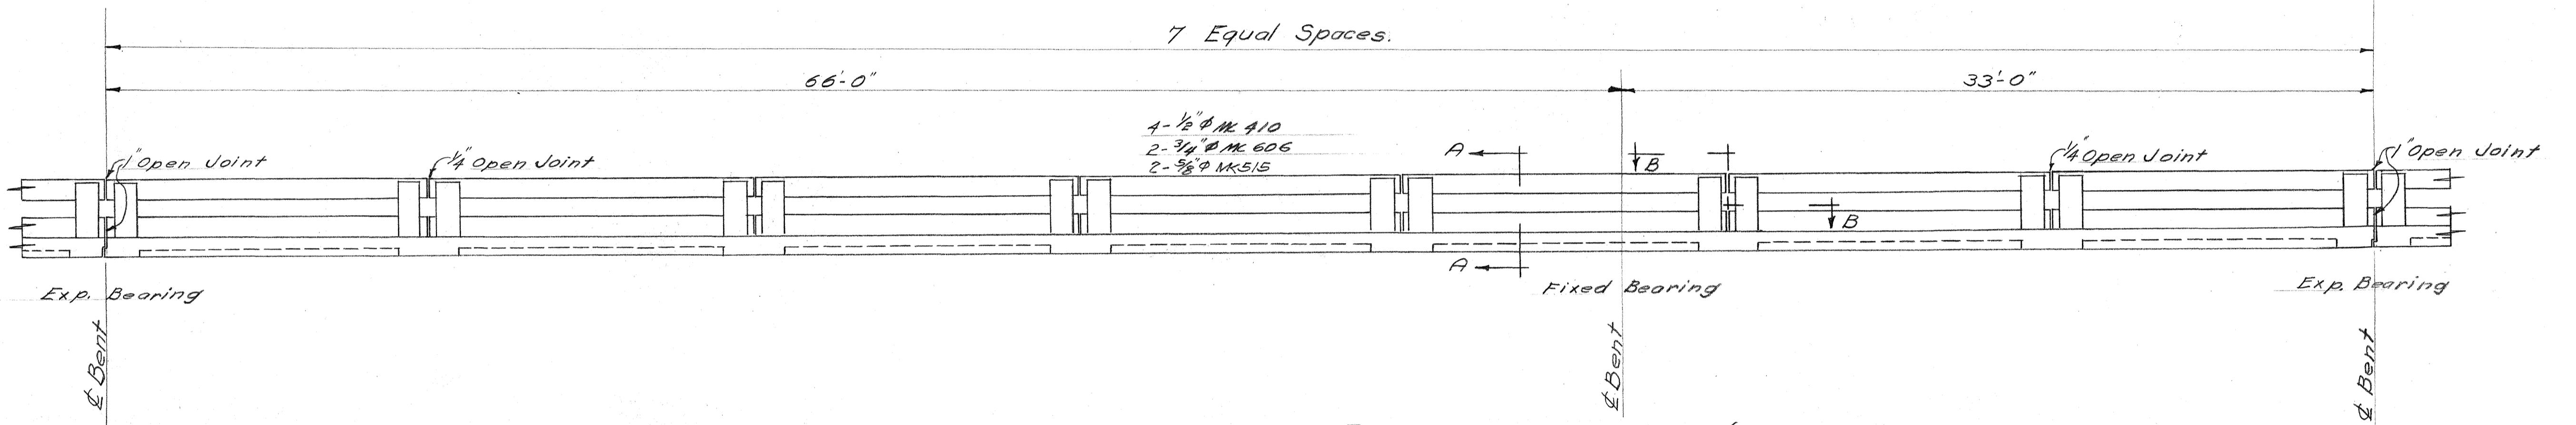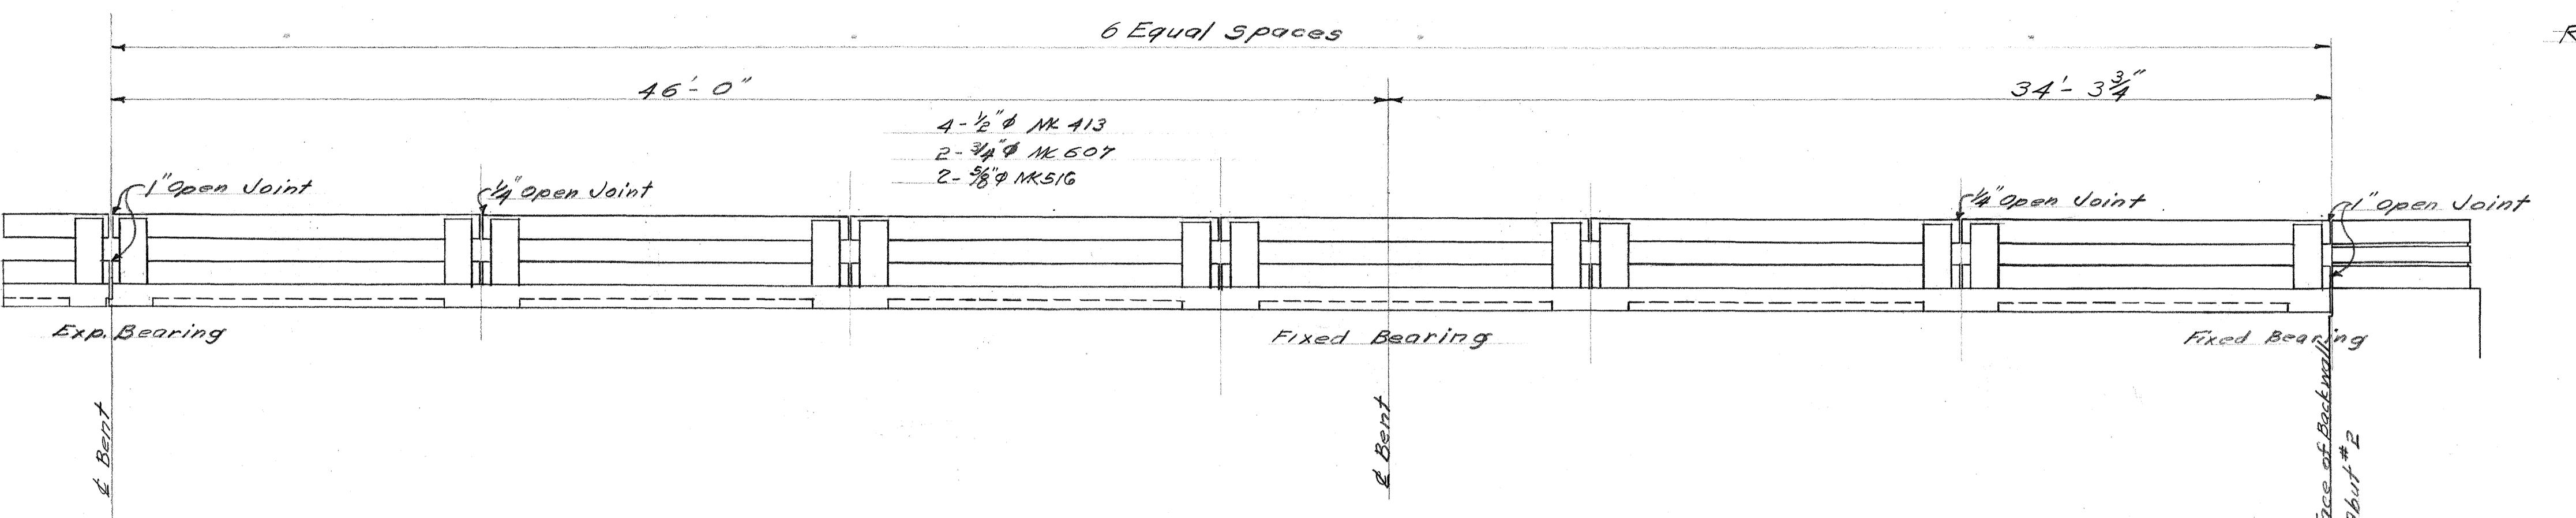

### RAILING LAYOUT (RIGHT)

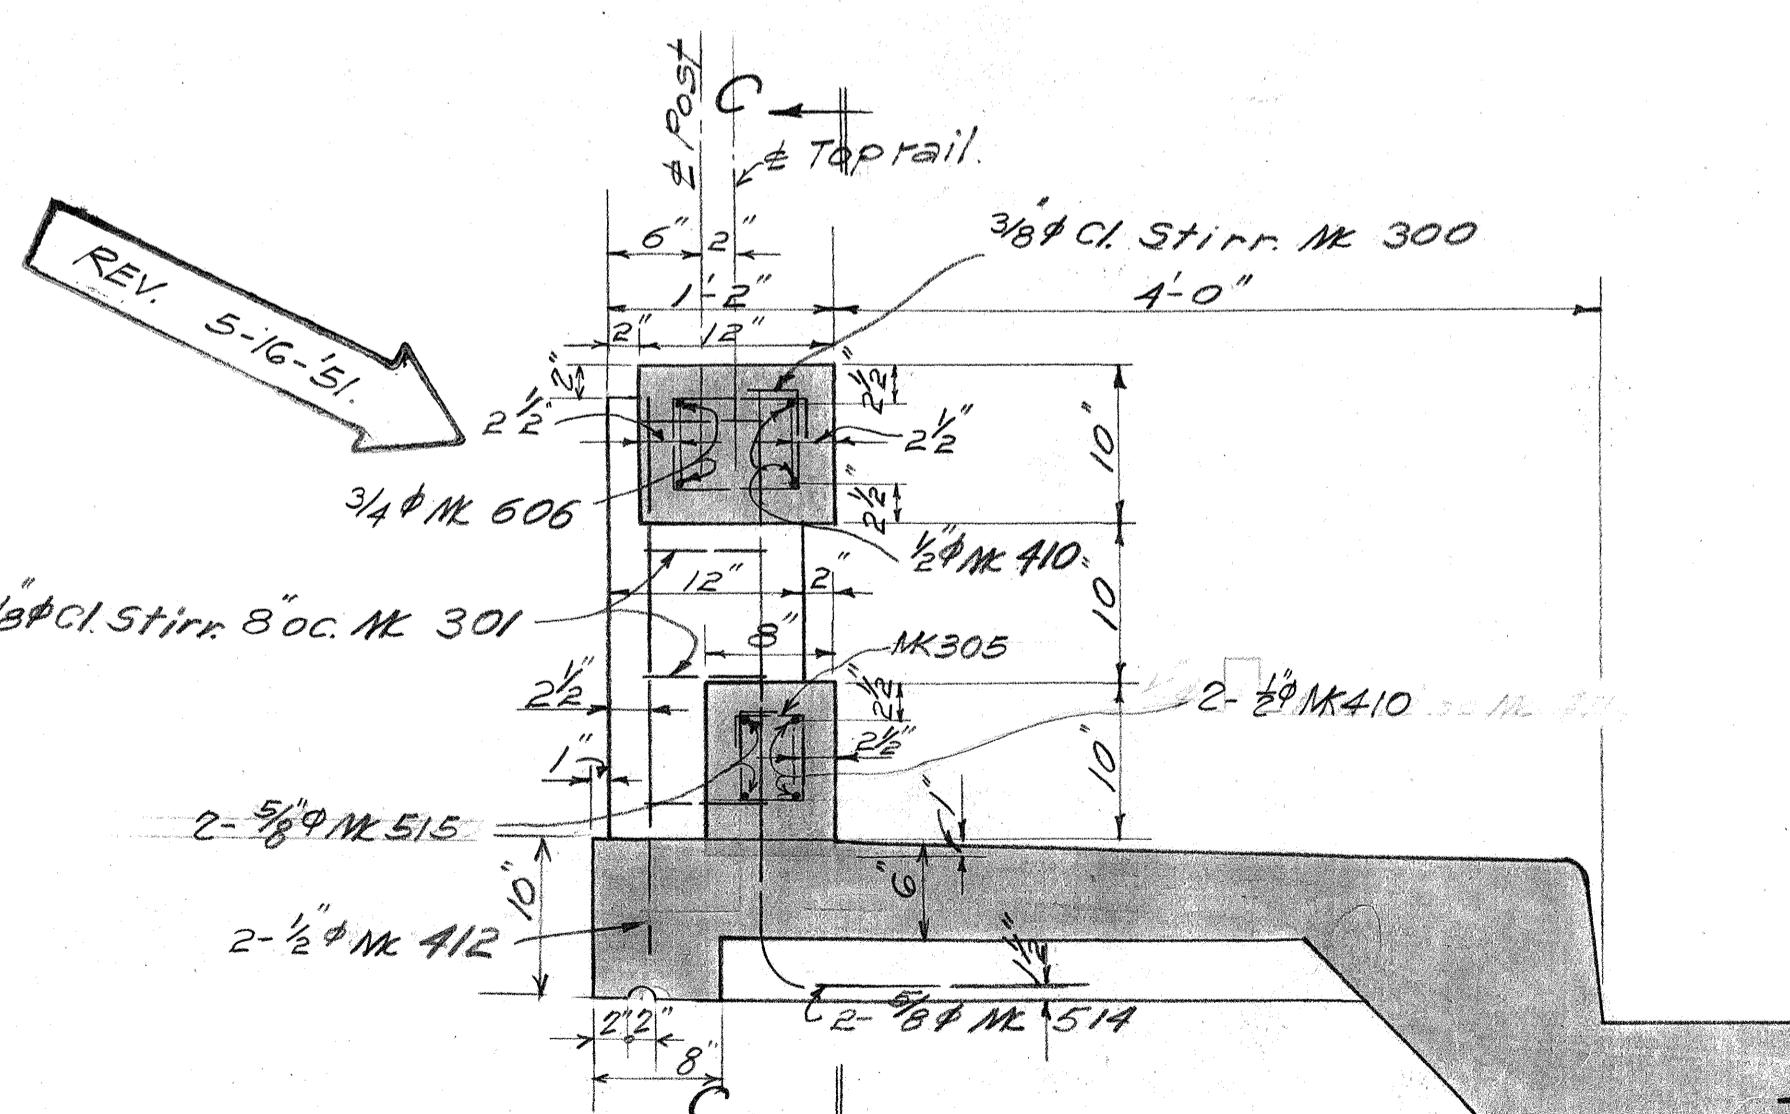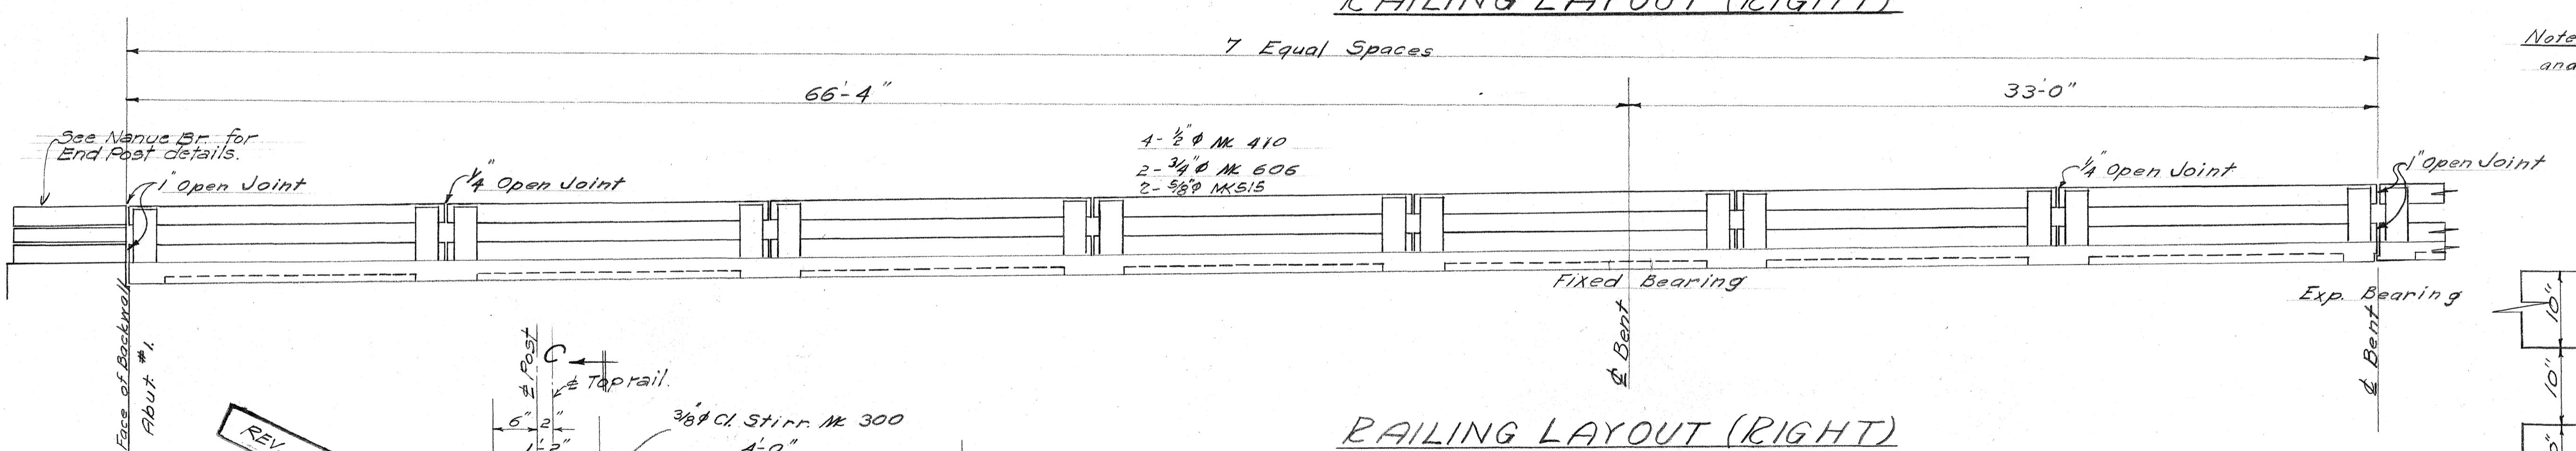

### RAILING LAYOUT (RIGHT) (Left Railing similar)

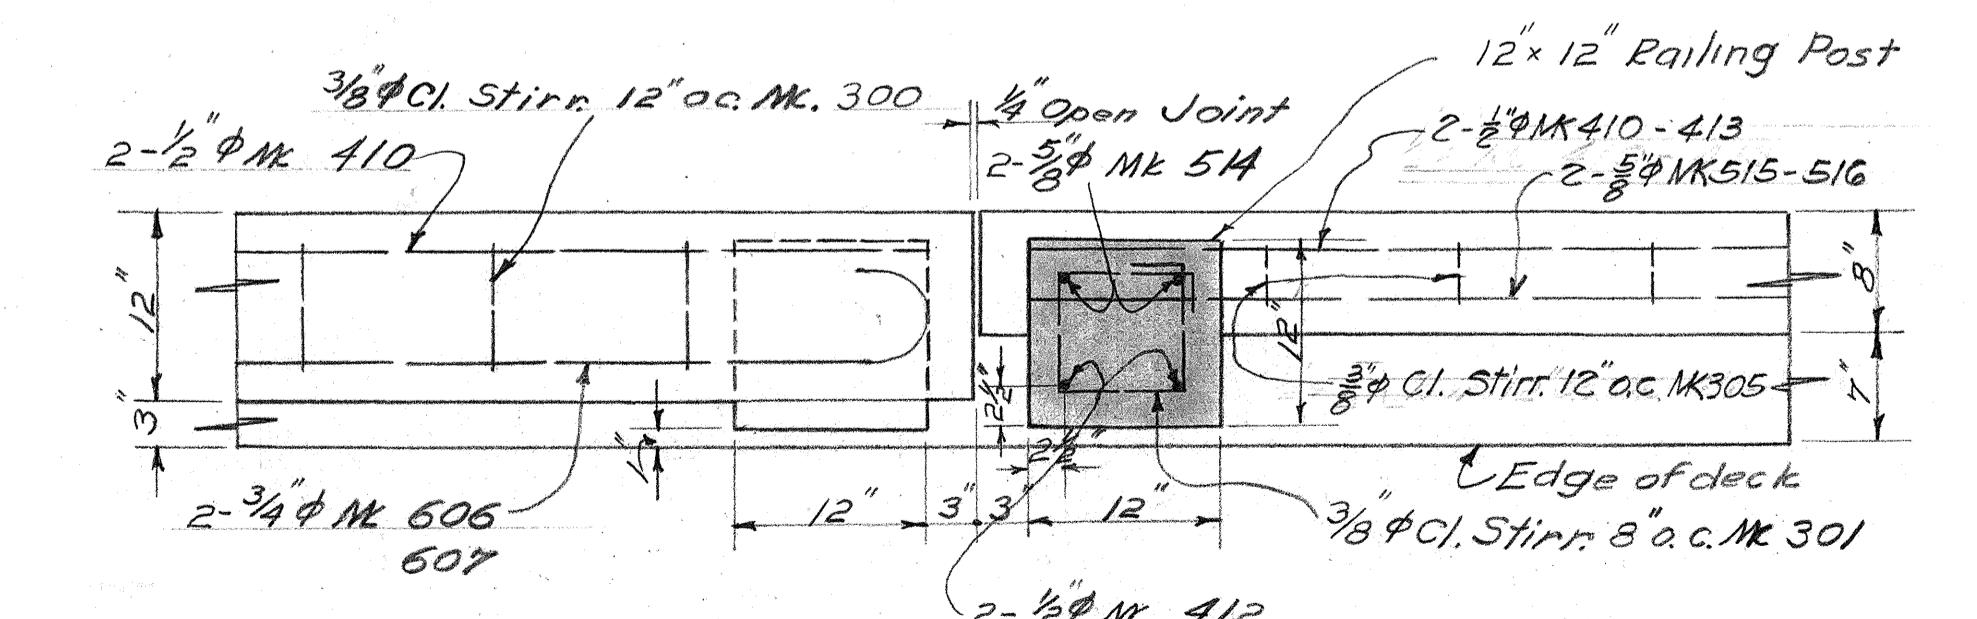

### SECTION B-B

1" = 1 FT

TERRITORIAL HIGHWAY DEPARTMENT  
TERRITORY OF HAWAII

UMAUMA BRIDGE  
Sta 100+45.56 to 103+26.55

Hawaii Belt Road SDR-3(13)

March 1950


SHEET NO. 5 OF 12 SHEETS

5468.147

ROAD NO.	STATE	FED. AID PROJ. NO.	FISCAL YEAR	HEET NO.	TOTAL SHEETS
W311	Haw	SDR3(13)	1950	148	304


## Upstream

(See Downstream Footings)  
for details.

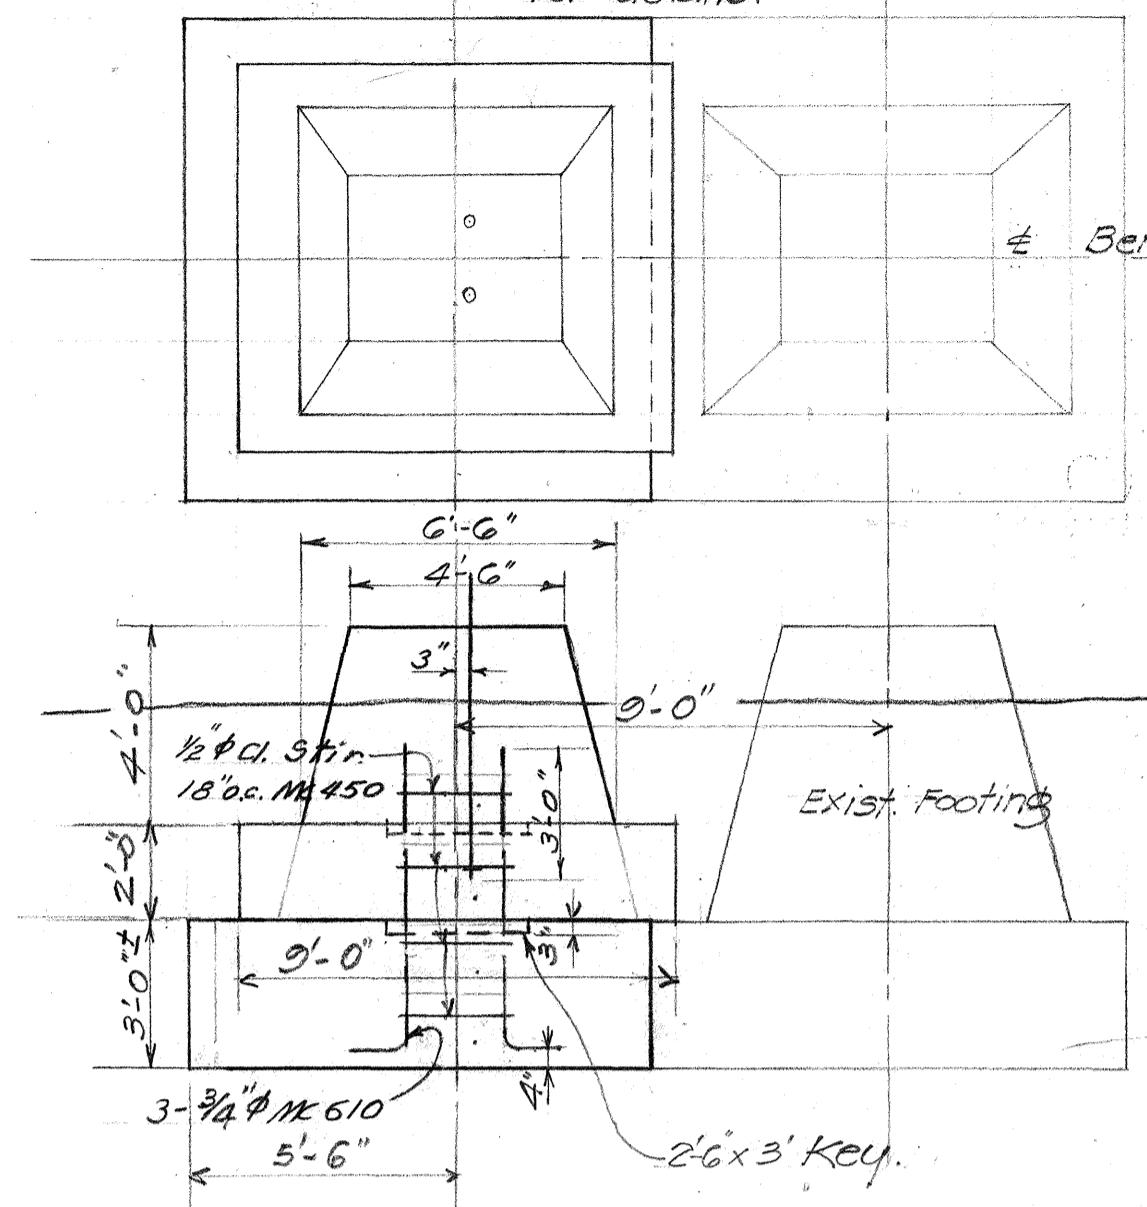


BENT No. 1

$$V_{f_0}'' = f' -$$

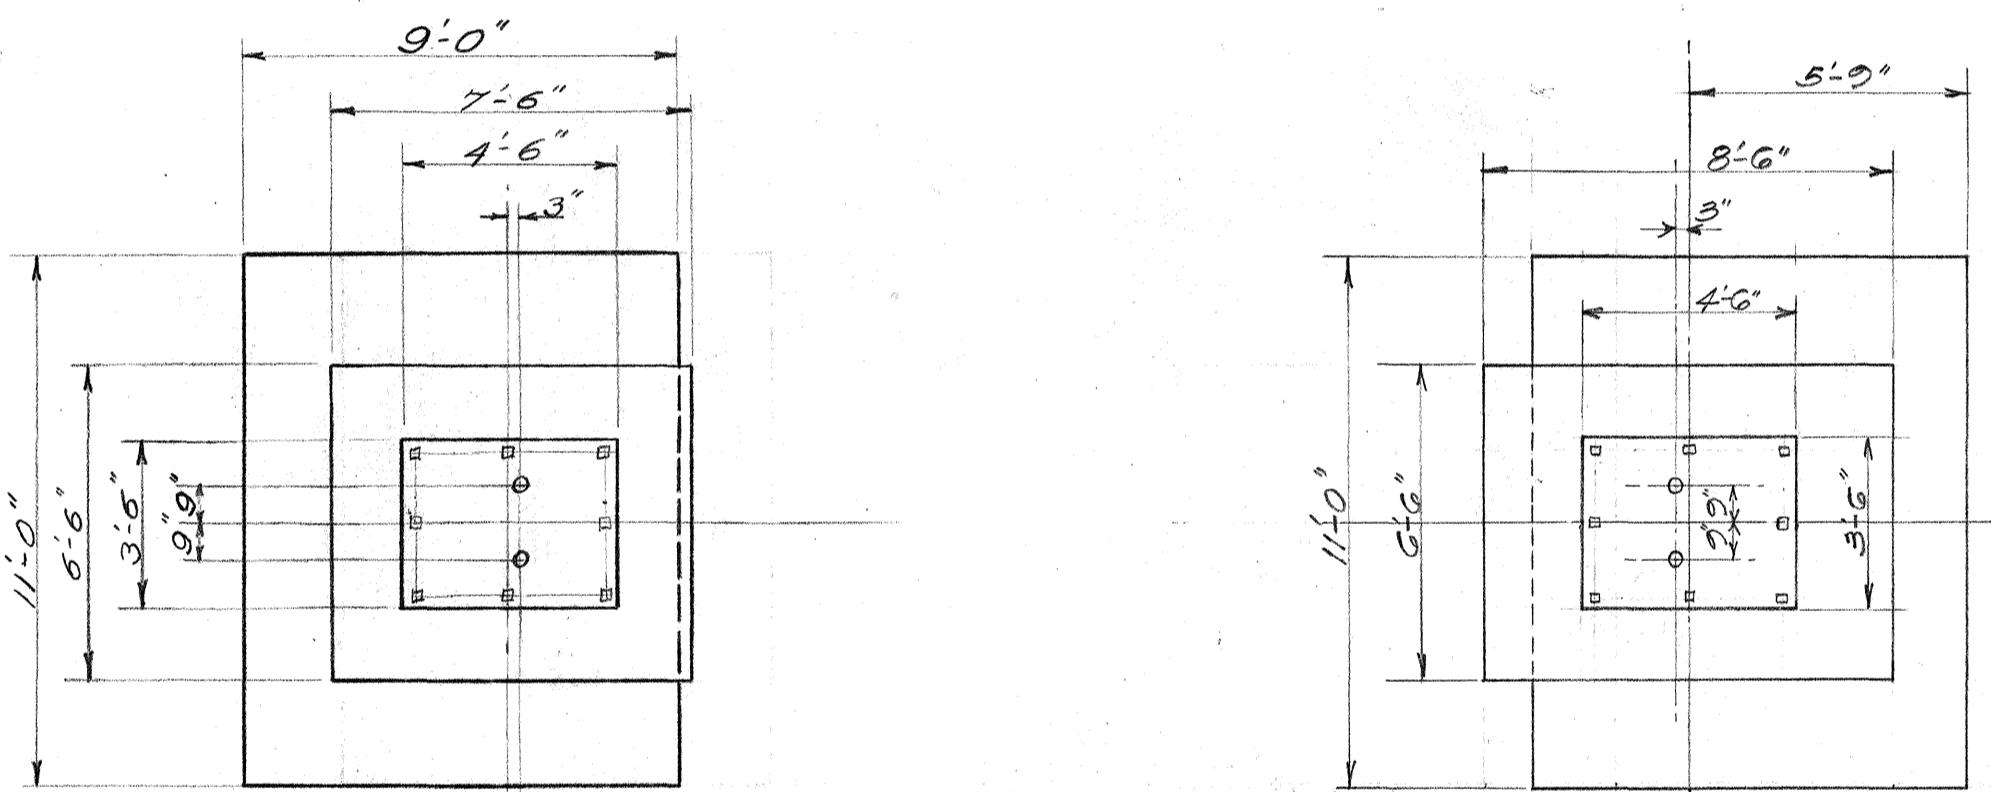

## Downstream

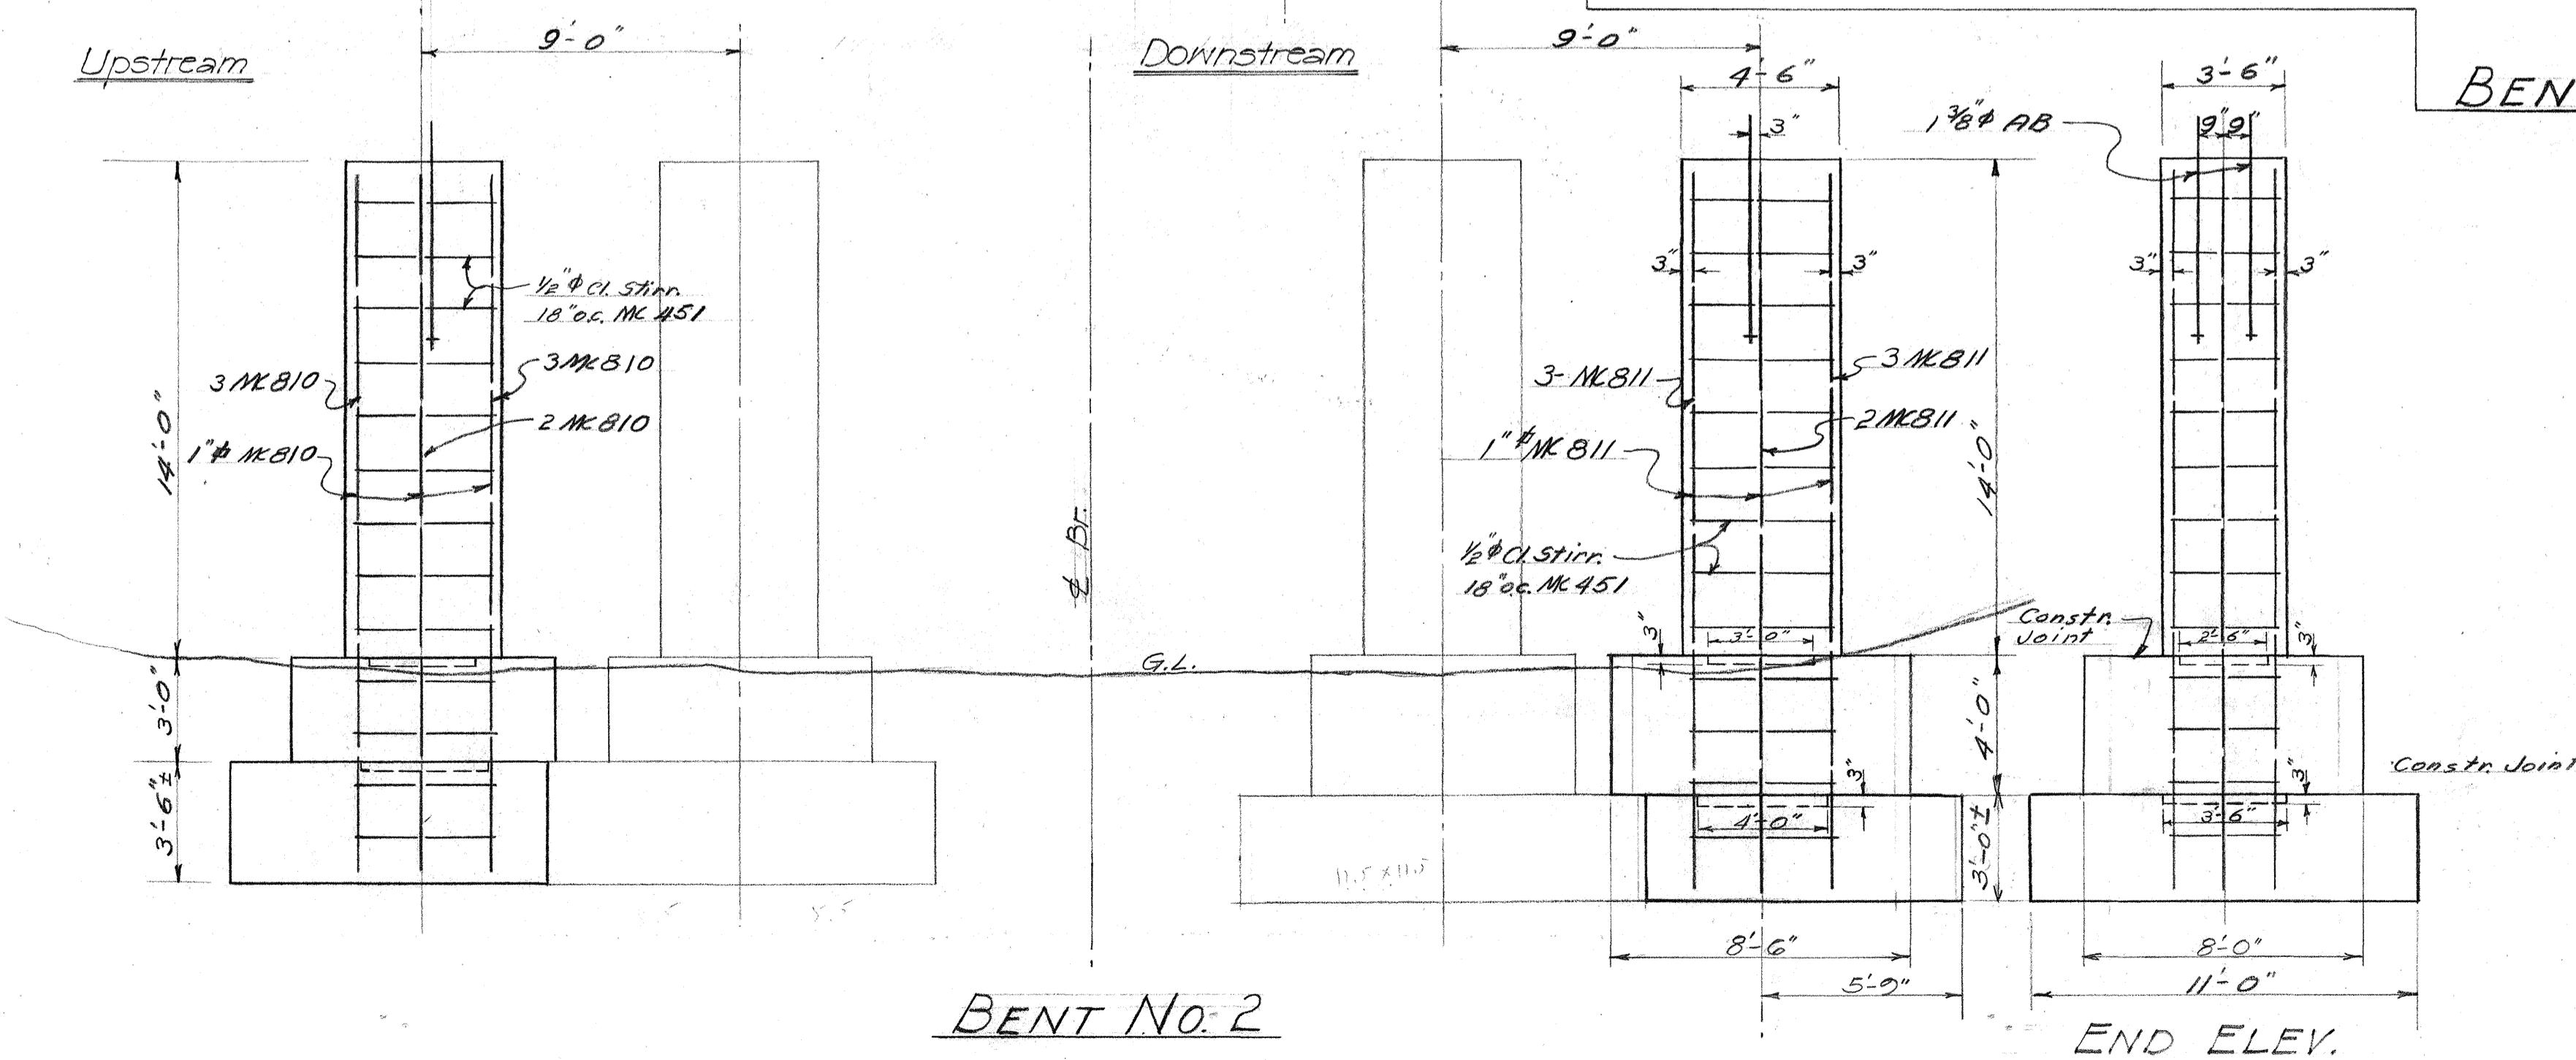


BENT No. 2

Note: All concrete in Piers  
to be class B-2.

3

BENT NO. 4

END ELEV.

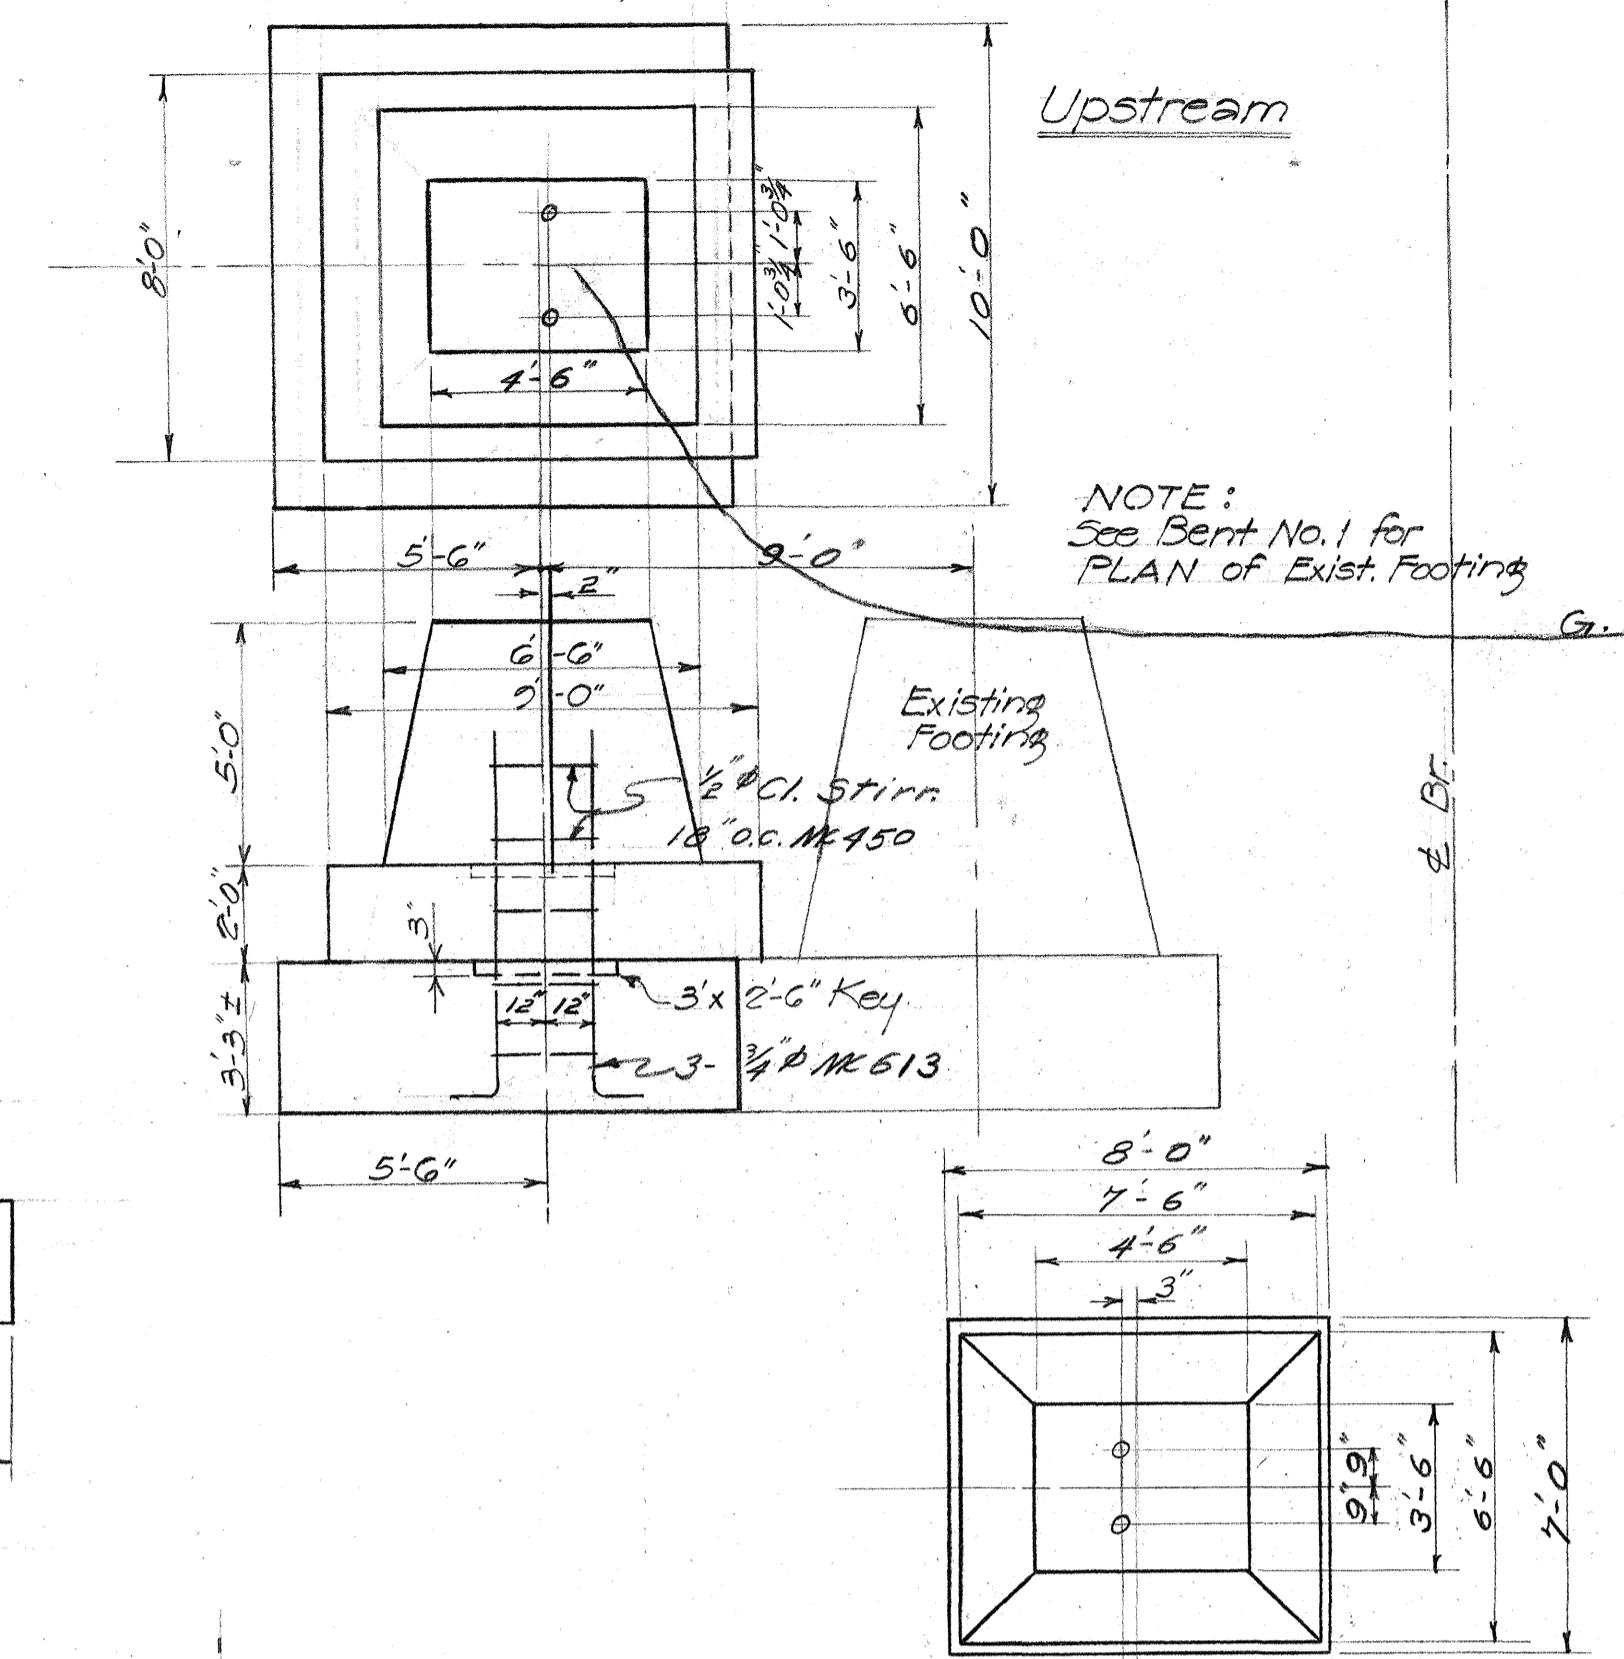

*BENT No. 3*

*END ELEV.*

Digitized by srujanika@gmail.com

ENT No 5

END ELEV.

**TERRITORIAL HIGHWAY DEPARTMENT**

# UMAUMA BRIDGE

5/14 1000+45.50 10 105+20.33

March 1852


SHEET NO. 6 OF 12 SHEETS

168 140

F 63.143


148 15

FED. ROAD  
DIST. NO. STATE FED. AID  
HAWAII HAW SDR-3(13) 1950 140 309

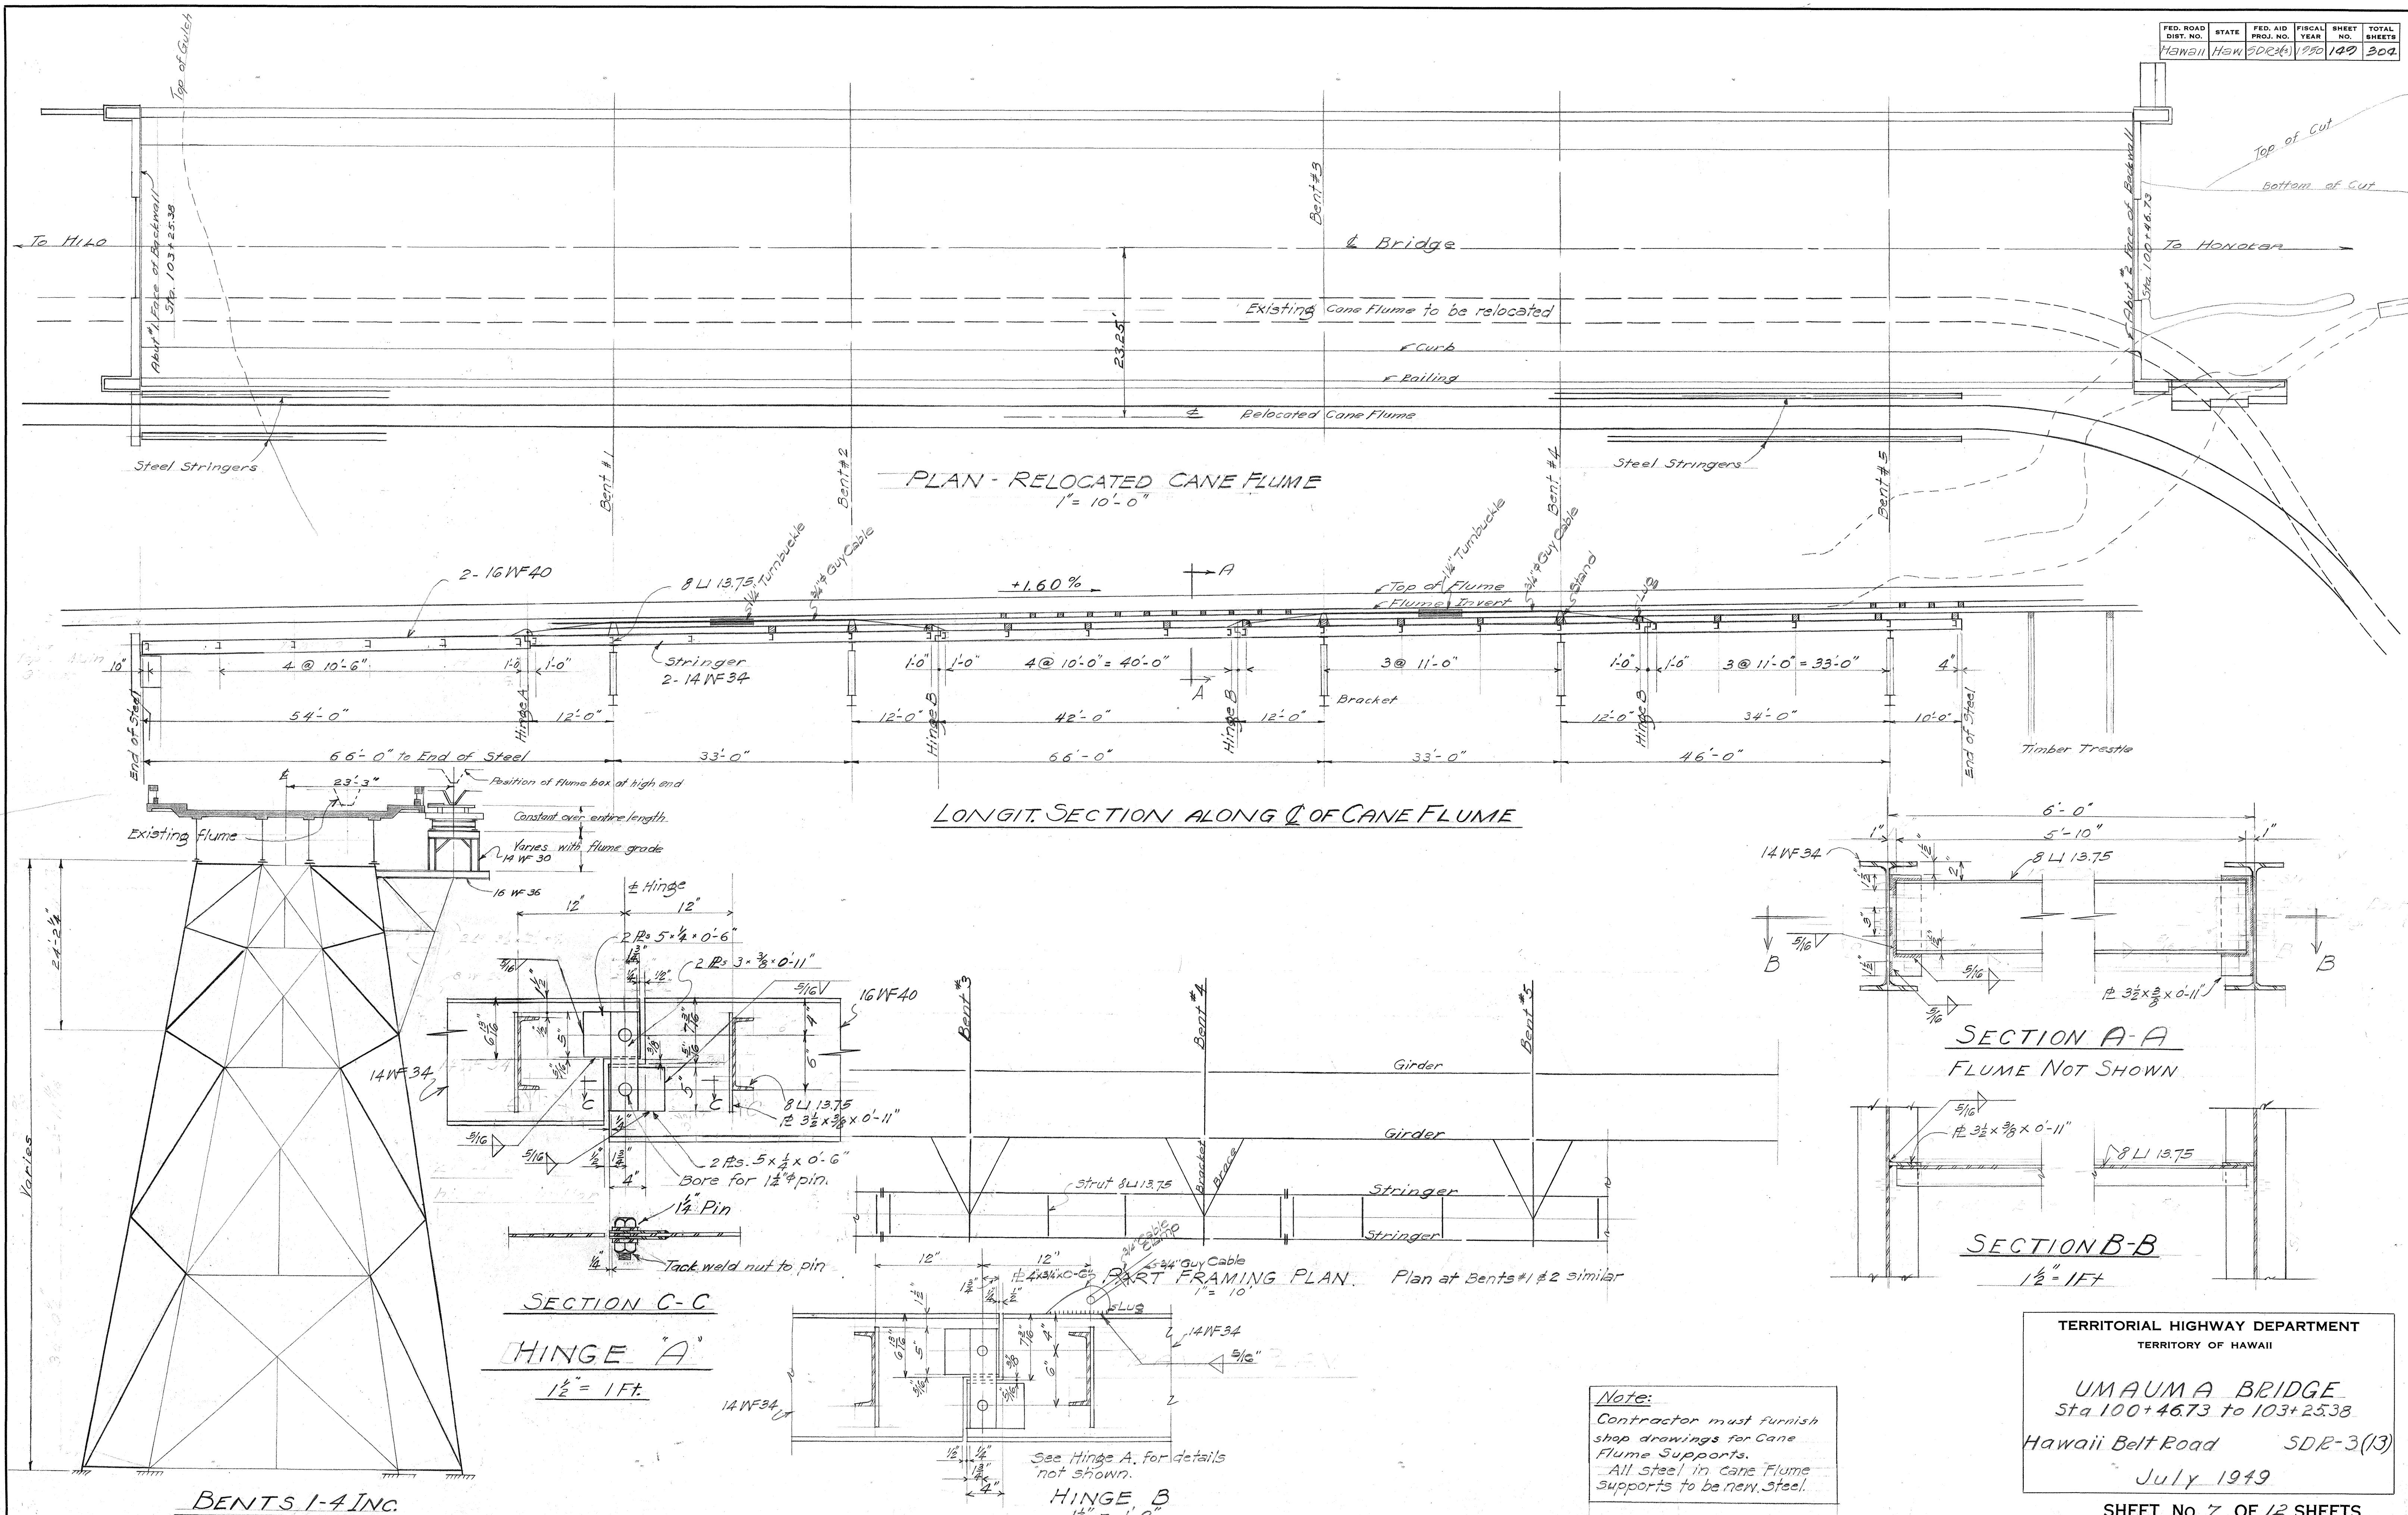

FED. ROAD DIST. NO.	STATE	FED. AID PROJ. NO.	FISCAL YEAR	SHEET NO.	TOTAL SHEETS
Hawaii	Haw	SDR 3(13)	1950	150	300

vision 5-29-51: Sway Brace  
connection to girder and  
bracket, revised.

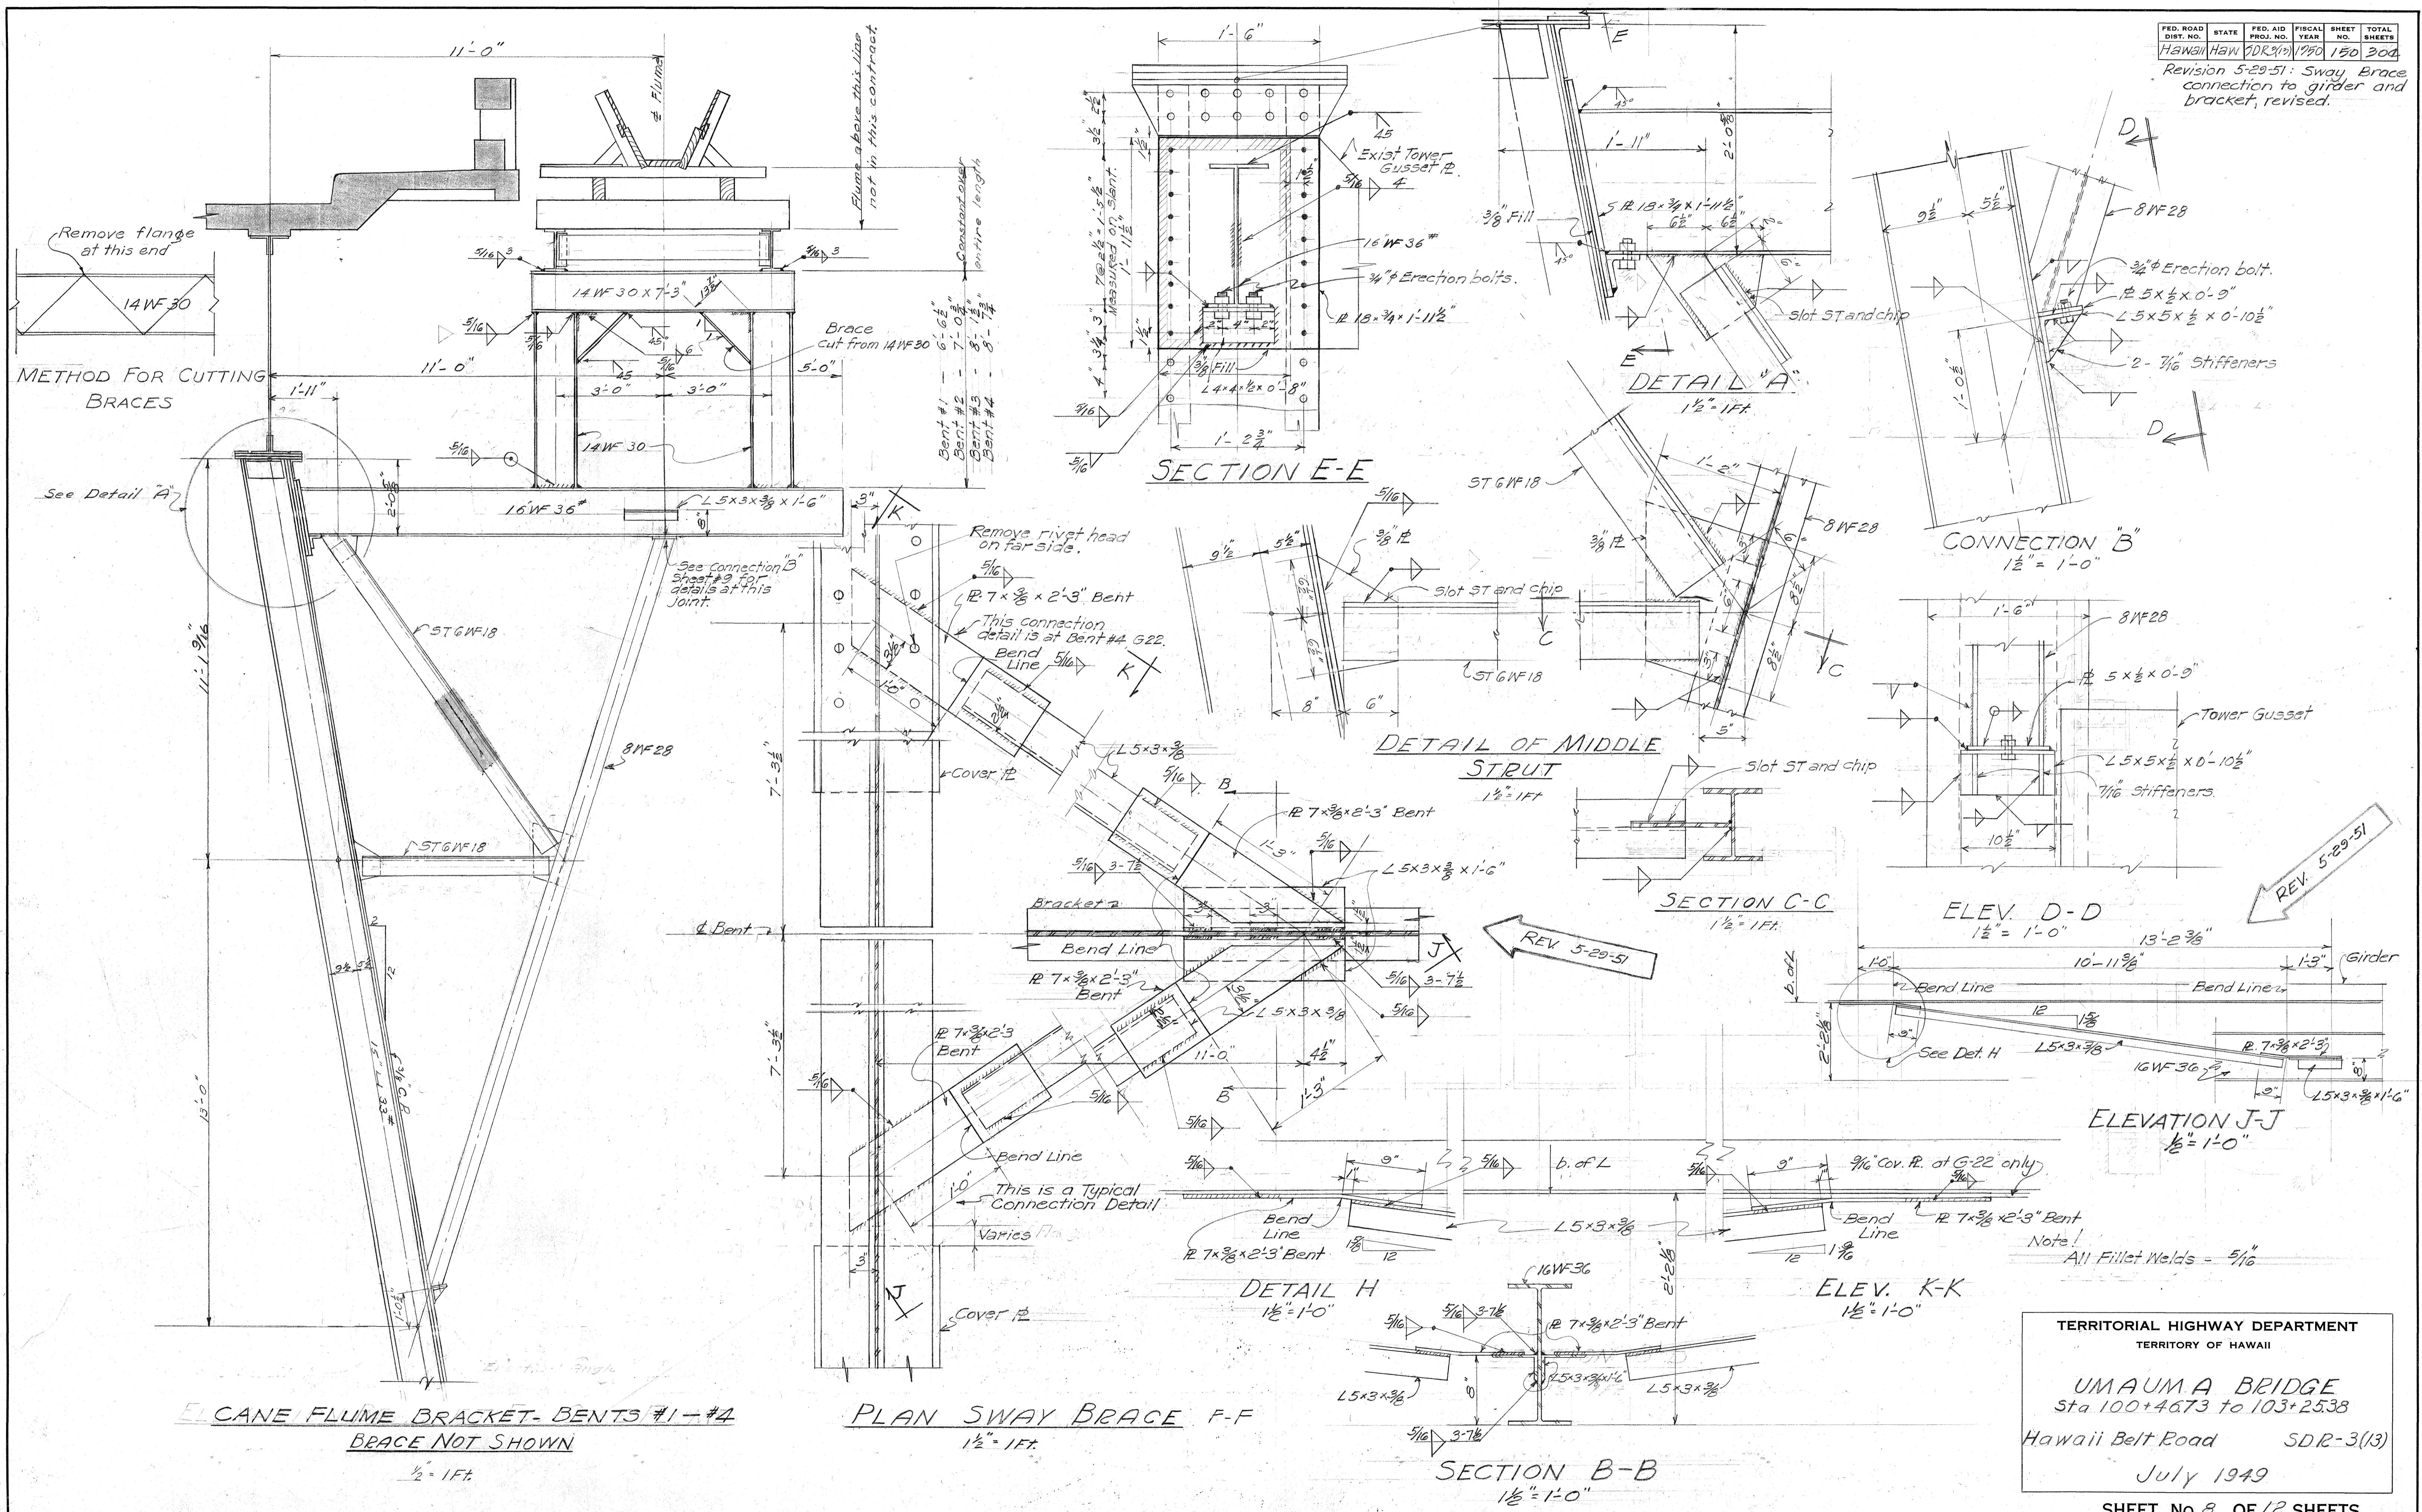

**TERRITORIAL HIGHWAY DEPARTMENT**  
**TERRITORY OF HAWAII**


UMAUMA BRIDGE  
Sta 100+46.73 to 103+25.38

July 1949

SHEET No. 8 OF 12 SHEETS



FED. ROAD DIST. NO.	STATE	FED. AID PROJ. NO.	FISCAL YEAR	SHEET NO.	TOTAL SHEETS
HAWAII	HAW	SDR 3(13)	1950	152	300

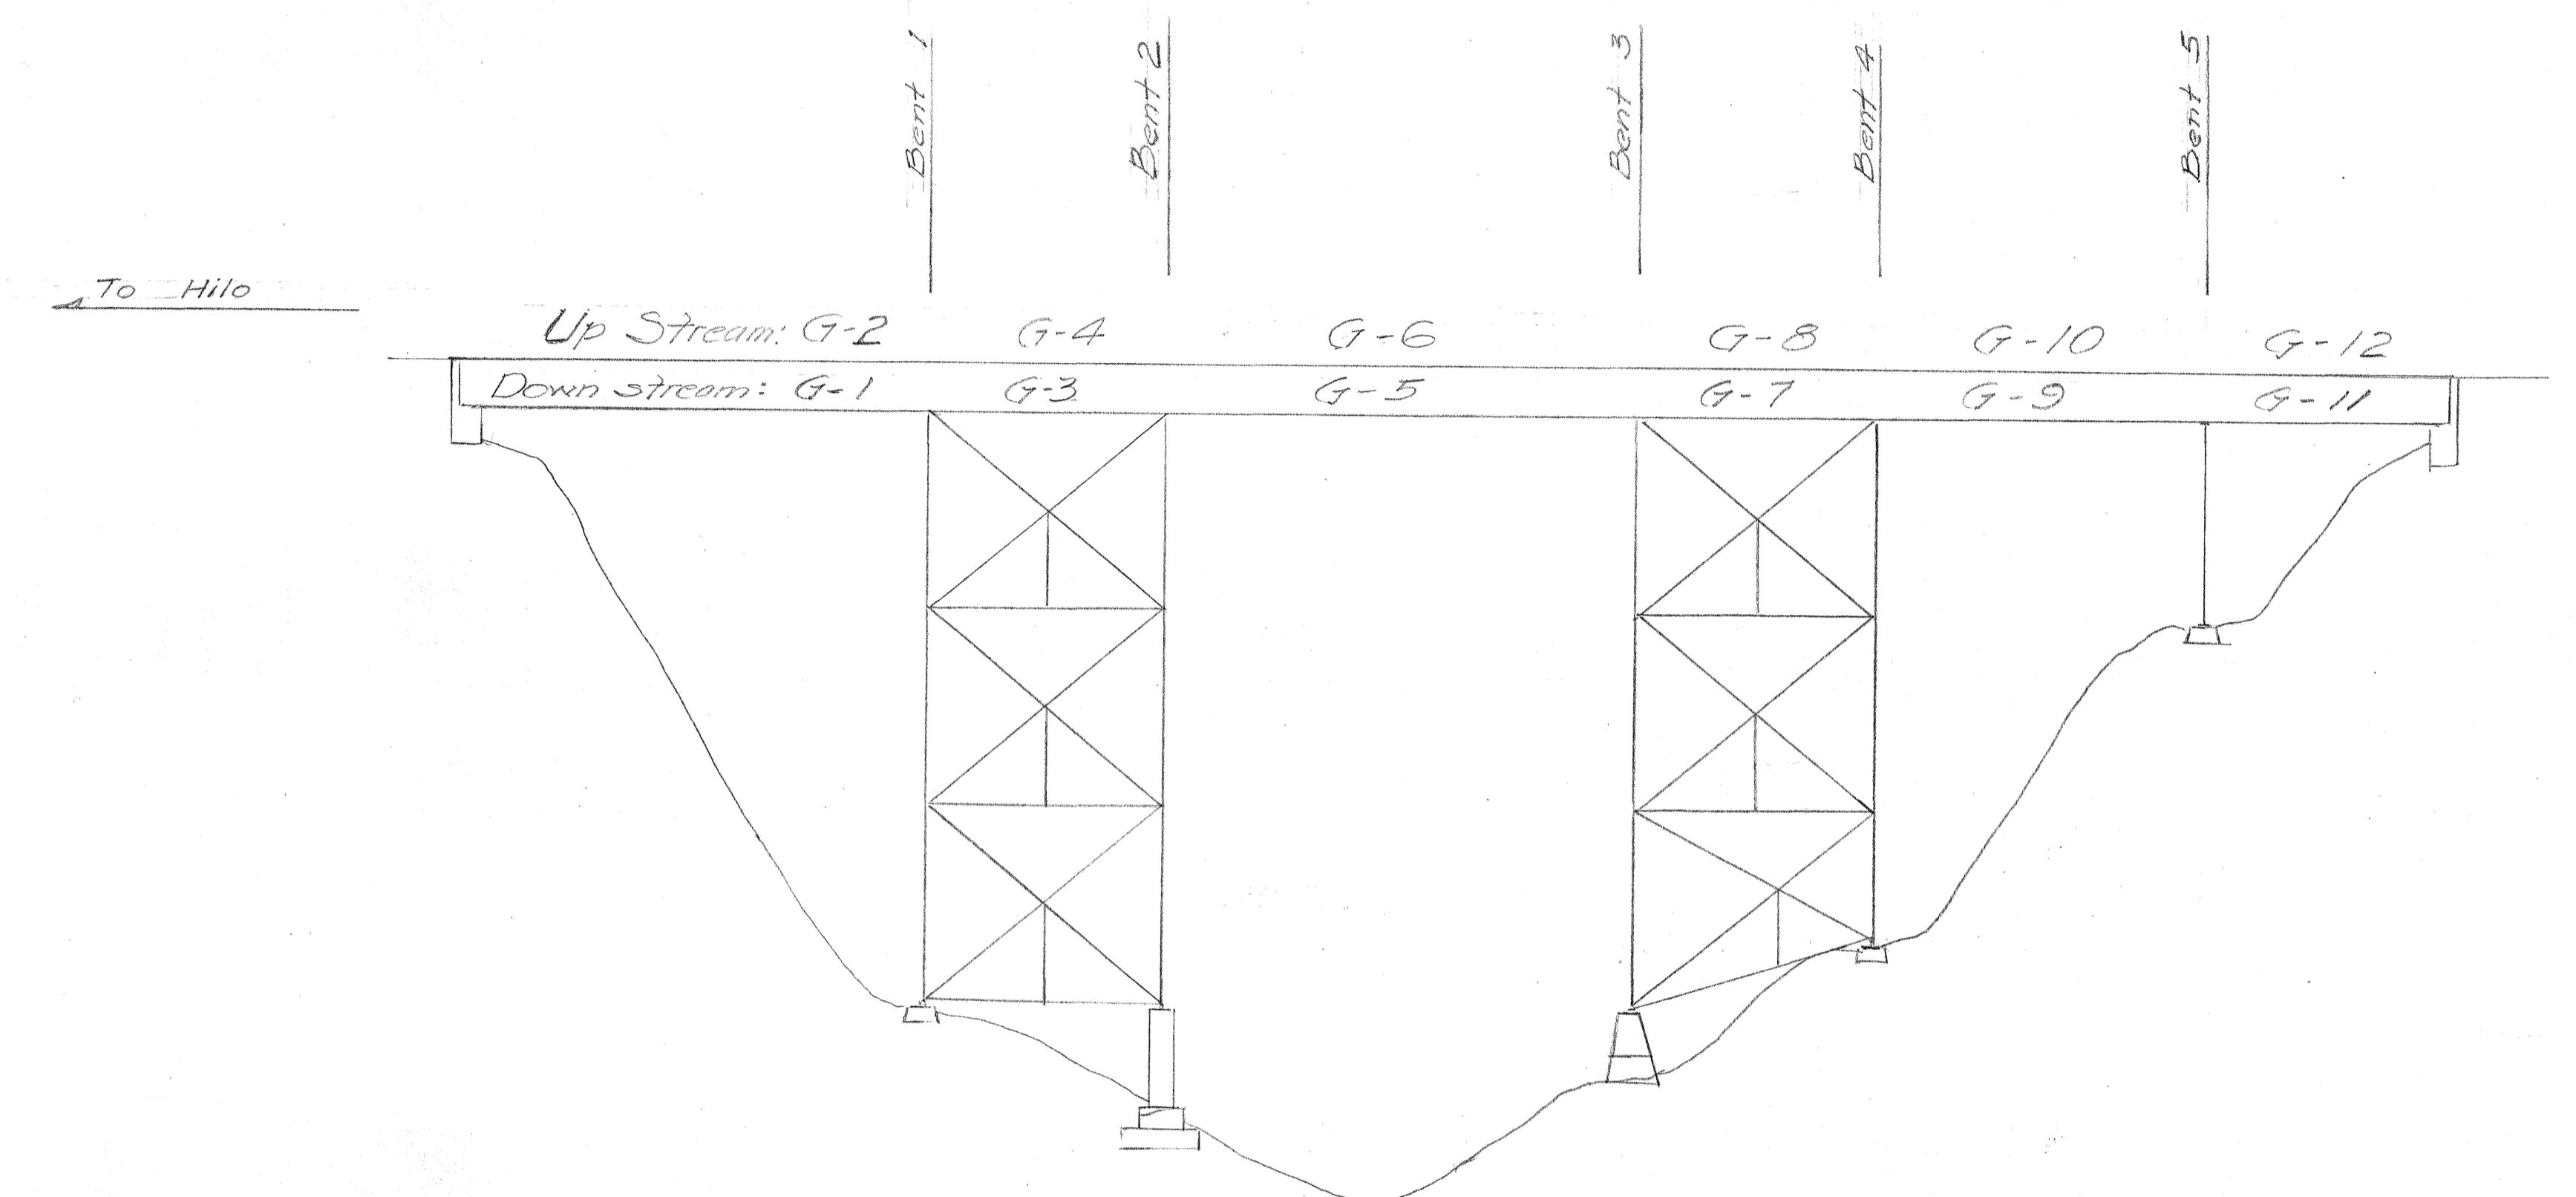

ELEVATION - LOOKING UP STREAM

ORIGINAL	SURVEY PLOTTED BY
PLAN	DESIGNED BY
NOTE BOOK	DRAWN BY
No.	TRACED BY
	QUANTITIES BY
	CHECKED BY
	RECORDED BY
	12/25/52

TERRITORIAL HIGHWAY DEPARTMENT  
TERRITORY OF HAWAII

UMAUMA BRIDGE

Sta 100+45.56 to 103+26.55

HAWAII BELT ROAD SDR 3(13)

May 1950

Condition survey of Bridge


SHEET NO. 10 OF 12 SHEETS

5 4 6 8 . 1 5 3

Bents: Looking Honokaa  
Tower Bracings: Looking Up stream

To Honokaa →

→ TO HILO

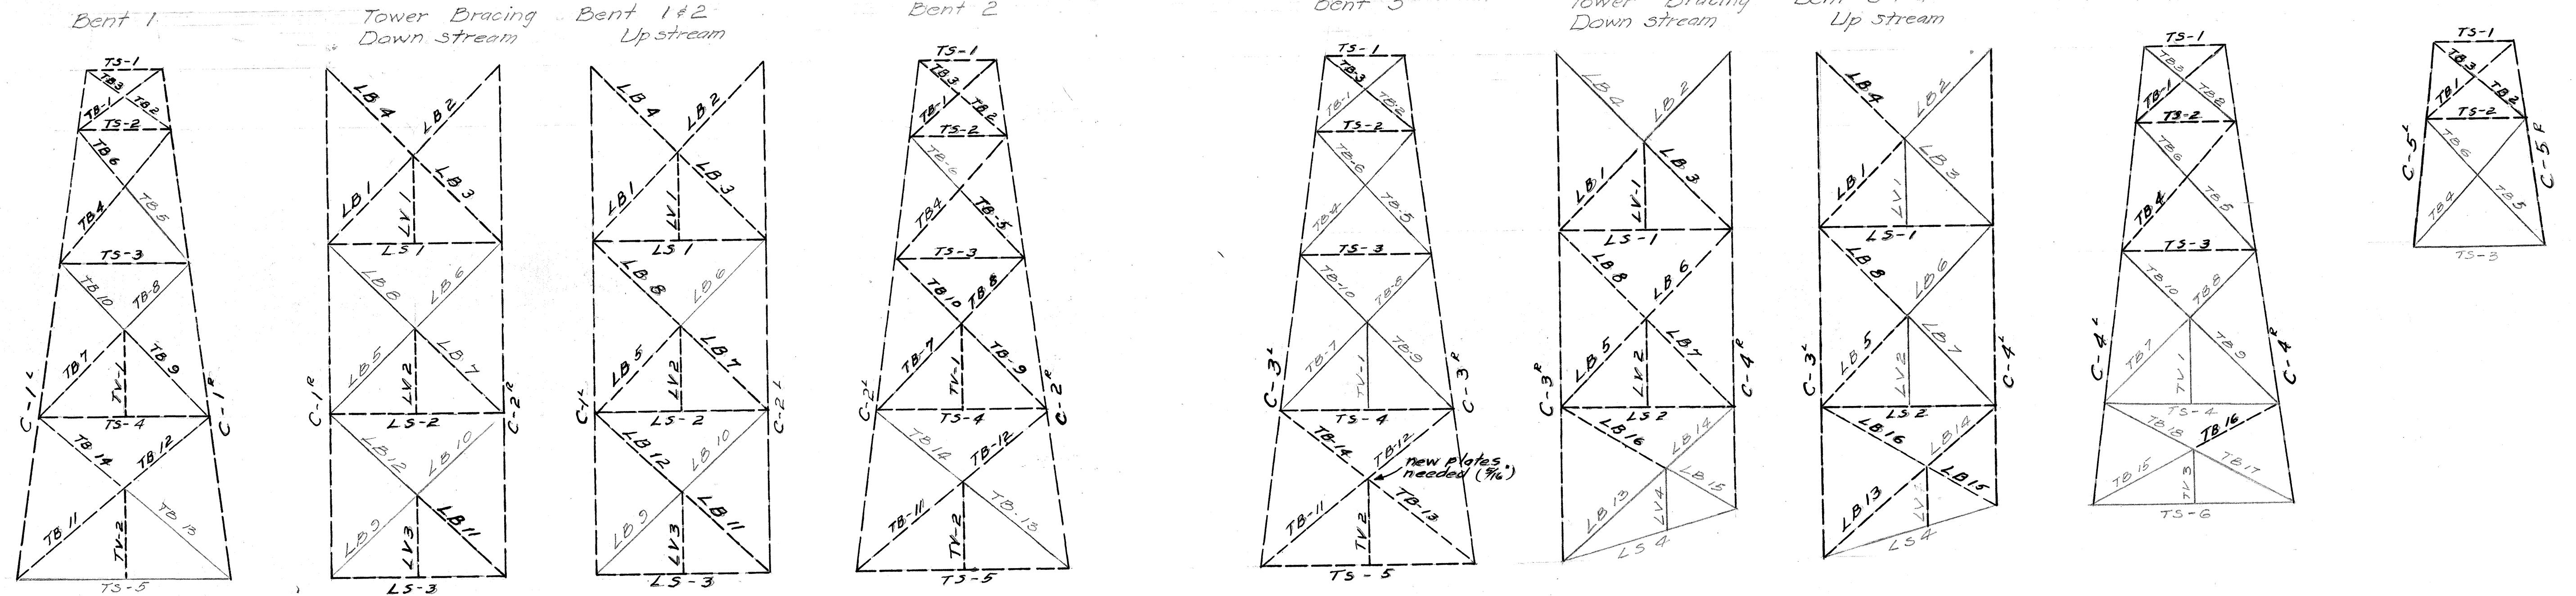

#### LIST OF CONDEMNED MEMBERS & PARTS:

##### Bent 1

Down stream		Up stream	
TS-1	7 rivets 3/4" - 1" grip	LB-1	2 rivets 3/4" - 3/4" grip
TS-2	" "	LB-2	20 "
TS-3	5 lattice bars	LB-3	10 "
TS-4	{ 2 " 10 rivets 3/4" - 1" grip	LB-4	2 "
TB-1	8 " 3/4" - 1/2" grip	LB-5	5 "
TB-2	8 " "	LB-6	2 "
TB-3	10 "	LB-7	4 "
TB-4	5 "	LB-8	8 "
TB-5	Member Slightly bent	LB-9	10 "
LB-11	5 "	LB-10	10 "
LS-1	15 " 3/4" - 1" grip	LB-11	5 "
LS-2	20 " "	LB-12	6 "
LS-3	20 " "	LB-13	10 "
LV-1	8 " 3/4" - 1/2" grip	LB-14	13 "
LV-2	6 " "	LB-15	18 "
LV-3	5 " "	LB-16	10 "
TB-11	Member Slightly bent	LB-17	12 "
TB-12	3 rivets 3/4" - 3/4" grip	LB-18	12 "
TB-14	3 " "	LB-19	16 "
TV-1	3 "	LB-20	16 "
TV-2	2 "	LB-21	6 "
C1L	{ 23 " 3/4" - 1/2" grip	LB-22	6 "
CIR	30 " 3/4" - 1" grip	LB-23	10 "
	CIR 14 " 3/4" - 1/2" grip	LB-24	10 "

##### Bent 2

Down stream		Up stream	
TS-1	7 rivets 3/4" dia 1" grip	TS-1	20 rivets 3/4" dia 1" grip
TS-2	" "	TS-2	10 "
TS-3	5 lattice bars	TS-3	14 "
TS-4	1 "	TS-4	Corroded at connections & needs new plates
LB-4	2 "	TS-5	{ 80 " 16 rivets 3/4" - 1" grip
LB-5	5 "	TS-5	12 lattice bars
LB-6	6 "	LB-1	10 " 3/4" dia 1" grip
LB-7	6 "	LB-2	10 rivets 3/4" - 1/2" grip
LB-8	4 "	LB-3	10 "
LB-9	4 "	LB-4	5 "
LB-10	8 "	LB-5	6 "
LB-11	10 "	LB-6	6 "
LB-12	6 "	LB-7	6 "
LB-13	6 "	LB-8	10 "
LB-14	17 "	LB-9	10 "
LB-15	13 "	LB-10	10 "
LB-16	10 "	LB-11	6 "
LB-17	10 "	LB-12	10 "
LB-18	10 "	LB-13	17 "
LB-19	10 "	LB-14	13 "
LB-20	10 "	LB-15	18 "
LB-21	10 "	LB-16	10 "
LB-22	10 "	LB-17	12 "
LB-23	10 "	LB-18	12 "
LB-24	10 "	LB-19	16 "

##### Bent 3

Down stream		Up stream	
TS-1	20 rivets 3/4" dia 1" grip	TS-1	15 rivets 3/4" dia 1/2" grip
TS-2	10 "	TS-2	15 "
TS-3	14 "	TS-3	15 "
TS-4	Corroded at connections & needs new plates	TS-4	1 "
LB-1	16 rivets 3/4" - 1" grip	LB-1	10 rivets 3/4" dia 1/2" grip
LB-2	10 "	LB-2	10 "
LB-3	5 "	LB-3	5 "
LB-4	6 "	LB-4	6 "
LB-5	6 "	LB-5	6 "
LB-6	6 "	LB-6	6 "
LB-7	6 "	LB-7	6 "
LB-8	15 "	LB-8	15 "
LB-9	15 "	LB-9	15 "
LB-10	25 "	LB-10	20 "
LB-11	10 "	LB-11	10 "
LB-12	10 "	LB-12	10 "
LB-13	20 "	LB-13	20 "
LB-14	20 "	LB-14	20 "
LB-15	6 "	LB-15	6 "
LB-16	20 "	LB-16	20 "
LB-17	10 "	LB-17	10 "
LB-18	10 "	LB-18	10 "
LB-19	10 "	LB-19	10 "
LB-115	10 "	LB-115	10 "
LB-116	10 "	LB-116</	

PLAN - BOTTOM FLANGE

TO HILO



SUMMARY OF RIVETS TO BE REPLACED

Dia.	Length	Grip	No.	Say:
7/8"	2 5/8"	1 1/8"	150	200
7/8"	3 1/4"	1 5/8"	155	200
7/8"	3 7/8"	2 1/8"	36	50
7/8"	4 "	2 1/4"	17	30
7/8"	5 1/8"	3 1/4"	27	40

Use Last Col. (say)  
for estimating in  
contract

All Rivets and Bolts at base plates of girders  
at Column connections on entire structure  
must be replaced. (these are not shown)

Approximate no. of rivets for Col. to  
Girder Connection

Dia.	Length	Grip	No.
7/8	3	1 1/8	80

The top flanges rivets are not readily accessible  
to inspection but they are assumed to be entirely bad  
and should be figured on being replaced.  
approximate quantities are:

Dia.	Length	Grip	No.
7/8"	2 5/8"	1 1/8"	600
7/8"	3 1/4"	1 5/8"	550
7/8"	3 7/8"	2 1/8"	100
7/8"	4 "	2 1/4"	180
7/8"	5 1/8"	3 1/4"	112

-Legend-

- (dot) indicates rivet
- (circled dots) indicates condemned rivet

Girders not shown have no  
cover plates - no rivets -

Condition survey of Bridge

TERRITORIAL HIGHWAY DEPARTMENT  
TERRITORY OF HAWAII

UMAUMA BRIDGE

Sta 100+45.56 to 103+26.55


HAWAII BELT ROAD SDR 3(13)

MAY 1950


SHEET NO. 12 OF 12 SHEETS

5 4 6 8 . 1 5 4



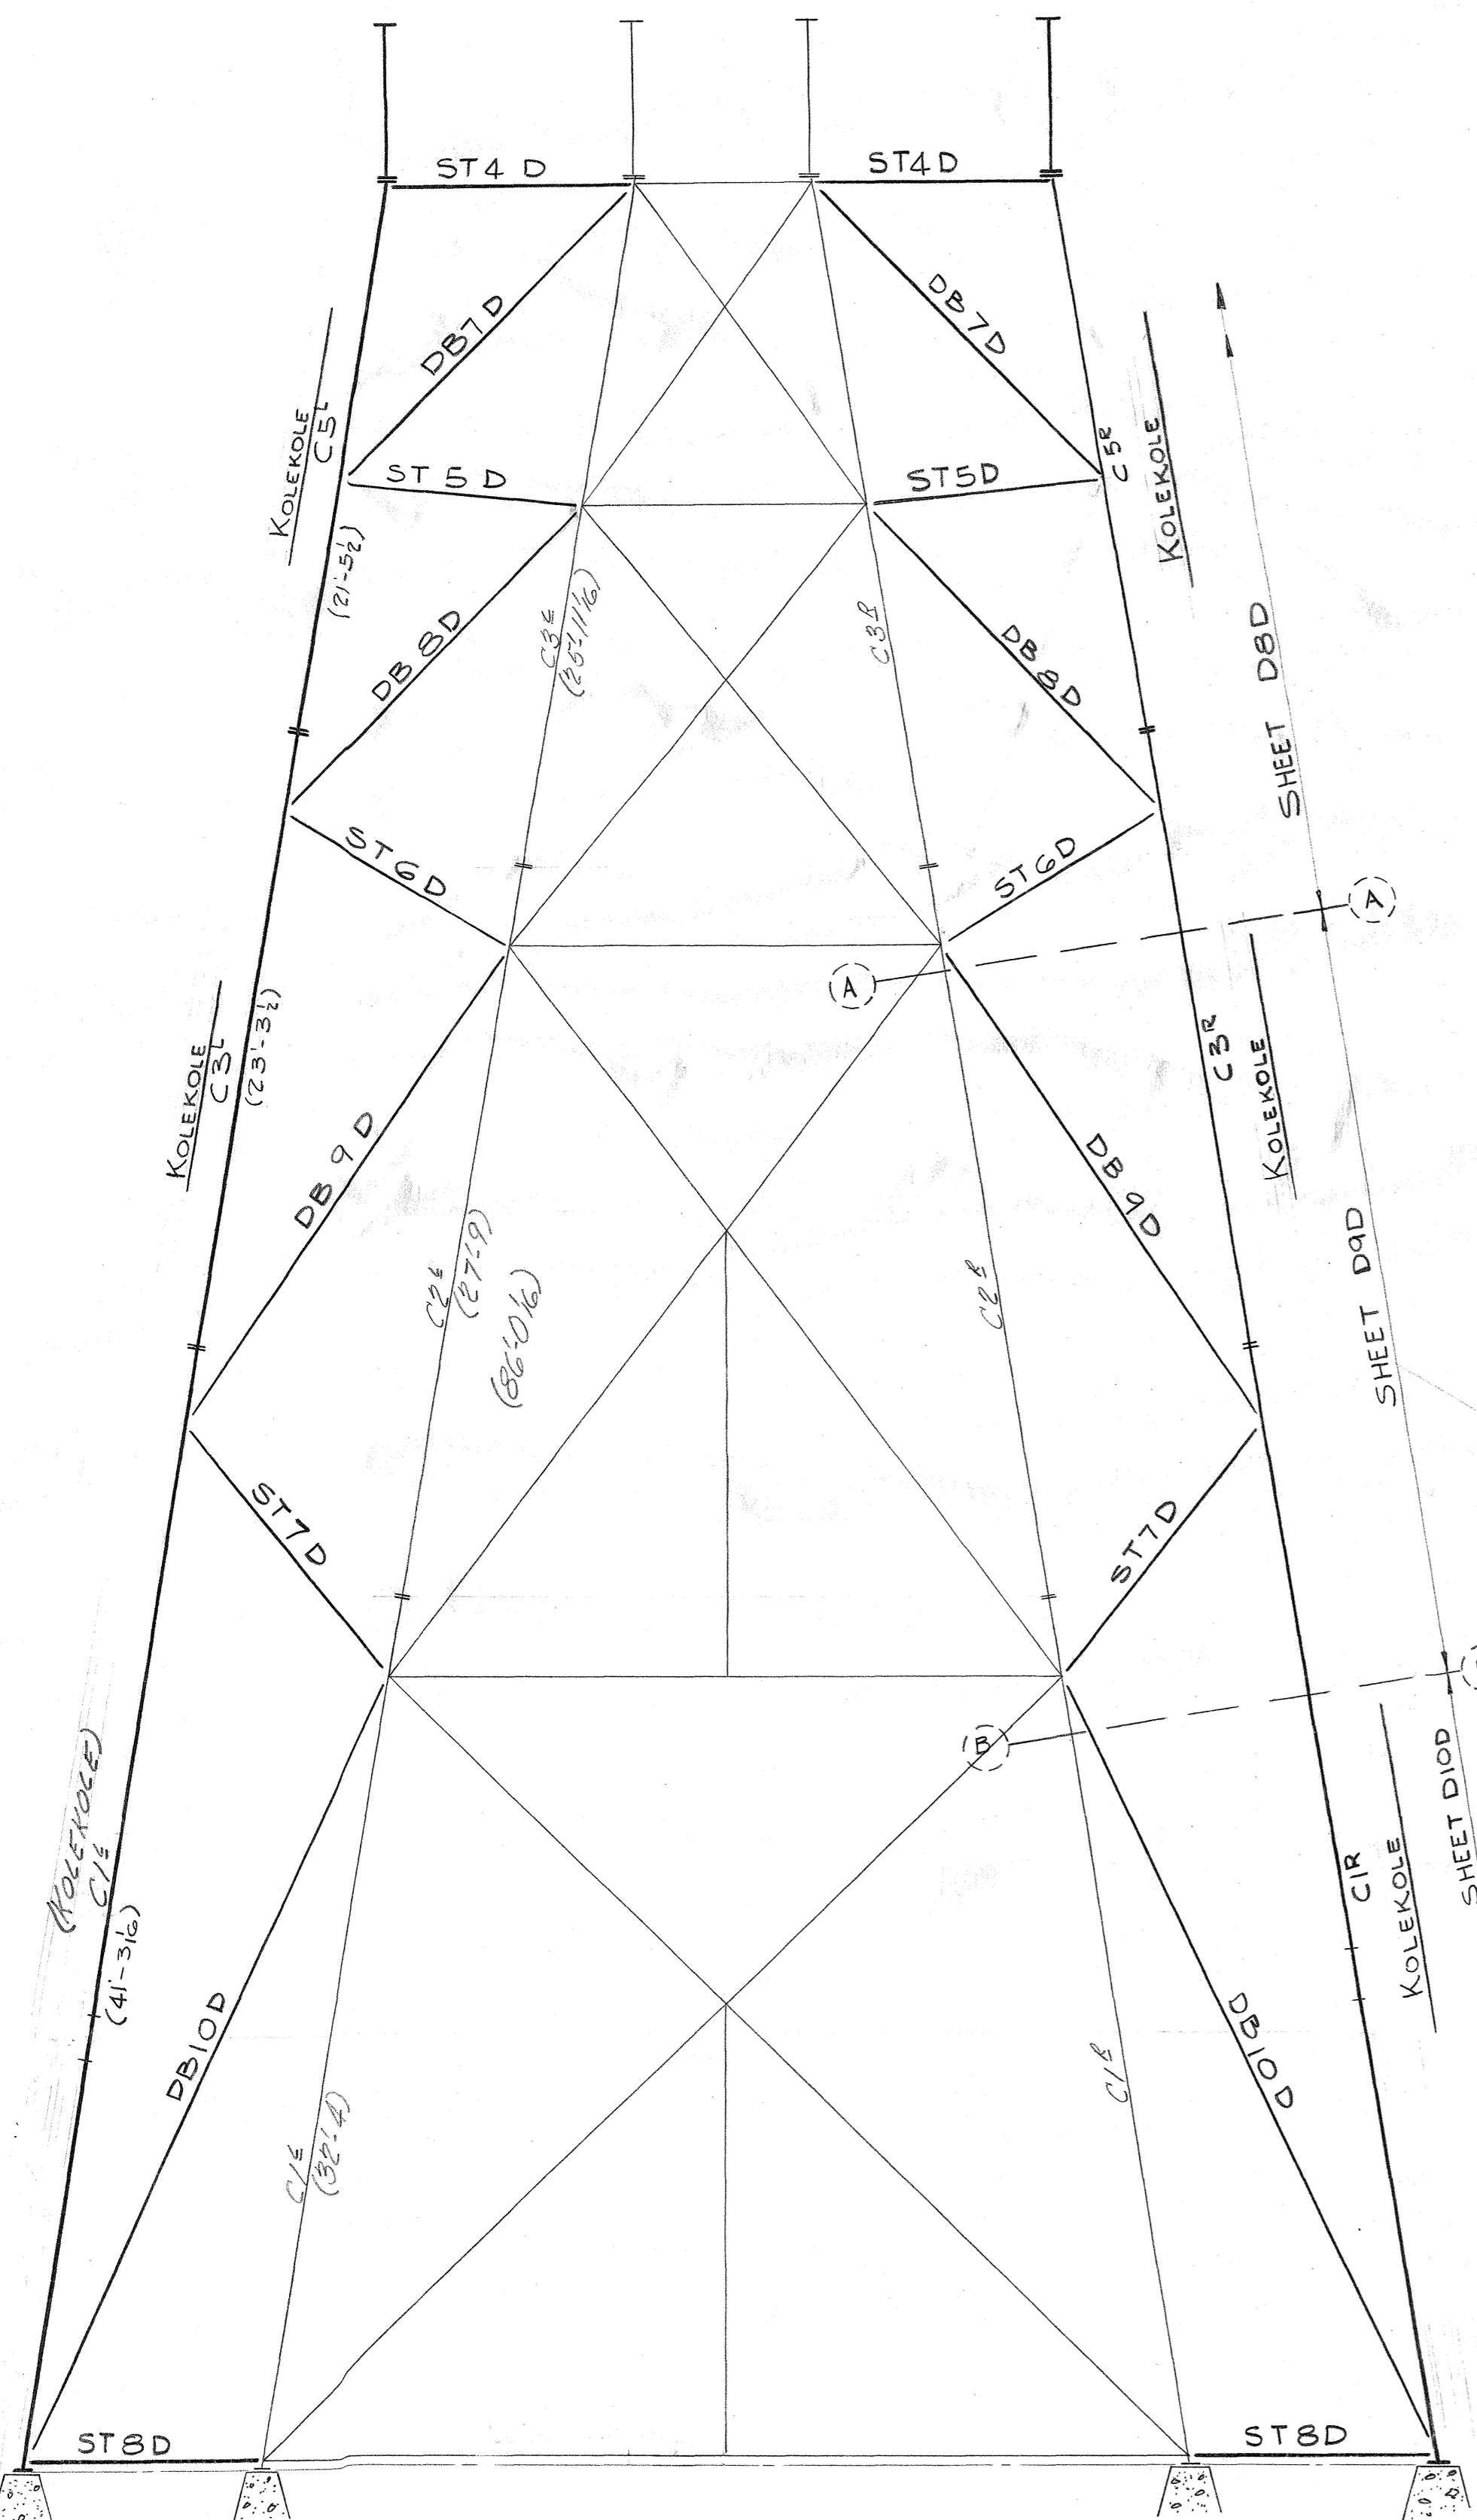

BENT #1  
(LOOKING NORTH)

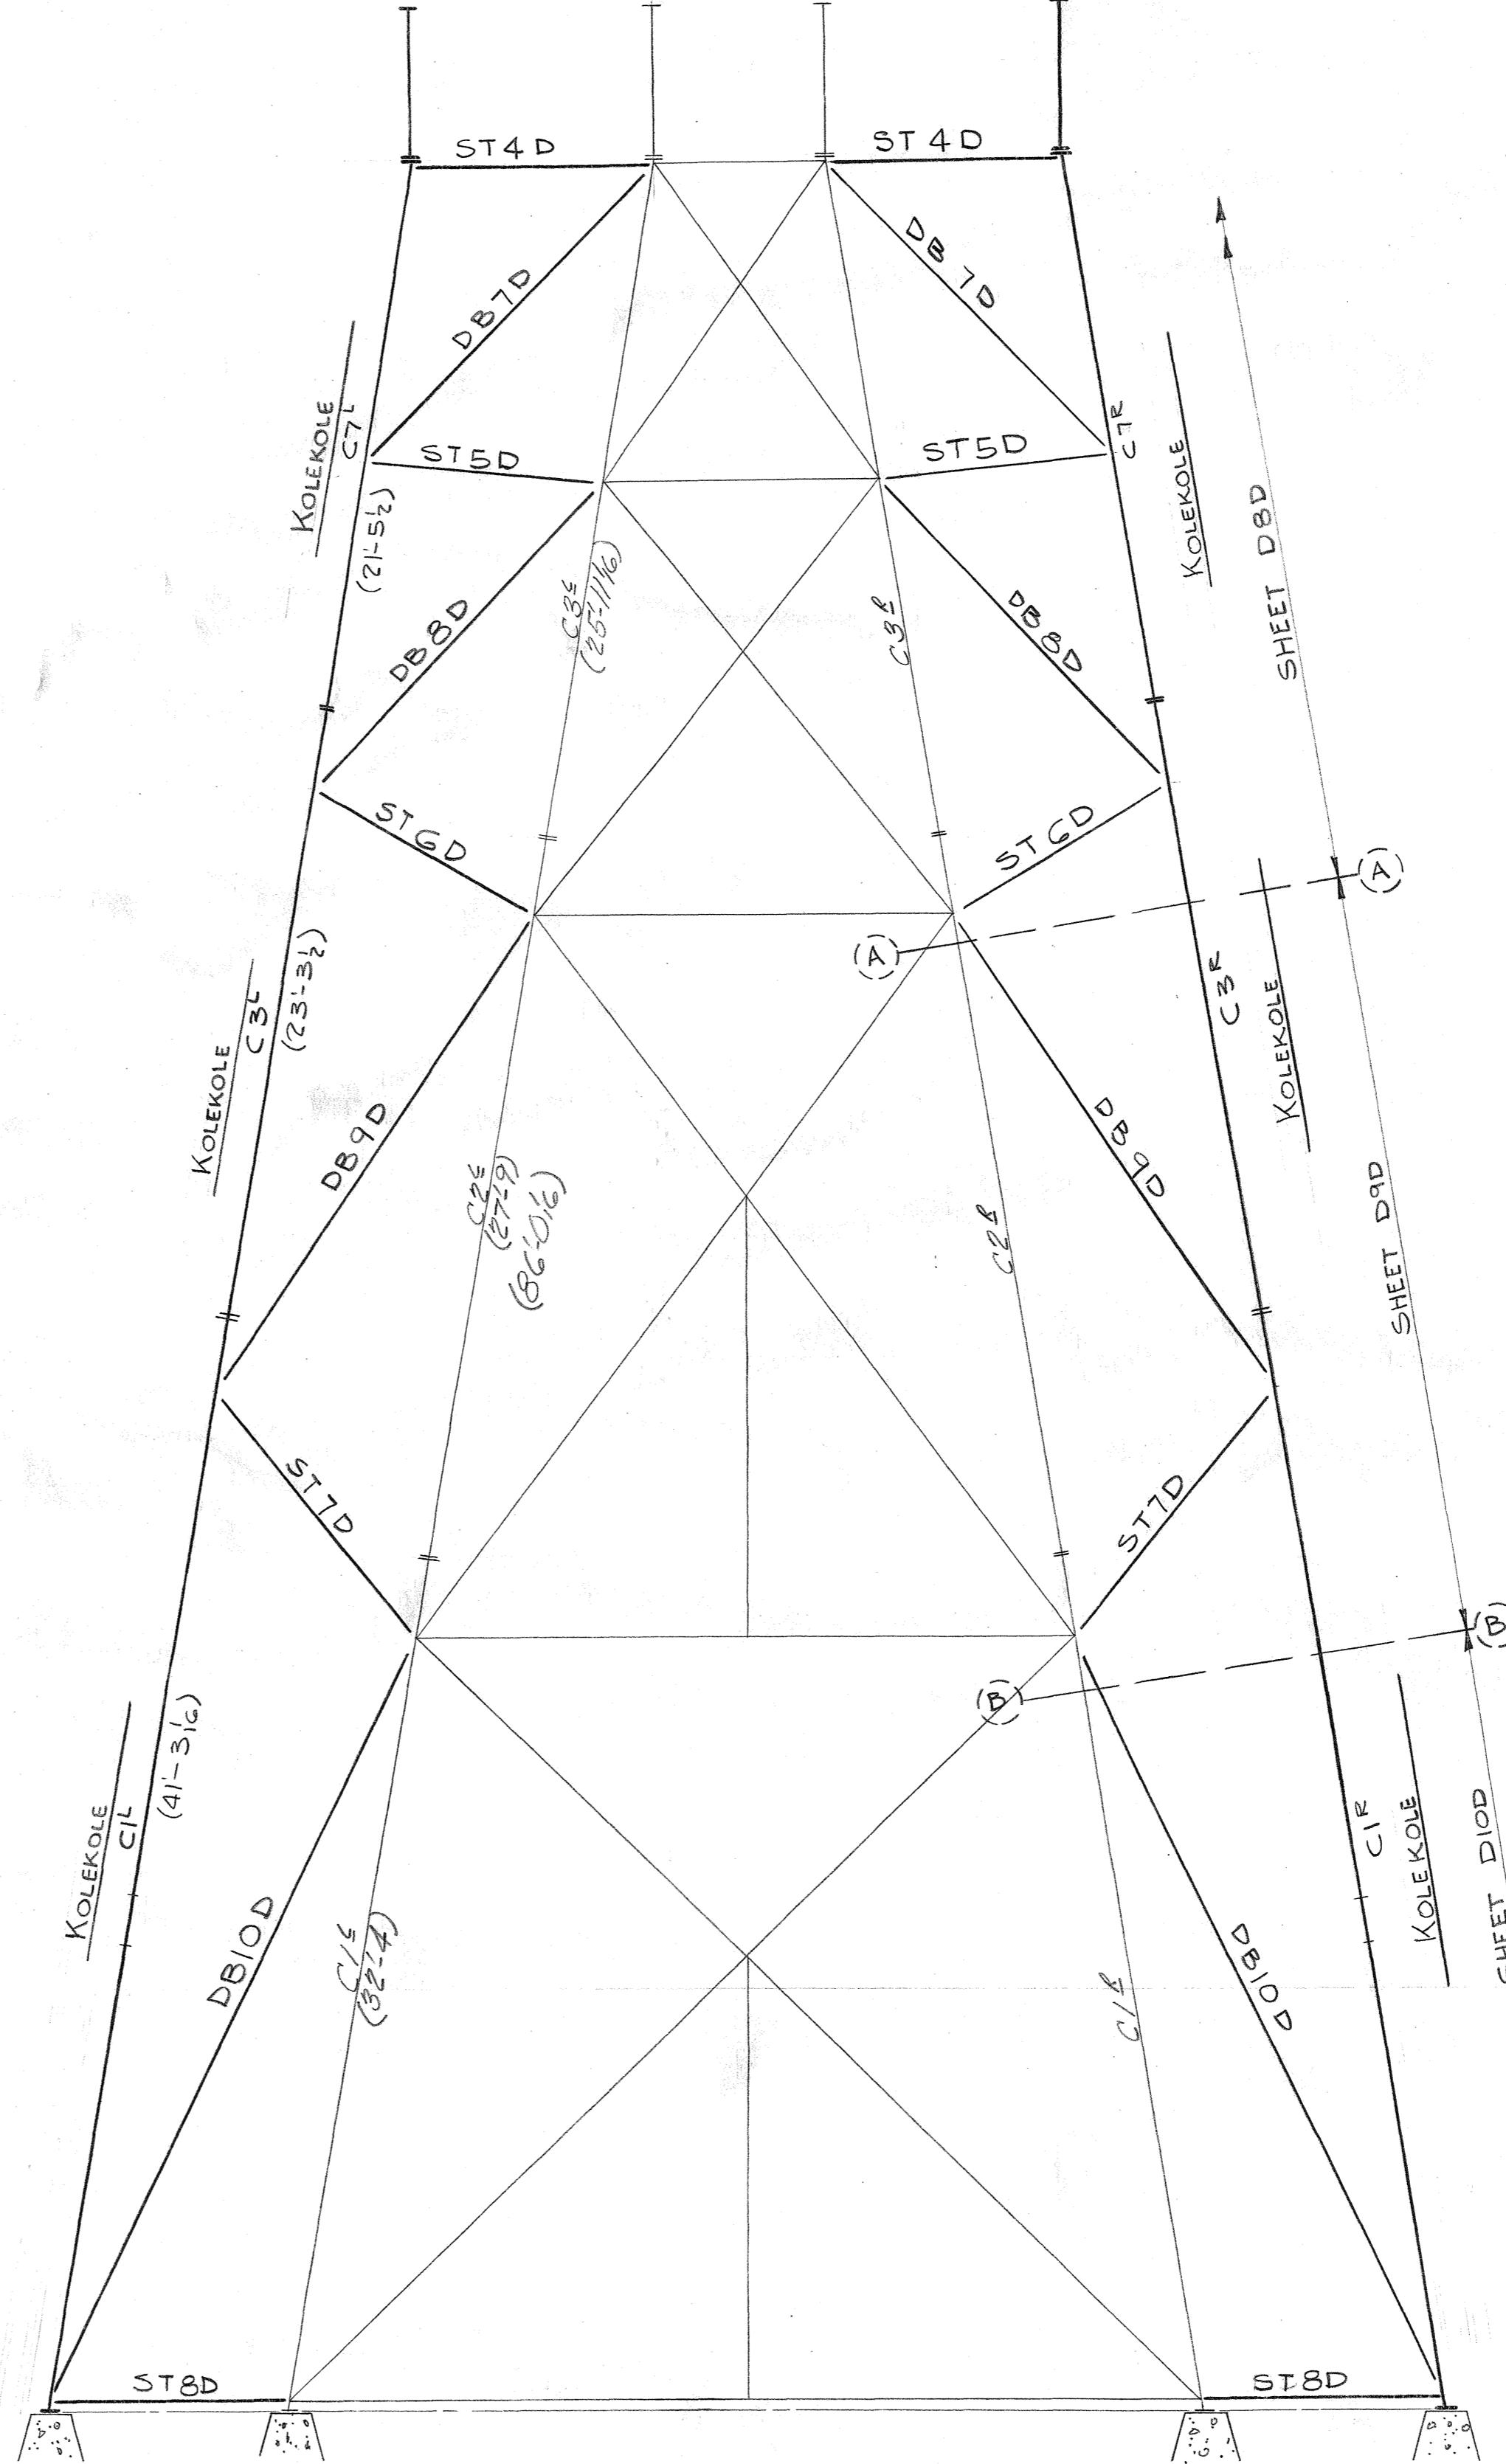

BENT #②  
LOOKING SOUTH

**Rivets:**  $\frac{3}{4}$ "<sup>4</sup>

**Holes:**  $\frac{13}{16}$ "<sup>8</sup>       $1\frac{1}{2}$ " E.D. UN.

**Paint:**





INDUSTRIAL DEV. CO.  
ADDITION TO THE UNIAUNI  
BUSINESS - HAWAII

# **INDEPENDENT IRON WORKS, INC.**

OAKLAND, CALIF.

MADE BY	DW	12-2-49	ORDER NO.	3807
CHECKED BY	✓	1-13-50	SHEET NO.	E2-D

FED. ROAD DIST. NO.	STATE	FED. AID PROJ. NO.	FISCAL YEAR	SHET NO.
HAWAII HAWDR 2131950	157	304		11/50

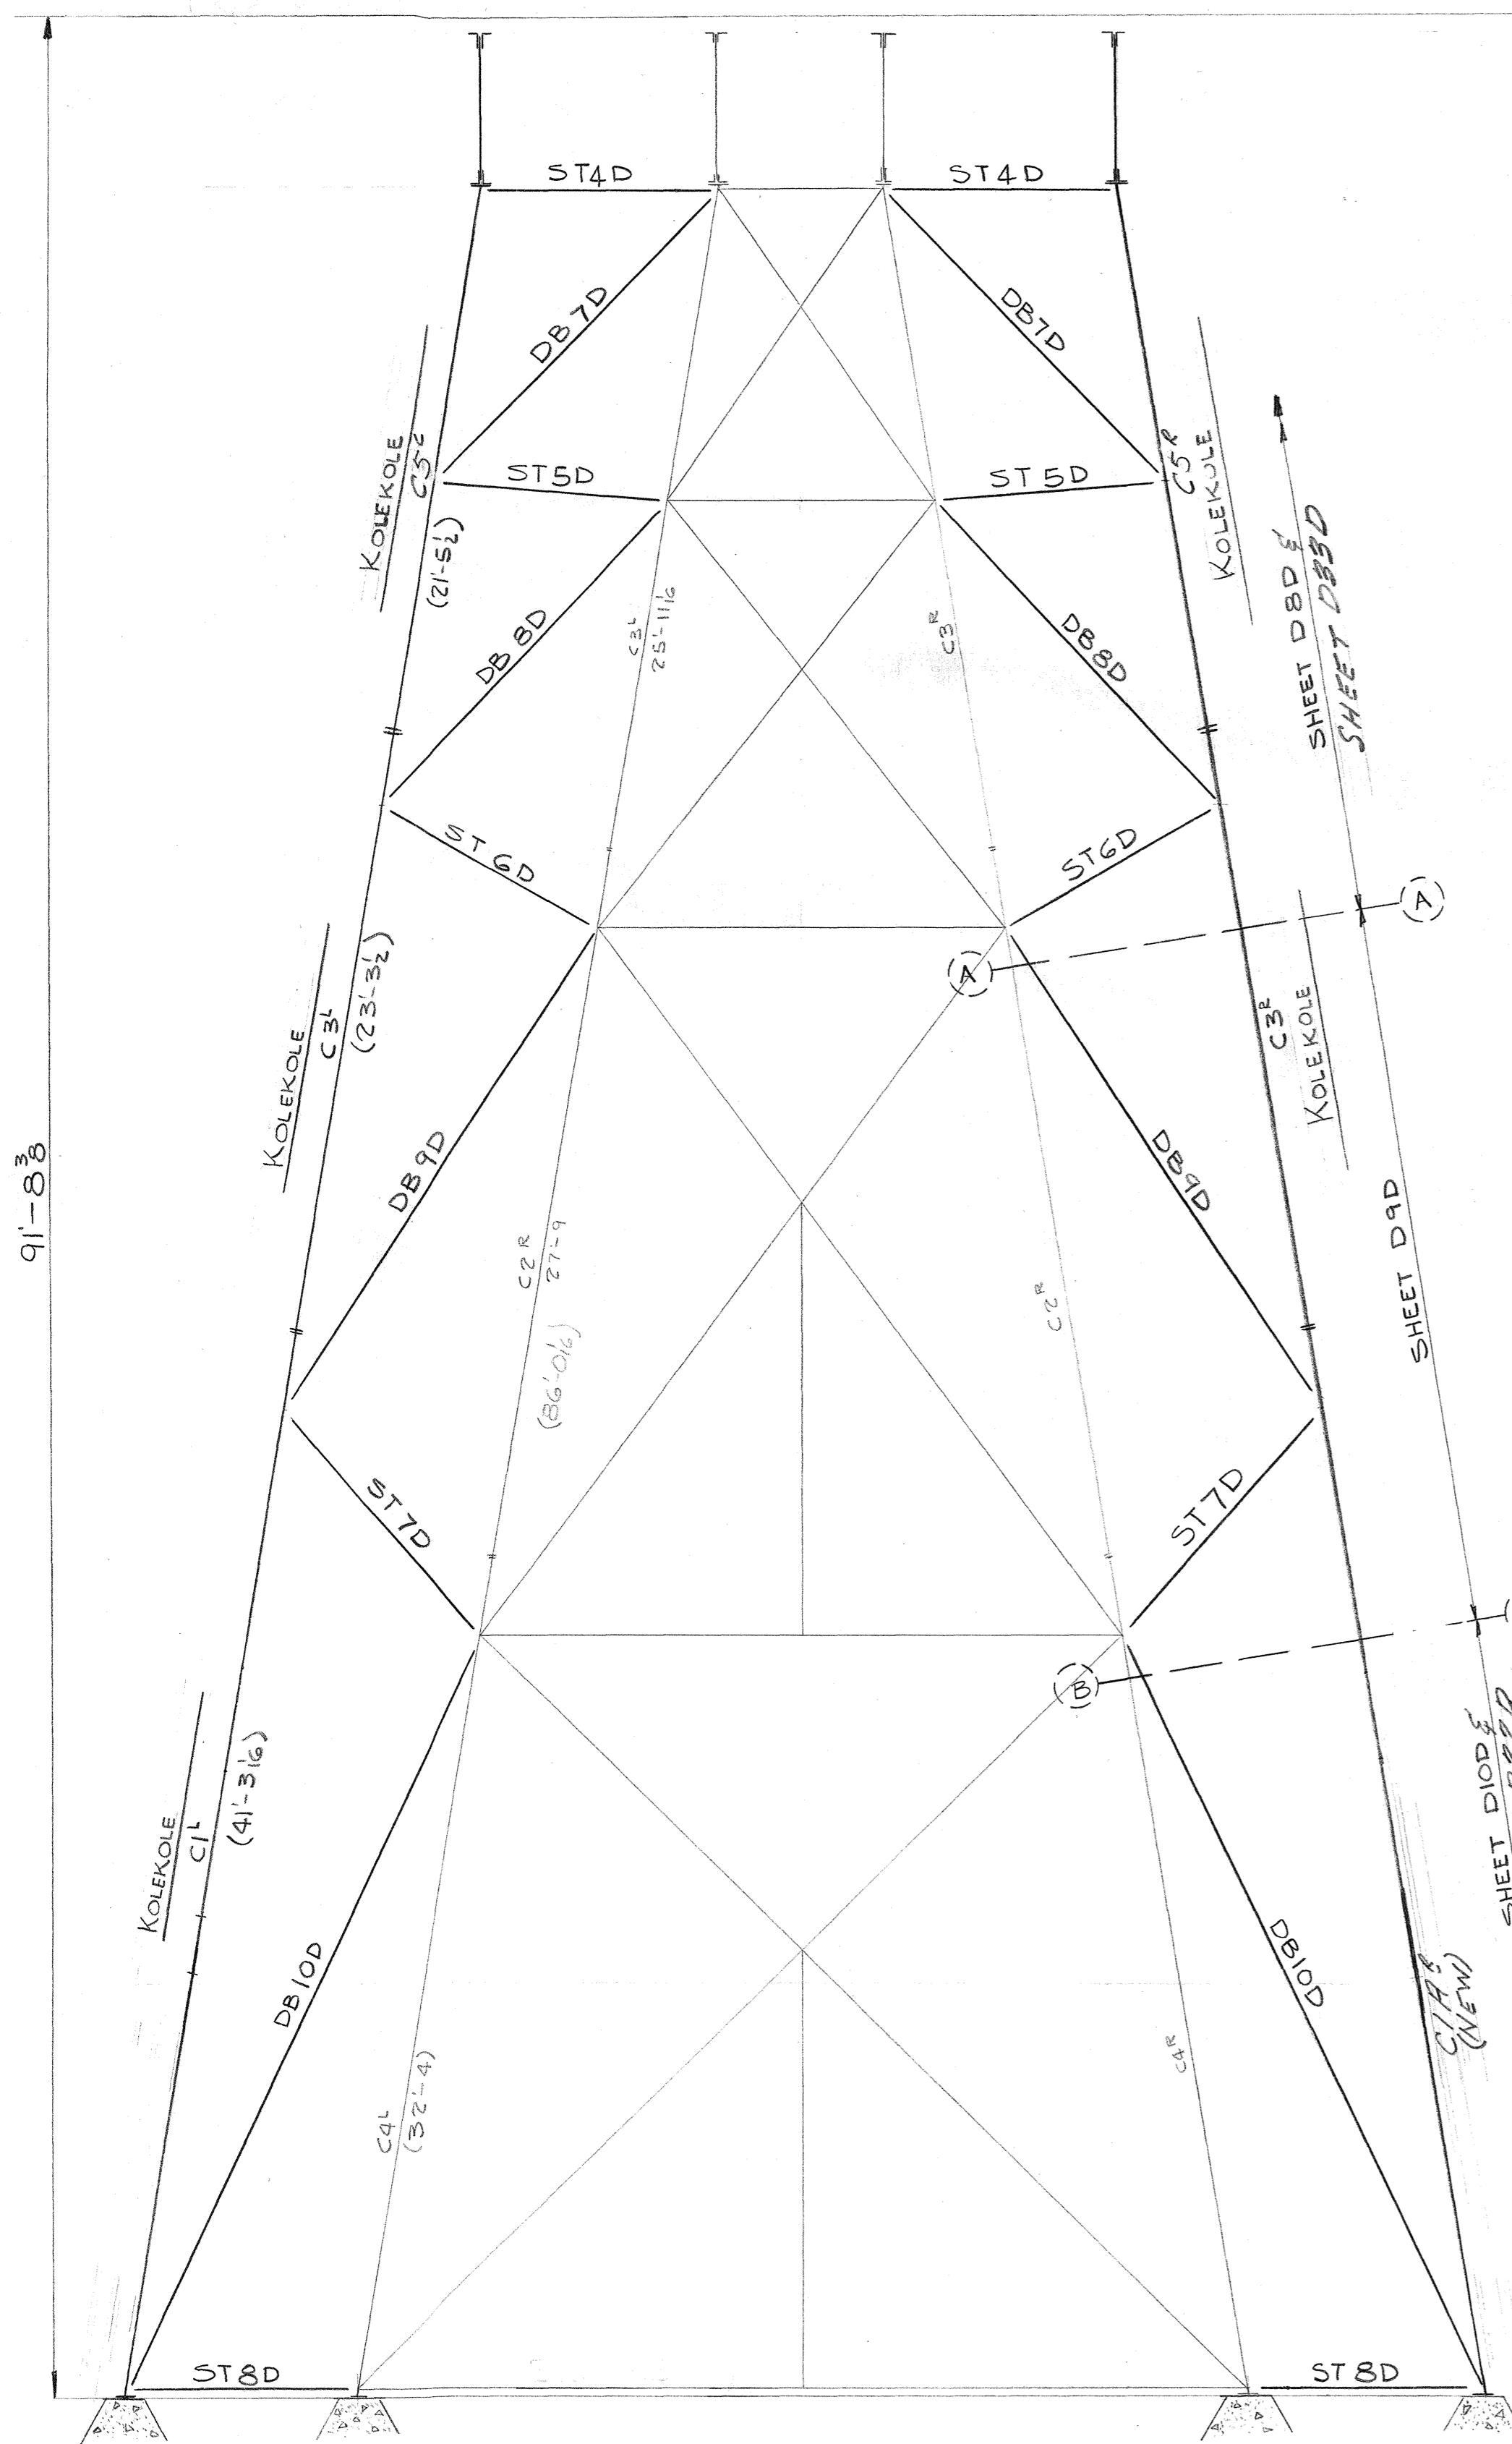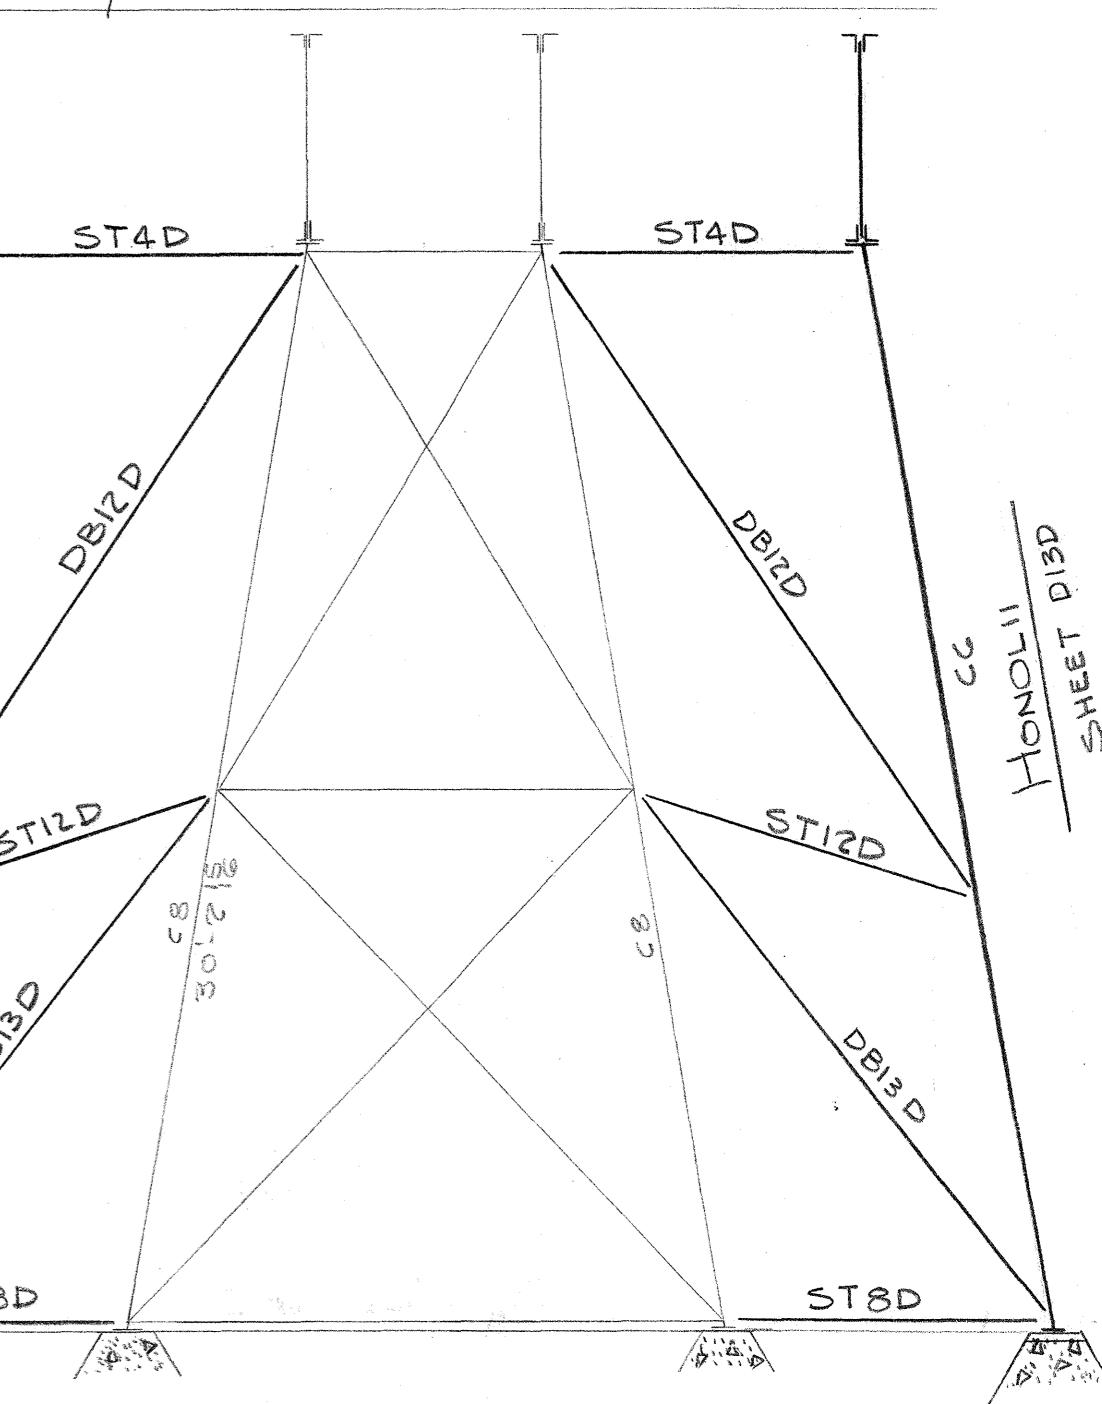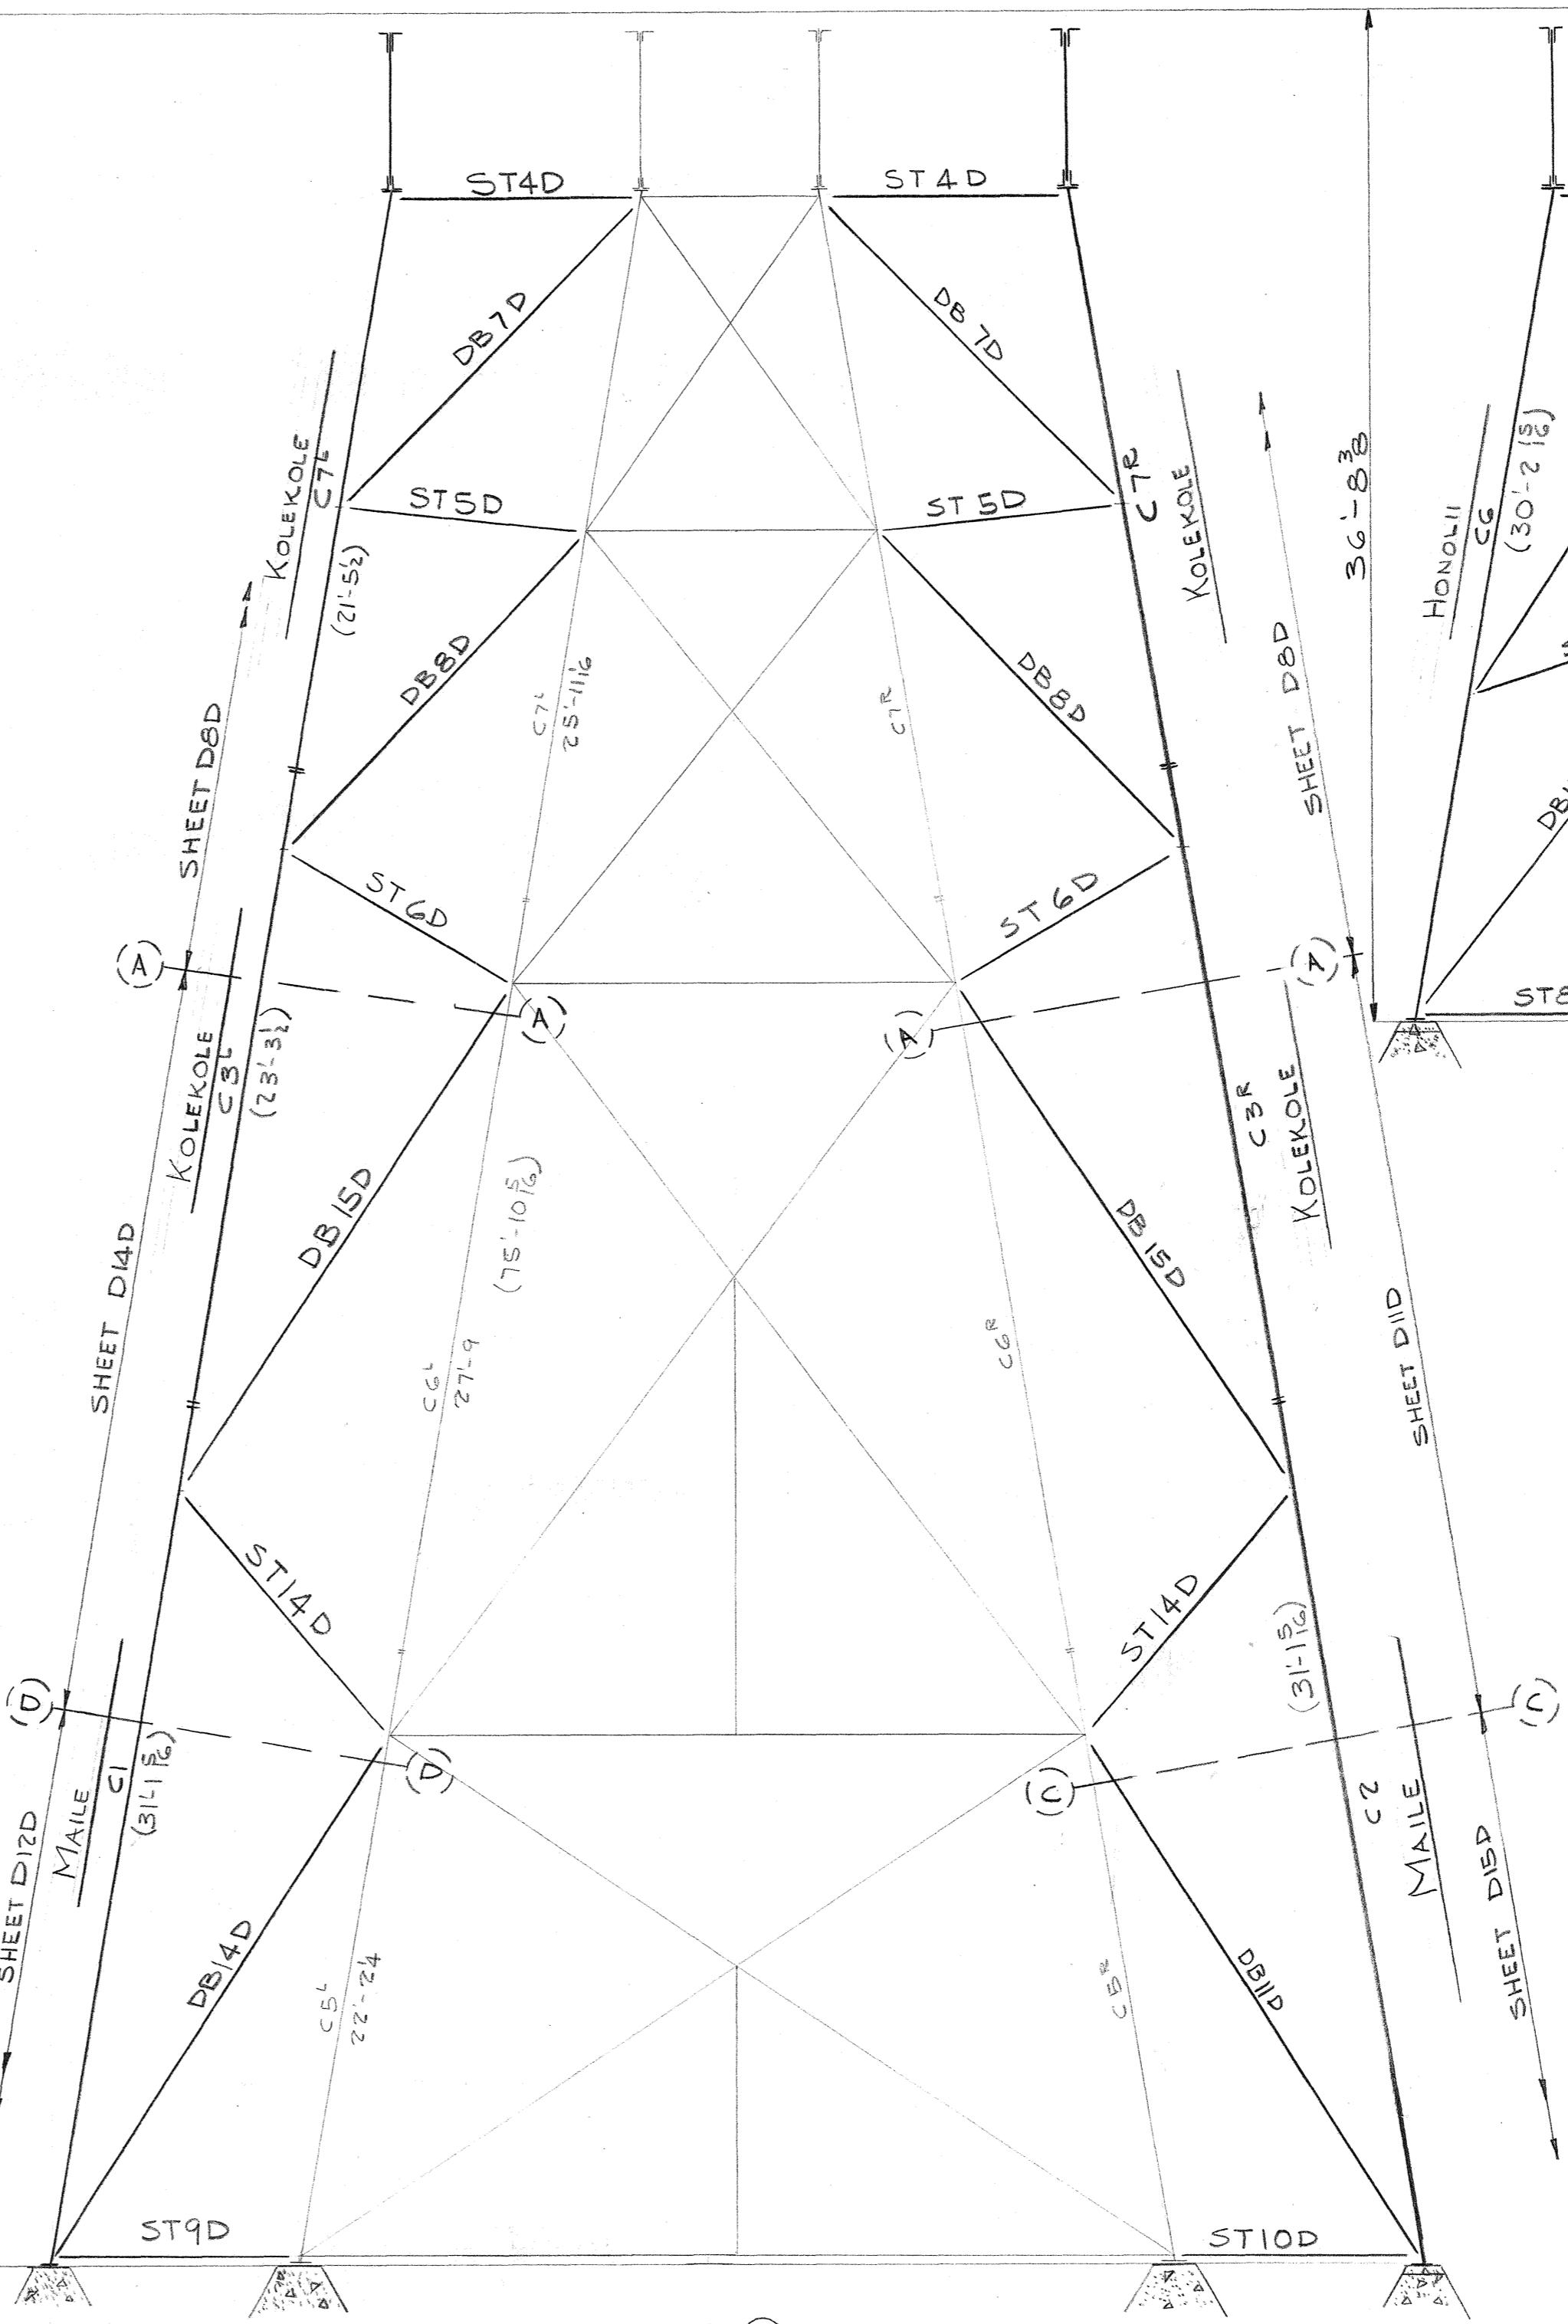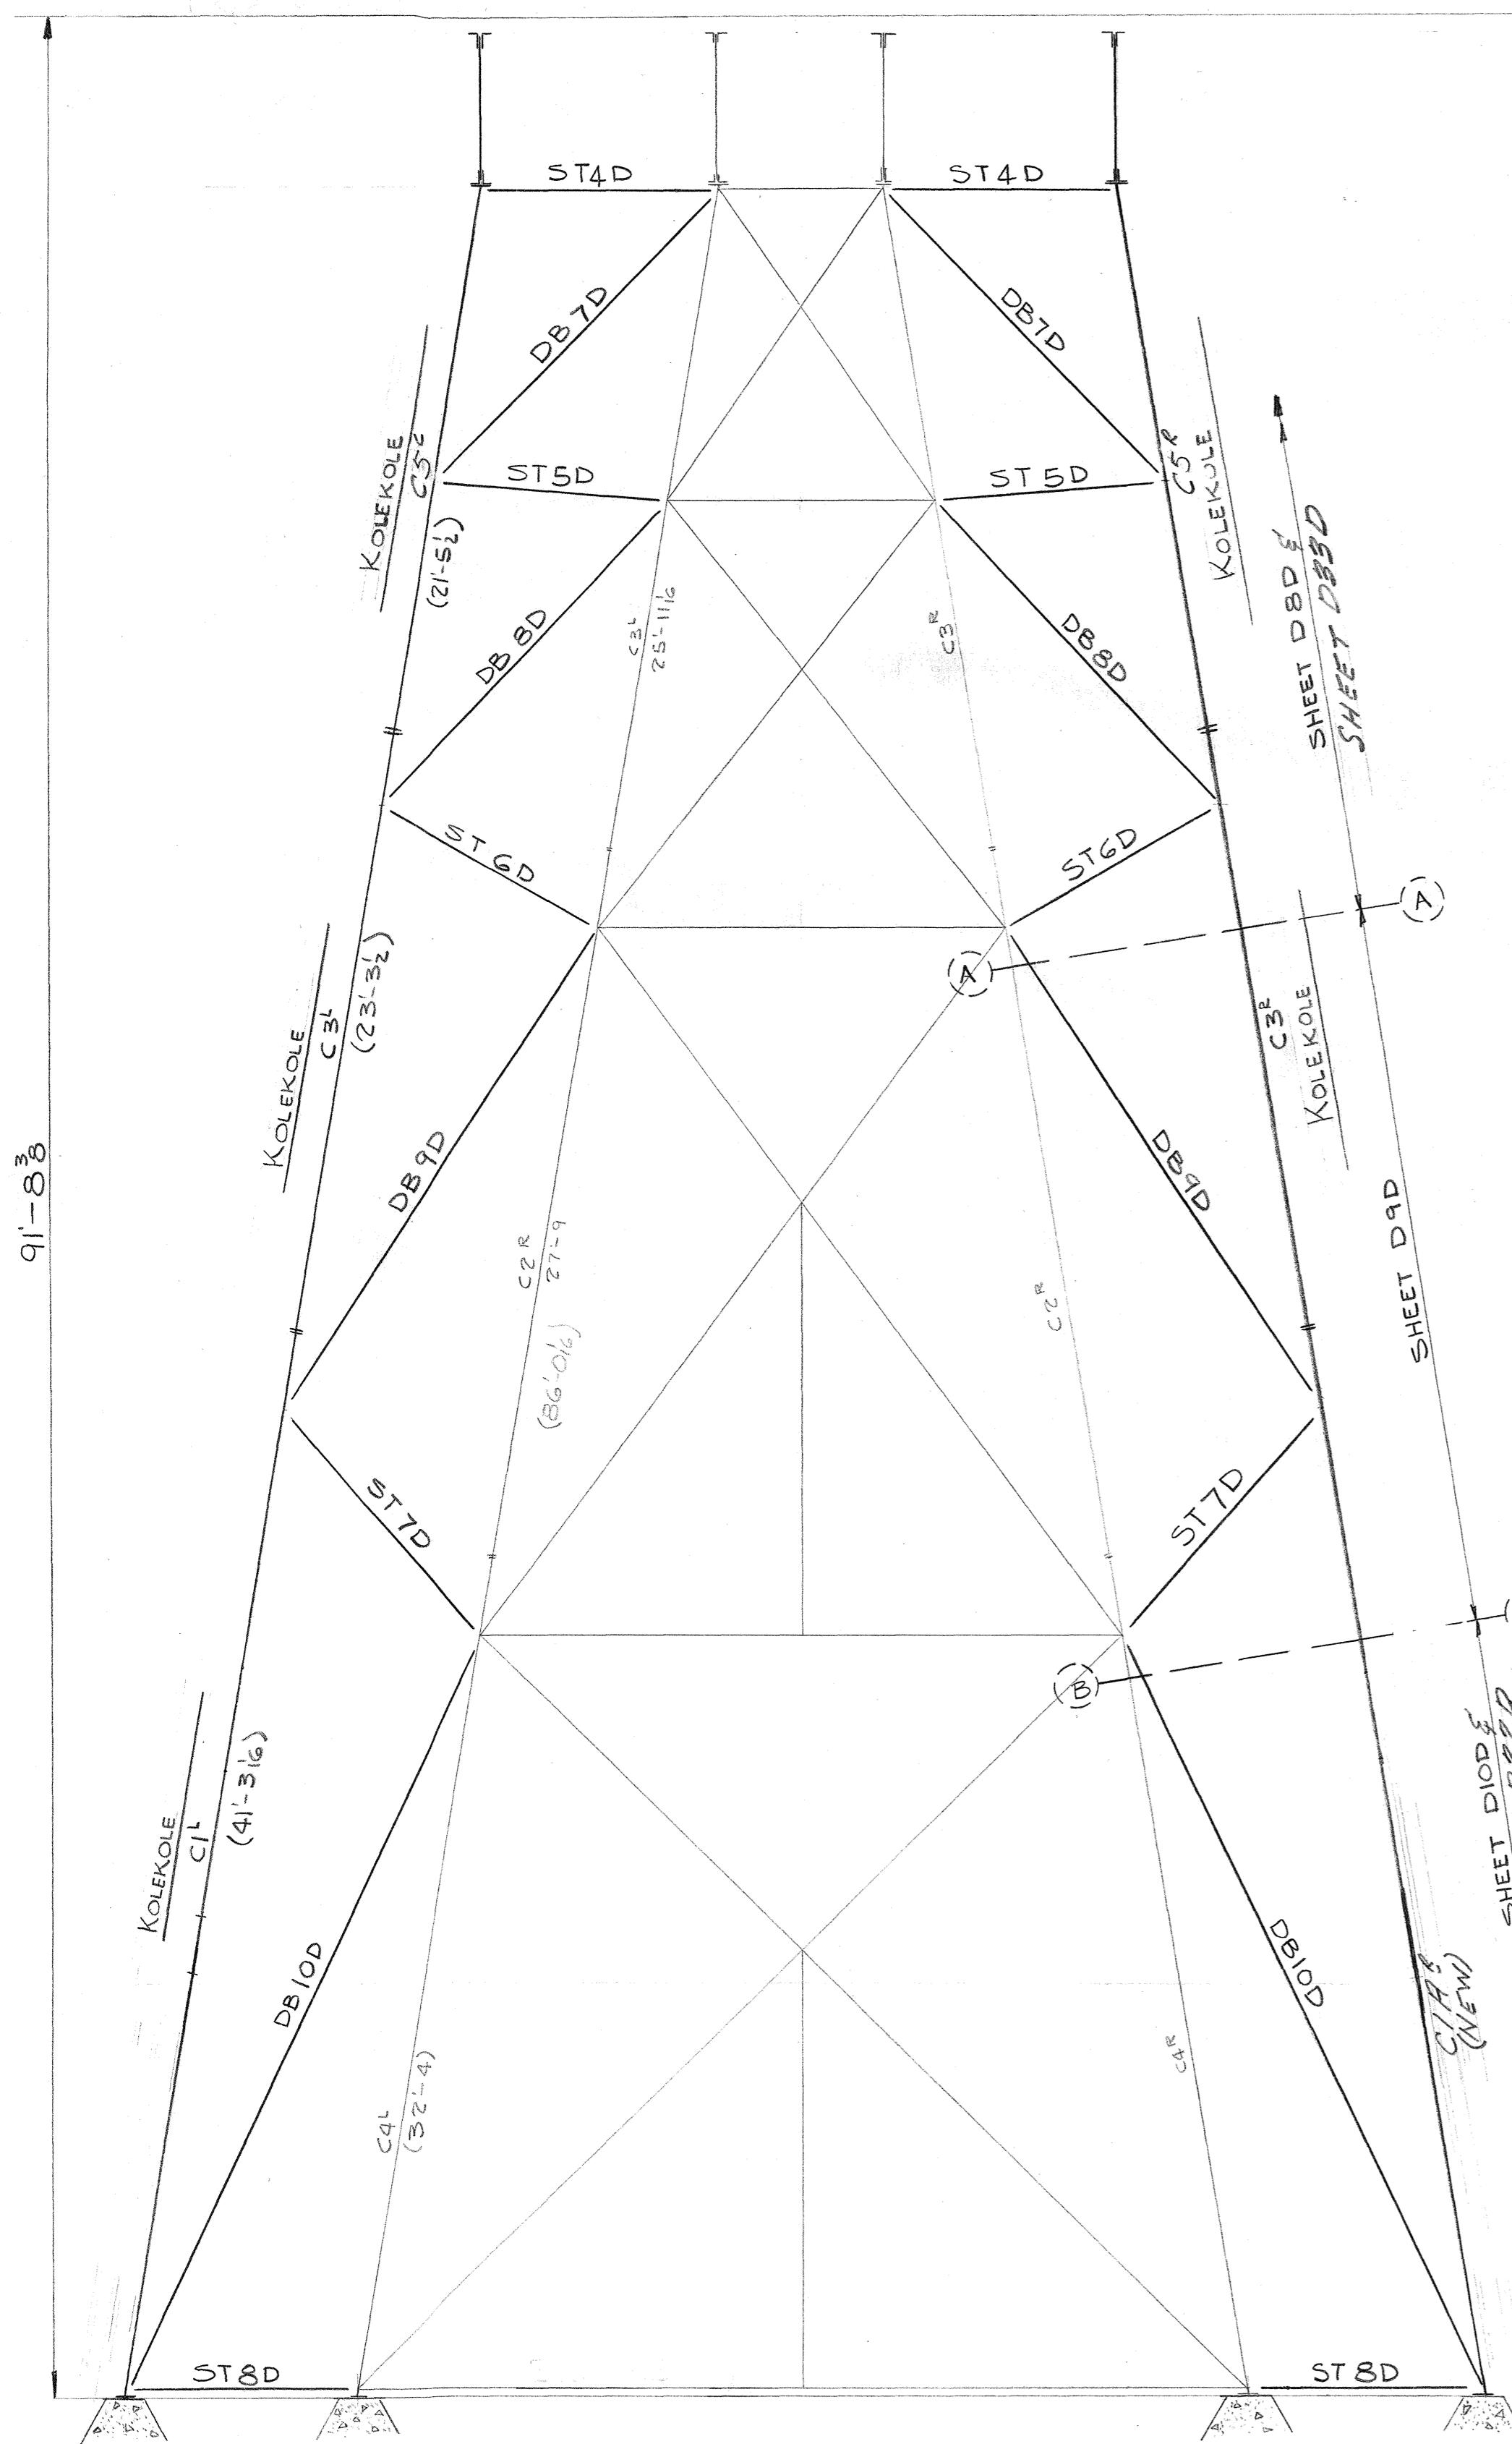q1-8<sup>3</sup>

Rivets:  $\frac{3}{4}$   
Holes:  $\frac{13}{16}$  ED-UN.  
Paint:



INDUSTRIAL DEV. CO.

ADDITION TO THE UMAUMA  
BRIDGE - HAWAII.INDEPENDENT IRON WORKS, INC.  
OAKLAND, CALIF.


MADE BY DAL 11-14-49	ORDER NO. 3807
CHECKED BY DD 1-16-50	SHEET NO. E3-D

5468.158

FED. ROAD DIST. NO.	STATE	FED. AID REC'D. IN FISCAL YEAR	SHEET NO.	TOTAL SHEETS
HAWAII HAWAII 202-02-1950		158	3001	

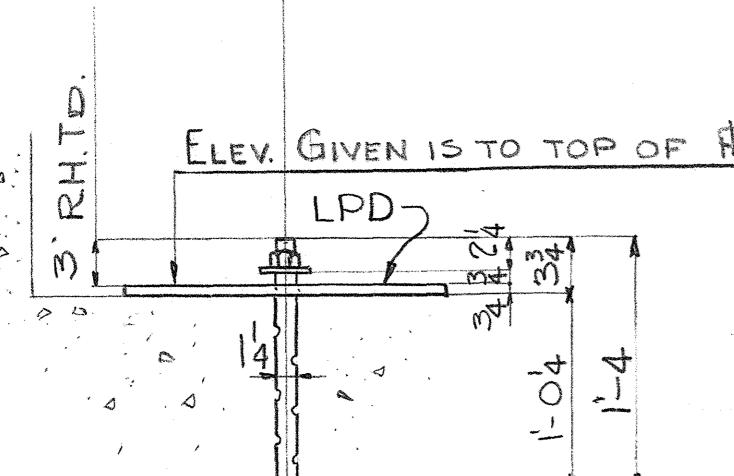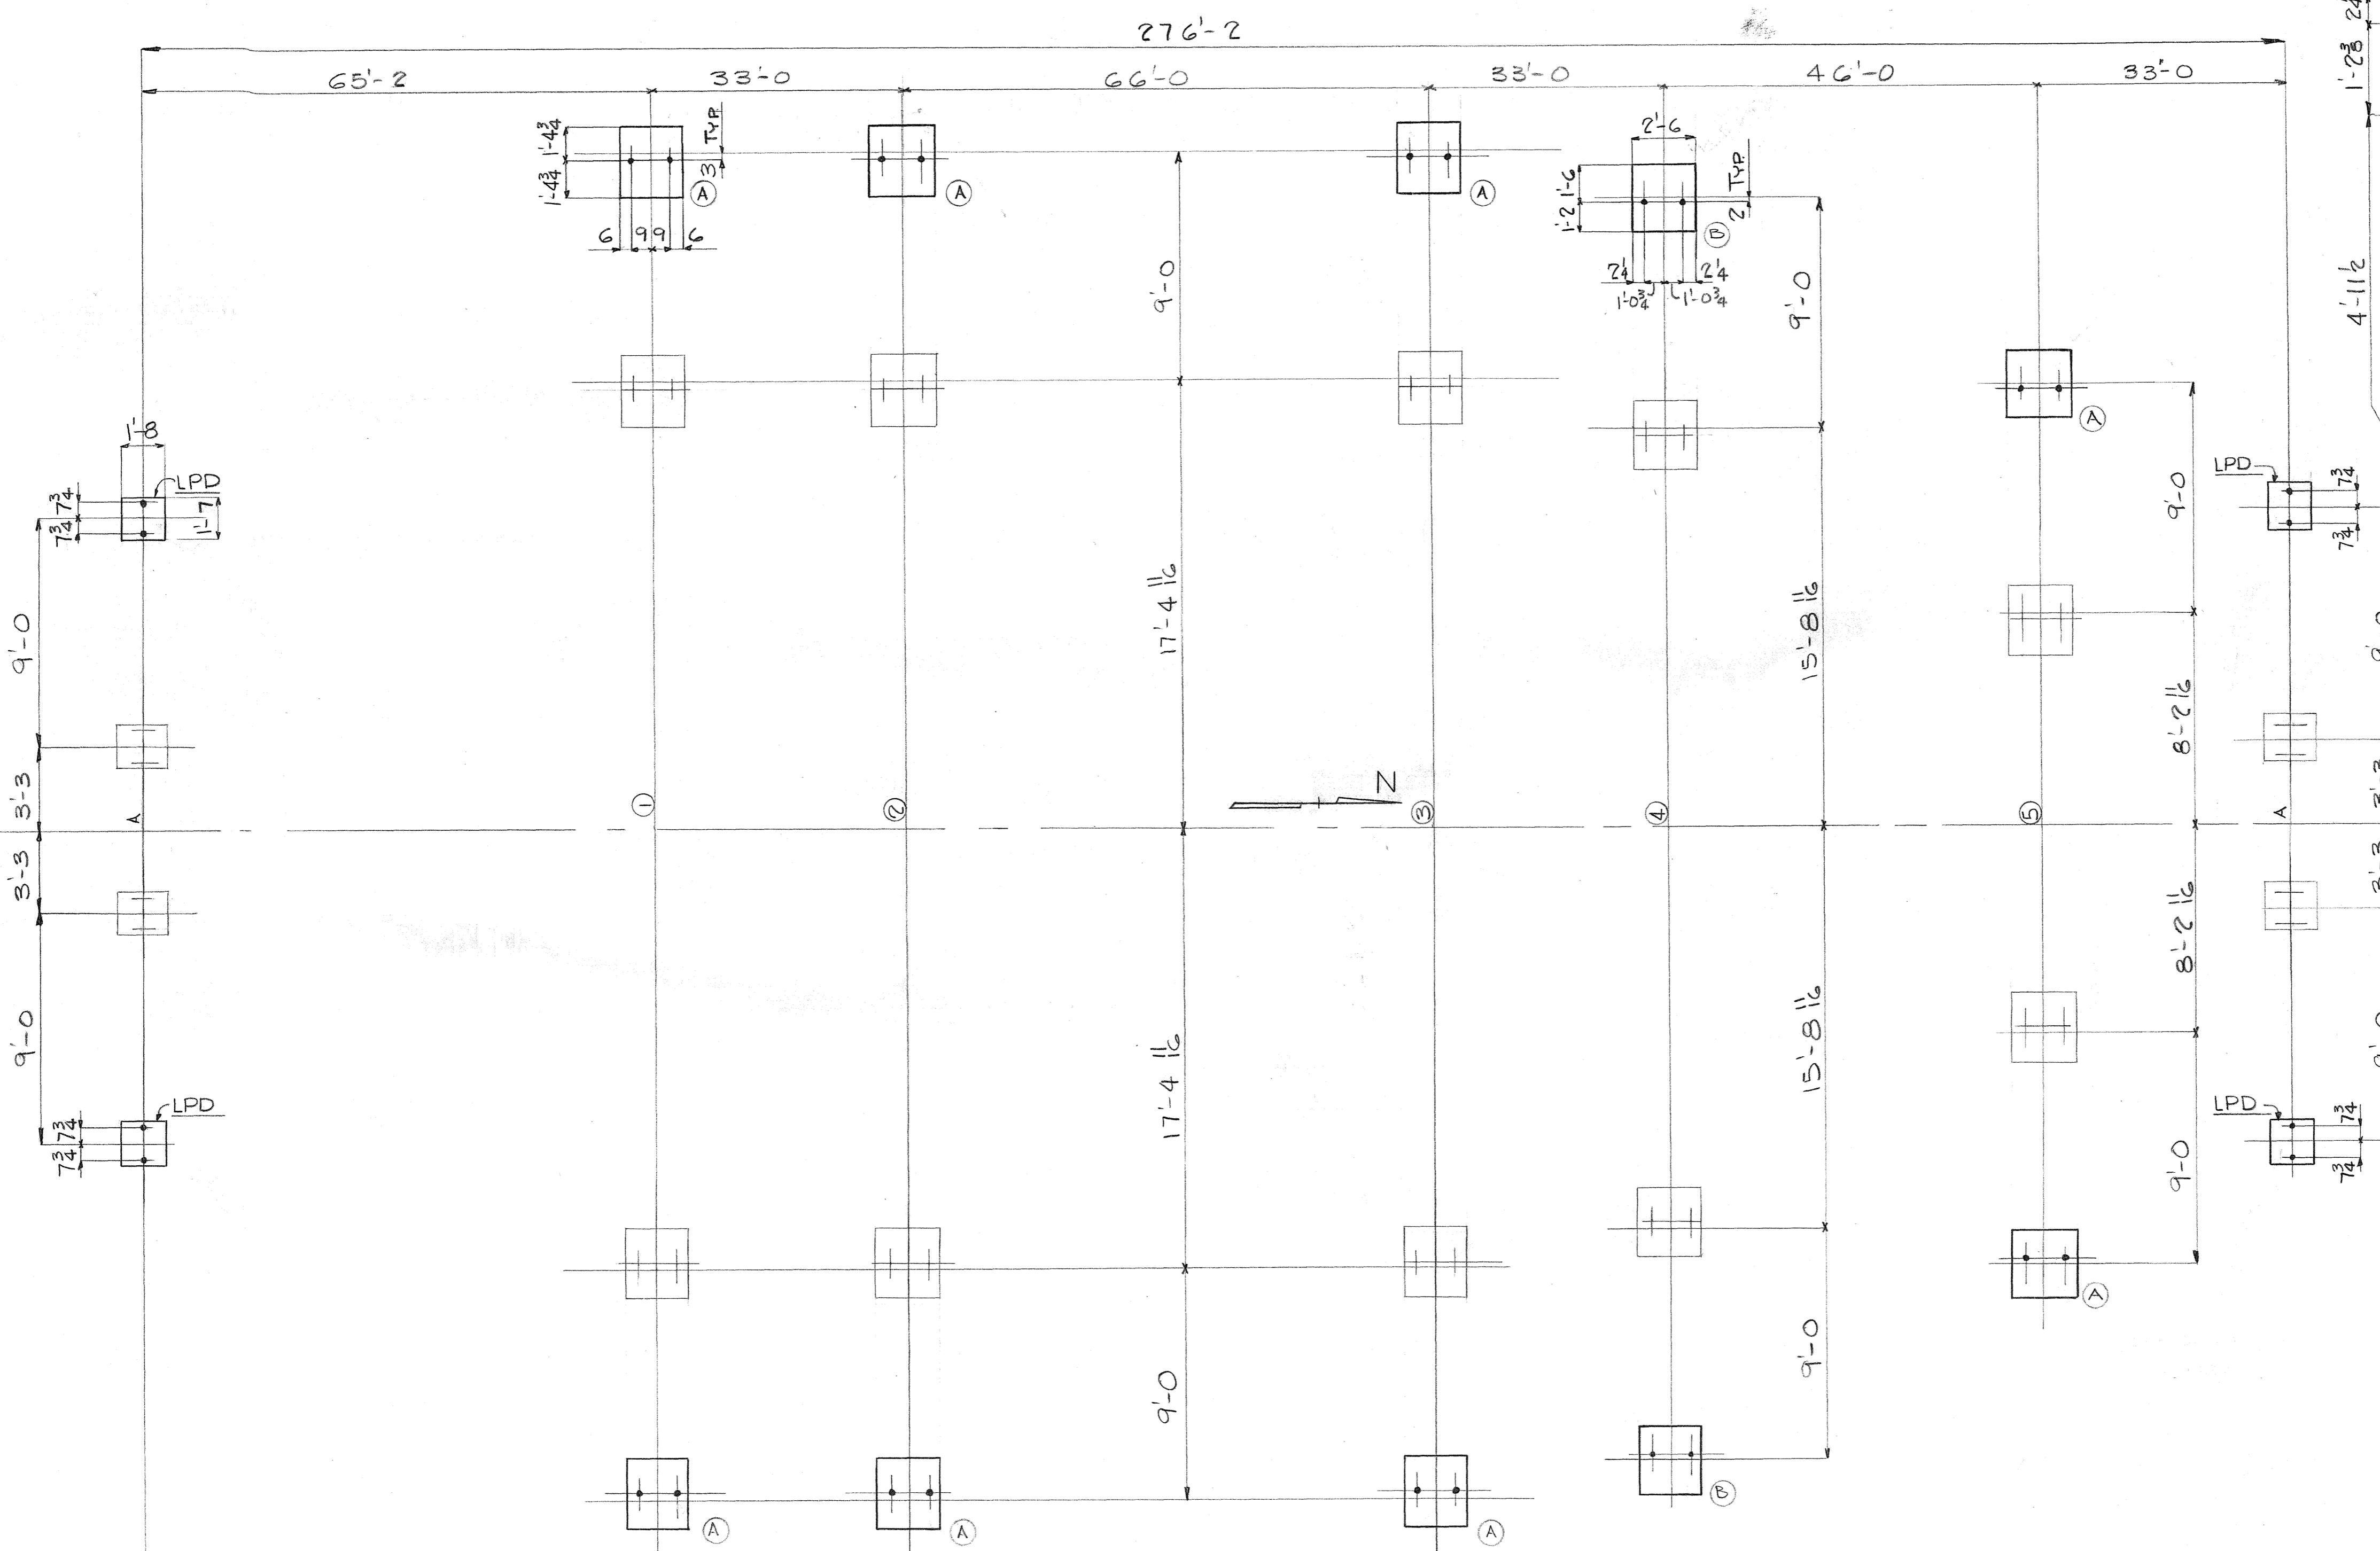

ANCHORAGE FOR ABUTMENT

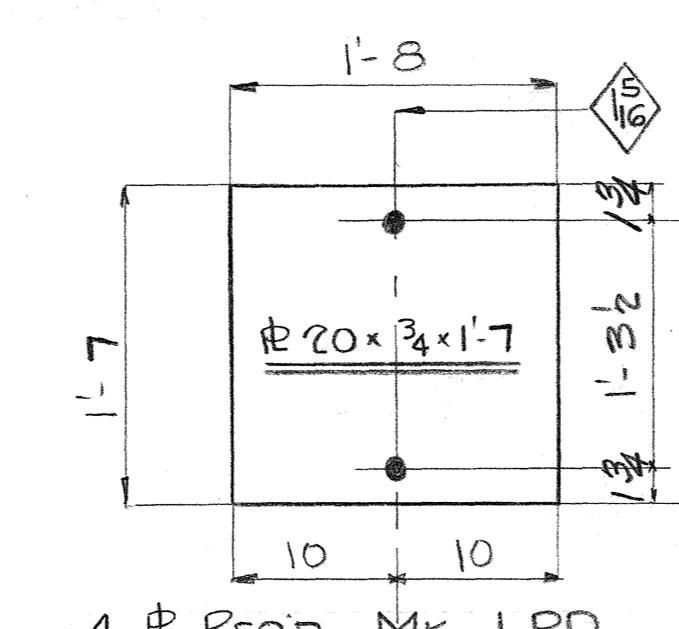

Rivets:

Holes:

Paint:

INDUSTRIAL DEVELOPMENT CO.

ADDITION TO UMAUMA BRIDGE

HAWAII

ANCHOR BOLT SETTING PLAN

INDEPENDENT IRON WORKS, INC.  
OAKLAND, CALIF.

MADE BY DAL 12-12-49 ORDER NO. 3807

CHECKED BY OBI 1-16-50 SHEET NO. E4D






5468.158

FED. ROAD  
DIST. NO. STATE FED. AID  
PROJ. NO. FISCAL PERIOD SHEET  
NO. TOTAL PAGES

HAWAII HON 3019780 159 302

## BILL OF MATERIAL INDUS. DEV. CO.

No.	Description	Length Ft. Ins.	Mark	REMARKS
2	EXISTING GIRDERS	G10&G8		
	REVAMP AS ON DETL.			
2	EXISTING GIRDERS	G9&G7		
	REVAMP AS ON DETL.			
2	SALVAGE GIRDERS	G13&G6		To BE TAKEN REVAMP AS ON DETL. FROM THE
2	SALVAGE GIRDERS	G14&G8		KOLEKOLE REVAMP AS ON DETL. BRIDGE
G	ST. 6W <sup>25</sup>	0	G	Plain - New
4	P 10'4x <sup>3</sup> / <sub>8</sub>	0	104	b Temp }
4	P 6x <sup>3</sup> / <sub>8</sub>	0	10	c
2	P 6x <sup>3</sup> / <sub>8</sub>	0	9 <sup>3</sup> / <sub>8</sub>	d
2	P 6x <sup>3</sup> / <sub>8</sub>	0	10	f
1G	P 3x <sup>3</sup> / <sub>8</sub>	0	11 <sup>3</sup> / <sub>8</sub>	g
4	P 5x <sup>3</sup> / <sub>8</sub>	0	7	h
2	L 4x4x <sup>3</sup> / <sub>8</sub>	6 <sup>1</sup> / <sub>2</sub>	ST3D	SALVAGE SEE SHTD7D

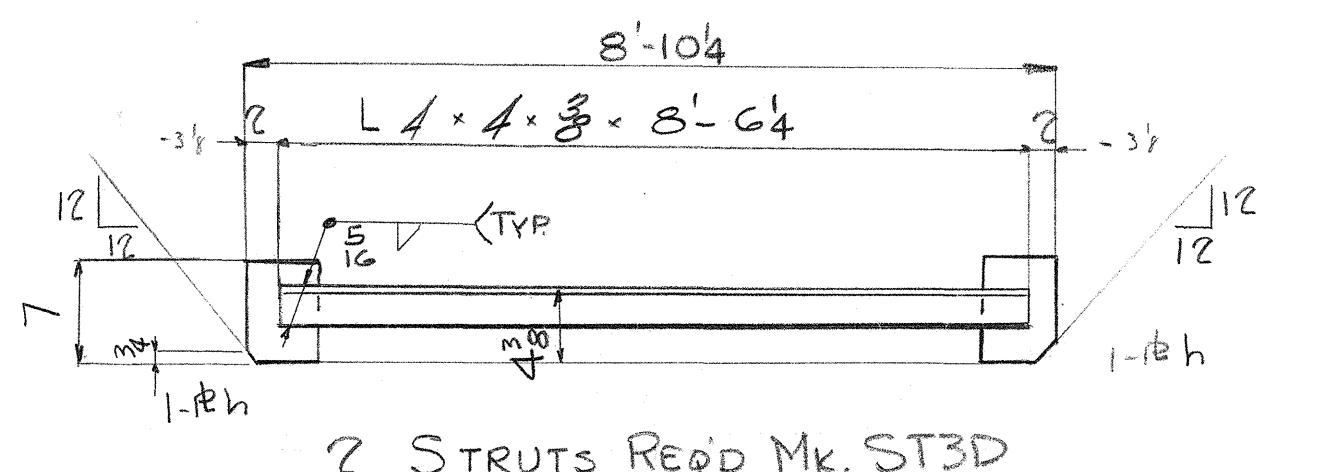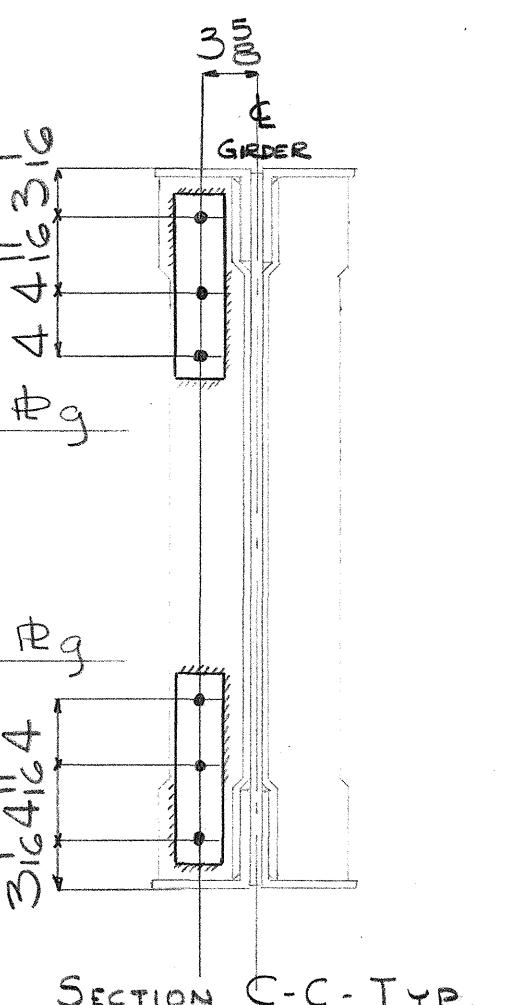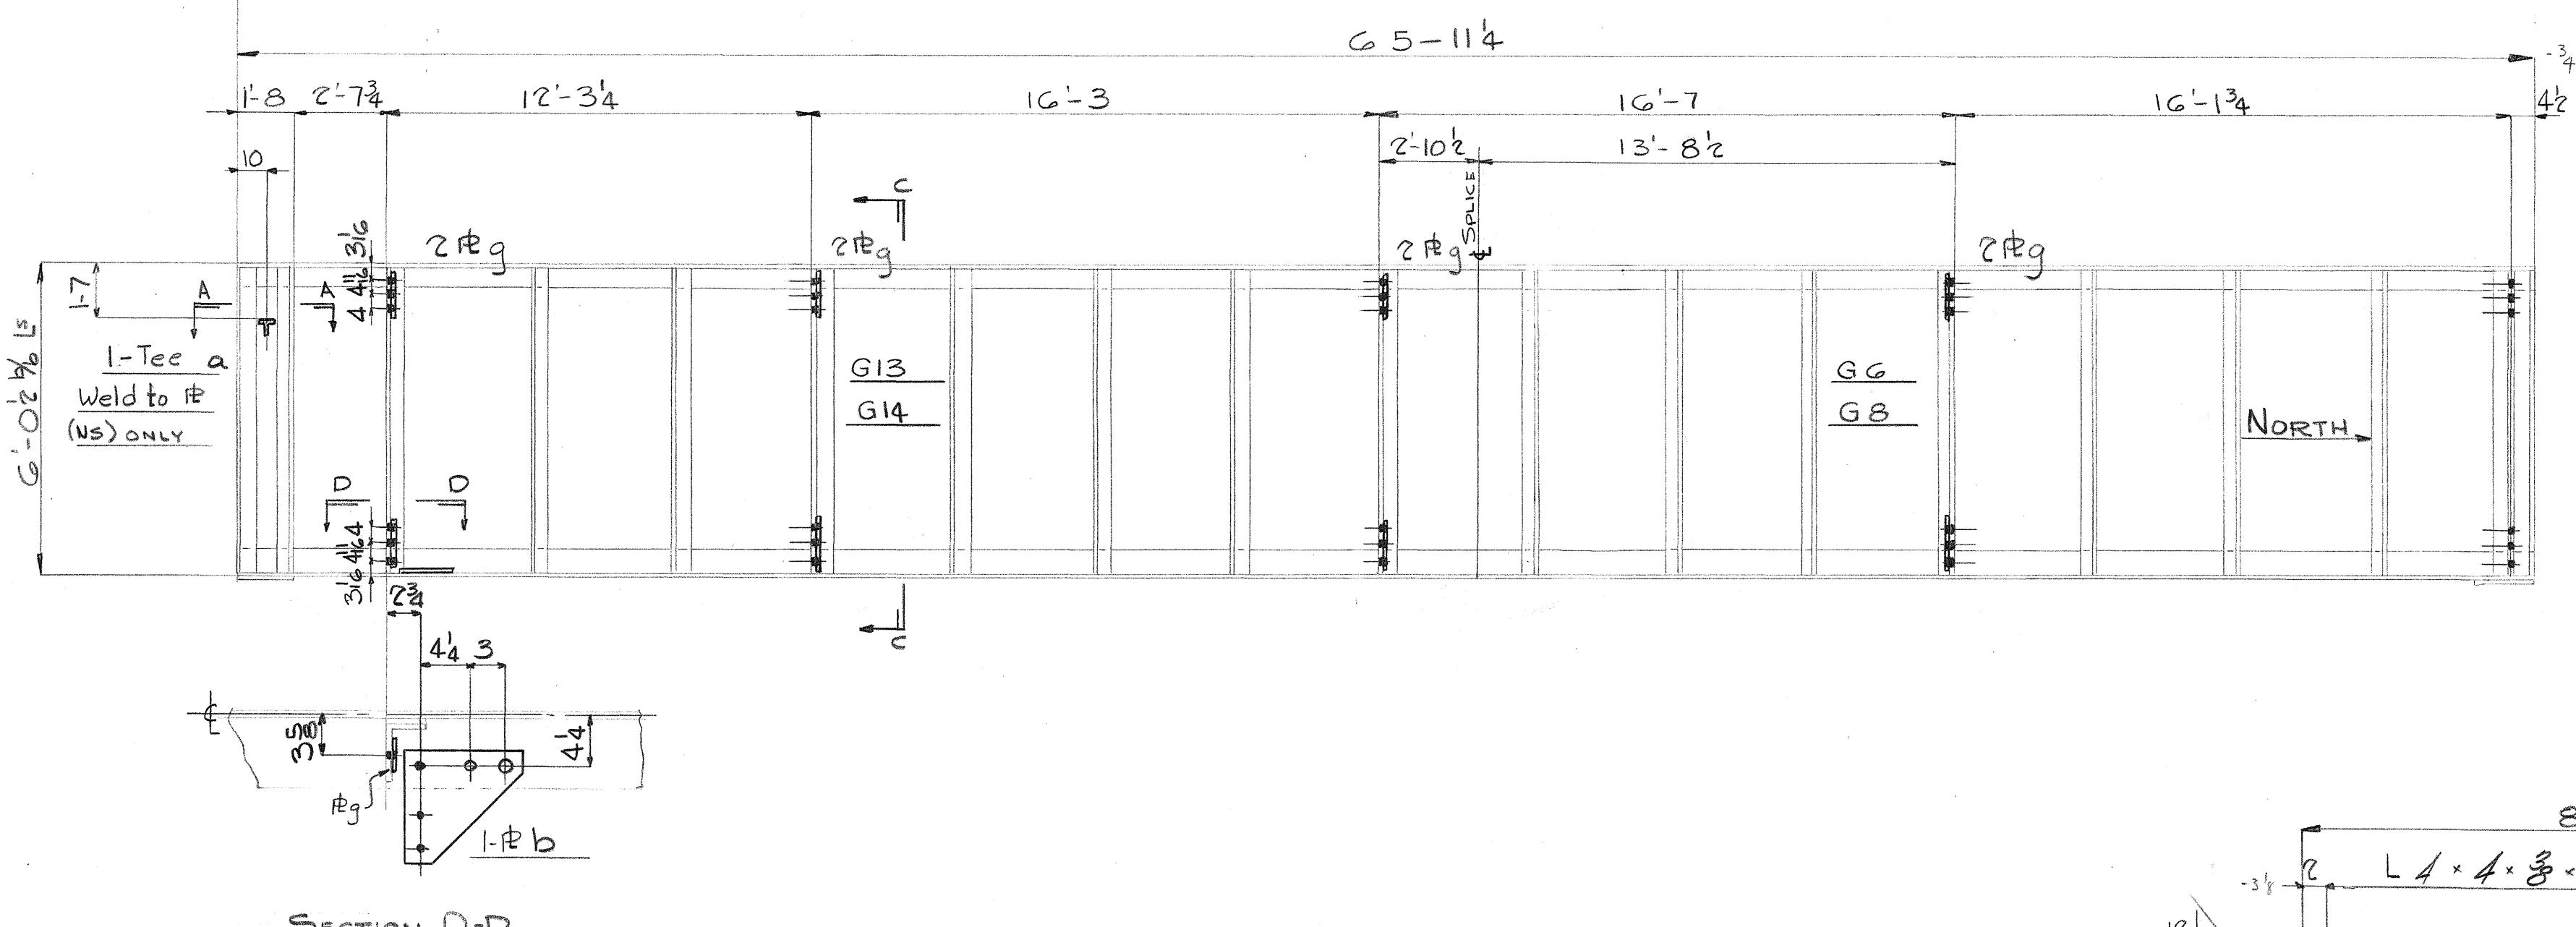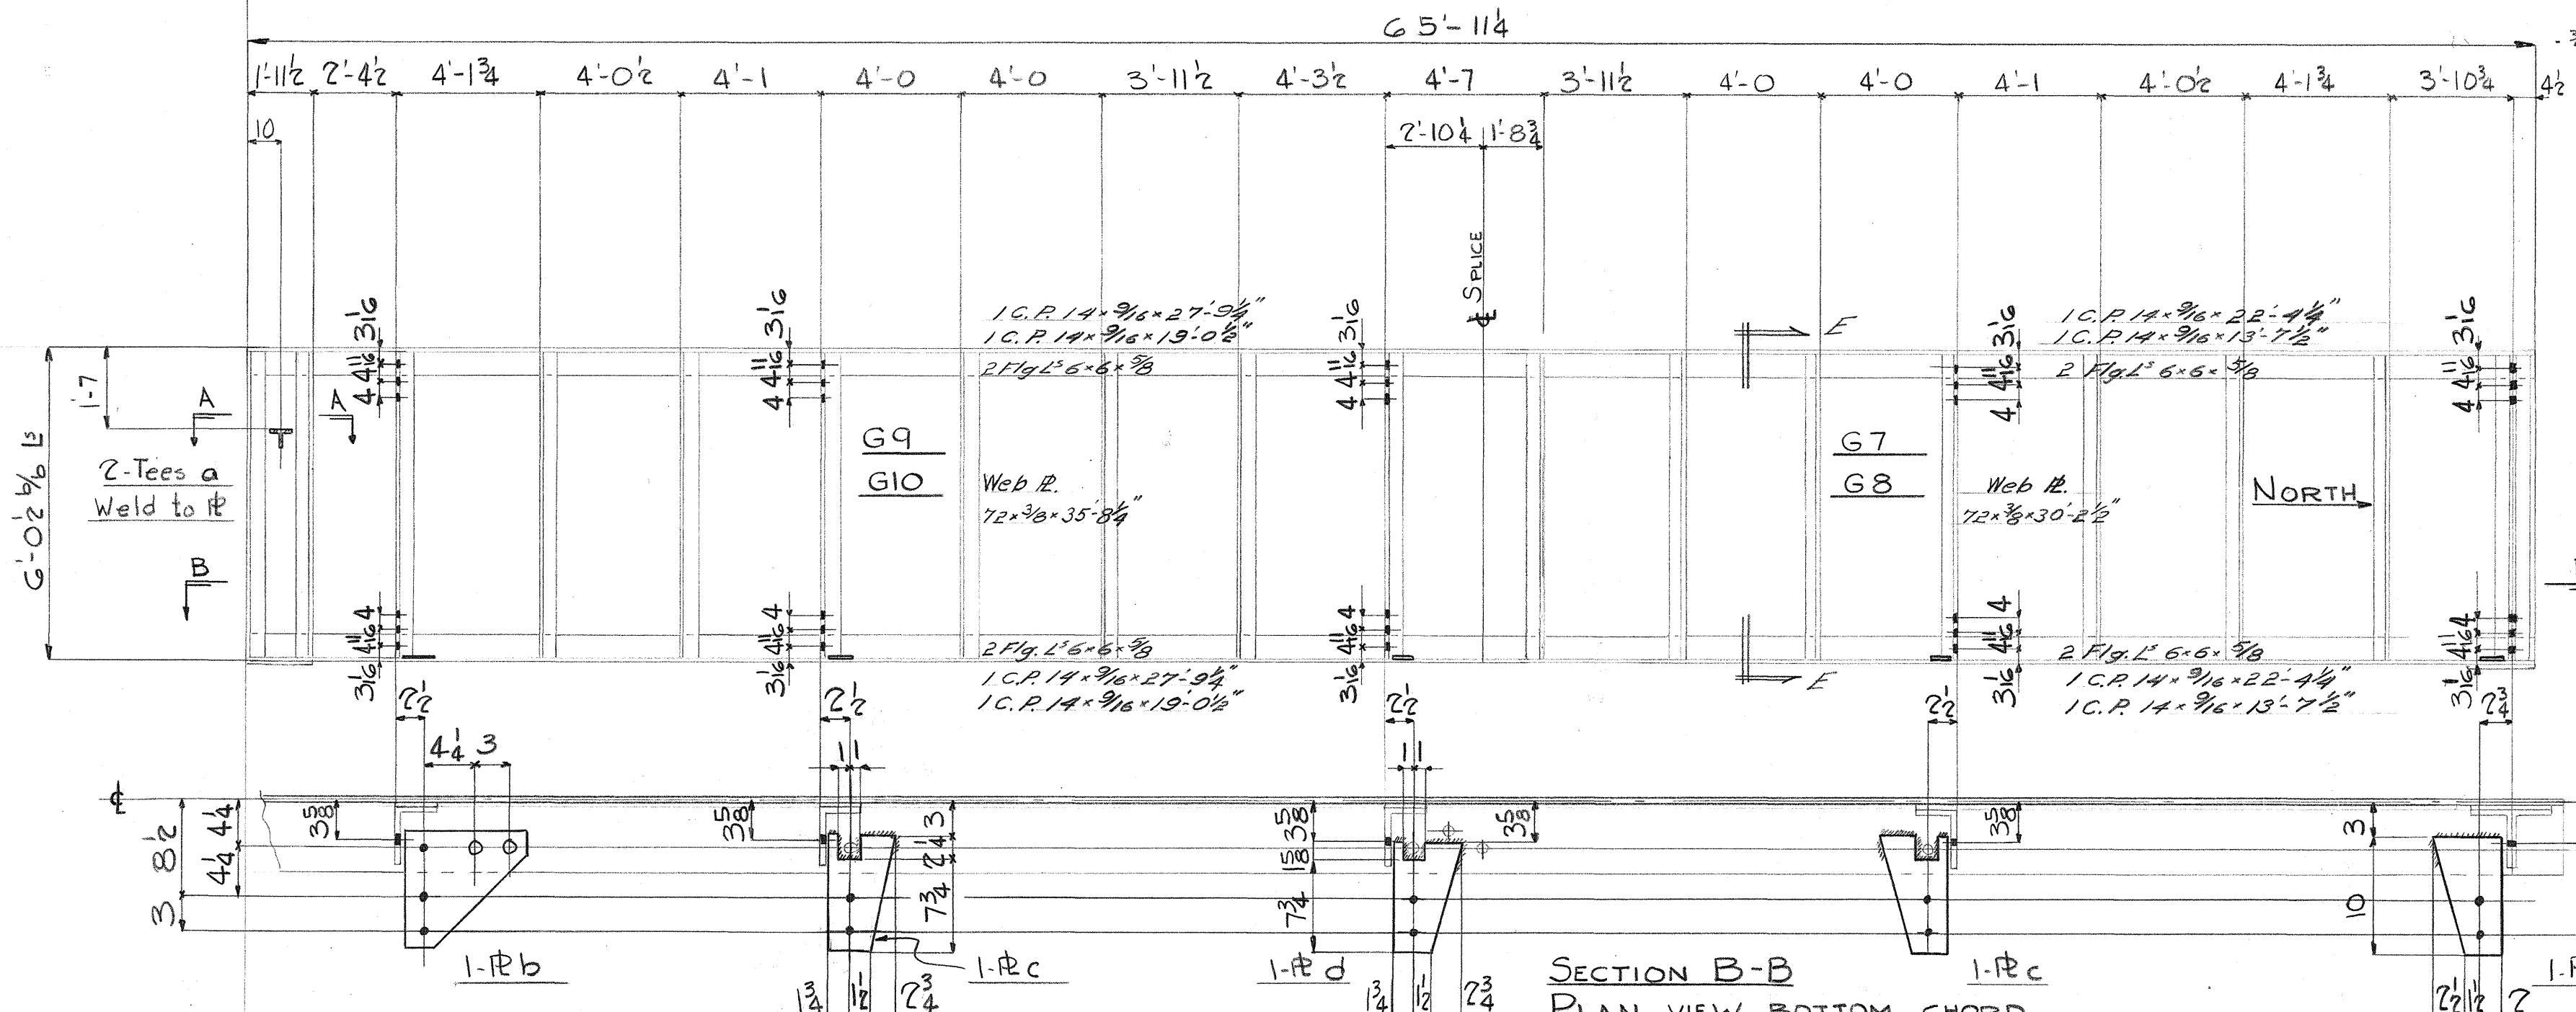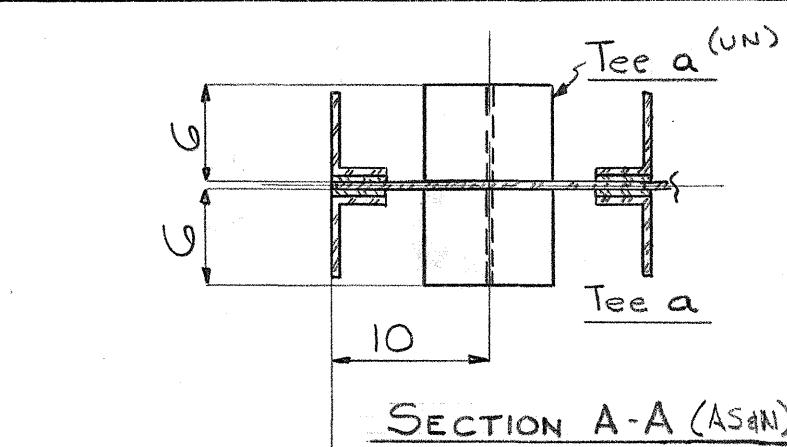

Rivets: 8<sup>4</sup>  
Holes: 16<sup>4</sup>  
Paint:

INDUSTRIAL DEV. CO.






ADDITION TO THE UMAUMA  
BRIDGE — HAWAIIINDEPENDENT IRON WORKS, INC.  
OAKLAND, CALIF.MADE BY DAL 11-15-49 ORDER NO. 3807  
CHECKED BY DD 1-5-50 SHEET NO. DID

5468.159

FED. ROAD DIST. NO.	STATE	FED. AID PROJ. NO.	FISCAL YEAR	SHEET NO.	TOTAL SHEETS
HAWAIIAN HIGHWAY DR3(3)NDEO	160	300			

## BILL OF MATERIAL INDUS. DEV.

No.	Description	Length Ft. In.	Mark	REMARKS
4	EXISTING GIRDERS G1&G2			REVAMP AS. ON DETL.
4	SALVAGE GIRDERS G1&G2 FROM THE REVAMP AS. ON DETL. KOLEKOLE BRIDGE			
8	PB 3 1/2	0 11 1/4	a	Temp New
8	PB 3 3/8	0 11 1/4	b	
24	PB 12 x 3/8	1 0	c	
12	PB 8 x 3/8	0 8	d	
24	PB 12 x 3/8	1 0	e	
12	STGW 225	0 6	f	
			g	Plain
G	BEAMS G 4	BID		
12	BEAMS 8 10	B2D		
	SALVAGE FROM COLUMN SECTIONS (SEE SHEET D7D)			
12	DIAG. BRACE	DBID		
22	L 4x3x3/8	8 10 STID		(PLAIN - NOT DETL'D)
12	L 4x3x5/8	8 7 1/4 f		
24	L 4x3x3/8	9 2 1/2 g		
	SALVAGE FROM TOWER BRACING SEE SHEET D7D			

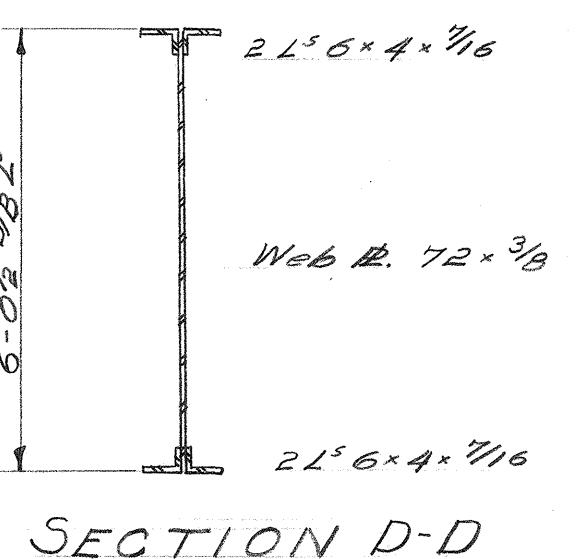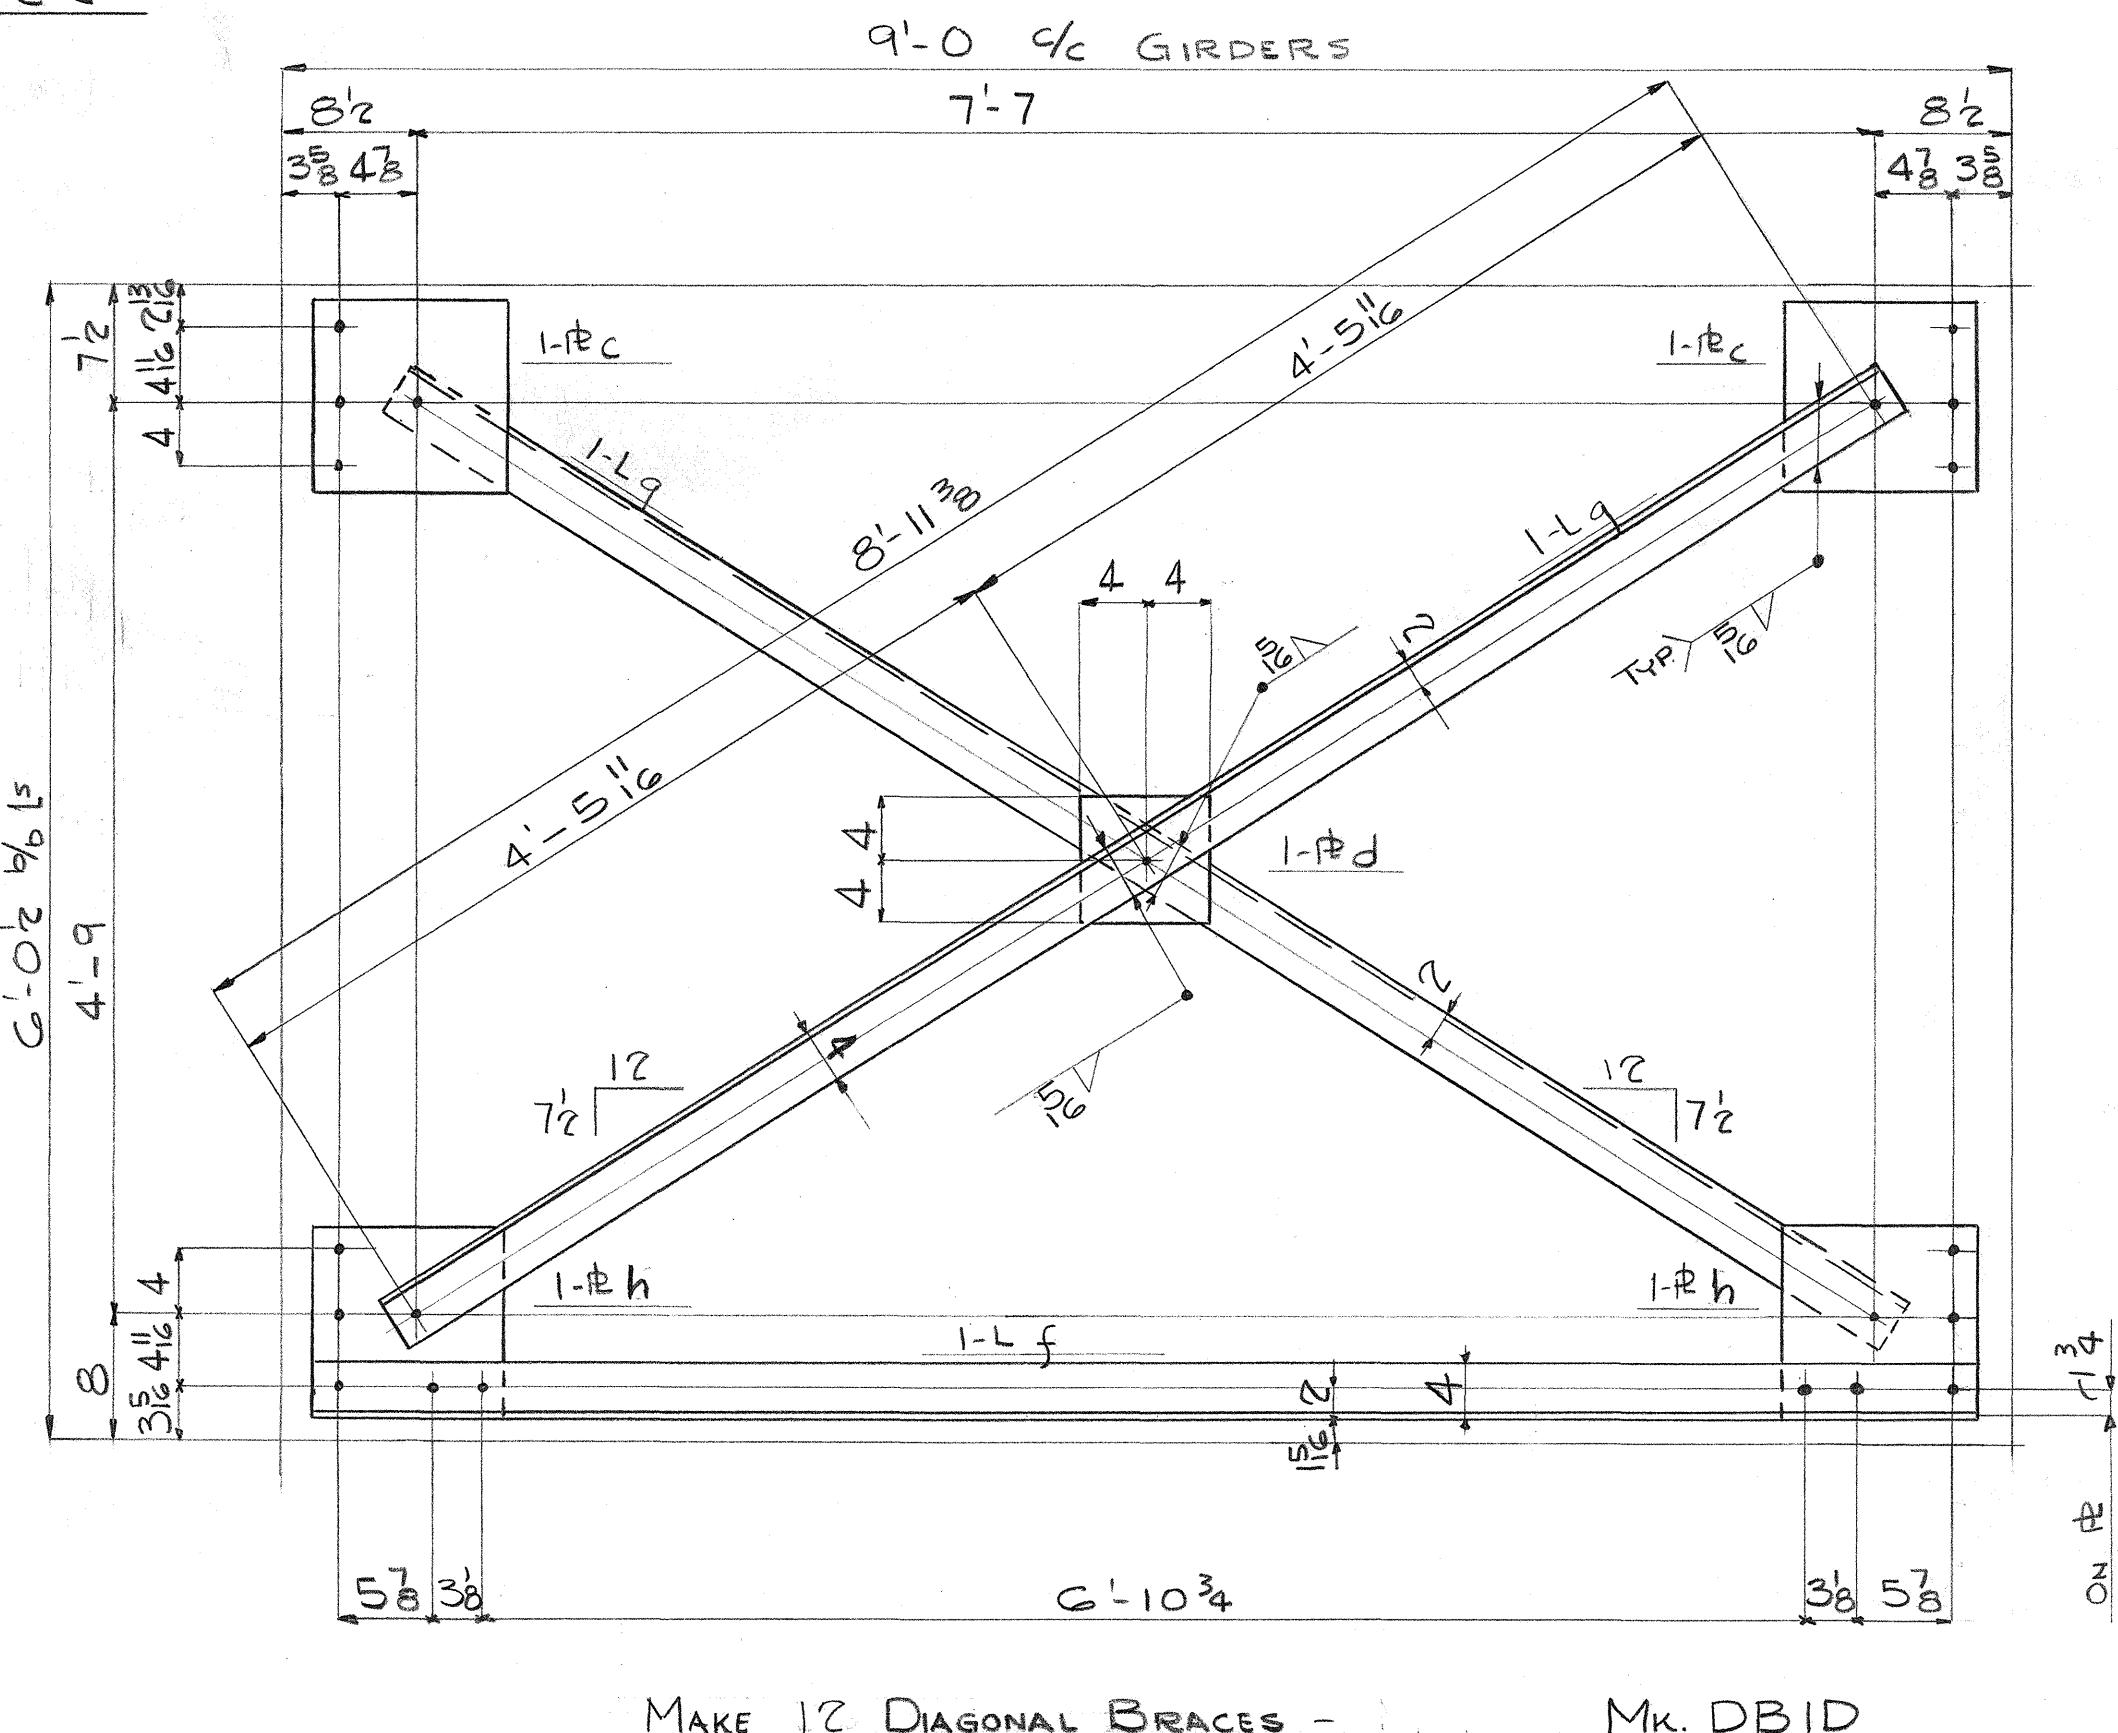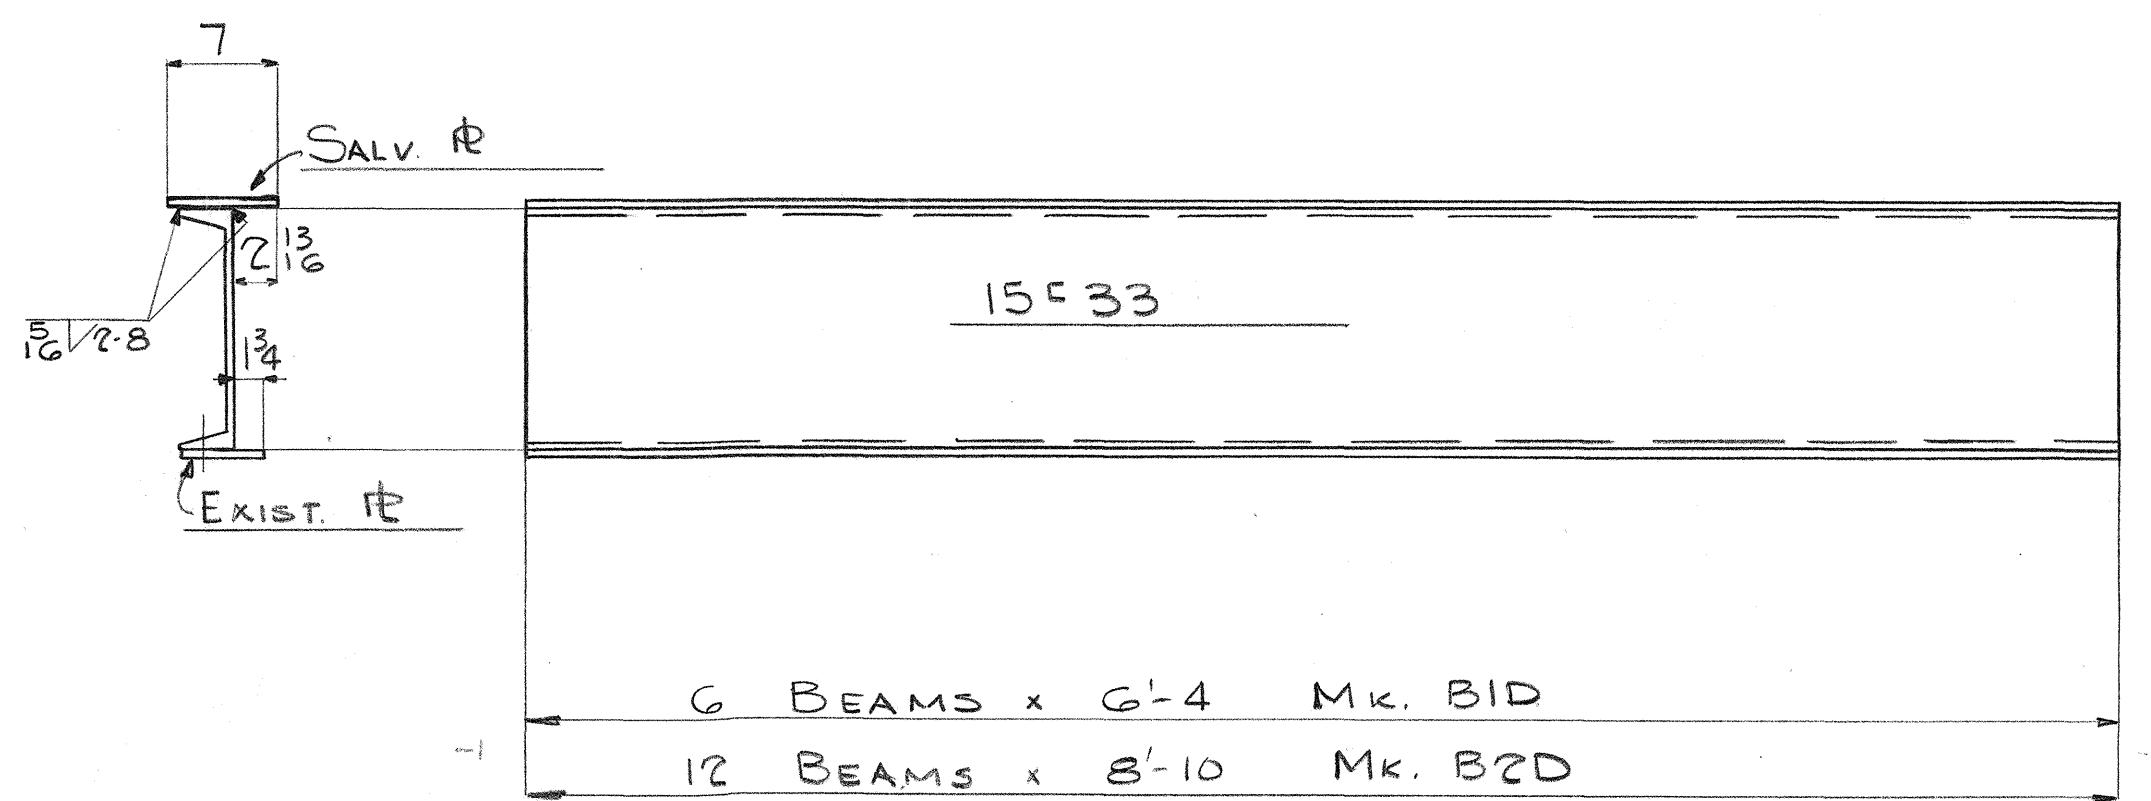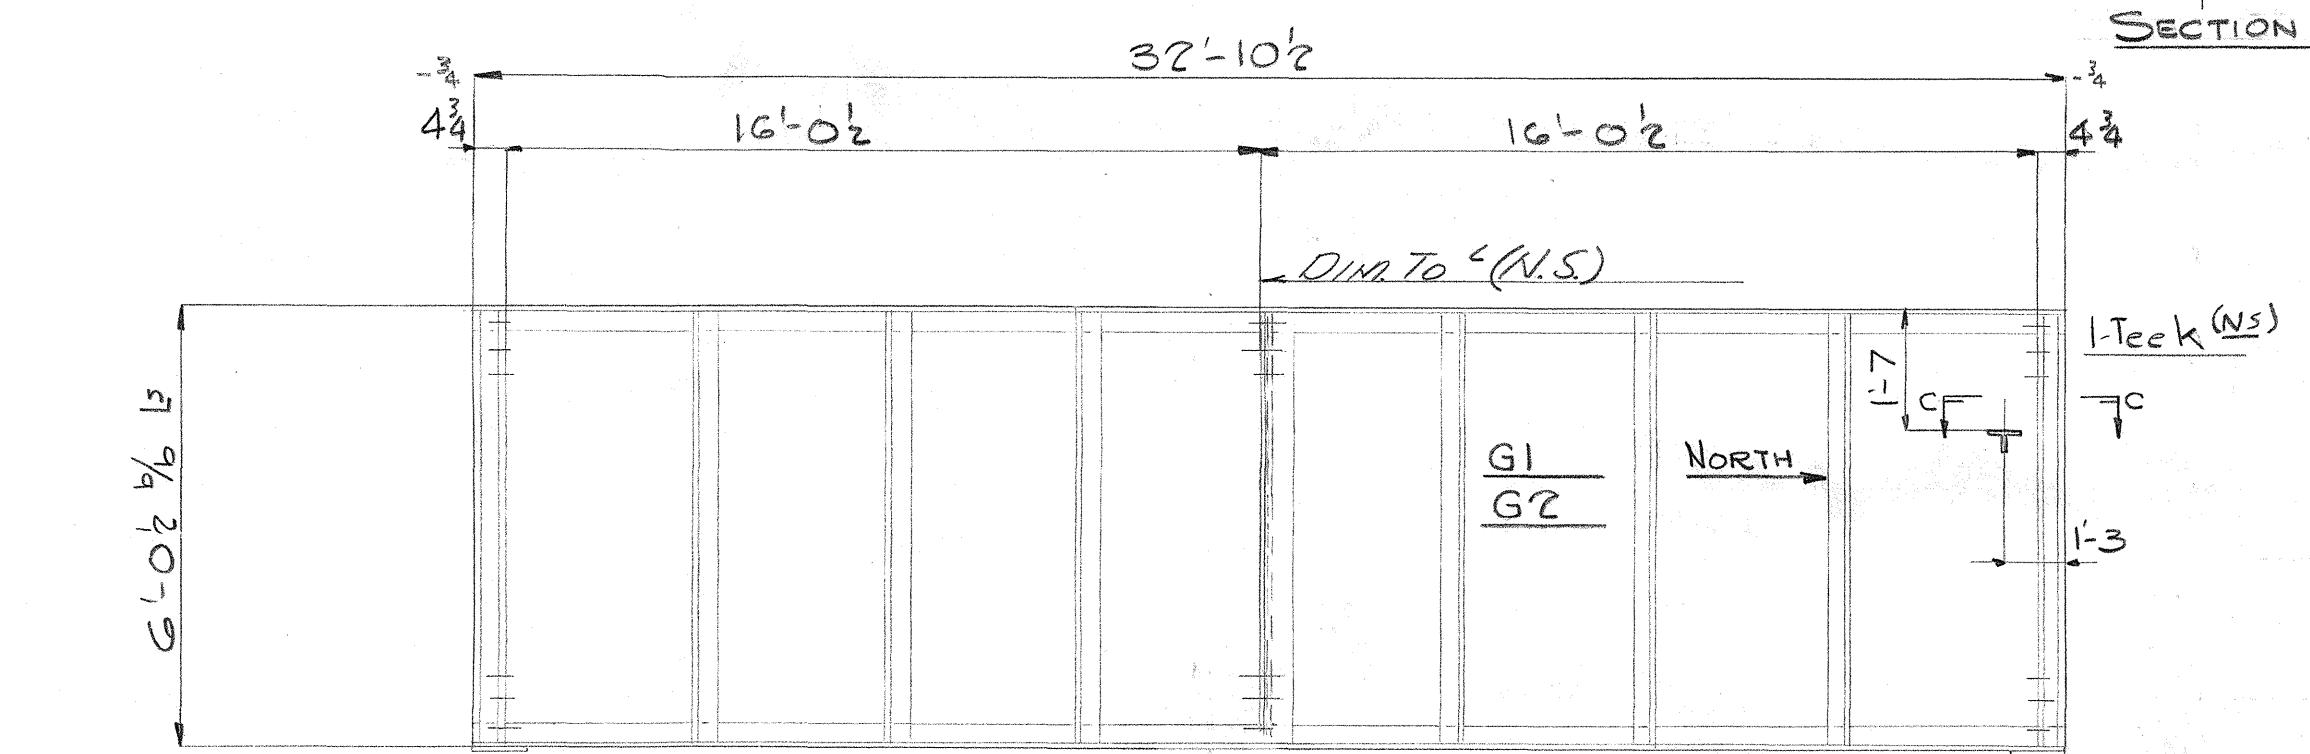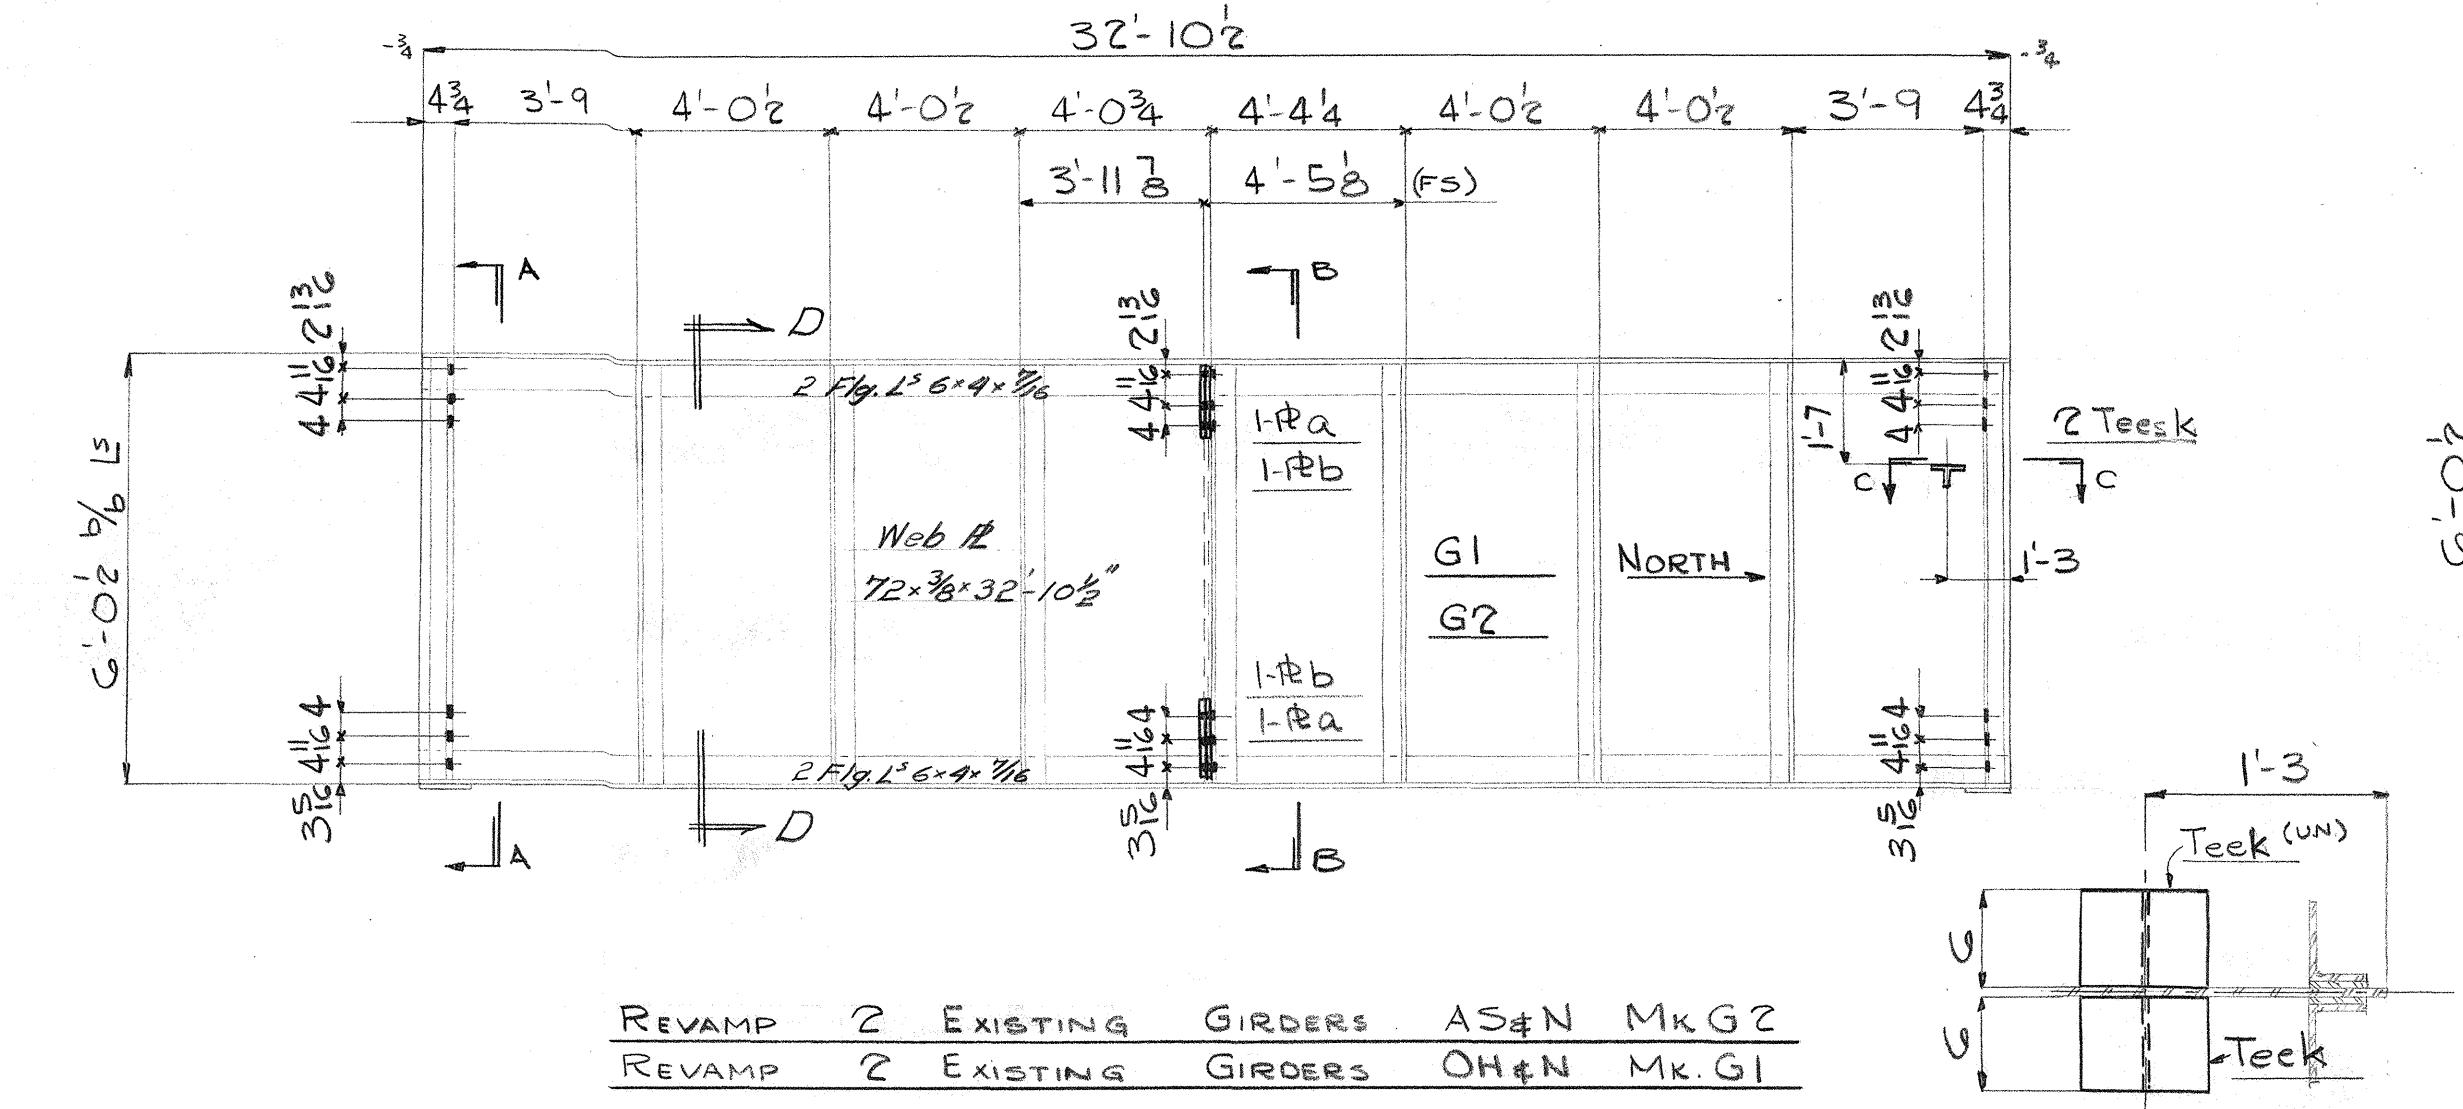

Rivets: 7/8"

Holes: 15/16"

Paint:






INDUSTRIAL DEV. CO.
ADDITION TO THE UMAUMA BRIDGE - HAWAII
INDEPENDENT IRON WORKS, INC. OAKLAND, CALIF.
MADE BY DAL 11-16-49 ORDER NO. 3807
CHECKED BY DW 1/5/50 SHEET NO. D2D

5468.160

FED. ROAD DIST. NO.	STATE	FED. AID PROJ. NO.	FISCAL YEAR	SHEET NO.	TOTAL SHEETS
HAWAII HAWAII DR 3(3)	DR 3(3)	161	304		

## BILL OF MATERIAL INDUS. DEN. CO.

No.	Description	Length Ft.	Length In.	Mark	REMARKS
2	EXISTING GIRDERS	G6&G8			
	REVAMP AS ON DET'L.				
2	EXISTING GIRDERS	G5&G7			
	REVAMP AS ON DET'L.				
2	SALVAGE GIRDERS	G5&G6	To BE TAKEN		
	REVAMP AS ON DET'L.		FROM THE		
2	SALVAGE GIRDERS	G7&G8	KOLEKO'E		
	REVAMP AS ON DET'L.		BRIDGE		
4	PB G x 3/8	0	10	a	Temp New
4	PB G x 3/8	0	10	b	
2	PB G x 3/8	0	9 3/8	c	
12	PB 3 x 4	0	11 3/4	d	
6	STG w 22.5	0	6	f	Plain

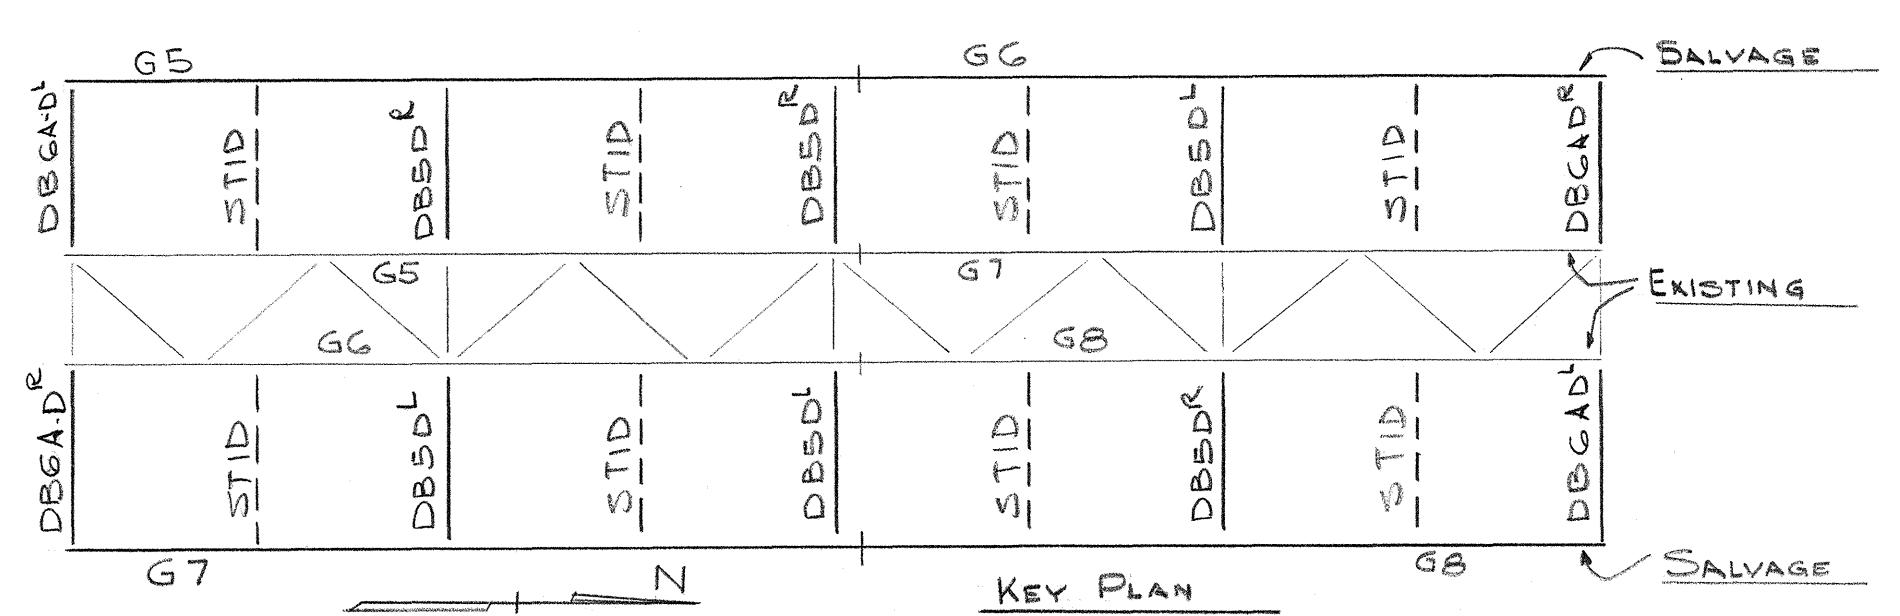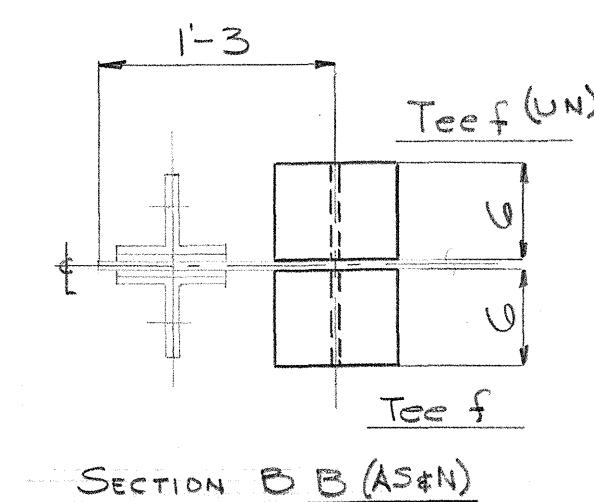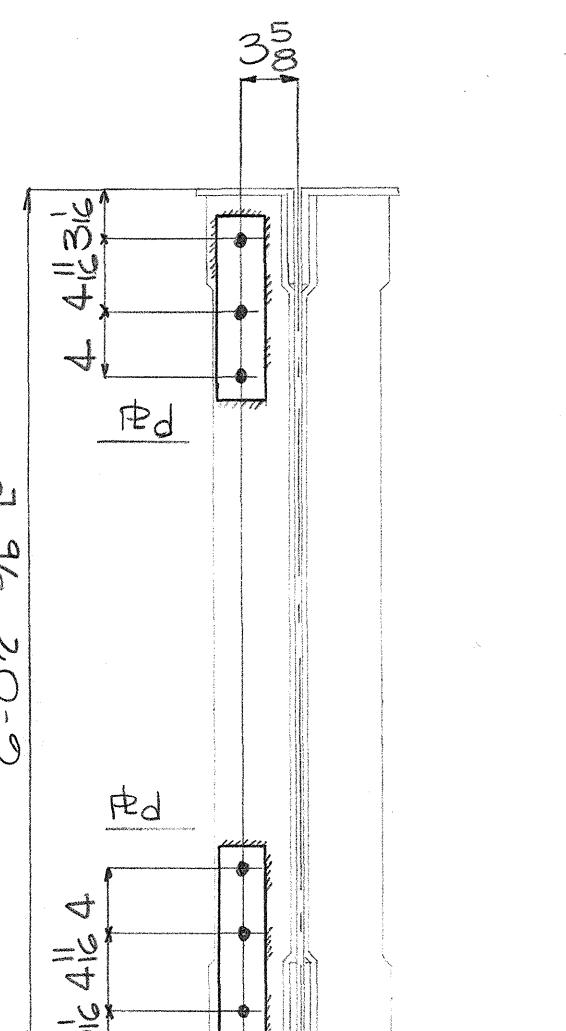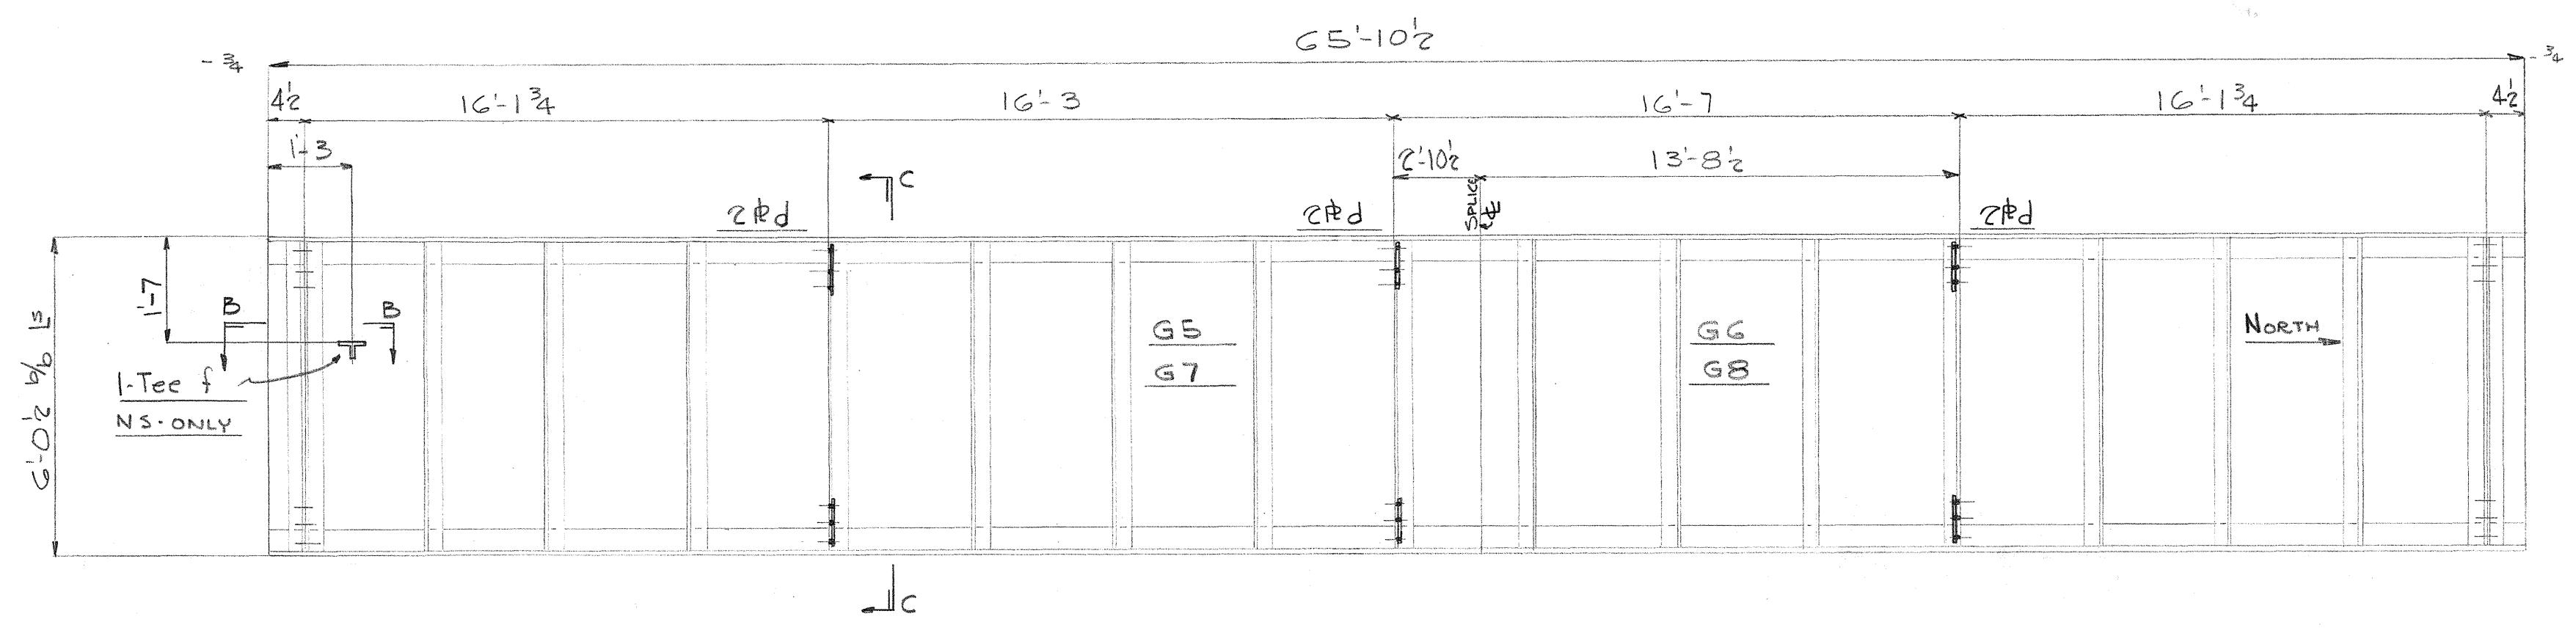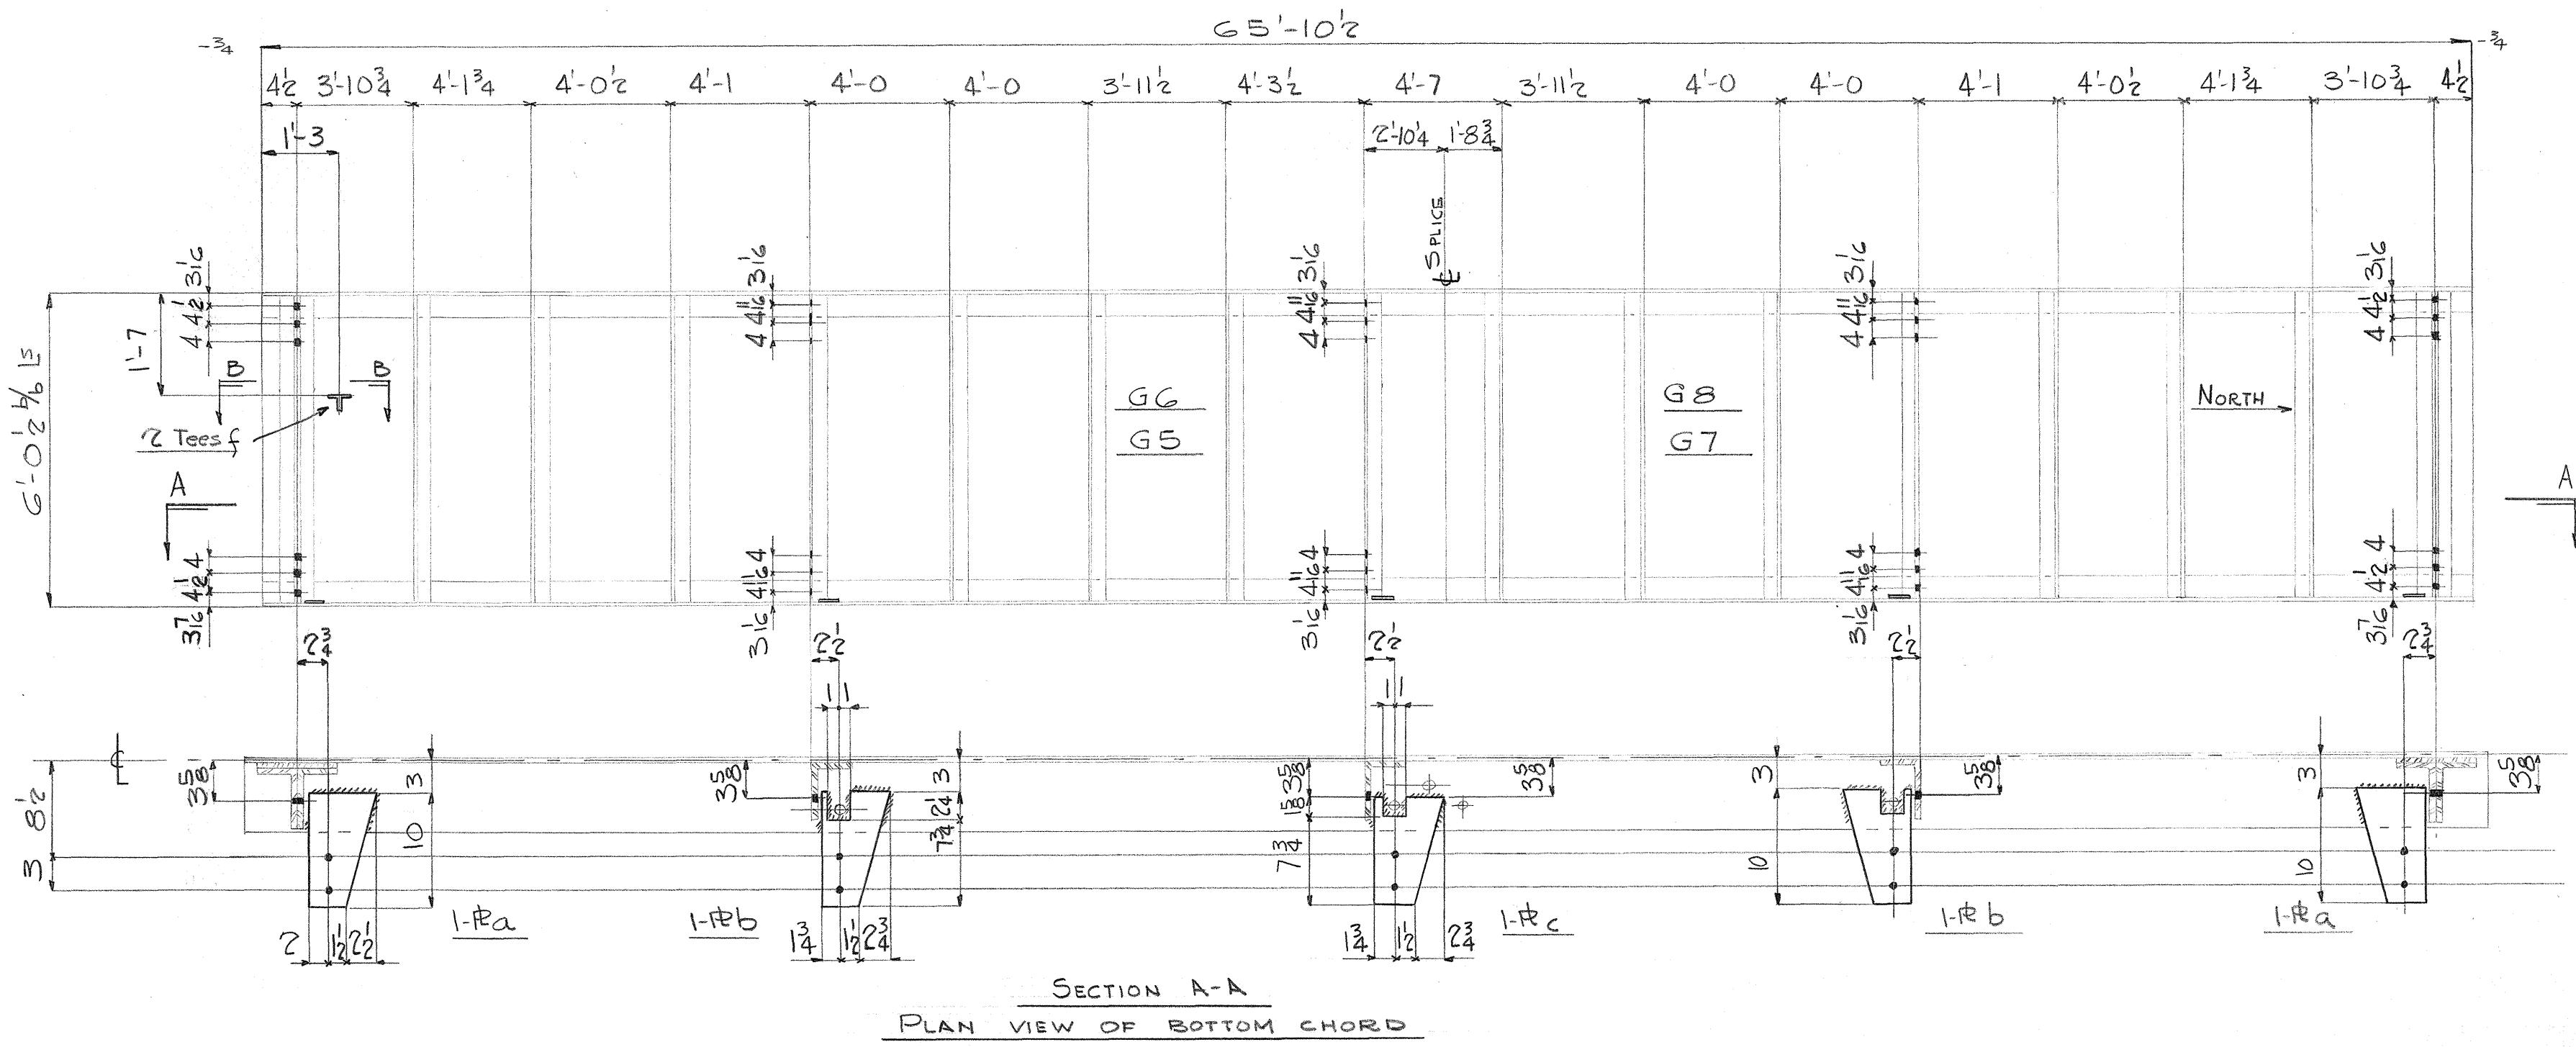

Rivets:	7 3/8			
Holes:	15 3/8			
Paint:				
INDUSTRIAL DEVELOPMENT CO.				
ADDITION TO UMAUMA BRIDGE				
HAWAII				
INDEPENDENT IRON WORKS, INC.				
OAKLAND, CALIF.				
MADE BY	DAL	11-17-49	ORDER NO.	3807
CHECKED BY	O.D.	1-5-50	SHEET NO.	D30








5468.161

FED. ROAD	STATE	FED. AID	FISCAL YEAR	SHEET NO.	TOTAL SHEETS
HAWAII	HAWAII	SDR 3(3)	1950	160	304

## INDUSTRIAL DEVELOPMENT COMPANY

## BILL OF MATERIAL

No.	Description	Length Ft. In.	Mark	REMARKS
2	EXISTING GIRDERS AS ON DET'L.	G12 & G14		
2	EXISTING GIRDERS G11 & G13			REVAMP AS ON DET'L.
2	SALVAGE GIRDERS G23&G21			FROM THE KOLE KOLE
2	SALVAGE GIRDERS G20&G14			REVAMP AS ON DET'L. BRIDGE
4	Tee Gw 225	0 G a	Plain New	
2	Tee Gw 225	0 G b	Temp	Do
4	R 3 x 1/2	0 11 3/4 C	Do	
2	R 4 3/8 x 3/4	5 11 3/8 d	Plain	
2	R 4 3/8 x 3/4	5 11 3/8 f	Plain	
4	R 10 x 96	5 04 g	Plain	
4	R 5 x 3/8	5 11 3/8 h	Plain	
2	R 12 x 3/4	1 3 k	Temp	

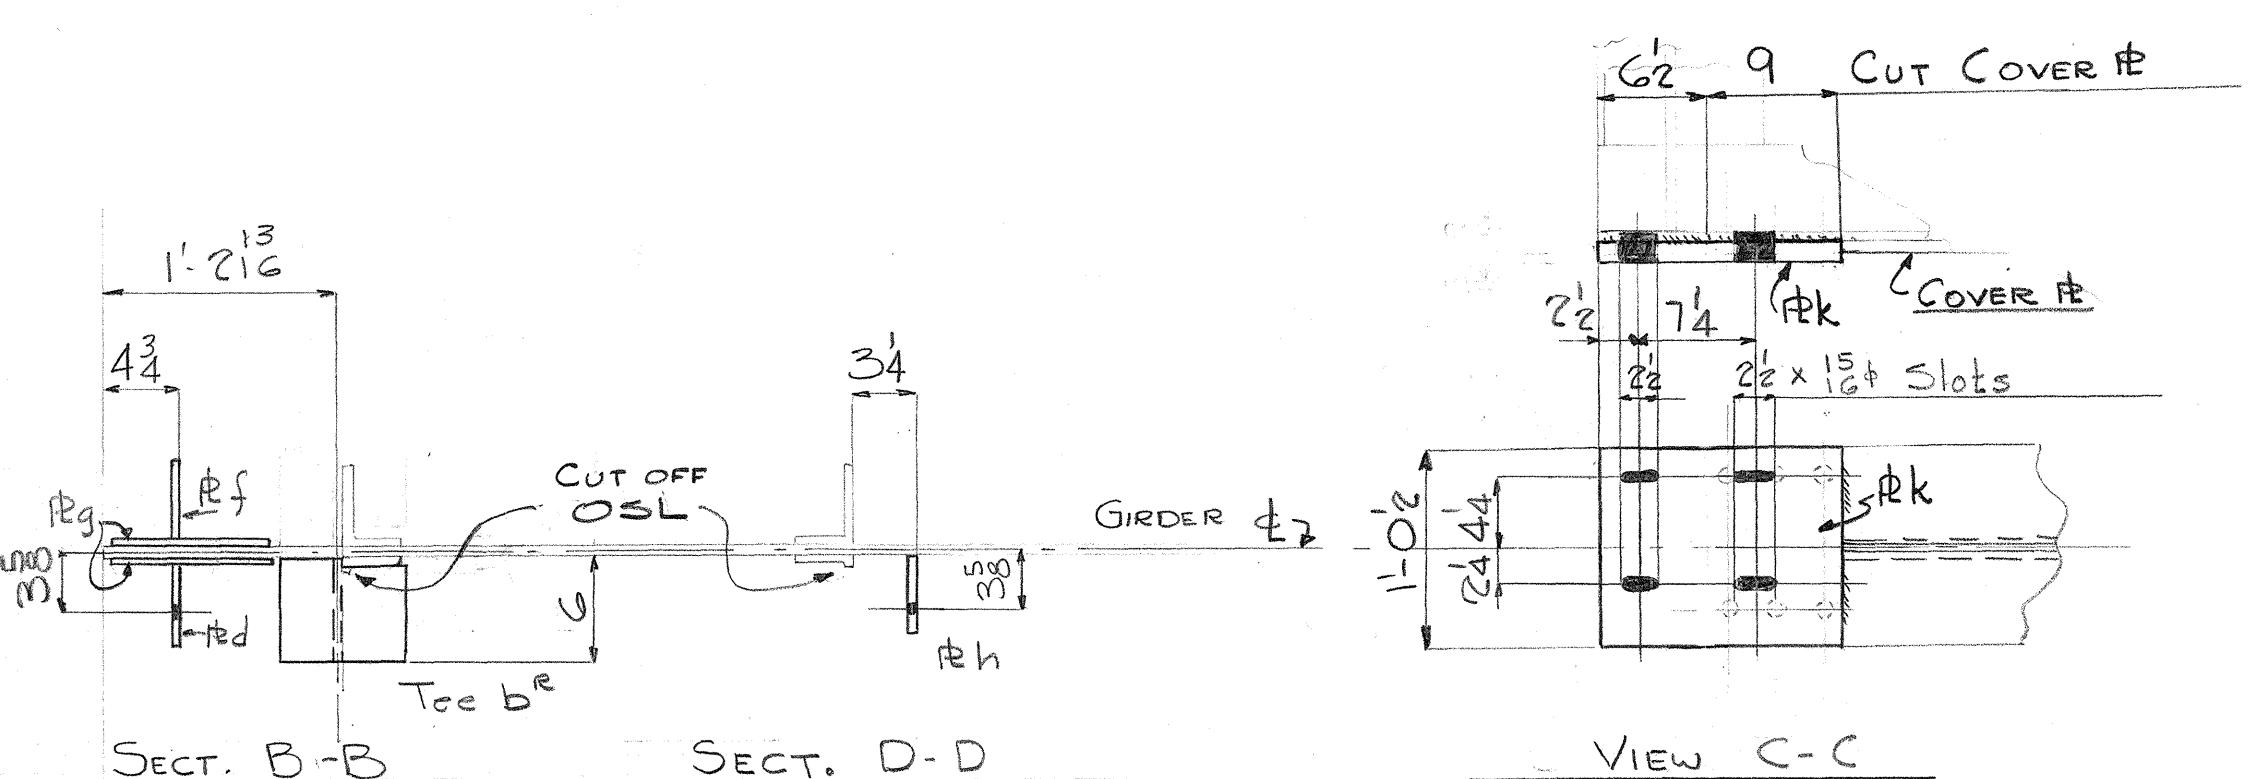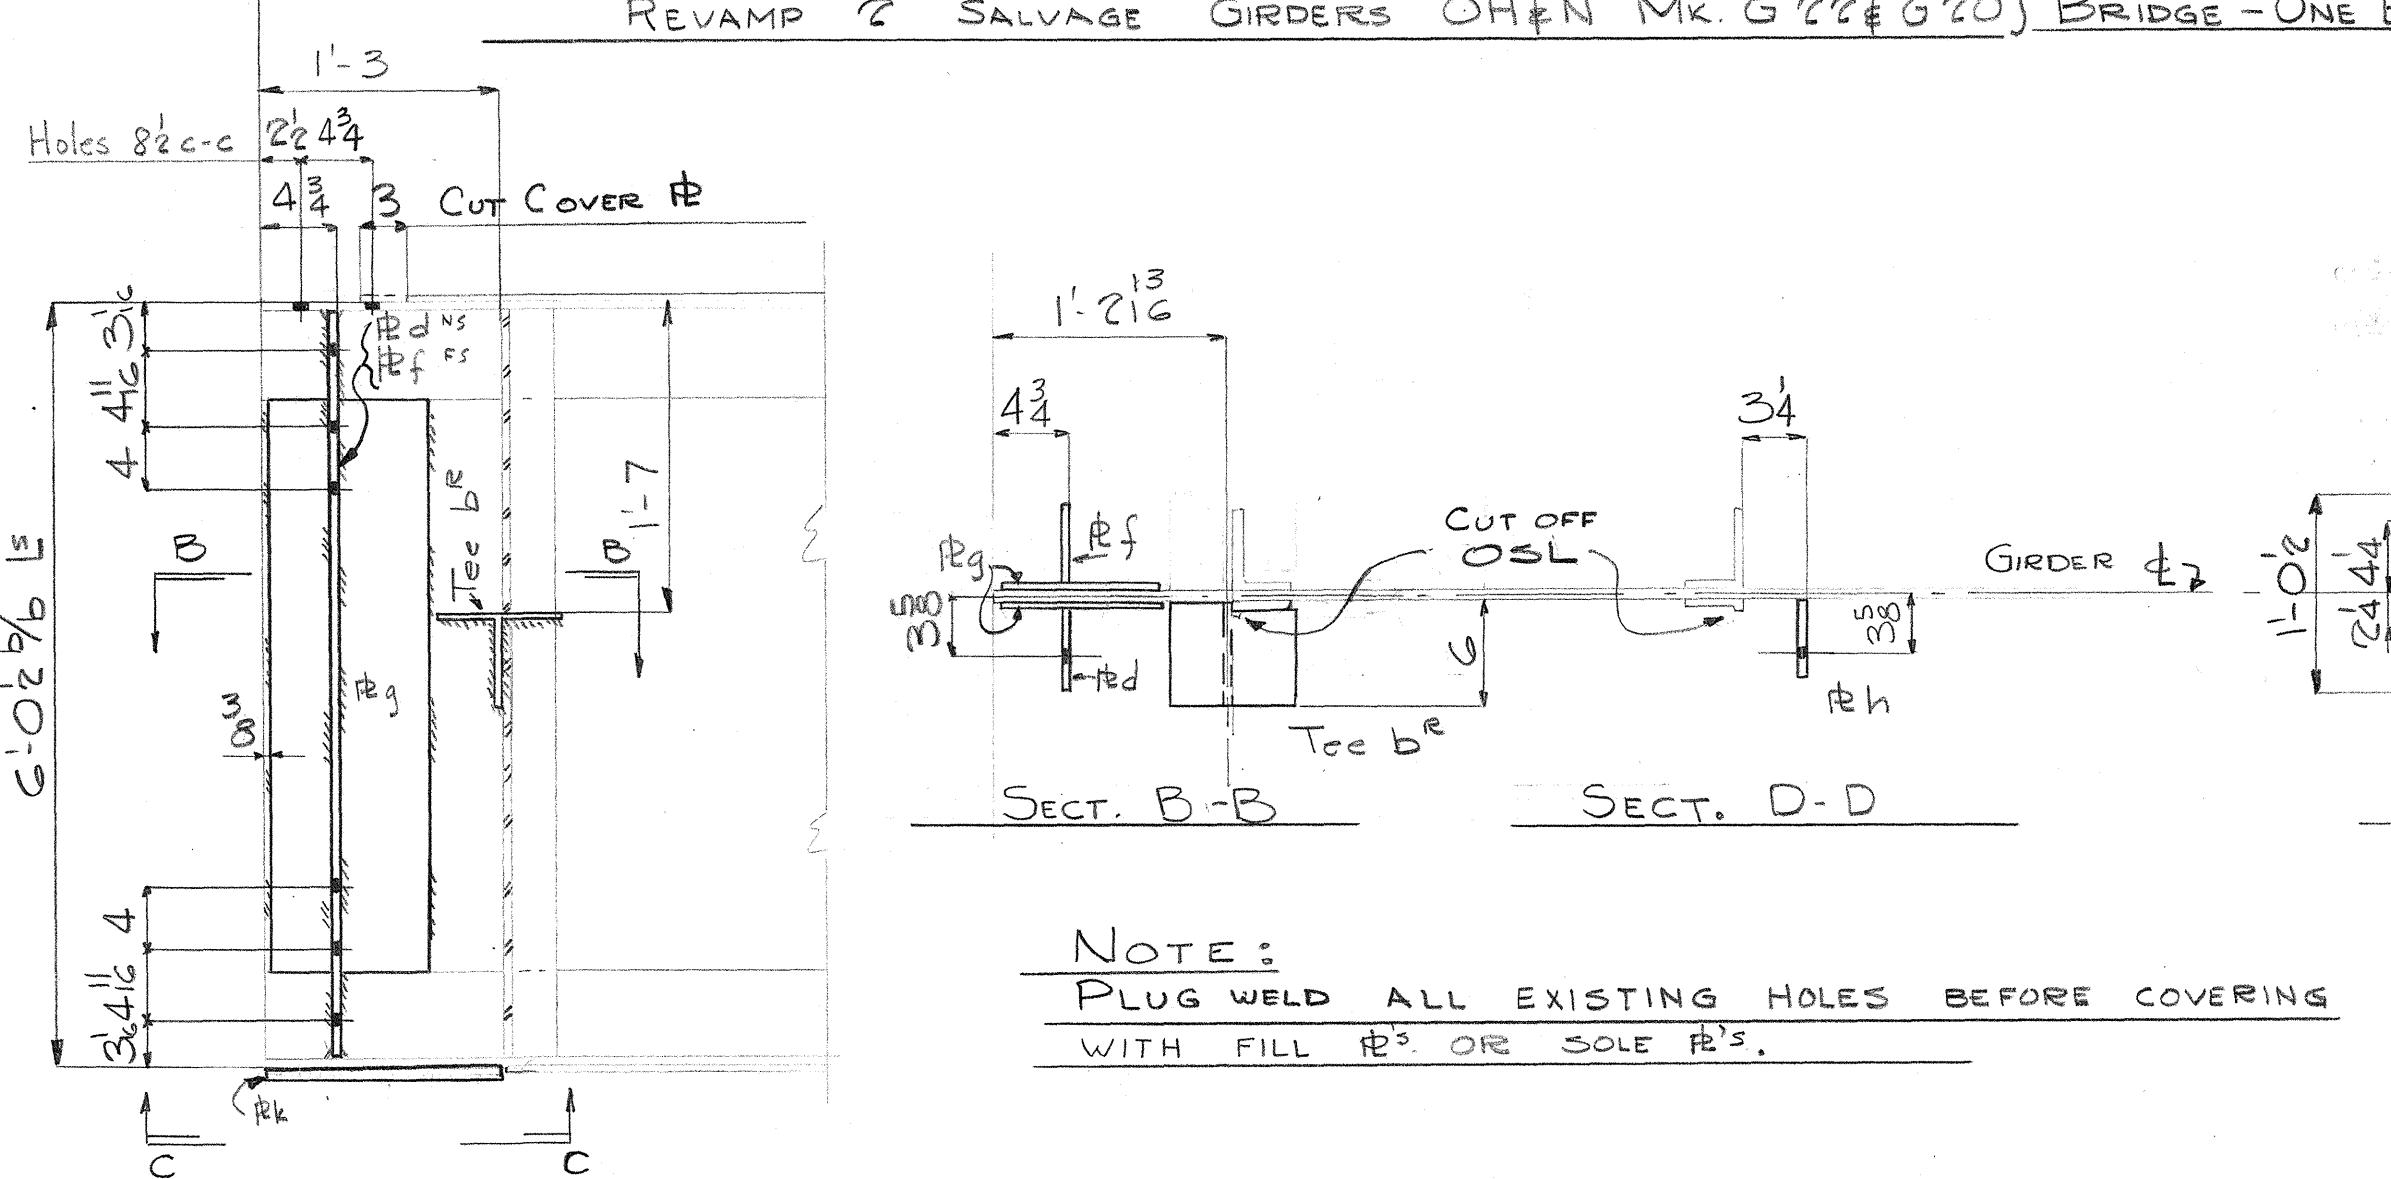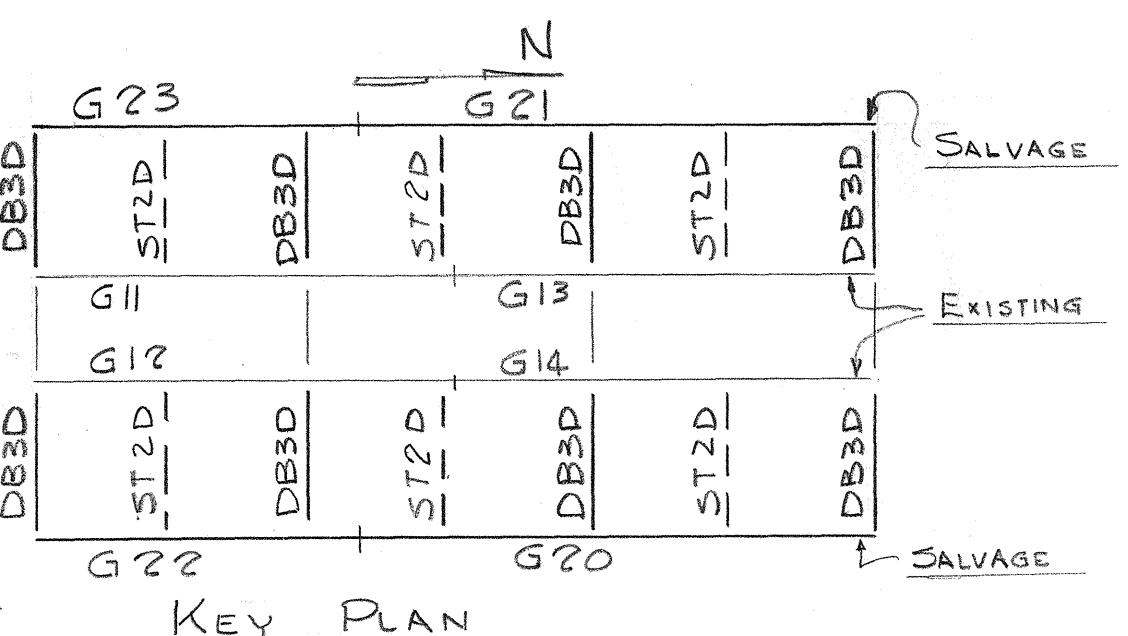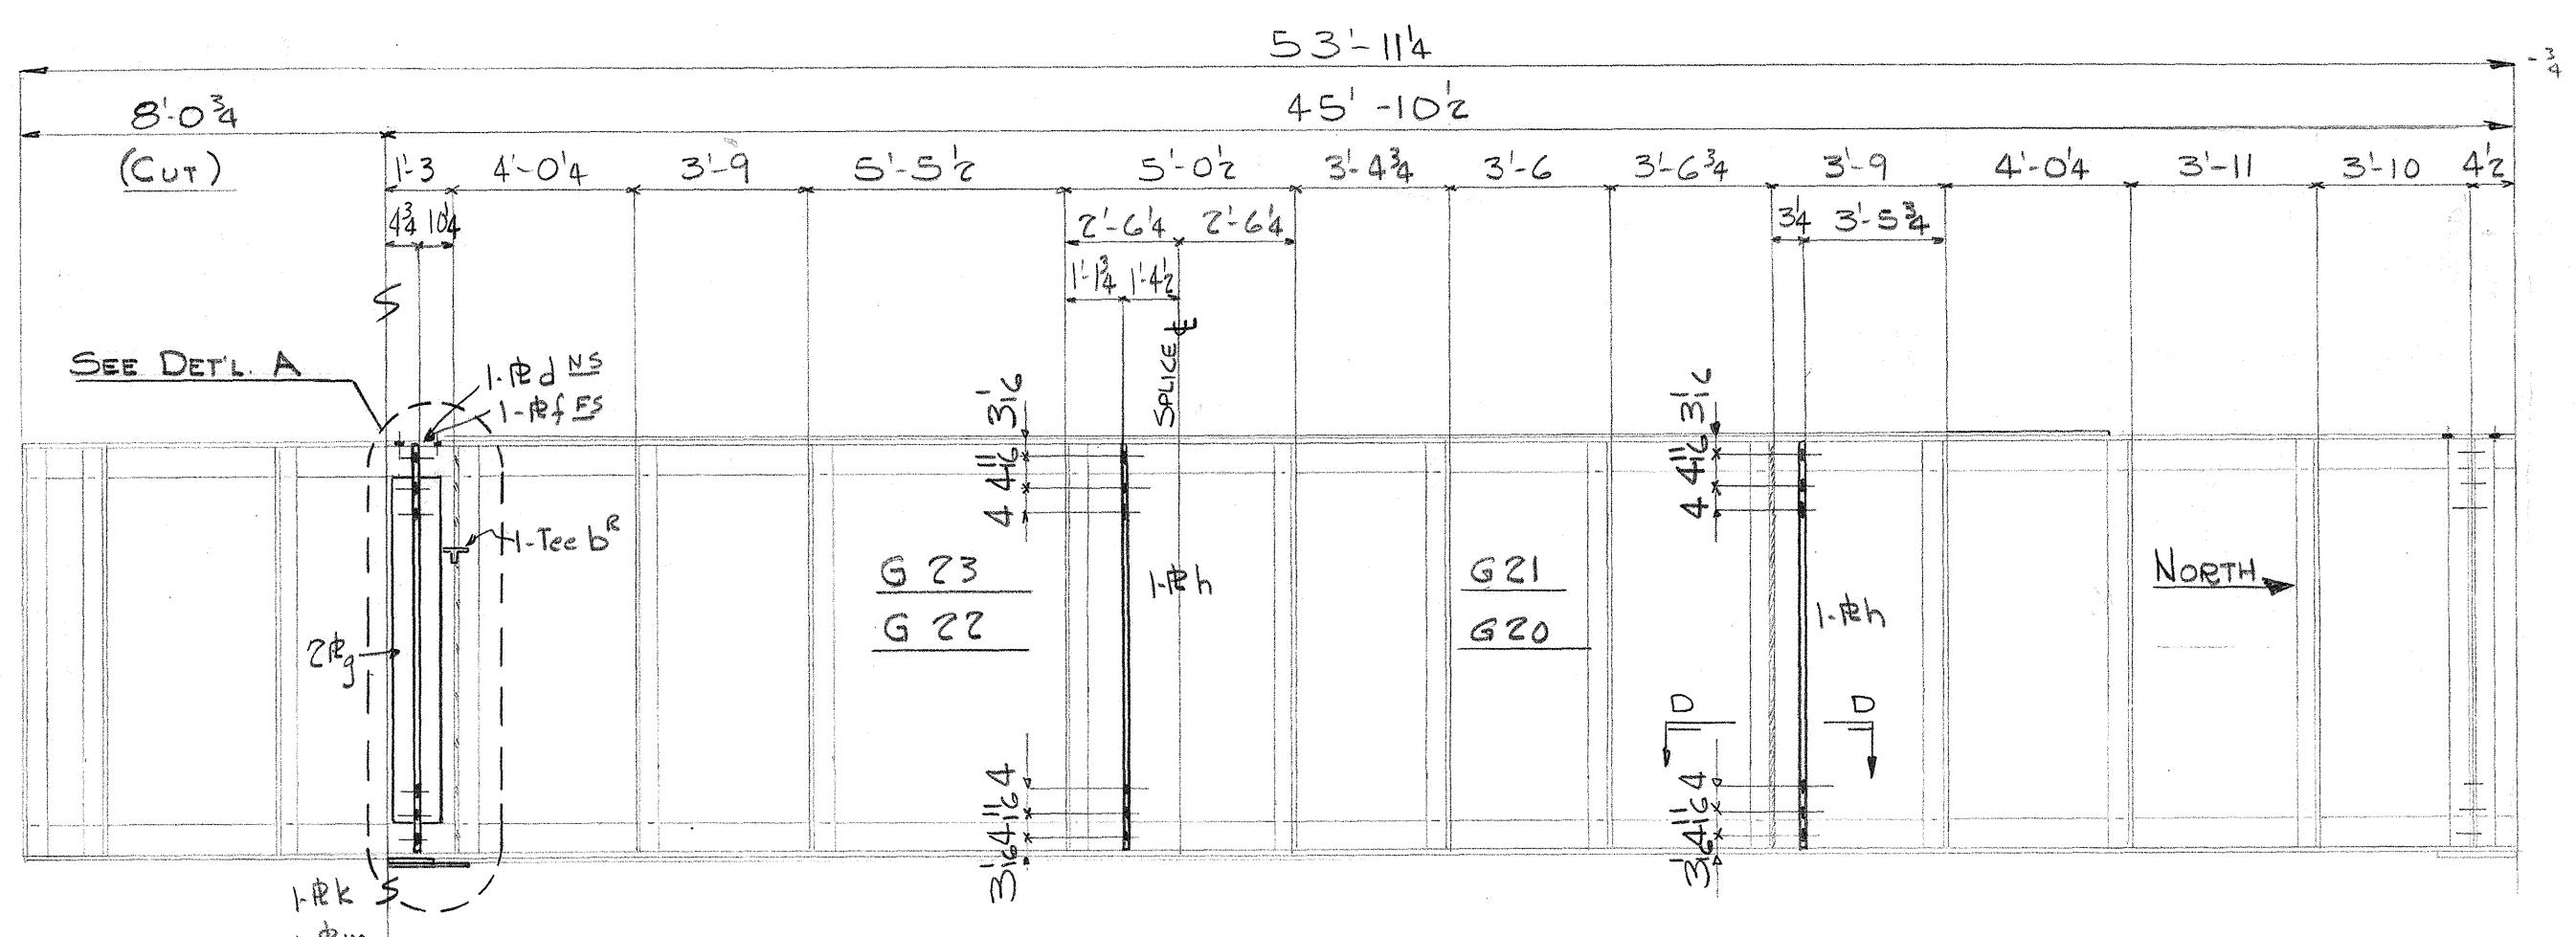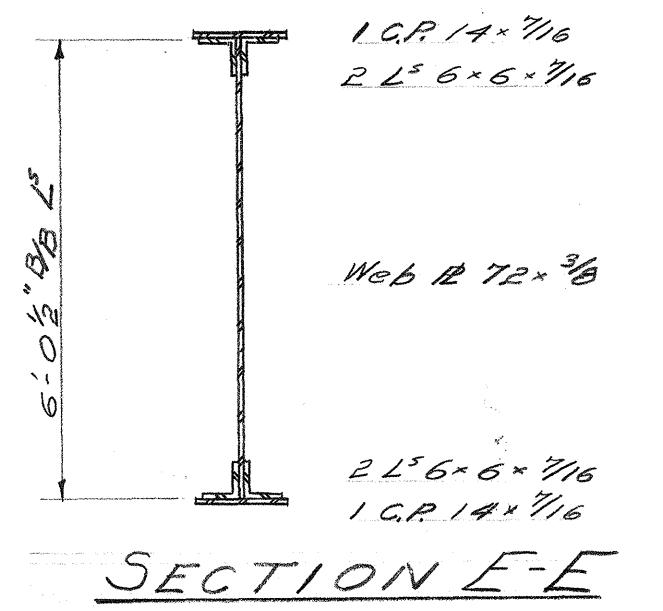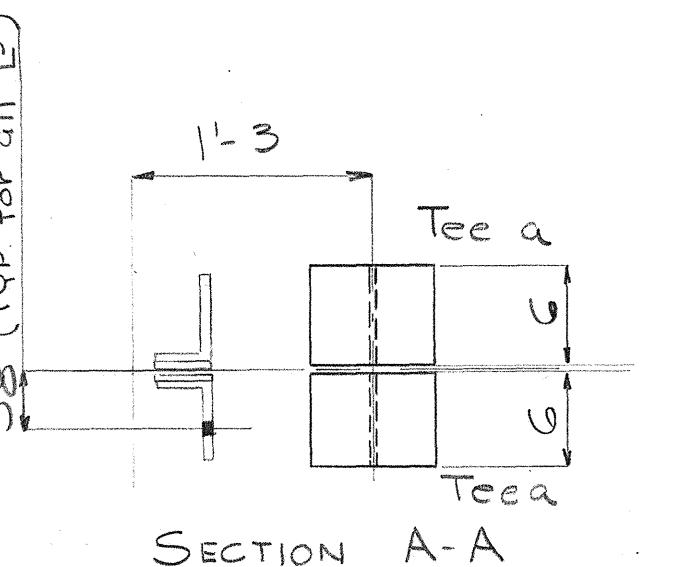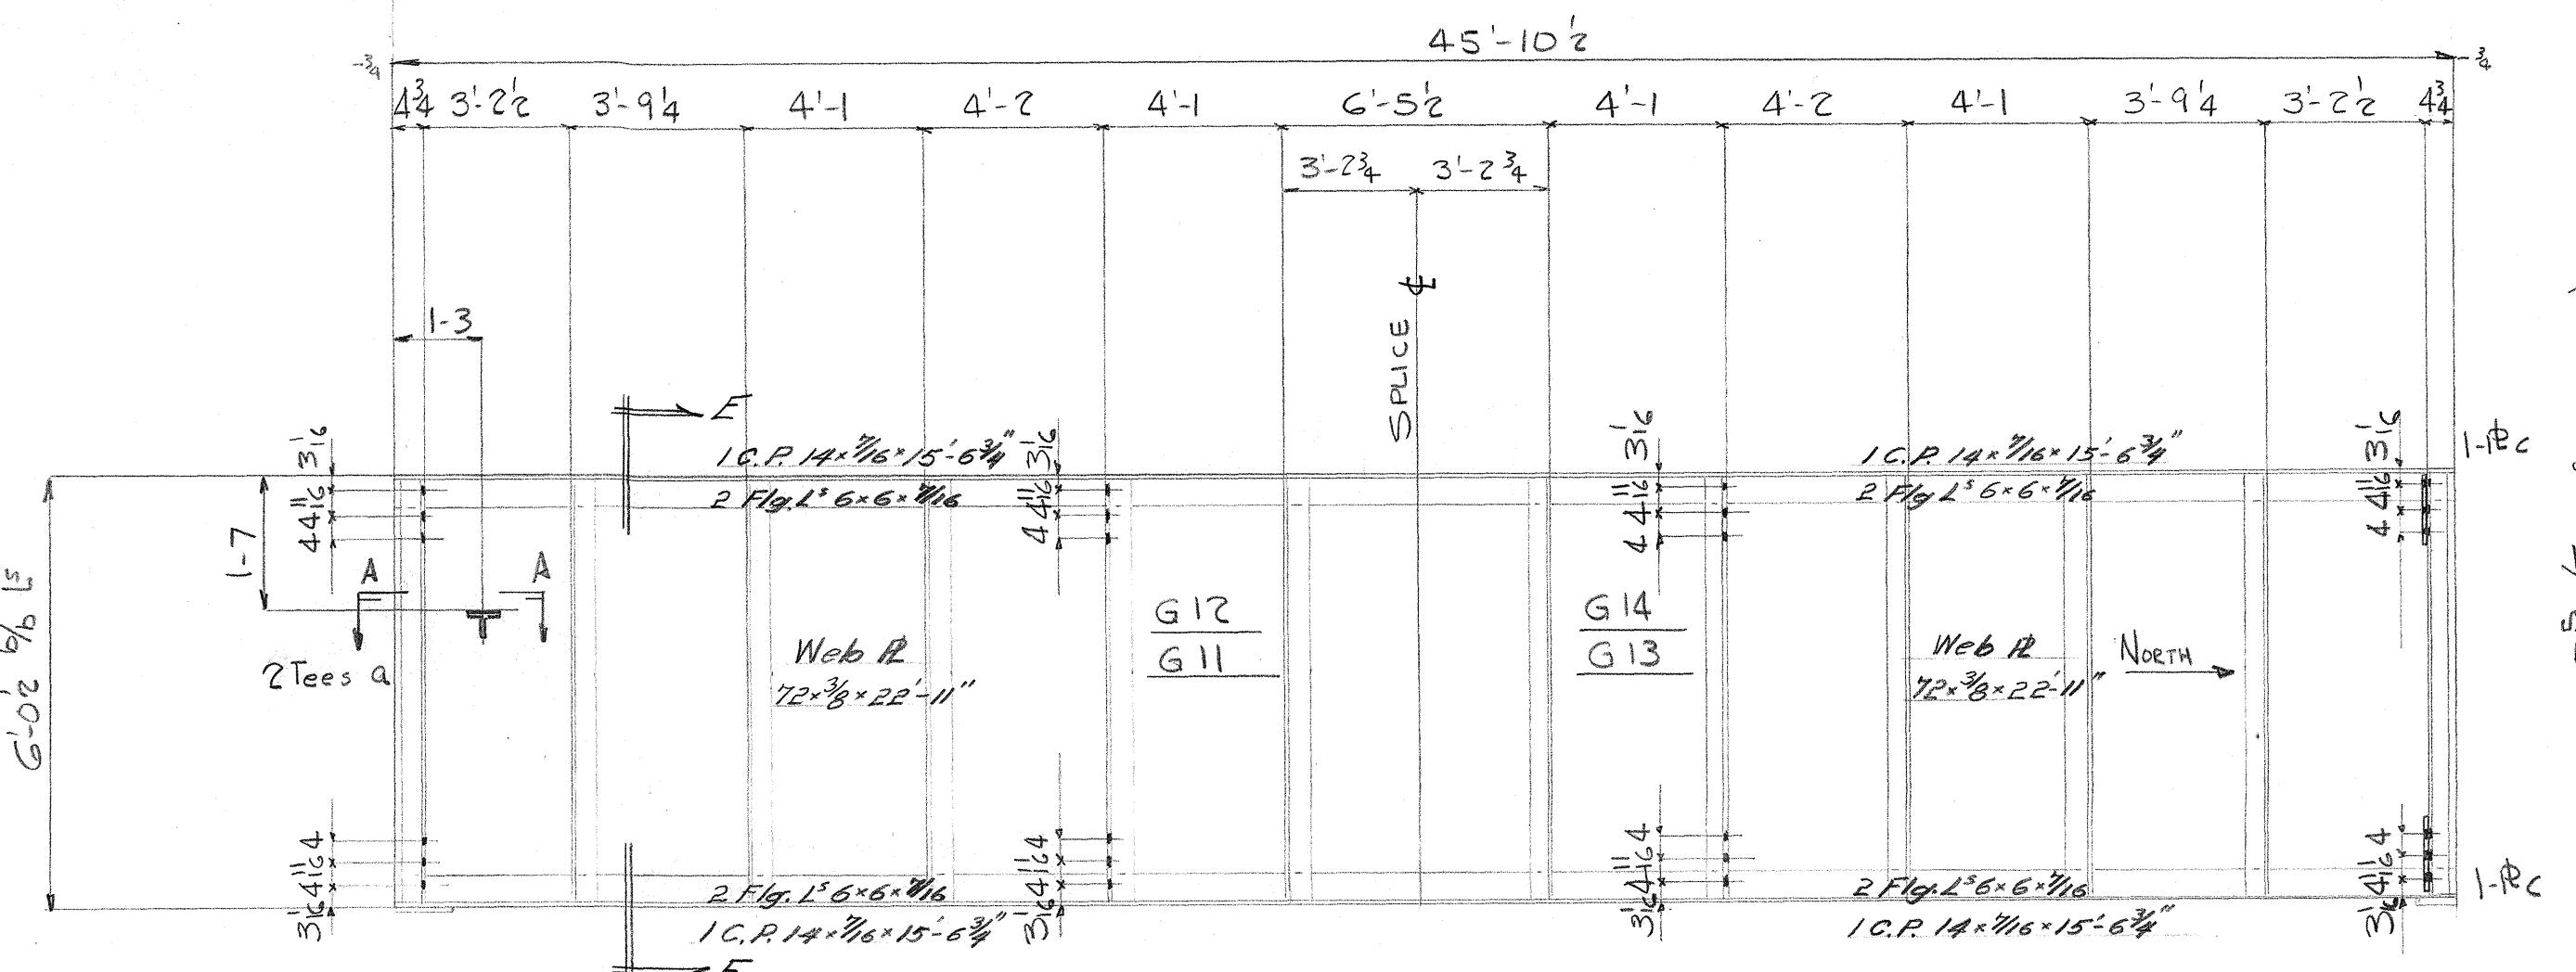

Rivets: 7/8"

Holes: 1 1/2" U.N.

Paint:

INDUSTRIAL DEVELOPMENT CO.  
ADDITION TO UMAUMA BRIDGE  
HAWAII

INDEPENDENT IRON WORKS, INC.  
OAKLAND, CALIF.

MADE BY DAL 11-18-49 ORDER NO. 3807  
CHECKED BY OP 1/6/50 SHEET NO. D4D

5468.162 29/100





FED. ROAD DIST. NO.	STATE	FEB. AID PROJ. NO.	FISCAL YEAR	SHEET NO.	TOTAL SHEETS
HAWAII	Haw	SDR 3(3)	1950	165	304

MATERIAL REQD. FOR DIAG.  
BRACES & STRUTS LISTED BELOW

NRATL. LISTED BELOW IS TO BE USED  
FOR STRUTS & DIAG. BRACES (ALL NRATL. REVAN PEG)

No.	SIZE	LENGTH	MARL	SHNQ.	No.	Fe. MK.	SIZE	LENGTH	BRIDGE	SHNQ.
2	" 4x4x38	8 6 <sup>1</sup> / <sub>4</sub>	ST3D	D1-D-1	T4	2- <sup>65</sup> 4x4x38	8 6	LAUPAHOEHOE	5	
12	15" ls	8 10	B2-D D2-D-1	C5	15" COL.	44 6 <sup>3</sup> / <sub>4</sub>	KAWALII	27		
				-1	C7	Do.	27 3 <sup>3</sup> / <sub>4</sub>	Do.	29	
6	15 F33	6 4	B1D	7 -1	C3	15" COL.	23 3 <sup>1</sup> / <sub>2</sub>	HONOLII	9	
22	" 4x3x <sup>3</sup> / <sub>8</sub>	8 10	ST1D	9	-2	TB3	2- <sup>65</sup> 4x3x38	10 6 <sup>3</sup> / <sub>4</sub>	LAUPAHOEHOE	27
				9	-2	TB1	Do.	16 3 <sup>3</sup> / <sub>8</sub>	Do.	27
				9	-1	TB5	2- <sup>65</sup> 4x3x5 <sup>1</sup> / <sub>6</sub>	9 11 <sup>3</sup> / <sub>8</sub>	Do.	27
				9	-1	TB6	Do.	16 8 <sup>4</sup> / <sub>5</sub>	Do.	27
				9	-1	TB4	Do.	27 3 <sup>3</sup> / <sub>4</sub>	Do.	27
				9	-1	TB7	Do.	26 4 <sup>3</sup> / <sub>4</sub>	Do.	28
				9	-1	TB8	Do.	9 9 <sup>3</sup> / <sub>8</sub>	Do.	28
24	" 4x3x <sup>3</sup> / <sub>8</sub>	9 2 <sup>3</sup> / <sub>8</sub>	9	5	-1	TB9	Do.	16 0 <sup>4</sup> / <sub>5</sub>	Do.	28
				5	-1	TB10	Do.	29 9 <sup>3</sup> / <sub>4</sub>	Do.	28
				5	-1	TB11	Do.	12 5 <sup>3</sup> / <sub>4</sub>	Do.	28
				5	-1	TB12	Do.	16 10 <sup>2</sup> / <sub>3</sub>	Do.	28
				5	-6	TB13	2- <sup>65</sup> 4x3x38	13 9 <sup>3</sup> / <sub>8</sub>	Do.	29
				5	-1	TB16	2- <sup>65</sup> 4x3x5 <sup>1</sup> / <sub>6</sub>	18 11 <sup>3</sup> / <sub>8</sub>	Do.	29
12	" 4x3x5 <sup>1</sup> / <sub>6</sub>	8 7 <sup>3</sup> / <sub>4</sub>	f	1	-3	TB16	Do.	18 11 <sup>3</sup> / <sub>8</sub>	Do.	29
2	" 4x3x5 <sup>1</sup> / <sub>6</sub>	8 7 <sup>3</sup> / <sub>4</sub>	d	D6-D-1	TB18	Do.	10 11 <sup>3</sup> / <sub>8</sub>	Do.	29	
12	" 4x3x5 <sup>1</sup> / <sub>6</sub>	8 7 <sup>3</sup> / <sub>4</sub>	f	L	-1	TB16	Do.	18 11 <sup>3</sup> / <sub>8</sub>	Do.	29
4	L 4x3x5 <sup>1</sup> / <sub>6</sub>	8 7 <sup>3</sup> / <sub>4</sub>	m	L	-2	TB18	Do.	10 11 <sup>3</sup> / <sub>8</sub>	Do.	29
2	" 4x3x5 <sup>1</sup> / <sub>6</sub>	8 7 <sup>3</sup> / <sub>4</sub>	g	7	-3	TB18	Do.	10 11 <sup>3</sup> / <sub>8</sub>	Do.	29
8	" 4x3x5 <sup>1</sup> / <sub>6</sub>	8 7 <sup>3</sup> / <sub>4</sub>	c	7	-4	TB20	Do.	12 6	Do.	30
56	" 4x3x5 <sup>1</sup> / <sub>6</sub>	9 2 <sup>3</sup> / <sub>8</sub>	h	7	-3	TB19	Do.	32 11	Do.	30
				7	-4	TB21	Do.	19 10 <sup>3</sup> / <sub>8</sub>	Do.	30
				7	-2	TB23	Do.	16 4 <sup>3</sup> / <sub>8</sub>	Do.	30
				7	-2	TB24	Do.	22 5 <sup>1</sup> / <sub>2</sub>	Do.	30
				7	-1	TB48	Do.	16 0 <sup>8</sup> / <sub>5</sub>	Do.	31
10	" 4x3x5 <sup>1</sup> / <sub>6</sub>	8 8	ST2-D D5-D-1	7	TB48	Do.	16 0 <sup>8</sup> / <sub>5</sub>	Do.	31	
				7	-1	TB49	Do.	21 7 <sup>4</sup> / <sub>5</sub>	Do.	31
6	" 4x3x5 <sup>1</sup> / <sub>6</sub>	8 7 <sup>3</sup> / <sub>4</sub>	w	7	-1	TB49	Do.	21 7 <sup>4</sup> / <sub>5</sub>	Do.	31
				7	-1	TB25	Do.	21 5 <sup>3</sup> / <sub>8</sub>	Do.	32
12	" 4x3x5 <sup>1</sup> / <sub>6</sub>	9 0 <sup>1</sup> / <sub>2</sub>	aa	7	-2	TB47	Do.	38 0 <sup>3</sup> / <sub>8</sub>	Do.	31

§ 1-35B "4x3x $\frac{5}{16}$ x23'-8'6"

£ 1-36 B " 4 x 3 x 5/16 x 26-5'2

## **BILL OF MATERIAL**


**Rivets:** 78Φ  
**Holes:** 15Φ UN  
**Paint:**

INDUSTRIAL DEV. CO.  
ADDITION TO UMAUMA BRIDGE  
HAWAII

# INDEPENDENT IRON WORKS, INC. OAKLAND, CALIF.

MADE BY	DW	12-6-49	ORDER NO.	3807
CHECKED BY	V	1-6-50	SHEET NO.	07D


5-4-65-165

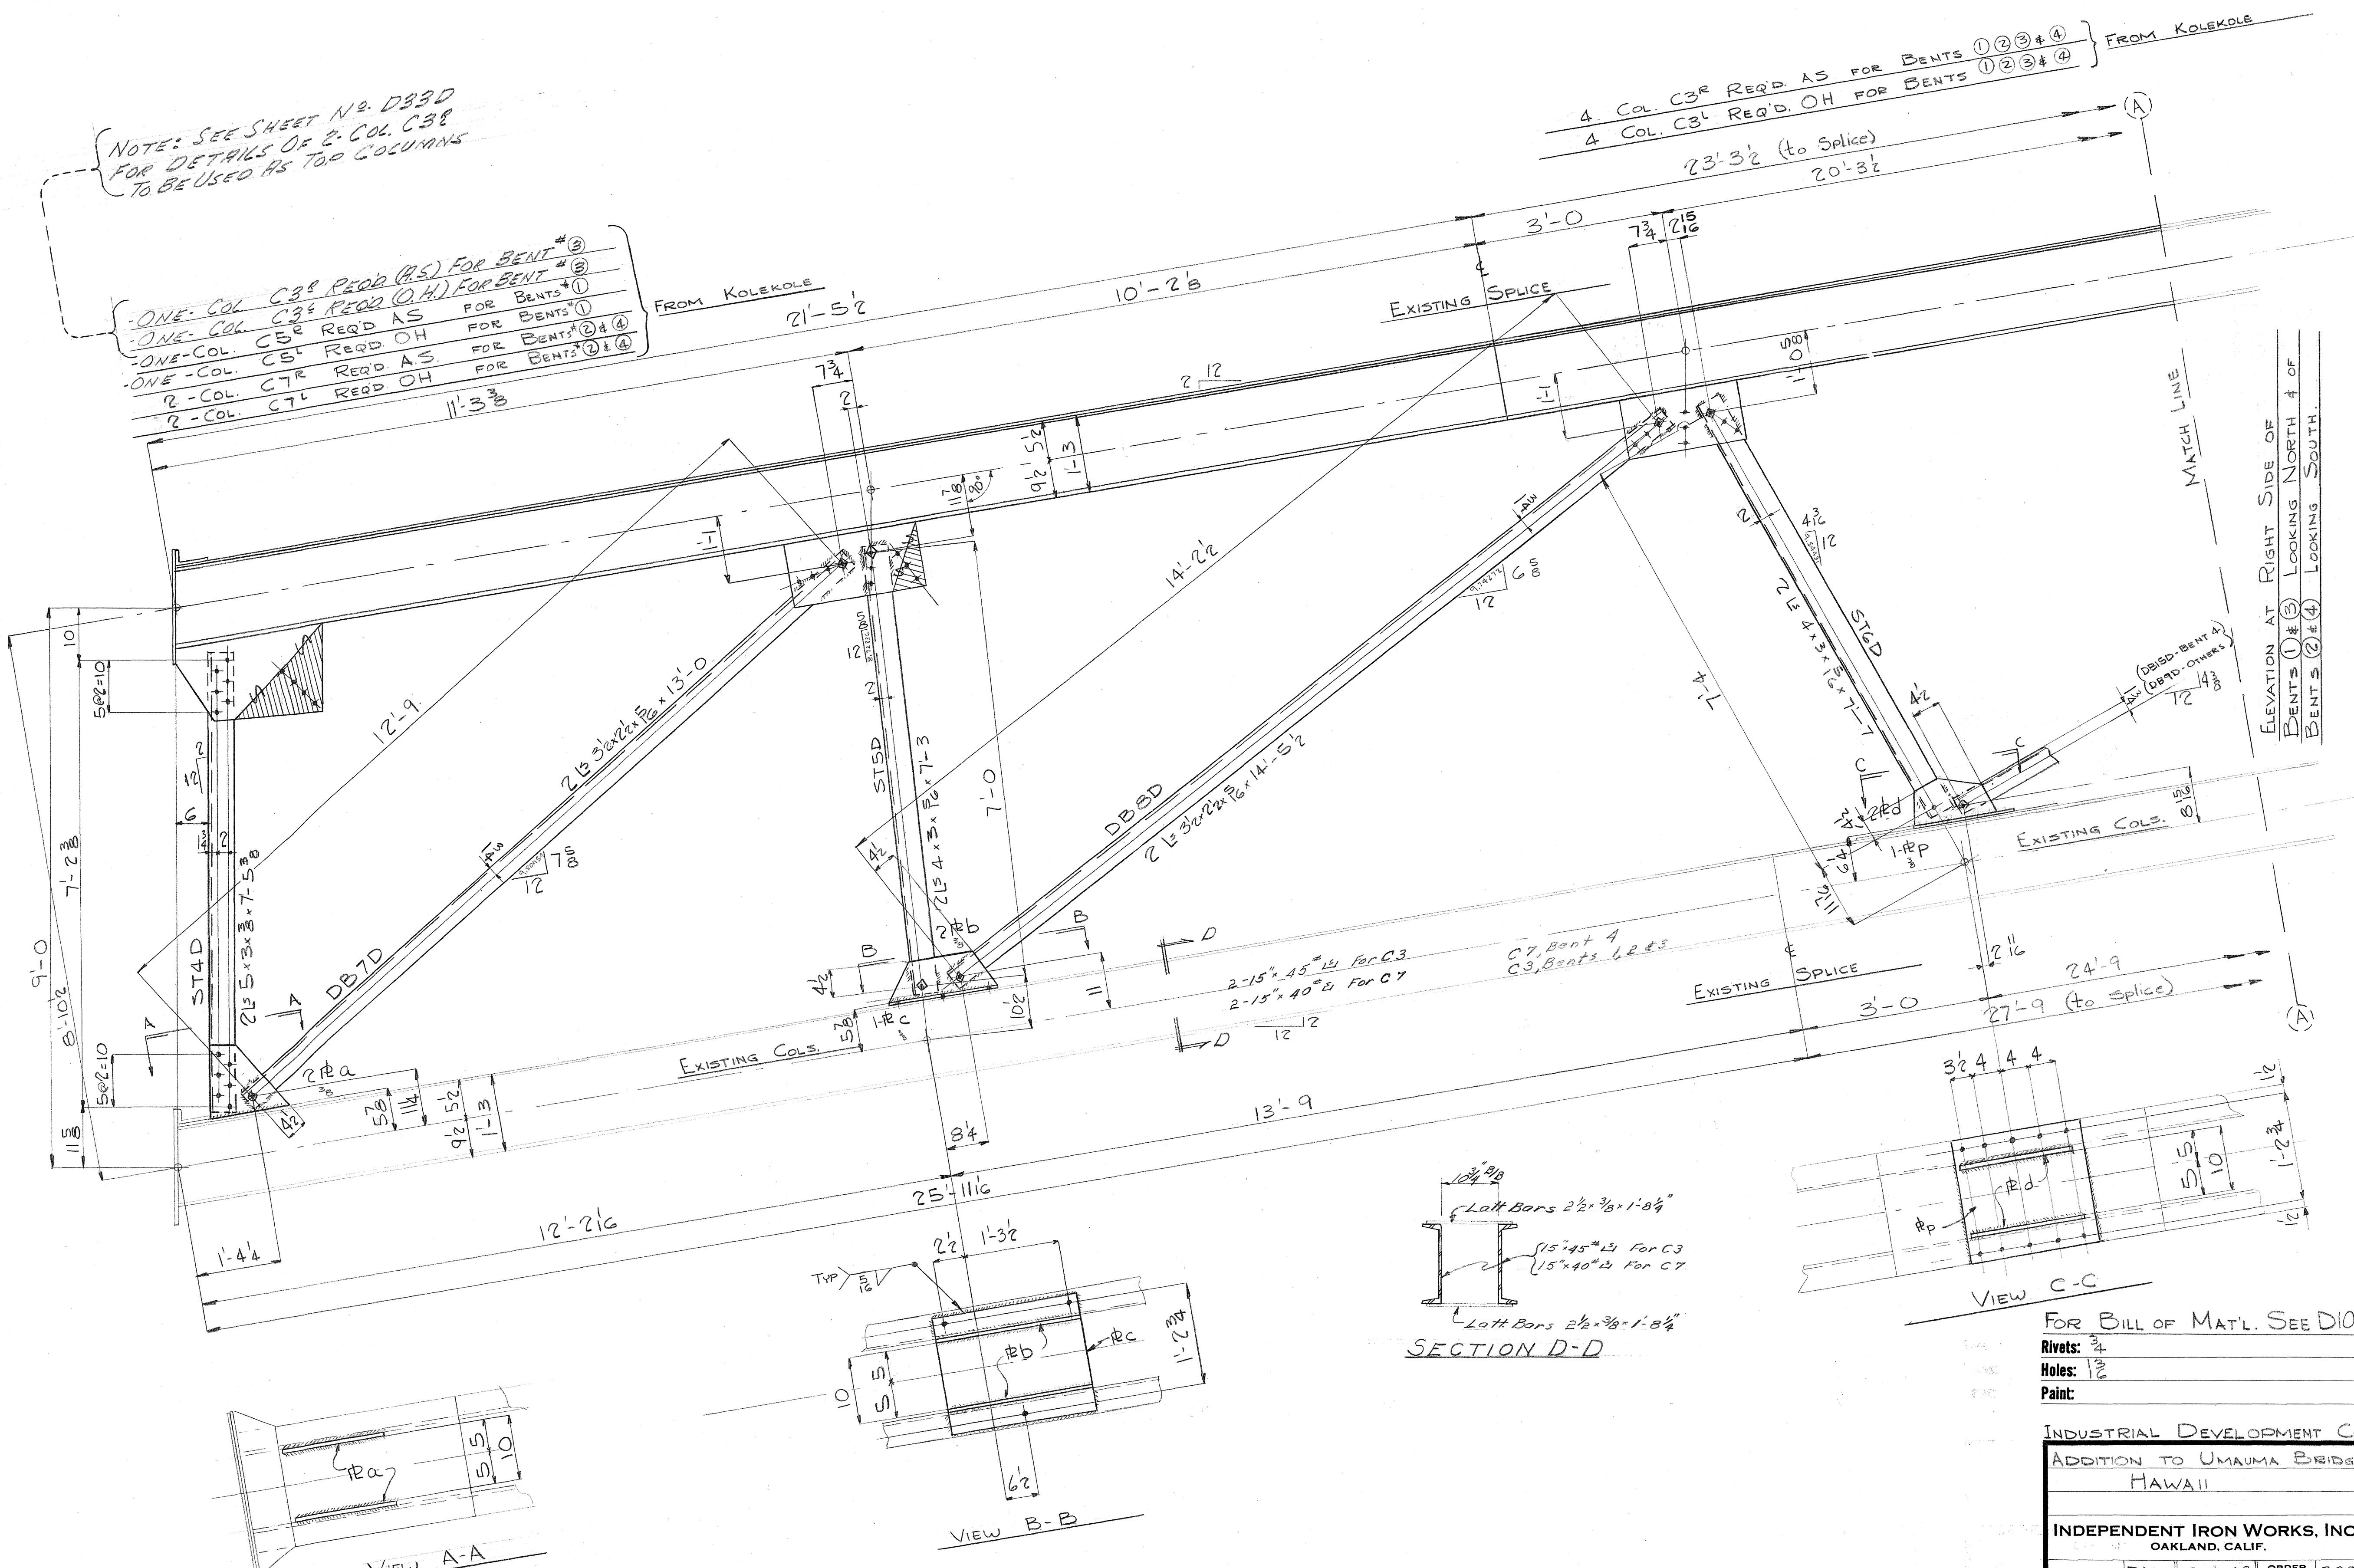


5468.166

FED. ROAD DIST. NO.	STATE	FED. AID PROJ. NO.	FISCAL YEAR	SHFT. NO.	SCHEM. SHEETS
HAWAII HWY 30R3(3)X950		167	300		


11/8/50

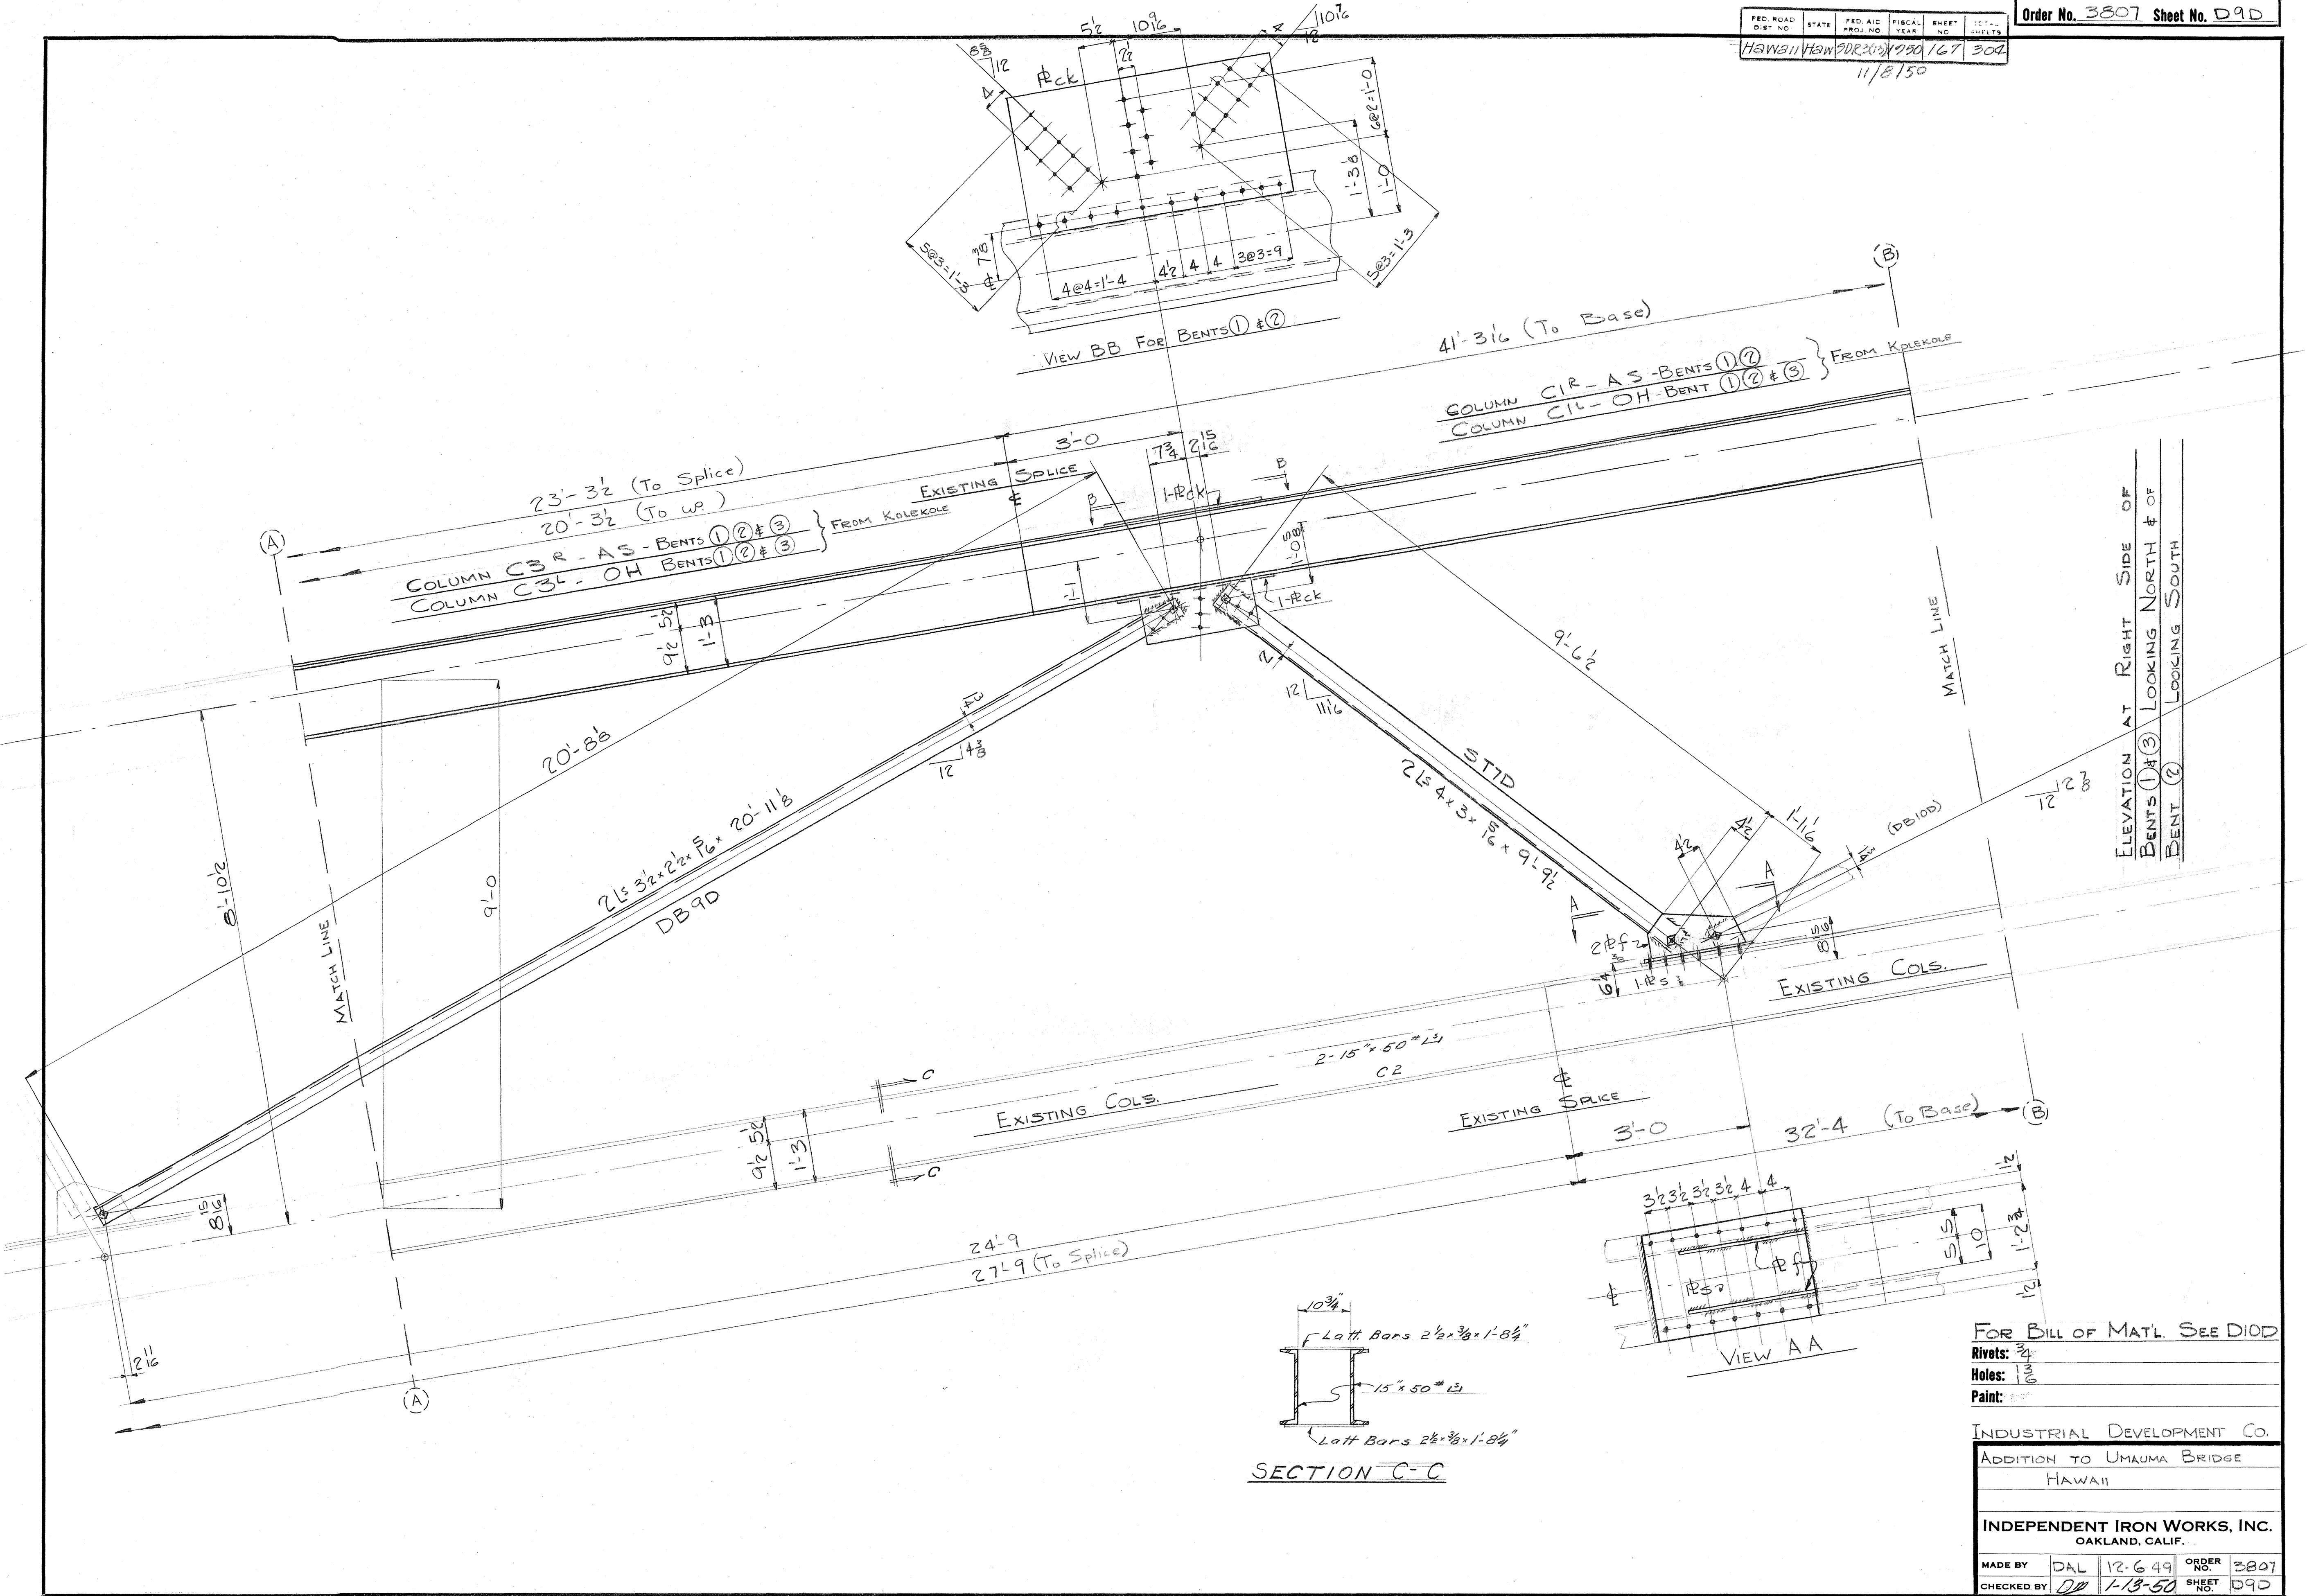

5468.168

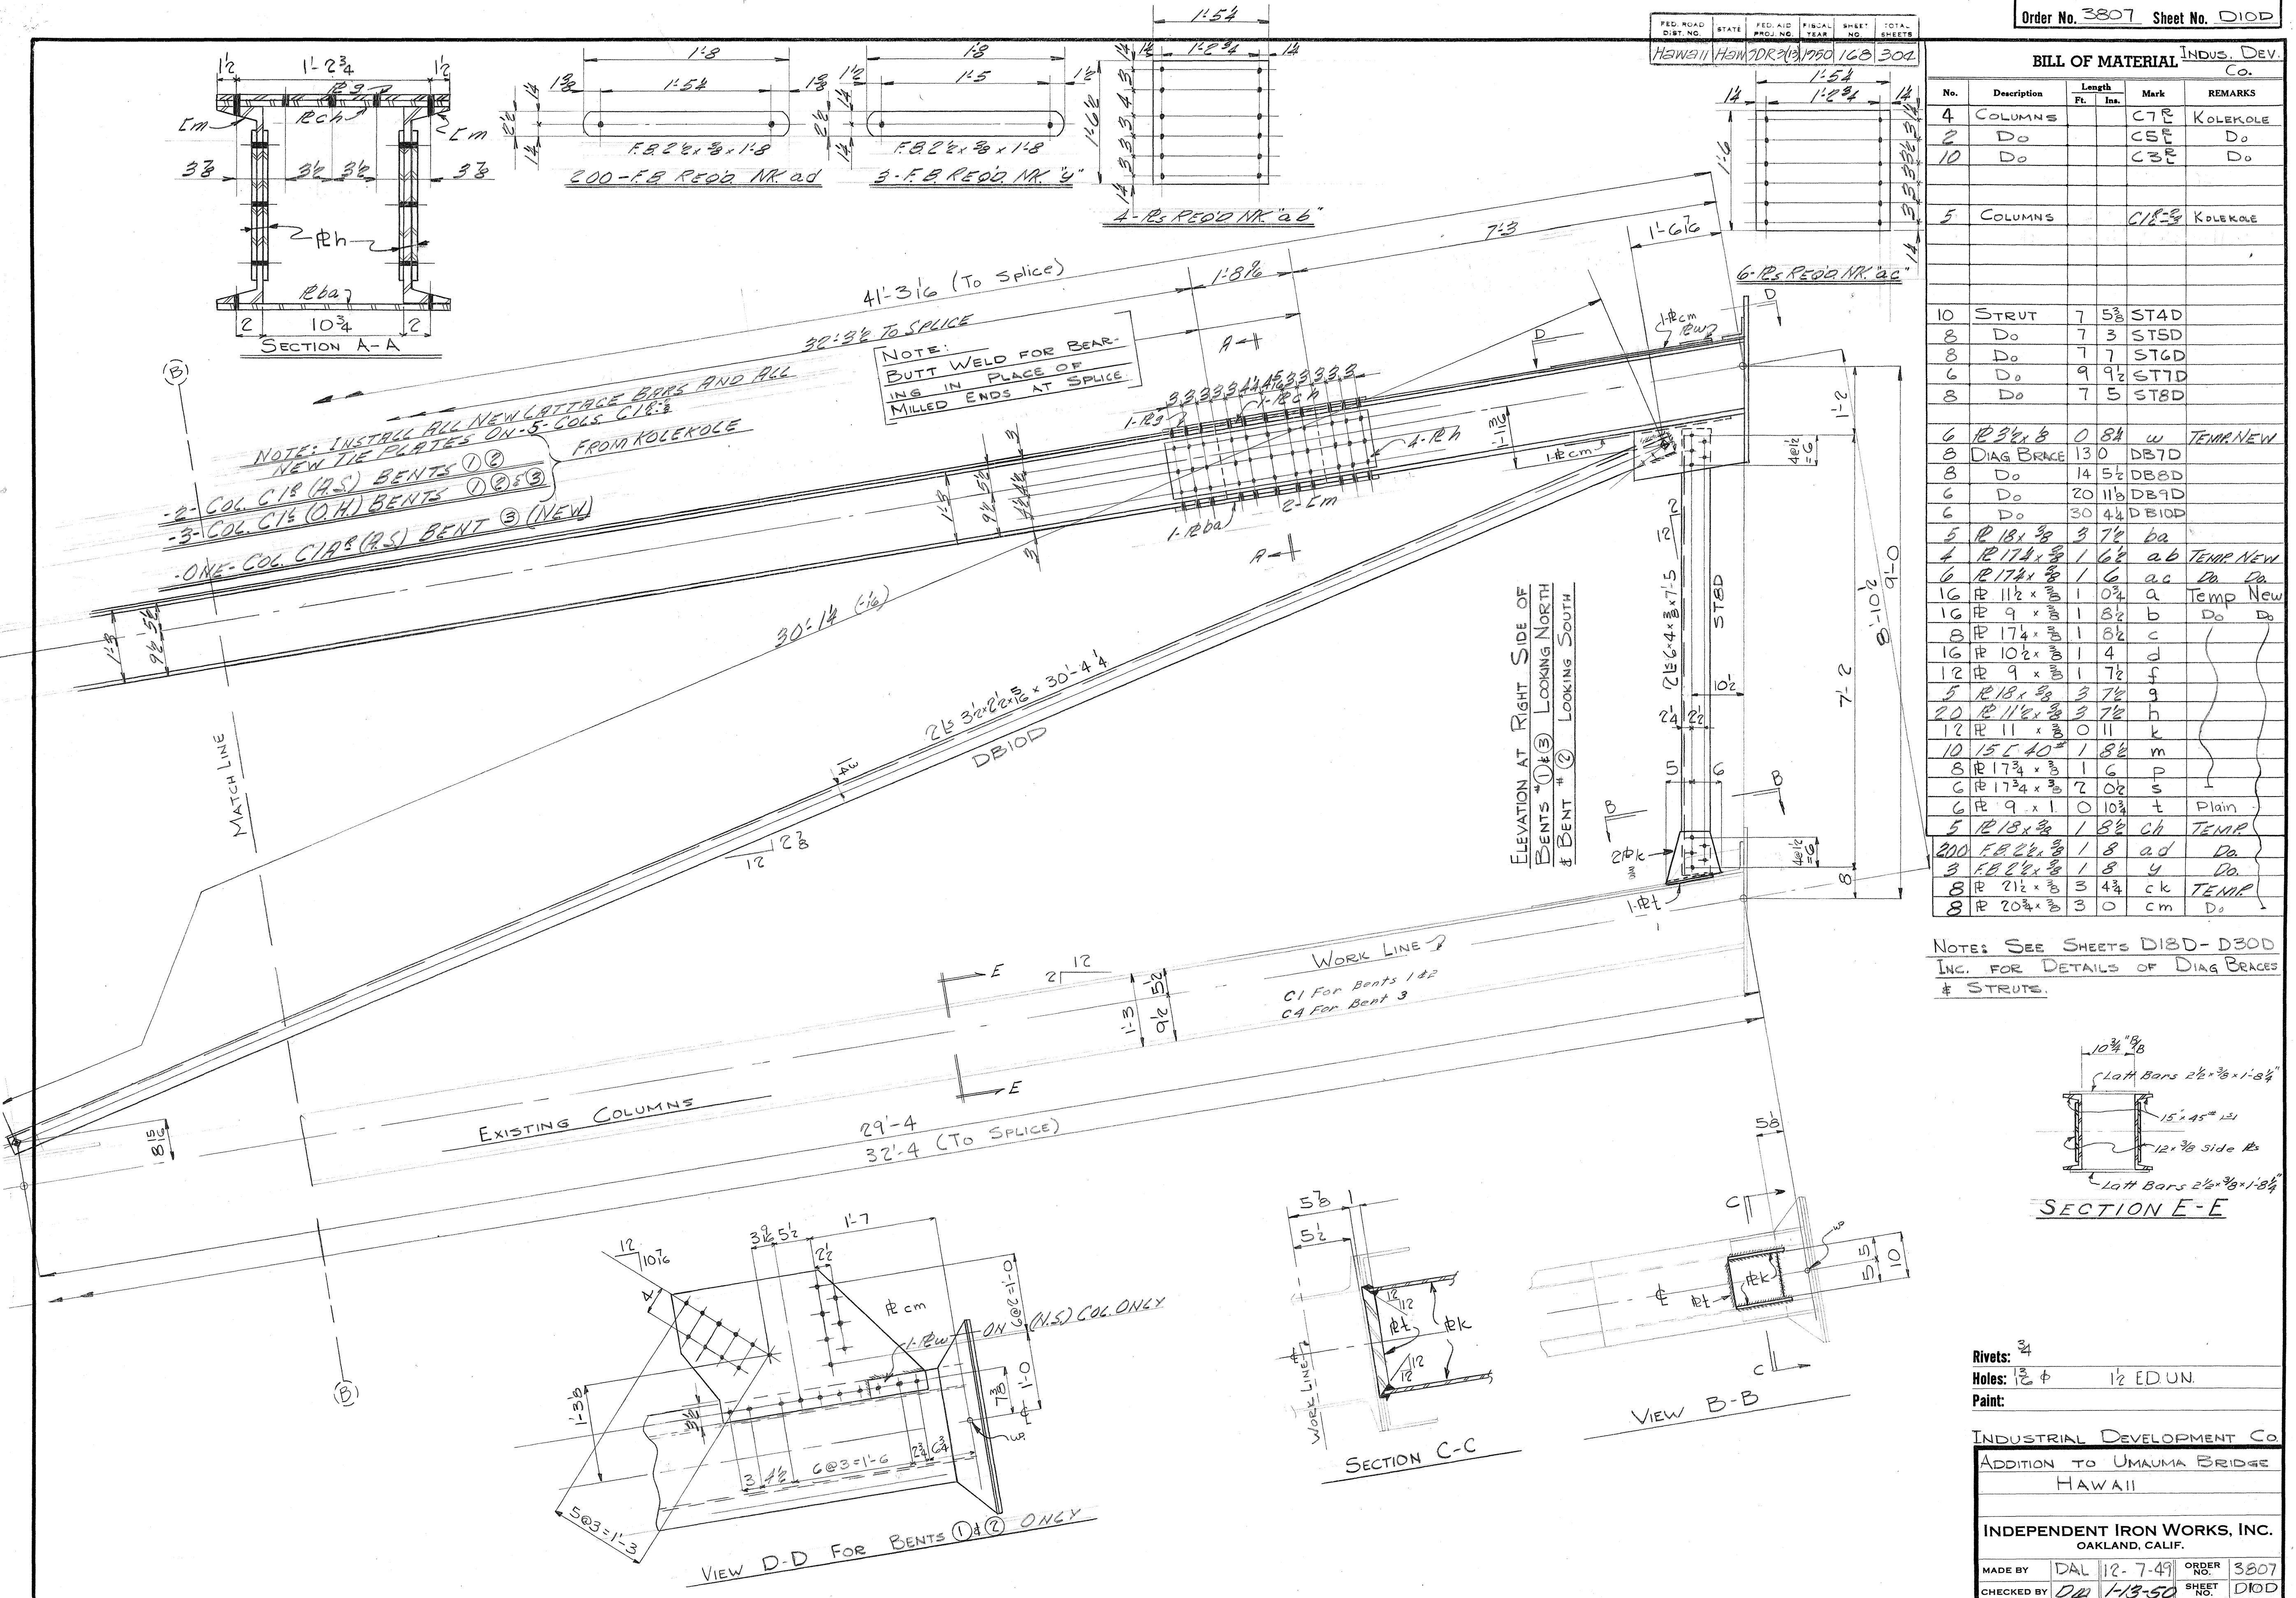

5468.168

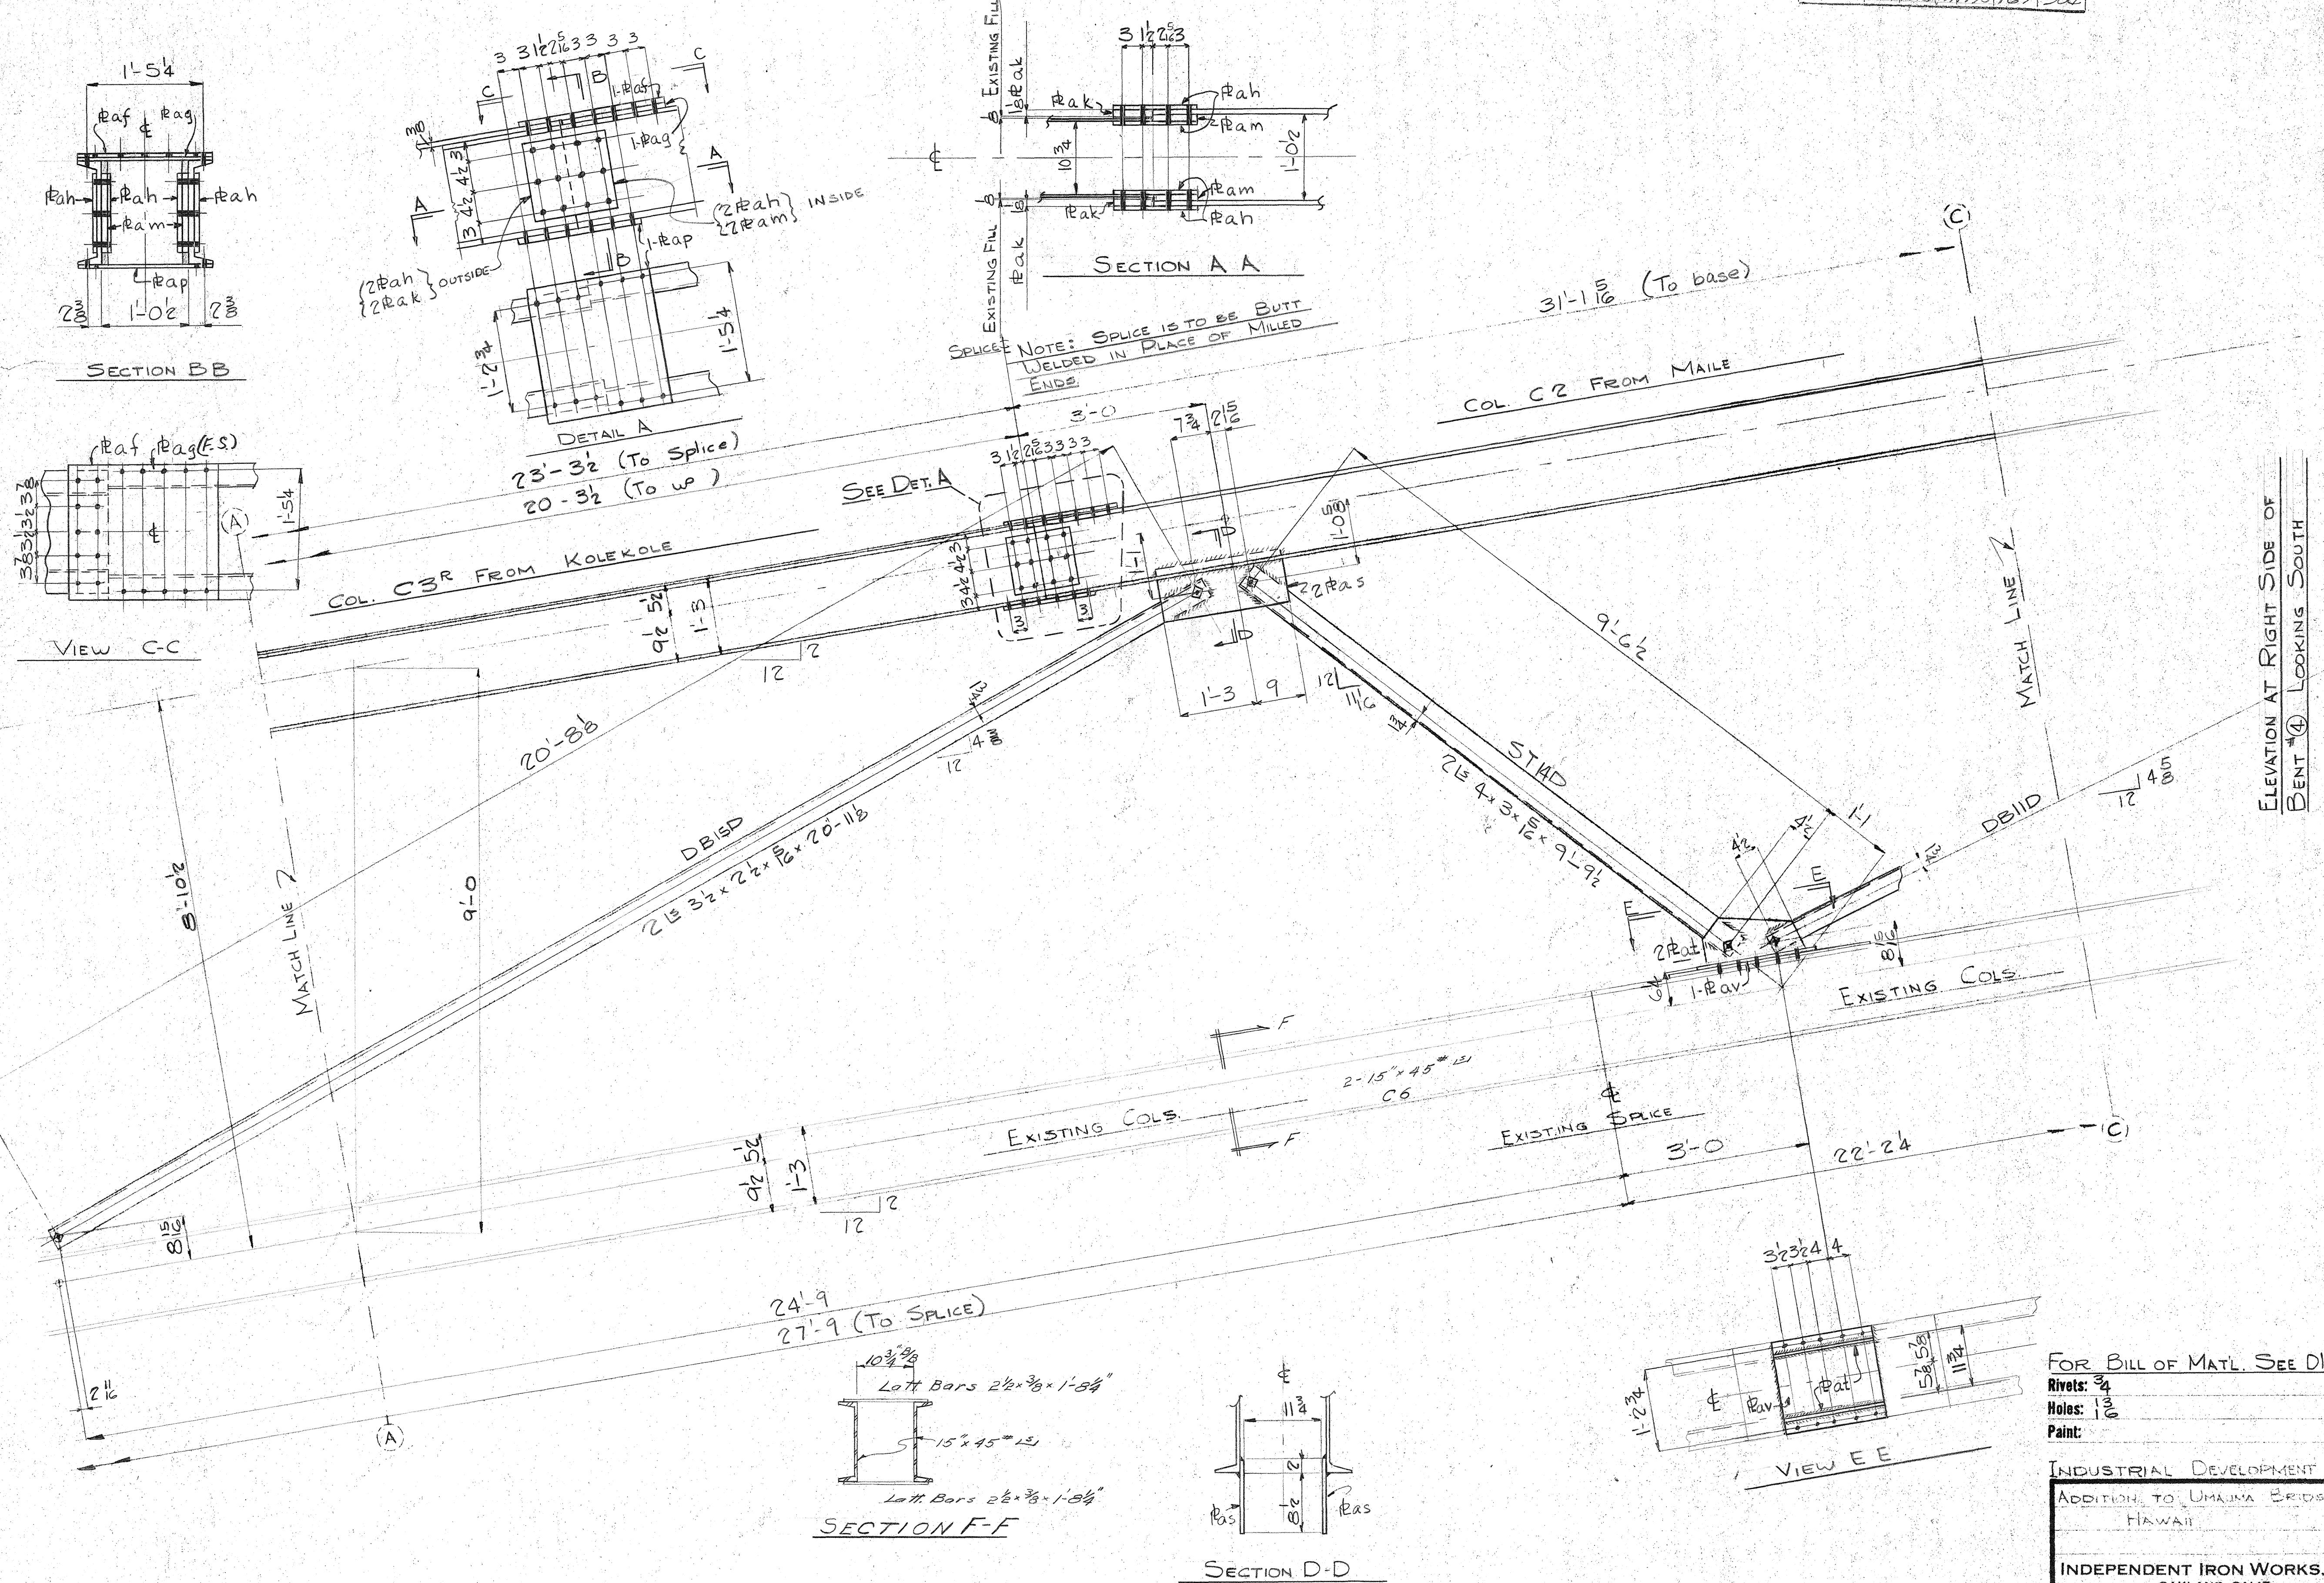


5468.169

FED. ROAD DIST. NO.	STATE	FED. AID PROJ. NO.	FISCAL YEAR	SHEET NO.	TOTAL SHEETS
Hawaii	Haw	SDR 3(13)	1950	170	304

der No. 3807 Sheet No. D12D

# BILL OF MATERIAL INDUS. DEV.

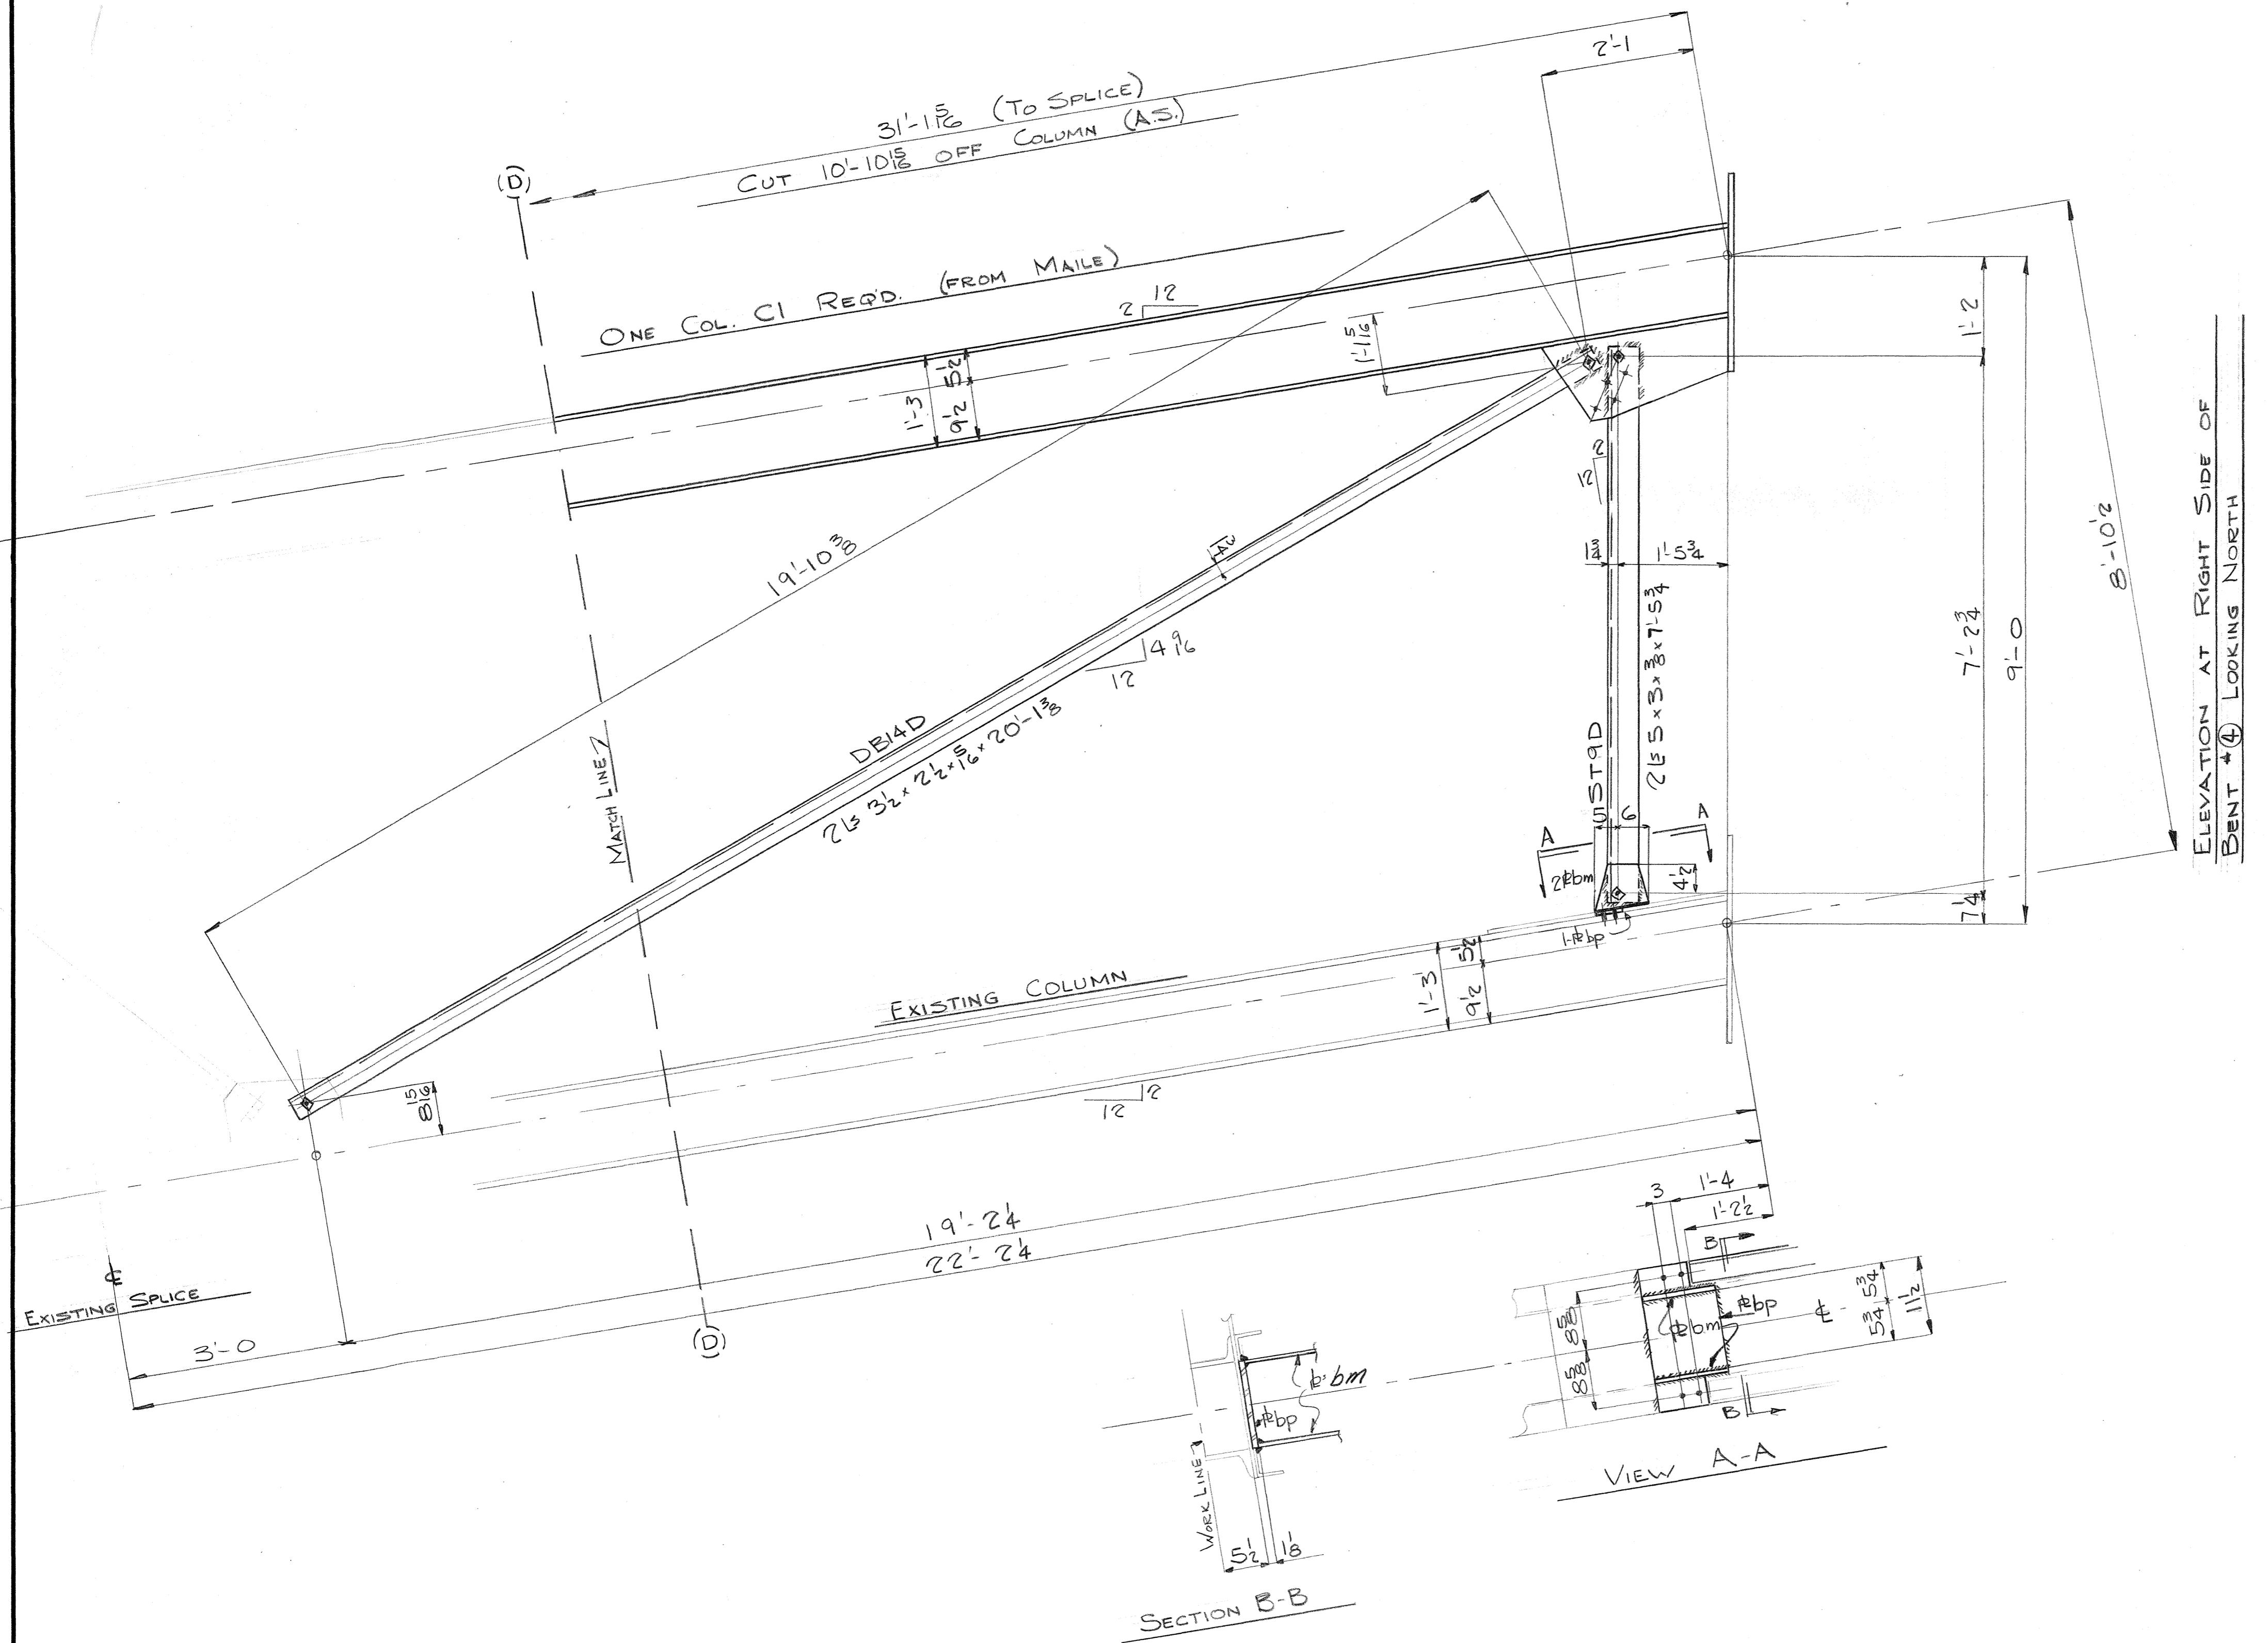

FOR BILL OF MAT'L. SEE DISD

Pivots:  $\frac{3}{4}$

**oles:**  $\frac{13}{16}$

## **aint:**

# INDUSTRIAL DEVELOPMENT CO.

ADDITION TO UMAUMA BRIDGE

Hawaii

# **INDEPENDENT IRON WORKS, INC.**

OAKLAND, CALIF.

MADE BY DAI 17-9-49 ORDER NO. 3807

SEARCHED BY DAC DATE 1-12-50 NO. 1000  
CHECKED BY DM SHEET NO. D12D

CHECKED BY LIA 1-1030 NO. WYCD


15

... I think it's time to move on.


10. The following table shows the number of hours worked by 1000 workers in a certain industry.

5468.17

FED. ROAD DIST. NO.	STATE	FED. AID PROJ. NO.	FISCAL YEAR	SHET. NO.	TOTAL SHEETS
HAWAII	HON	SDR 2101950171	171	304	

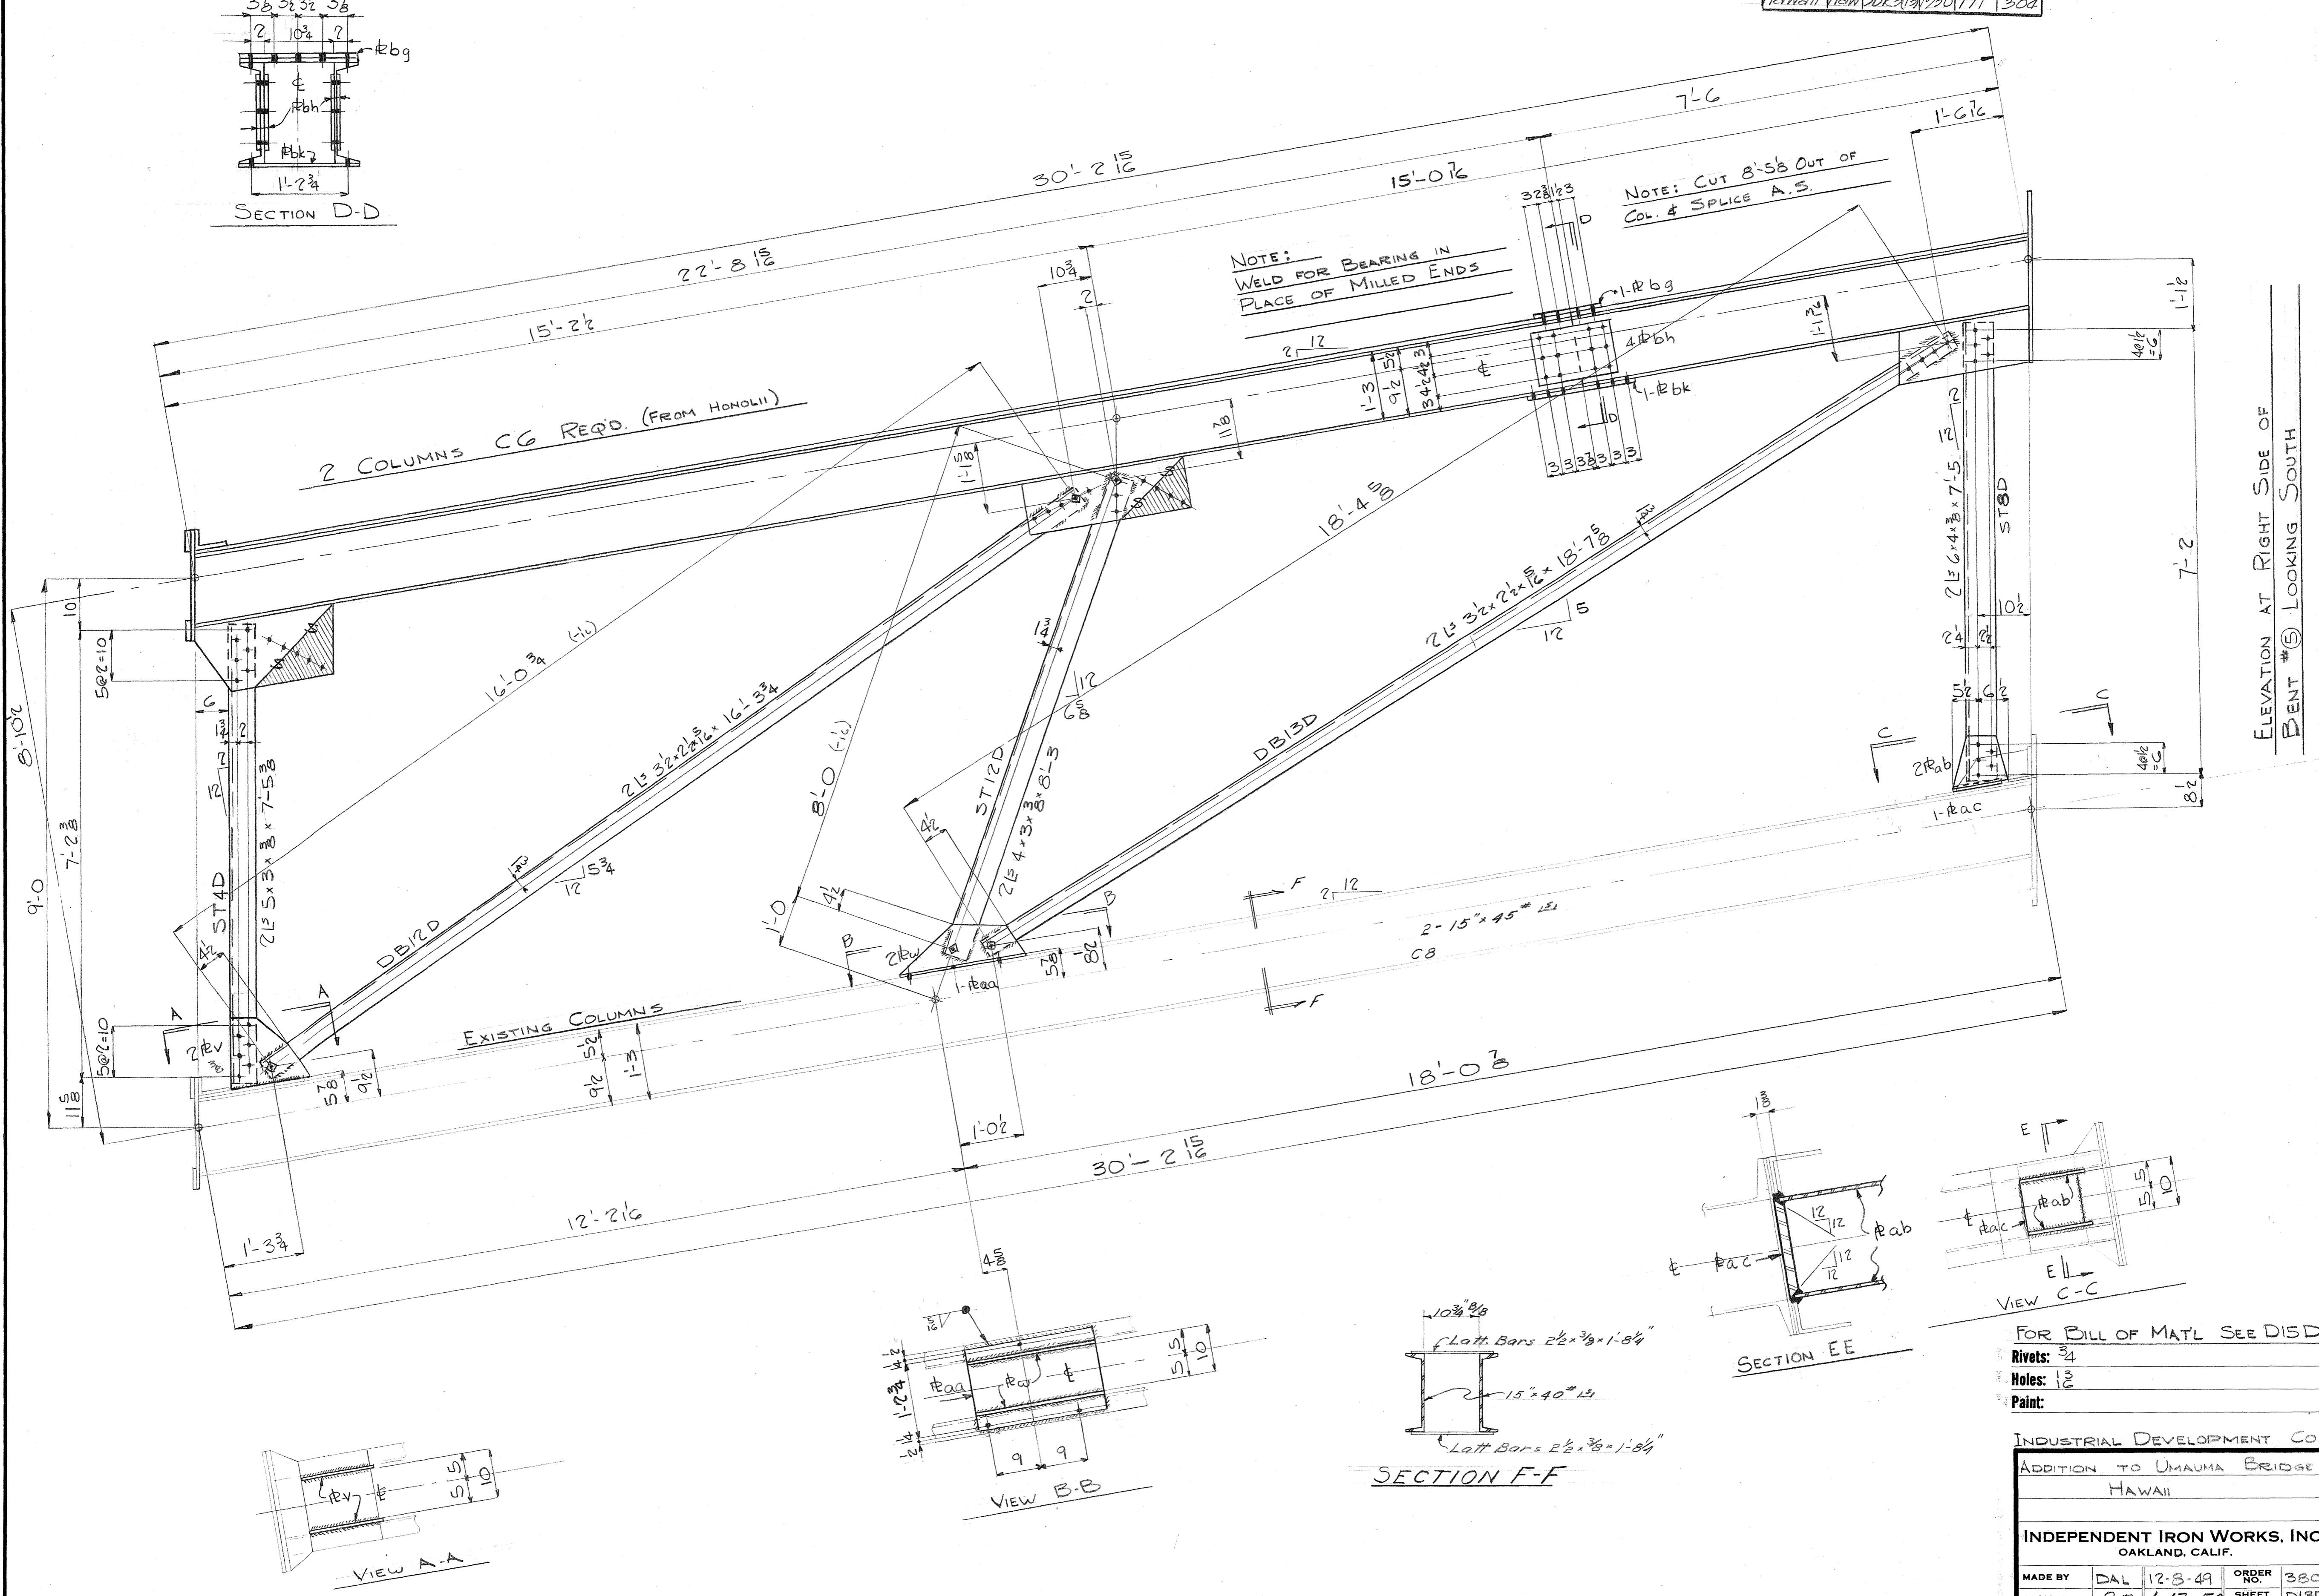

FED. ROAD DEPT. NO.	STATE	FED. AID PROJ. NO.	FISCAL YEAR	SHEET NO.	TOTAL SHEETS
Hawaii	Haw	SDR 301950	172	302	302

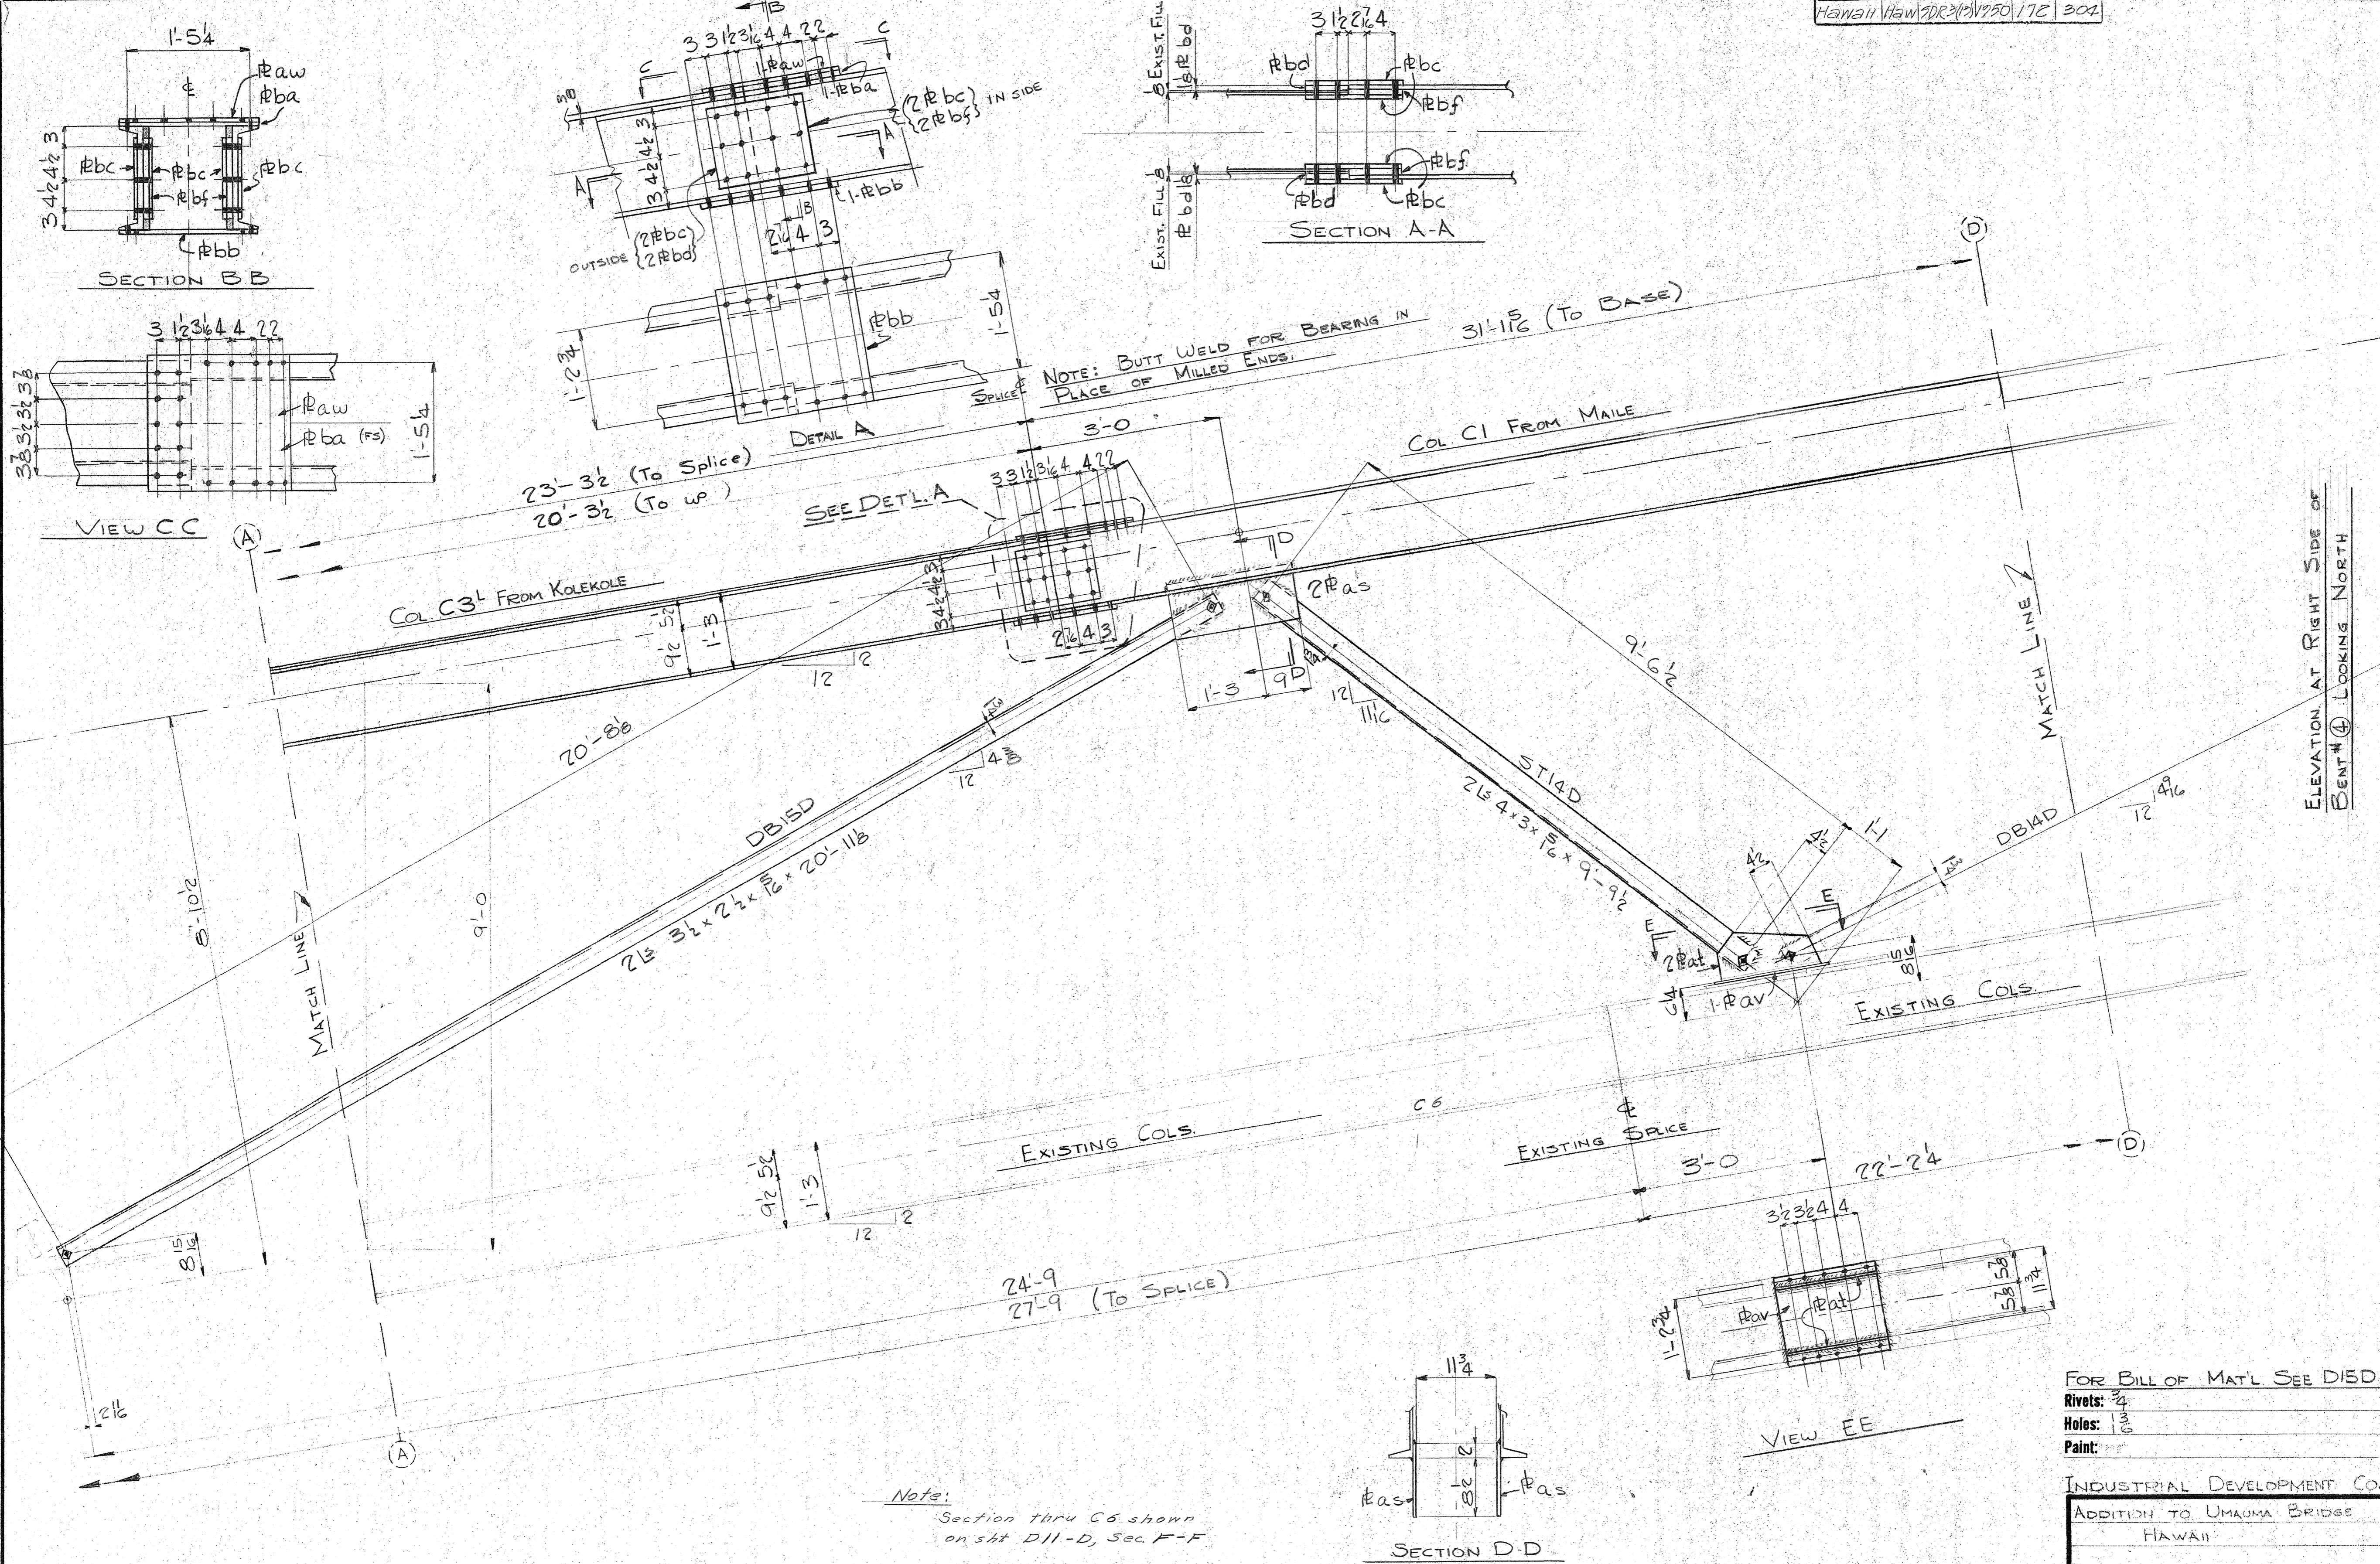

5468.172

FED. ROAD DIST. NO.	STATE	FED. AID PROJ. NO.	FISCAL YEAR	SHEET NO.	TOTAL SHEETS
Hawaii	Hawa	3DR363	1950	173	304

**BILL OF MATERIAL** INDUS. DEV.  
CO.

No.	Description	Length		Mark	REMARKS
		Ft.	Ins.		
1	COLUMN			C1	MAILE
2	COLUMNS			C6	HONOLII
1	COLUMN			C2	MAILE
1	STRUT	7	5 3/4	ST9D	
1	Do	7	5 3/4	ST10D	
2	Do	8	3	ST12D	
2	Do	9	9 1/2	ST14D	
1	DIAG. BRACE	20	1 3/8	DB11D	
2	Do	16	3 3/4	DB12D	
2	Do	18	7 5/8	DB13D	
1	Do	20	1 3/8	DB14D	
2	Do	20	11 1/8	DB15D	
1	PE 13 1/4 x 3/8	1	4	V	Temp New
4	PE 10 x 3/8	2	0 1/2	w	Do Do
2	PE 17 1/4 x 3/8	2	0 1/2	aa	
4	PE 12 x 3/8	1	0 1/2	ab	
2	PE 10 1/4 x 1	0	10 3/4	ac	
2	PE 11 1/2 x 1/2	0	11 1/2	ad	
1	PE 19 3/4 x 3/8	1	9 1/4	af	
1	PE 15 1/2 x 3/8	1	7 3/4	ag	
4	PE 11 1/2 x 3/8	1	0 1/4	ah	
2	PE 5 3/4 x 1/8	0	1 1/2	ak	
2	PE 6 3/4 x 7/8	0	1 1/2	qm	
1	PE 18 1/4 x 3/8	1	7 3/4	ap	
4	PE 10 1/2 x 3/8	2	0	as	
4	PE 7 1/2 x 3/8	1	6 3/4	at	
2	PE 17 3/4 x 3/8	1	6 1/4	av	
1	PE 22 x 3/8	1	7 3/4	aw	
1	PE 16 1/4 x 3/8	1	7 3/4	ba	
1	PE 19 1/2 x 3/8	1	7 3/4	bb	
4	PE 11 1/2 x 3/8	1	1 1/2	bc	
2	PE 5 3/4 x 1/8	0	1 1/2	bd	
2	PE 7 3/4 x 7/8	0	1 1/2	bf	
2	PE 12 3/8 x 3/8	1	5 1/4	bg	
3	PE 11 1/2 x 3/8	1	3 3/8	bh	
2	PE 17 1/4 x 3/8	1	9 3/8	bk	
2	PE 11 x 1/2	0	1 1	bm	
2	PE 11 x 1"	1	6 3/4	bp	

OTE: SEE SHEETS D18D-D30D INC  
OR DETAILS OF DIAGONAL BRACES  
I STRUTS,

vets:  $\frac{3}{4}$   
les:  $\frac{1}{2} \frac{3}{4} \phi$   
int:

## INDUSTRIAL DEVELOPMENT CO.


## ADDITION TO UMAUMA BRIDGE

10. The following table shows the number of hours worked by each employee.

**INDEPENDENT IRON WORKS, INC.**  
**OAKLAND, CALIF.**

MADE BY	DAL	1C-4-41	NO.	3801
CHECKED BY	000	1-16-50	SHEET NO.	D15D

3 13 401

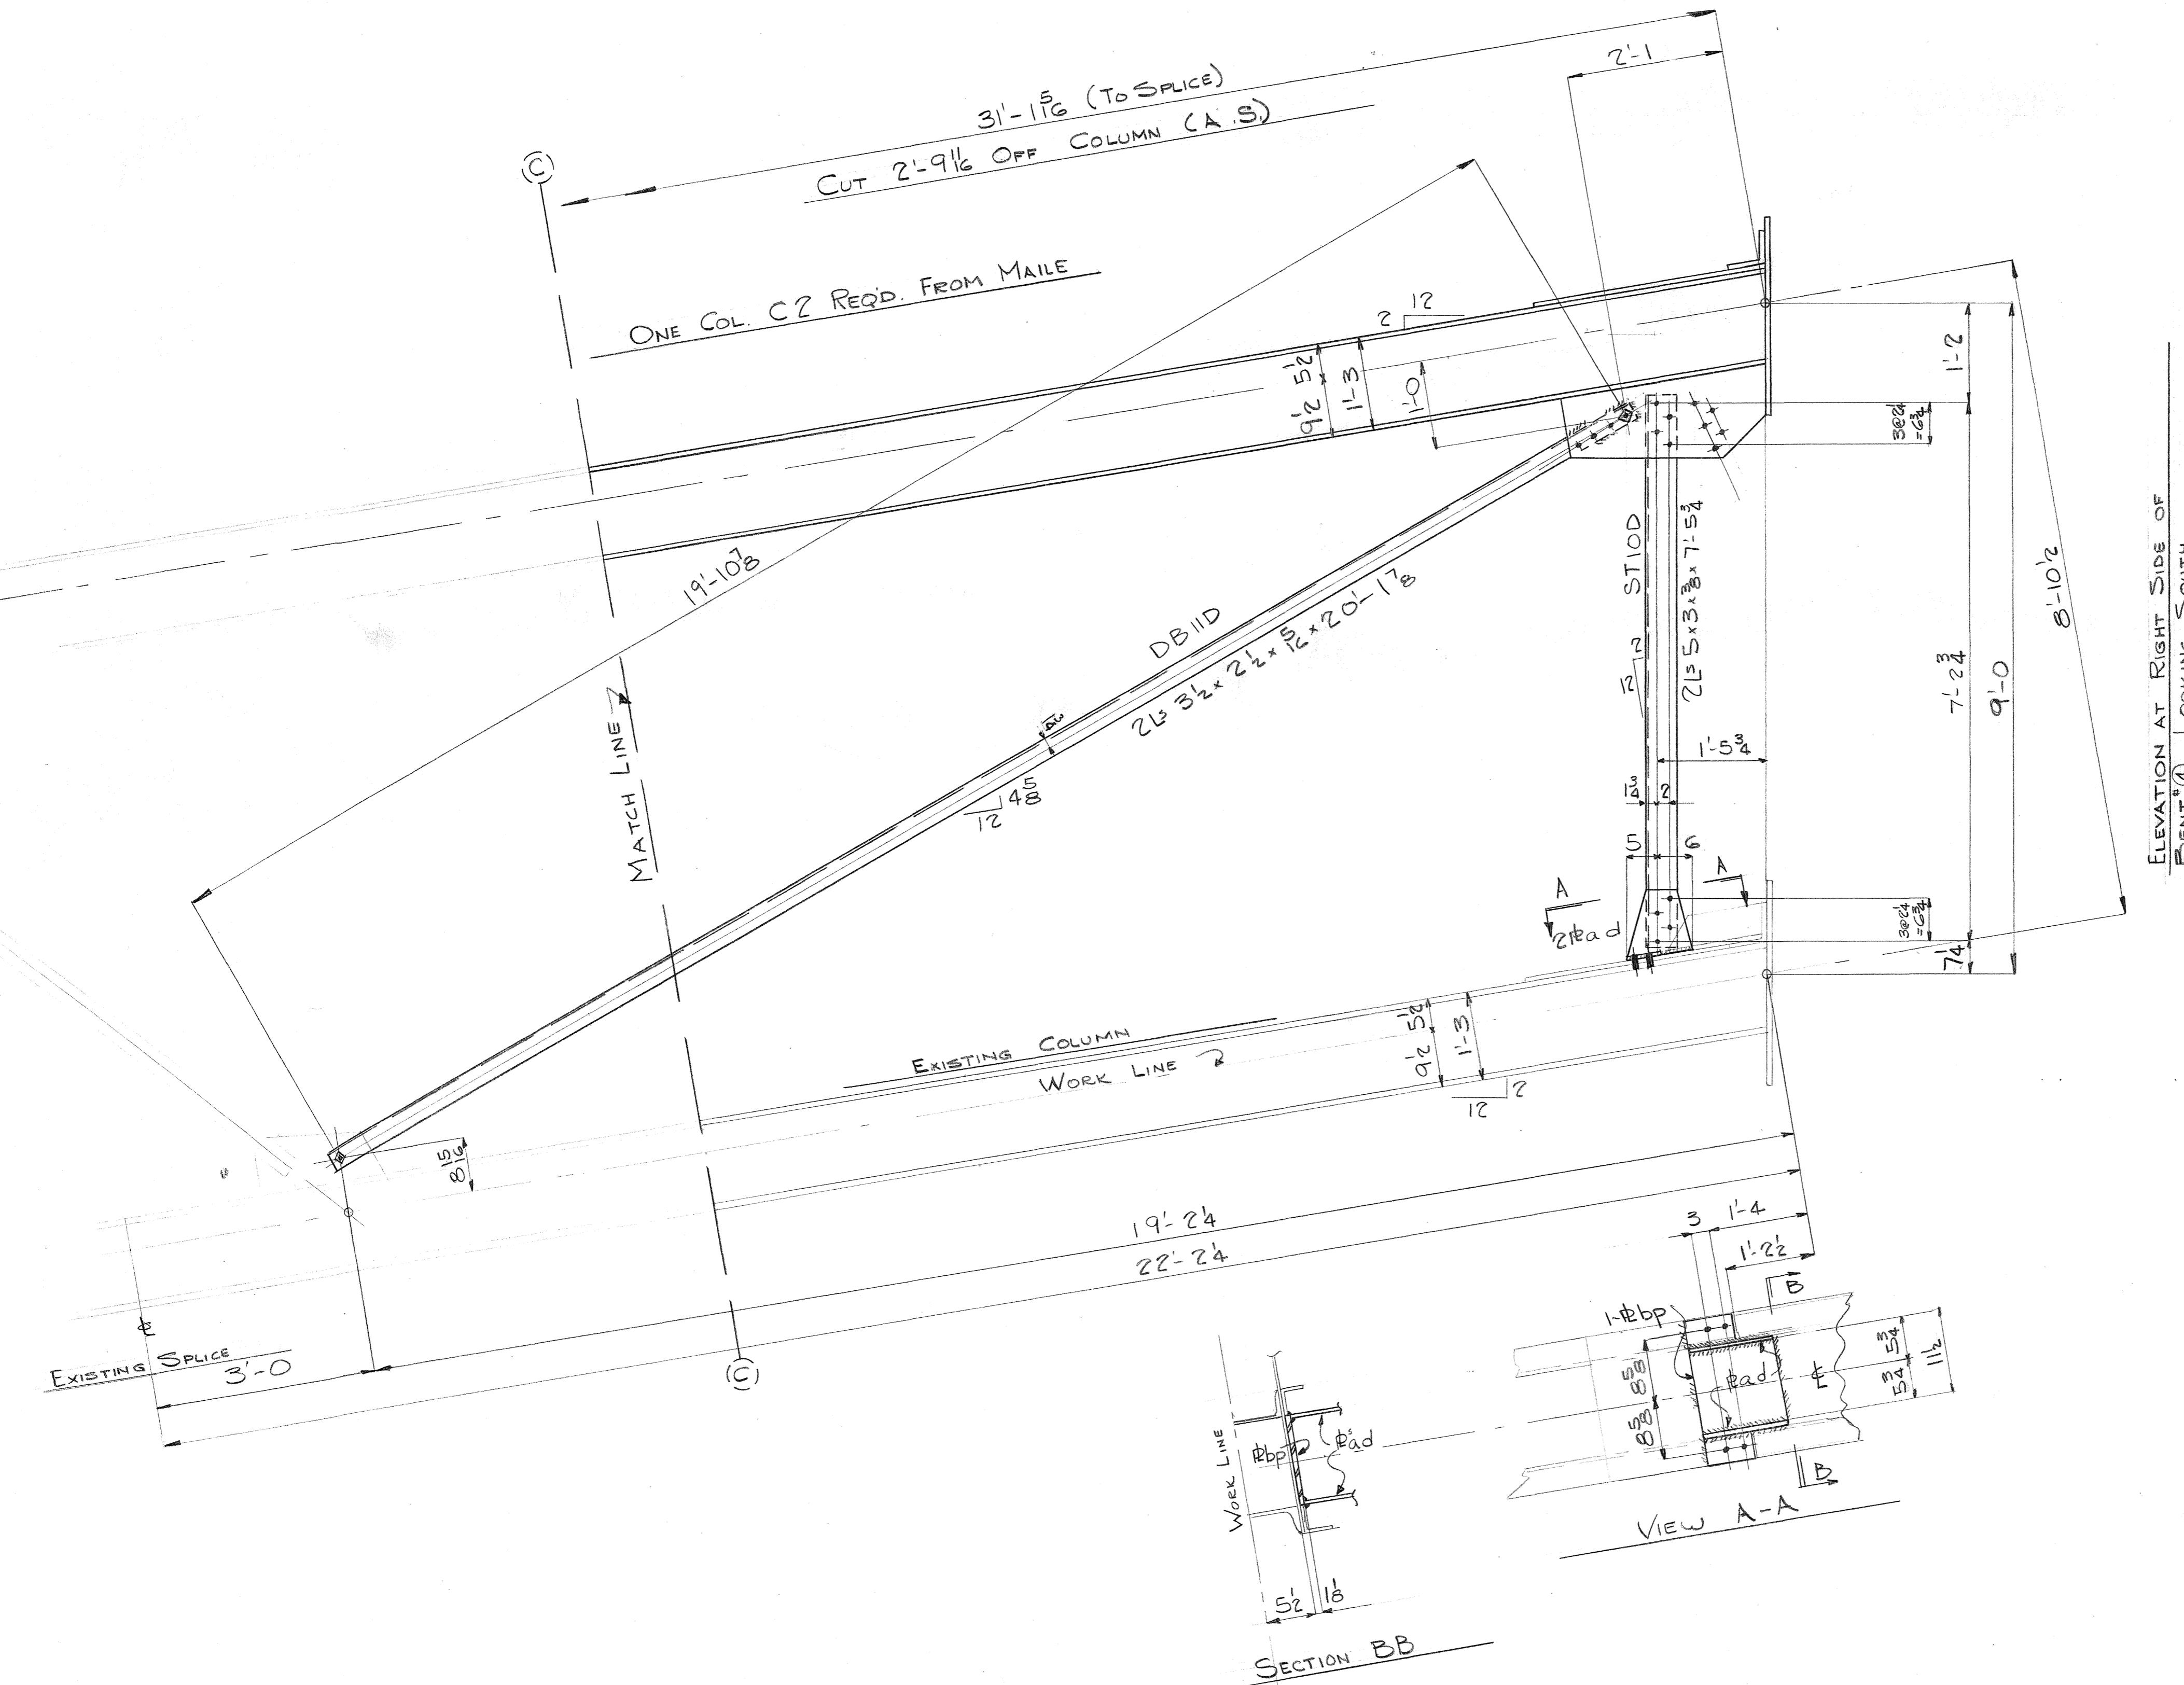


FED. ROAD PROJECT NO.	STATE	FED. AID PROJ. NO.	FISCAL YEAR	SHEET NO.	TOTAL SHEETS
HAWAII	HAWAII	508-3/4/1950	174	302	


**BILL OF MATERIAL**INDUSTRIAL  
DEVELOPMENT

No.	Description	Length Ft. In.	Mark	REMARKS
16	P 32 x $\frac{3}{8}$	3 1	LPI	SALV. FROM KOLEKOLE
4	P 35 $\frac{1}{2}$ x $\frac{3}{8}$	3 2	PI-D	Temp. New
2	DIAG BRACE	17 6	DB17D	
22	D.	18 11	DB18D	
1		31 3	DB19D	
2		19 2	DB20D	
2		26 11	DB21D	
2		22 7 $\frac{3}{4}$	DB22D	
2		16 2	DB23D	
2		14 7	DB24D	
2		32 1	DB25D	


2	P 29 $\frac{1}{2}$ x $\frac{3}{8}$	3 9	bv	Temp. New
2	P 27 $\frac{1}{2}$ x $\frac{3}{8}$	3 8 $\frac{1}{4}$	bw	Do
4	P 28 $\frac{1}{2}$ x $\frac{3}{8}$	2 9 $\frac{1}{4}$	ca	
4	P 5 x $\frac{3}{8}$	1 6 $\frac{1}{4}$	cb	
4	P 22 x $\frac{3}{8}$	2 9 $\frac{1}{2}$	cc	
4	P 34 $\frac{1}{2}$ x $\frac{3}{8}$	2 11 $\frac{1}{2}$	cd	
4	P 21 $\frac{1}{2}$ x $\frac{3}{8}$	3 6 $\frac{1}{2}$	cf	
4	P 6 x $\frac{3}{8}$	1 3 $\frac{1}{2}$	cg	
1	P 3 x $\frac{3}{8}$	3 9	cp	
1	P 3 x $\frac{3}{8}$	3 8 $\frac{1}{4}$	cs	
2	P 3 $\frac{1}{2}$ x $\frac{3}{8}$	0 8 $\frac{1}{4}$	w	

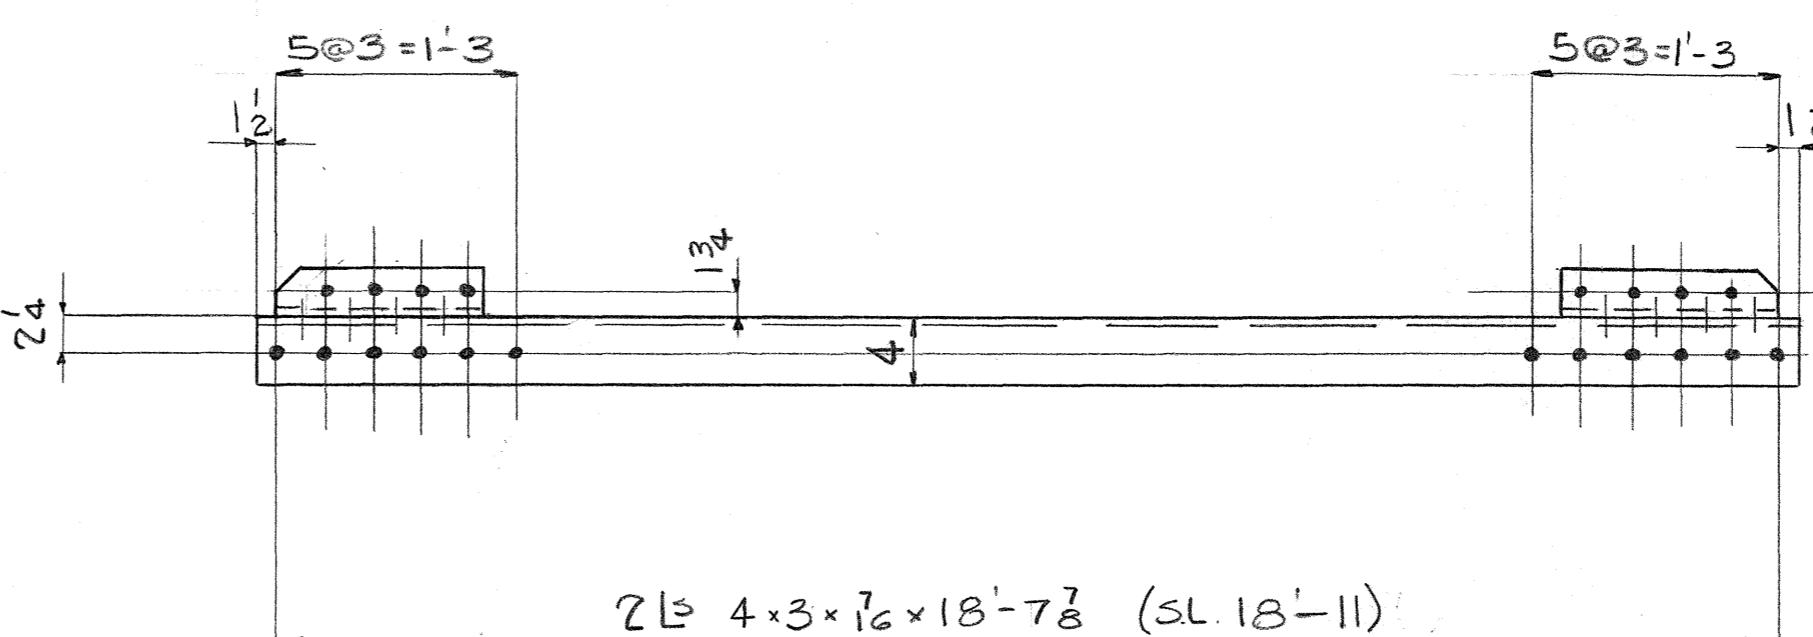NOTE: SEE SHEETS D18D - D30D INC.  
FOR DETAILS OF DIAGONAL BRACES.


22 DIAGONAL BRACES REQ'D. MK. DB18D

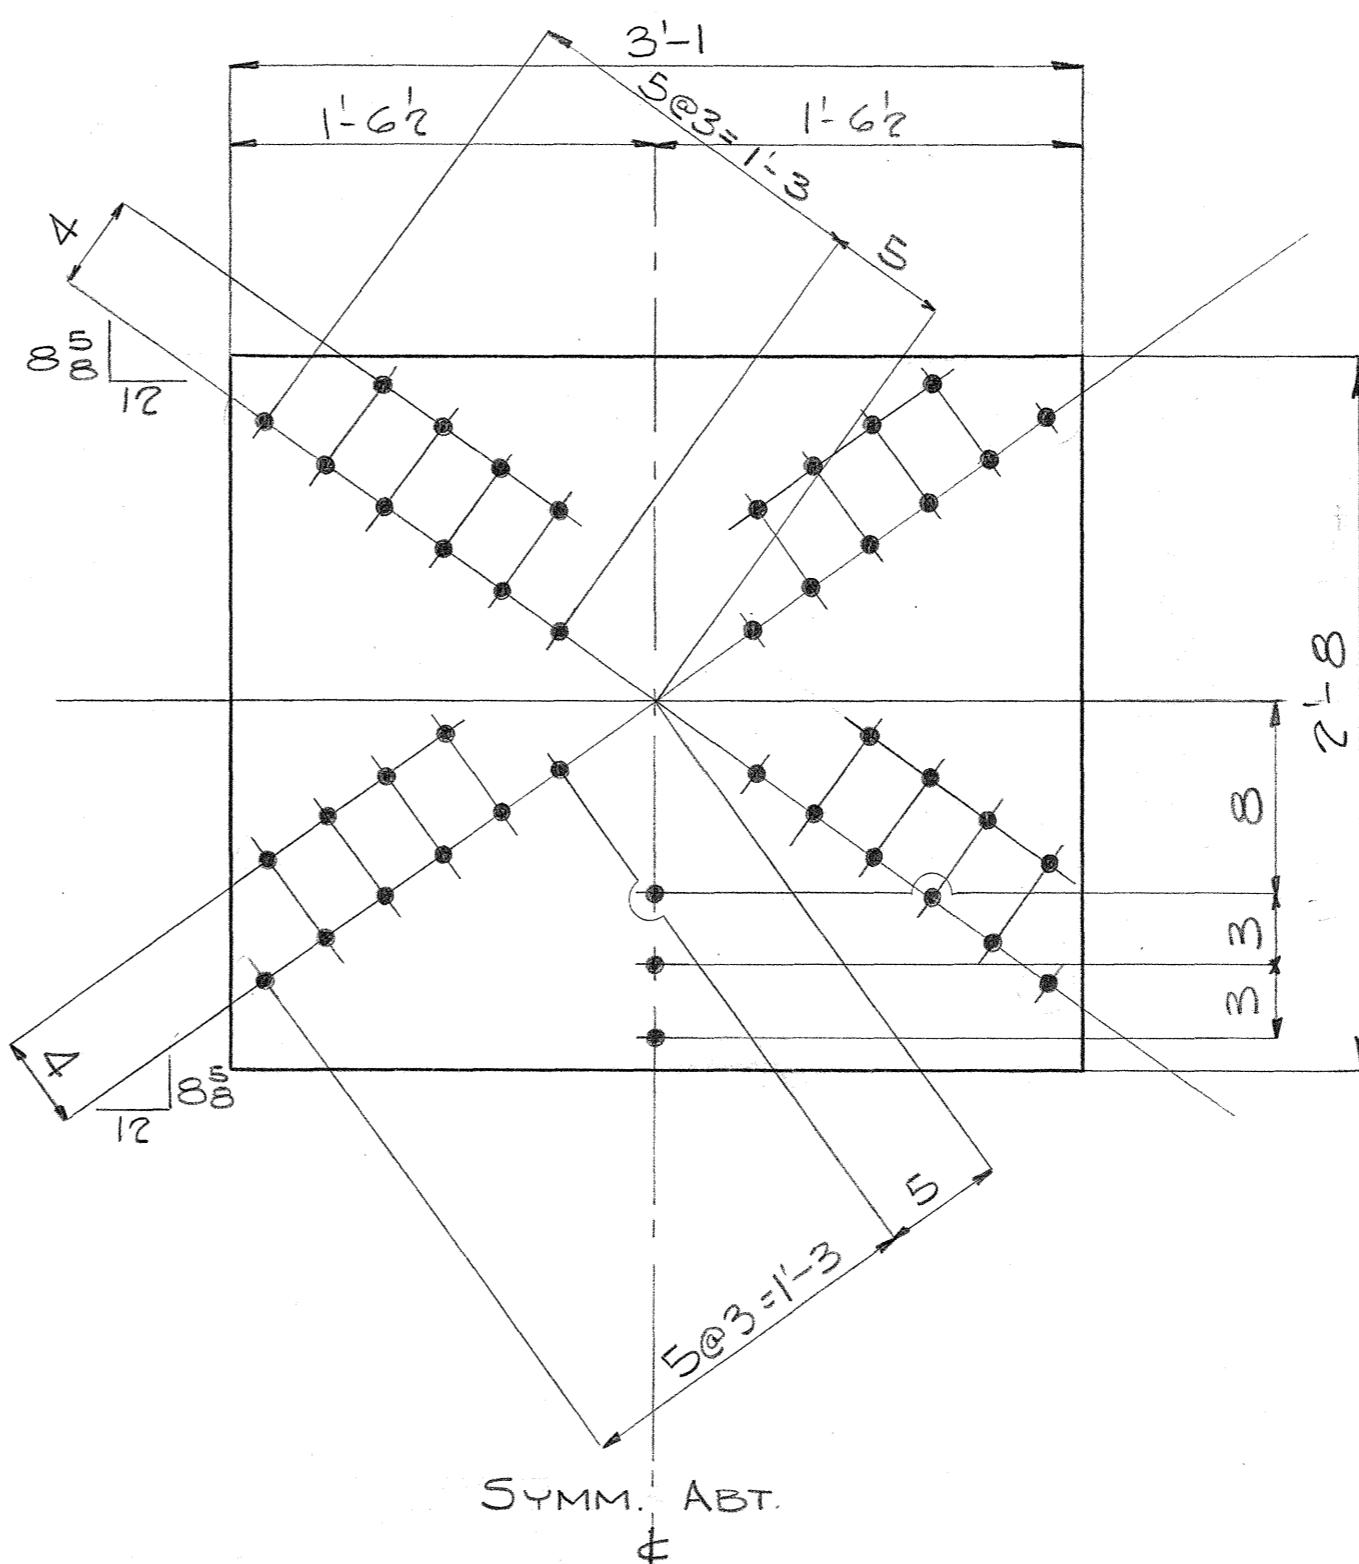

16 P REQ'D. MK. LPI — SALVAGE FROM KOLEKOLE

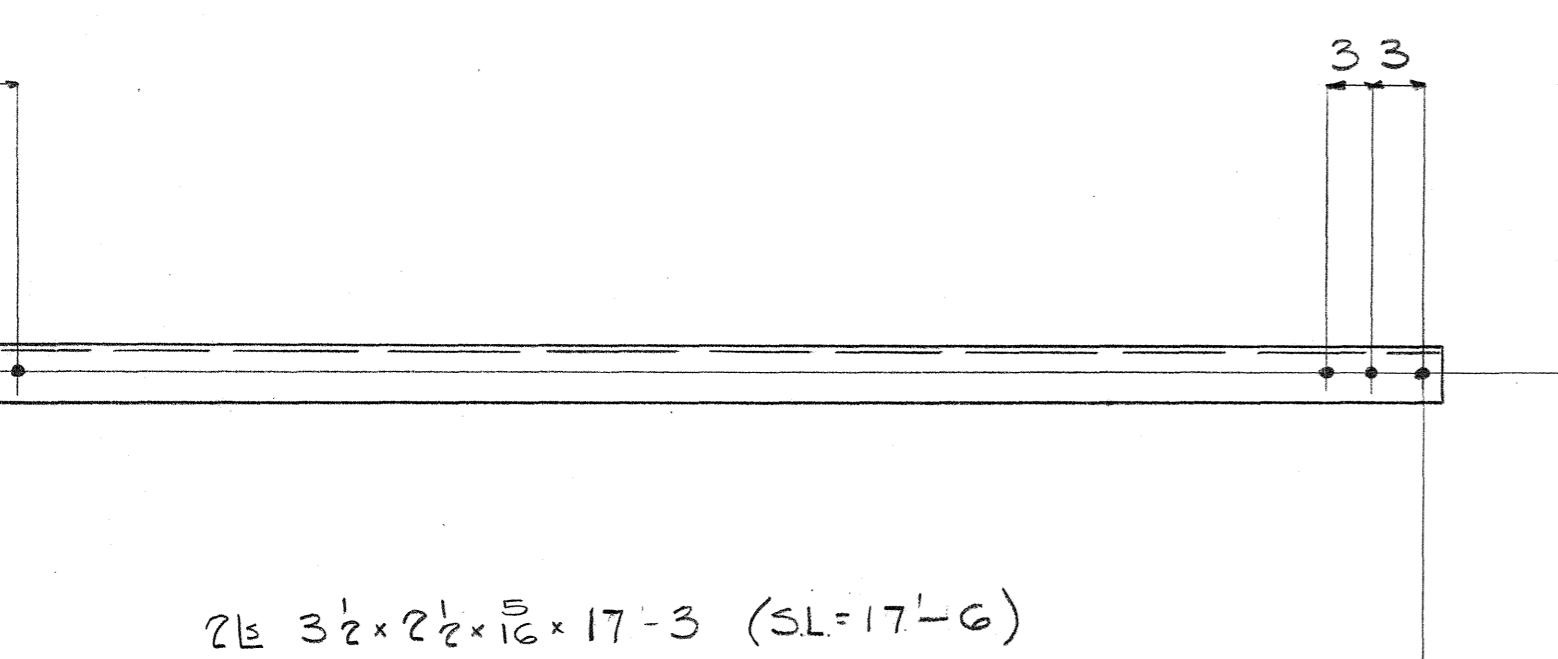

2 BRACES REQ'D. MK. DB17D

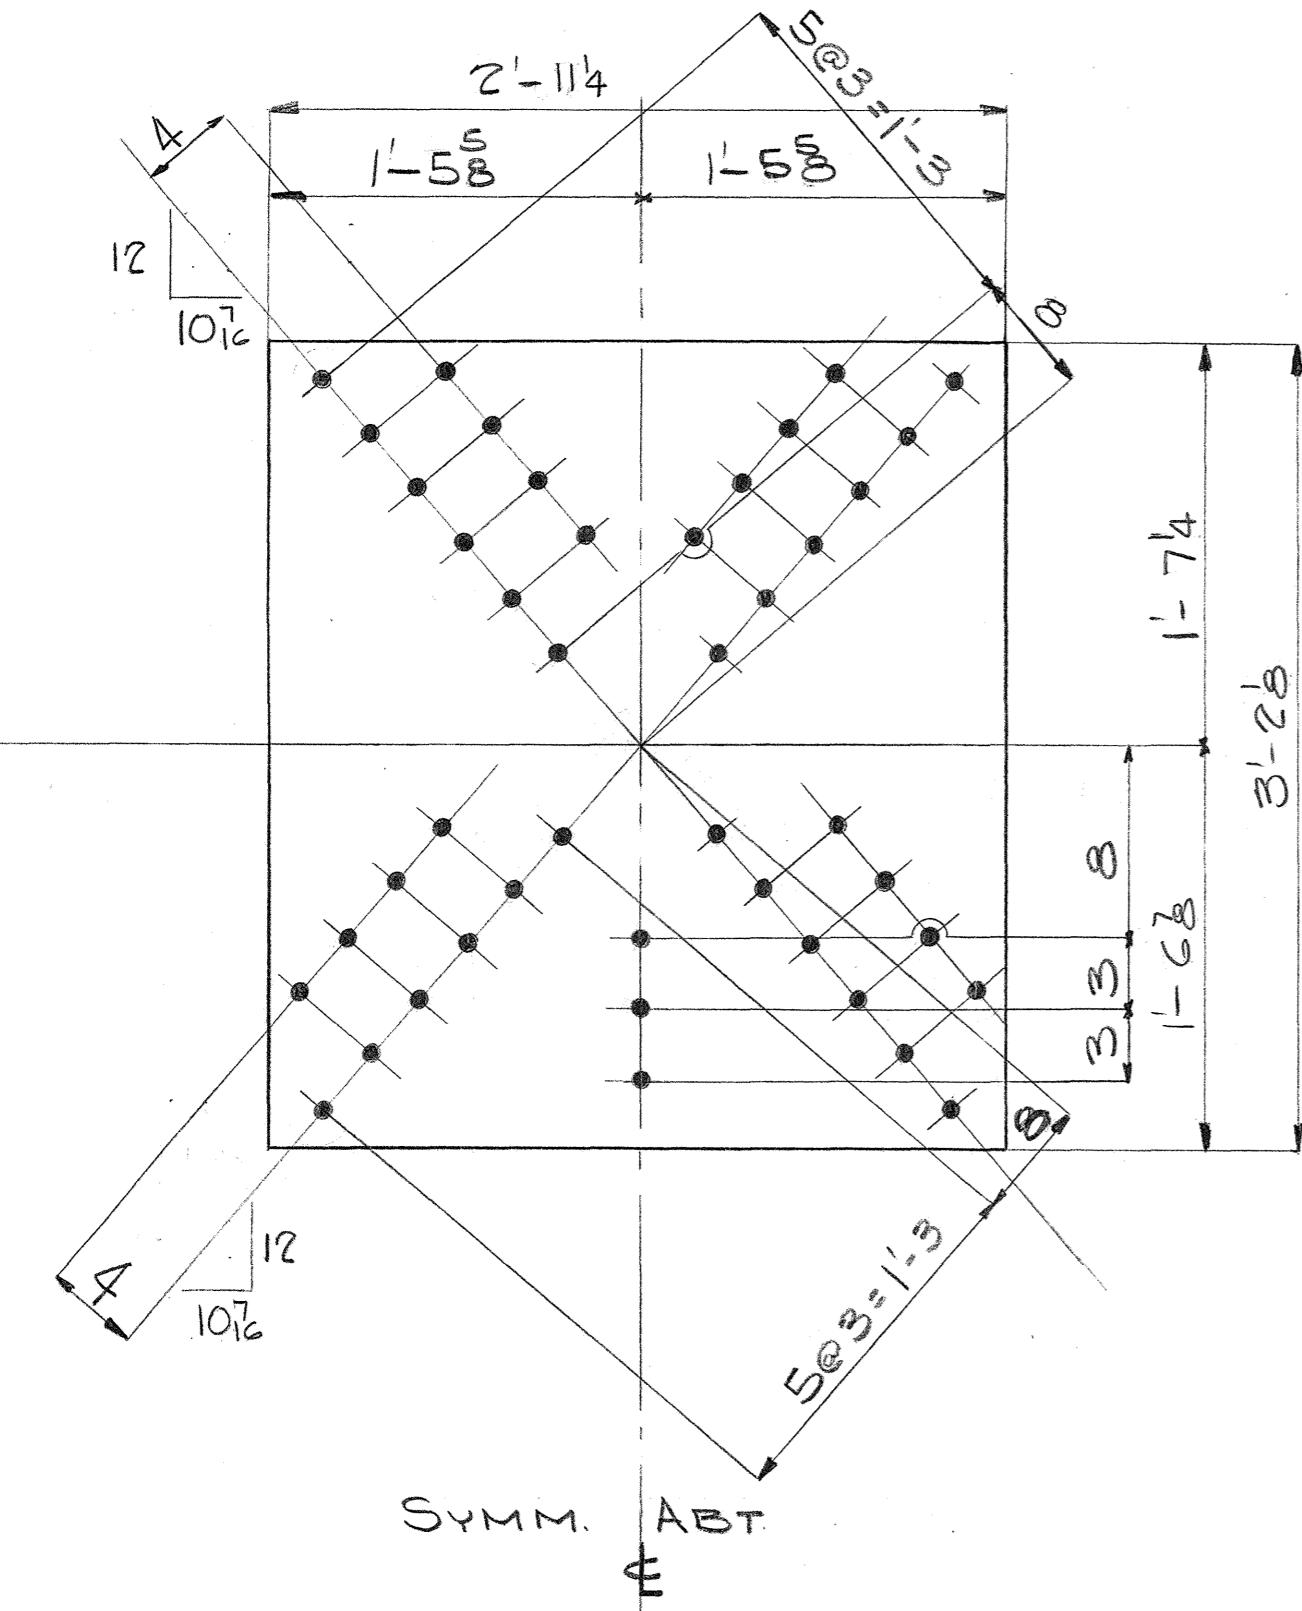

4 PLATES REQ'D. MK. PI-D

Rivets:  $\frac{3}{4}$   
Holes:  $\frac{13}{16}$   $\frac{1}{2}$  ED. UN.  
Paint:


INDUSTRIAL DEVELOPMENT CO.  
ADDITION TO UMAUMA BRIDGE  
HAWAII

INDEPENDENT IRON WORKS, INC.  
OAKLAND, CALIF.

MADE BY DAL 12-13-49 ORDER NO. 3807  
CHECKED BY 1/16-50 SHEET NO. DIGD

5 4 6 8 . 1 7 4 11/75

FED ROAD  
DIRT NO STATE FED AID PROJ. NO. FISCAL YEAR  
HIGHWAY HIGH 300.9(15) 1950 175 300

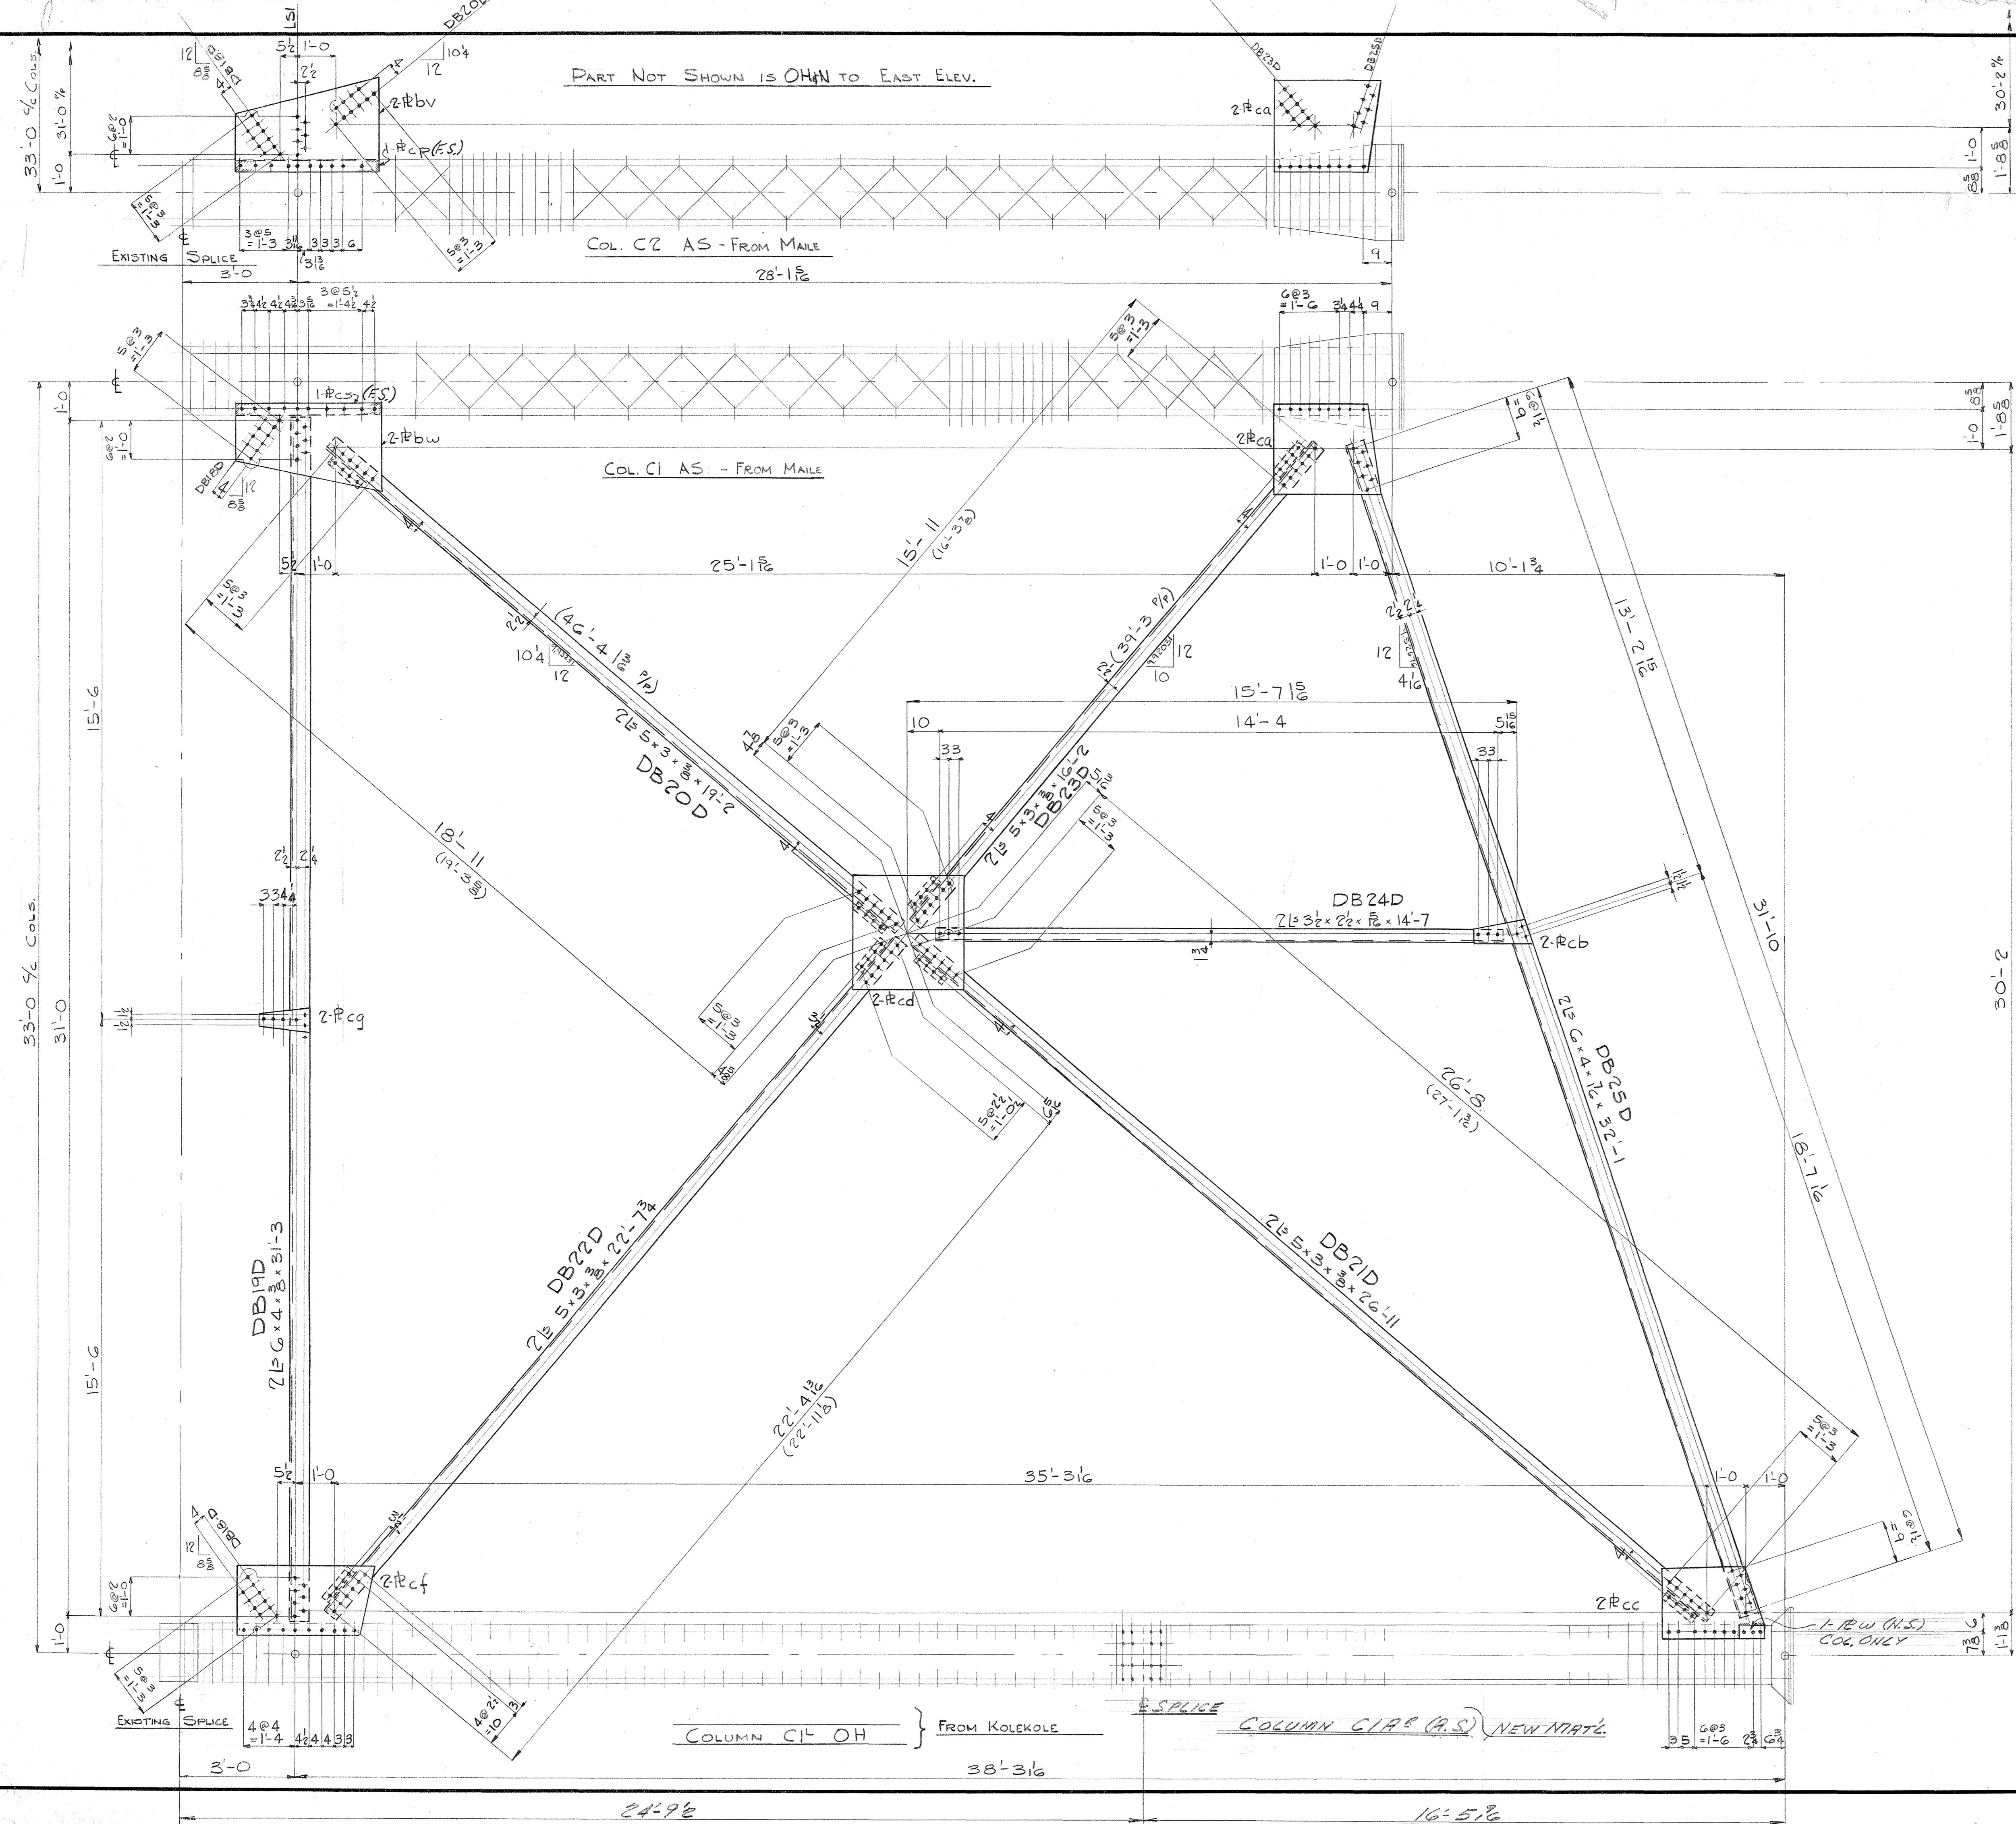

ITEM ADDITION TO UMAUMA BRIDGE, HAWAII					
RIVETS: 34# HOLES: 18# 16 ED UN.					
CUSTOMER INDUSTRIAL DEVELOPMENT CO. JOB NO. 3807					
DRFT'S N'N	CHECKED	APPR'D	NEXT ASSEMBLY	SCALE	DRWG. NO.
DAL	<i>[Signature]</i>				D17D

OAKLAND, CALIFORNIA 12-16-49 1-17-50





THIS PRINT MUST NOT BE COPIED IN WHOLE OR IN PART OR USED DEDIMENTALLY TO OUR INTEREST

5468.175

FED. ROAD DIST. NO.	STATE	FED. AID PROJ. NO.	FISCAL YEAR	SHEET NO.	TOTAL SHEETS
HAWAII	HON	FDK 312	1950	176	309

## BILL OF MATERIAL INDUSTRIAL DEV. CO.

No.	Description	Length Ft. In.	Mark	REMARKS
NOTE : REVAMP THE BRACES LISTED BELOW AS SHOWN ON DETAILS.				
1	BRACE	16' 18"	TB4	KOLE KOLE SALVAGE FROM
1	Do.	16' 8 1/2"	TB13	KOLE KOLE

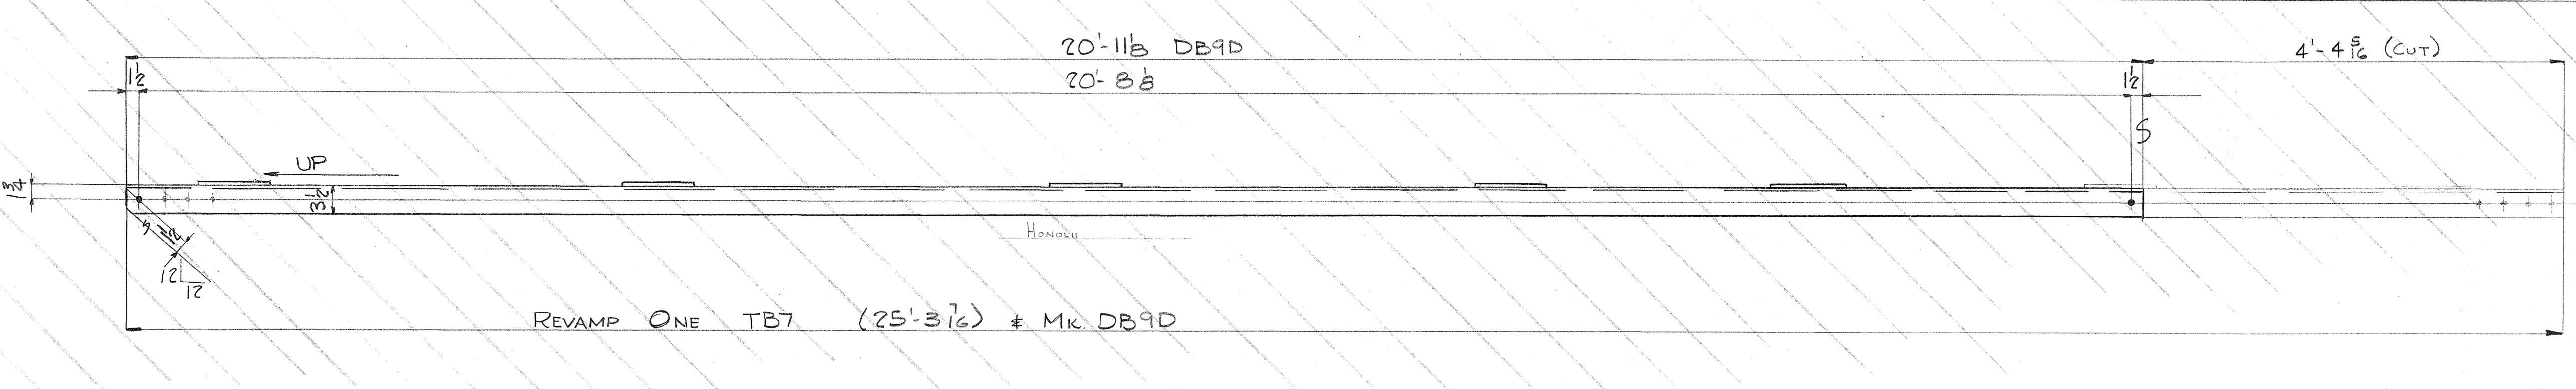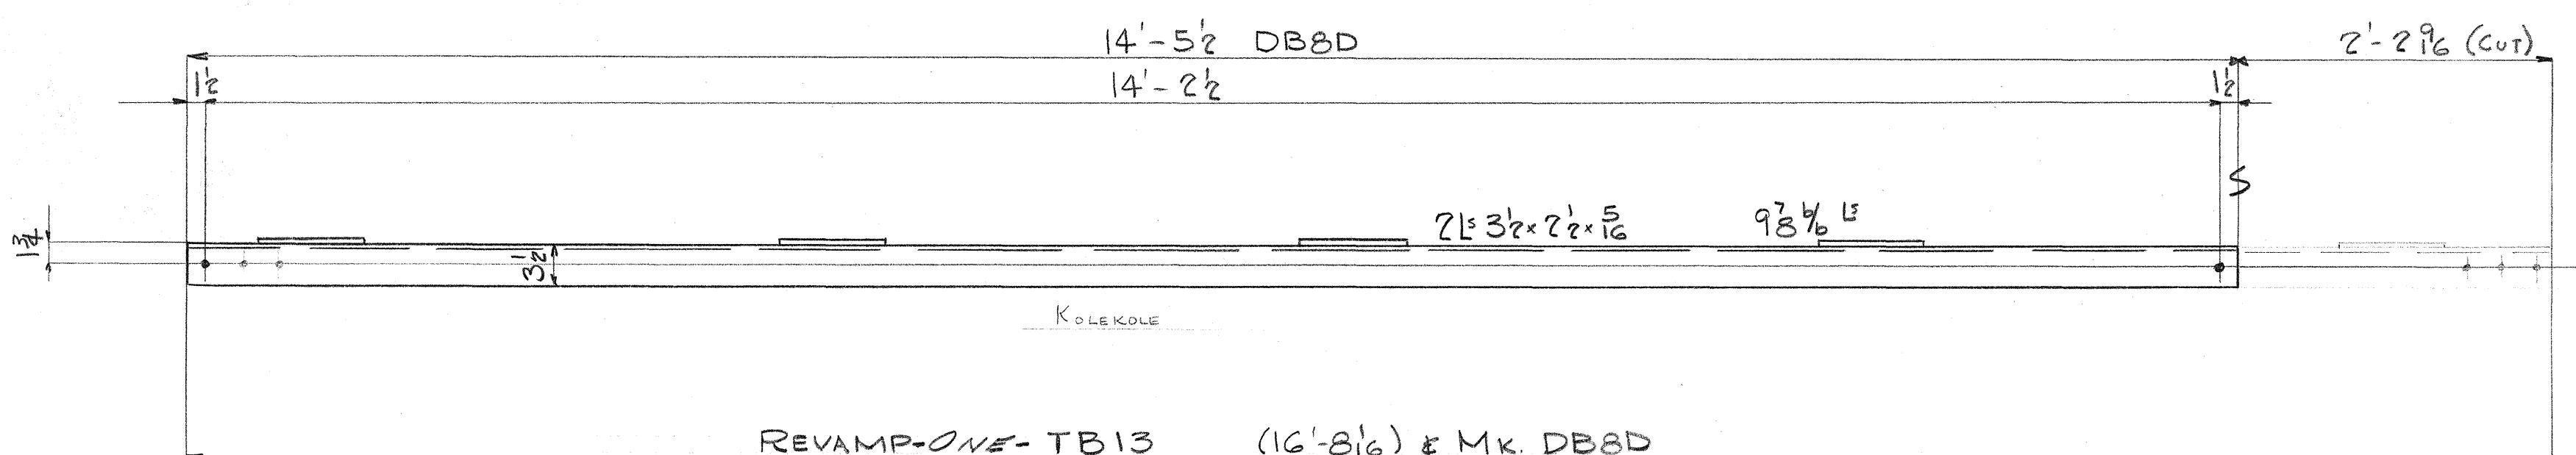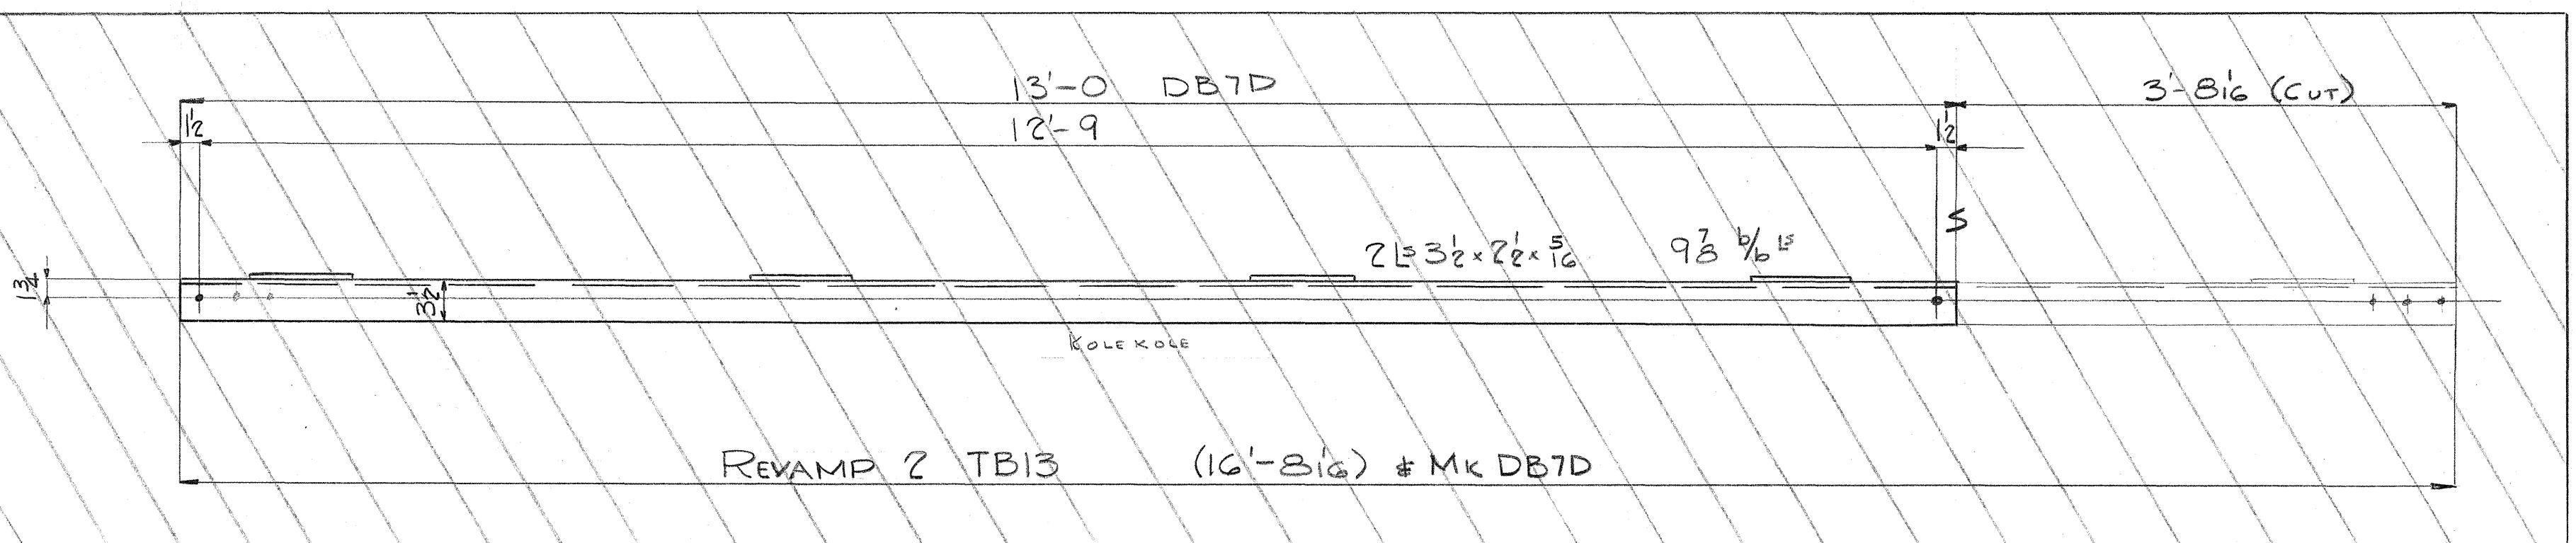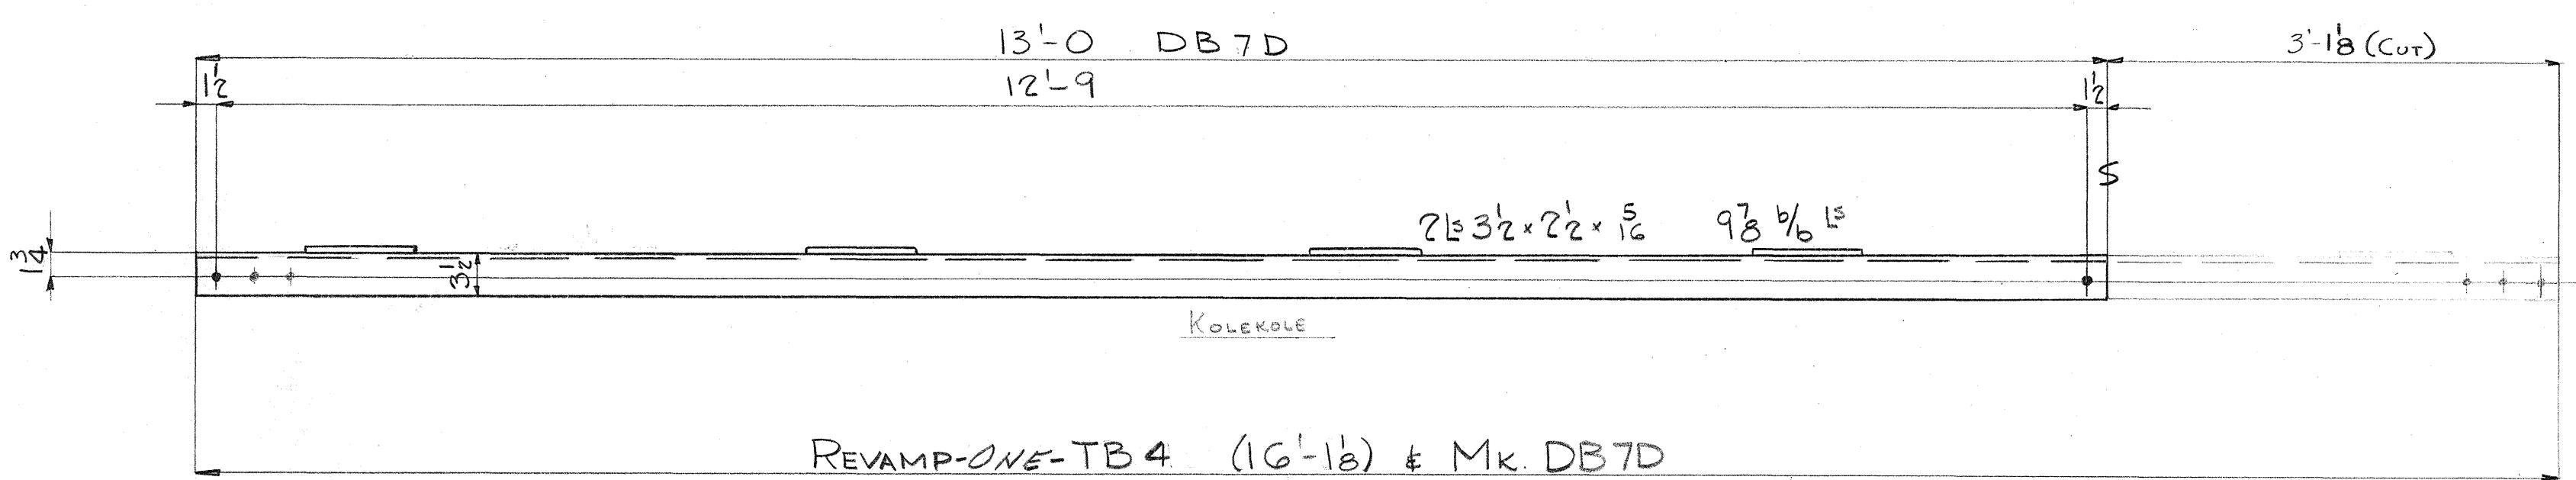

Rivets:  $\frac{3}{4}$   
Holes:  $1\frac{3}{16}$   $1\frac{1}{2}$  ED  
Paint:

INDUSTRIAL DEVELOPMENT COMPANY  
ADDITION TO UMAUMA BRIDGE  
HAWAII



INDEPENDENT IRON WORKS, INC.  
OAKLAND, CALIF.  
MADE BY DAL 12-21-49 ORDER NO. 3807  
CHECKED BY OAH 1-17-50 SHEET NO. D18D

5468.176

FED. ROAD DIST. NO.	STATE	FED. AID PROJ. NO.	FISCAL	SHEET	TOTAL
Hawaii	Haw	SDR 3(13)	1950	177	304

## **BILL OF MATERIAL**

No.	Description	Length		Mark	REMARKS
		Ft.	Ins.		
<u>NOTE: REVAMP THE PIECES LISTED BELOW AS SHOWN ON THE DETAILS</u>					
1	BRACE		13B		
1	Do.		97B		
<u>NEW MATERIAL IS LISTED BELOW</u>					
2	BRACES			DB17D	
1	Do.			LVI	
10	STRUTS			LSI	
4	" $3 \times 3 \times \frac{3}{8}$	0	8 $\frac{1}{2}$	a	TEMP.
2	" $6 \times 4 \times \frac{3}{8}$	2	2	b	Do.
12	R $8\frac{1}{2} \times \frac{5}{16}$	1	5 $\frac{3}{4}$	c	Do.
4	" $3\frac{1}{2} \times 2\frac{1}{2} \times \frac{5}{16}$	17	6	d	
2	" $3\frac{1}{2} \times 2\frac{1}{2} \times \frac{5}{16}$	10	9 $\frac{3}{4}$	f	
20	R $14\frac{3}{8} \times \frac{9}{16}$	1	2 $\frac{1}{2}$	g	TEMP.
20	R $3 \times \frac{3}{8}$	1	0 $\frac{3}{4}$	h	Do.
20	" $6 \times 4 \times \frac{3}{8}$	31	3	k	
190	F.B. $2\frac{1}{2} \times \frac{3}{8}$	1	1 $\frac{1}{2}$	m	
752	$\frac{3}{4} " 4$ RIVETS			(SHOP)	

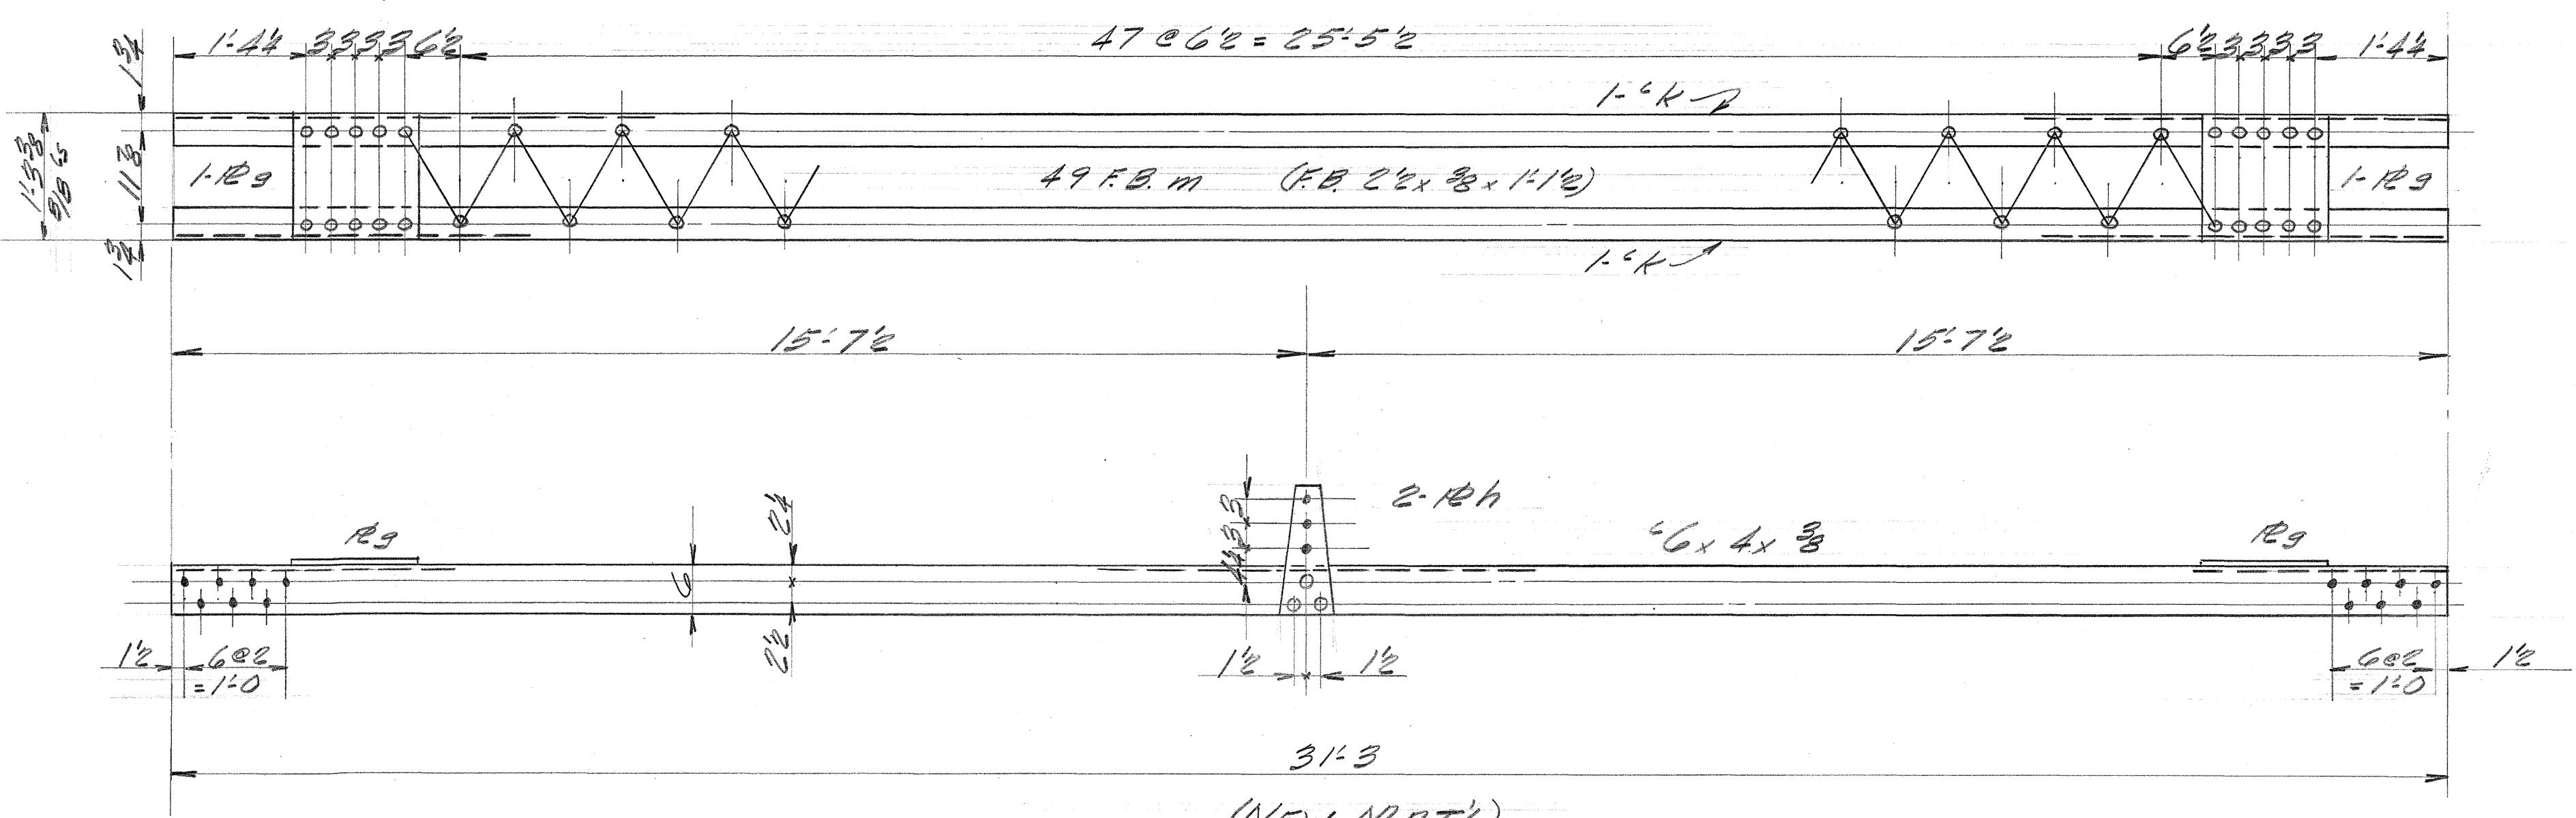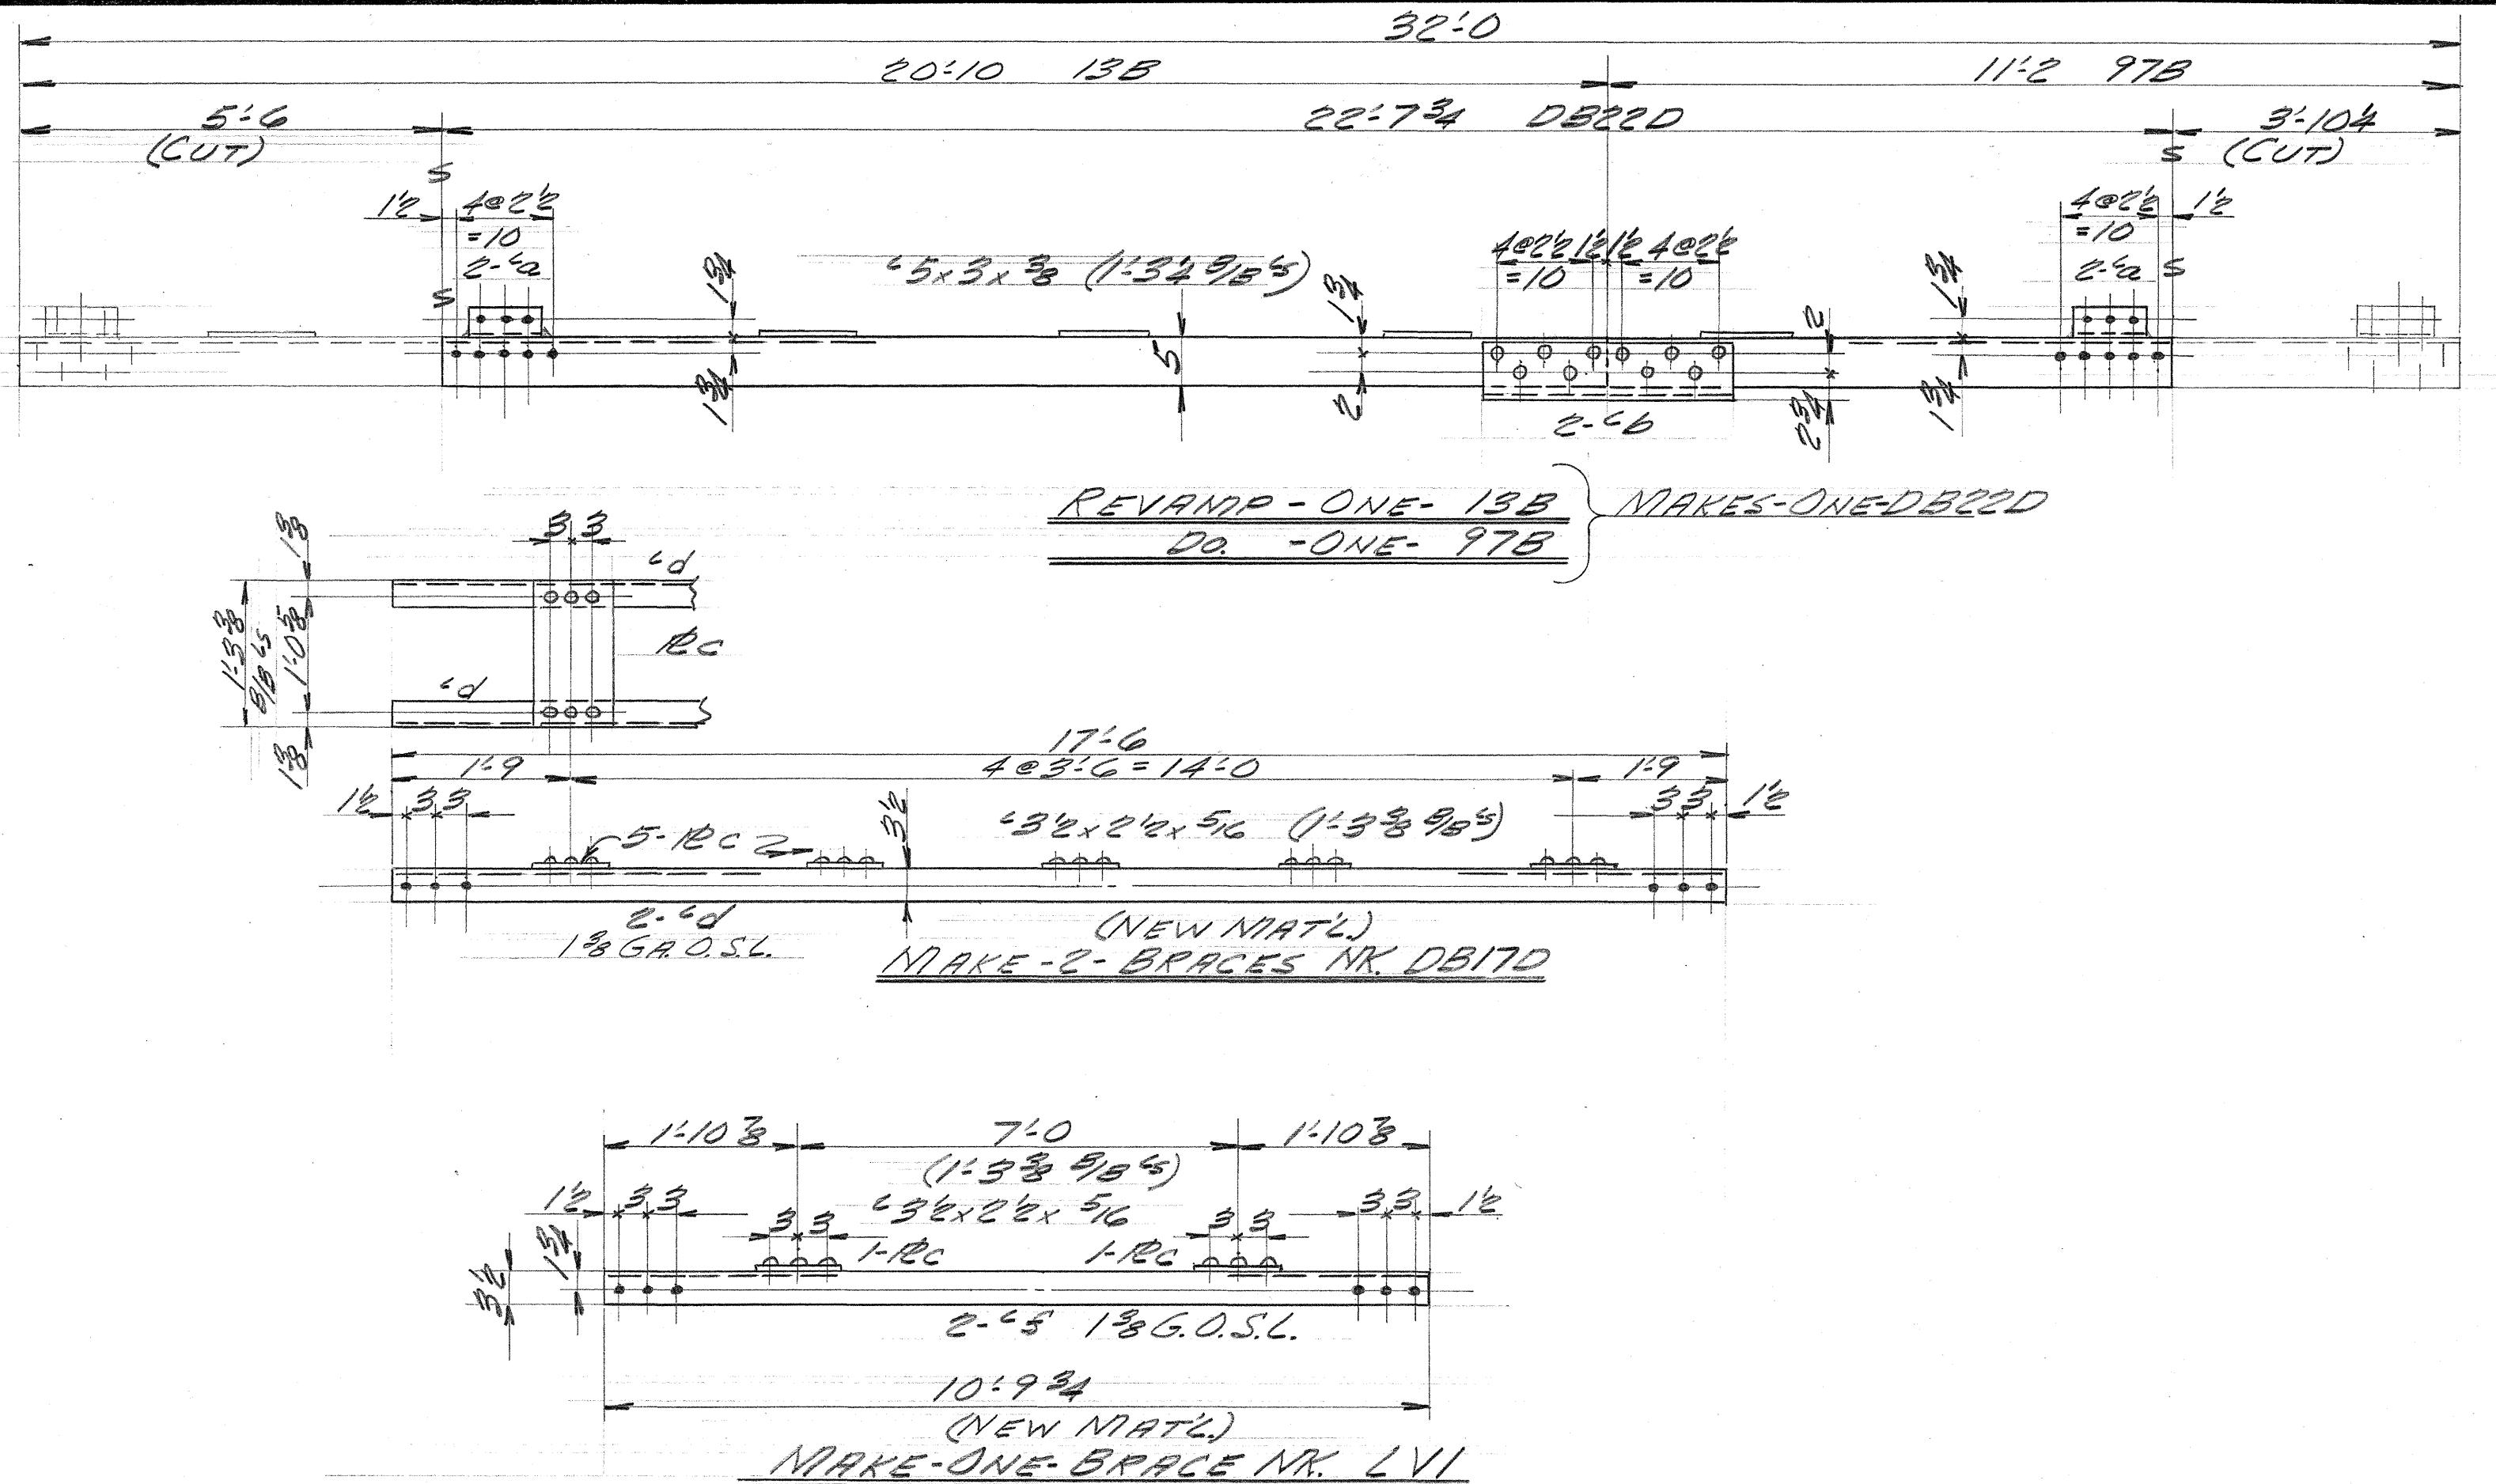

Rivets:  $\frac{3}{4}^{\prime\prime}$       Holes:  $\frac{13}{16}^{\prime\prime}$       Paint: (SEE SPECS.)

# INDUSTRIAL DEV. CO.

ADDITION TO THE  
UNAUNIR BRIDGE  
- HAWAII -  
**INDEPENDENT IRON WORKS, INC.**  
**OAKLAND, CALIF.**

MADE BY	<u>DW</u>	<u>8-22-50</u>	ORDER NO.	<u>3807</u>
CHECKED BY			SHEET NO.	<u>7190</u>

5462 1 P.E.

3465.1




1

5468.156

FED. ROAD BIST. NO.	STATE	FED. AID PROJ. NO.	FISCAL YEAR	SHEET NO.	TOTAL SHREETS
HAWAII HONDR2034D20				178 300	


**BILL OF MATERIAL**UNAUNUA  
BRIDGE

No.	Description	Length Ft. In.	Mark	REMARKS
NOTE: REVAMP THE BRACES LISTED BELOW AS SHOWN ON THE DETAILS				
3	BRACES	82A		
3	Do.	83A		
1	Do.	84A		
1	Do.	74B		
1	Do.	75B		
1	Do.	81A		
1	Do.	85A		
1	Do.	86A		
1	Do.	87A		
1	Do.	68B		
1	Do.	69B		
1	Do.	26B		

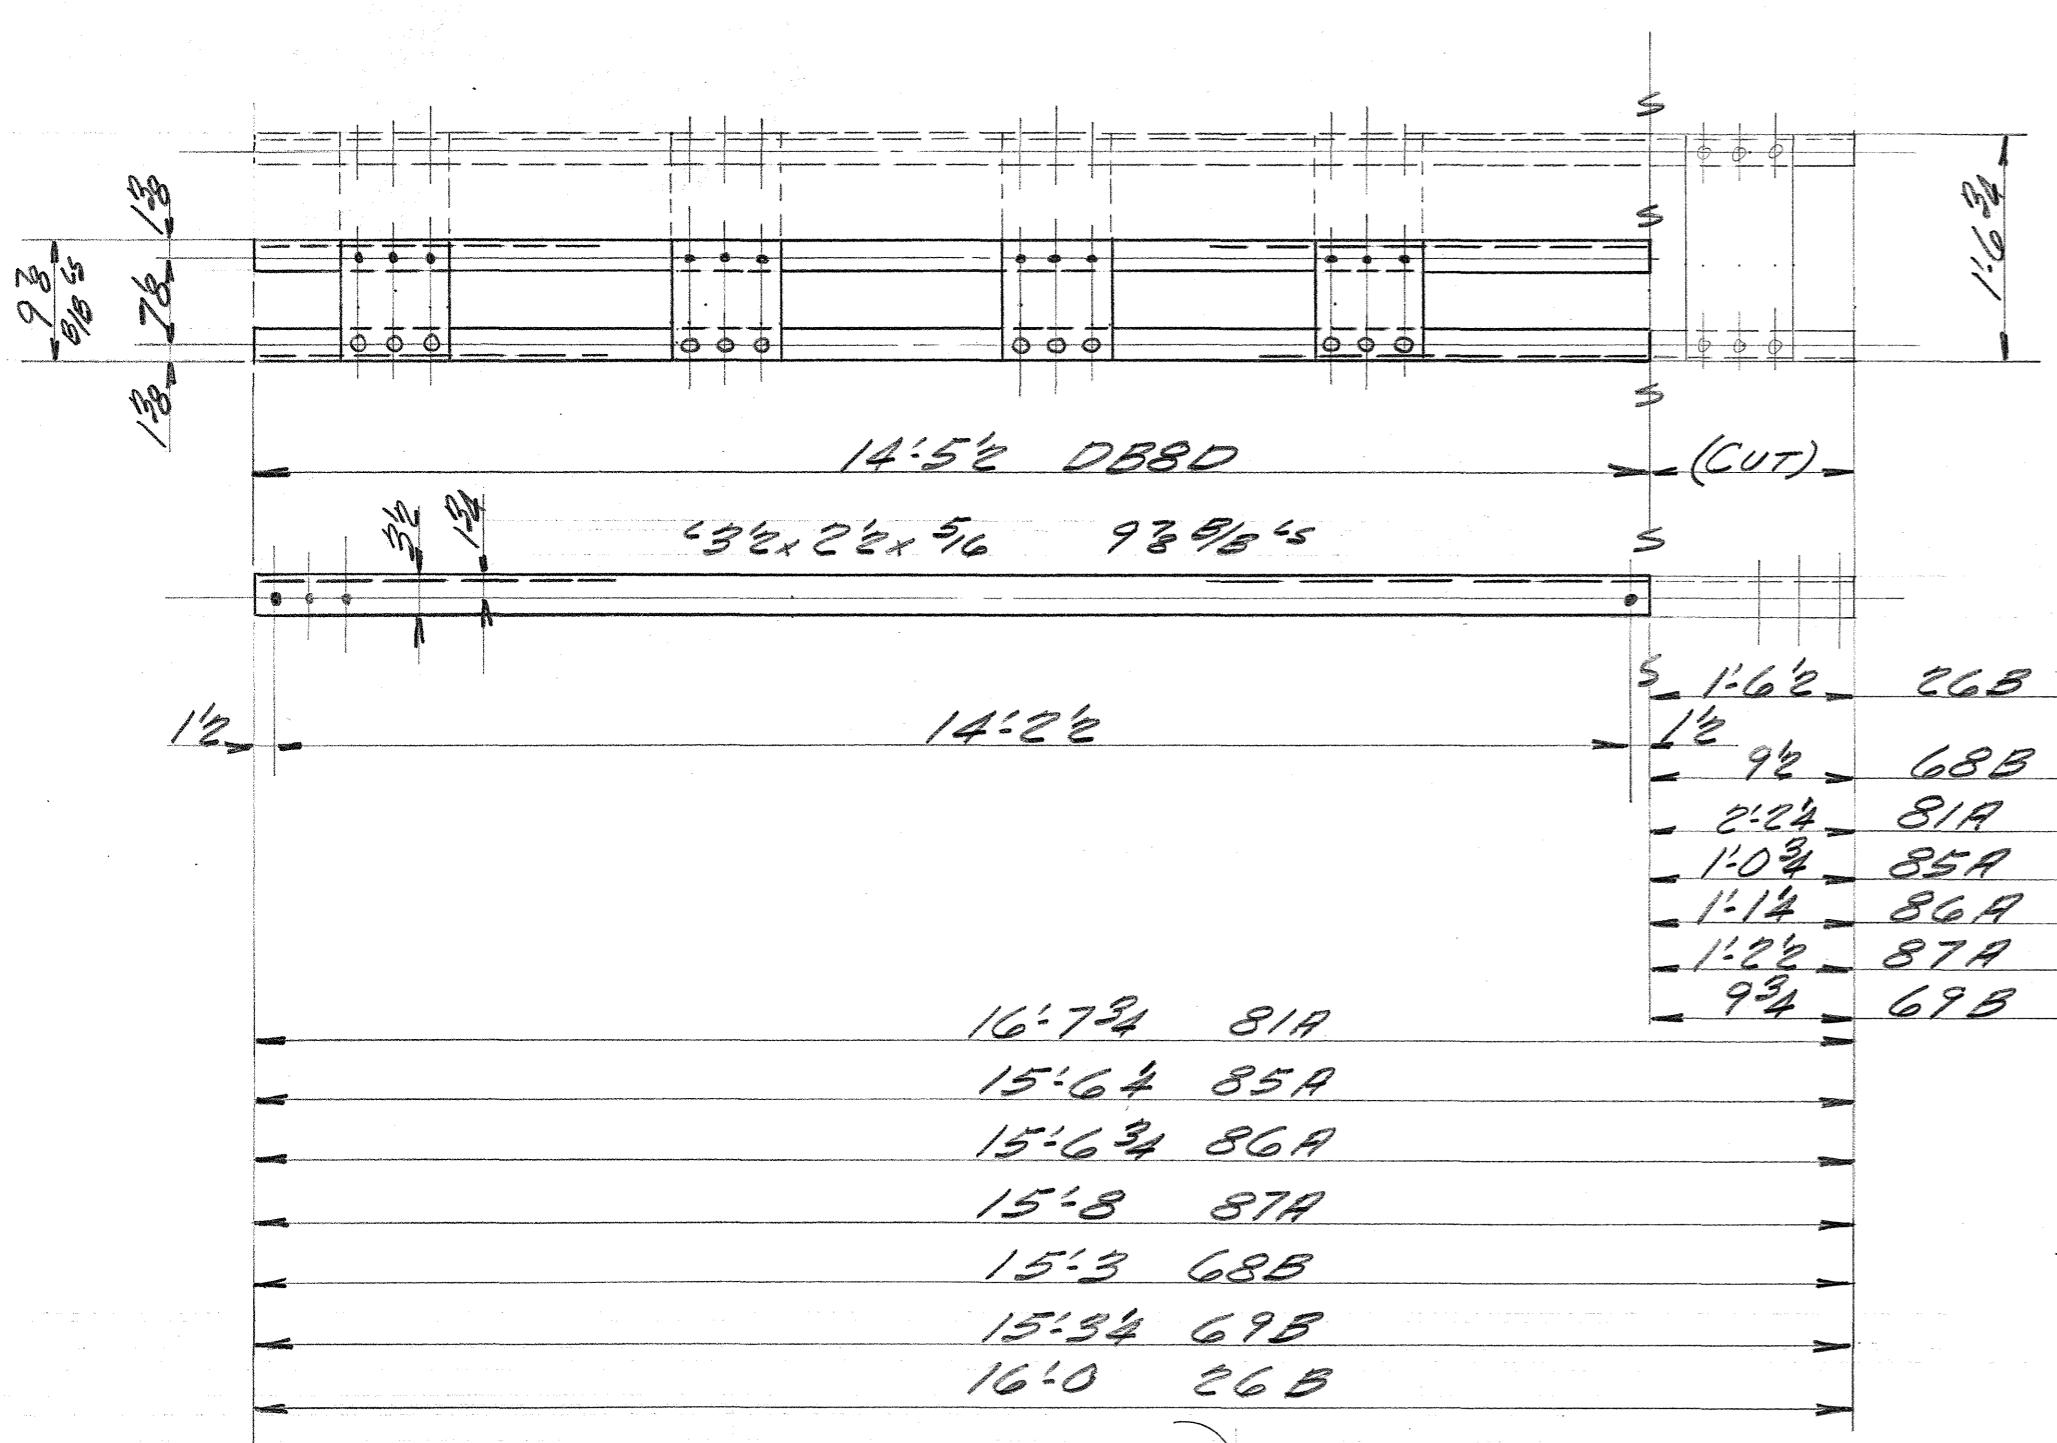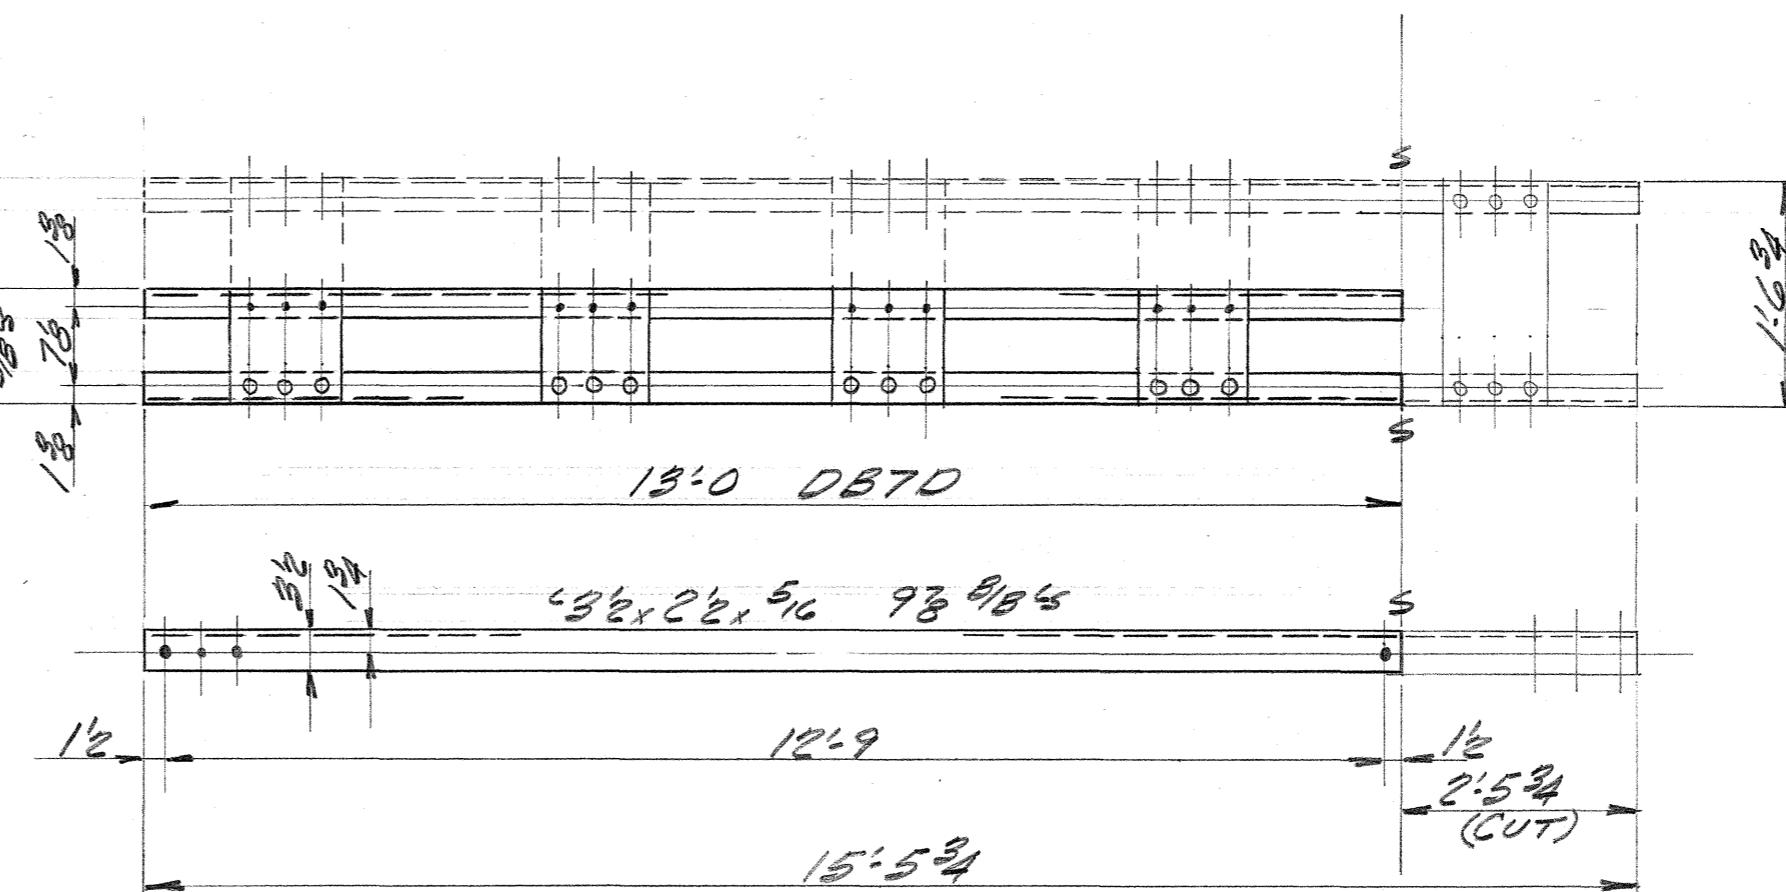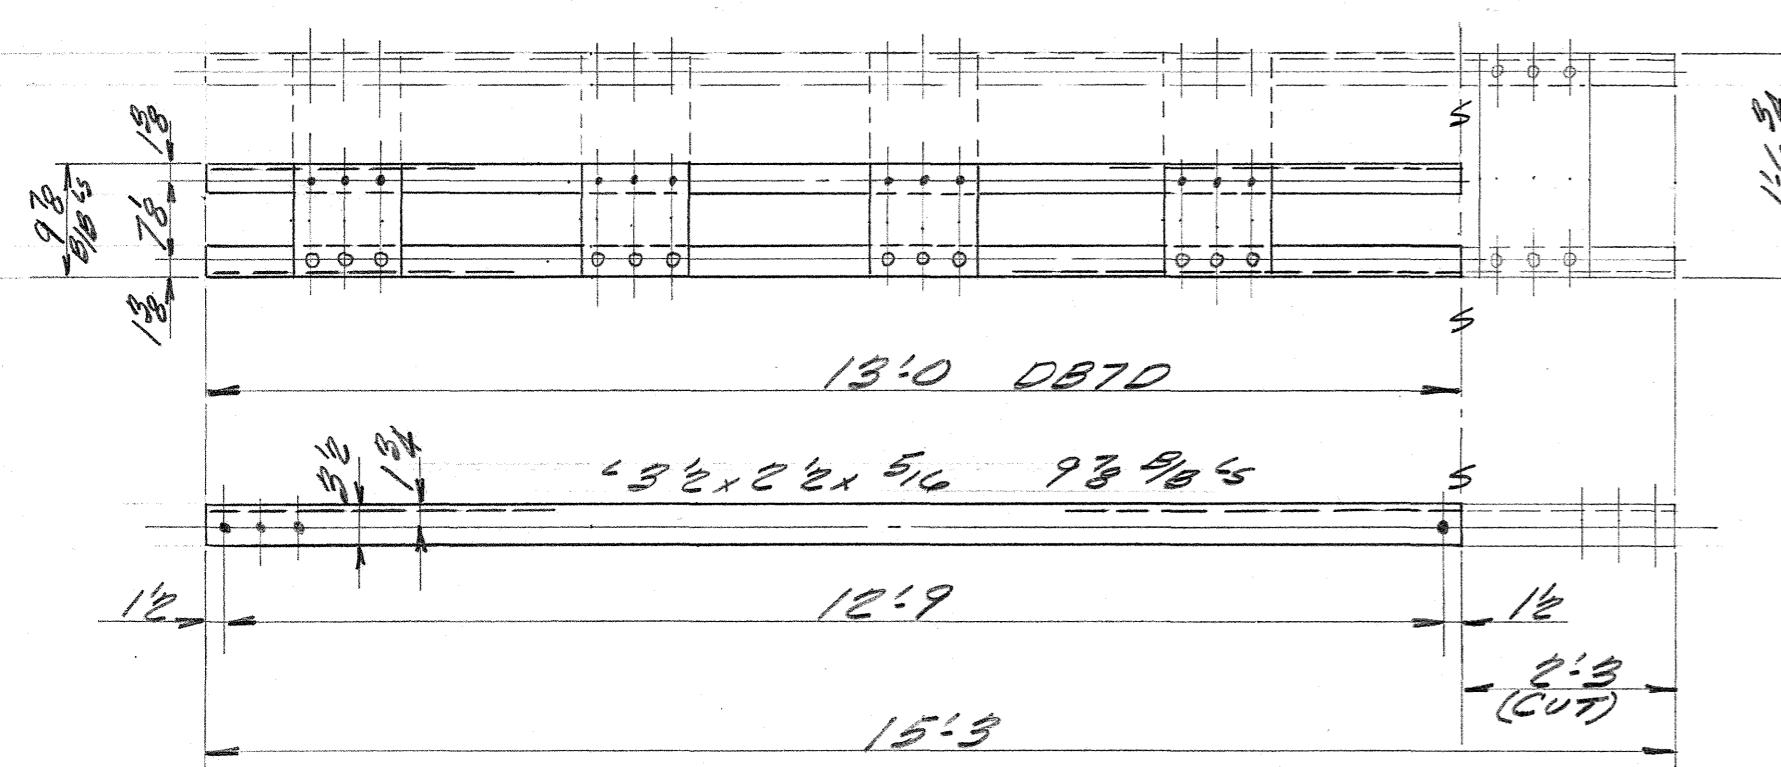


REVAMP-ONE-81A  
Do. Do. 85A  
Do. Do. 86A  
Do. Do. 87A  
Do. Do. 68B  
Do. Do. 69B  
Do. Do. 26B

MAKES 7 DB80

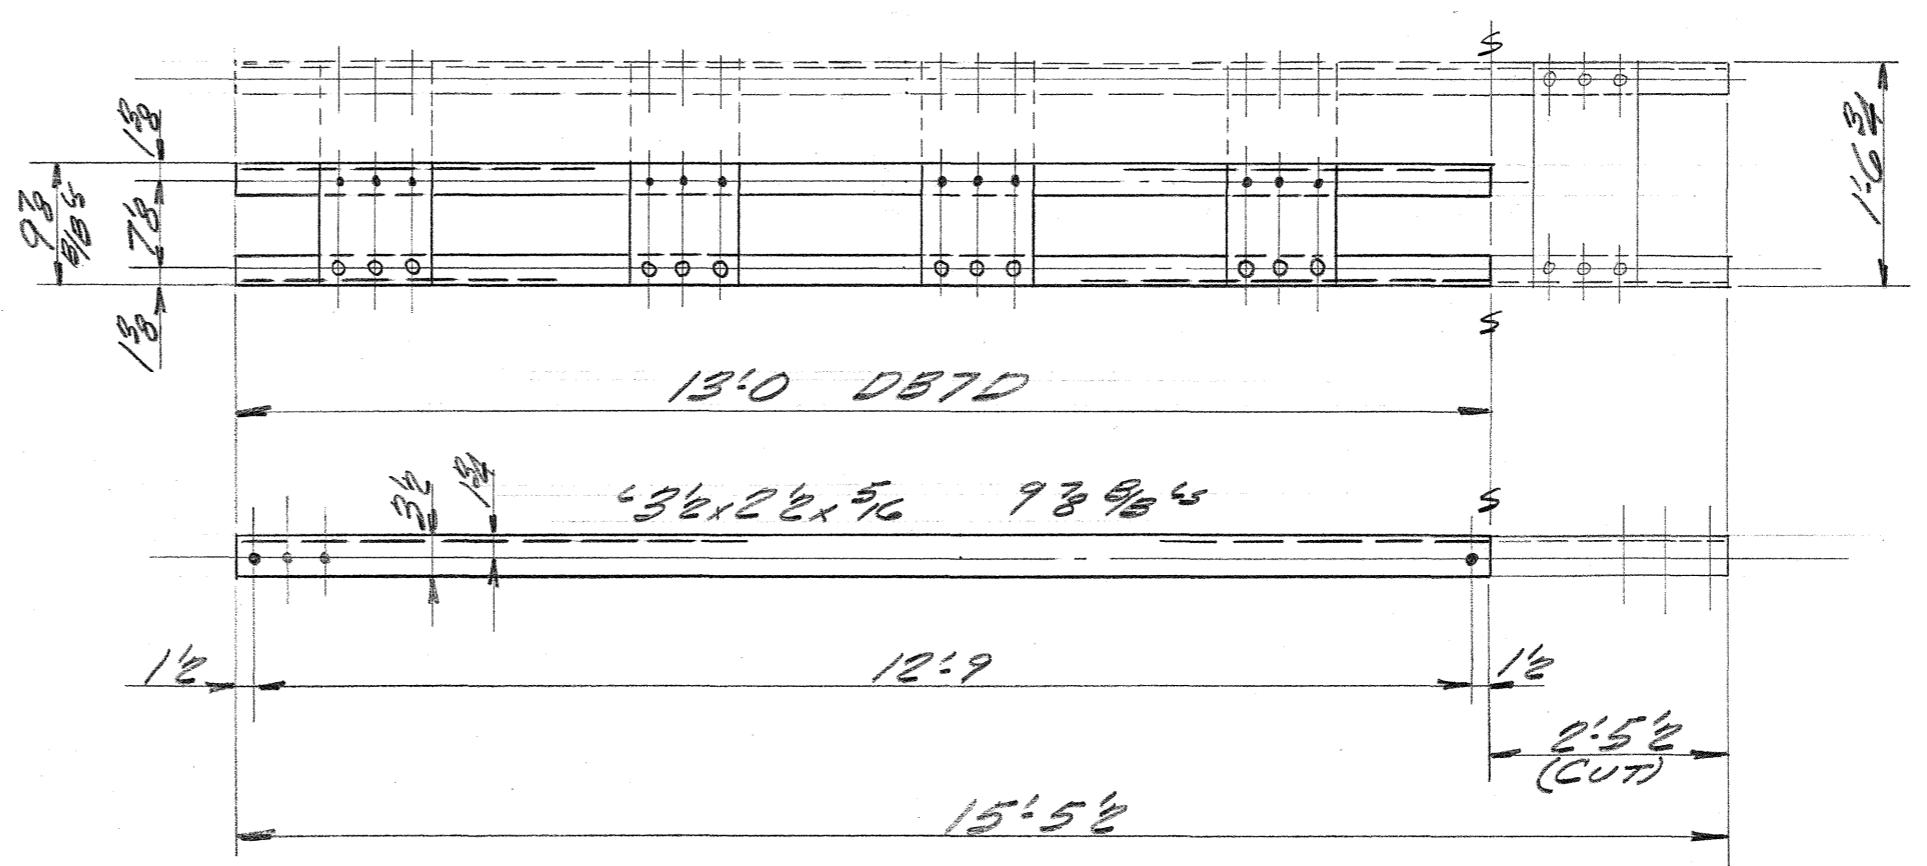

REVAMP-ONE-84A (MAKES ONE DB70)

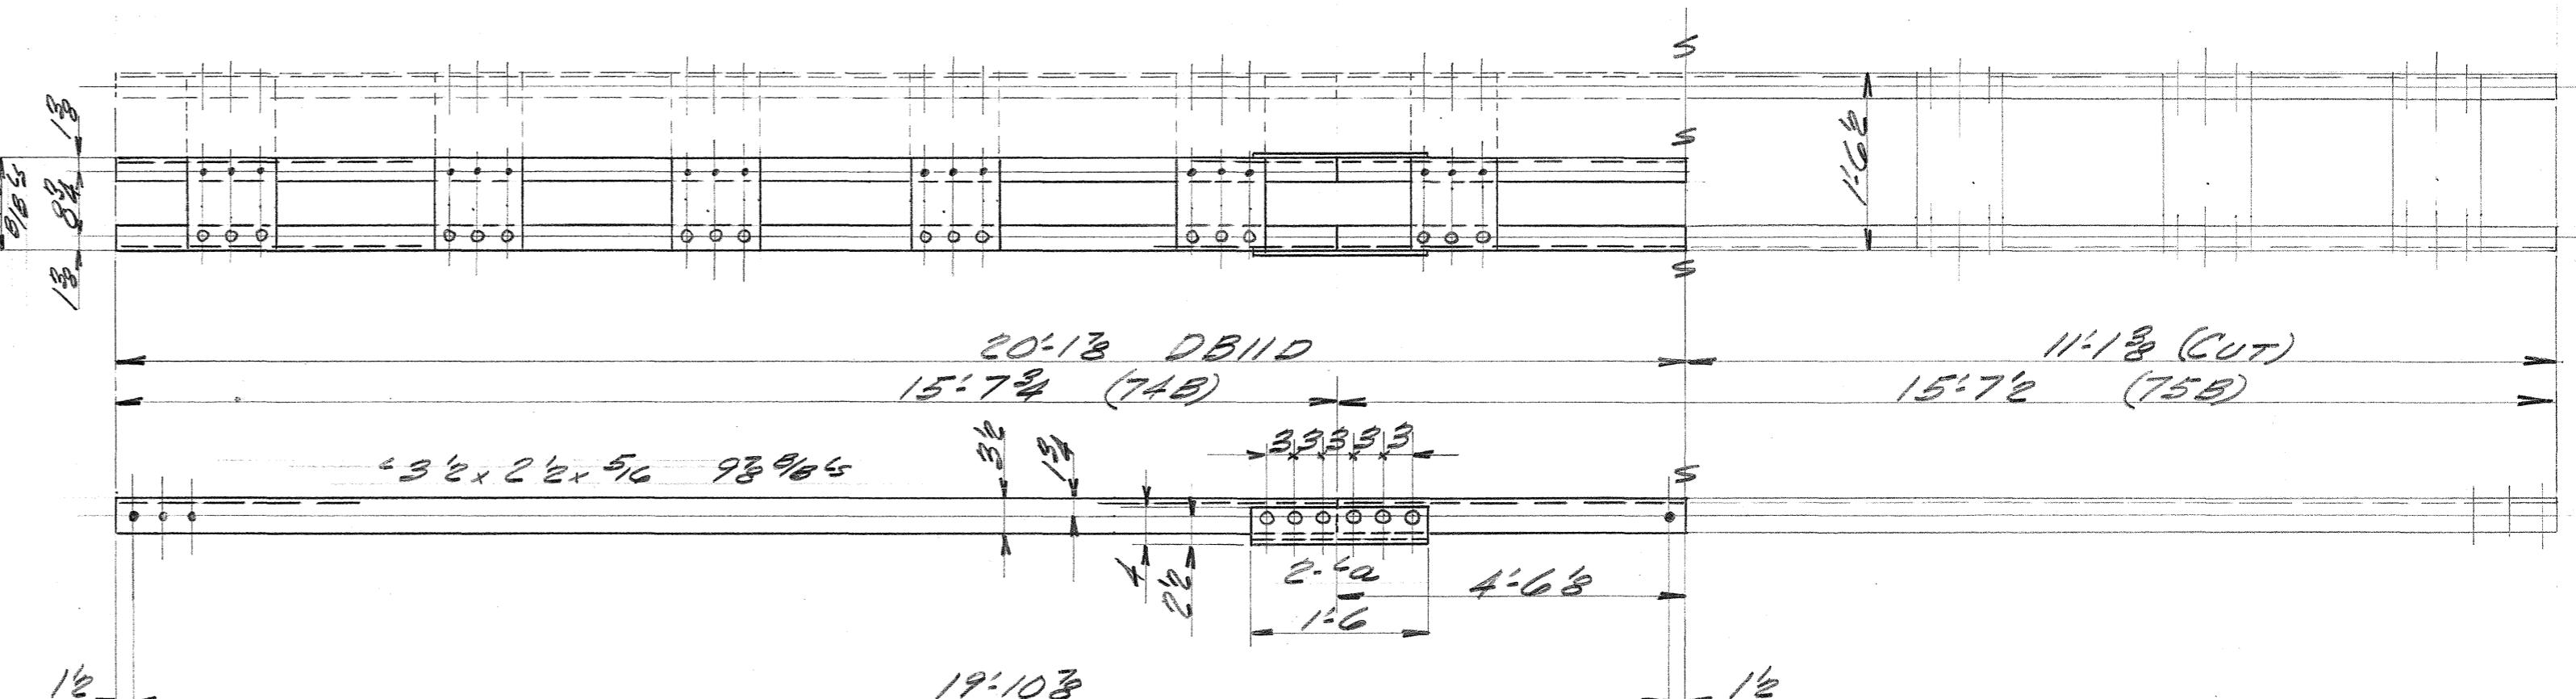

REVAMP-ONE-74B  
Do. -ONE- 75B

Rivets: 3/4" Ø  
Holes: 1 1/2" Ø  
Paint: (SEE SPEC'S)

INDUSTRIAL DEV. CO

ADDITION TO THE  
UNAUNUA BRIDGE  
- HAWAII -INDEPENDENT IRON WORKS, INC.  
OAKLAND, CALIF.




MADE BY	801	8-1950	ORDER NO.	3807
CHECKED BY			SHEET NO.	D200

FED. ROAD DIST. NO.	STATE	FED. AID PROJ. NO.	FISCAL YEAR	SHEET NO.	TOTAL SHEETS
---------------------	-------	--------------------	-------------	-----------	--------------


Hawaiian 50131950 172 302

## BILL OF MATERIAL INDUSTRIAL Dev. G

No.	Description	Length Ft.	Length In.	Mark	REMARKS
2	BRACE	11	7 1/2	TBI	KOLEKOLE
2	Do	10	5 1/2	TB14	Do
2	PB 3 1/2 x 3	0	7	a	Temp-New
4	L 4 x 4 x 1/2	2	0	b	Temp-New
2	PB 3 1/2 x 3/4	0	7	c	Temp. New

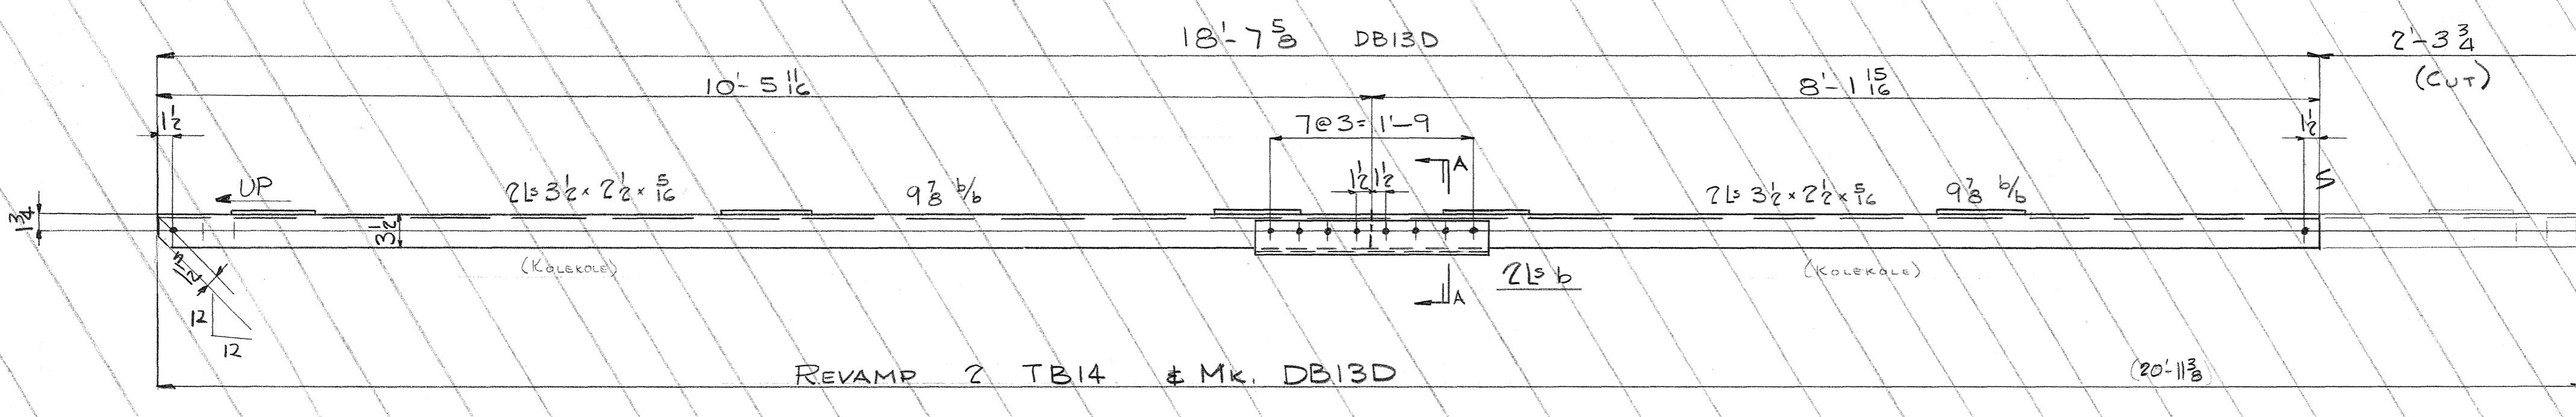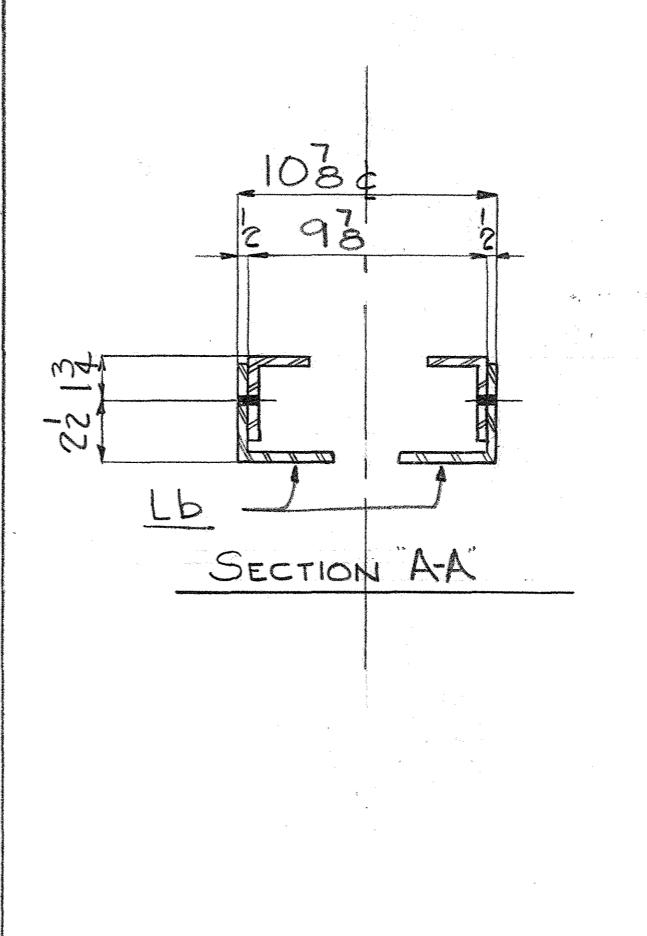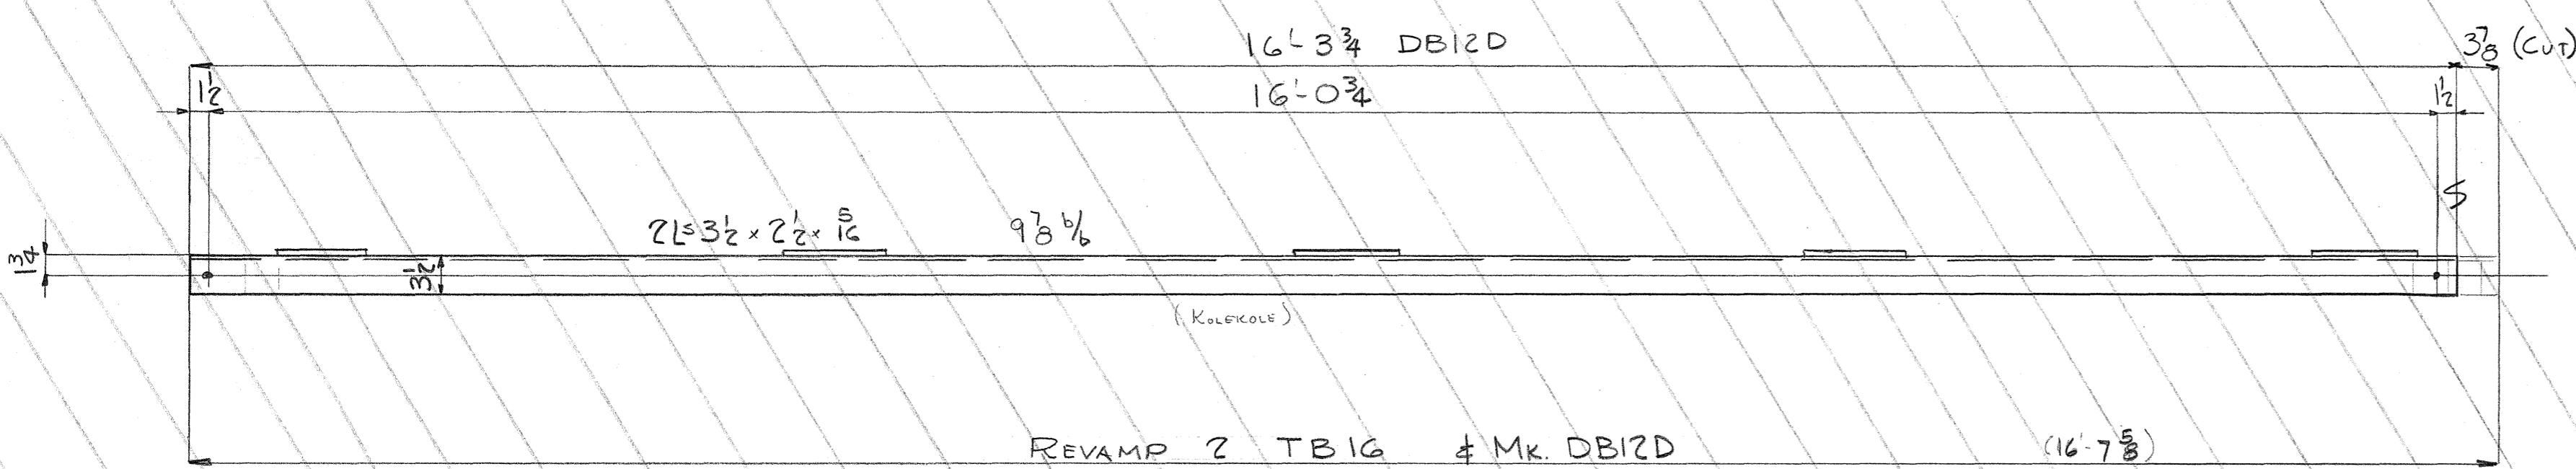

1	1	1	1	1	1
1	1	1	1	1	1
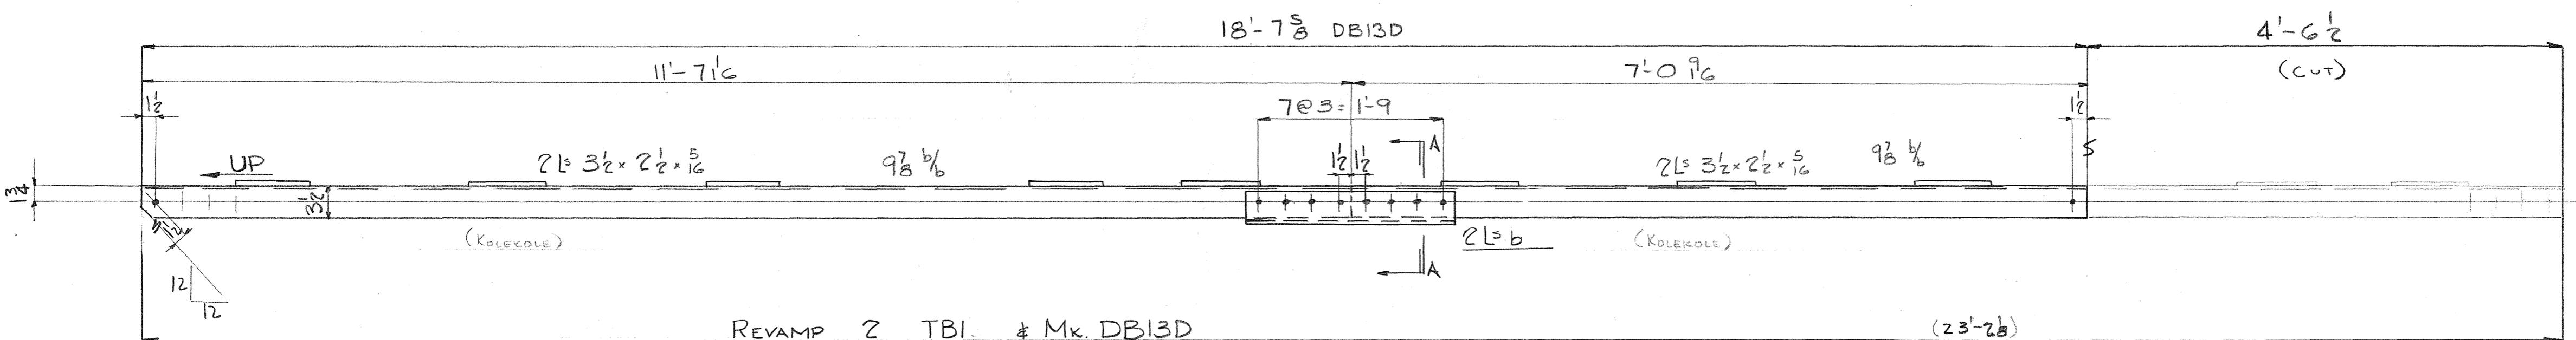


Rivets:  $\frac{3}{4}$   $\frac{1}{2}$   
Holes:  $\frac{1}{2}$   $\frac{1}{2}$  ED.  
Paint:

INDUSTRIAL DEVELOPMENT CO.  
ADDITION TO UMAUMA BRIDGE  
HAWAII

INDEPENDENT IRON WORKS, INC.  
OAKLAND, CALIF.






MADE BY DAL 12-23-49 ORDER NO. 3807  
CHECKED BY DWI 1-18-50 SHEET NO. D21D

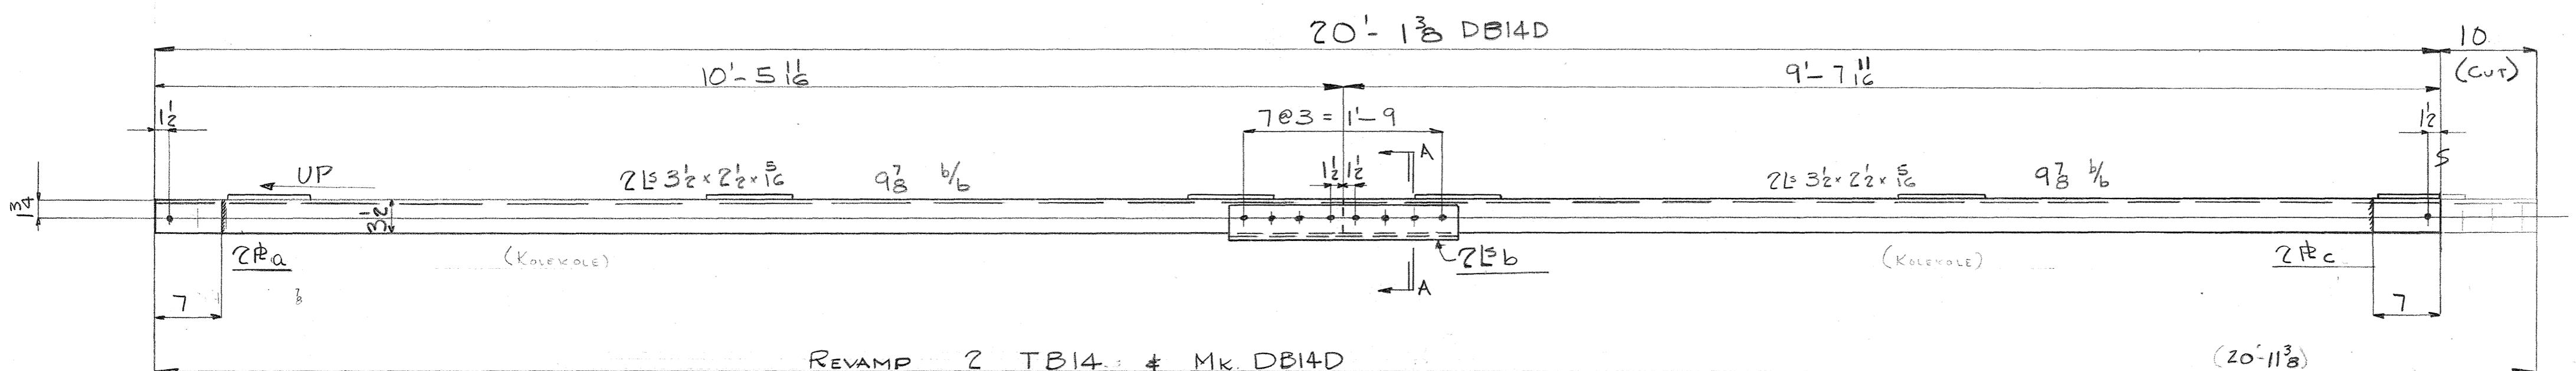




5468.179

FED. ROAD DIST. NO.	STATE	FED. AID PROJ. NO.	FISCAL YEAR	HEET NO.	TOTAL SHEETS
HAWAII	HAW	SDR-2(3)	1950	180	304



Order No. 3807 Sheet No. D22D

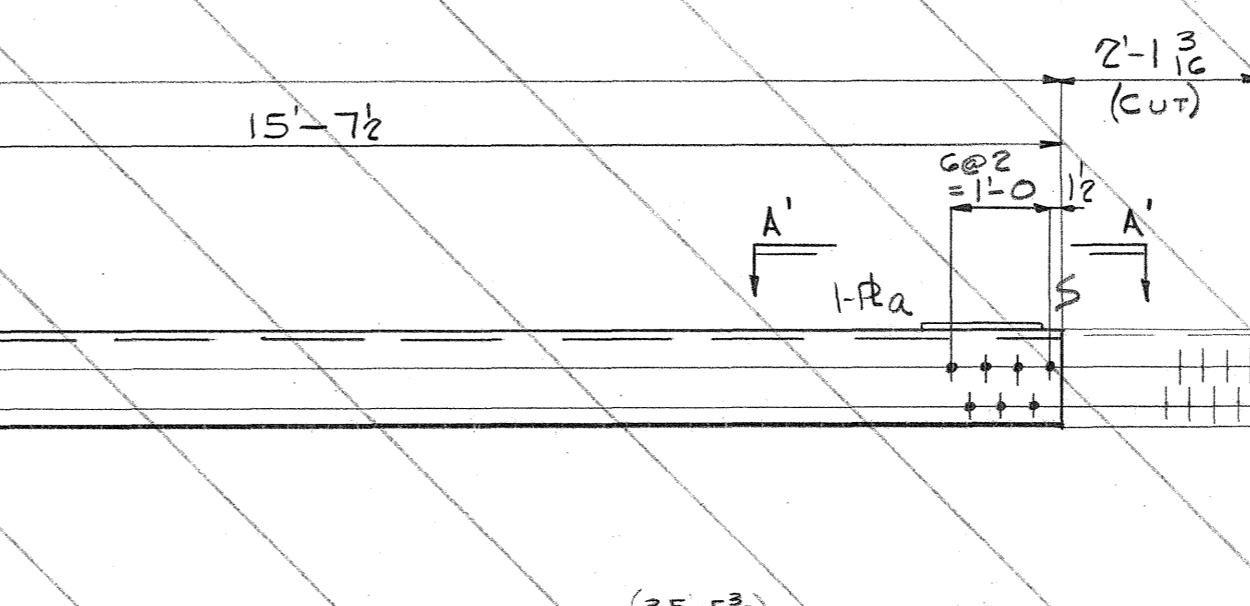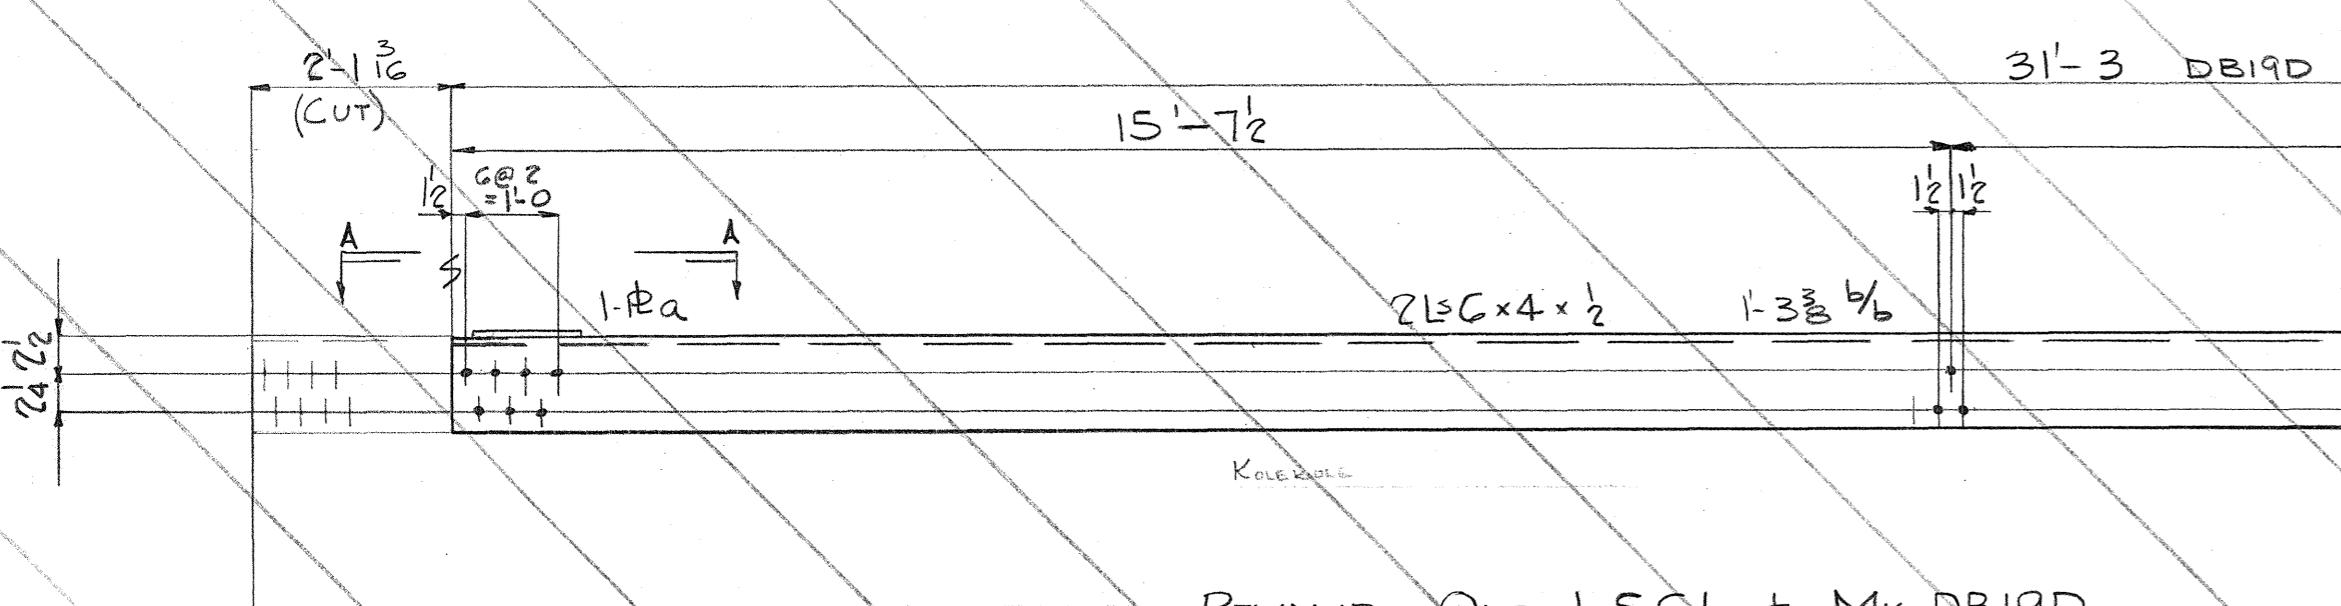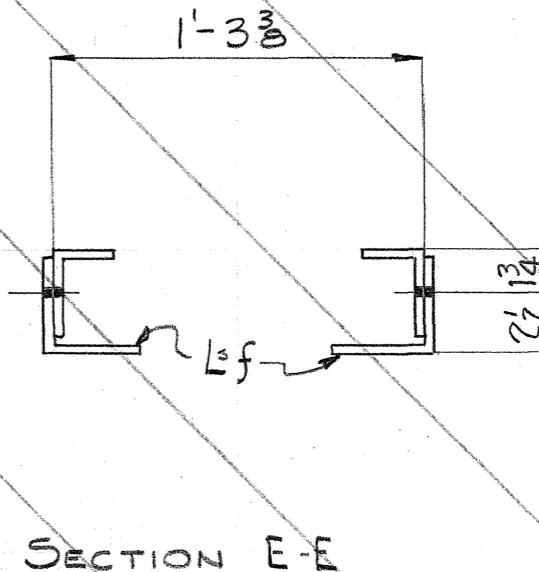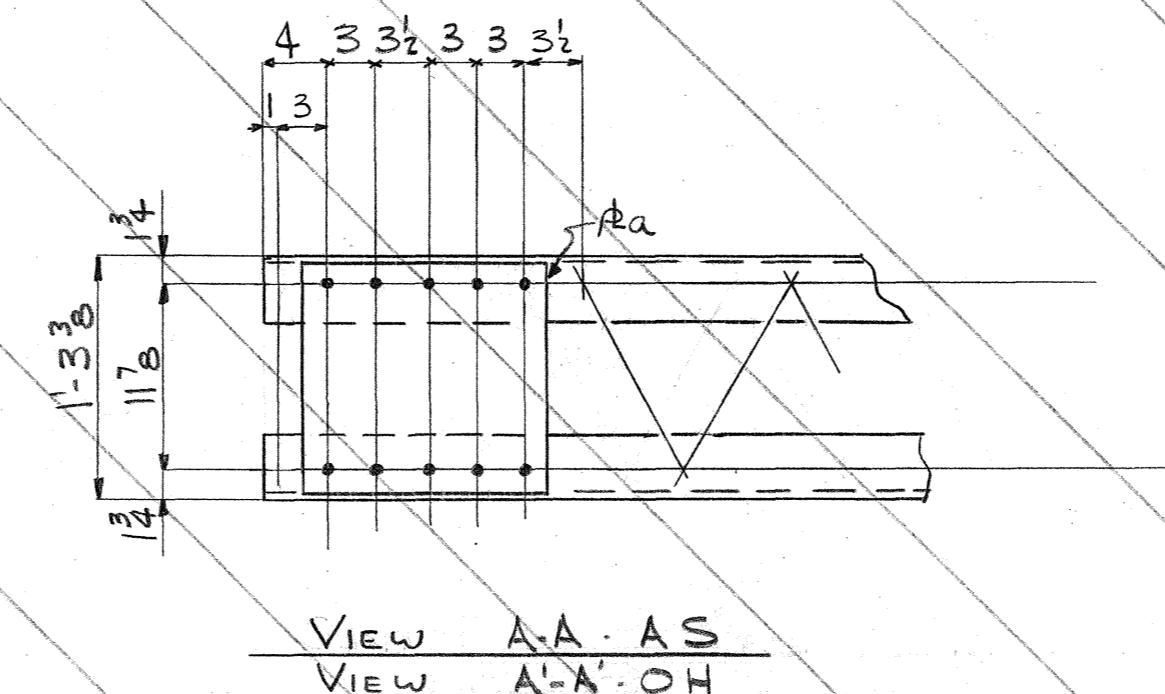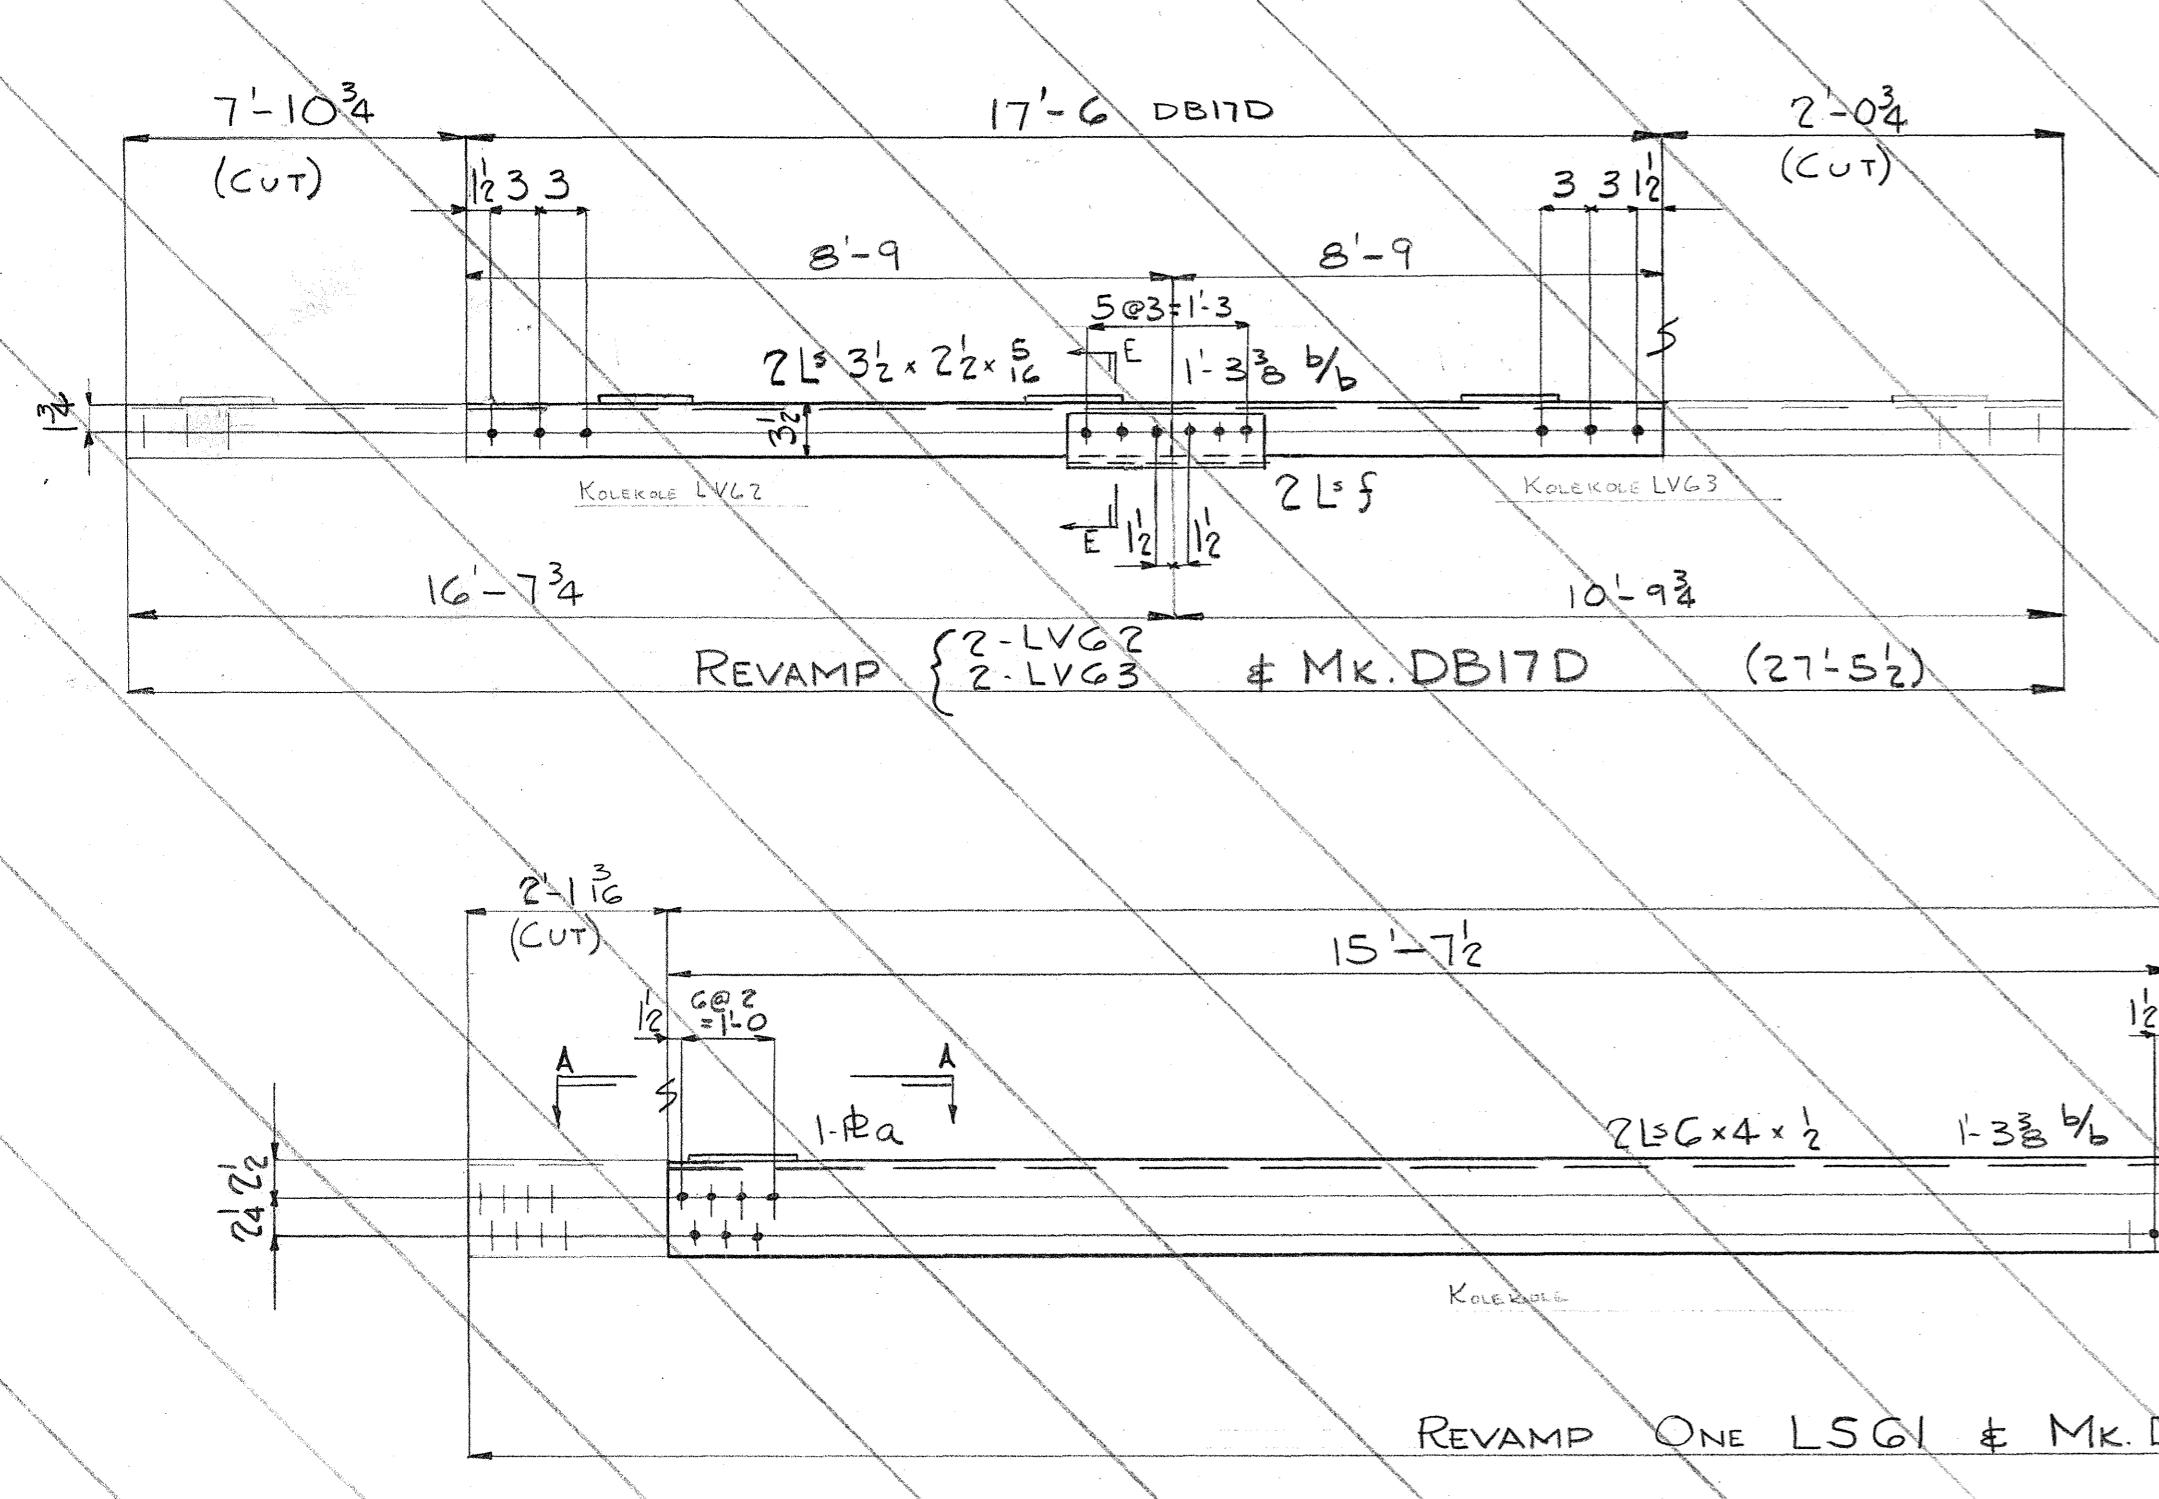

~~REVAMP ONE LSGI & MK. DB19D~~

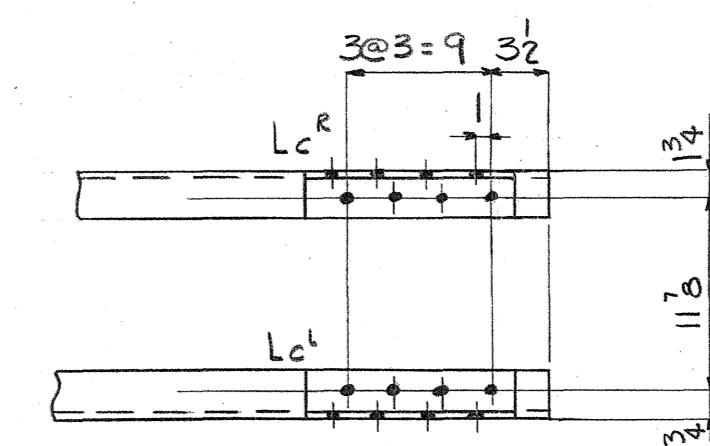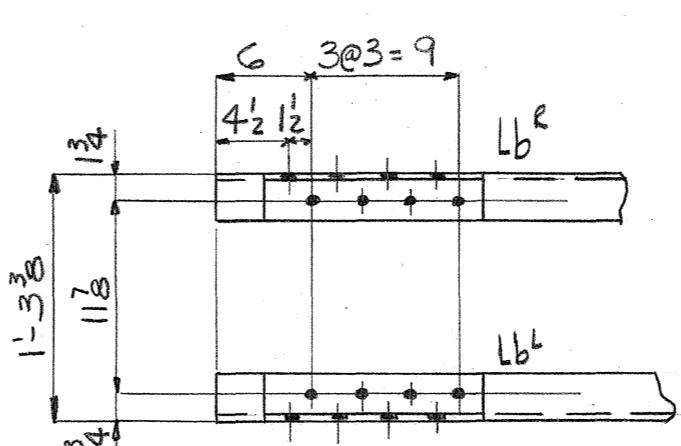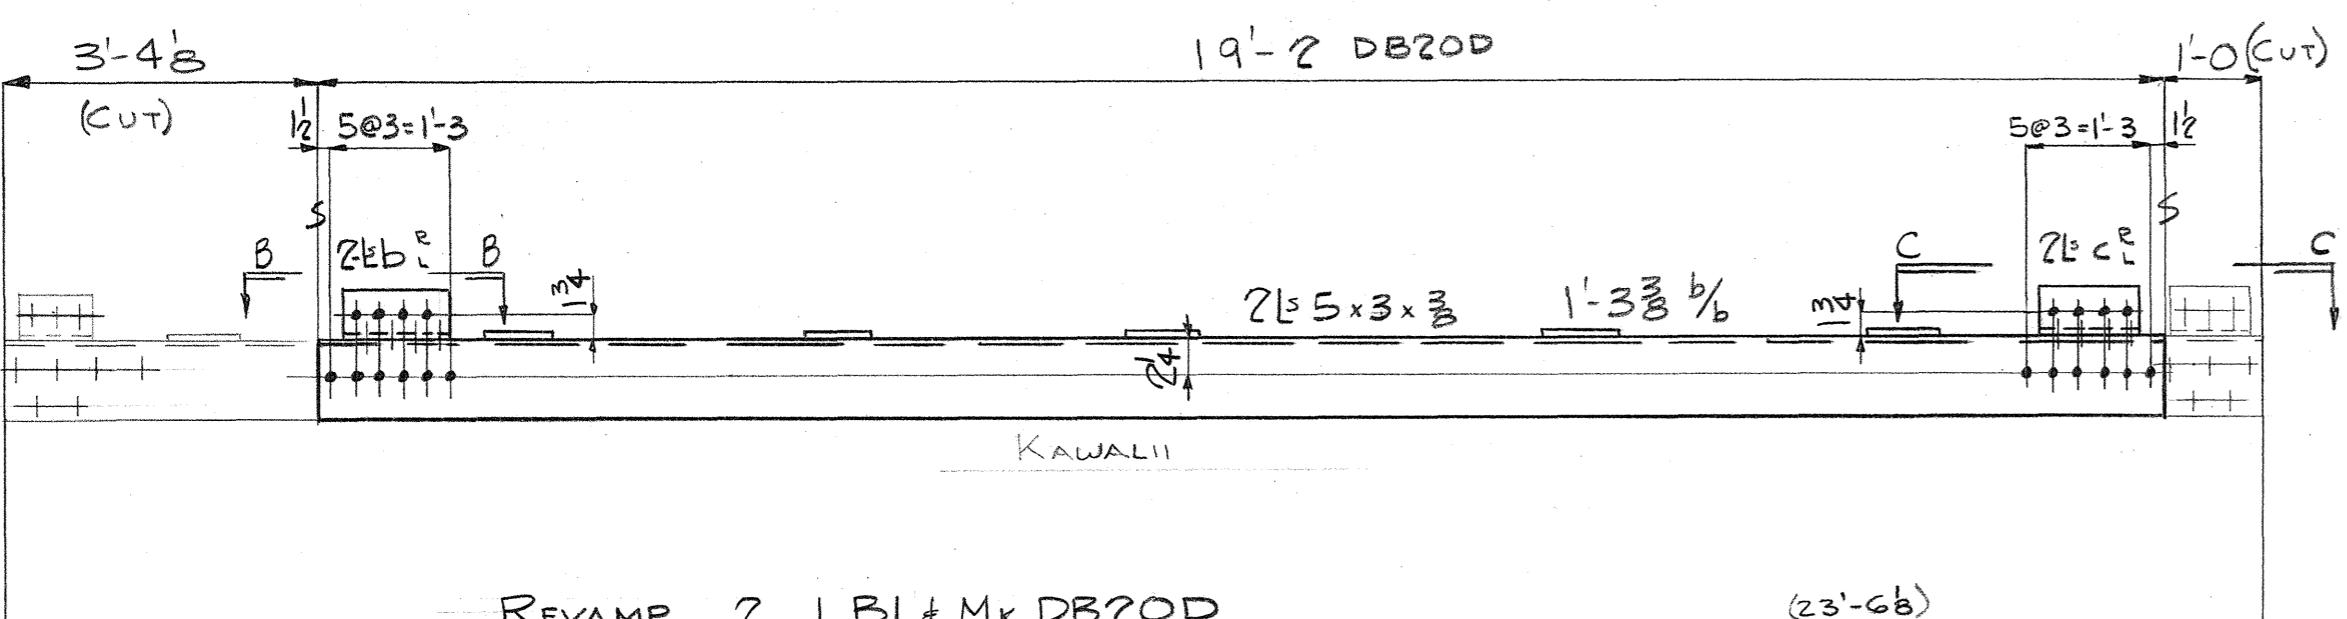

REVAMP 2 LBI & Mk. DB20E

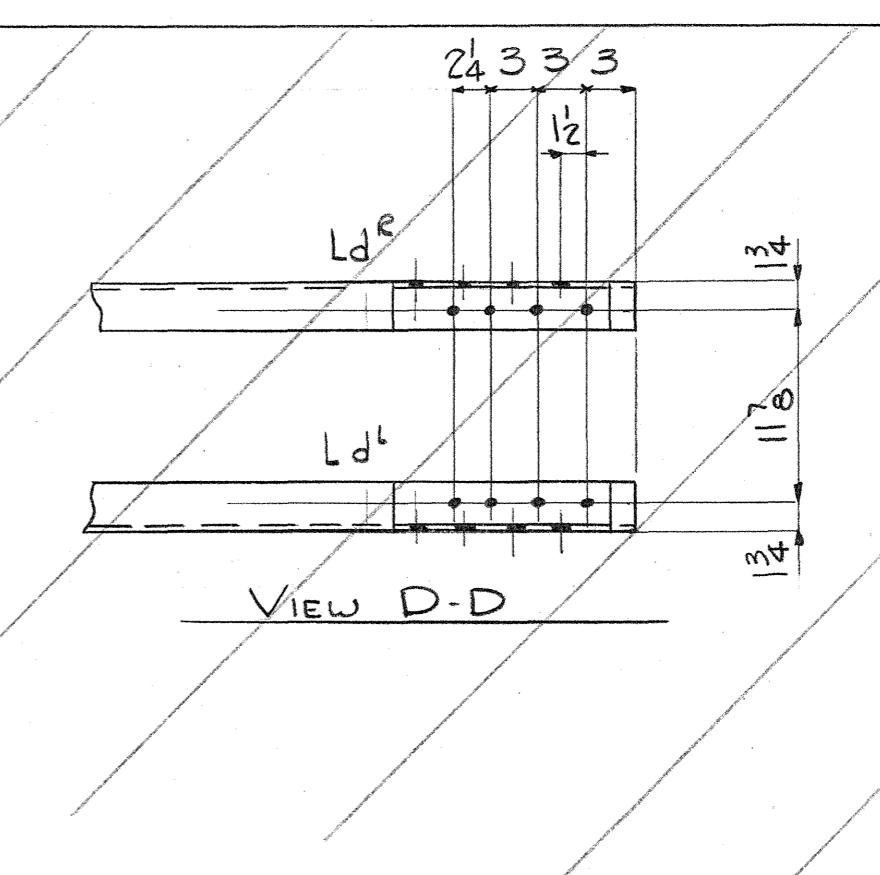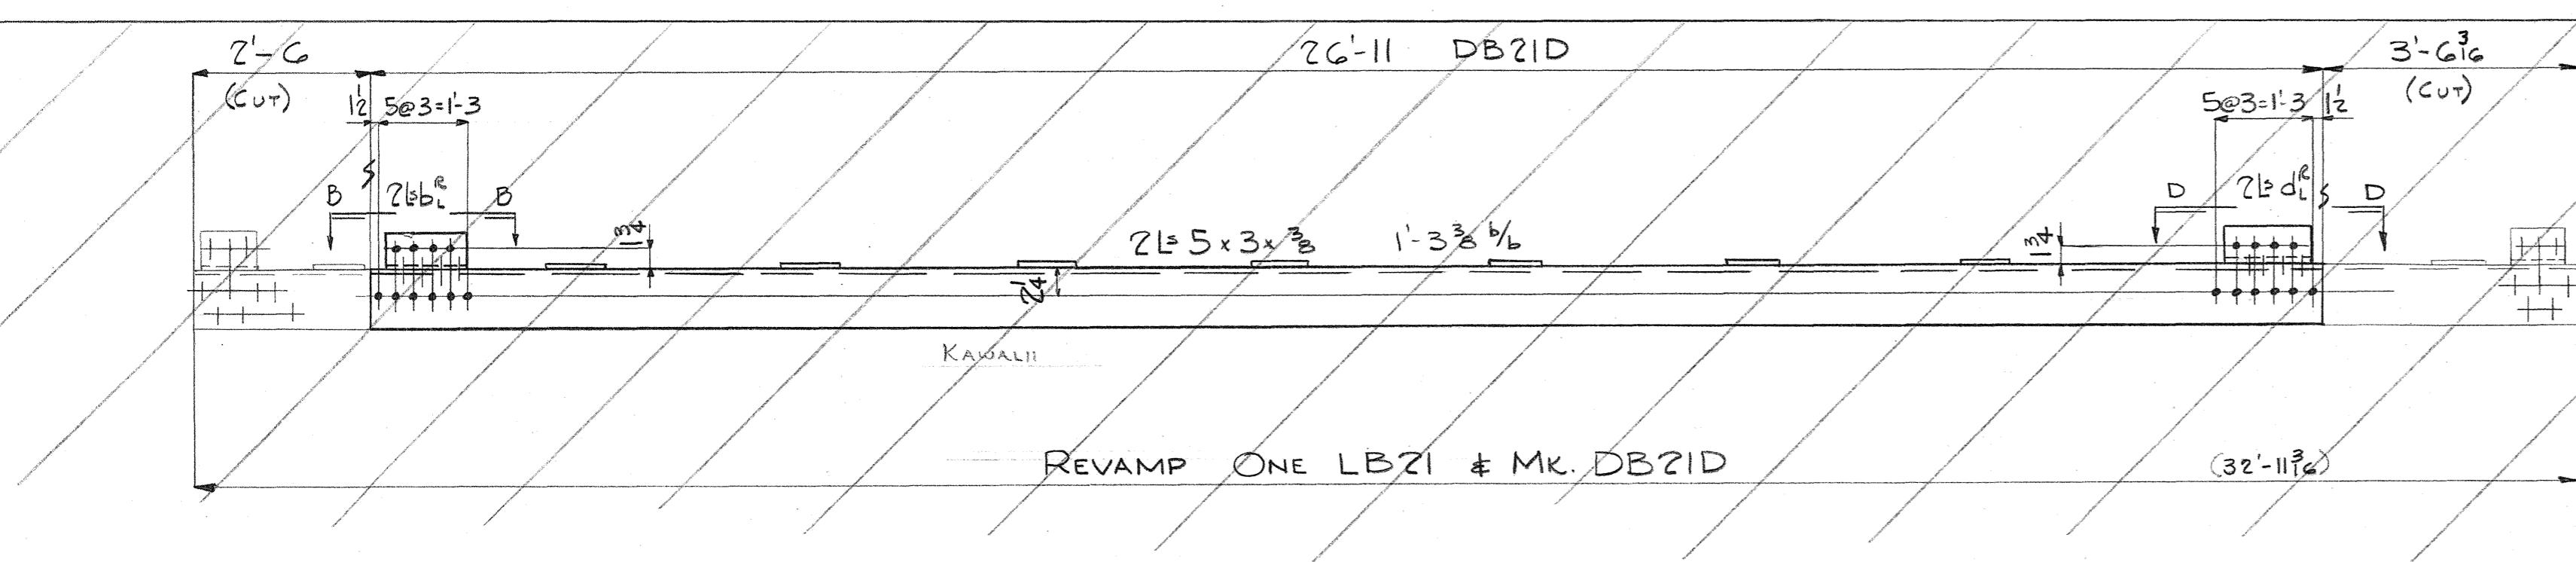

~~REVAMP ONE LBZI \$ MK. DBZID~~

**Rivets:**  $\frac{3}{4}$  φ

---

**Holes:**  $\frac{13}{16}$  φ       $1\frac{1}{2}$  E.D. UN

---

**Paint:**

INDUSTRIAL DEVELOPMENT CO.  
ADDITION TO UMAUMA BRIDGE

# **INDEPENDENT IRON WORKS, INC.**

OAKLAND, CALIF.

MADE BY	DAL	12-27-49	ORDER NO.	380
CHECKED BY	D22	1-18-50	SHEET NO.	D221

2190

— 47 —






Digitized by srujanika@gmail.com

180 5468.180 47

FED. ROAD DIST. NO.	STATE	FED. AID PROJ. NO.	FISCAL YEAR	SHEET NO.	TOTAL SHEETS
HAWAII	HAW 5DR 3(3) 1950	181	300		

## BILL OF MATERIAL INDUSTRIAL DEVELOPMENT

No.	Description	Length Ft.	Length In.	Mark	REMARKS
NOTE: BRACES	LISTED BELOW ARE TO BE REVAMPED AS SHOWN ON DETAILS				
1	BRACE	38	B16	LB20	SALV. FROM KAWALI
1	Do	23	11 1/2	LB19	Do
1	Do	19	10 3/8	LB17	
1	Do	17	4 3/4	LH2	
8	L 3 x 3 x 3/8	1	1 1/2	a	Temp-New
2	L 3 x 3 x 3/8	1	0	b	Do
2	L 3 x 3 x 3/8	1	0 3/4	c	Do
2	P 8 x 4	1	6	d	?

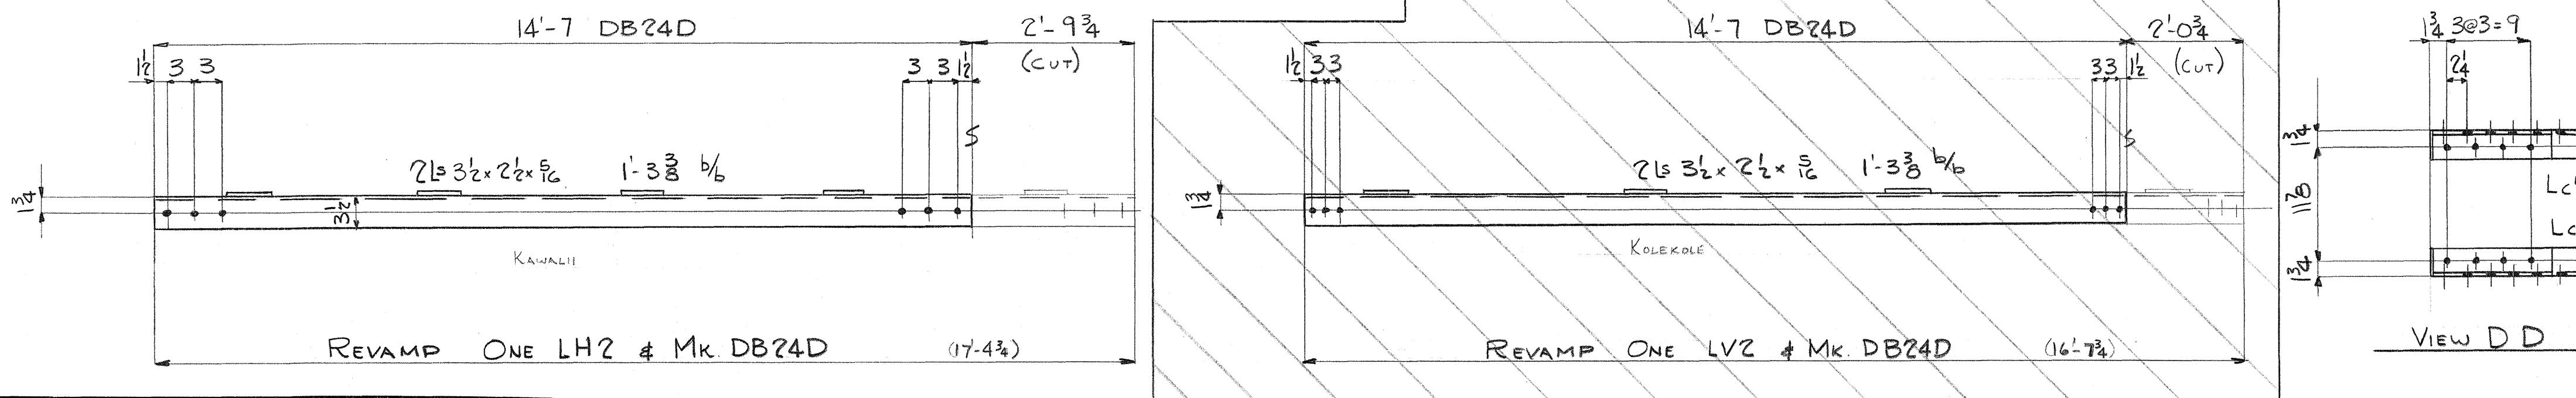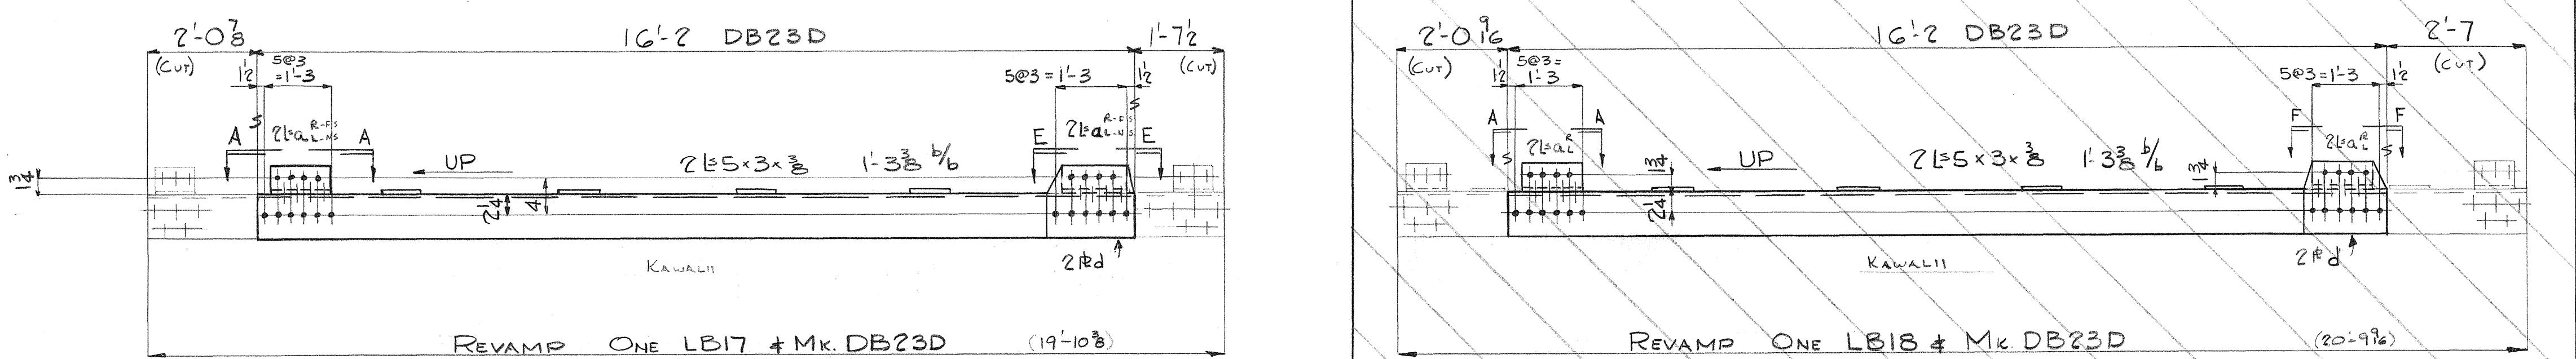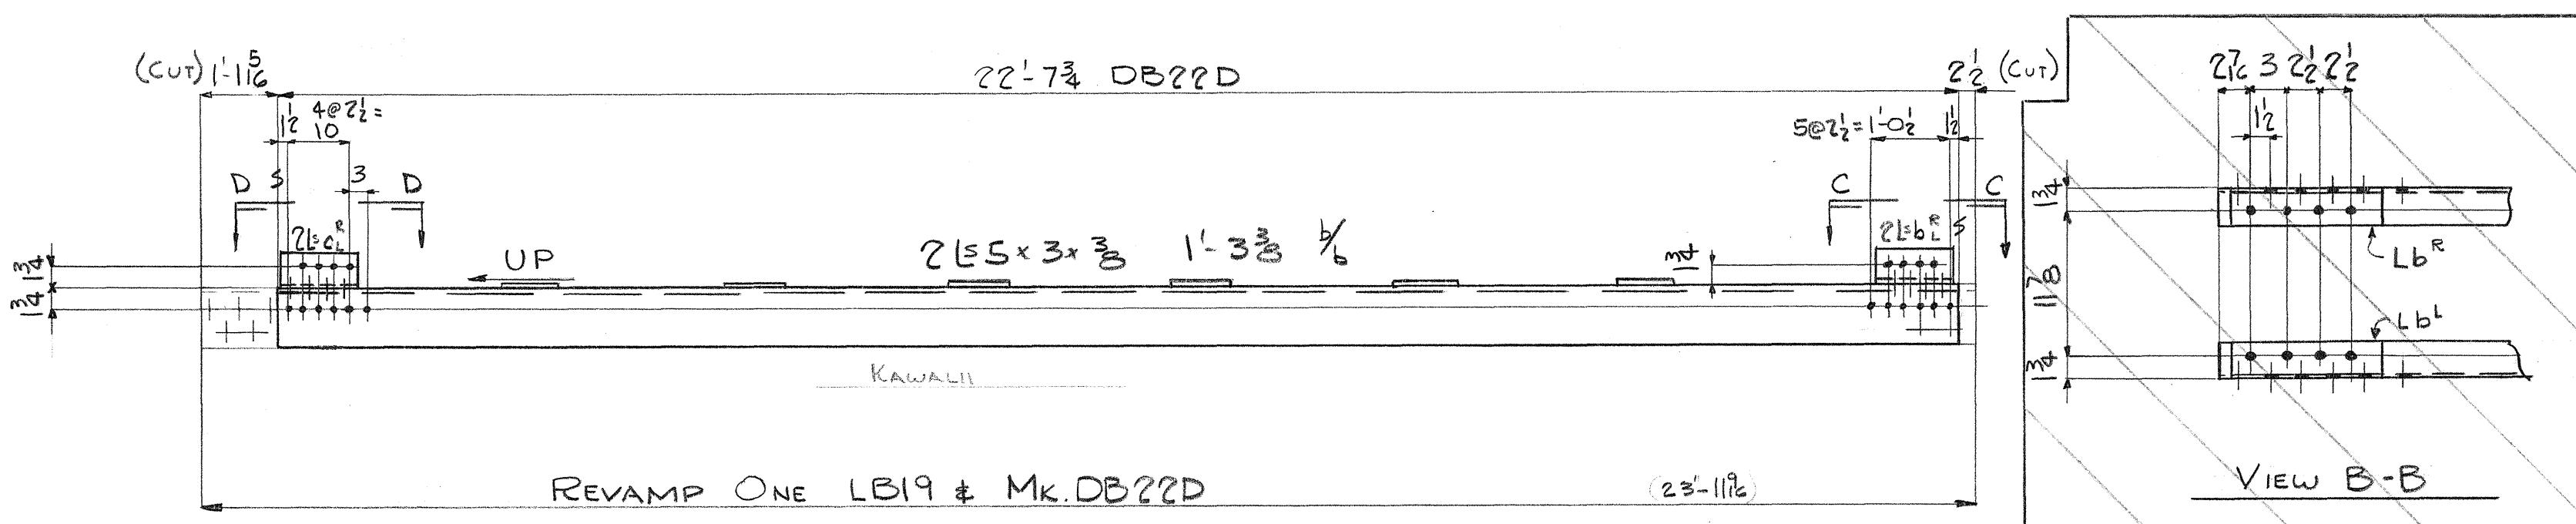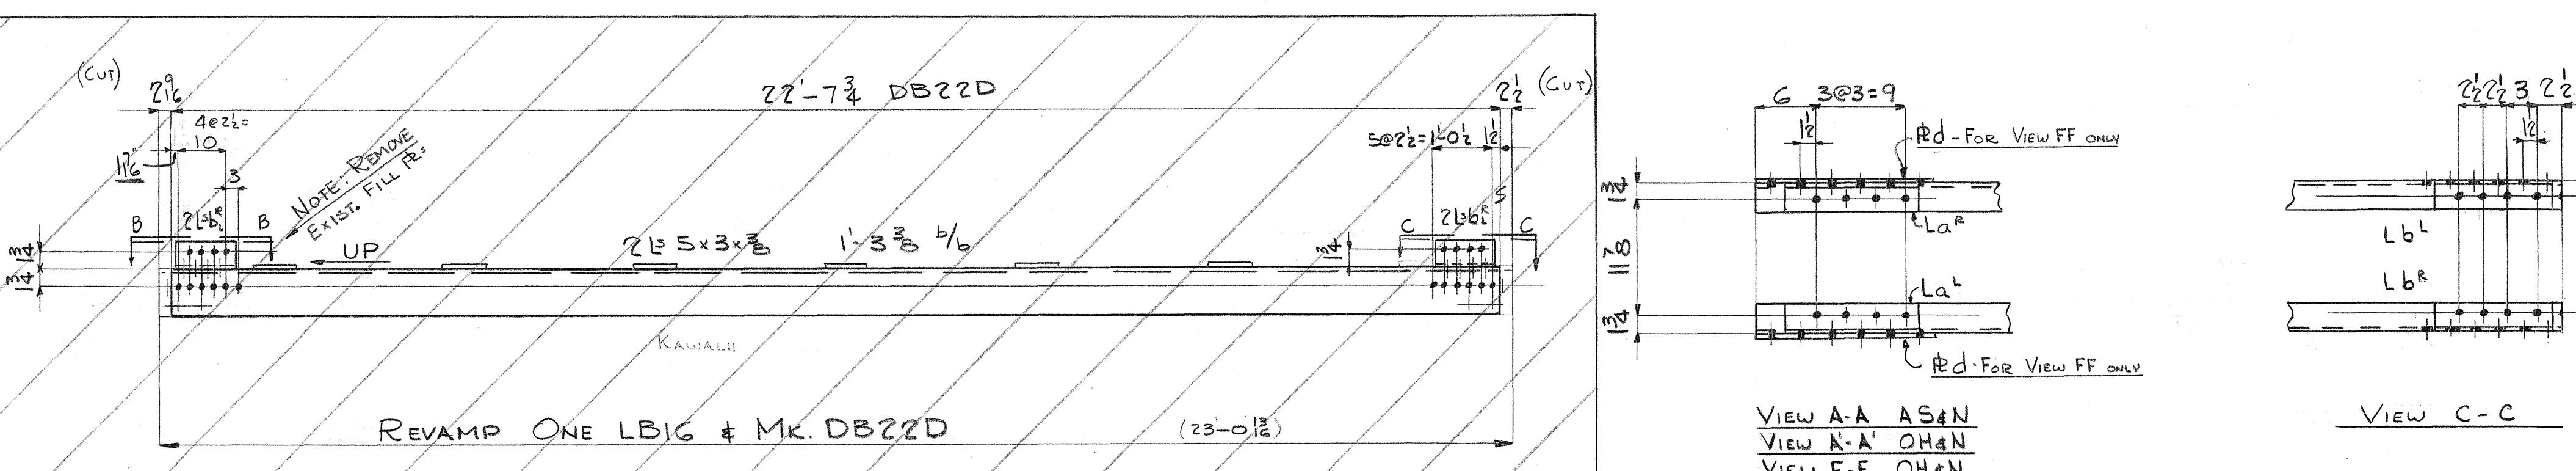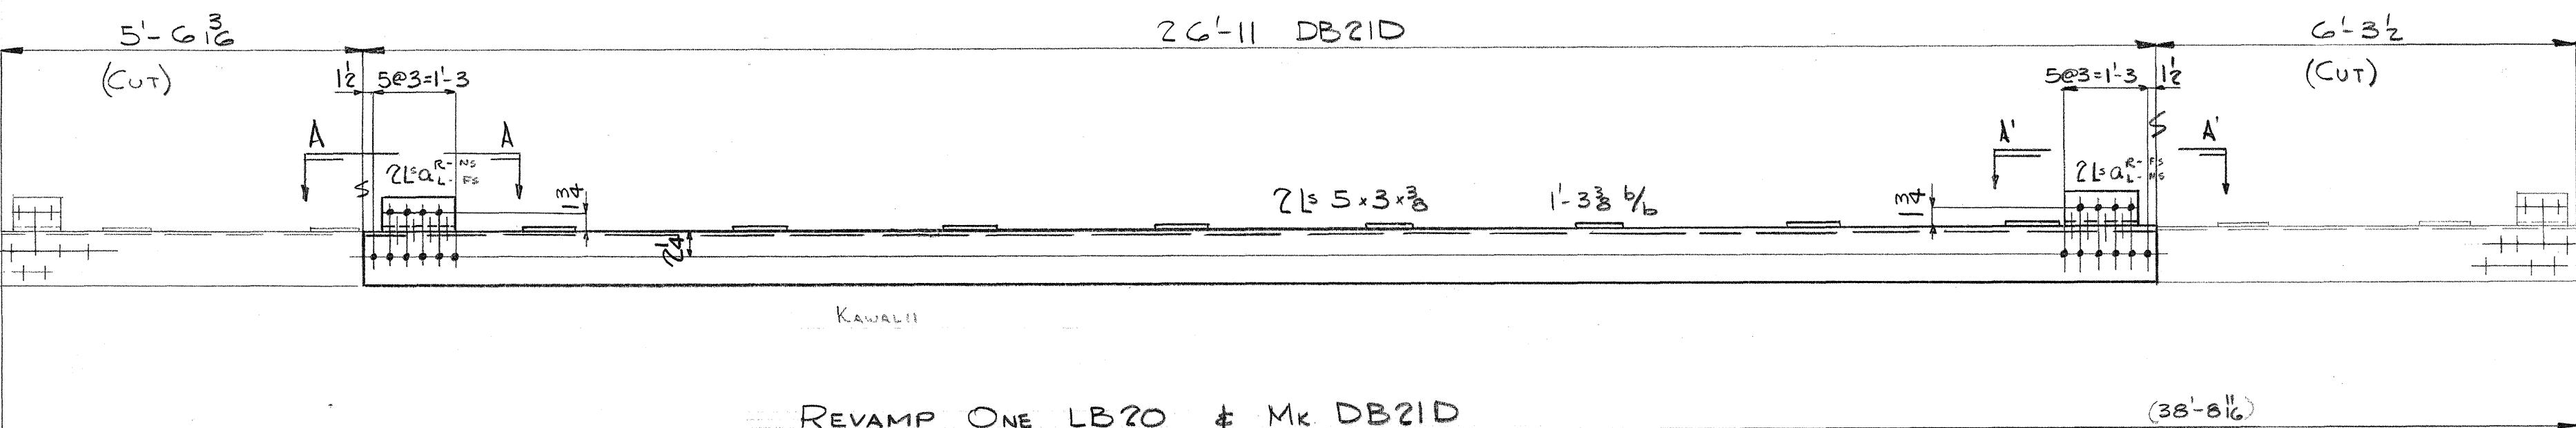

Rivets:  $\frac{3}{4}$   $\frac{1}{2}$   
Holes:  $\frac{13}{16}$   $\frac{1}{2}$  EDUN  
Paint:  
INDUSTRIAL DEVELOPMENT CO.  
ADDITION TO UMAUMA BRIDGE  
HAWAII  
INDEPENDENT IRON WORKS, INC.  
OAKLAND, CALIF.  
MADE BY DAL 12-28-49 ORDER NO. 3807  
CHECKED BY DW 1-18-50 SHEET NO. D23D

5468.181

FED. ROAD ROUTE NO.	STATE	FED. AID FUNDING	FISCAL YEAR	SHEET NO.	TOTAL SHEETS
HAWAII HIGHWAY	SDR 3/2/1950	182	302		

## BILL OF MATERIAL INDUSTRIAL DEVELOPMENT CO.










No.	Description	Length Ft. Ins.	Mark	REMARKS
NOTE: BRACES LISTED BELOW ARE TO BE REVAMPED AS SHOWN ON DETAILS.				

SALV. FROM  
2 BRACES 35 5 3/8 LSG2 KOLEKOLE  
1 Do 22 9 5/8 LB2 HONOLU

2 Do 32 0 5/8 LS2 HONOLU

4 P 6 x 4 1 0 a Temp New  
4 P 15 3/8 x 3/8 1 4 b Du Do  
6 L 3 x 3 x 3/8 1 1/2 c }

4 L 3 x 3 x 3/8 1 7/8 g }

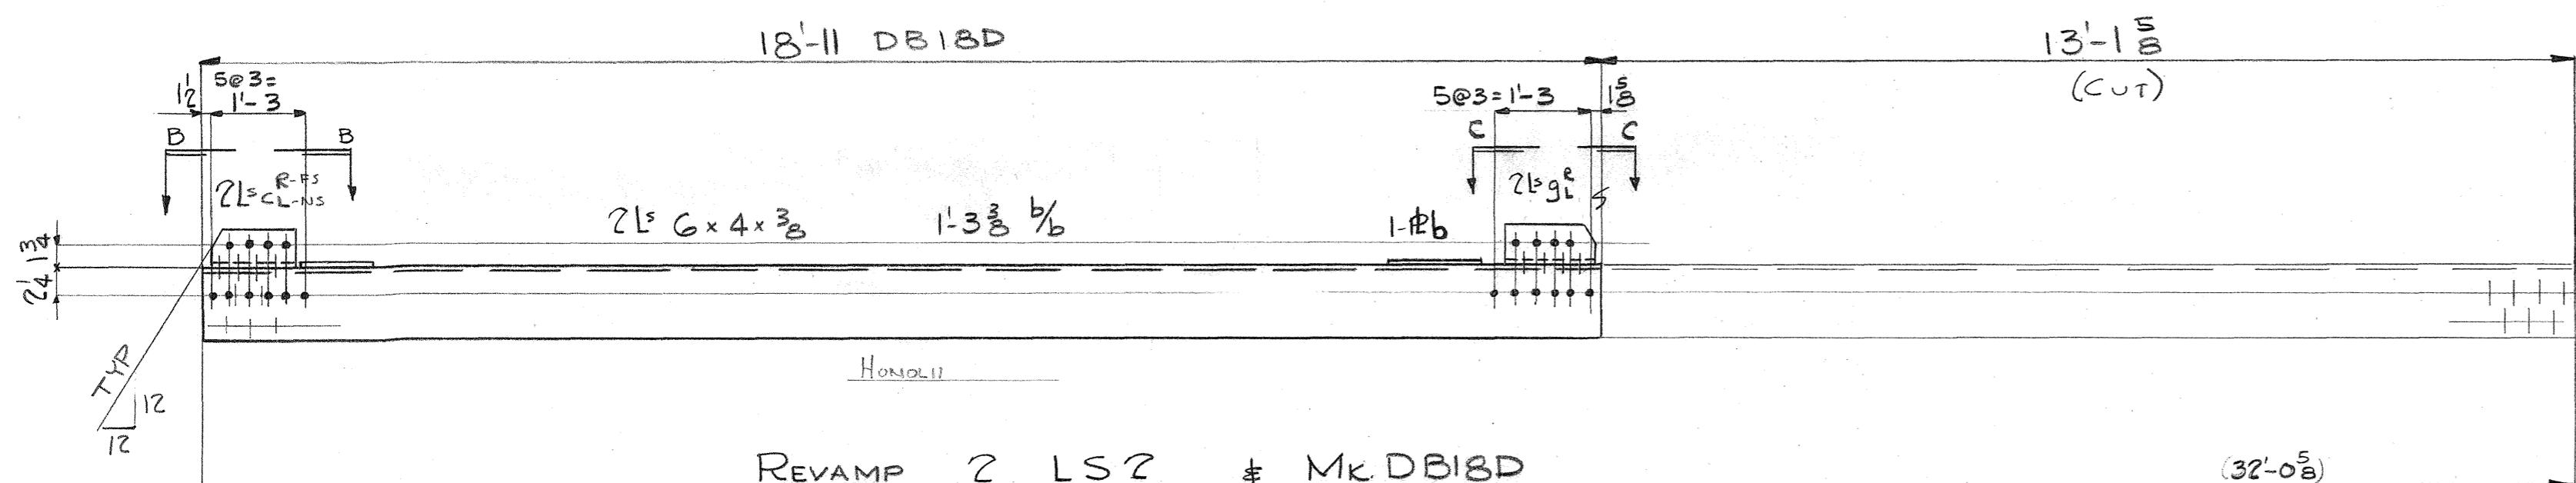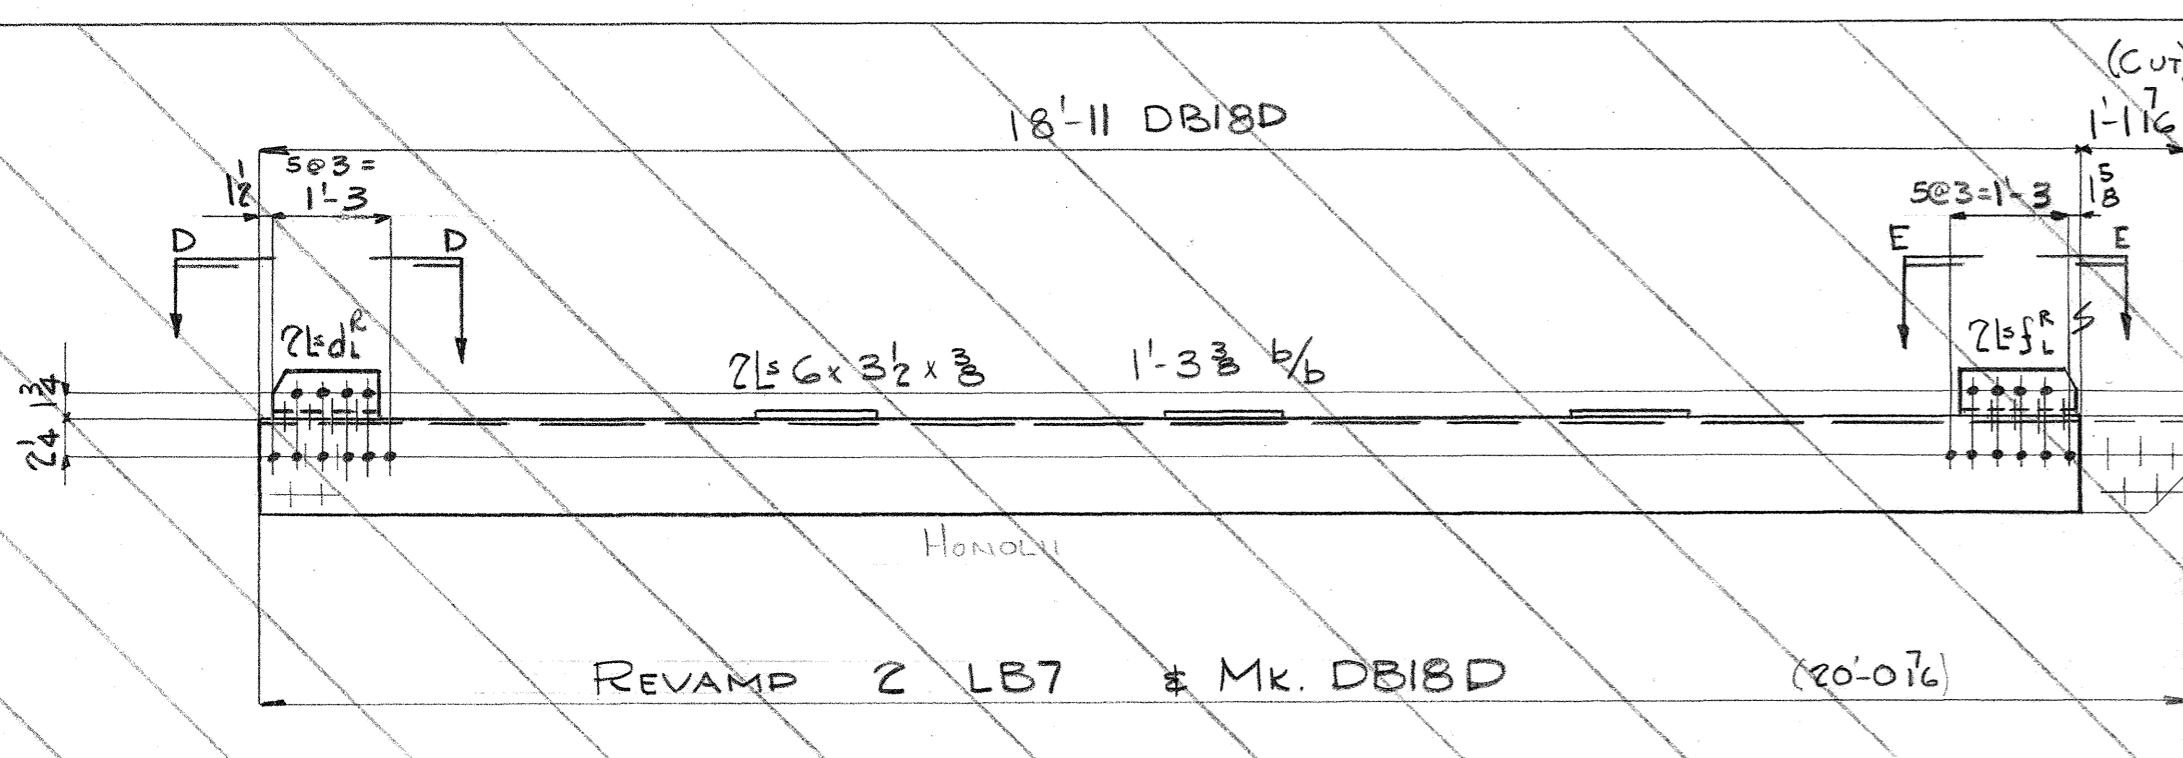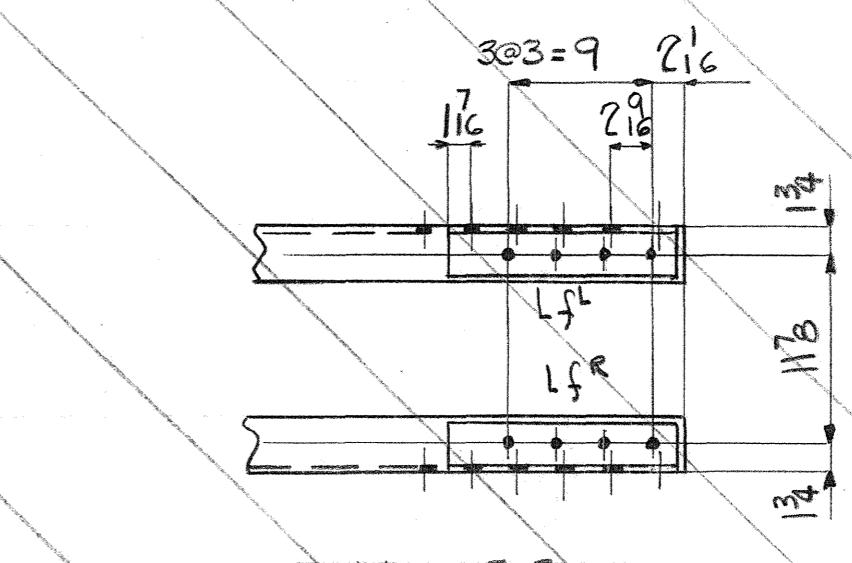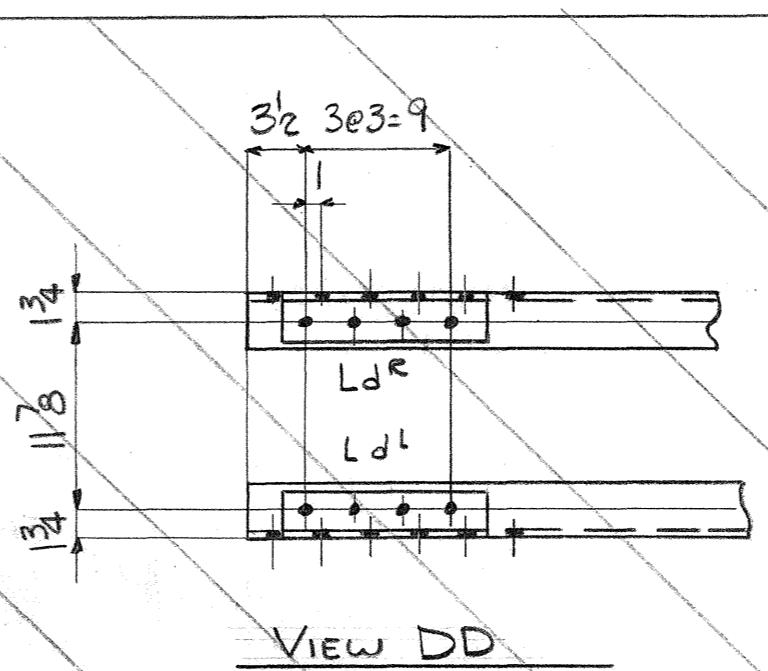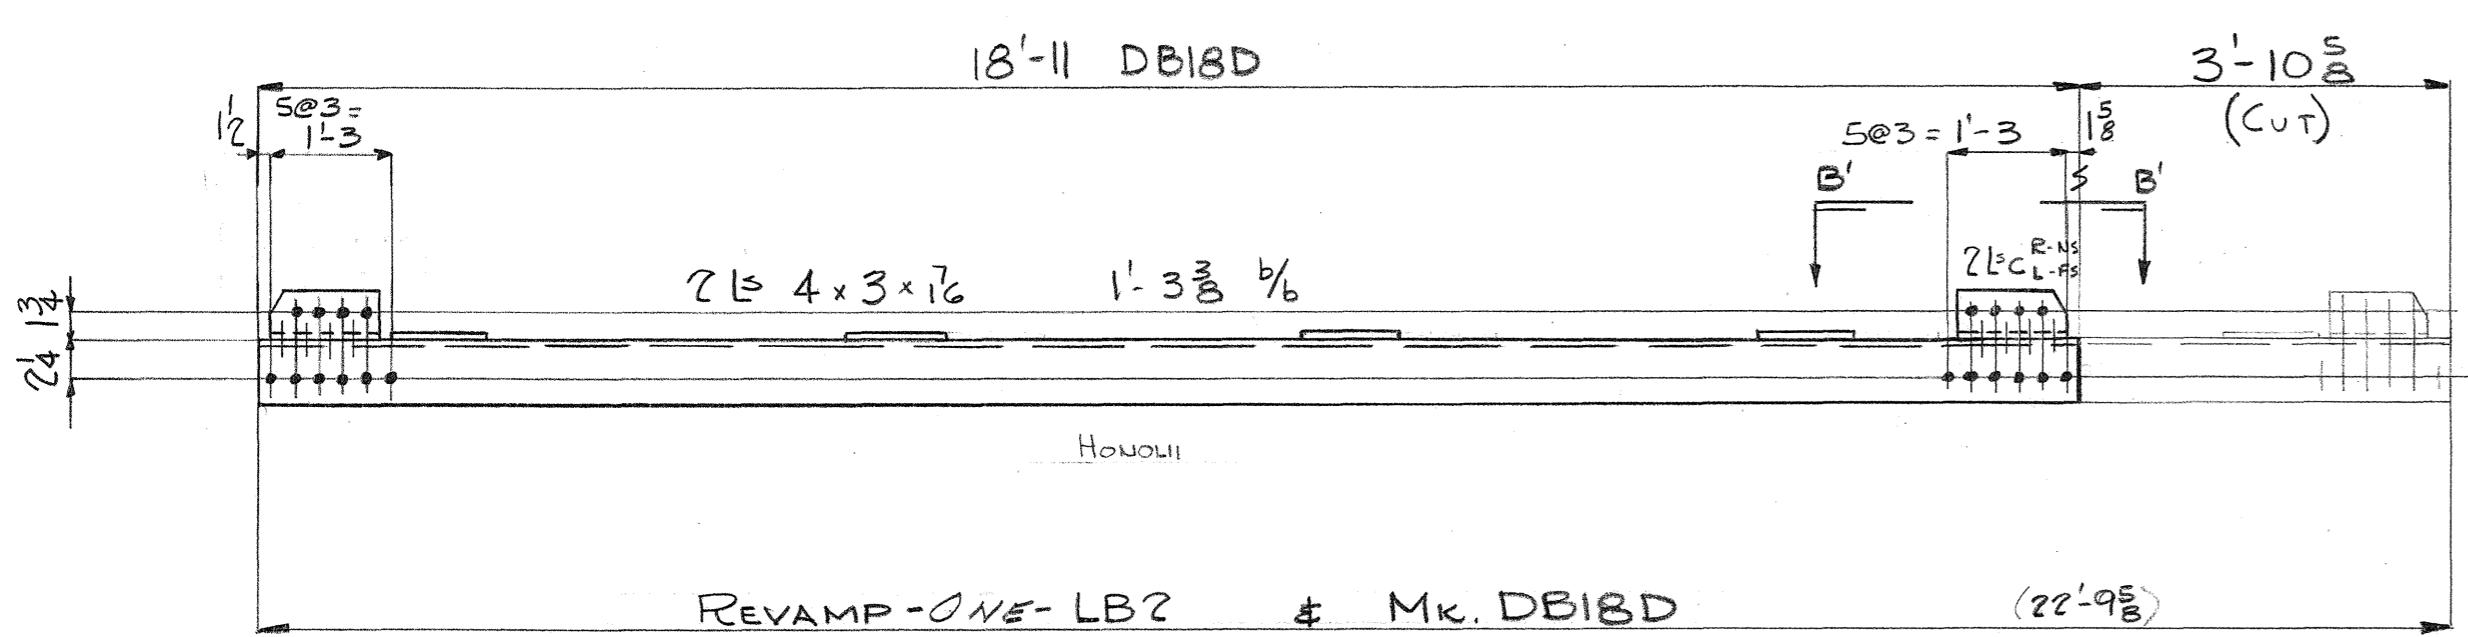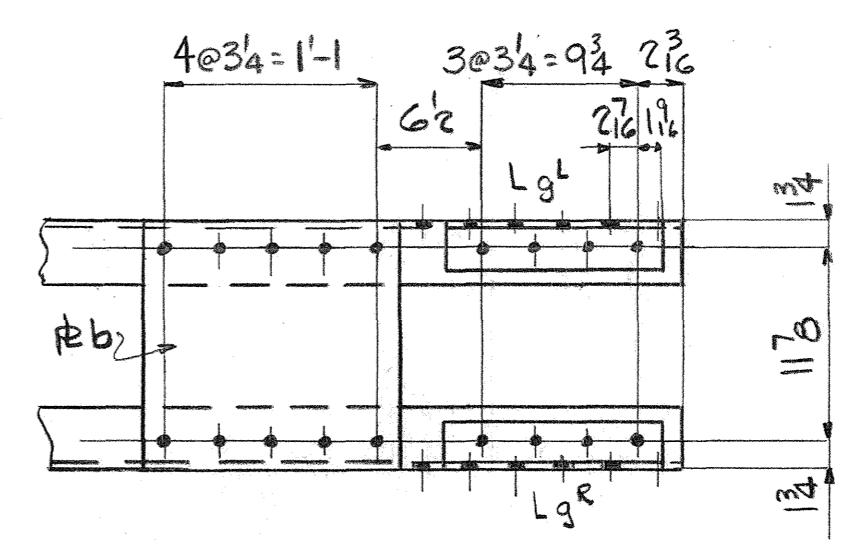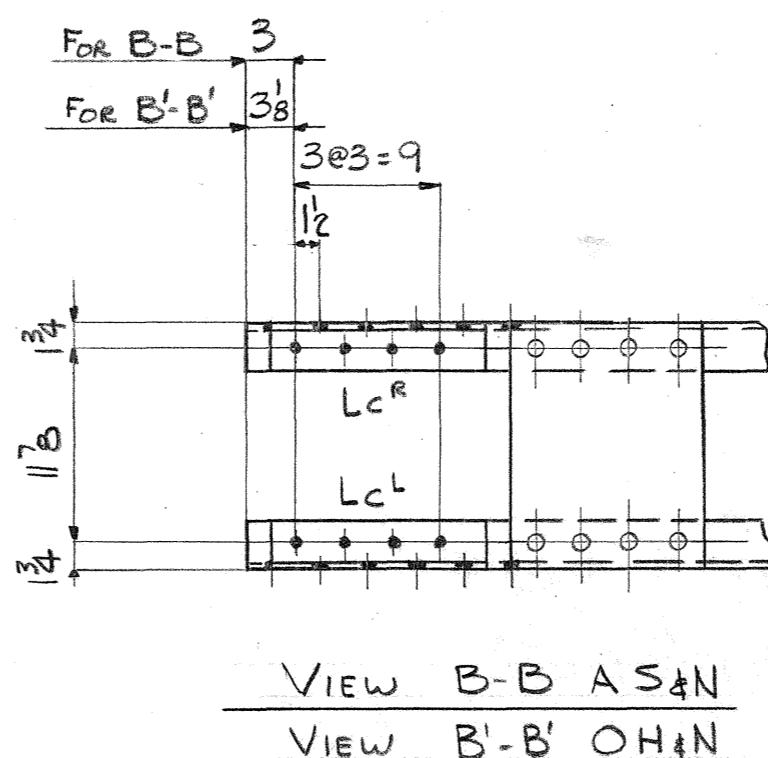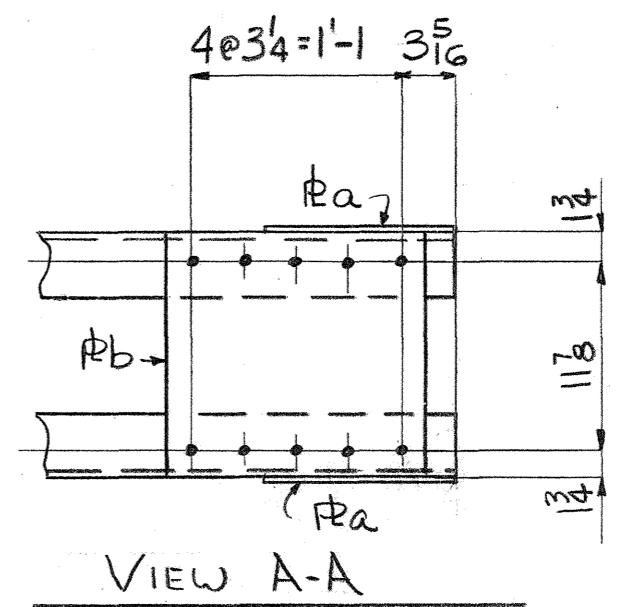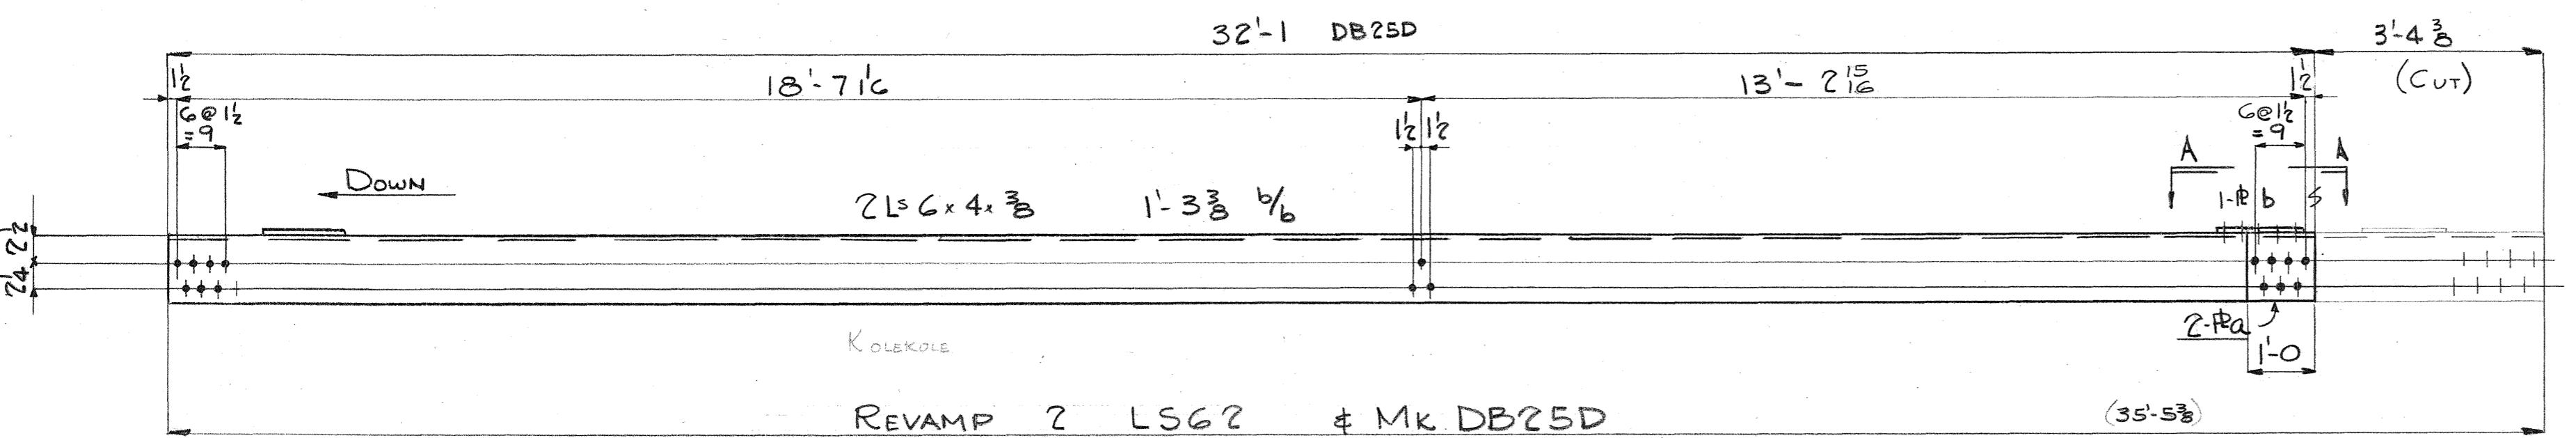

Rivets:  $\frac{3}{4}$   $\Phi$   
Holes:  $\frac{13}{16}$   $\Phi$  1 1/2 ED. UN  
Paint:

INDUSTRIAL DEVELOPMENT COMPANY  
ADDITION TO THE UMAUMA BRIDGE  
HAWAII

INDEPENDENT IRON WORKS, INC.  
OAKLAND, CALIF.








MADE BY DAL 12-30-49 ORDER NO. 3807  
CHECKED BY ODA 1-18-50 SHEET NO. D24D

3 4 6 8 . 1 8 2 47 185

FED. ROAD DIST. NO.	STATE	FED. AID PROJ. NO.	FISCAL YEAR	SHEET NO.	TOTAL PAGES
Hawaii Hwy SDR 310/1950				182	304

**BILL OF MATERIAL INDUSTRIAL DEVELOPMENT CO.**

No.	Description	Length Ft. Ins.	Mark	REMARKS
NOTE: BRACES LISTED BELOW ARE TO BE REVAMPED AS SHOWN ON DETAILS.				
4	BRACES 31 3 LSI	HONOLULU		
1	Do	23 6 1/2 LB2	KAWAII	
12	L 3x3x3/8	1 1/2	A	Temp. New
8	L 3x3x3/8	1 0 1/2 CL	Do	Do
7	FB 15 1/2x3/8	1 4	S	Do

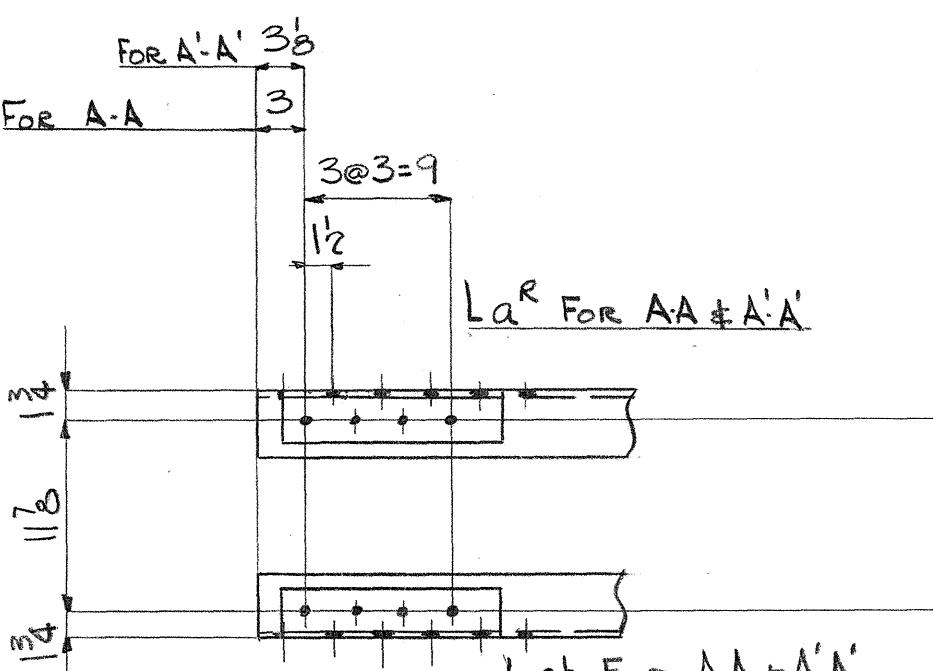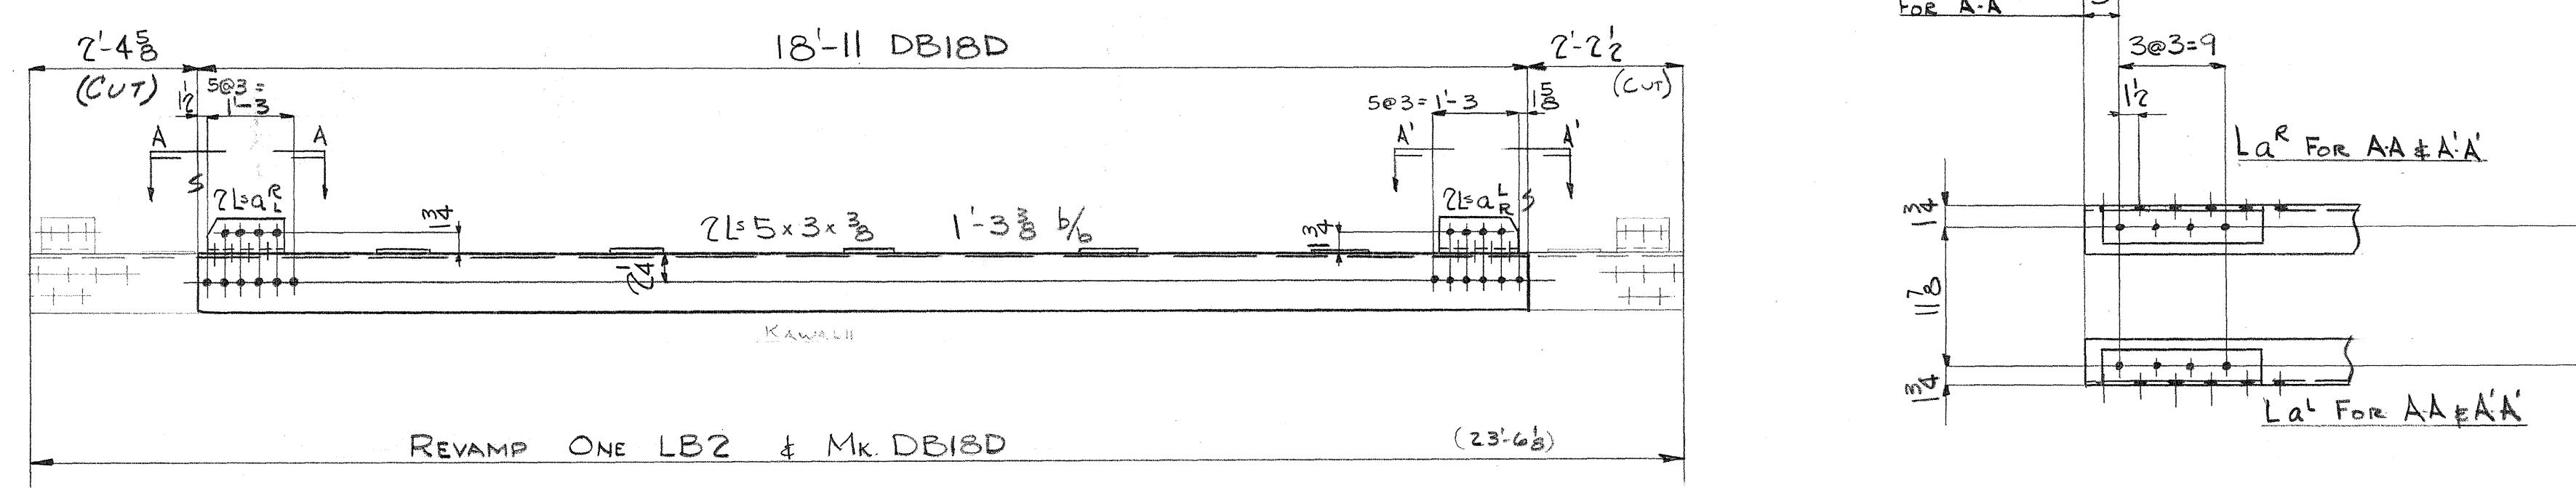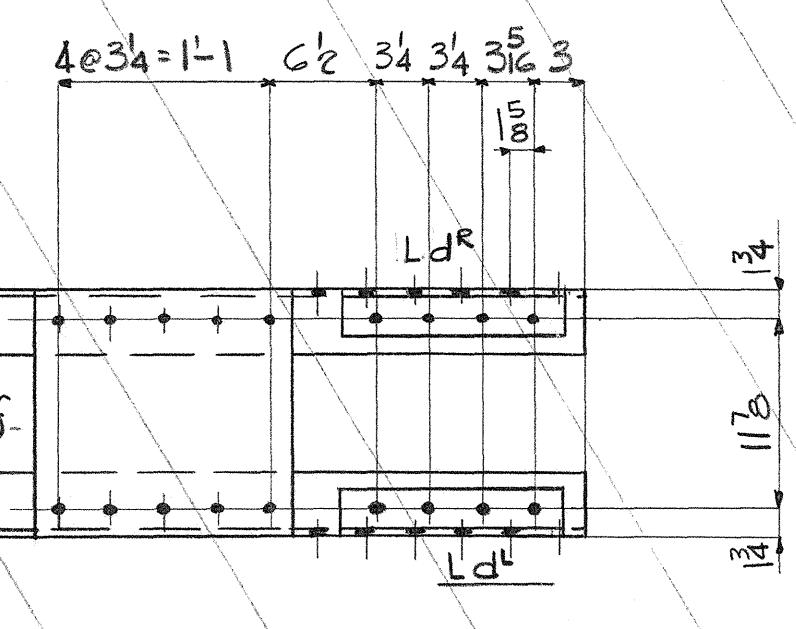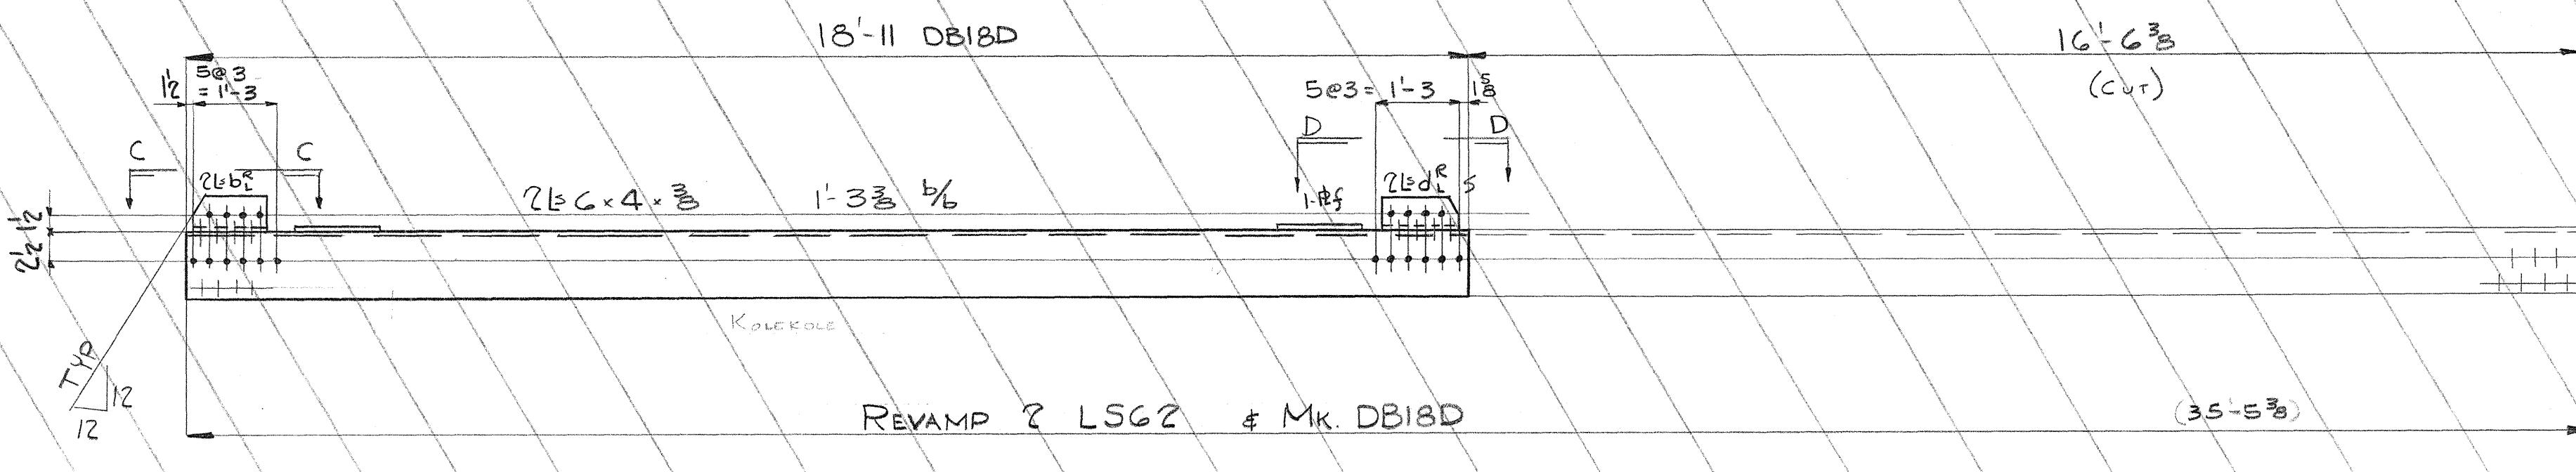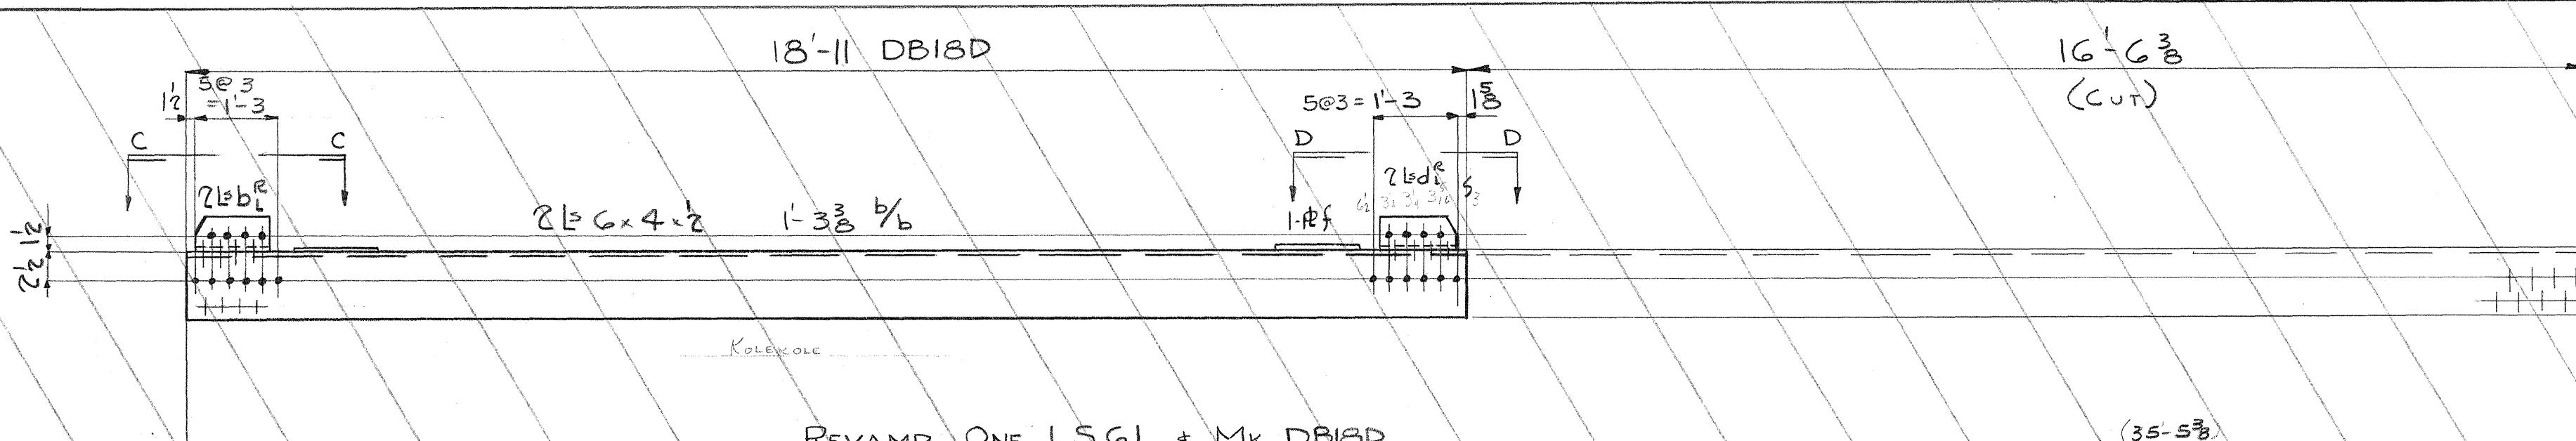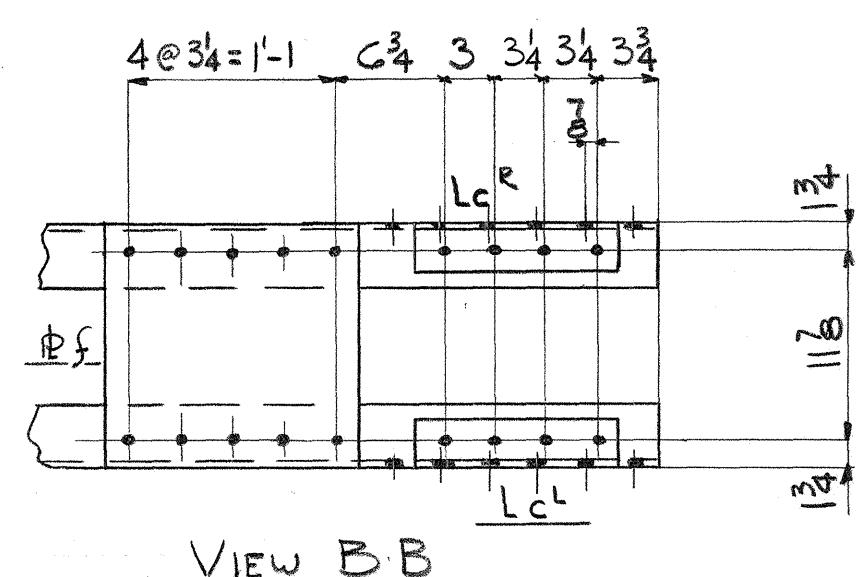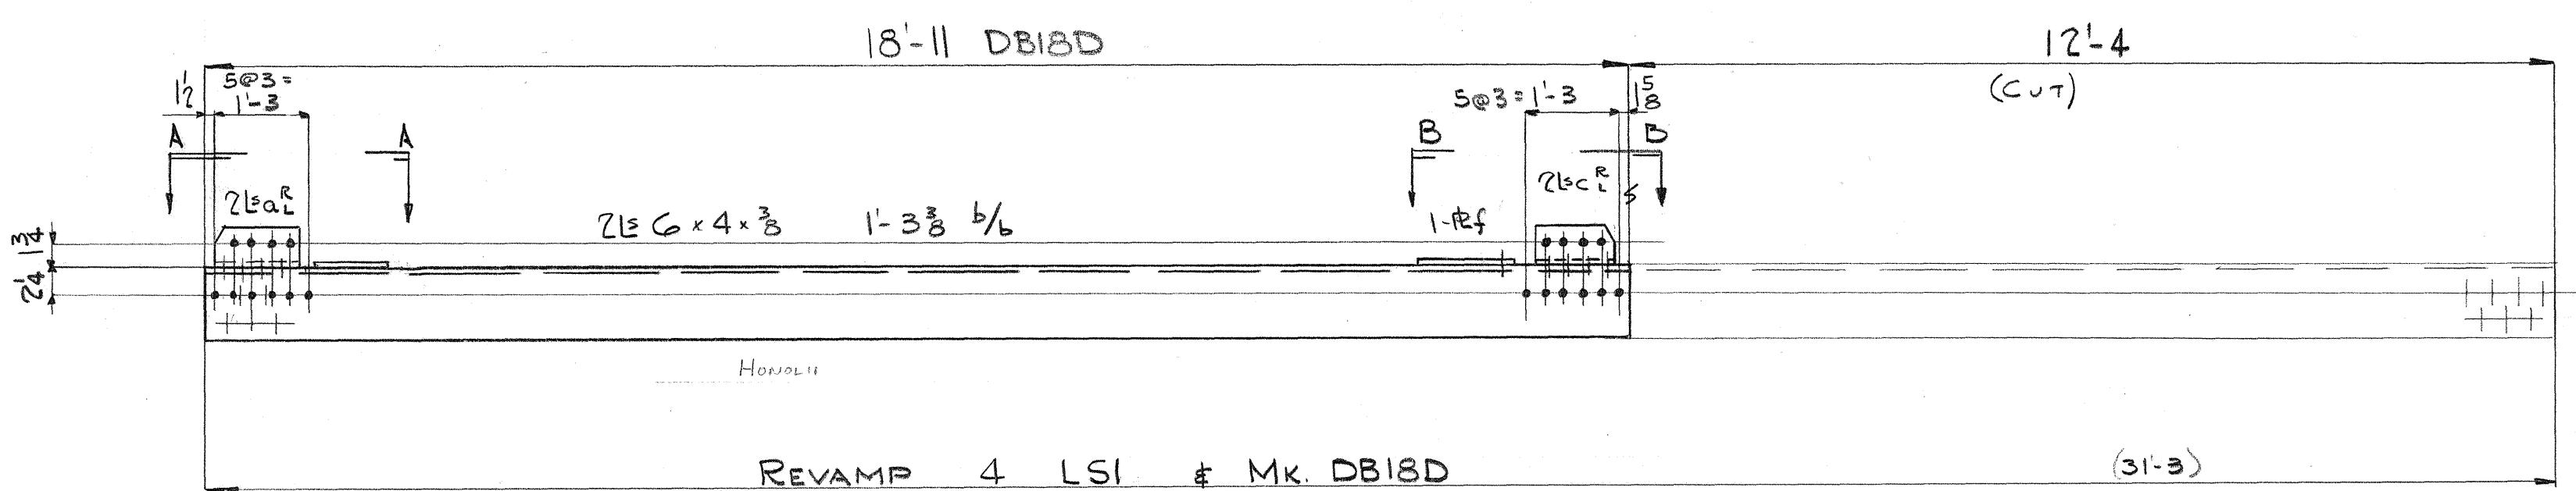

VIEW A-A AS+N  
VIEW A'-A' OH+N

Rivets:  $\frac{3}{8}$  in.  
Holes:  $\frac{13}{16}$  in.  $\frac{1}{2}$  ED UN  
Paint:

INDUSTRIAL DEVELOPMENT COMPANY  
ADDITION TO UMAUMA BRIDGE  
HAWAII

INDEPENDENT IRON WORKS, INC.  
OAKLAND, CALIF.



MADE BY DAL 1-3-50 ORDER NO. 3807  
CHECKED BY DOL 1-18-50 SHEET NO. D25D

5468.183




FED. ROAD DIST. NO.	STATE	FED. AID PROJ. NO.	FISCAL YEAR	SHEET NO.	TOTAL SHEETS
HONOLULU	HAWAII	3013031000	184	304	

**BILL OF MATERIAL INDUSTRIAL DEVELOPMENT CO.**

No.	Description	Length Ft. In.	Mark	REMARKS
NOTE: BRACES LISTED BELOW ARE TO BE REVAMPED AS SHOWN ON DETAIL.				
1	BRACE	28 5 LB5		SALV. FROM KAWAII
4	L3x3x $\frac{3}{8}$	1 1/2	Q <sup>R</sup>	Temp-New

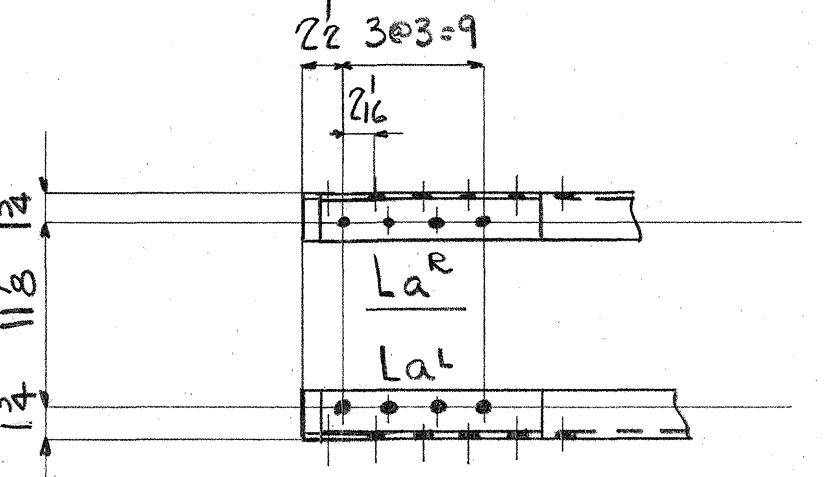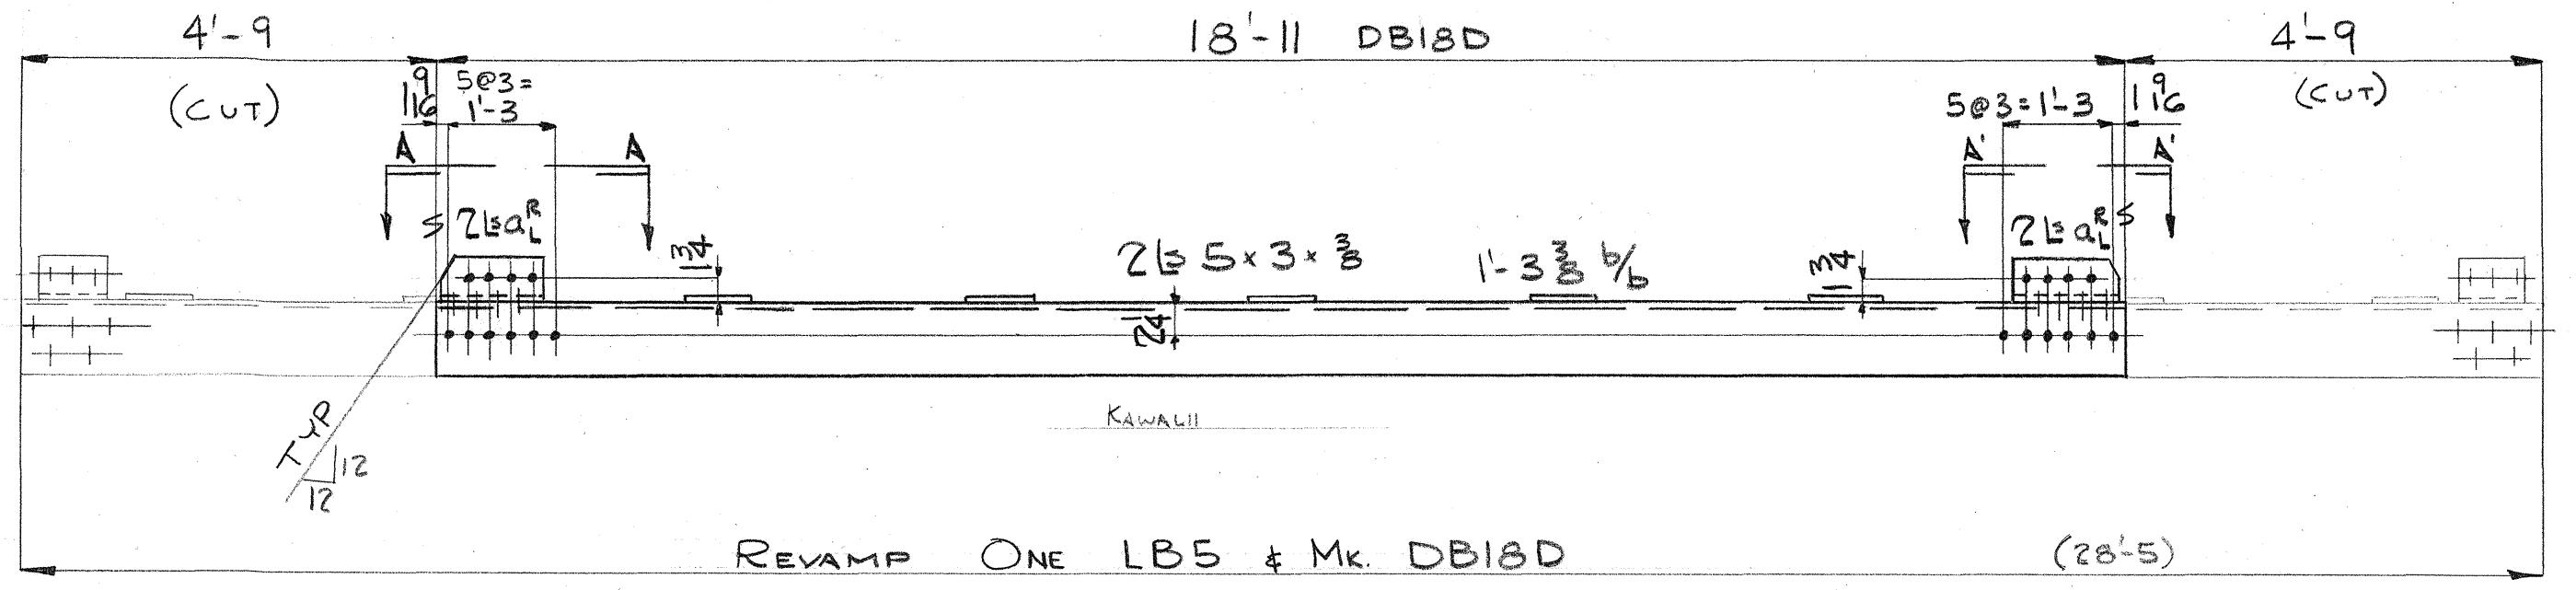

VIEW A-A LS  
VIEW A'-A' OH

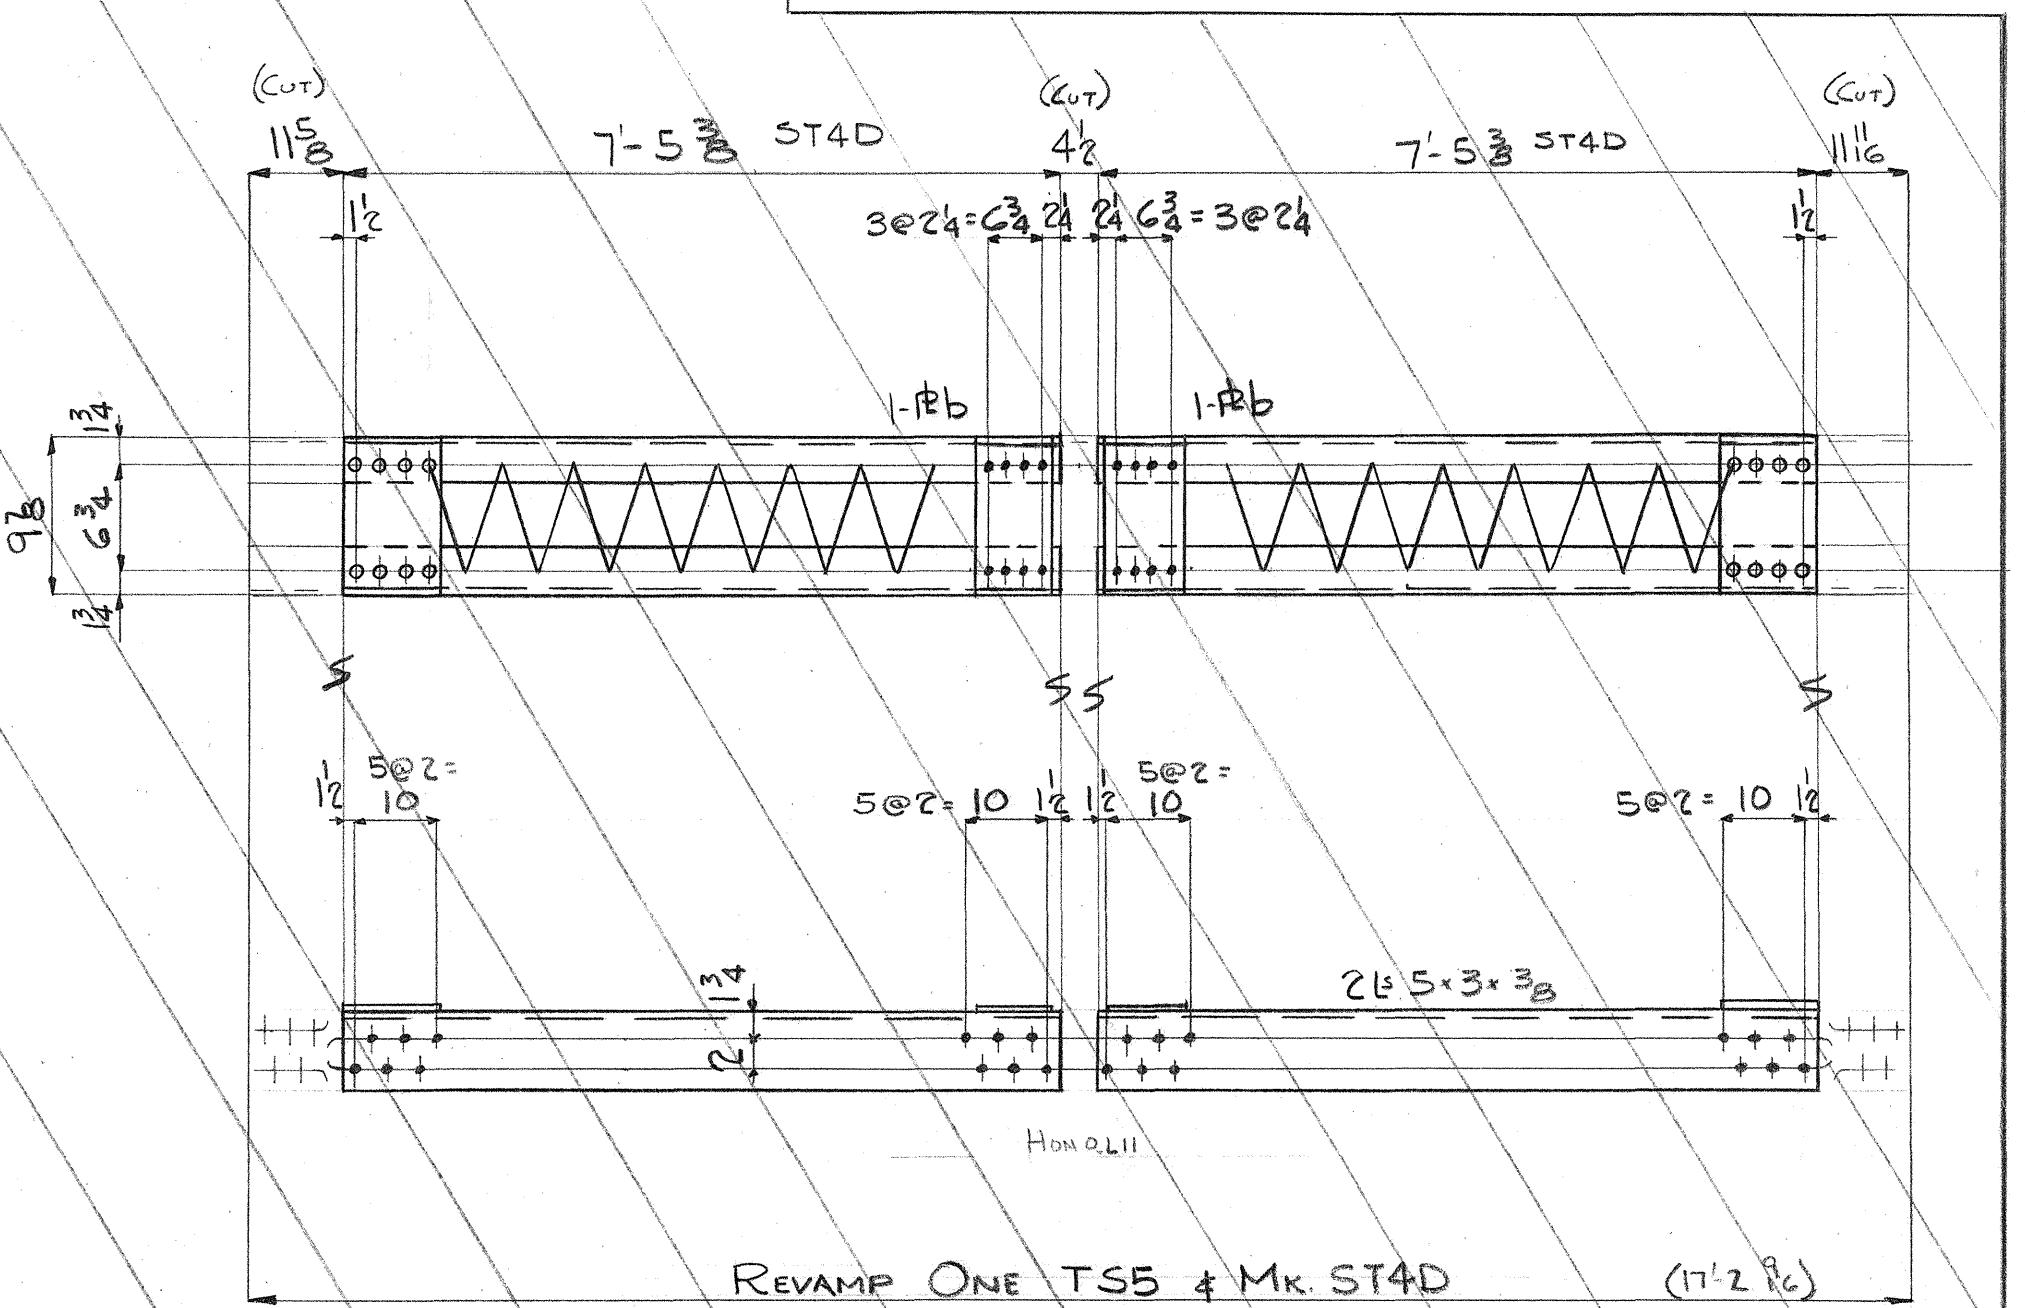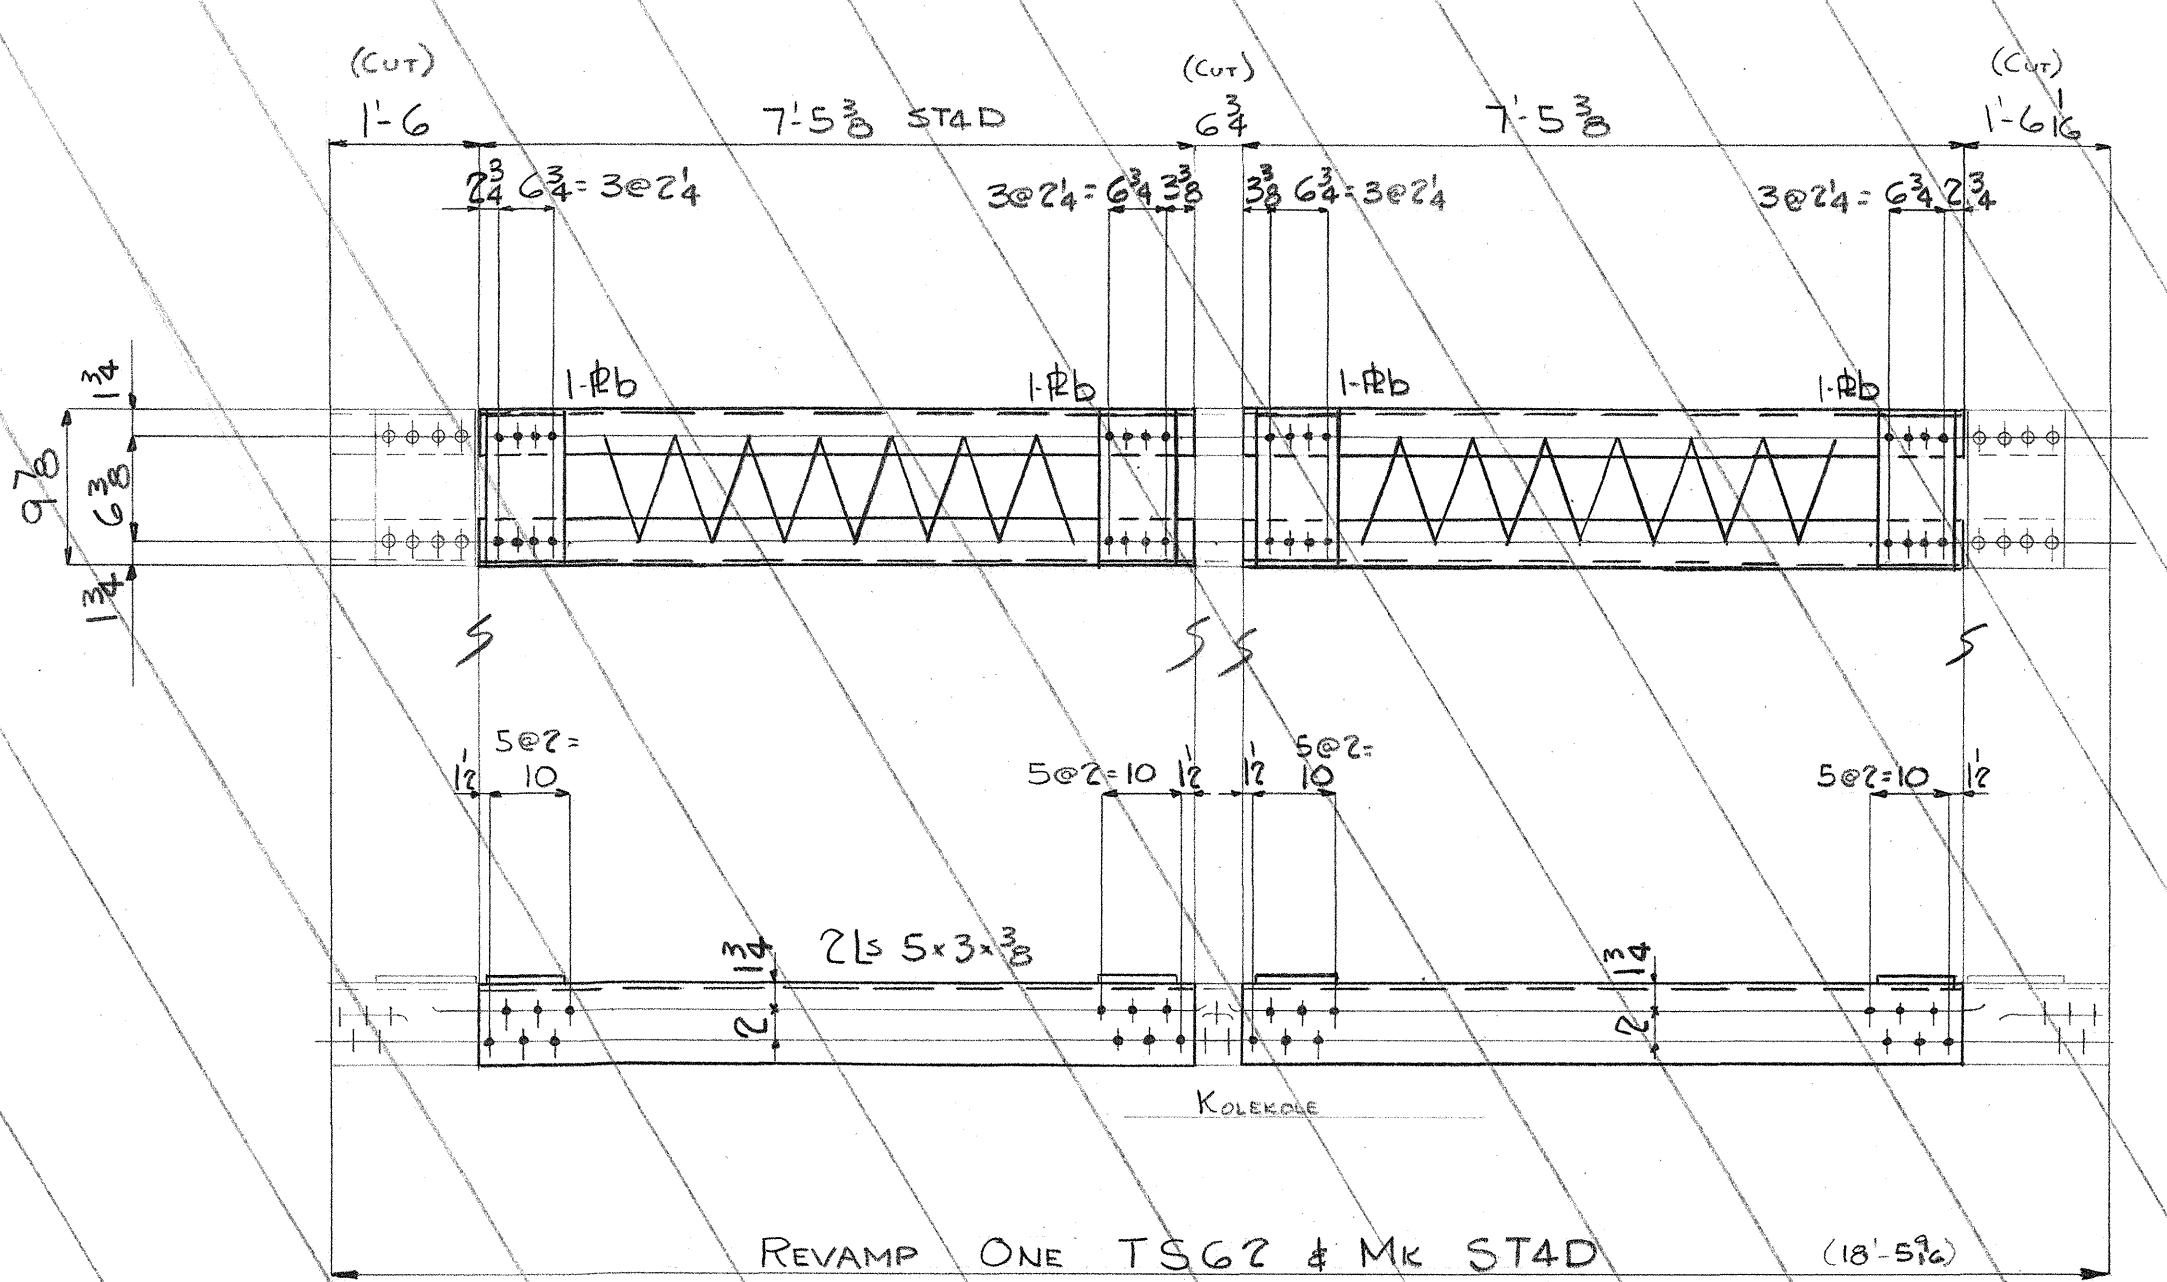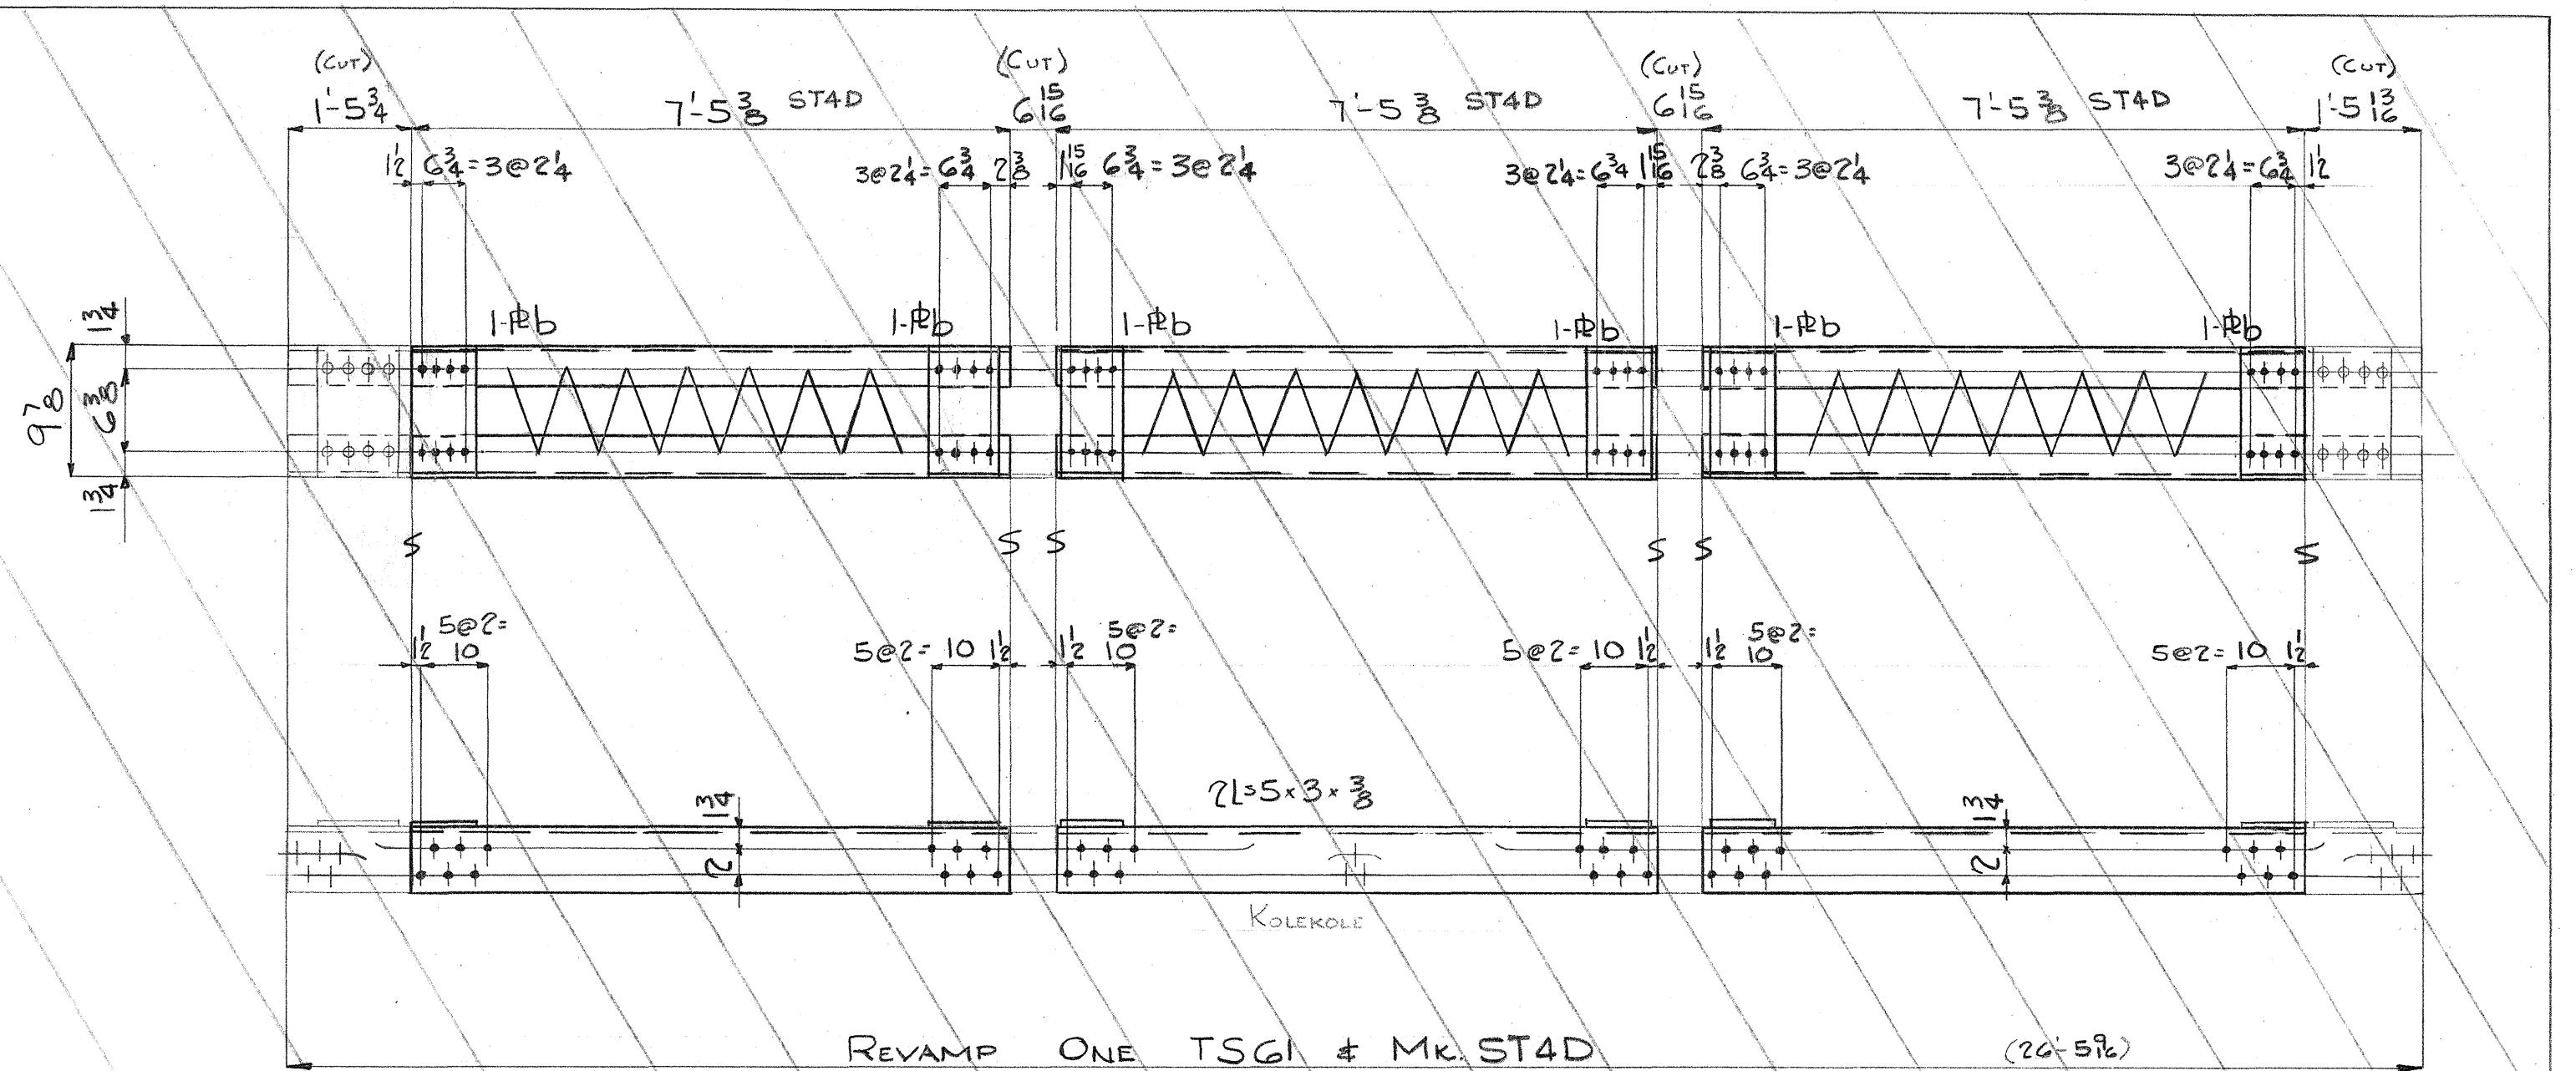

Rivets:  $\frac{3}{4}$   
Holes:  $\frac{1}{2}$   
Paint:

INDUSTRIAL DEVELOPMENT COMPANY  
ADDITION TO UMAUMA BRIDGE  
HAWAII

INDEPENDENT IRON WORKS, INC.  
OAKLAND, CALIF.

MADE BY DAL 1-4-50 ORDER NO. 3807  
CHECKED BY DW 1-19-50 SHEET NO. D2GD

5468.184

FED. ROAD DIST. NO.	STATE	FED. AID PROJ. NO.	FISCAL YEAR	SHEET NO.	TOTAL SHEETS
HAWAII	HONOLULU	SDR 34/1950	1950	307	




Nov. 1, 1950

## BILL OF MATERIAL INDUSTRIAL DEVELOPMENT CO.

No.	Description	Length	Mark	Remarks
NOTE:	BRACES LISTED BELOW ARE TO BE REVAMPED AS SHOWN ON DETAILS.			

SALV. FROM:

1 BRACES	20 5 1/2 TSG	KOLEKOLE
1 Do.	20 5 1/2 TSG	HONOLULU
4 # 9 1/2 x 3 3/8	O 9 3/4 b	ZENAR (NEW)

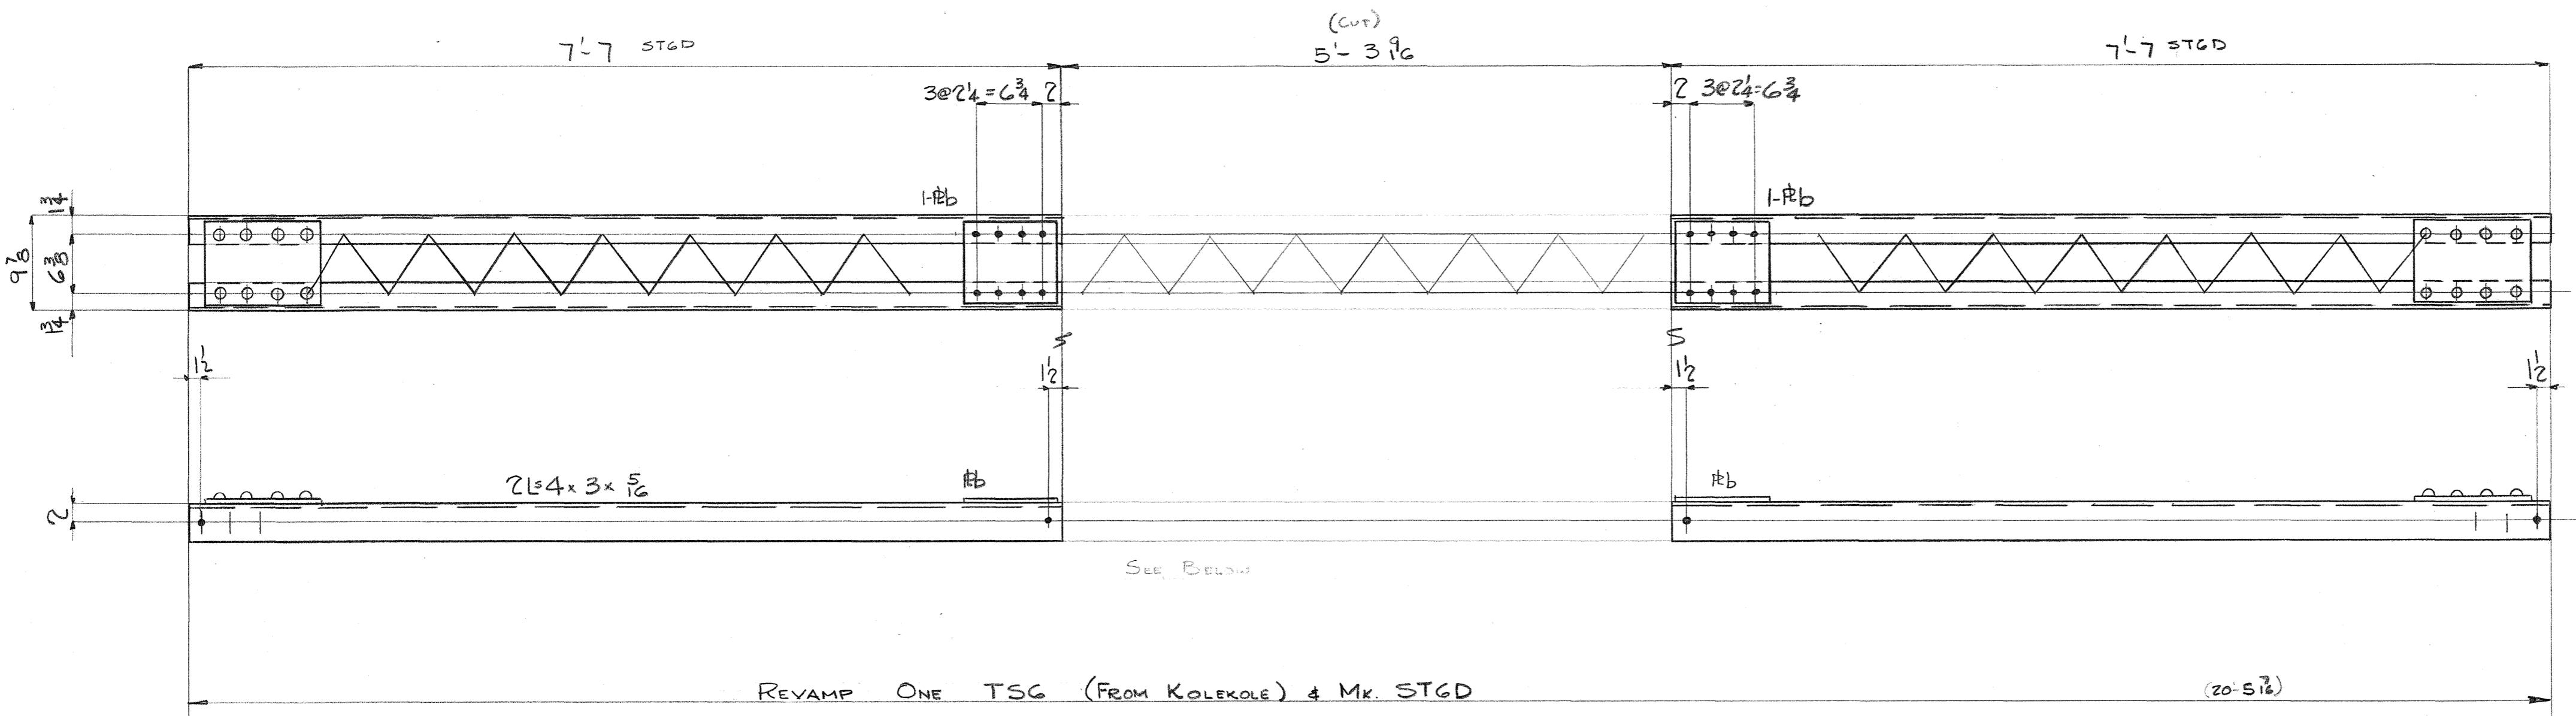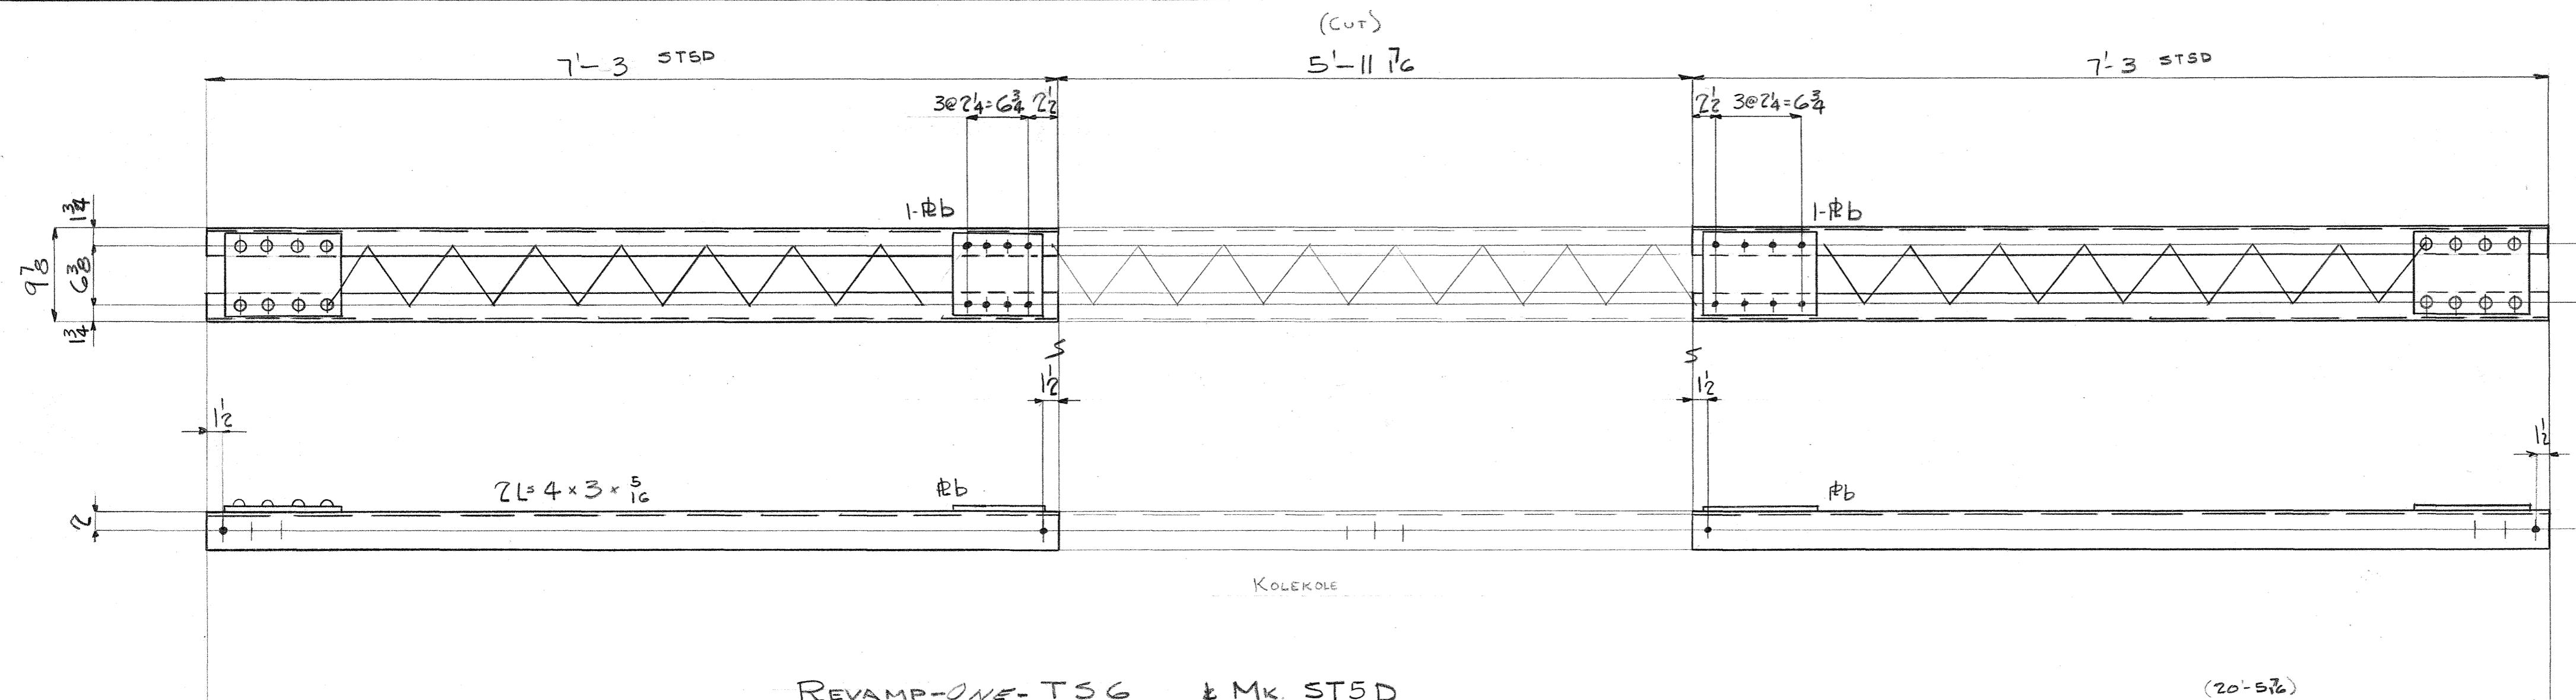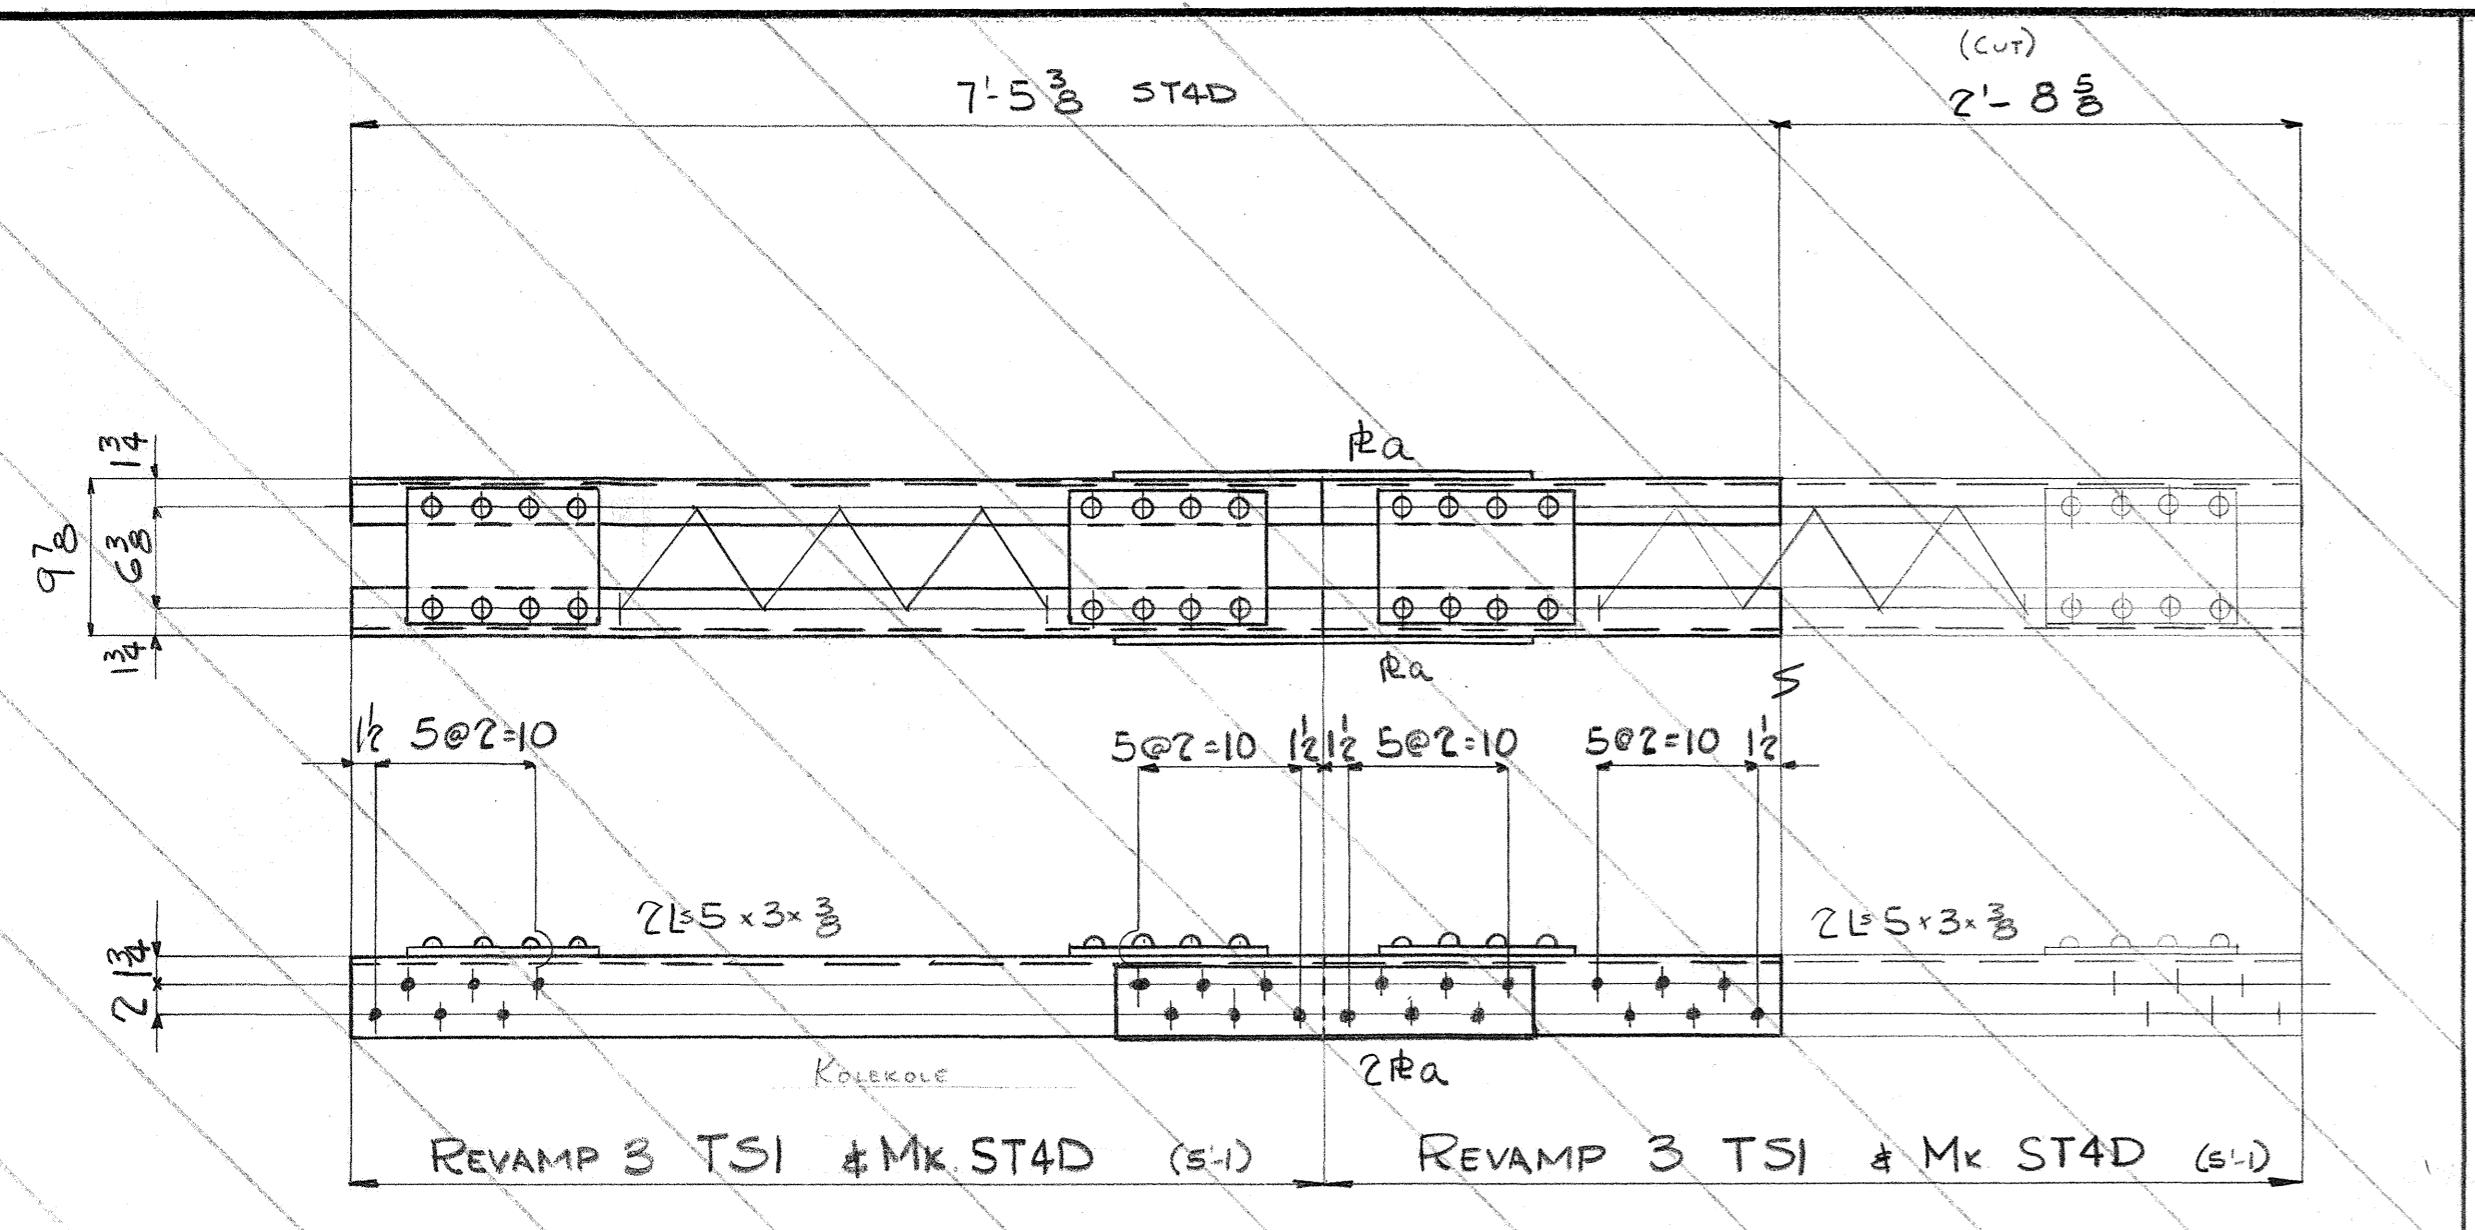

Rivets:  $\frac{3}{4}$  "

Holes:  $\frac{13}{16}$  "  $\frac{1}{2}$  ED. UN.

Paint:

INDUSTRIAL DEVELOPMENT COMPANY  
ADDITION TO UMAUMA BRIDGE  
HAWAII

INDEPENDENT IRON WORKS, INC.  
OAKLAND, CALIF.

MADE BY DAL 1-5-50 ORDER NO. 3807  
CHECKED BY DO 1-19-50 SHEET NO. D27D




5468.185

FED. ROAD DIST. NO.	STATE	FED. AID PRJ. NO.	FISCAL YEAR	SHEET NO.	TOTAL SHEETS
Hawaii	HAWSDR 2(13)	1950	186	300	

# BILL OF MATERIAL

## INDUSTRIAL

## DEVELOPMENT

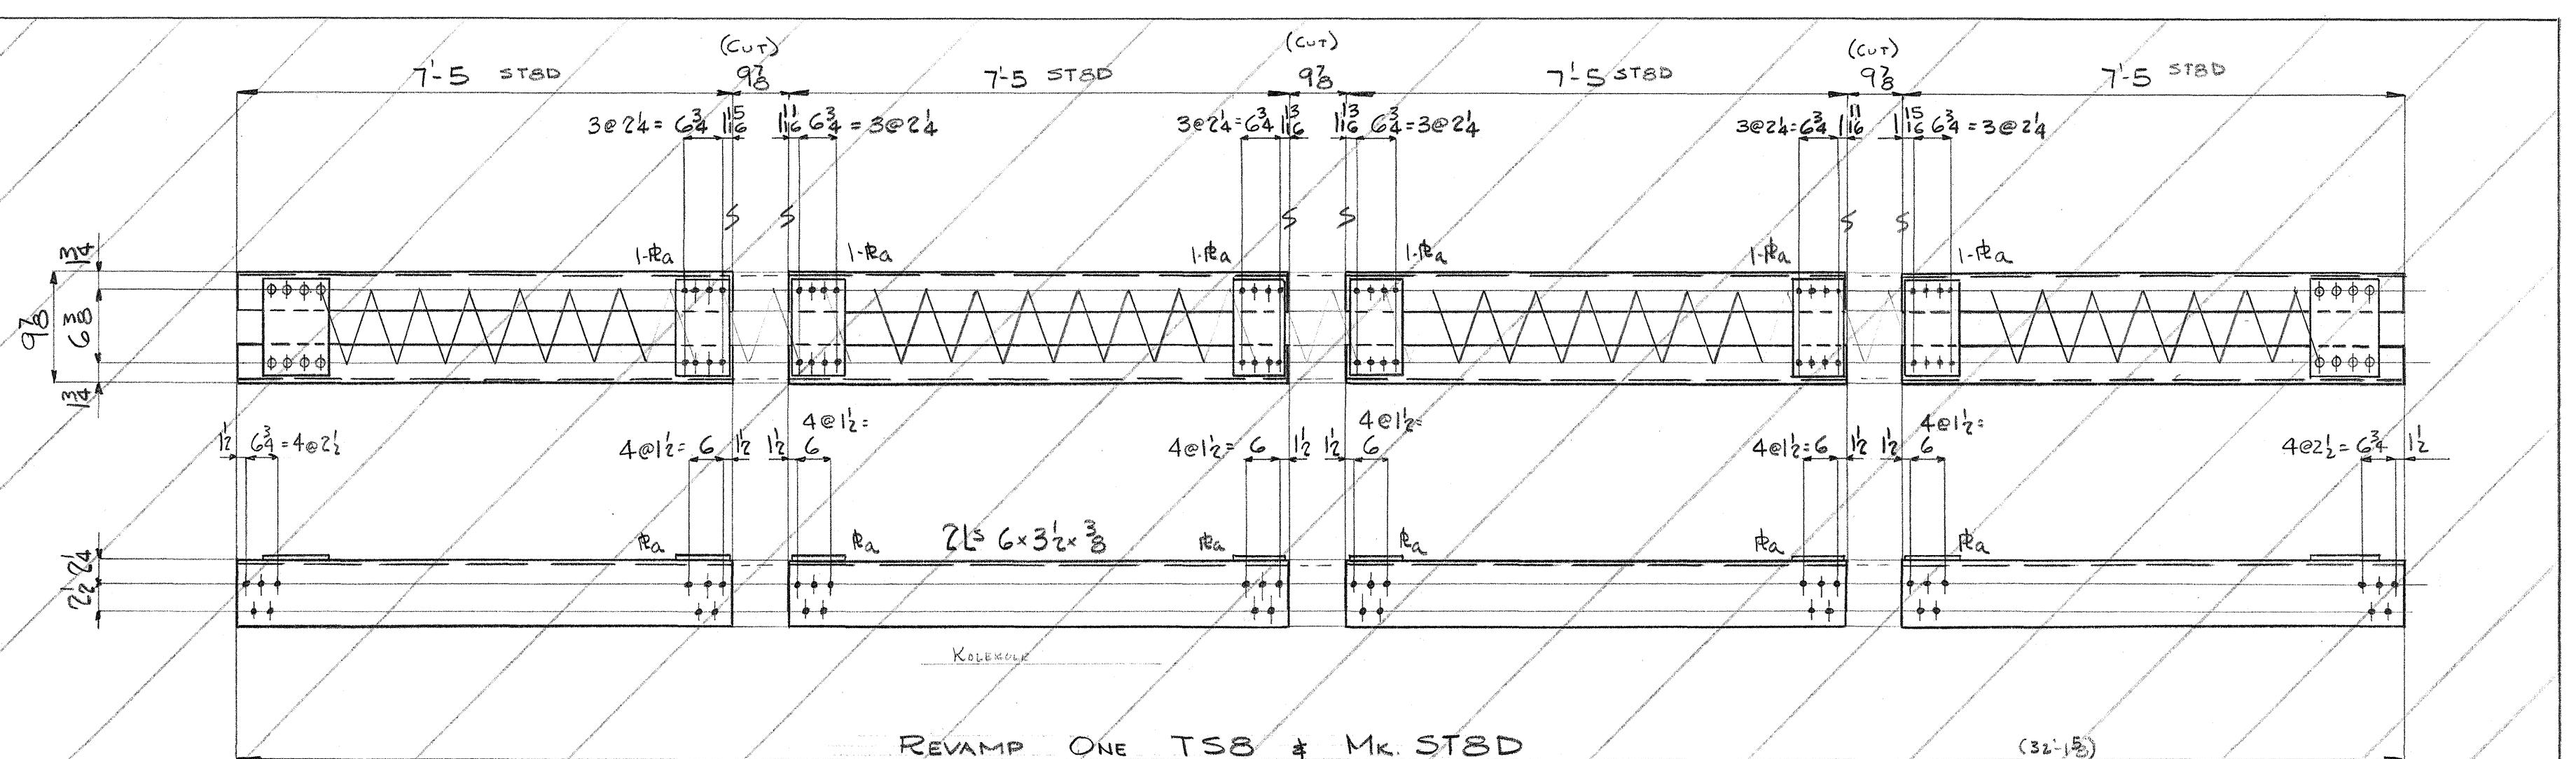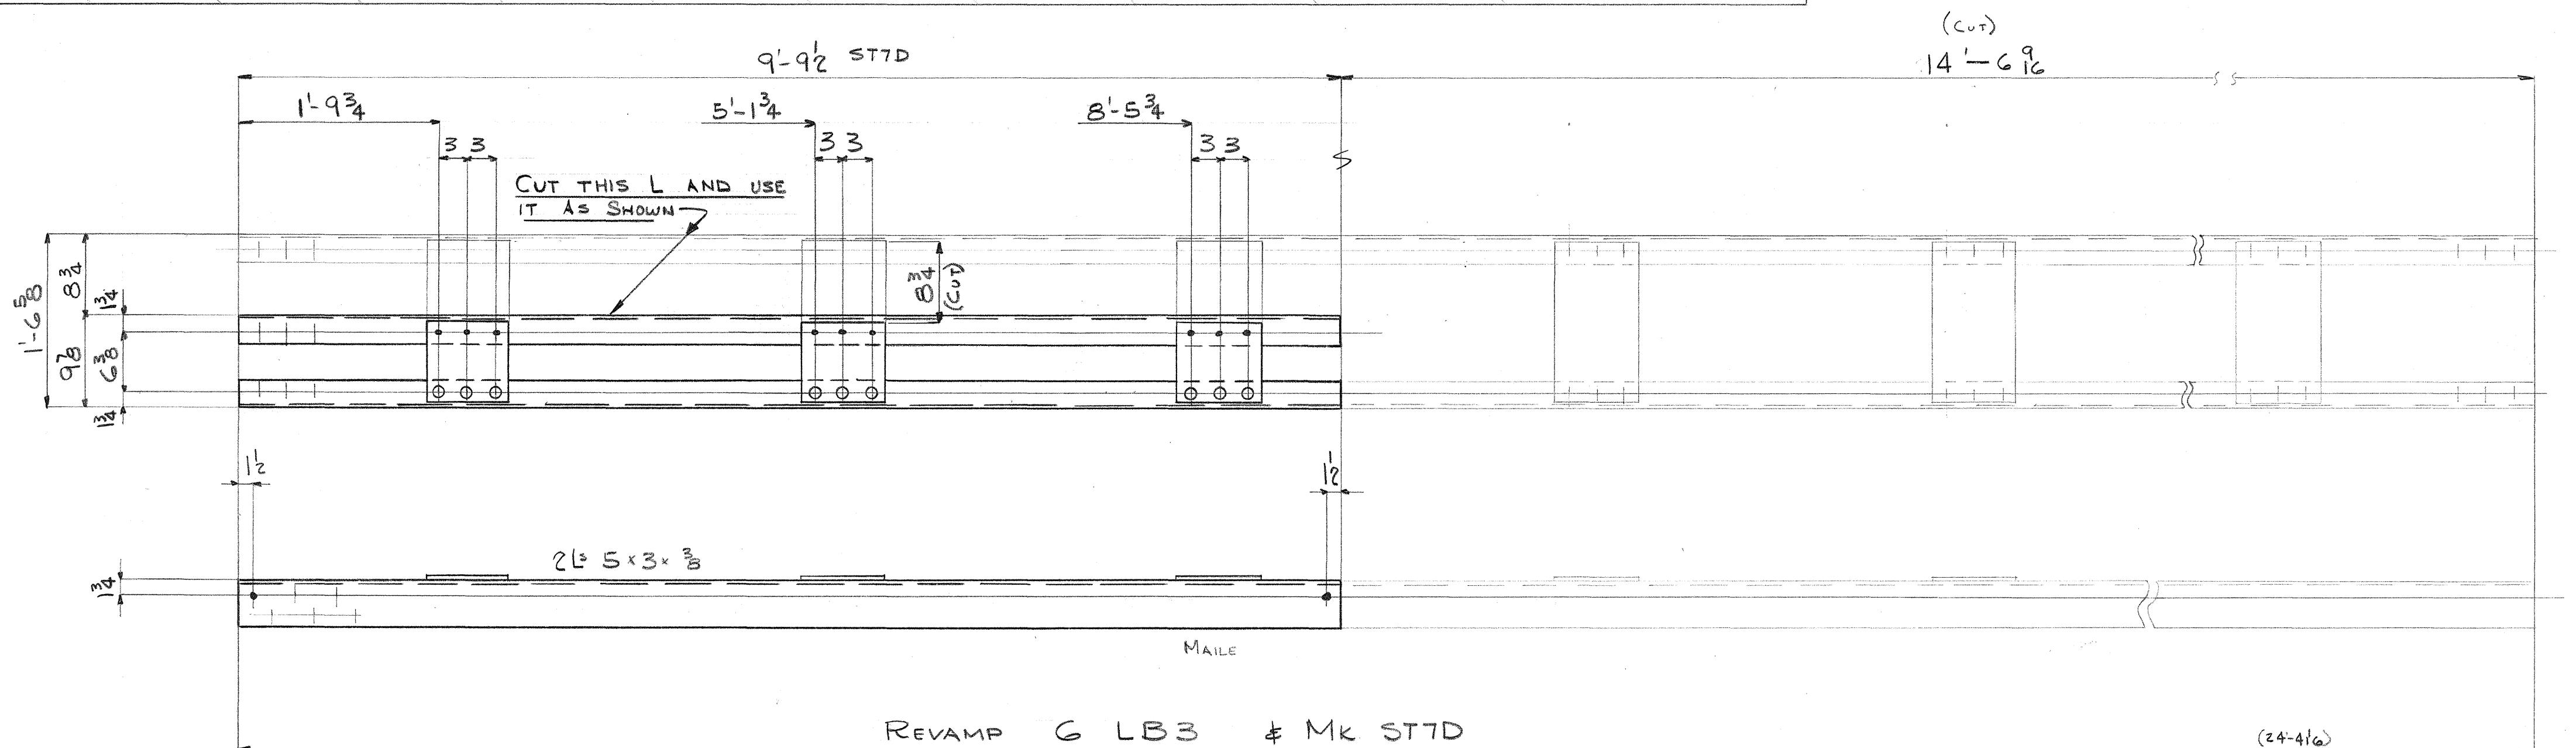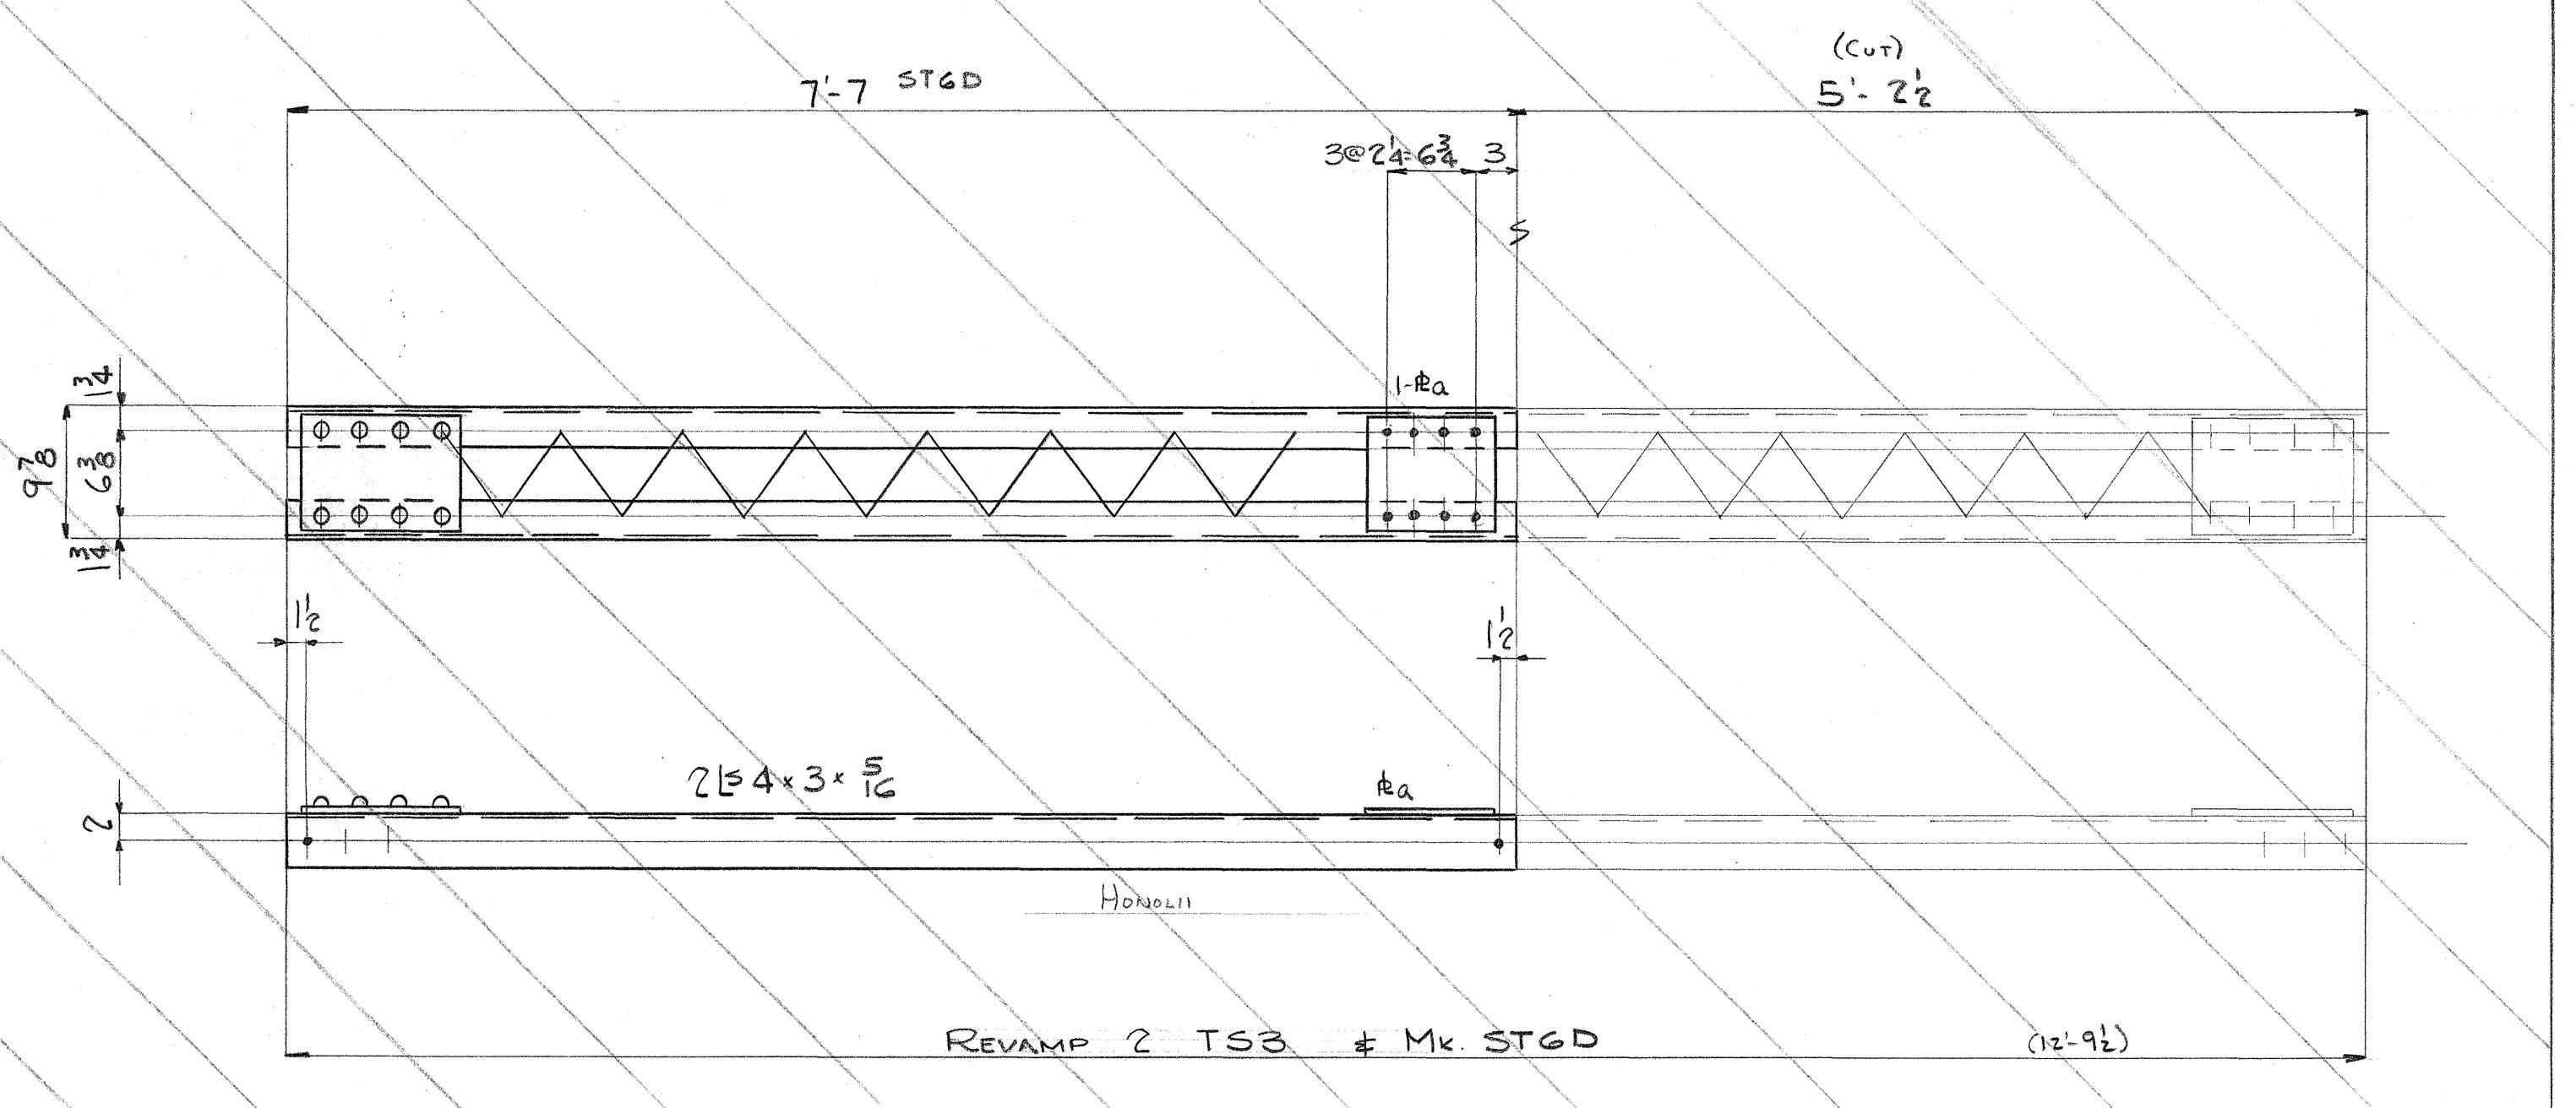

ivets:  $\frac{3}{4}$  φ  
holes:  $\frac{13}{16}$  φ       $1\frac{1}{2}$  ED UN  
aint:

INDUSTRIAL DEVELOPMENT COMPANY  
ADDITION TO UMAUMA BRIDGE





**INDEPENDENT IRON WORKS, INC.**  
OAKLAND, CALIF.

**INDEPENDENT IRON WORKS, INC.**  
OAKLAND, CALIF.

Nov. 1, 1950

BILL OF MATERIAL UHARUMA BRIDGE

No.	Description	Length Ft. In.	Mark	REMARKS
NOTE: REVAMP THE BEIGES LISTED BELOW AS SHOWN ON THE DETAILS				
1	BRACE	70B		
1	Do.	25B		
2	Do.	96B		
1	Do.	71B		
1	Do.	72B		
2	Do.	18B		
NEW NATE IS LISTED BELOW				
6	BRACES	DB90		
6	Do.	DB100		
6	" 4x3x $\frac{3}{8}$	1	a	TENIP
4	R 3x $\frac{3}{8}$	0	b	Do.
108	R 8x $\frac{3}{8}$	0	c	Do.
12	" 3x2x $\frac{3}{8}$	20	d	Do.
12	" 3x2x $\frac{3}{8}$	30	e	Do.
735	$\frac{3}{4}$ " RIVETS (SHRD)			

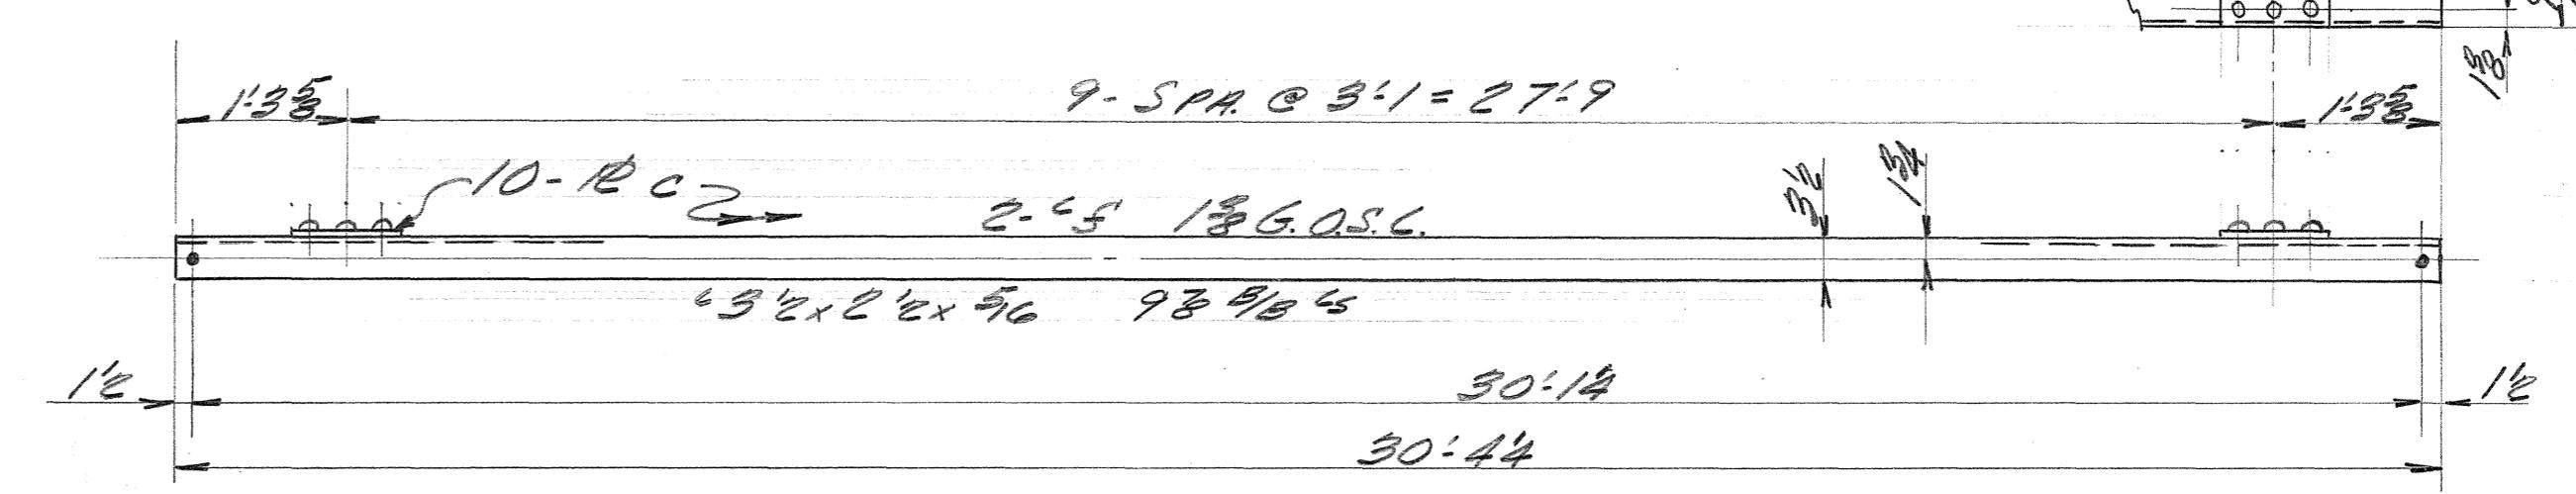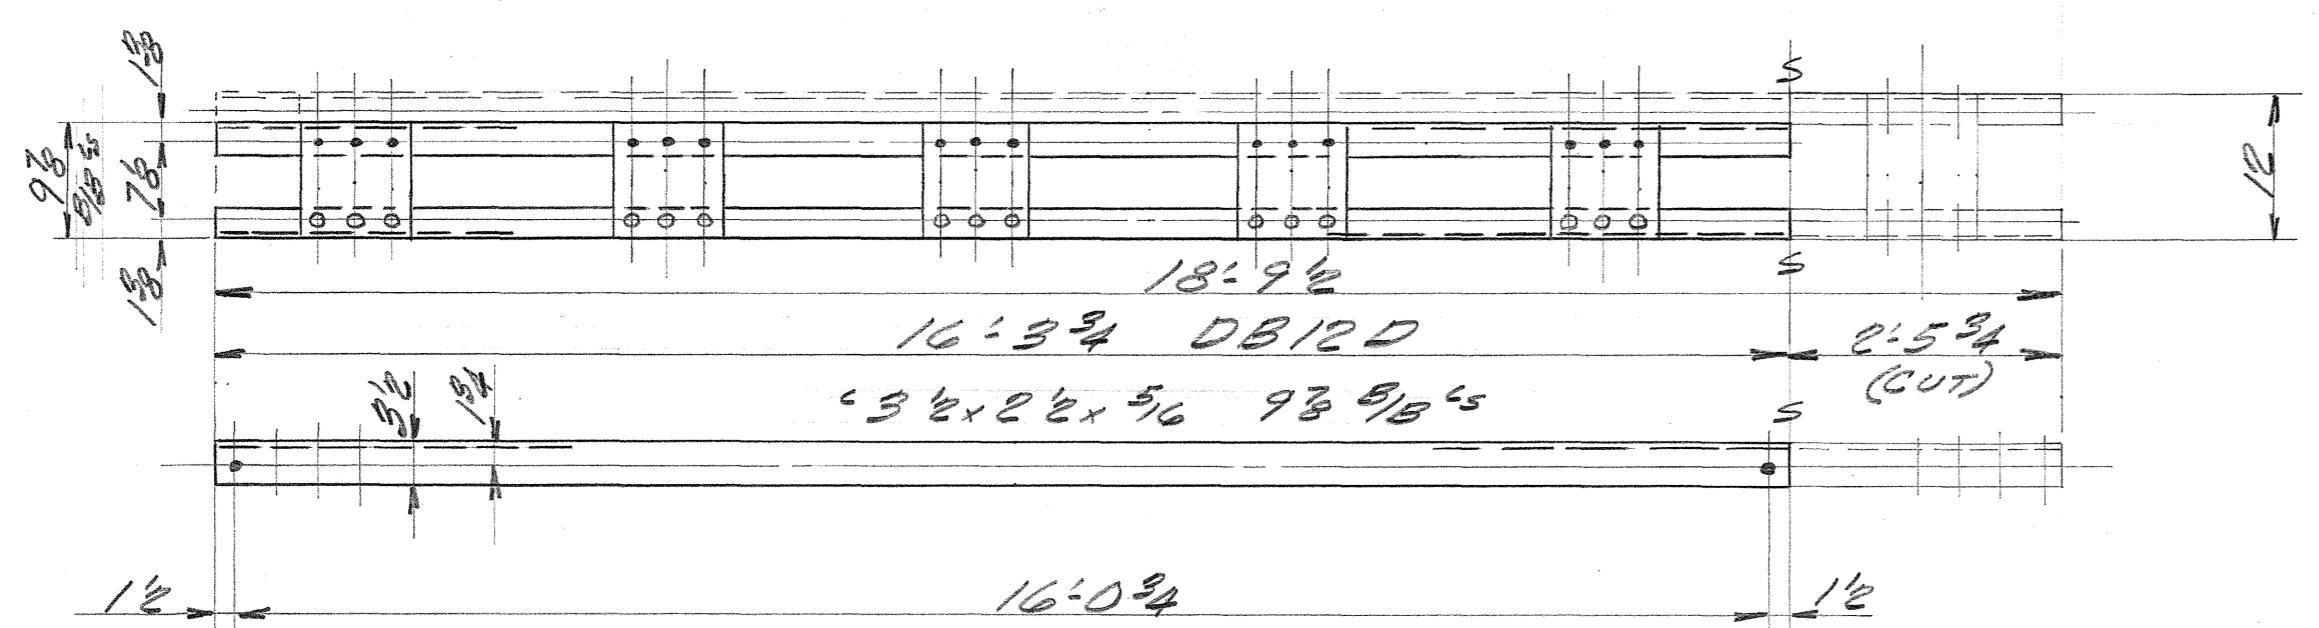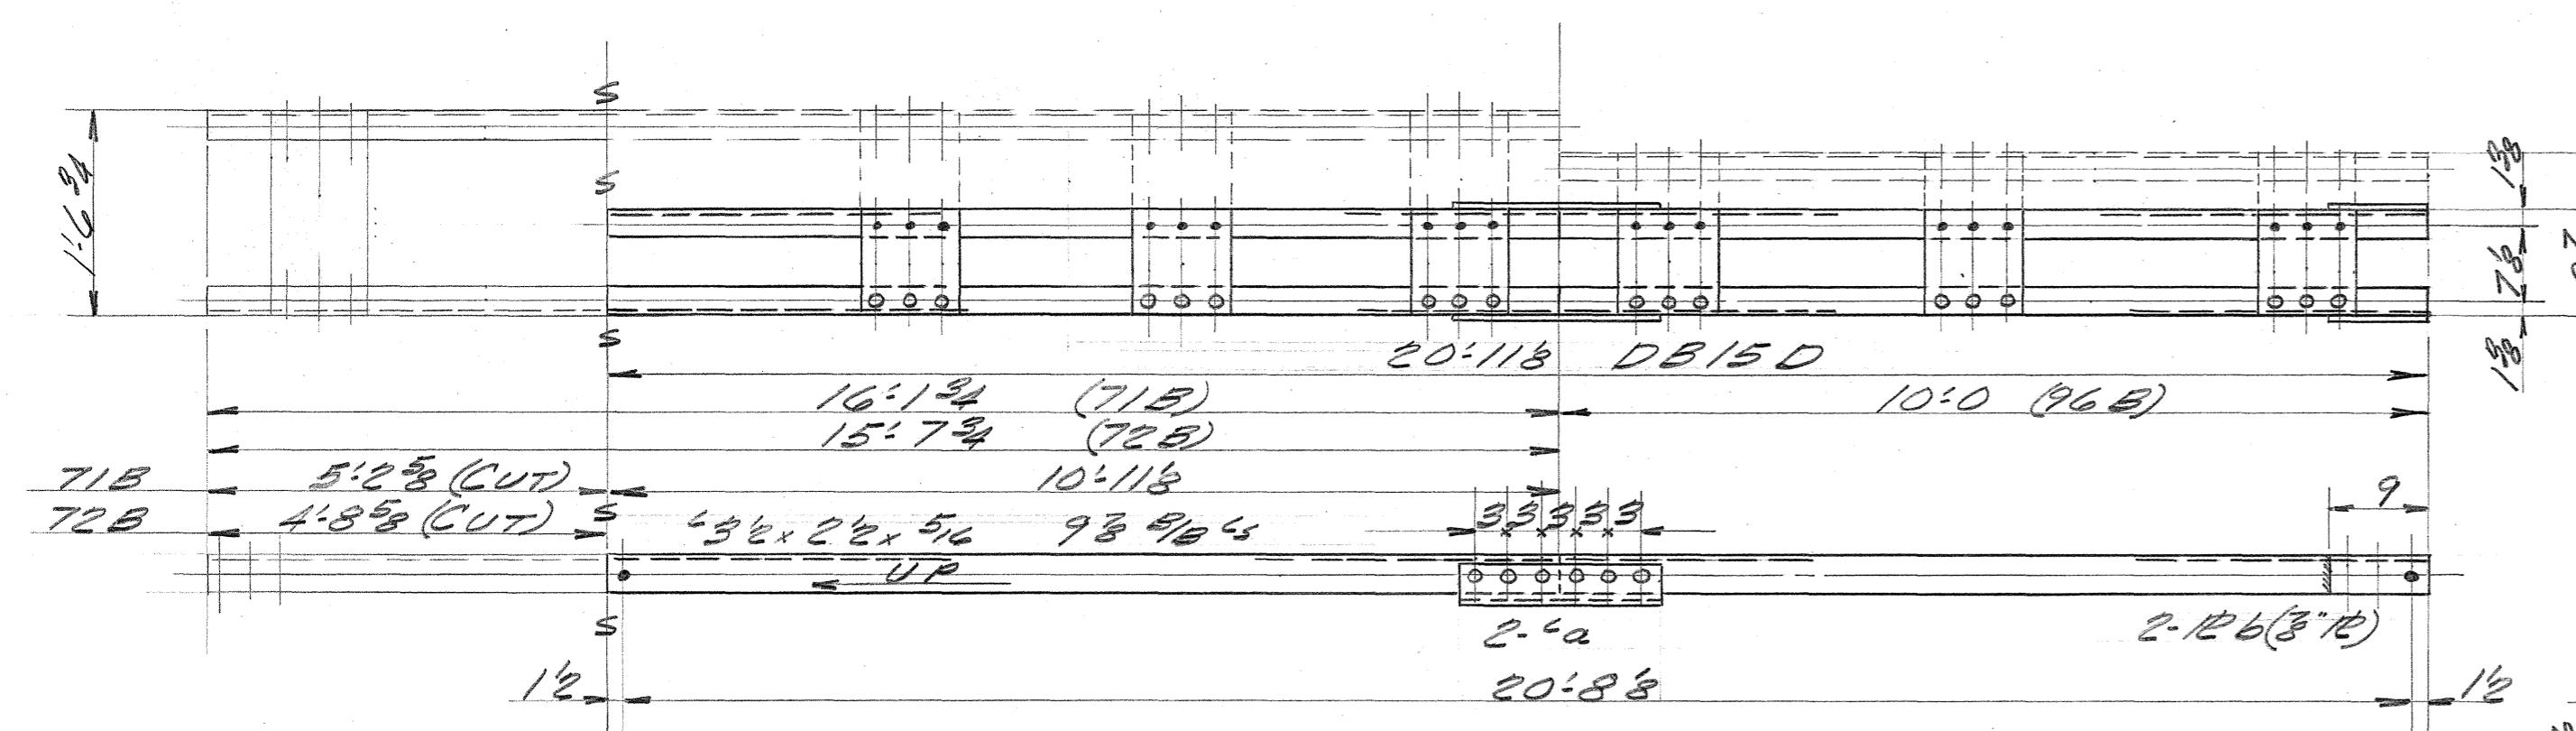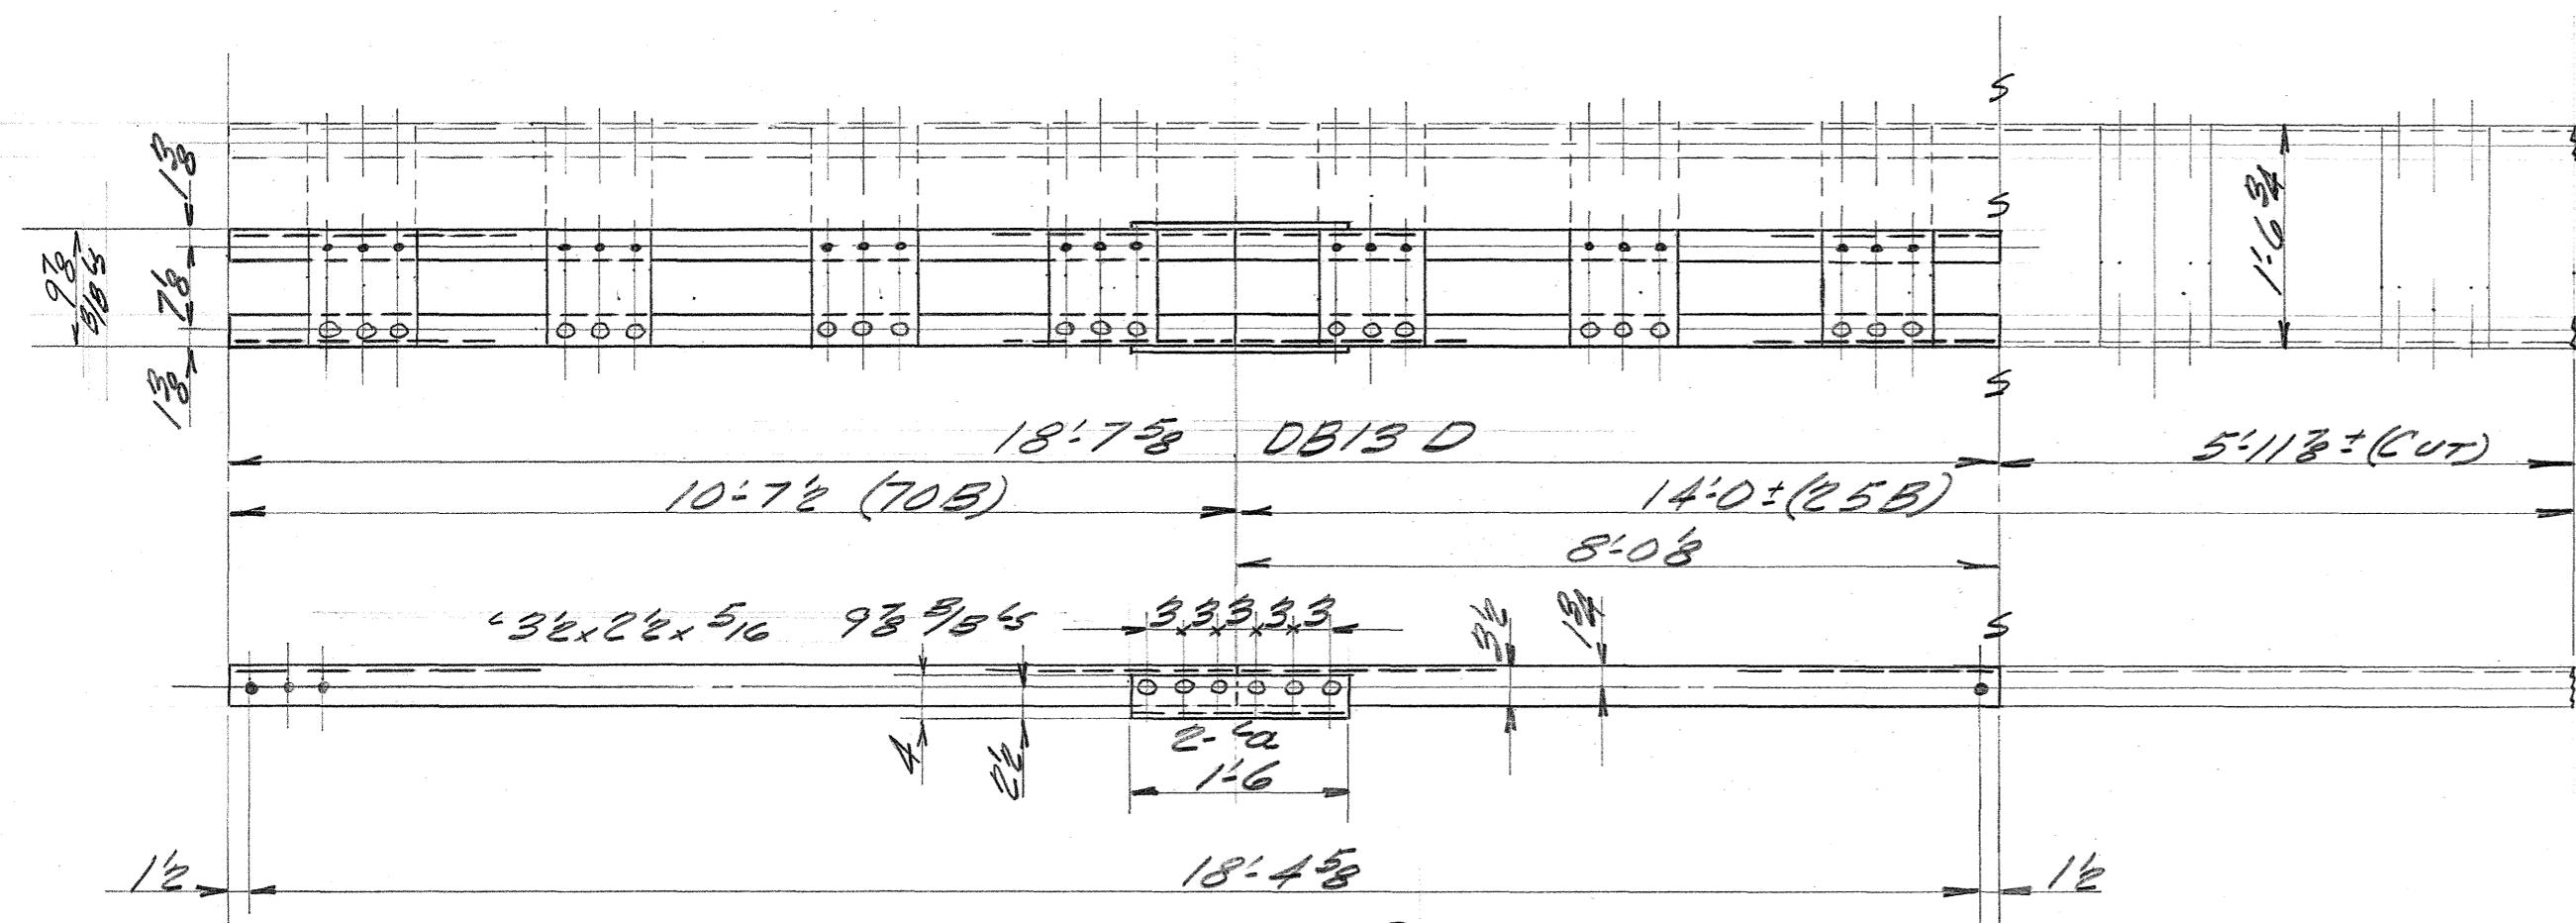


Rivets: $\frac{3}{4}$ "
Holes: $\frac{13}{16}$ "
Paint: (SEE SPECS)
INDUSTRIAL DEV. CO.
ADDITION TO THE UHARUMA BRIDGE - HAWAII - INDEPENDENT IRON WORKS, INC. OAKLAND, CALIF.
MADE BY 000 820-50 ORDER 3807 CHECKED BY SHEET D290

5468.187

FED. ROAD DIST. NO.	STATE	FED. AID PROJ. NO.	FISCAL YEAR	SHEET NO.	PLTS
Hawaii	Haw	SDR 3(13)	1950	188	304


# BILL OF MATERIAL

## INDUSTRIAL DEVELOPMENT CO.

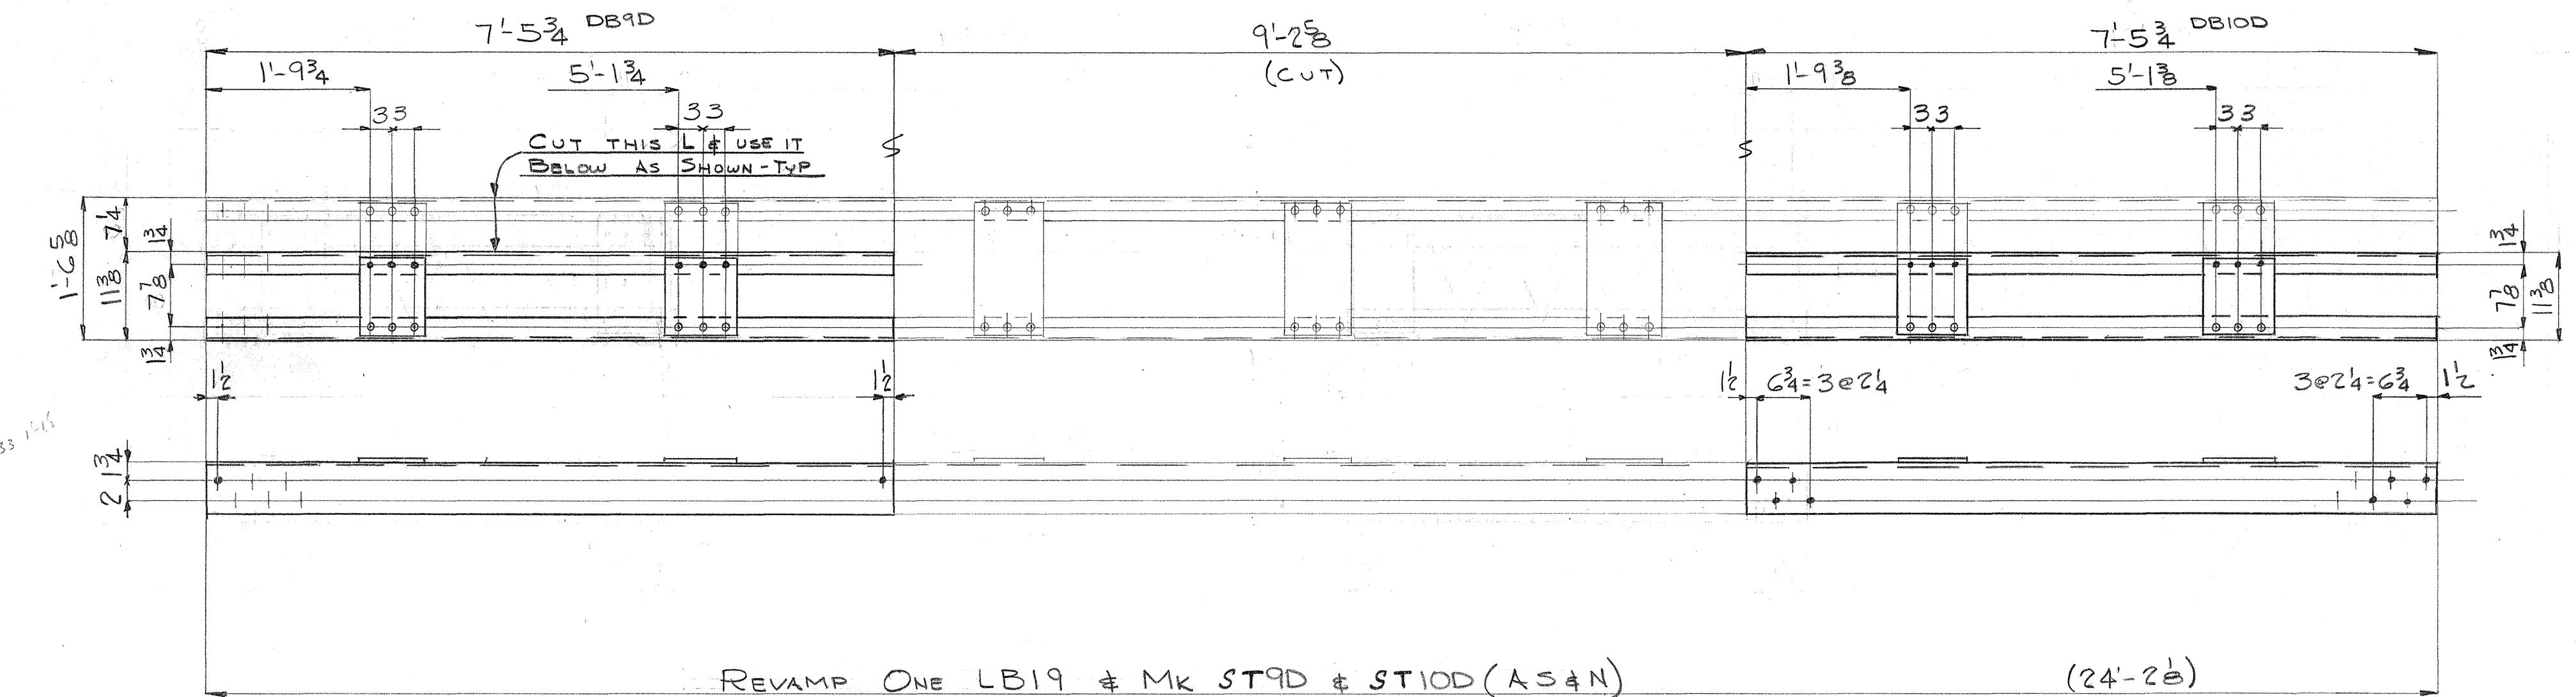


REVAMP ONE LB19 & MK ST9D & ST10D (AS&N)

(24-28)

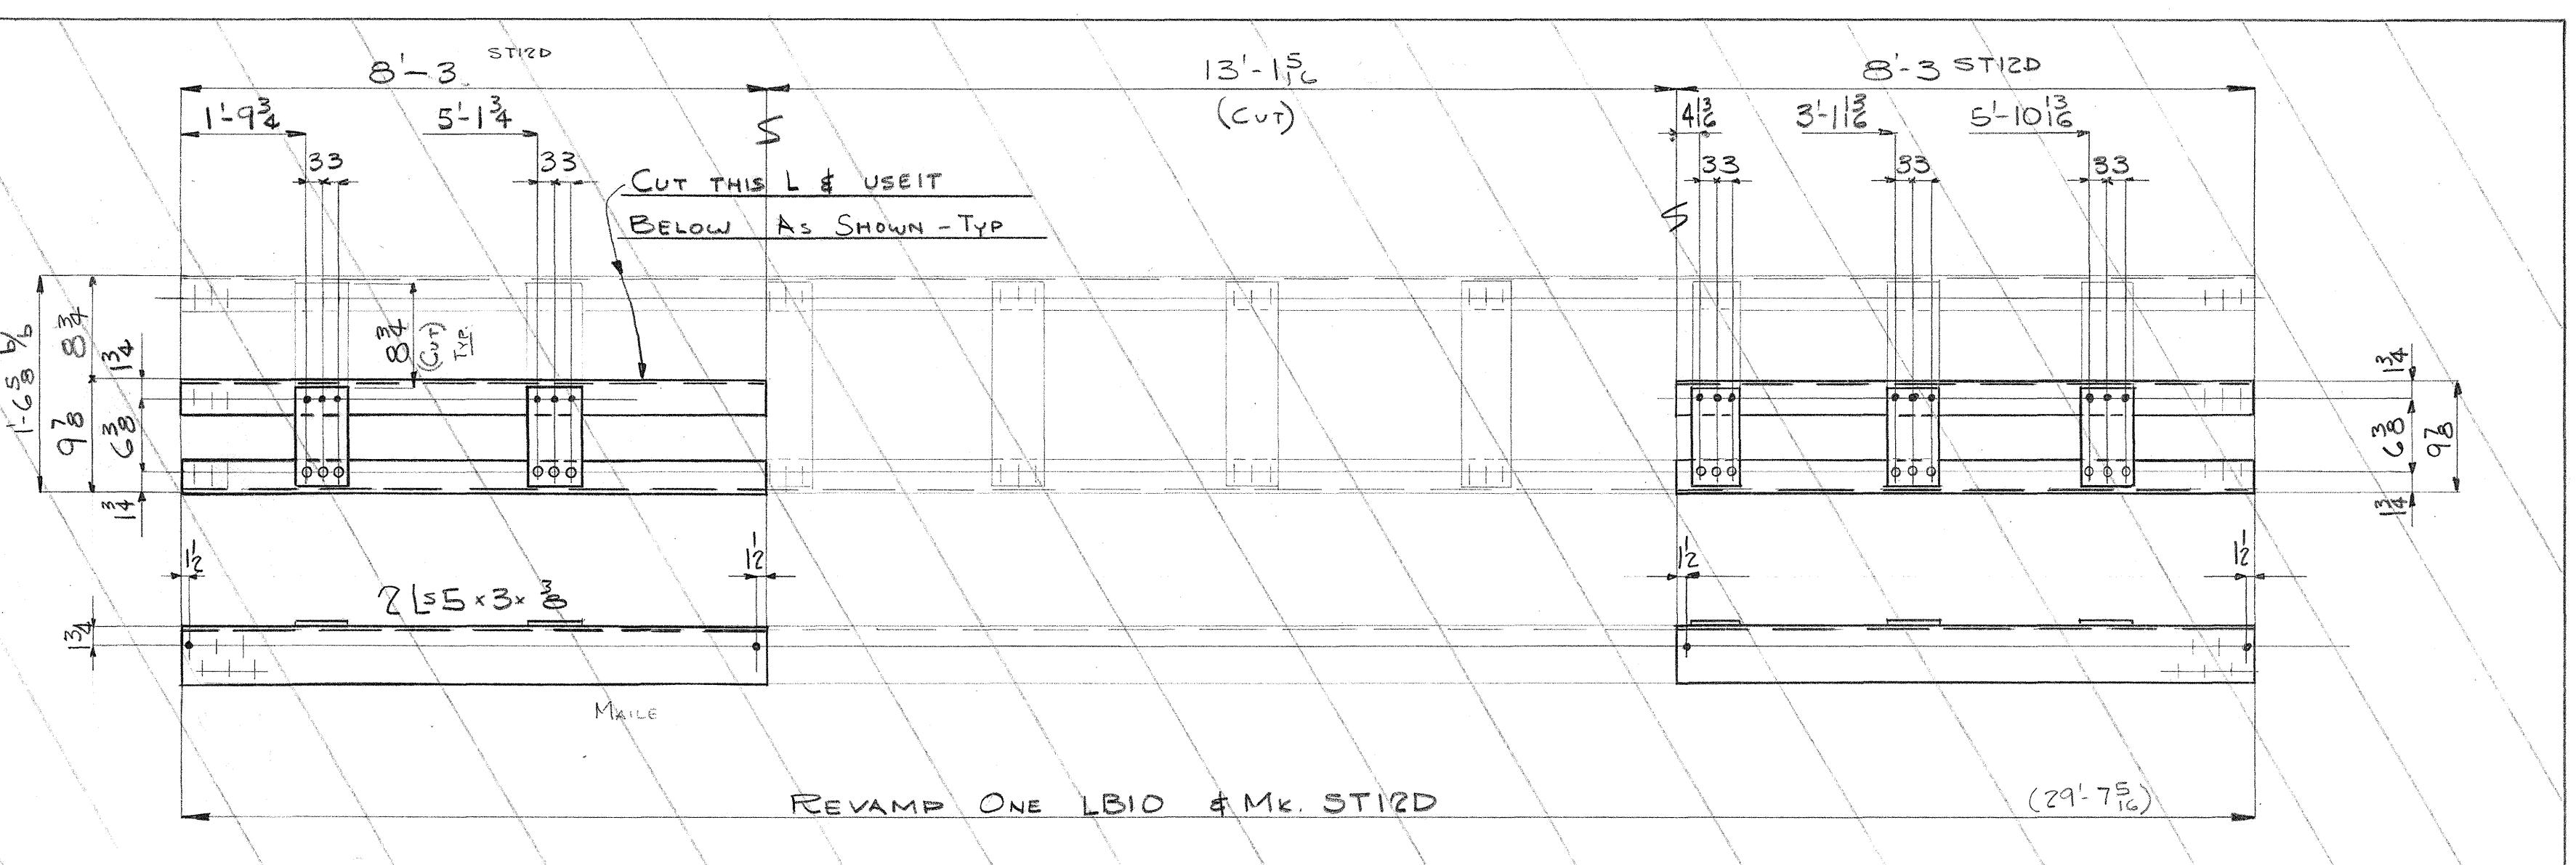

REVAMP ONE LB10 & MK. ST12D

9-75  
16)

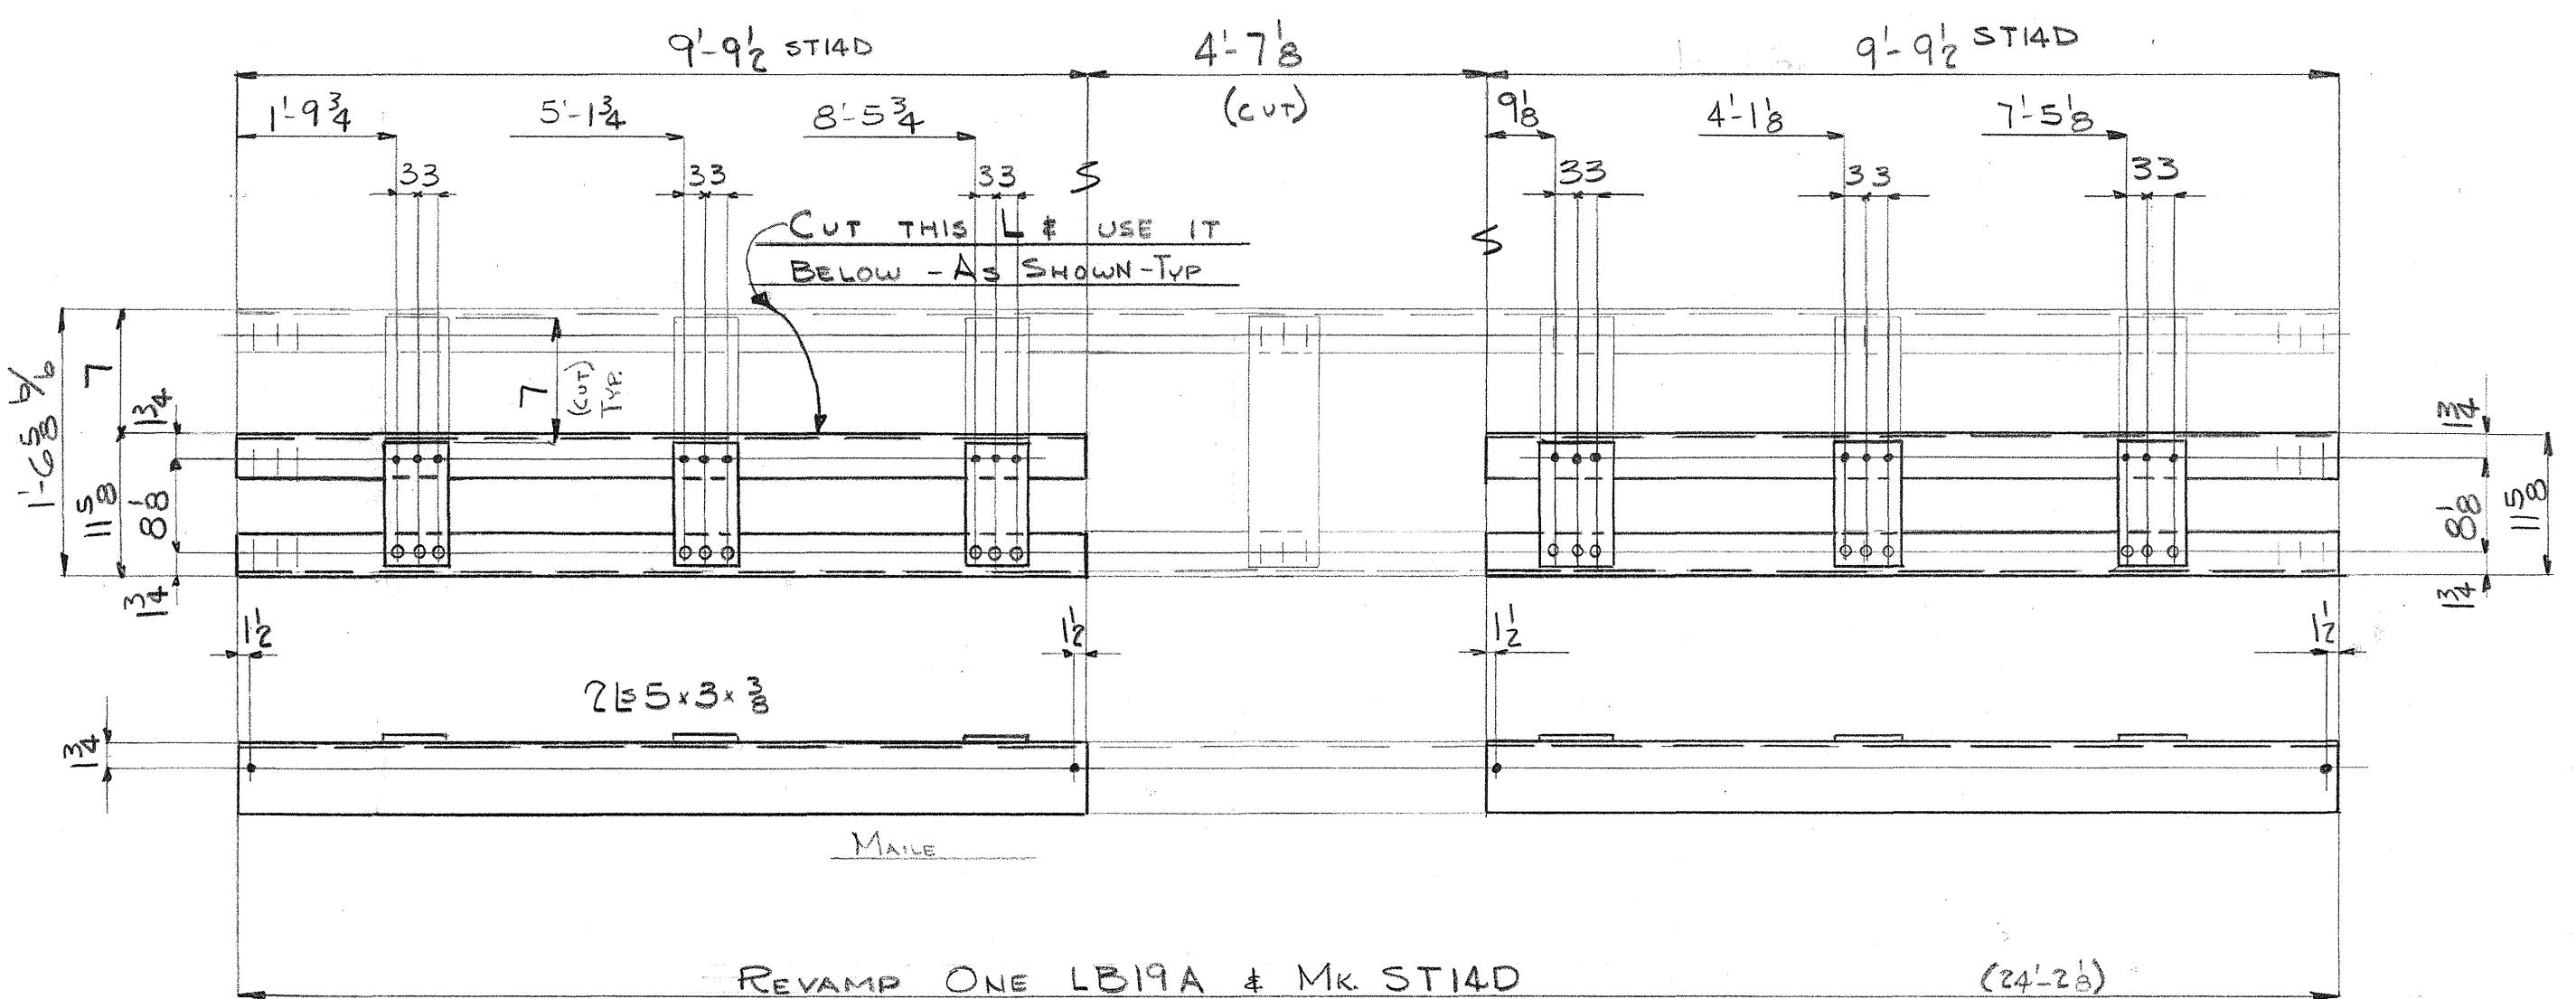

REVAMP ONE LB19A + MK ST14D

(24-28)

Rivets:  $\frac{3}{4}$  φ

Holes:  $\frac{3}{8}$  φ       $\frac{1}{2}$  ED UN

Paint:

INDUSTRIAL DEVELOPMENT COMPANY  
ADDITION TO UMAUMA BRIDGE

---

**INDEPENDENT IRON WORKS, INC.**  
OAKLAND, CALIF.

MADE BY	DAL	1-6-50	ORDER NO.	3807
CHECKED BY	Op	1-19-50	SHEET NO.	D30D

7:5

Hawaii No

$7 \cdot 3 \cdot 3$        $14 @ 4' = 5'3$        $3 \cdot 7$

1-RC      1-EP      1-RC

$14 @ 4'$

$1/2$        $4@1/2$        $1/2$

$6 \times 3 \times 3$

$1/2$        $4@1/2$        $1/2$

NIKE - 8-STRUTS MR. ST80 (NEW NIKE)

The figure shows a diagram of a guitar neck with six strings. Above the neck, there are two sets of markings: 'CUT' on the left and right ends. On the left end, there is a grid of dots representing fret positions, with a calculation below it:  $\frac{1}{2} - \frac{1}{3} = \frac{1}{6}$ . To the right of the neck, there is another set of markings: 'CUT' on the right end, a grid of dots, and a calculation:  $\frac{1}{2} - \frac{1}{3} = \frac{1}{6}$ . Between these two sets of markings, the neck is divided into three equal segments by vertical dashed lines. The middle segment is labeled  $5 \times 3 \times \frac{3}{8} (1-3 \frac{3}{8} \frac{9}{16} \frac{5}{16})$ . Below the neck, there is a list of string positions and their corresponding scale lengths:
 

- 52A - 3-1/8
- 53A & 55A - 2-3/8
- 54A - 2-6/4
- 56A - 4-9
- 57A - 5<sup>3</sup>/4
- 58A - 2-3<sup>3</sup>/4
- 25-2<sup>3</sup>/4 52A
- 23-6/4 53A & 55A
- 23-11/2 54A
- 28-5 56A
- 19-10<sup>1</sup>/<sub>2</sub> 57A

3-3 3/4  
(CUT)

16'-2 DB23D

3-3 3/4  
(CUT)

$1/2$     $5@3$     $=1/3$     $2\text{-ct}$

$4 \times 3 \times 3$     $1-3 \frac{4}{16}$

$1/2$     $1/2$     $1/2$

$1/2$     $5@3$     $=1/3$     $2\text{-ct}$

$2\text{-Raa}$   
 $4\text{-Rss}$

22-9/16

REVAMP-ONE- 98B (MAKES-ONE- DB23D)

26-11 DB21D

2-5  
(CUT)

3-0  
1/2

5@3  
=1/3  
2-ct

$5 \times 3 \times 3$     $(1-3 \frac{8}{16} \frac{9}{16})$

$1/2$

3-0  
1/2

5@3  
=1/3  
2-ct

31-4

REVANAP - ONE- 46A (NAKES - ONE- DB21D)

ivets: 34  
holes: 136 " 5  
aint: (SEE SPECS)

## INDUSTRIAL DIV Co

ADDITION TO THE  
UNAUNA BRIDGE  
- HAWAII -


(NEW NAT'L.)

546 S. 189

Order No. 3807 Sheet No. D32D

# **BILL OF MATERIAL**

**3/8" Ø RIVETS (SHOP)**

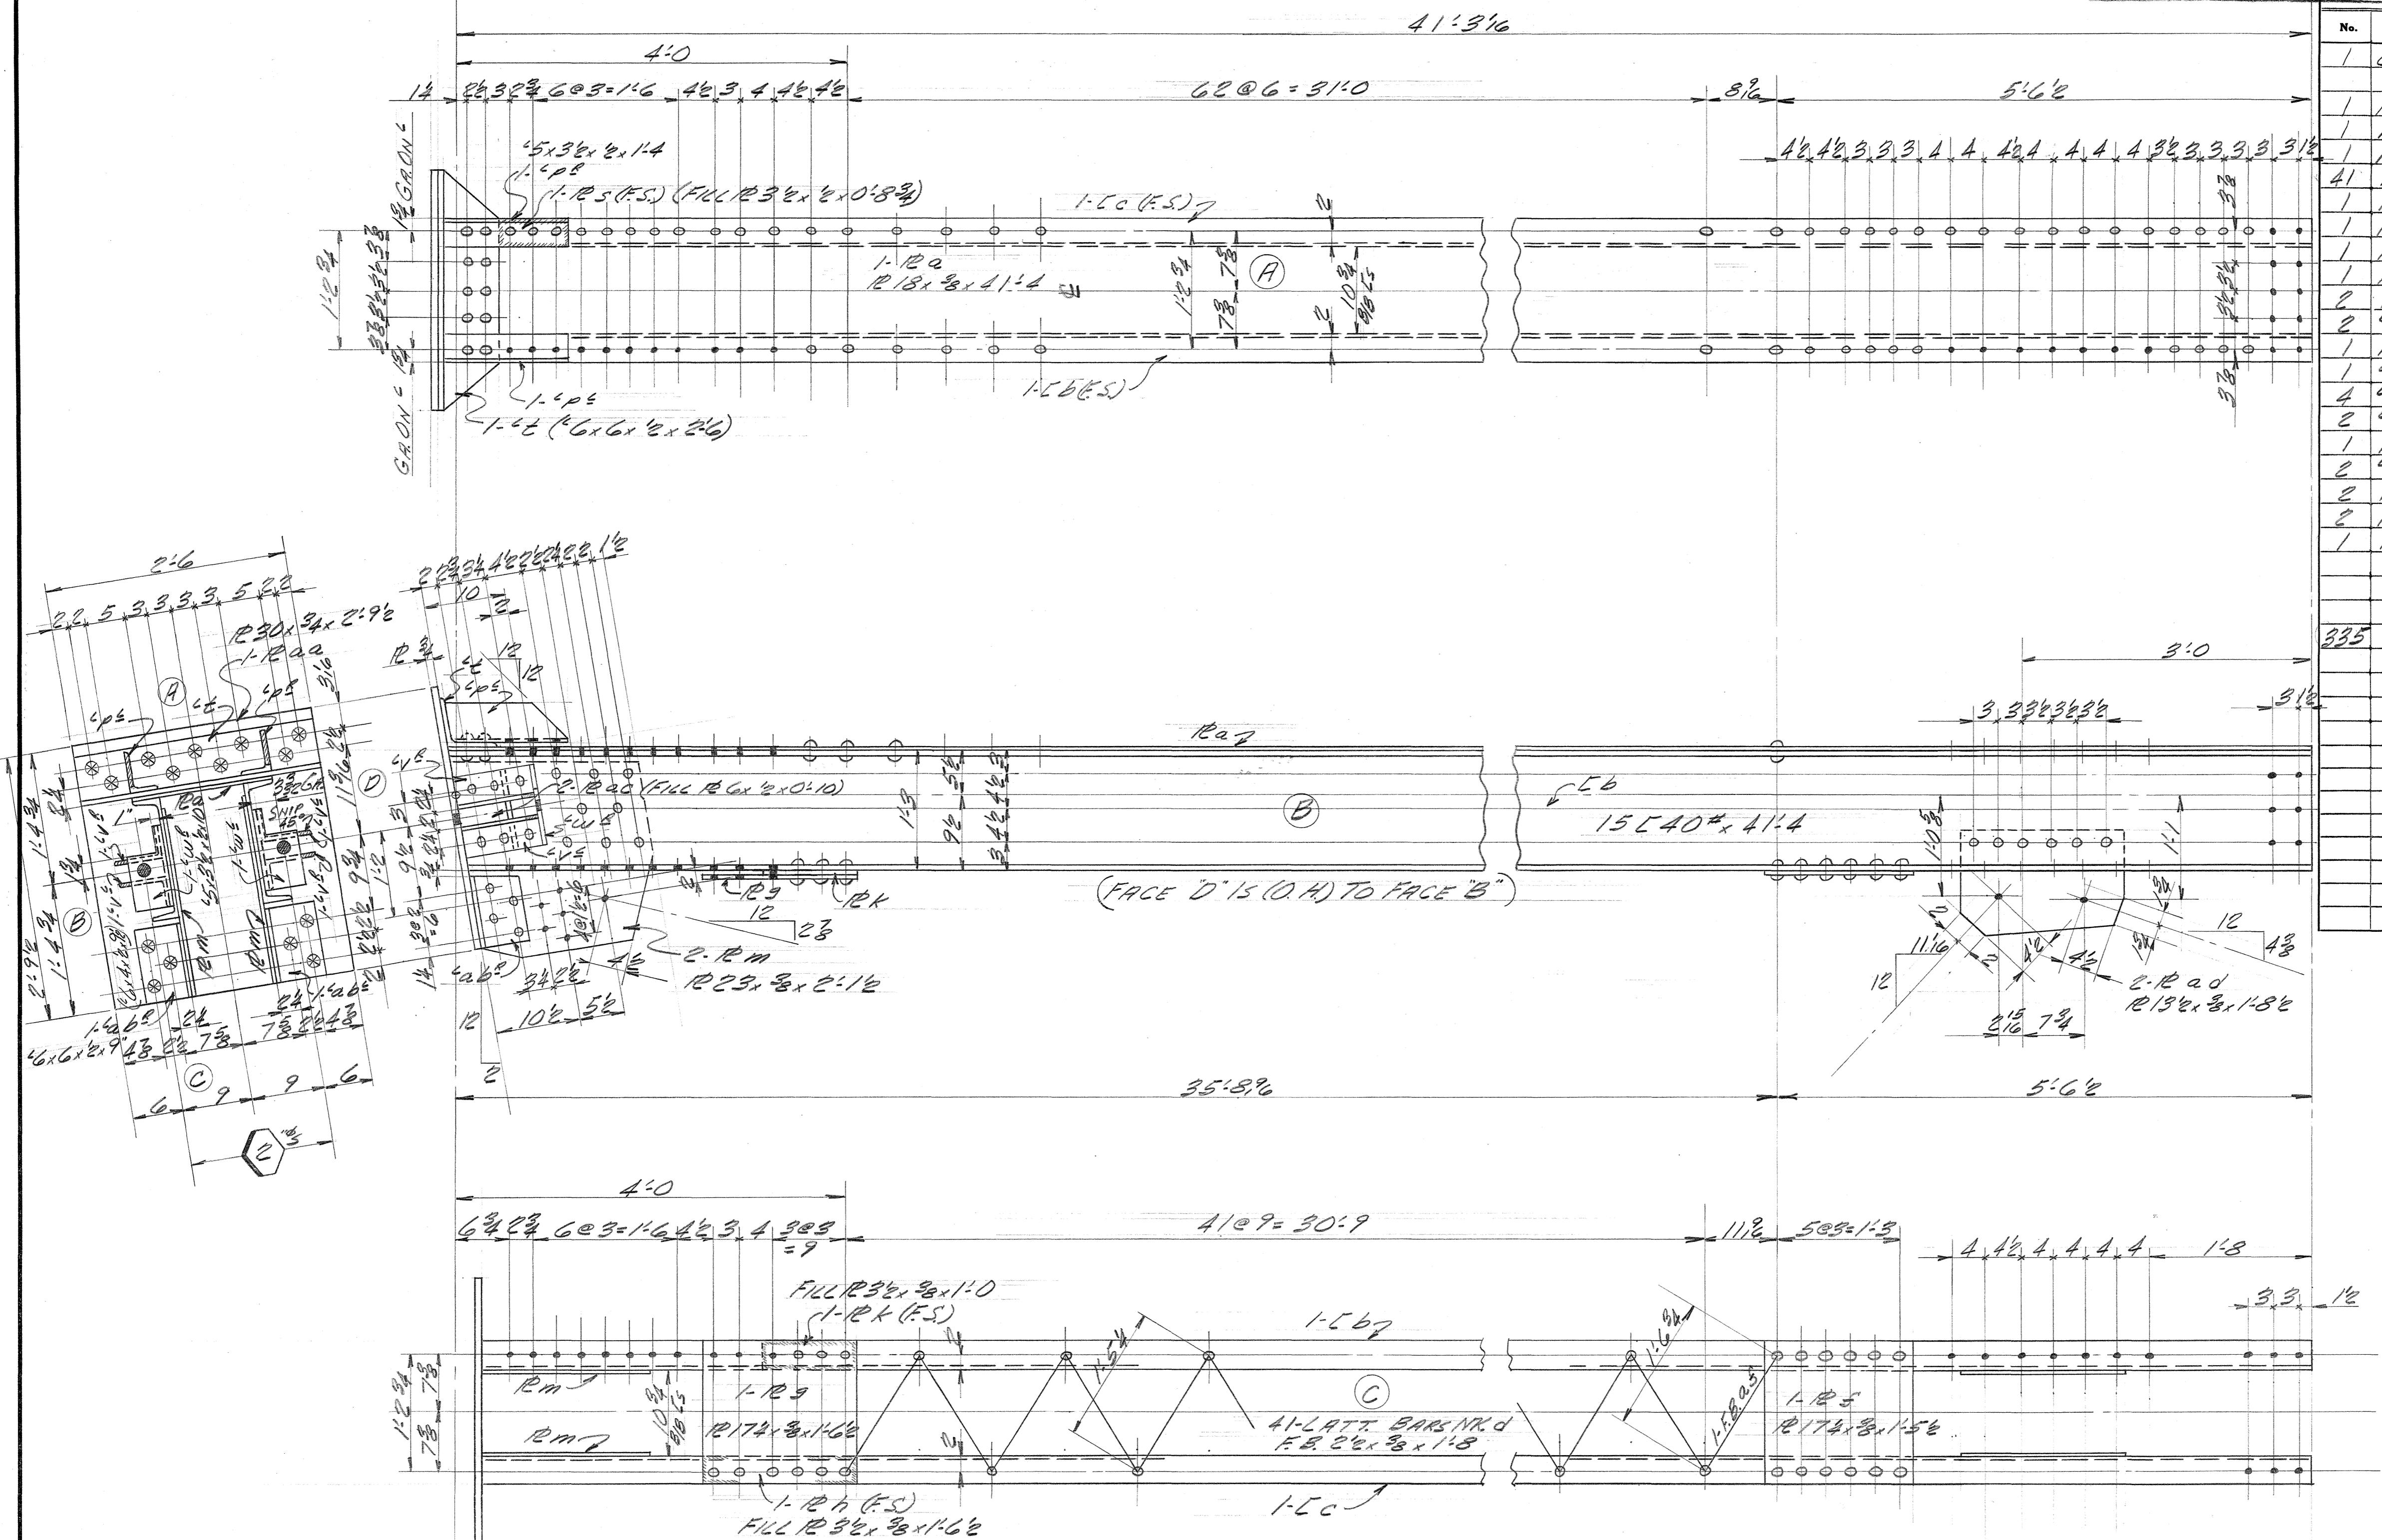

MAKE-ONE-COL. MR. CIA<sup>R</sup> (A.S.)

Rivets: 3/16  
Holes: 13/16 U.N.  
Paint: (SEE SPEC'S)

## INVESTIGATIVE DEPT.

# INDUSTRIAL DEV.

## ADDITION TO THE

## UNAUNA BRIDGE

**-HAWAII-**

**INDEPENDENT IRON WORKS, INC.**  
**OAKLAND, CALIF.**

MADE BY	<i>DM</i>	8-18-50	ORDER NO.	<i>3807</i>
CHECKED BY			SHEET NO.	<i>D32D</i>

1900

B. S. 130

10. The following table shows the number of hours worked by each employee in a company.

5468.190


FED. ROAD DIST. NO.	STATE	FED. AID PROJ. NO.	FISCAL YEAR	SHEET NO.	TOTAL SHEETS
HAWAII HAWI SDR 103		1950	101	300	

**BILL OF MATERIAL UNAUNUA BRIDGE**

No.	Description	Length Ft.	Mark	REMARKS
2	COLUMNS C3E KOLEKOLE (REVAMP A.S. ON DET.)			
4	F.8.4x 3/4 2 0	a	PLAIN	
2	R.22x 3/4 2 0	b	TEAR	
4	6x6x 1/2 0 11	c	Do	
2	6x4x 1/2 2 0	d	Do	
4	R.18x 3/8 1 10	e	Do	
2	R.20x 3/8 2 6	f	Do	
2	F.8.3x 3/8 0 82	g	Do	
2	R.20x 3/8 2 1	h	Do	
4	R.12x 3/8 1 11	i	Do	
4	R.15x 3/8 1 3	j	P.GAIN	

NEW MATE. IS LISTED BELOW

4	F.8.4x 3/4 2 0	a	PLAIN
2	R.22x 3/4 2 0	b	TEAR
4	6x6x 1/2 0 11	c	Do
2	6x4x 1/2 2 0	d	Do
4	R.18x 3/8 1 10	e	Do
2	R.20x 3/8 2 6	f	Do
2	F.8.3x 3/8 0 82	g	Do
2	R.20x 3/8 2 1	h	Do
4	R.12x 3/8 1 11	i	Do
4	R.15x 3/8 1 3	j	P.GAIN

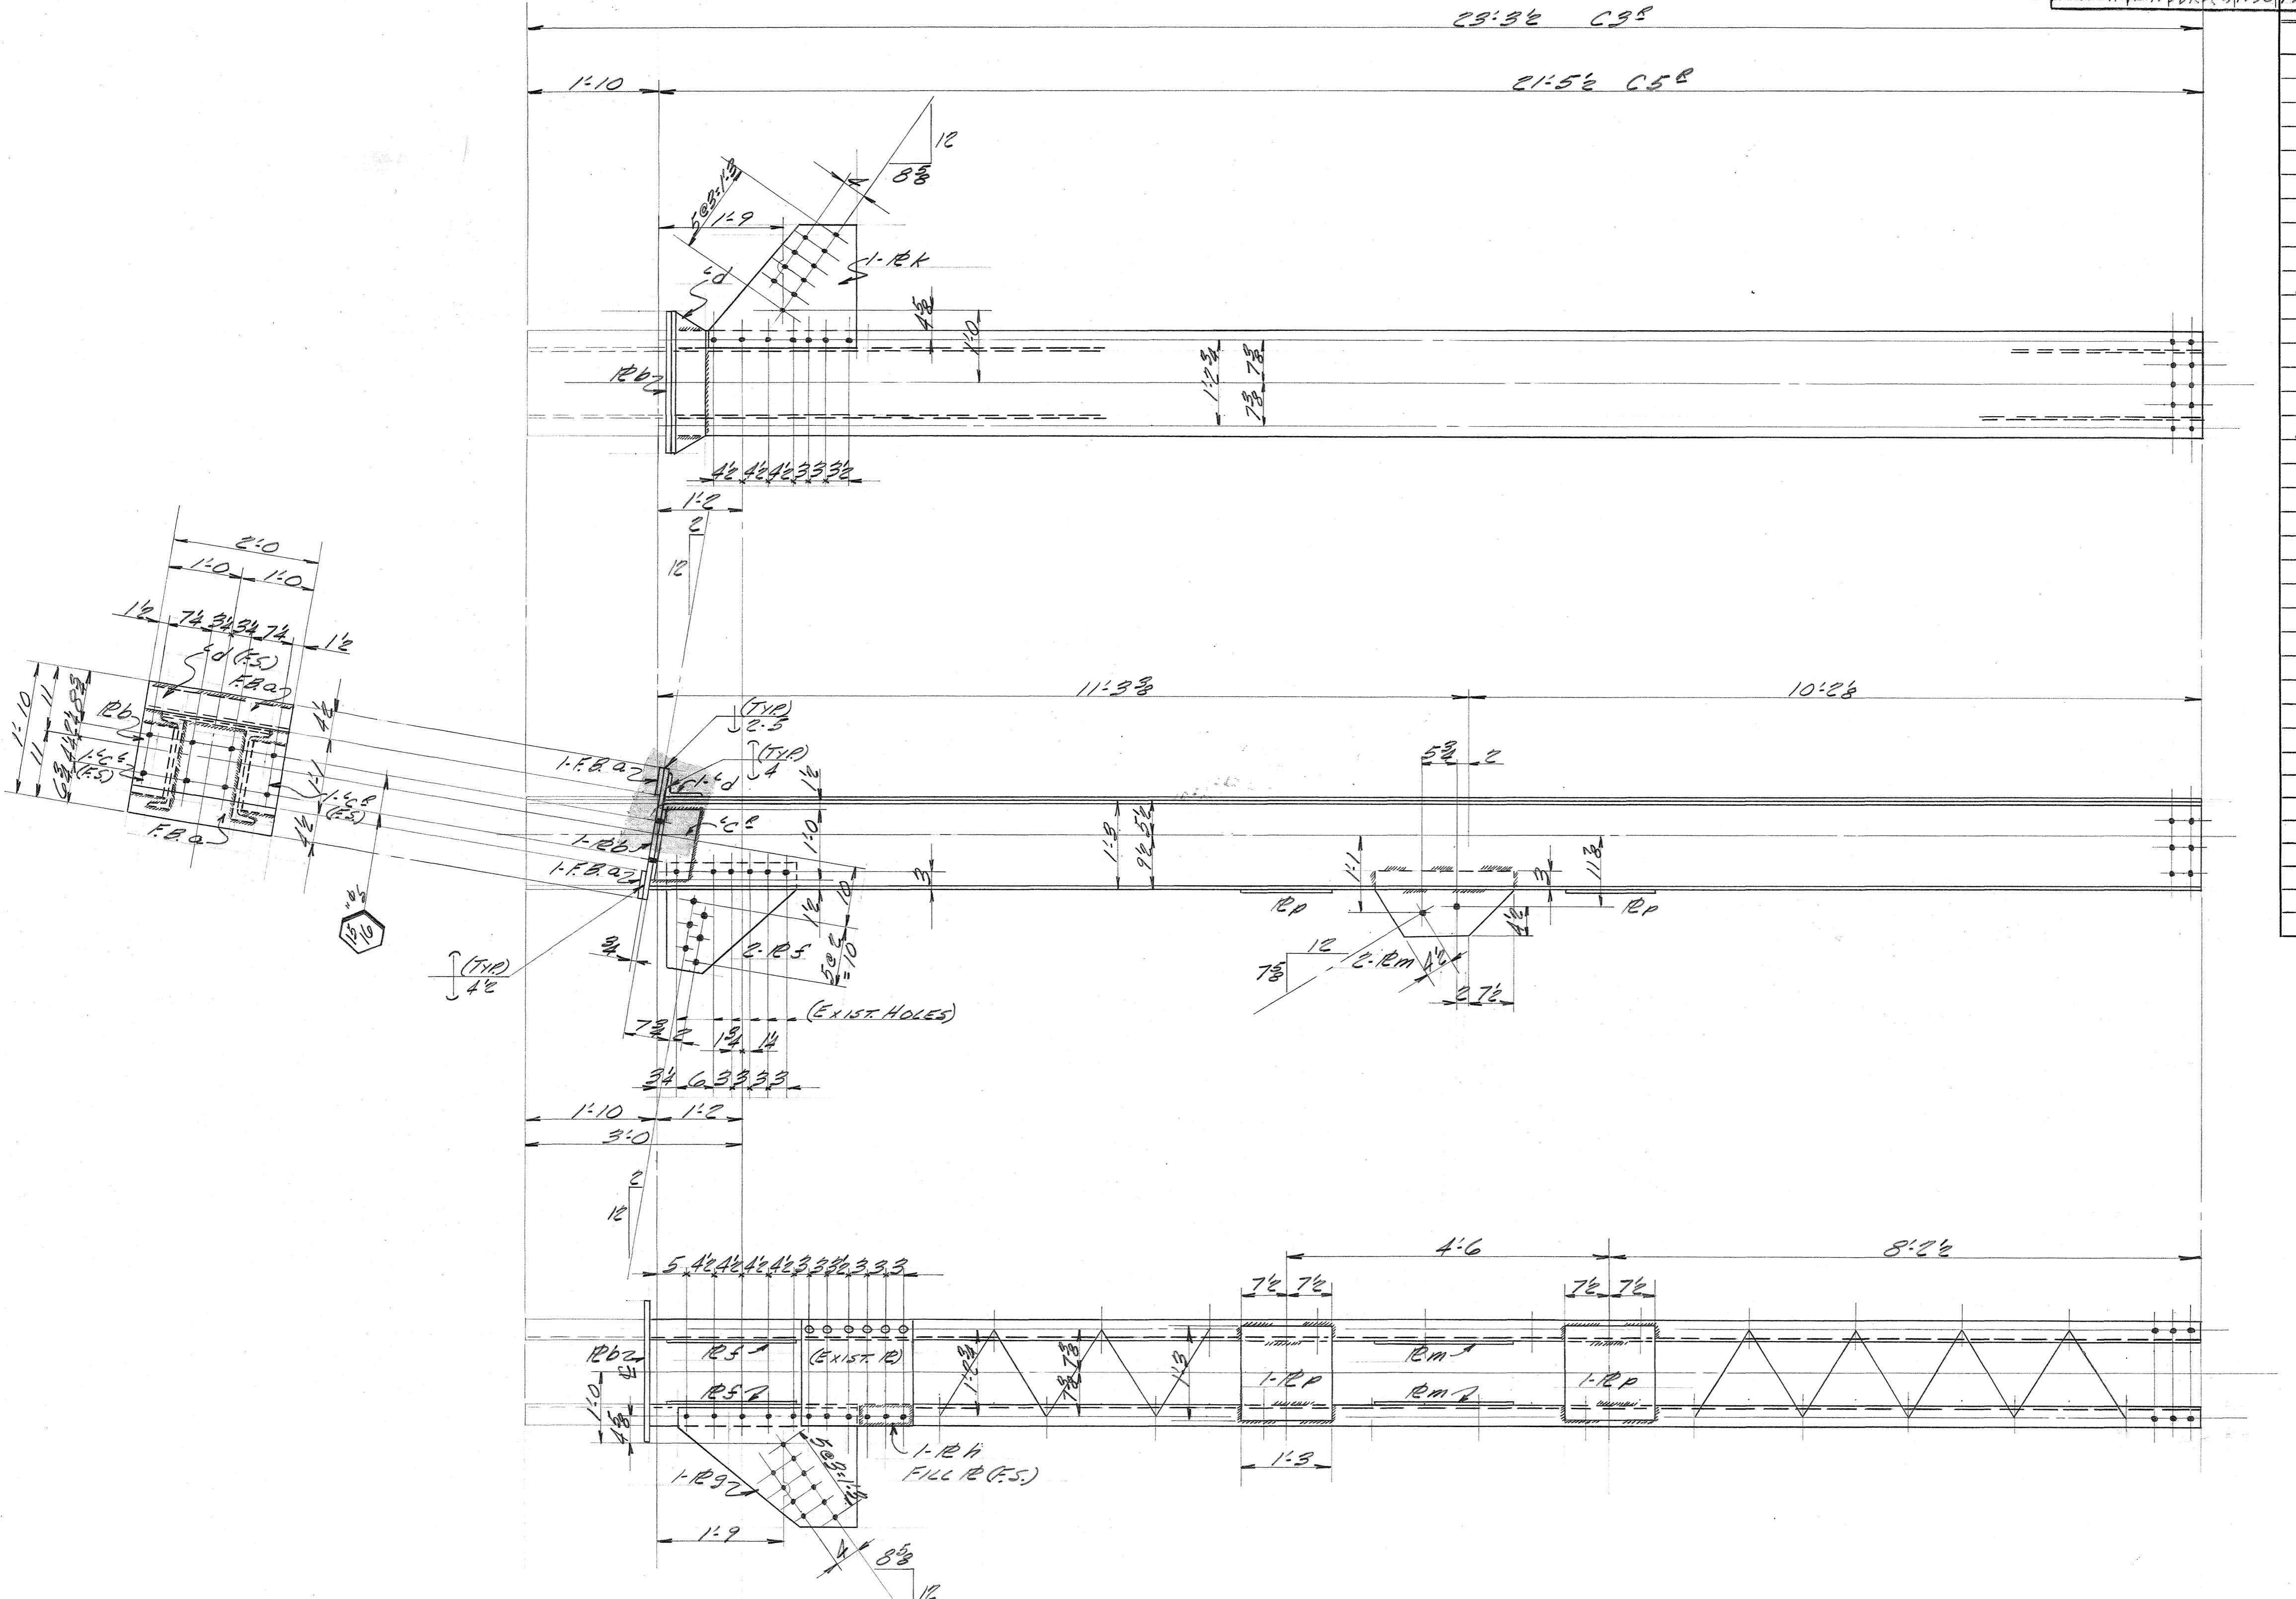FINAL DRAWING

Rivets:  $\frac{3}{8}$ "  
Holes:  $\frac{1}{2}$ "  
Paint: (SEE SPECS)

INDUSTRIAL DEV. CO.  
ADDITION TO THE  
UNAUNUA BRIDGE  
- HAWAII -

INDEPENDENT IRON WORKS, INC.  
OAKLAND, CALIF.

MADE BY 00 10-4-50 ORDER NO. 3807  
CHECKED BY SHEET NO. 0330