



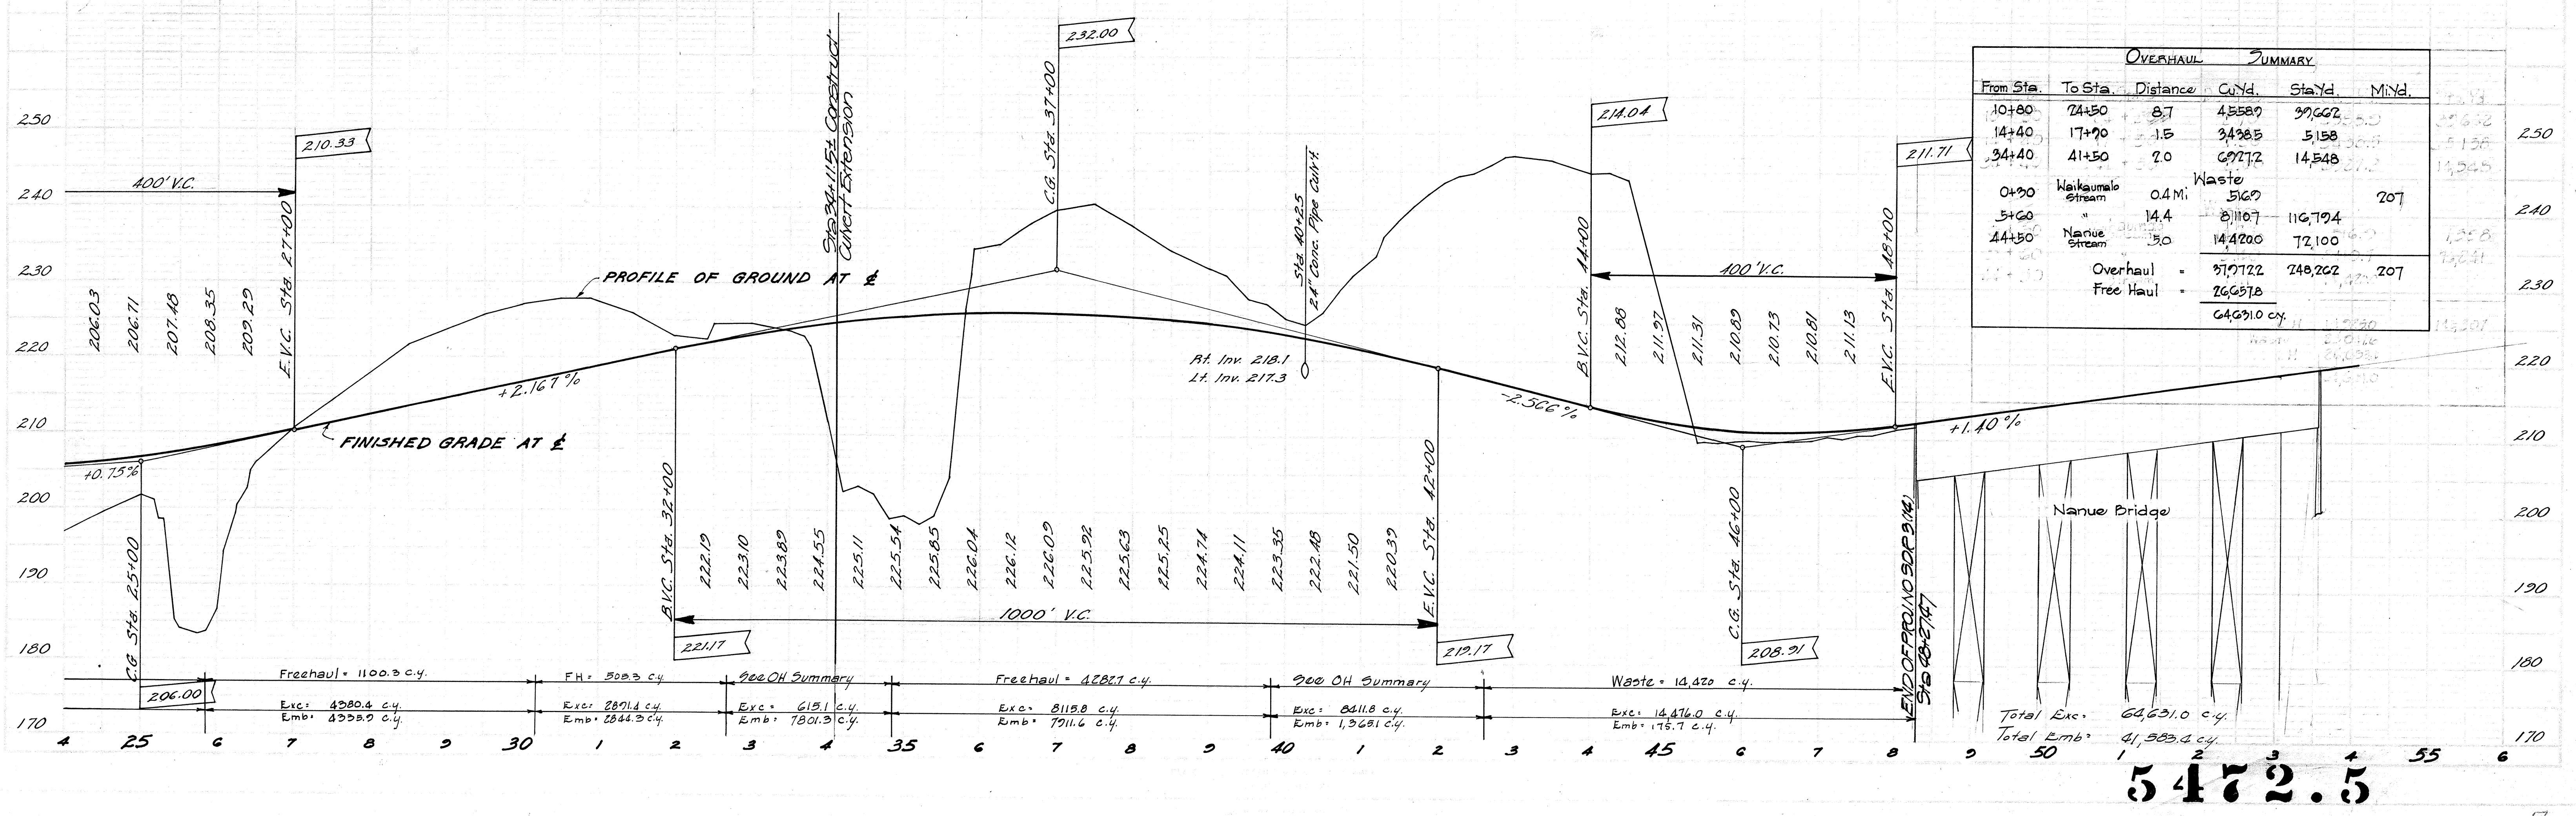

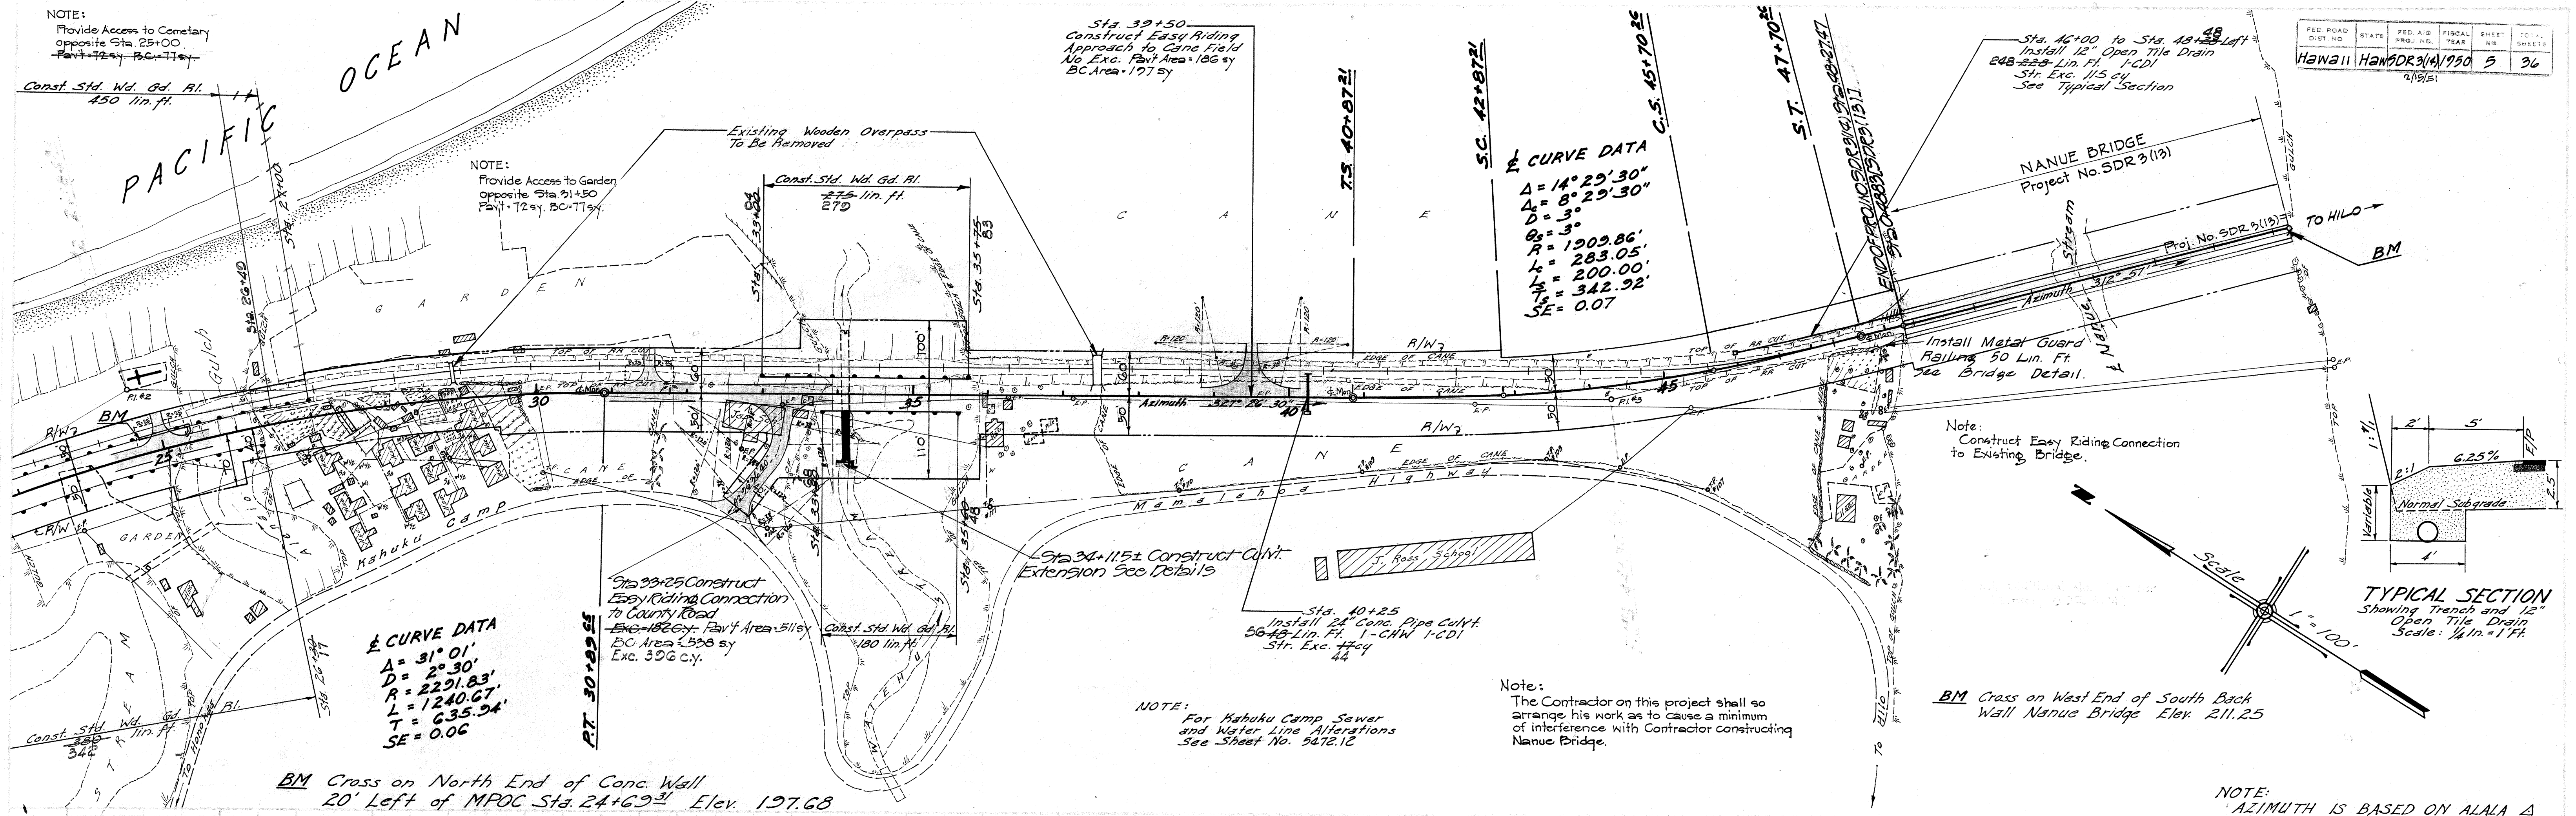

5472.5