

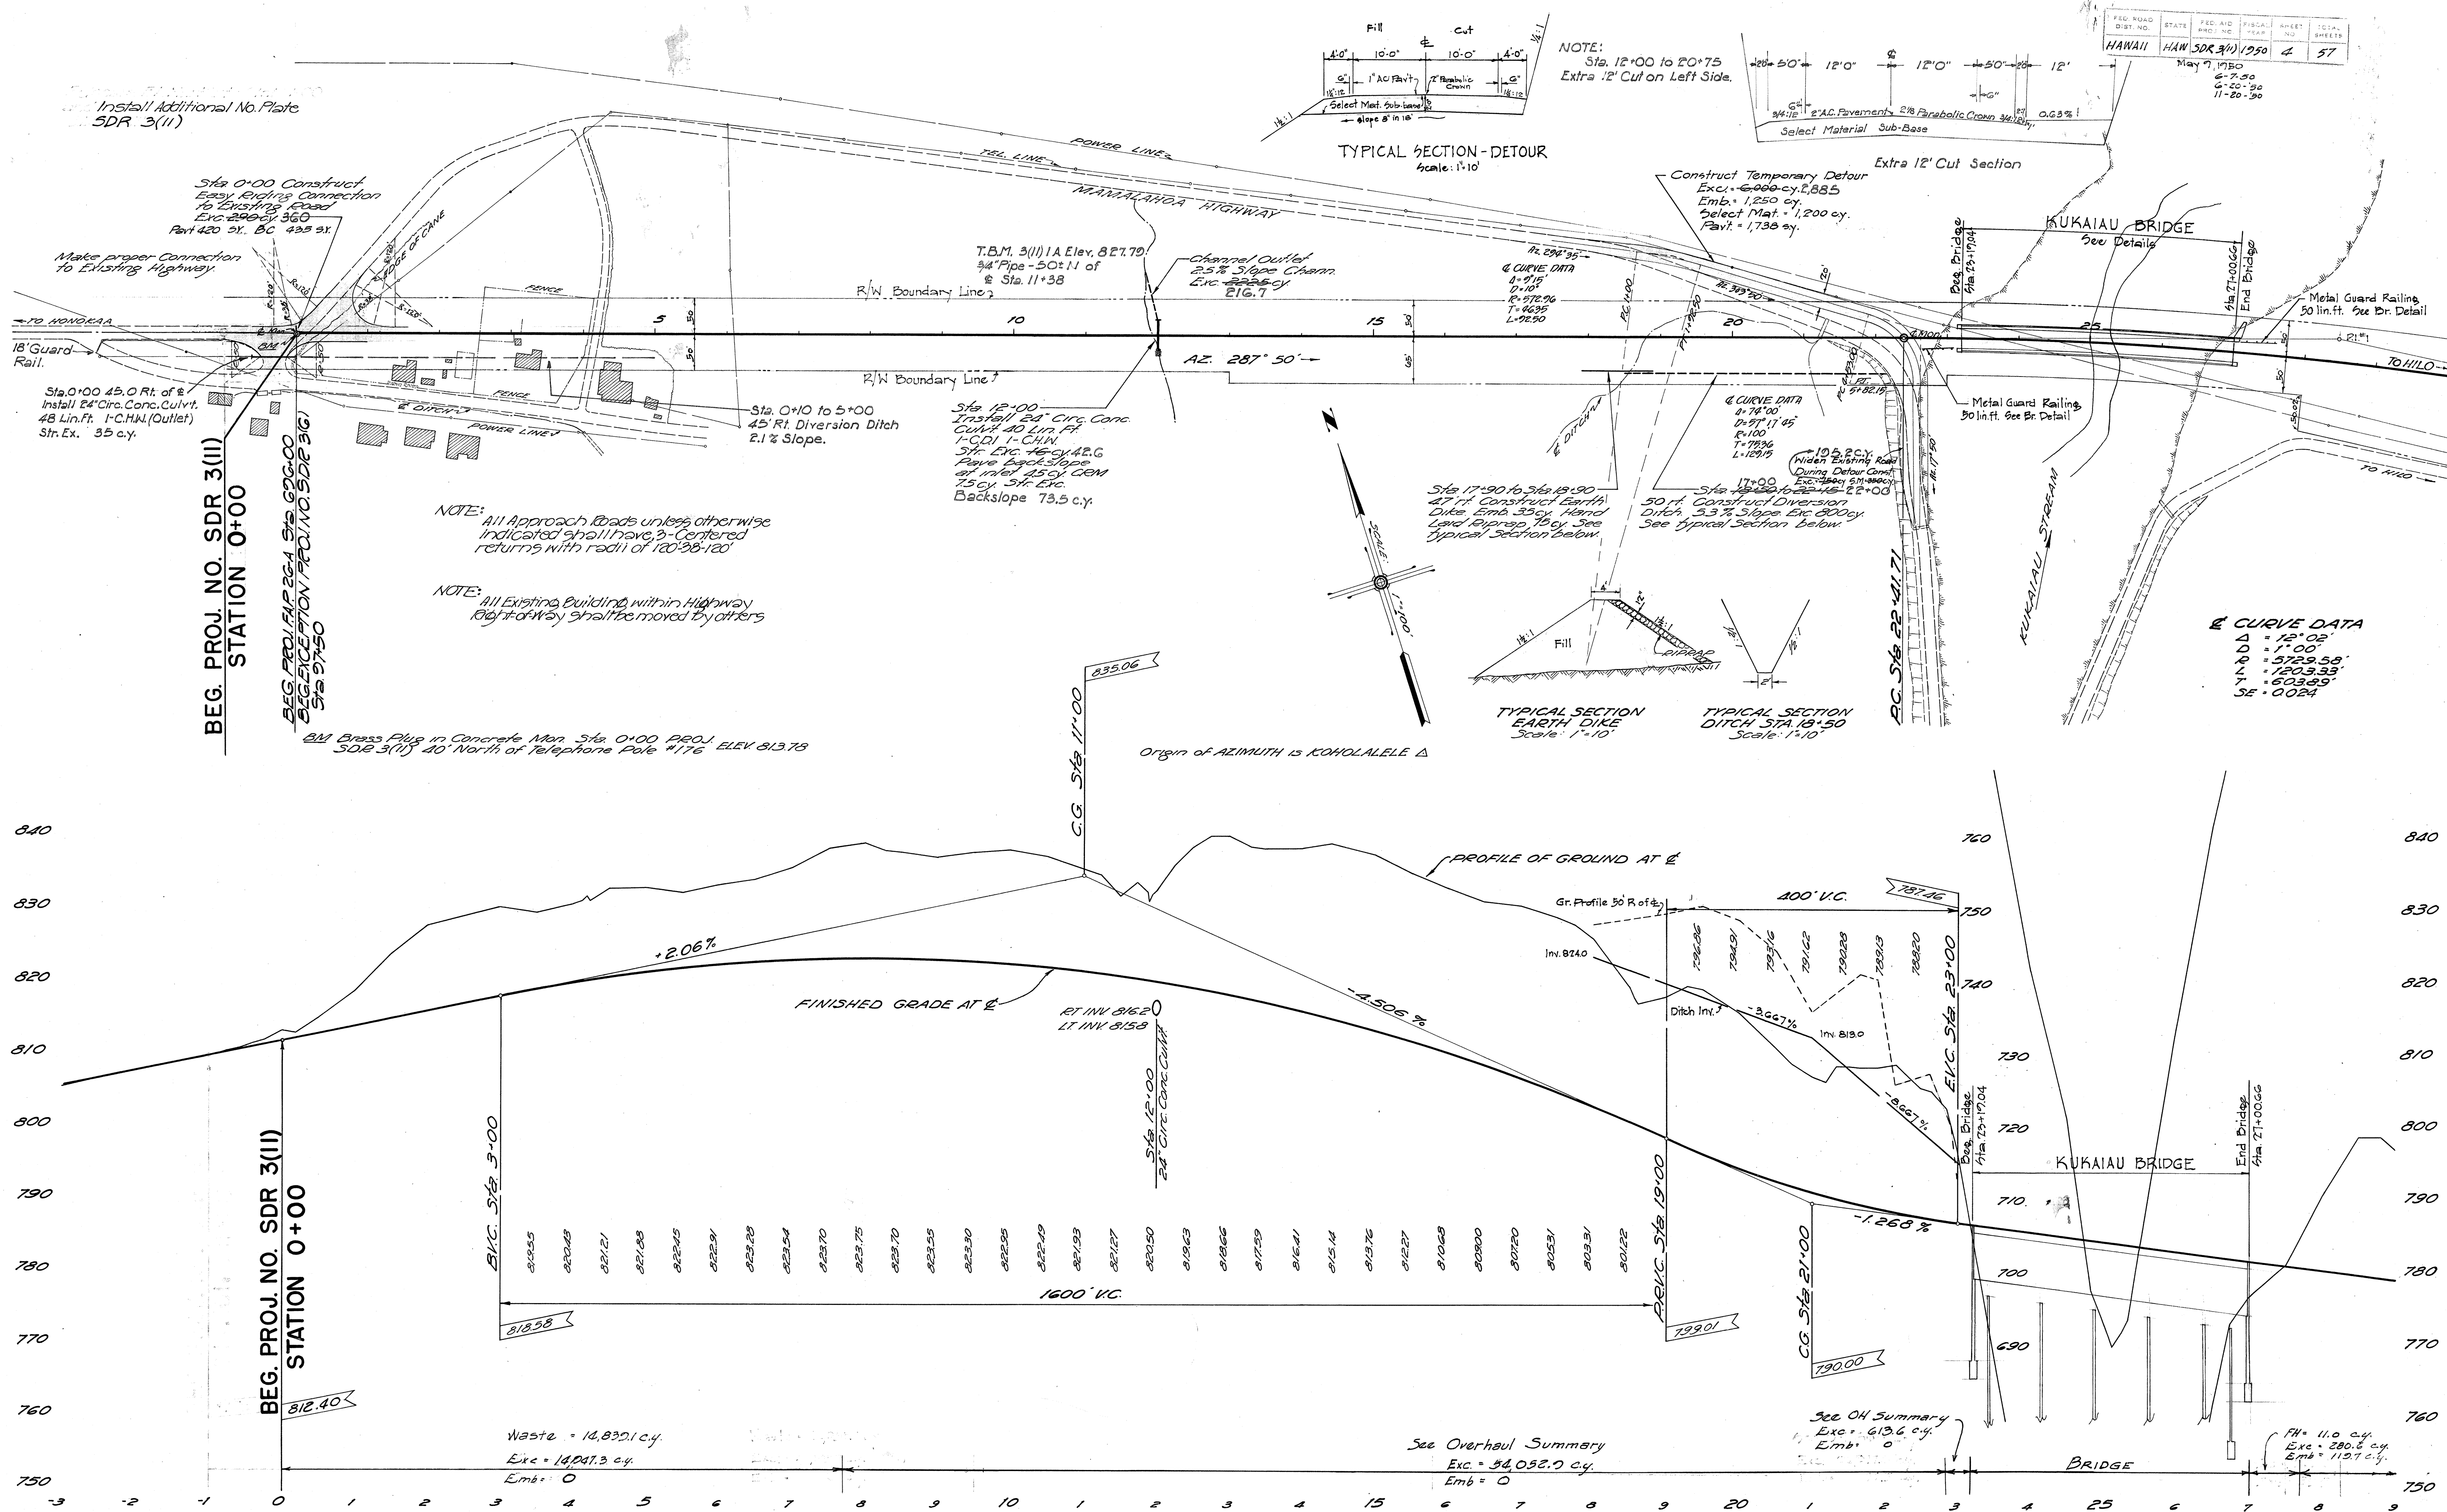


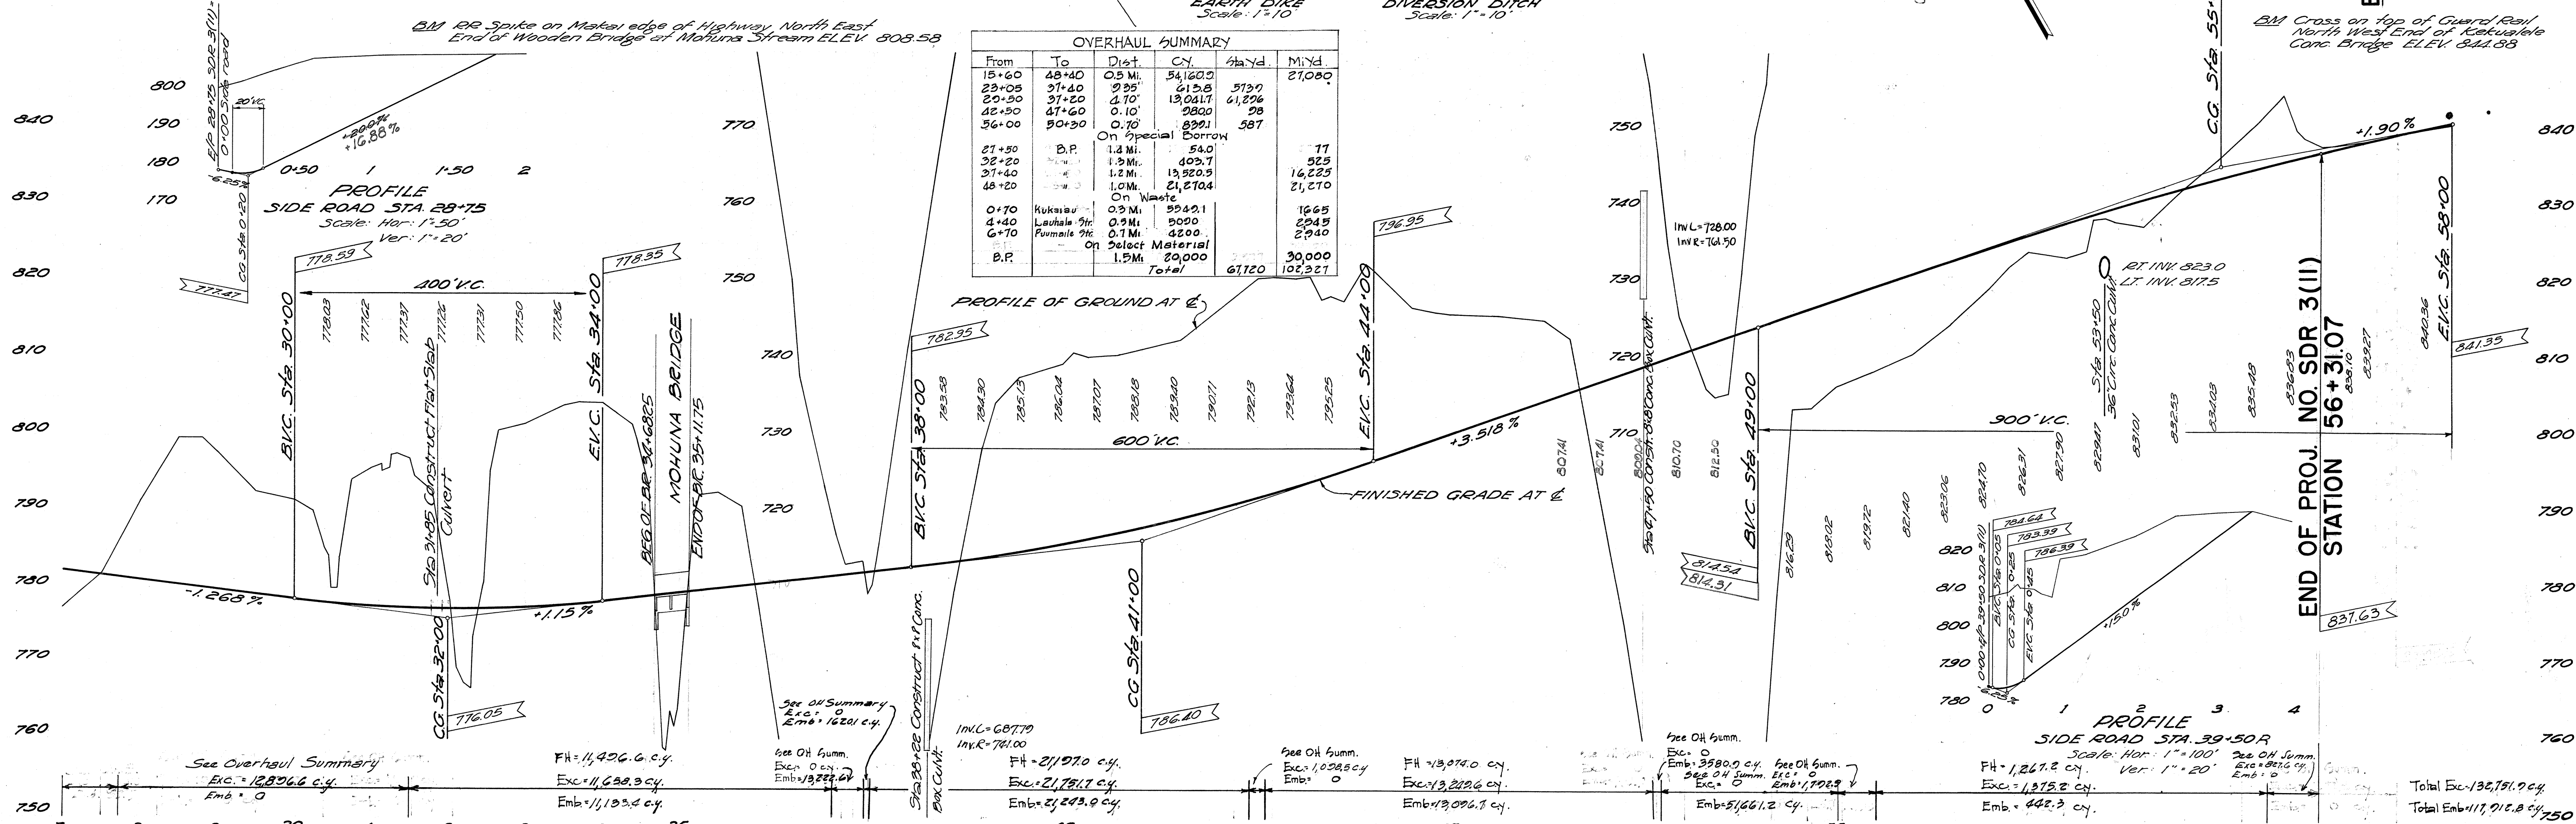

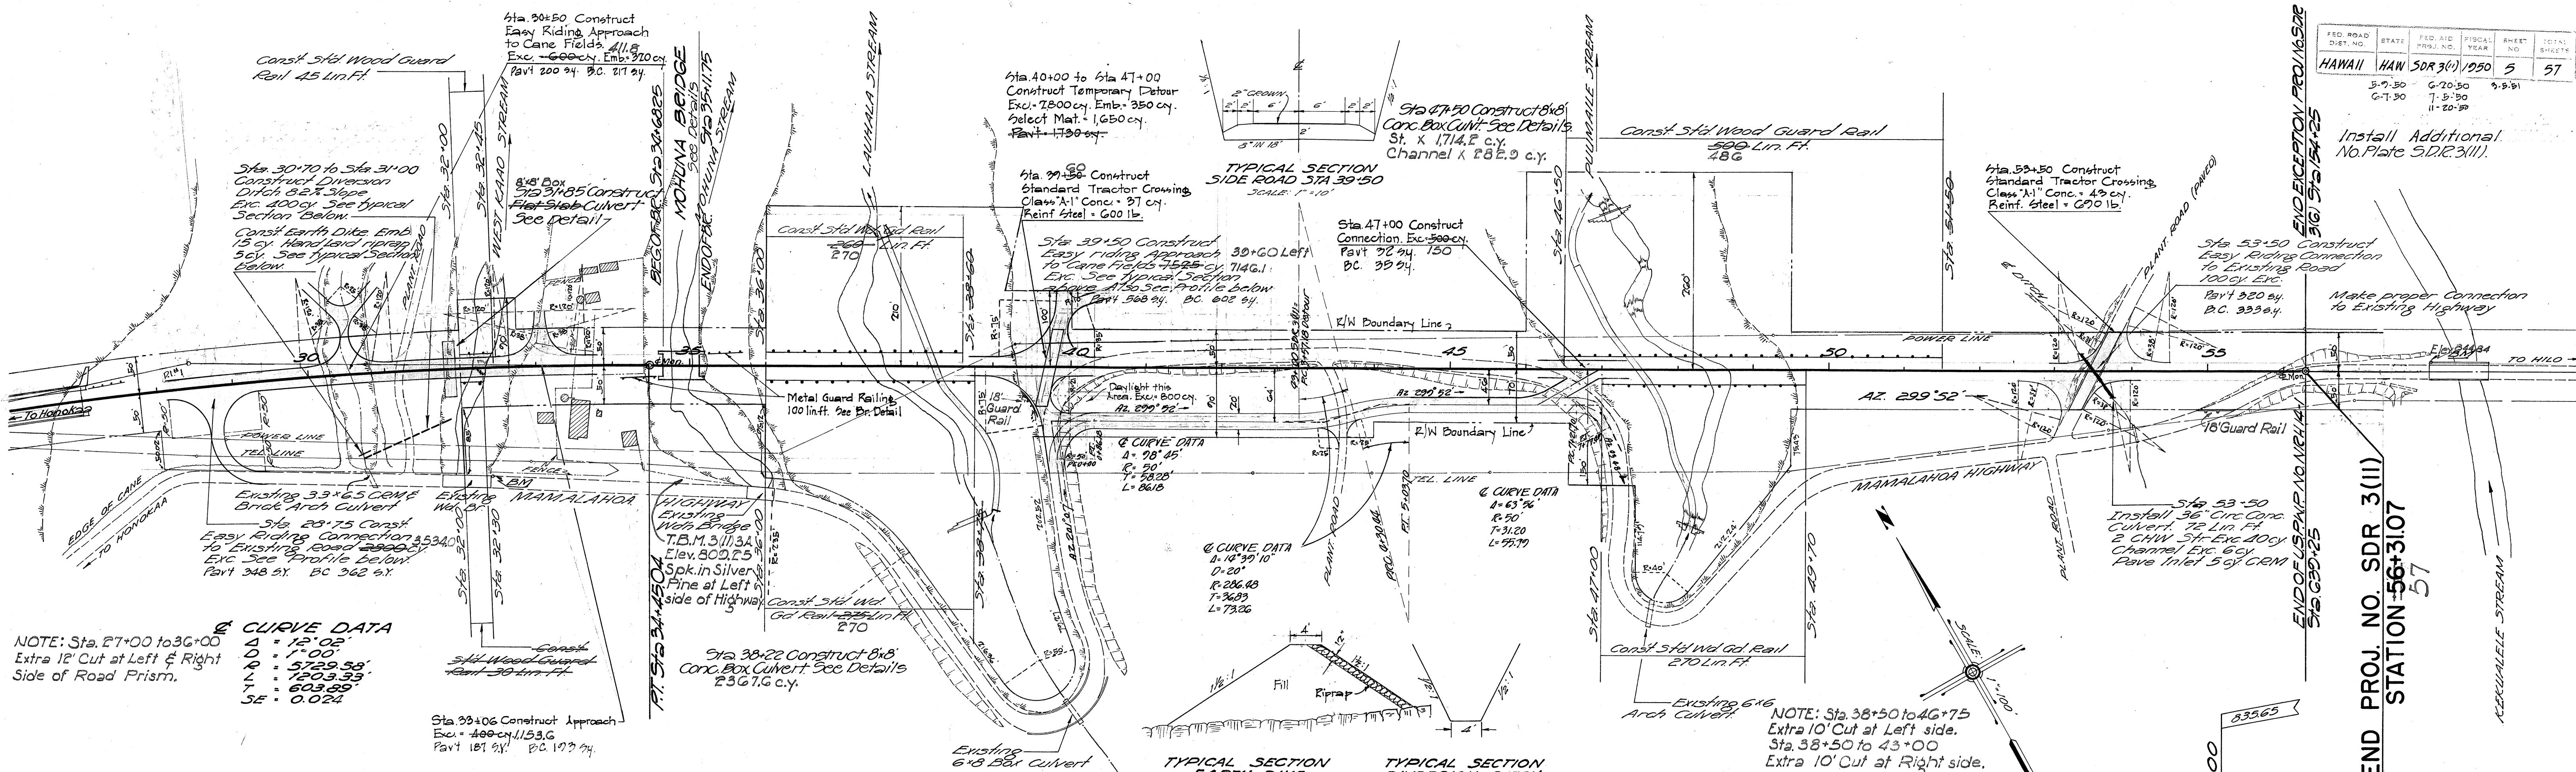

From	To	Dist.	CY	Sta.	M.Yd.
15+60	48+40	0.5 Mi.	54,160.9	513.7	27,080
23+05	31+40	0.25	615.8	513.7	
20+50	37+20	1.70	13,041.7	61,296	
42+50	47+60	0.10	2800	28	
56+00	50+30	0.70	830.1	587	
On Special Borrow					
27+50	B.P.	1.2 Mi.	540	17	
32+20	B.P.	1.2 Mi.	402.7	525	
37+40	B.P.	1.2 Mi.	13,520.9	14,225	
48+20	B.P.	1.0 Mi.	21,270.4	21,270	
On Waste					
0+70	Kukui	0.3 Mi.	3942.1	1665	
4+40	Kukui	0.3 Mi.	5050	2245	
6+70	Kukui	0.1 Mi.	4300	2940	
On Select Material					
B.P.	B.P.	1.5 Mi.	20,000	30,000	
Total					
			67,120	102,327	

5426.5