


6-7:50

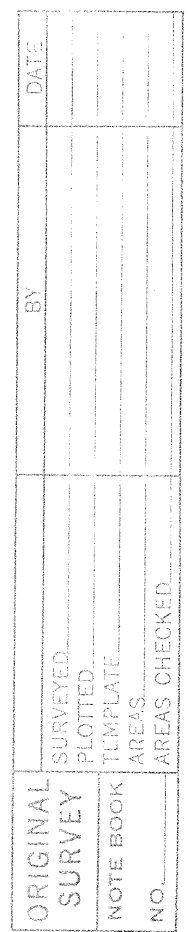

BORINGS BY - R. AHSING

5426.6