
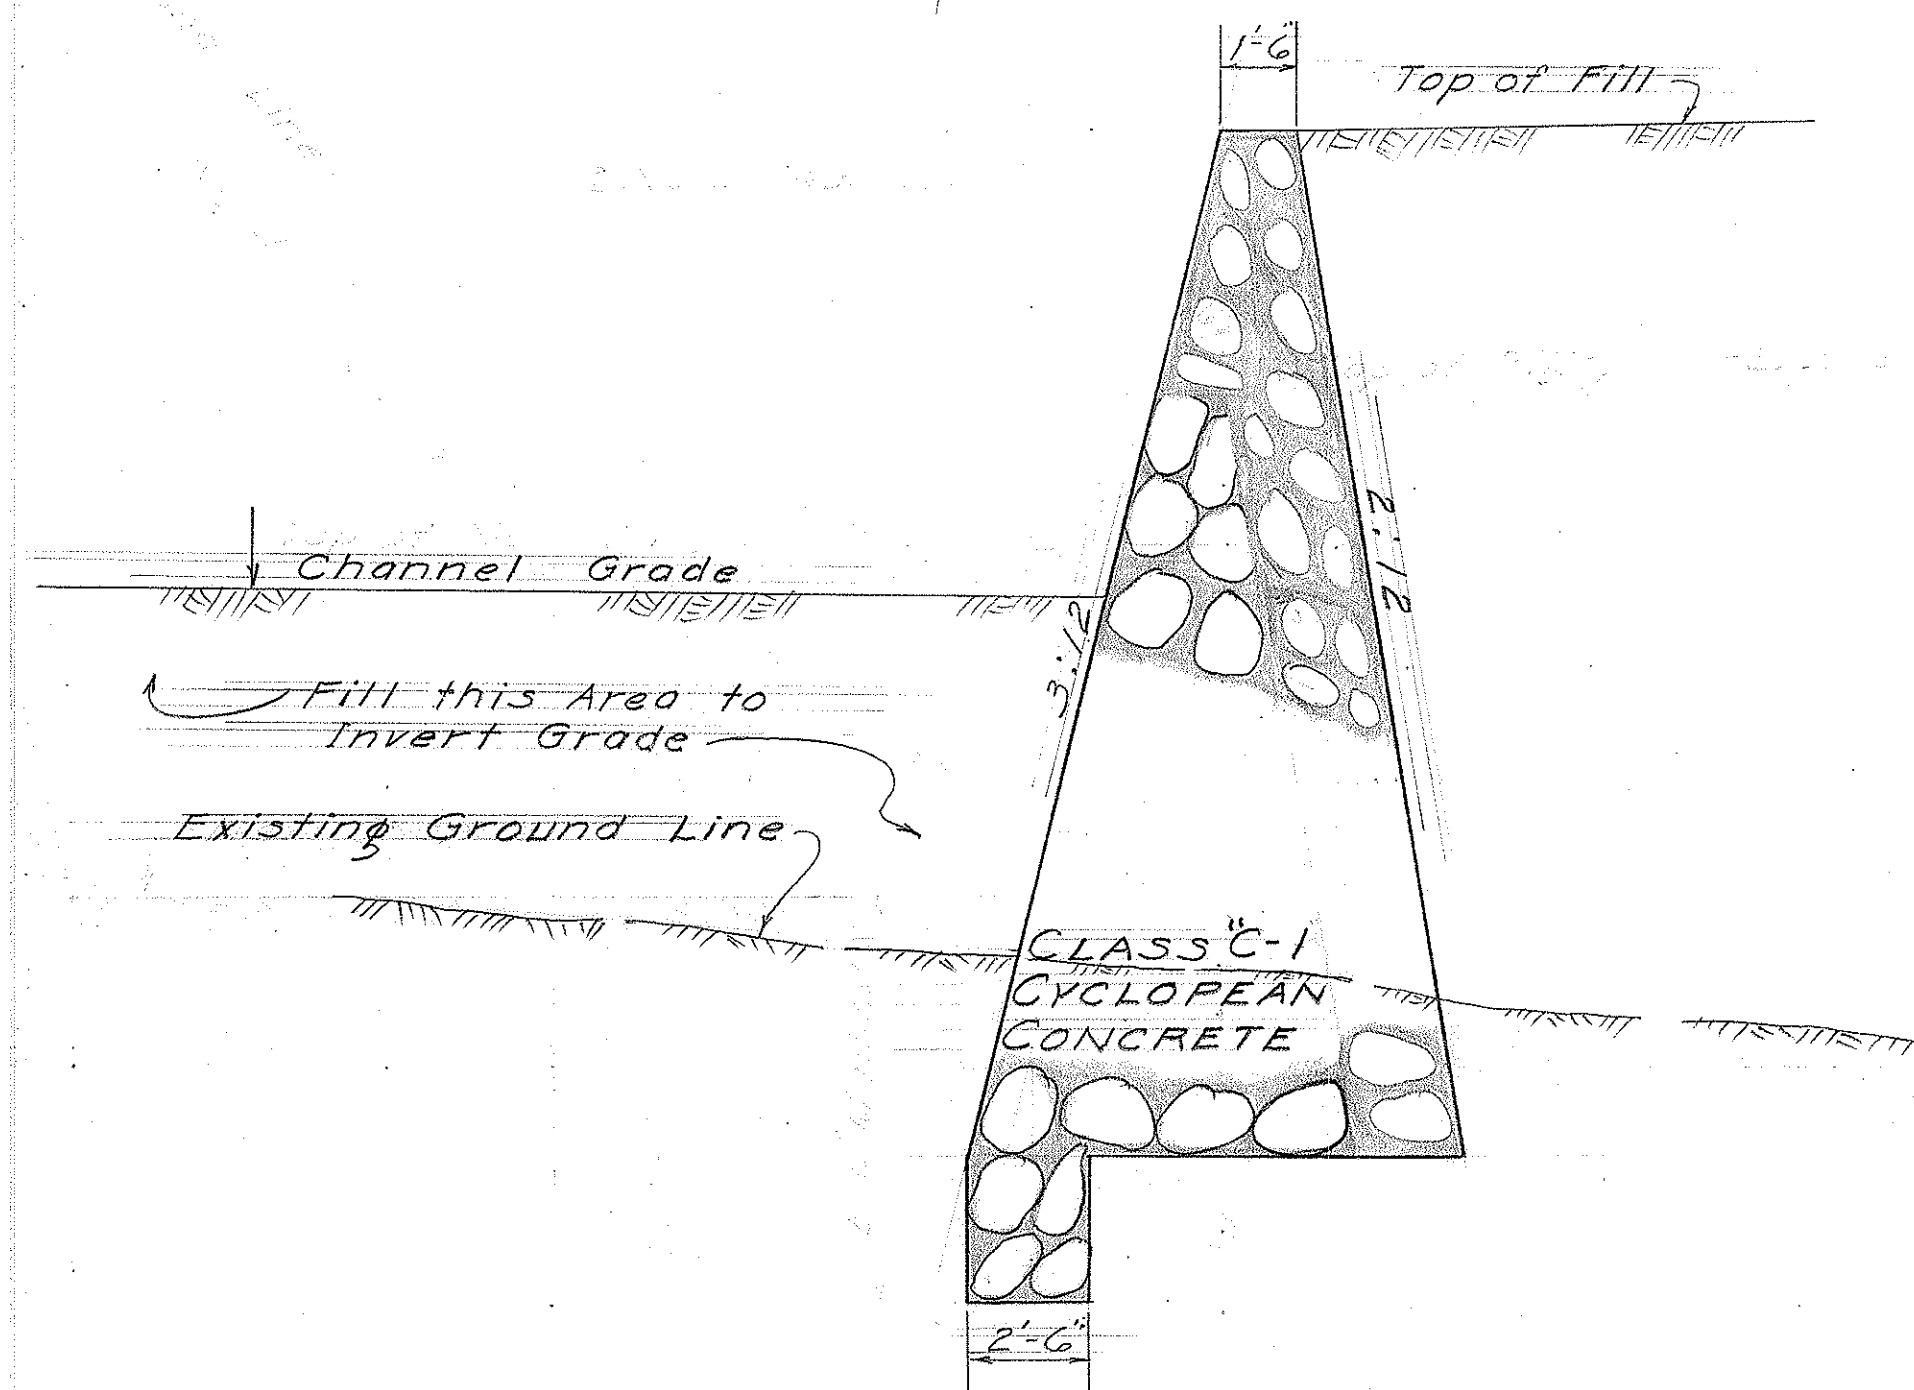
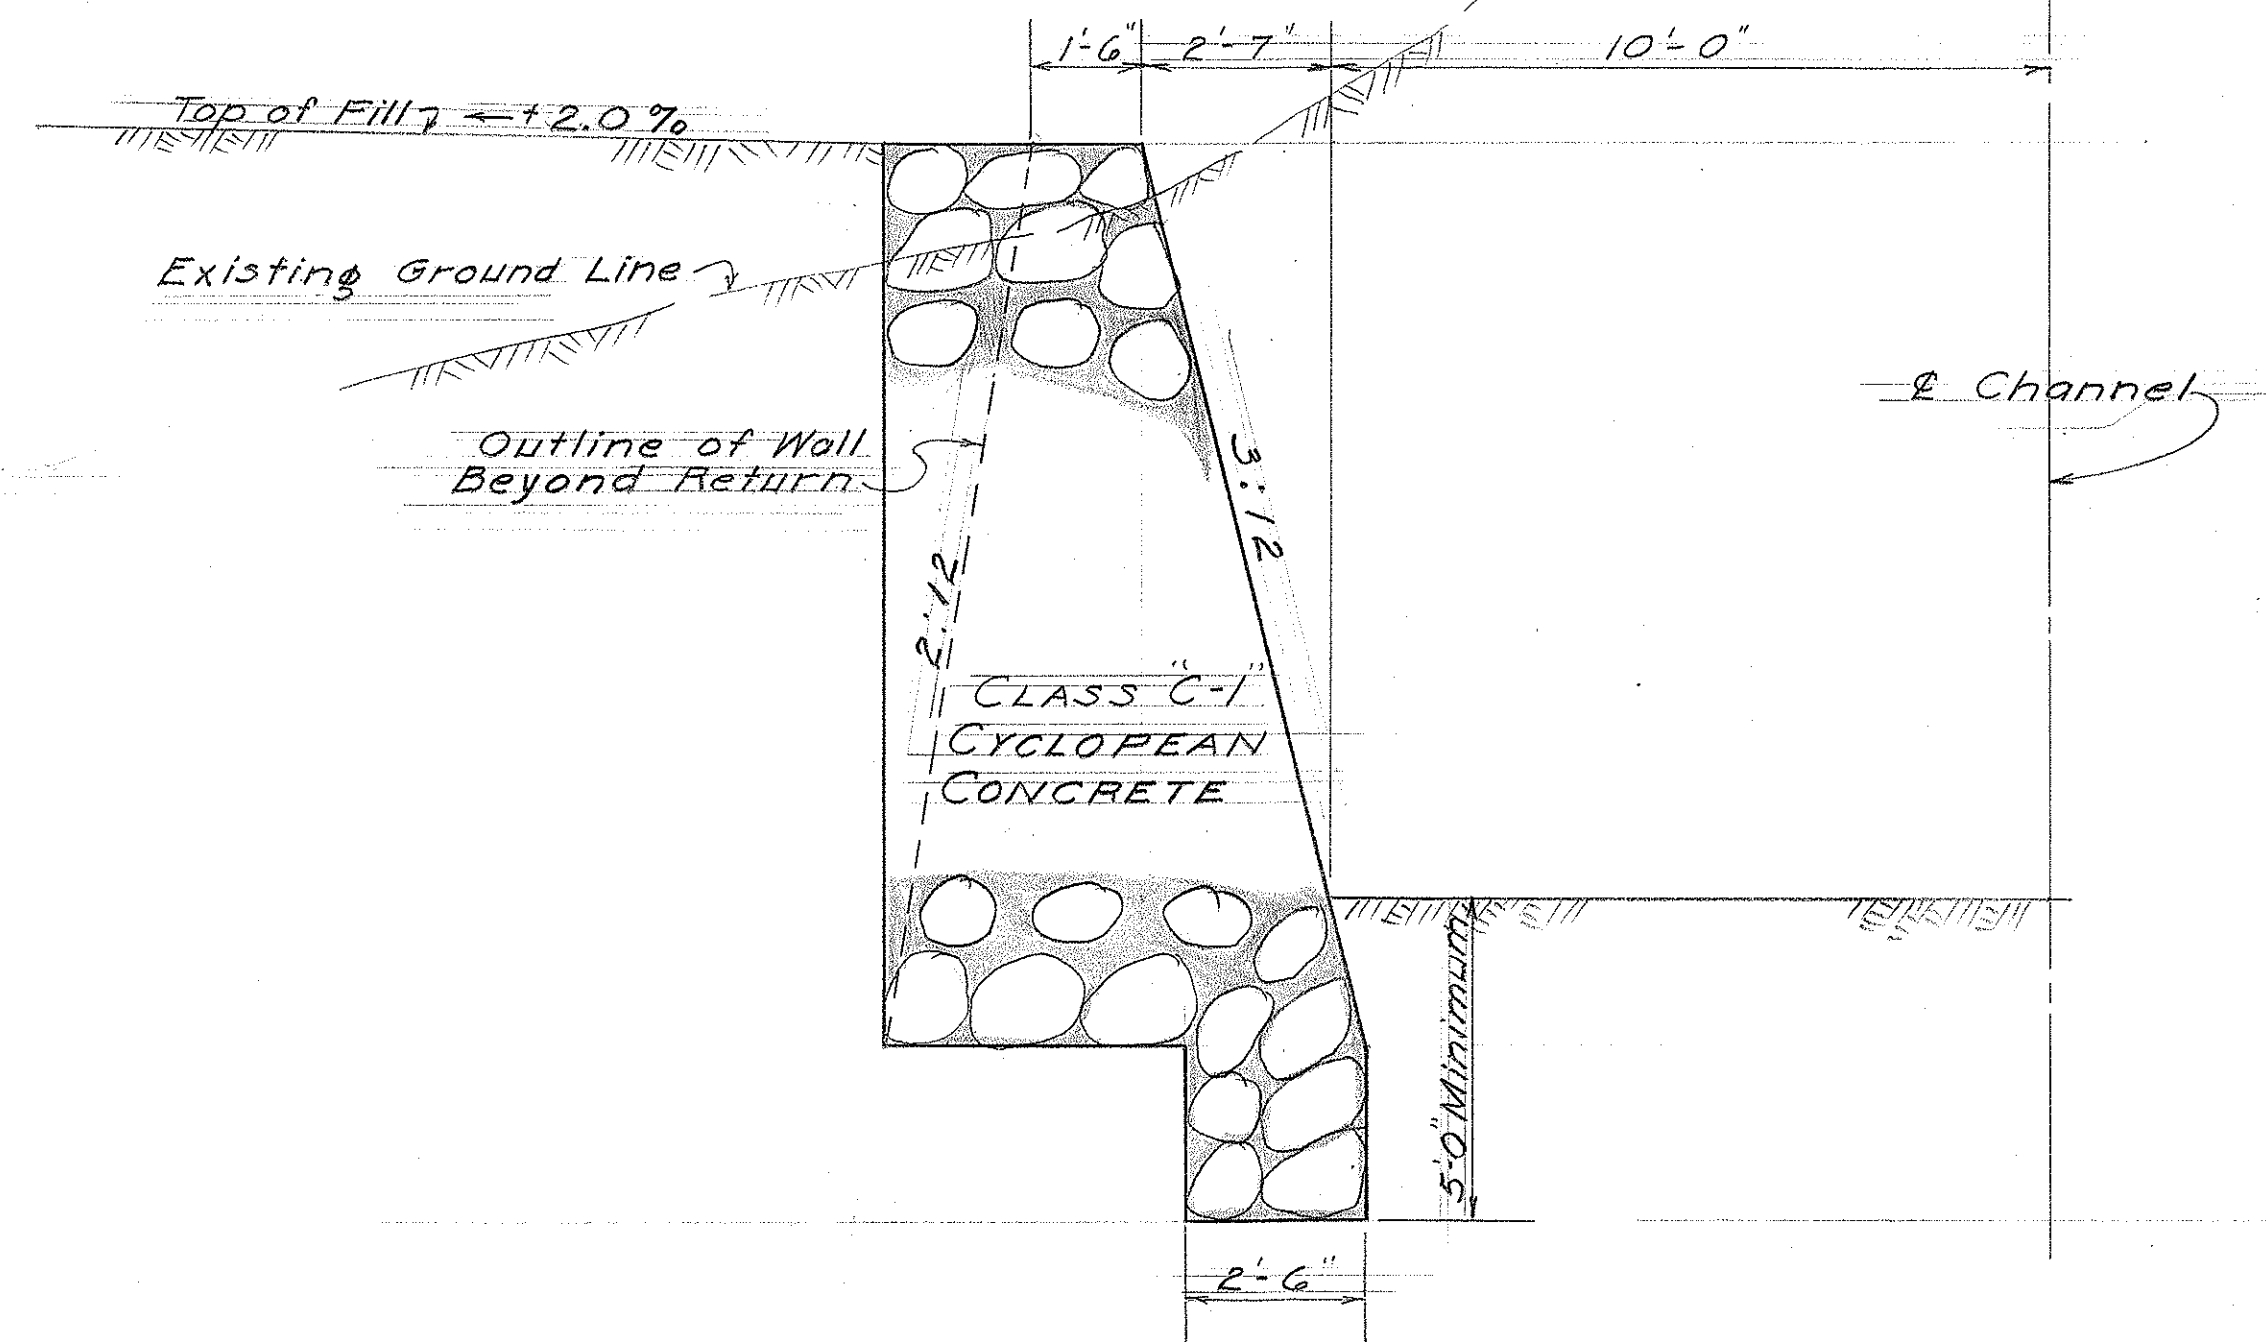
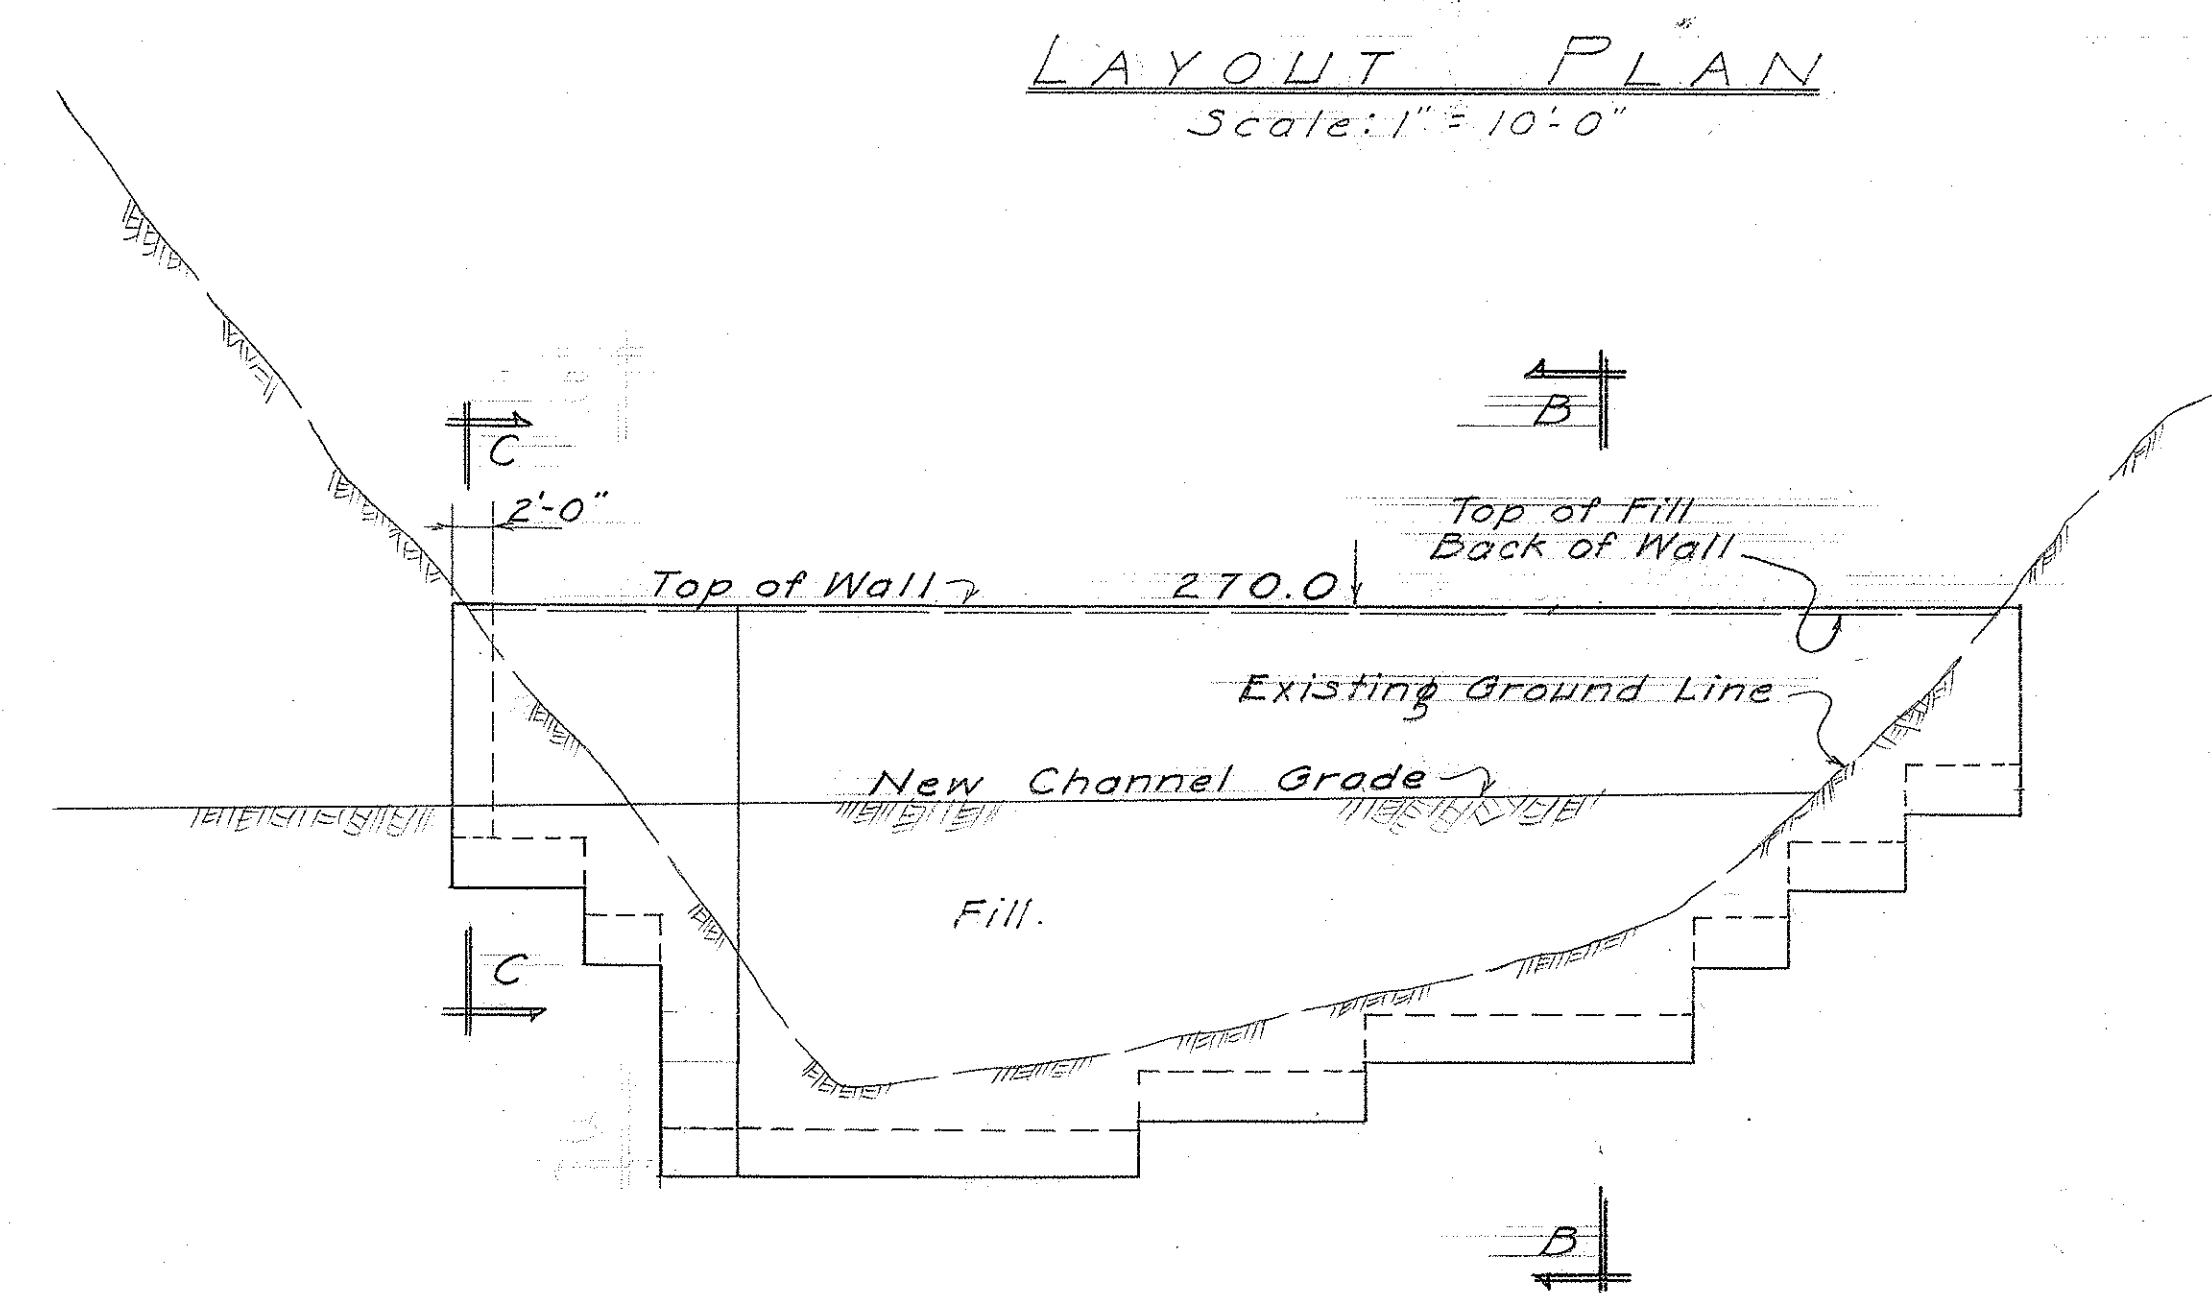


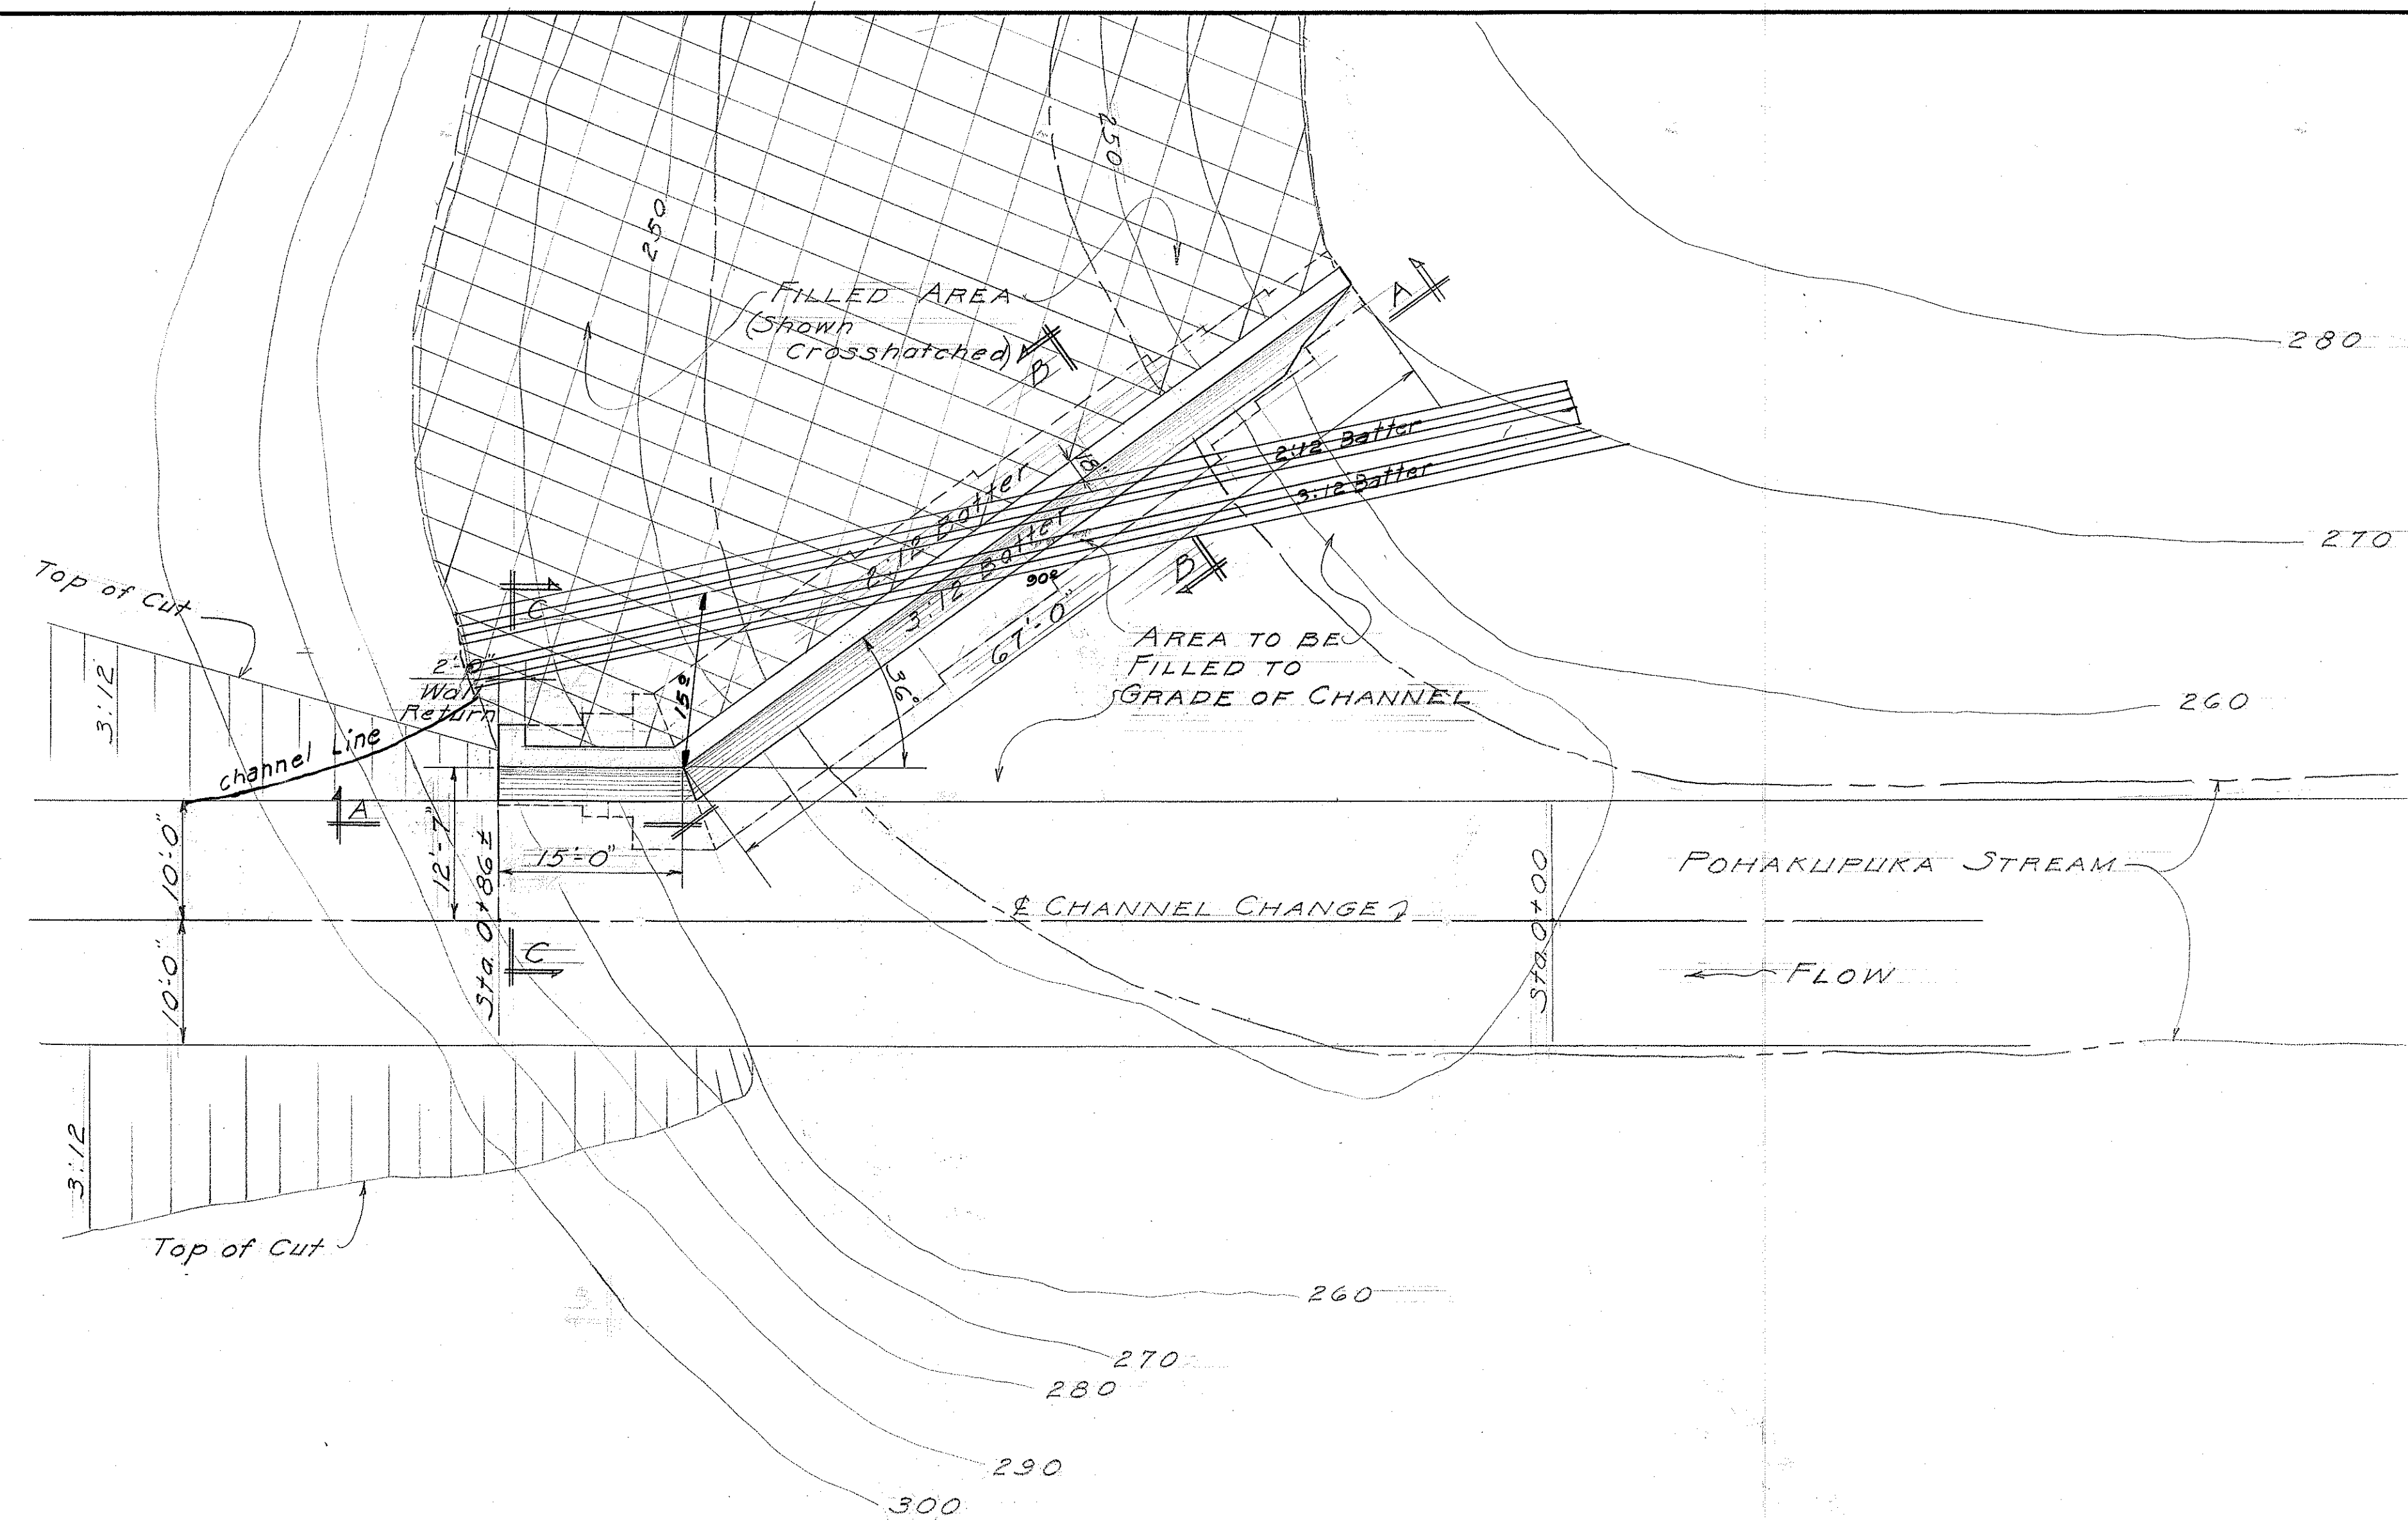

ESTIMATED QUANTITIES	
ITEM	QUAN.
CLASS C-1 CYCLOPEAN CONC.	407 CY
STRUCTURE EXCAVATION	209 CY
	458

TERRITORIAL HIGHWAY DEPARTMENT
TERRITORY OF HAWAII
CHANNEL CHANGE
POHAKUPUKA STREAM
HAWAII BELT ROAD SDR3(16)
MARCH 1951
SHEET No. / OF / SHEETS

5509.25

SURVEY PLOTTED BY	DATE
DESIGNED BY	3-5
DRAWN BY	W. K. K.
CHECKED BY	W. K. K.
NOTE BOOK	No.