
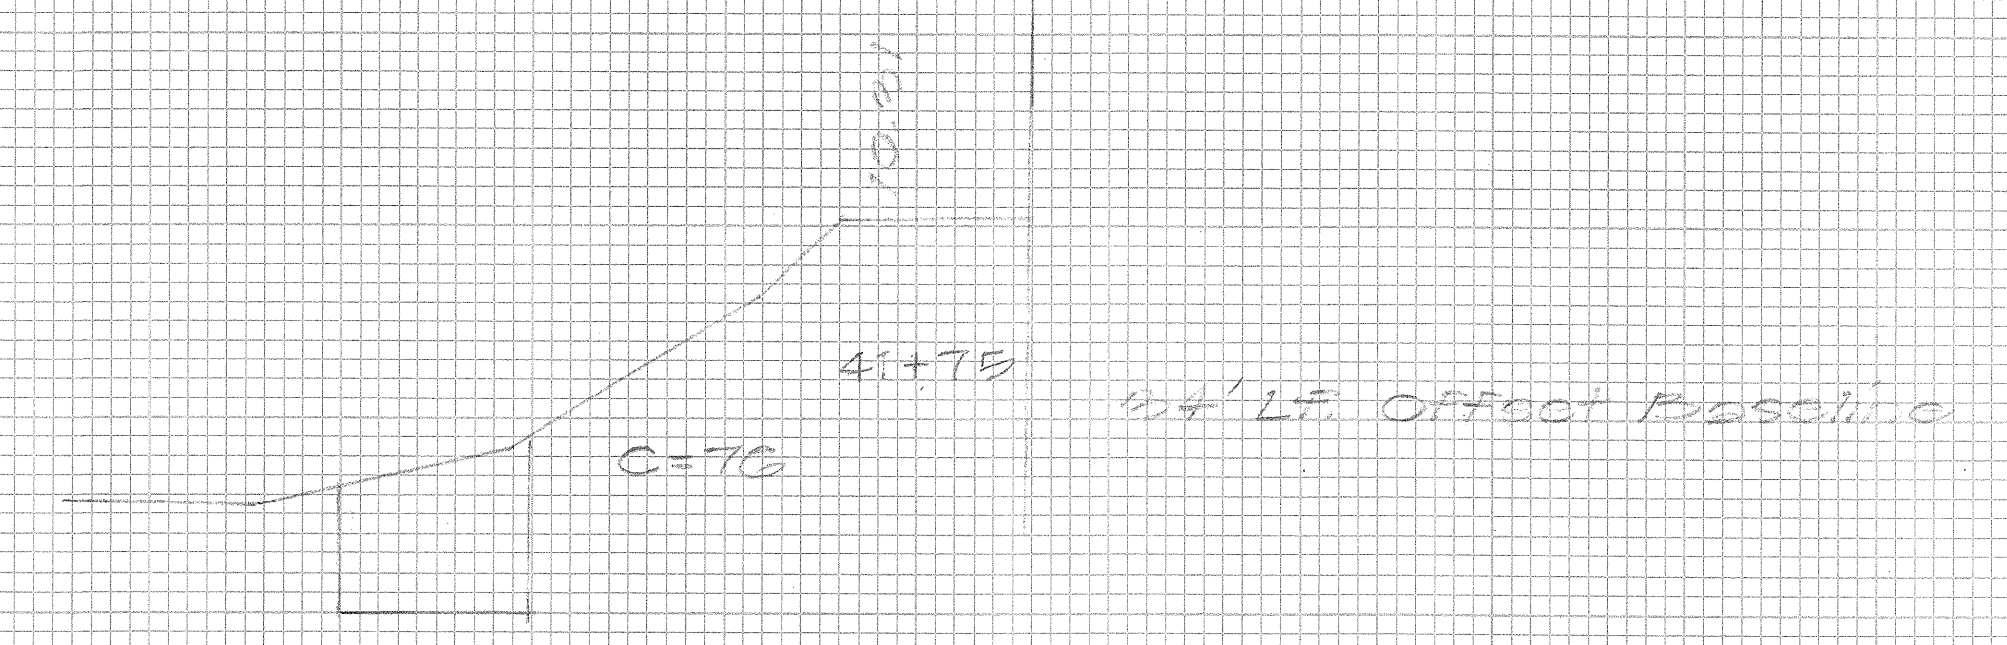


Rev. 8/29/52

DATE	BY
FINAL SURVEY	
NOTE BOOK	
NO.	

DATE	BY
ORIGINAL SURVEY	
NOTE BOOK	
NO.	

NOTE: Sta. 41+75 to Sta. 46+75 excavated 2 ft. below plan grade

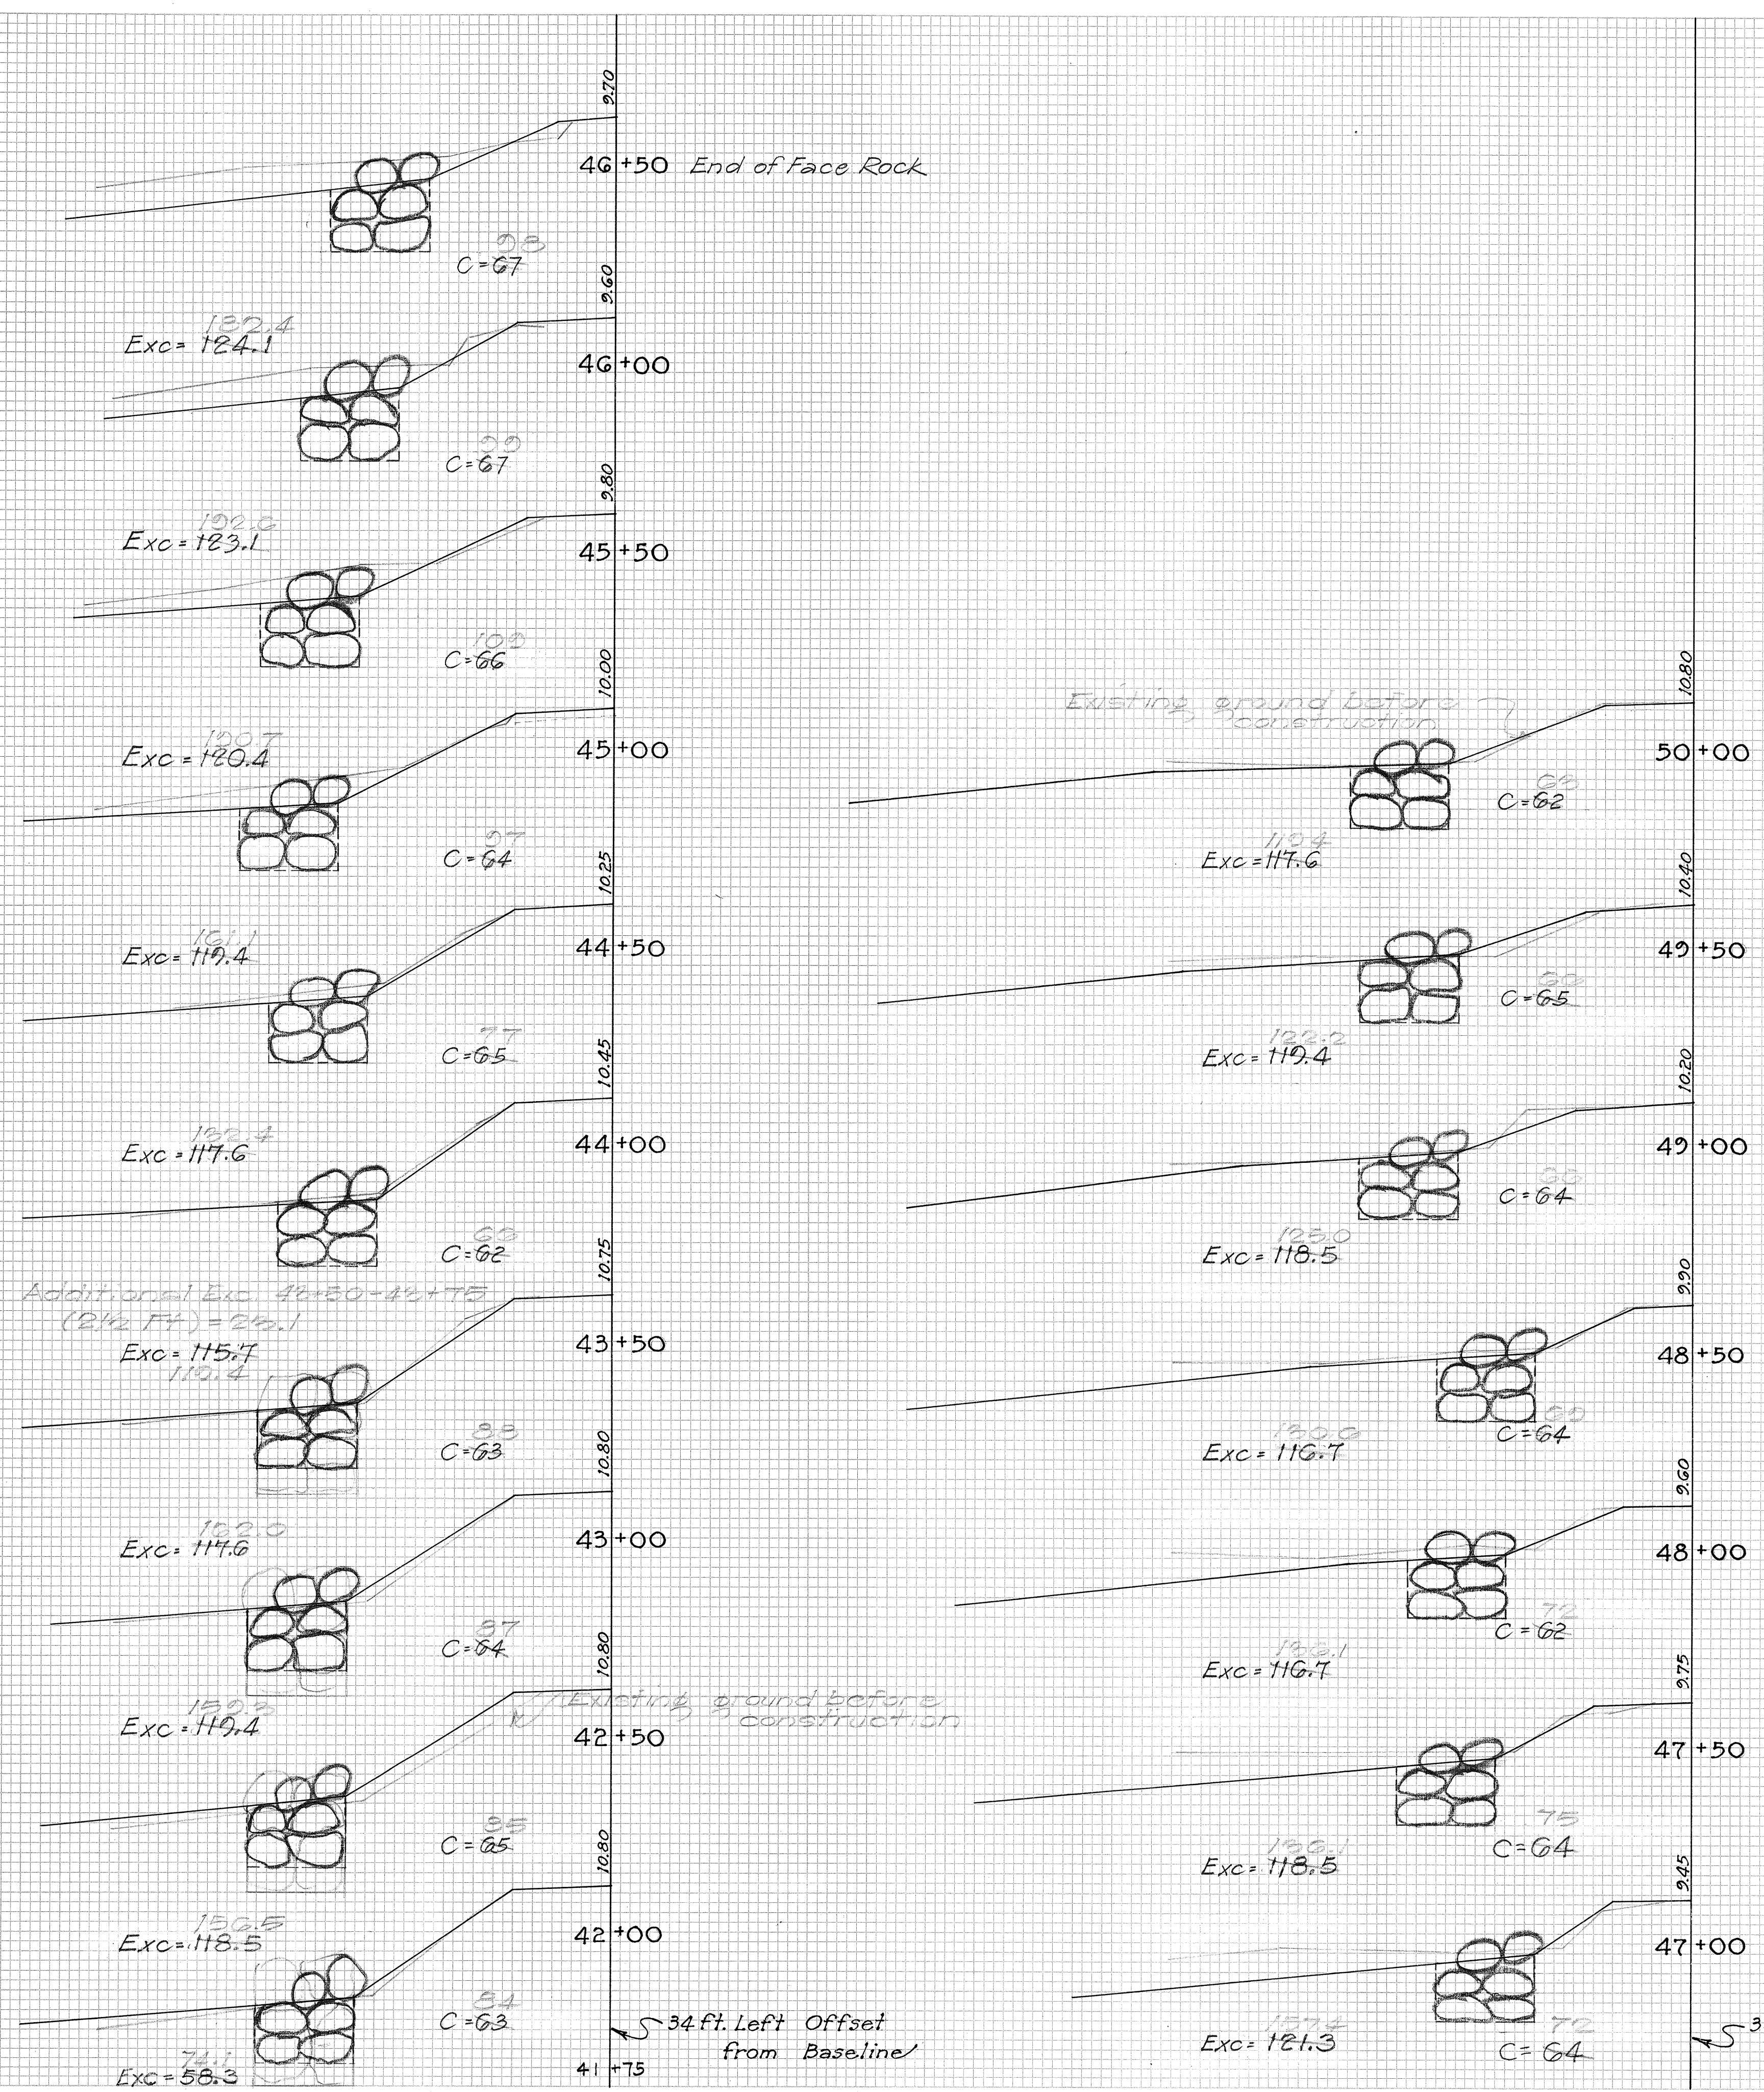

ESTIMATED QUANTITIES
 STRUCT. EXC. = 1,960 cu. yds.
 5 TON ROCK = 7,100 tons @ 1.5 cu. yds. per ton