
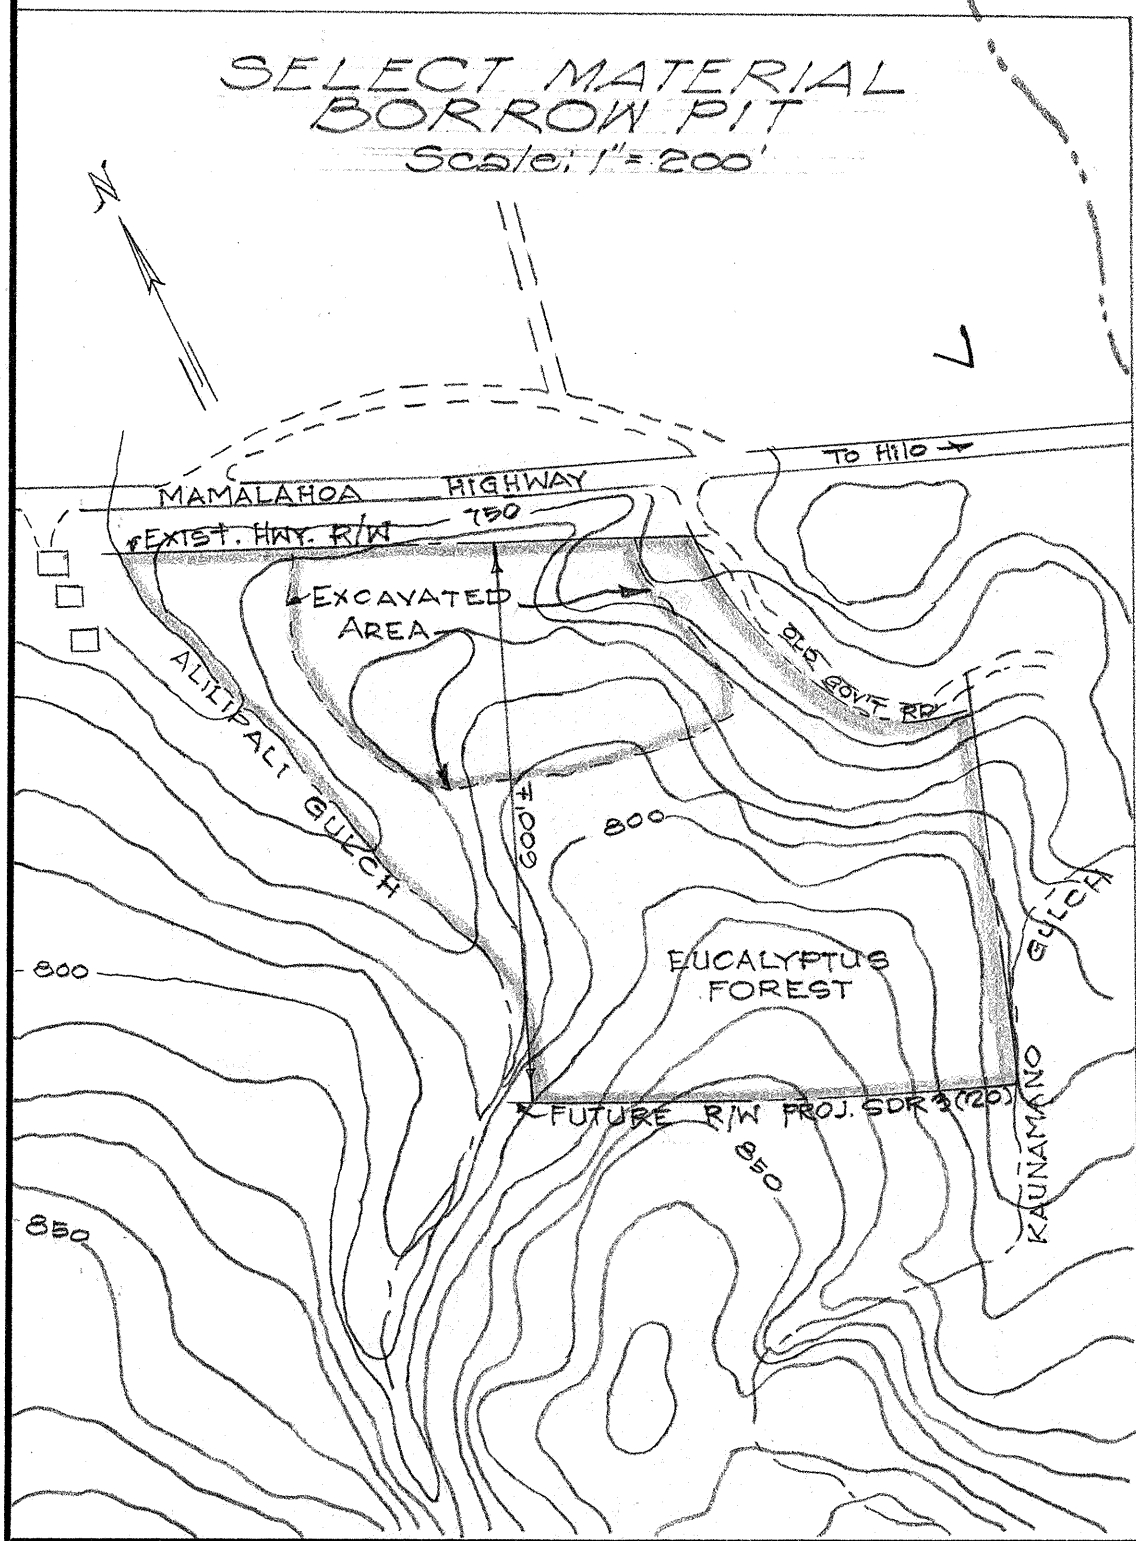


| FED. ROAD DIST. NO. | STATE | FED. AID PROJ. NO. | FISCAL YEAR | SHEET NO. | TOTAL SHEETS |
|---------------------|-------|--------------------|-------------|-----------|--------------|
| HAWAII              | HAW   | SDR 3(7)           | 1952        | 3         | 30           |

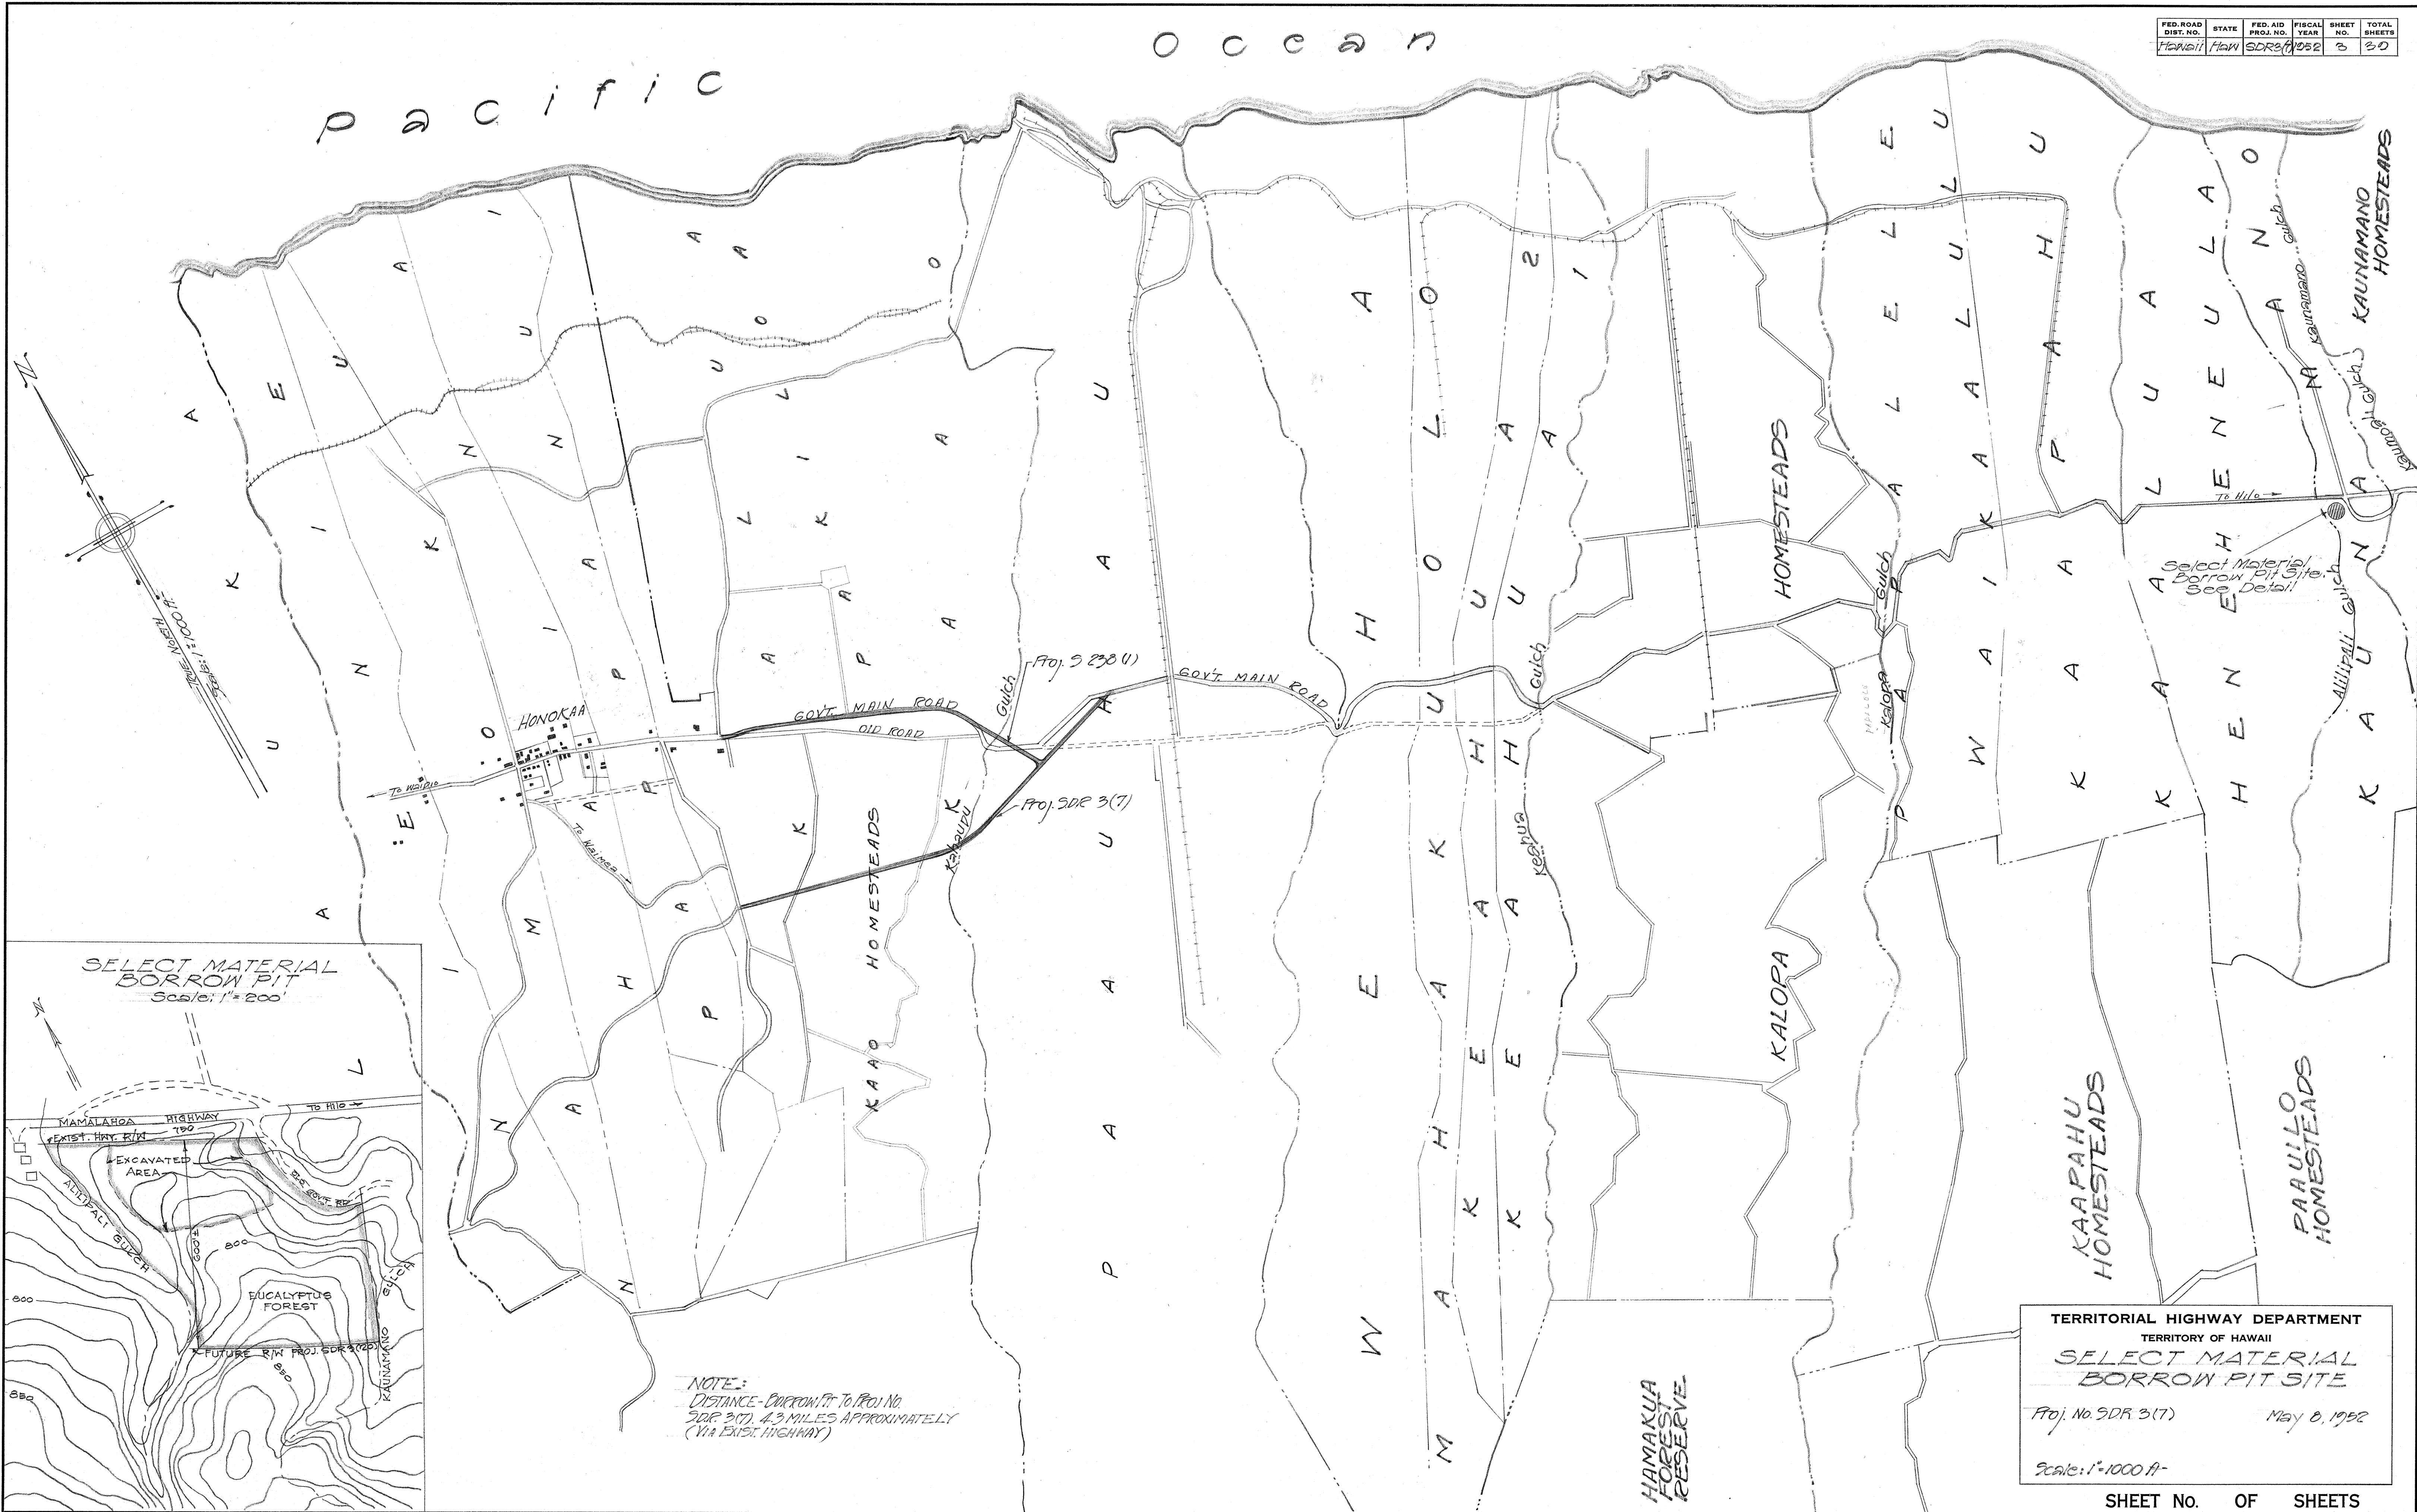

| ORIGINAL PLAN         | DATE |
|-----------------------|------|
| SURVEY PLOTTED BY     | ...  |
| DESIGNED BY           | ...  |
| DRAWN BY              | ...  |
| CHECKED BY            | ...  |
| NOTE BOOK No.         | ...  |
| QUANTITIES CHECKED BY | ...  |

TERRITORIAL HIGHWAY DEPARTMENT  
TERRITORY OF HAWAII  
SELECT MATERIAL BORROW PIT SITE  
Proj. No. SDR 3(7) May 8, 1952  
Scale: 1" = 1000 ft.

SHEET NO. OF SHEETS

3590.3