
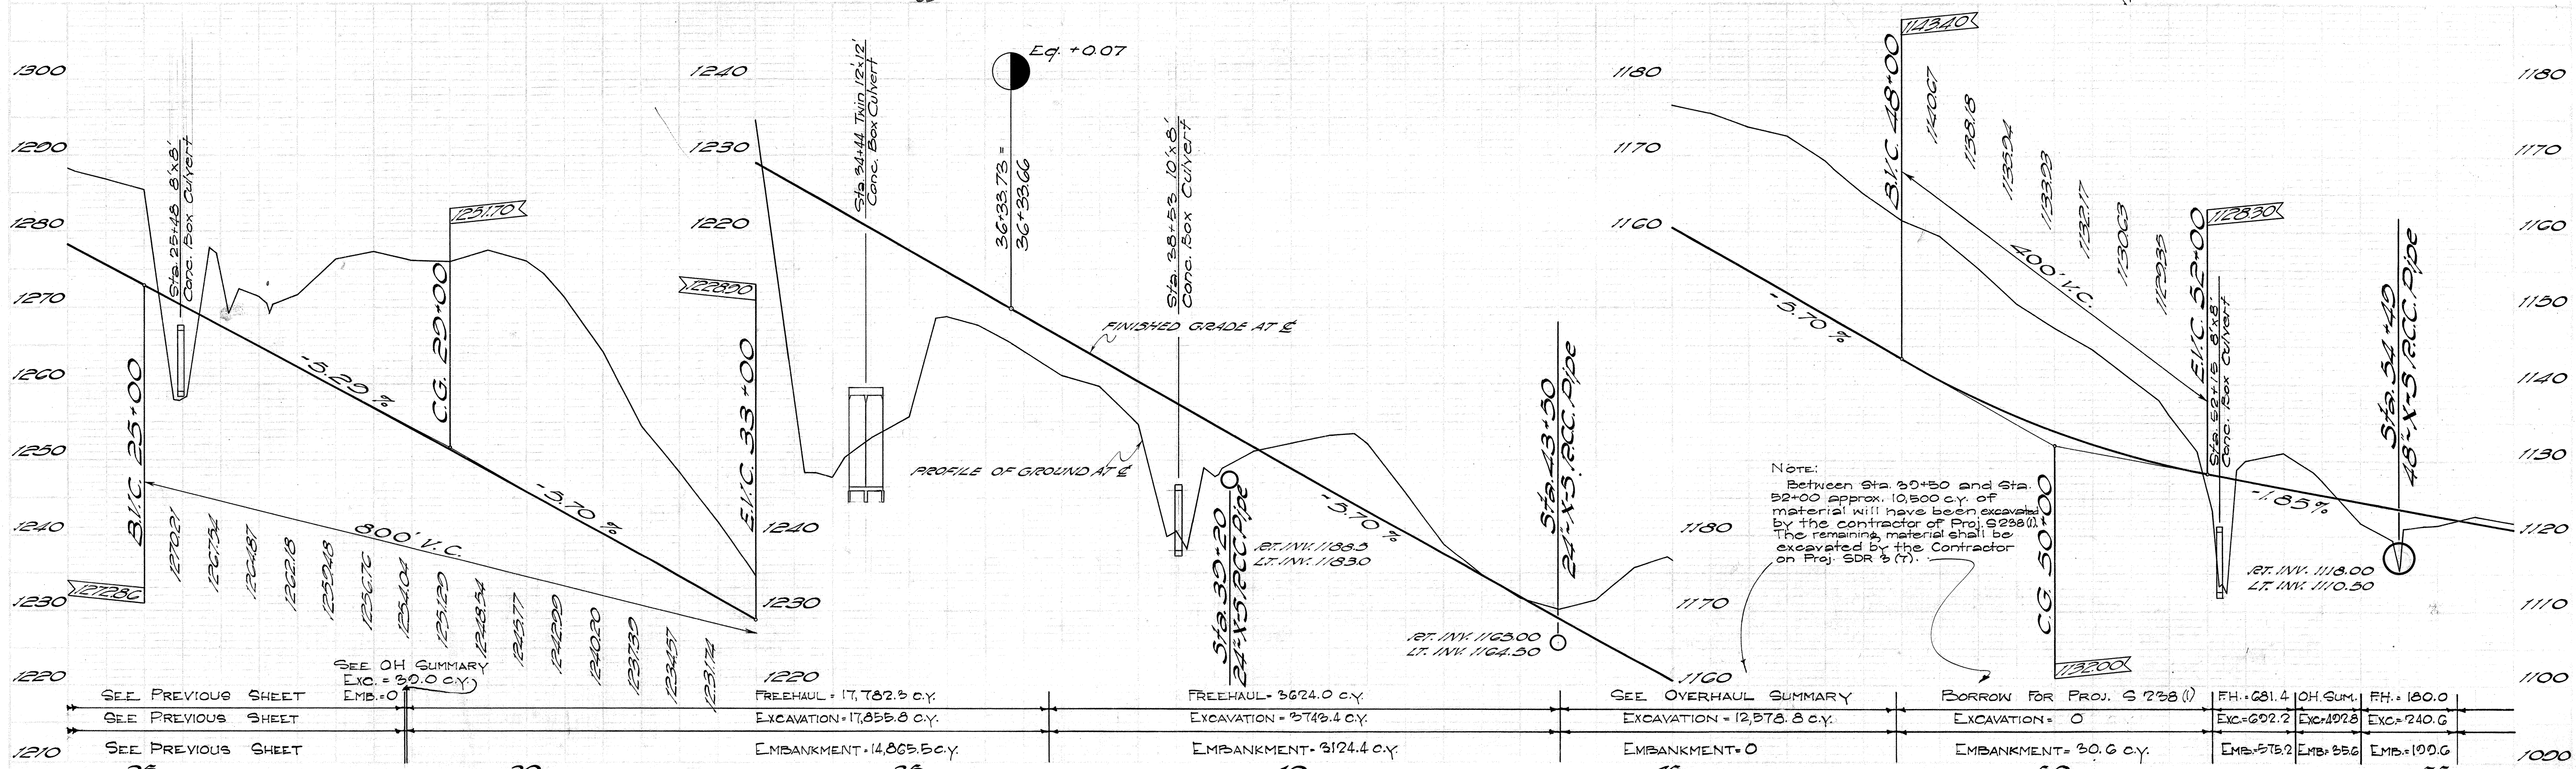



PLAN
 DIST. NO.
 STATE
 FEDERAL AID
 PROJECT NO.
 SHEET NO.
 TOTAL SHEETS

FED. ROAD DIST. NO.	STATE	FED. AID PROJ. NO.	FISCAL YEAR	SHEET NO.	TOTAL SHEETS
148	HAWAII	148	1952	5	30

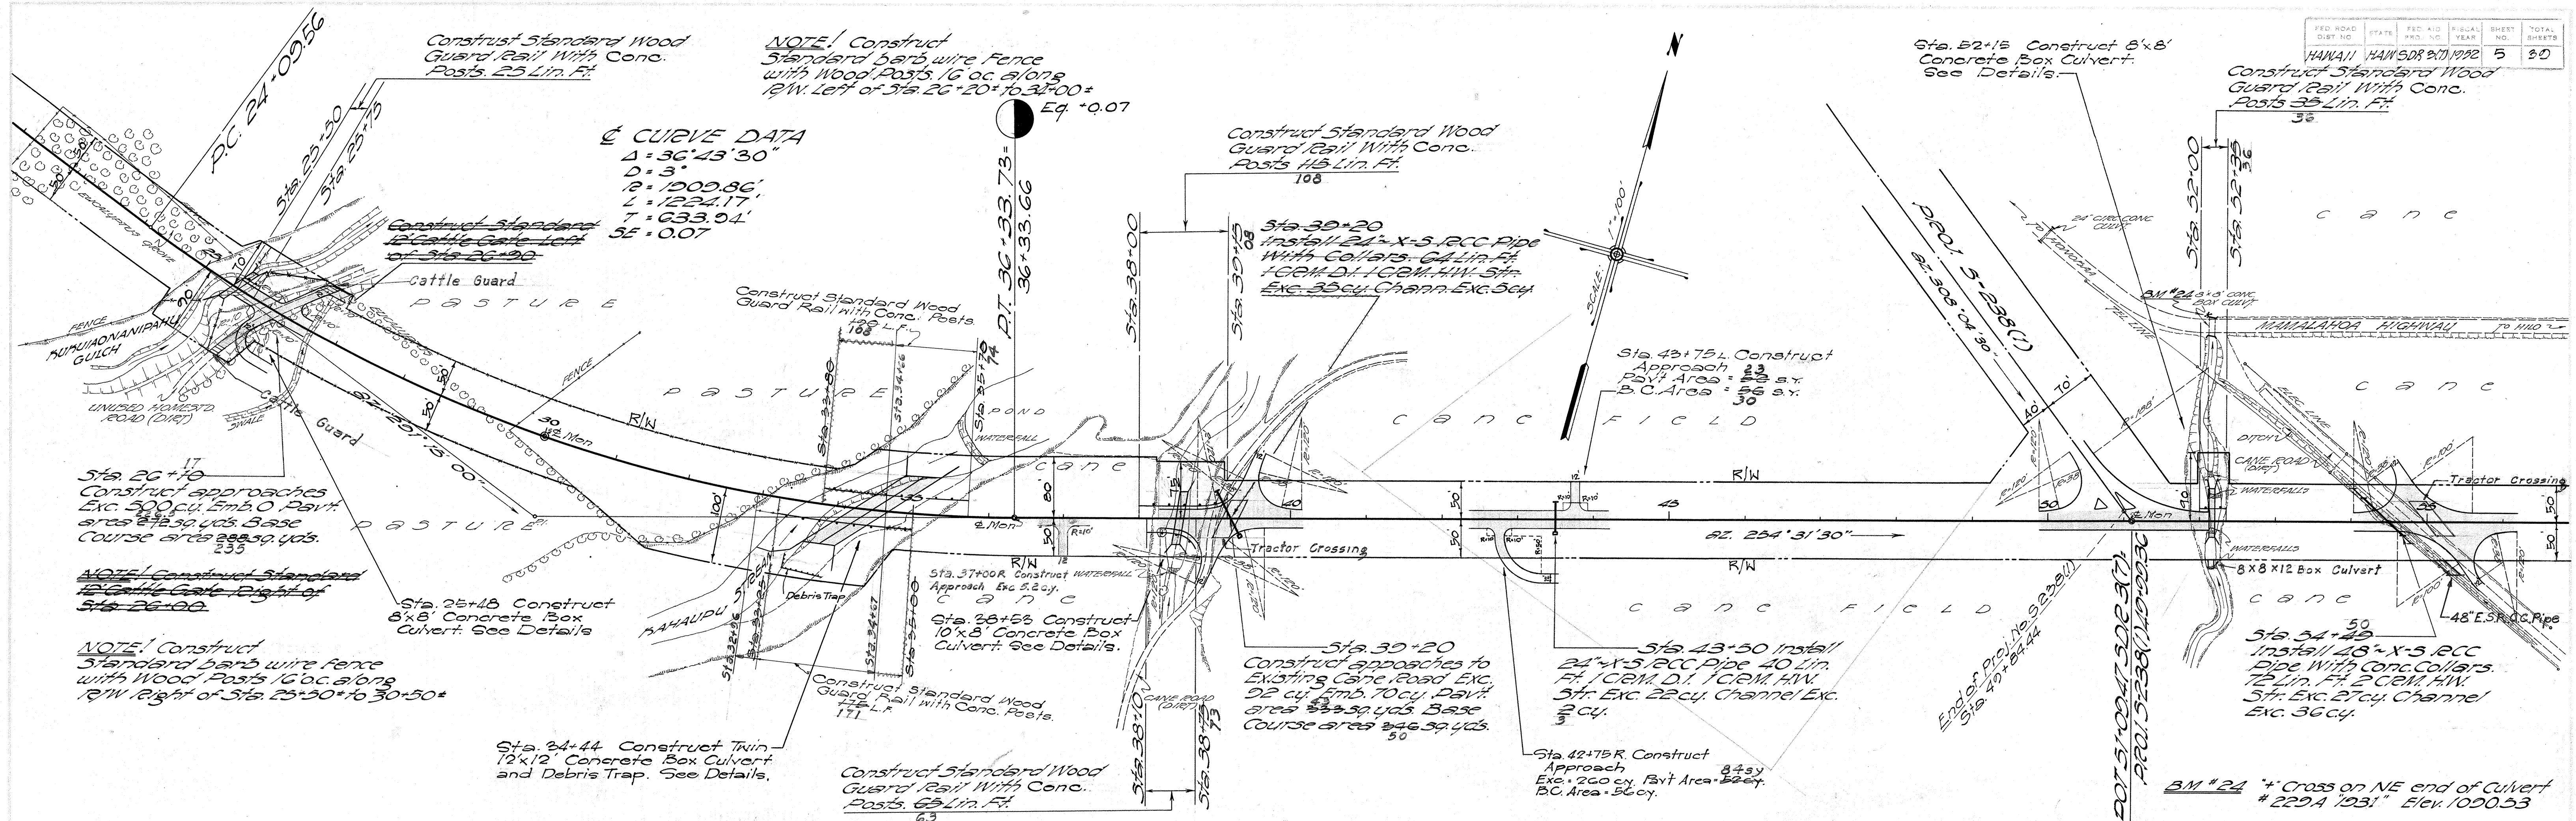


5590.5

PLAN
SCALE: 1"=100'
NOTE: EXC. MATERIAL TO BE USED TO CONSTRUCT ROADWAY PRISM BETWEEN STA 65+00 AND STA 71+00 APPROX. 6047 C.Y.

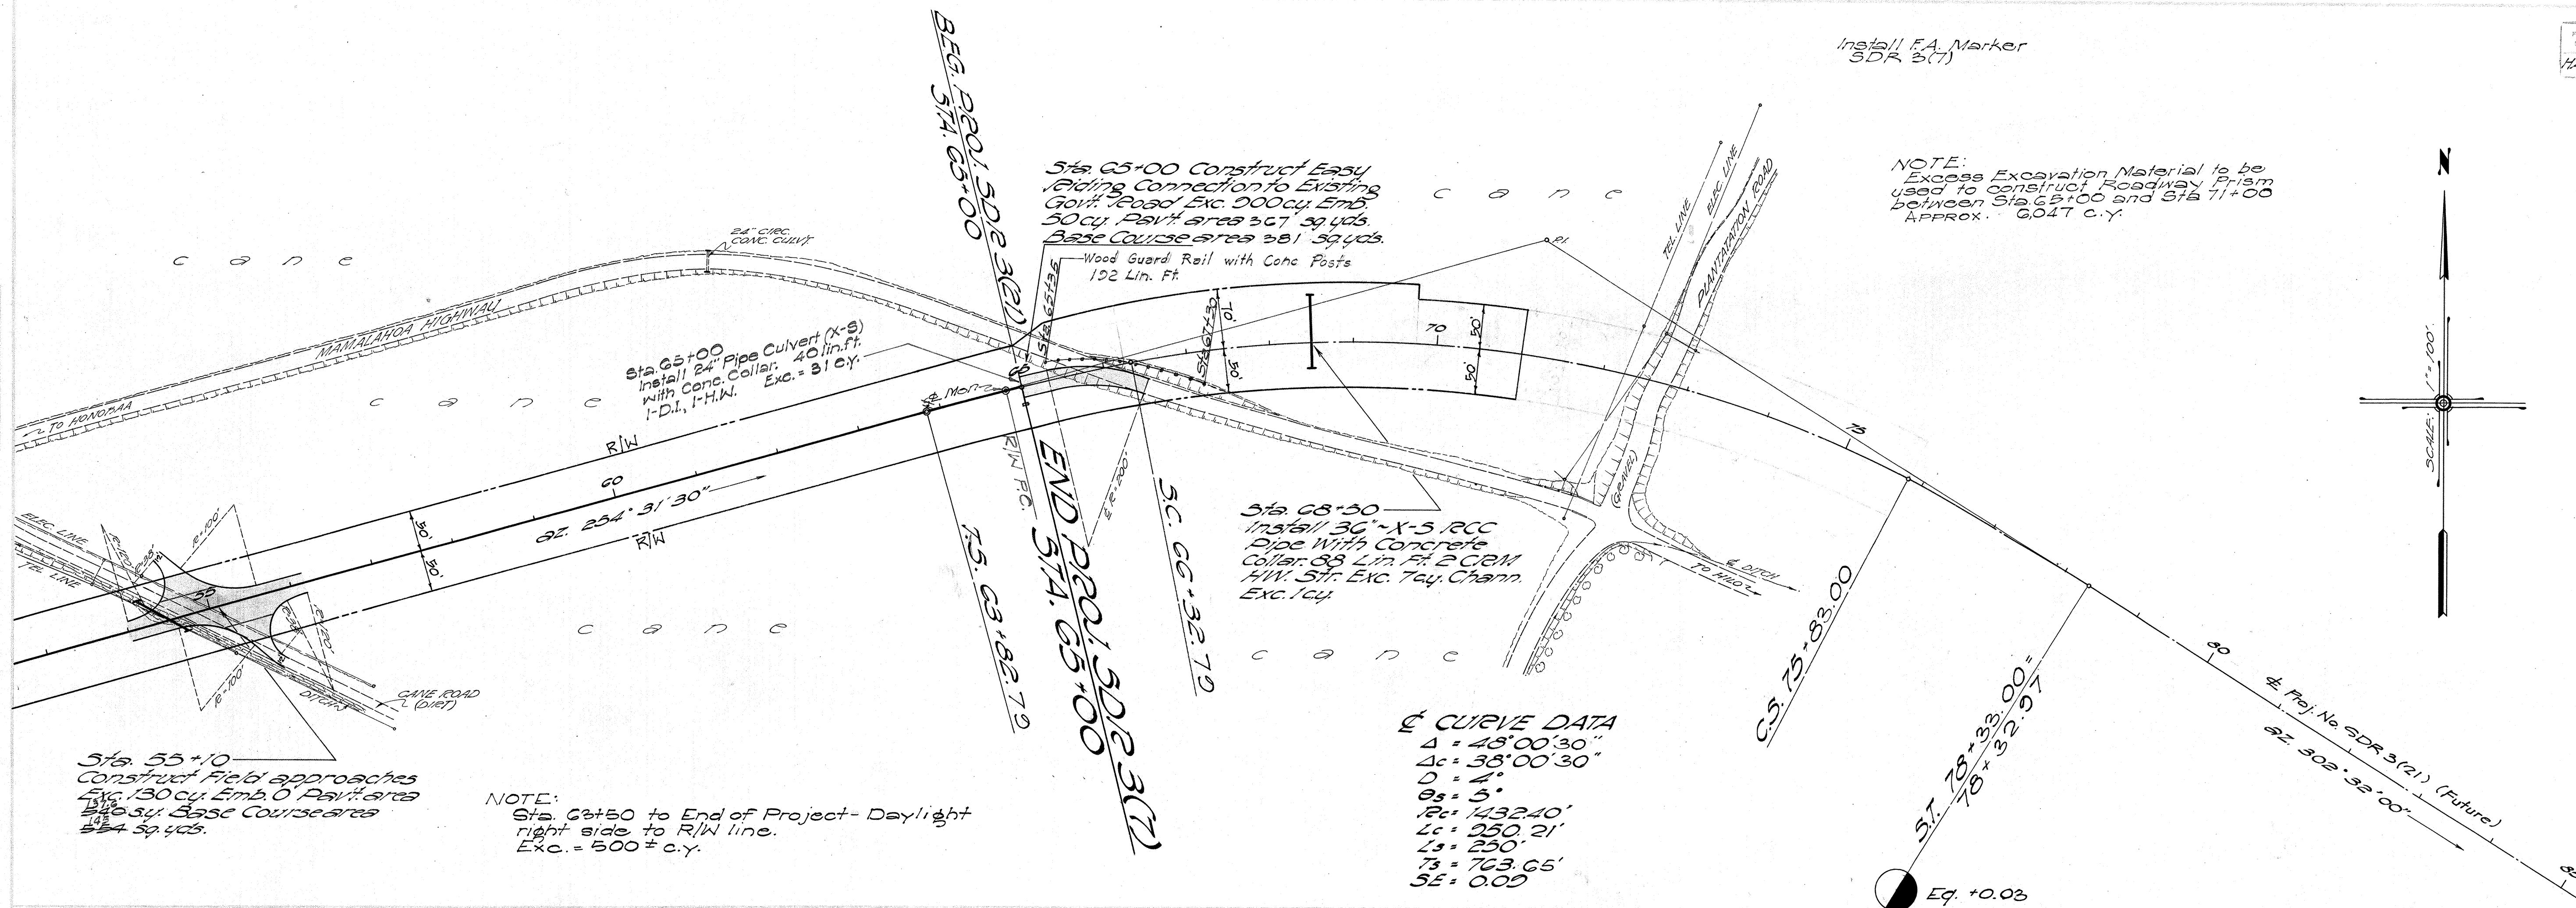

PROFILE
SCALE: 1"=10'
NOTE: EXC. MATERIAL TO BE USED TO CONSTRUCT ROADWAY PRISM BETWEEN STA 65+00 AND STA 71+00 APPROX. 6047 C.Y.

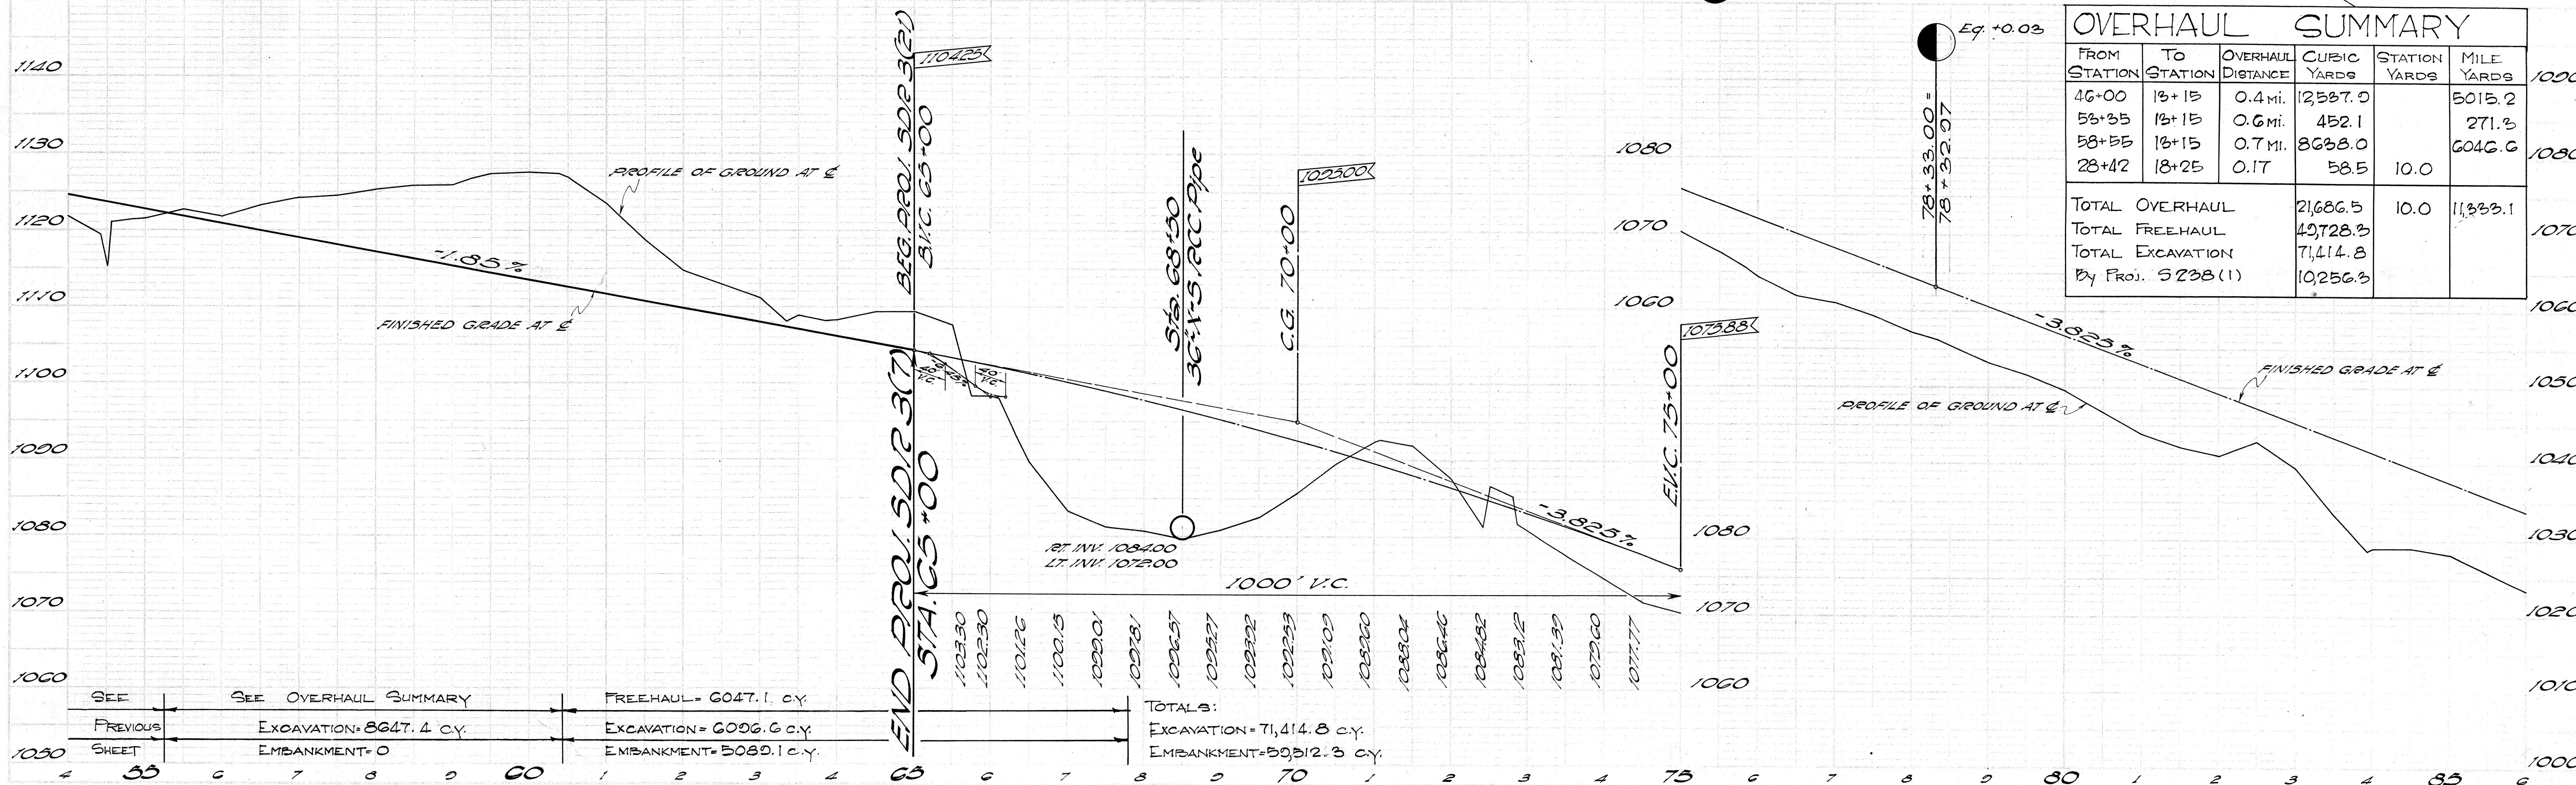

OVERHAUL SUMMARY					
FROM STATION	TO STATION	OVERHAUL DISTANCE	CUBIC YARDS	STATION YARDS	MILE YARDS
46+00	13+15	0.4 mi.	12587.9		5015.2
53+35	13+15	0.6 mi.	452.1		271.3
58+55	13+15	0.7 mi.	8638.0		6046.6
28+42	18+25	0.17	58.5	10.0	
TOTAL OVERHAUL			21686.5	10.0	11333.1
TOTAL FREEHAUL			42728.3		
TOTAL EXCAVATION			71414.8		
By Proj. 5238(1)			10256.3		