
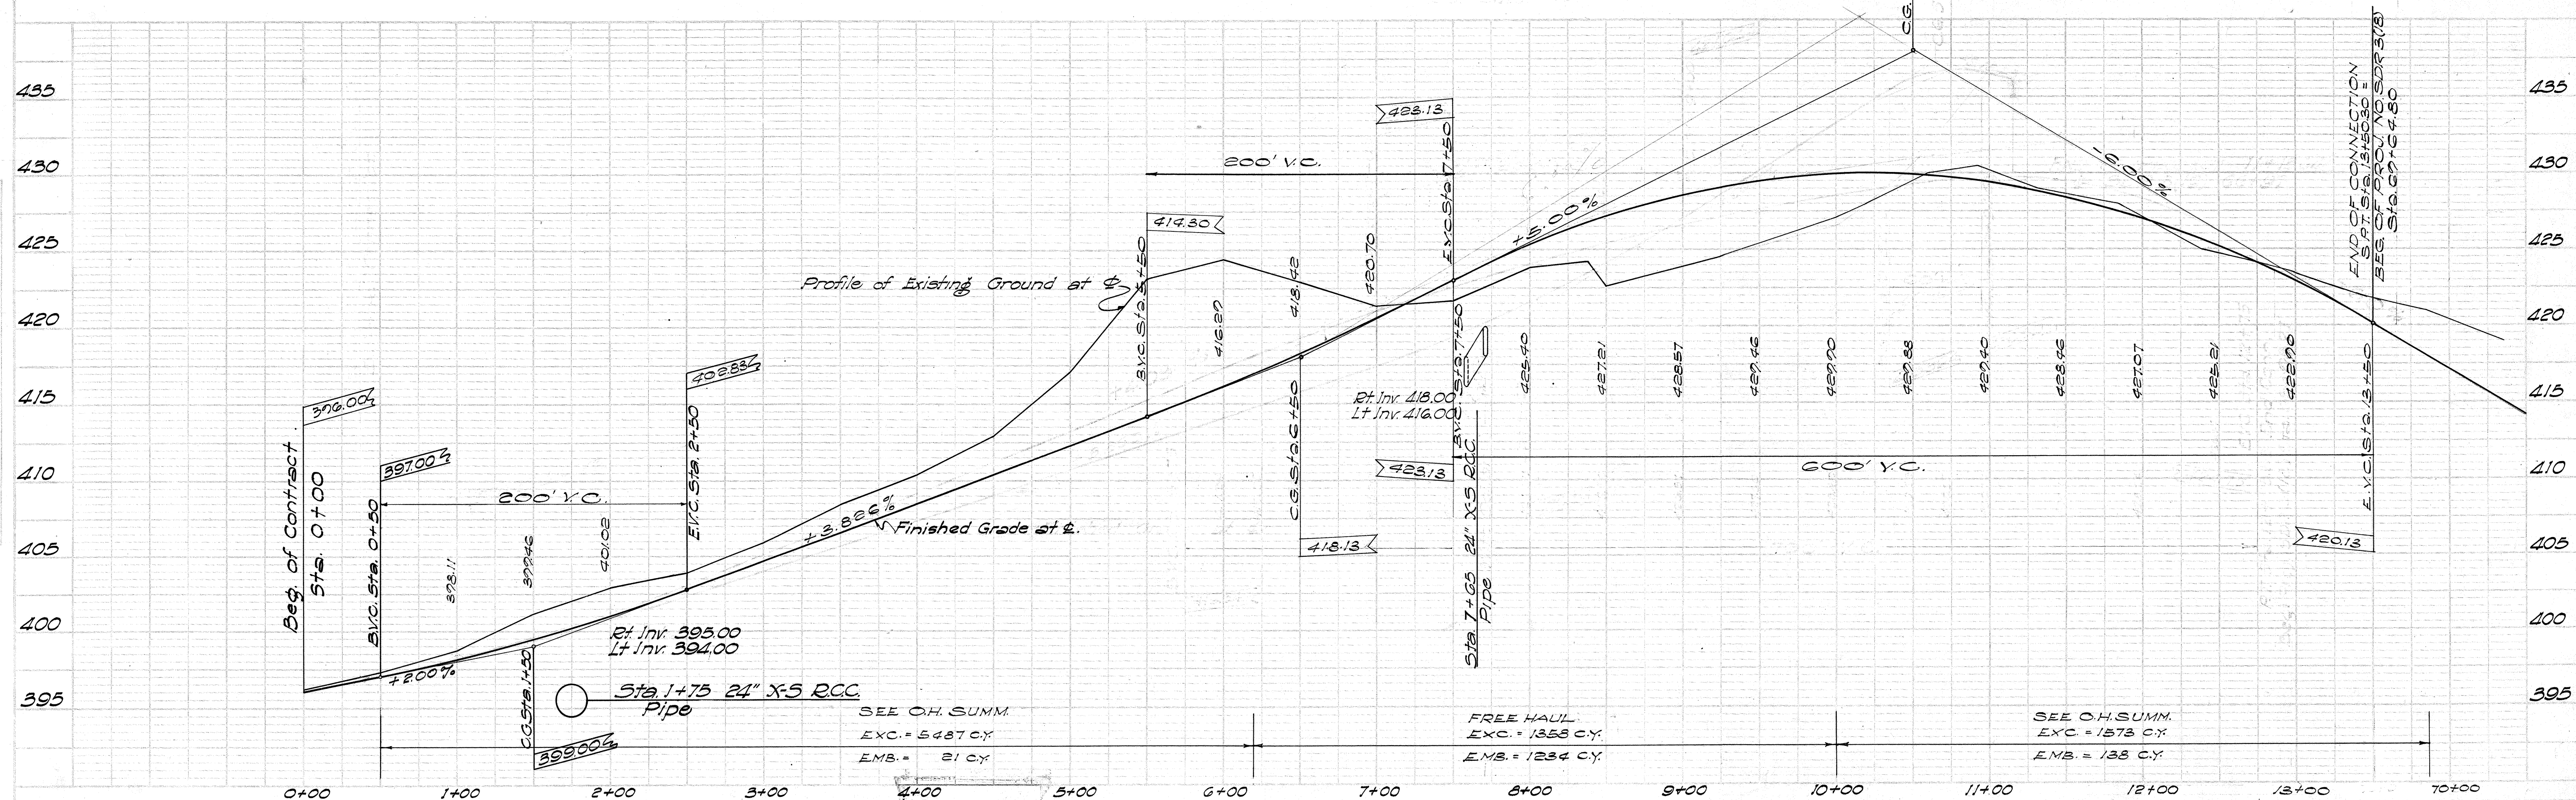


± CURVE DATA
 $\Delta = 25^{\circ}00'30''$
 $R = 600'$
 $T = 133.06'$
 $L = 261.87'$
 $SE = 0.10'/ft$

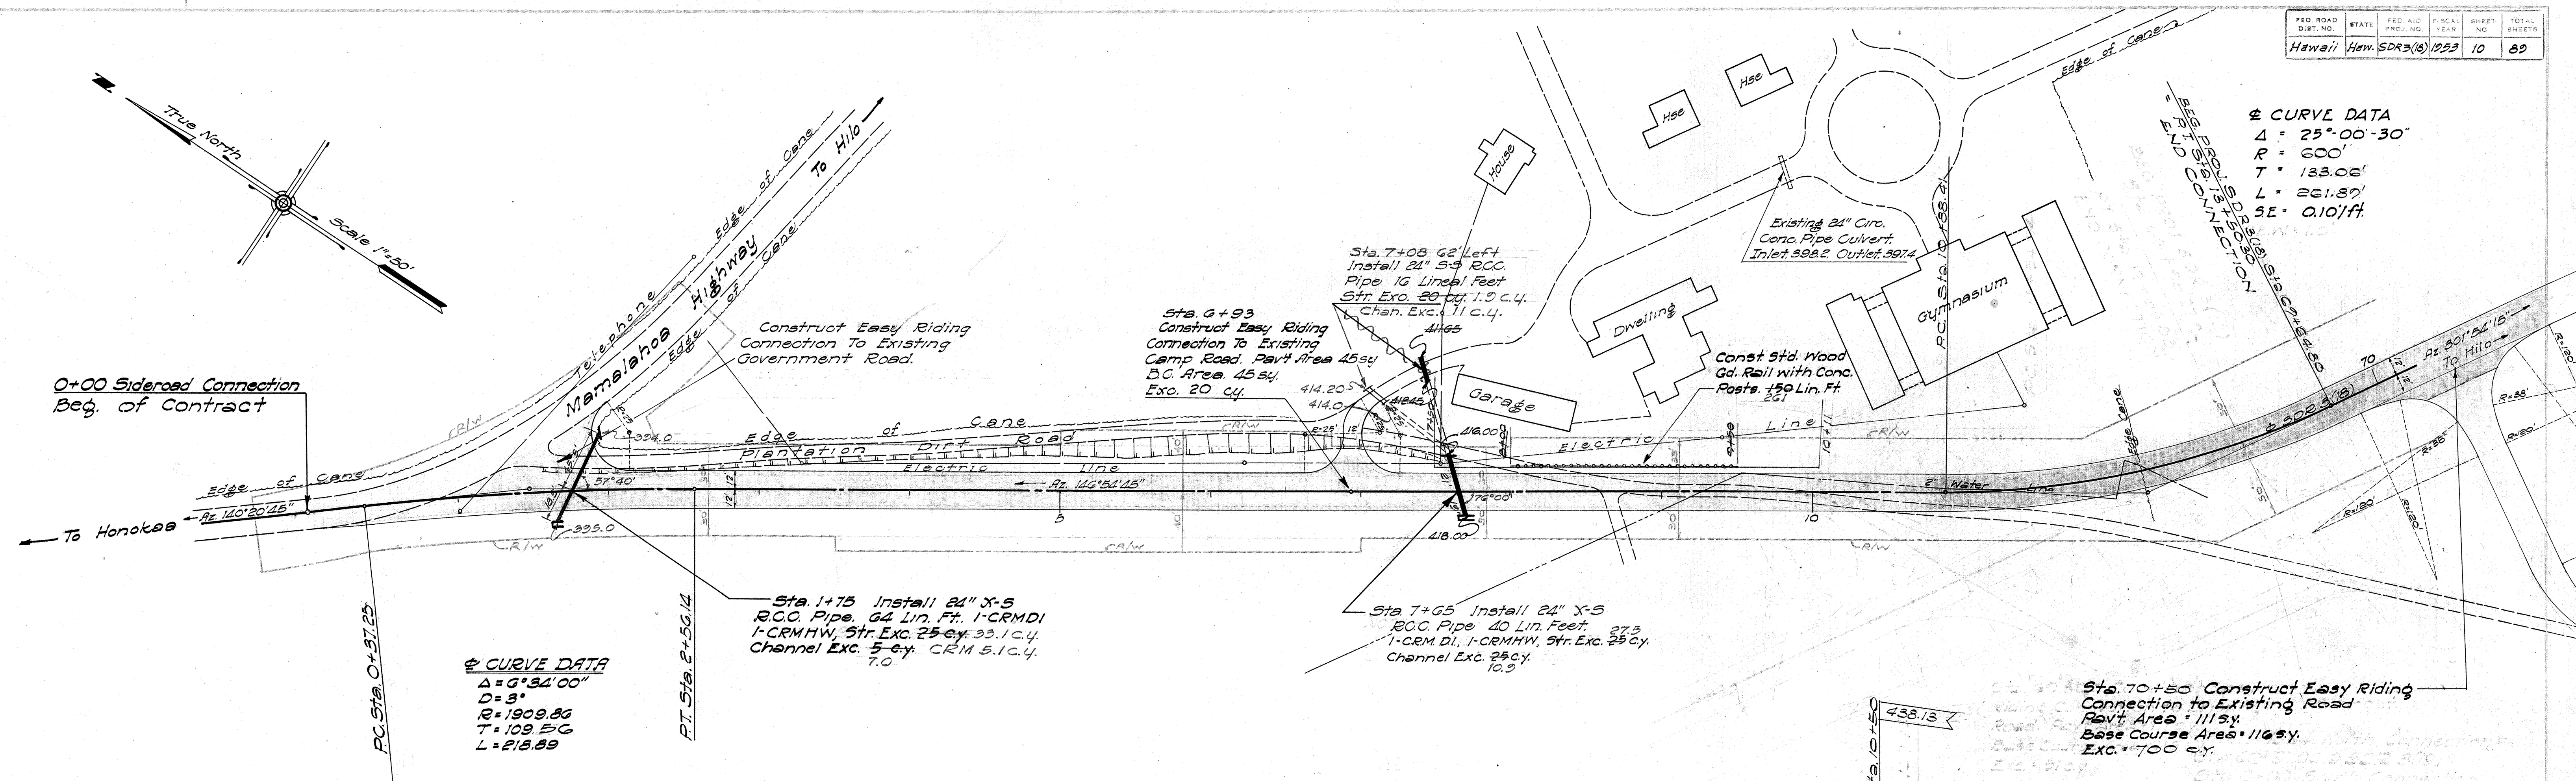

5624.10