

INDEX TO DRAWINGS	
SHEET	DESCRIPTION
1	TITLE SHEET
2-3	TYPICAL SECTION
4	BORROW PIT
5-9	PLAN AND PROFILE
10	DETAIL AT CONNECTION
11-12	SOIL PROFILE
13-14	LOCATION OF REGULATORY AND WARNING SIGNS AND ACCESS POINTS
15-18	STANDARD DETAILS
19-30	BOX CULVERT DETAIL
31-39	CROSS SECTIONS

TERRITORY OF HAWAII
TERRITORIAL HIGHWAY DEPARTMENT
HONOLULU T.H.


PLANS OF
HAWAII BELT ROAD
SEISMIC WAVE DAMAGE REHABILITATION PROJ. NO. S.D.R. 3 (18)
DISTRICT OF NORTH HILO
ISLAND OF HAWAII

CONVENTIONAL SIGNS USED

Centerline	-----	I55
Boundary Line	-----	or, -----
Fences (Noted)	-----	or, -----
Existing Roadway	-----	-----
Box Culvert	-----	-----
Centerline Monuments	-----	©
Water Main	-----	W4 W5
Warning & Regulatory Signs	-----	I-Type
Tree (Large)	-----	or, -----

SCALES


PLAN	-----	1 INCH = 100 FT.
PROFILE	-----	HOR. 1 INCH = 100 FT.
	-----	VER. 1 INCH = 10 FT.
CROSS SECTION	-----	HOR. 1 INCH = 10 FT.
	-----	VER. 1 INCH = 10 FT.

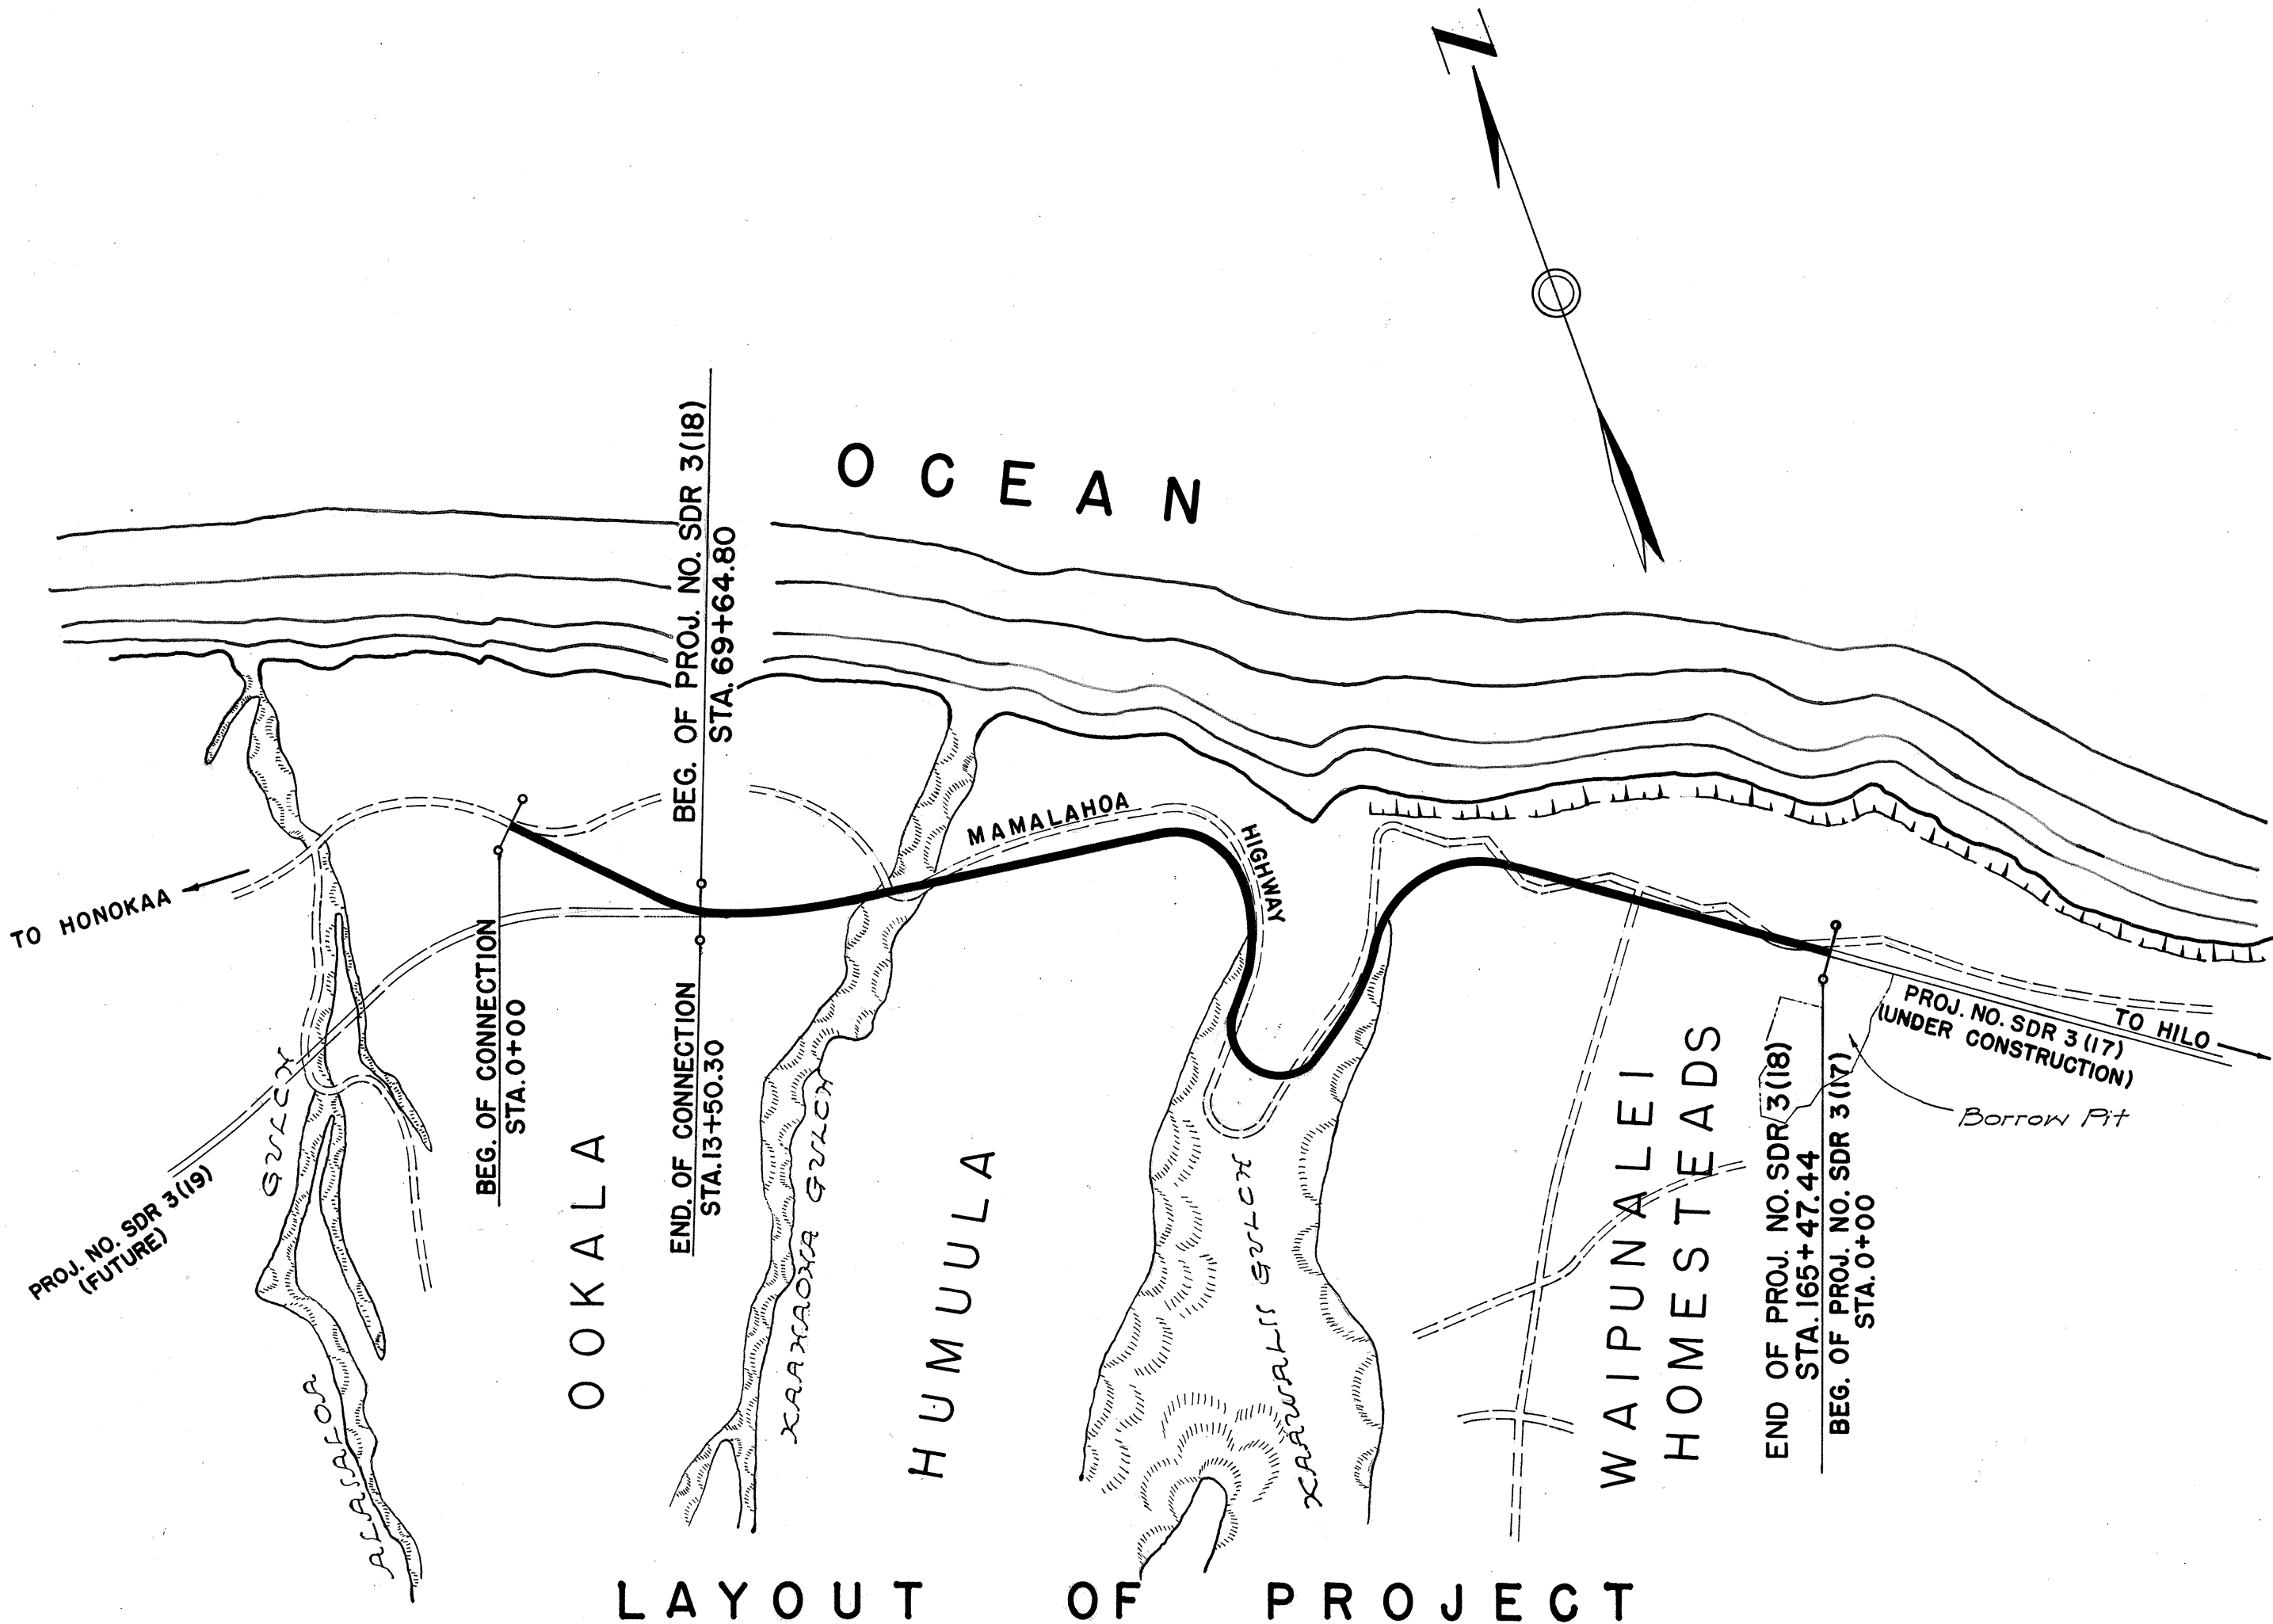

LAYOUT OF PROJECT

Scale: 1" = 1000'

Gross and Net Length of Project = 1.839 mi.

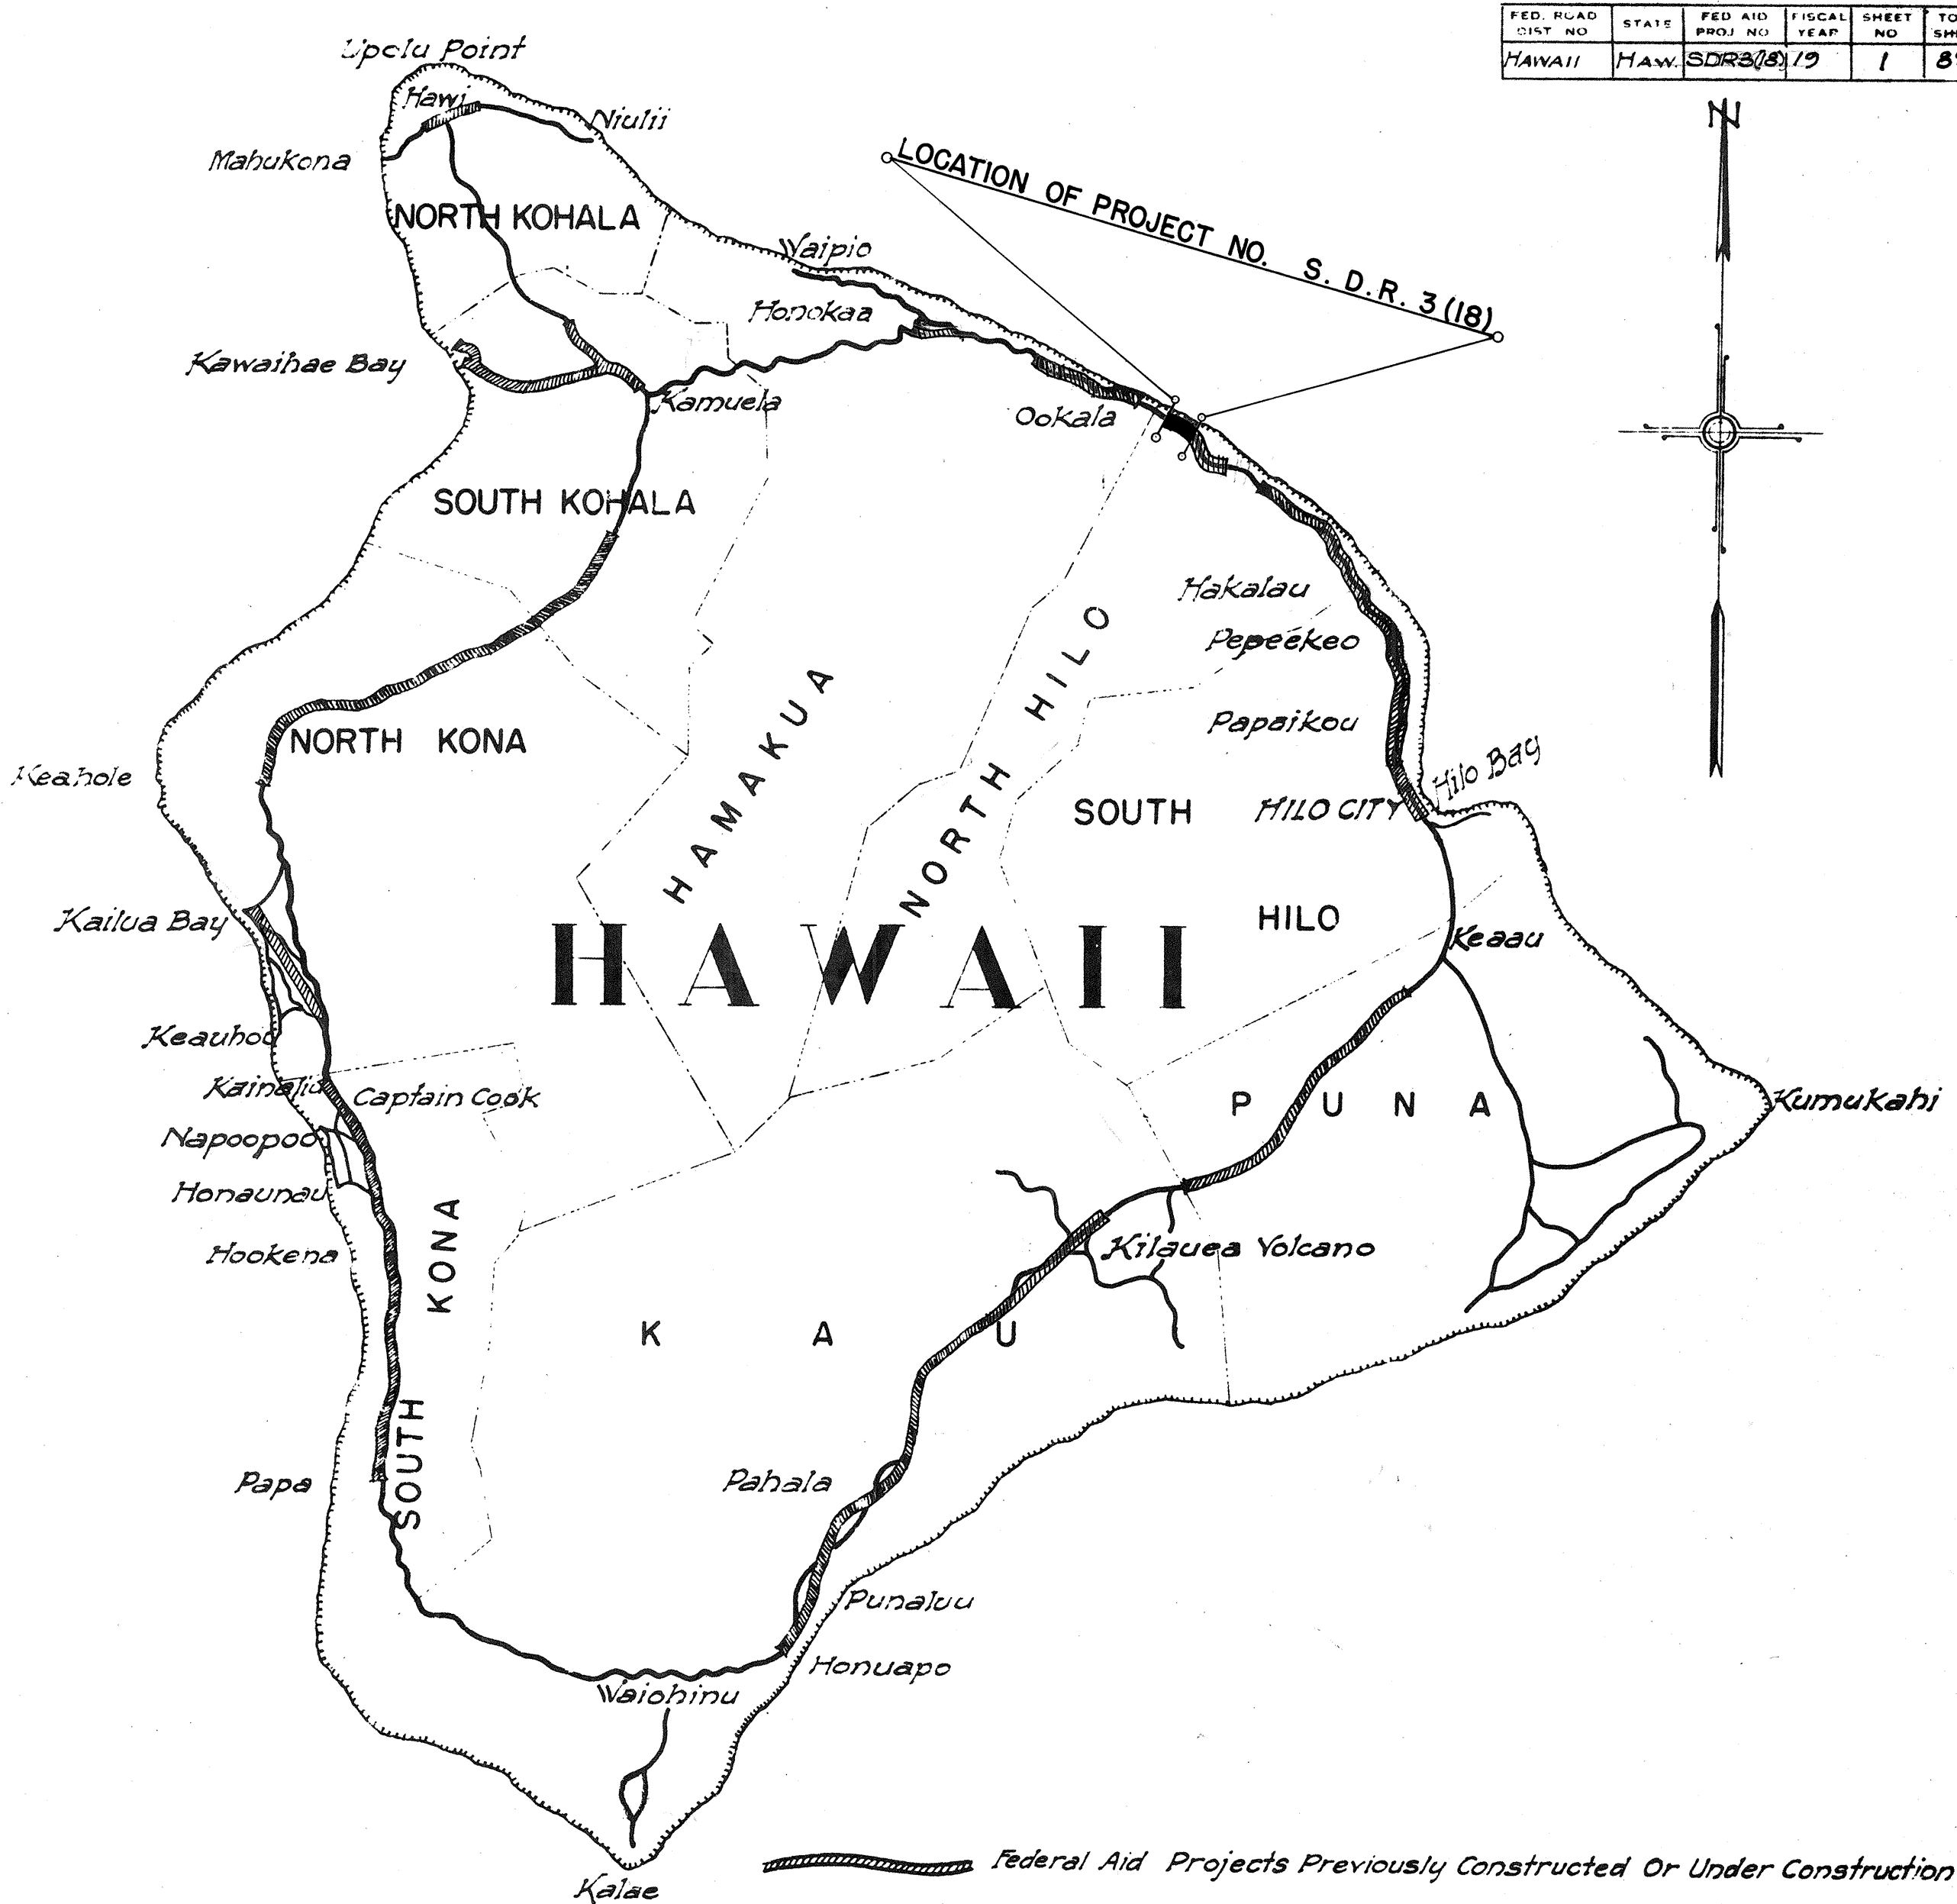

NOTE:
ALL CHANGES MADE DURING CONSTRUCTION
HAVE BEEN NOTED IN RED IN THESE
TRACINGS AND CHECKED BY

David K. Kailimai
PROJECT ENGINEER

11-21-55
DATE

APPROVED: *David K. Kailimai*
TERRITORIAL HIGHWAY ENGINEER

DEPARTMENT OF COMMERCE
BUREAU OF PUBLIC ROADS
APPROVED: _____
DISTRICT ENGINEER DATE