

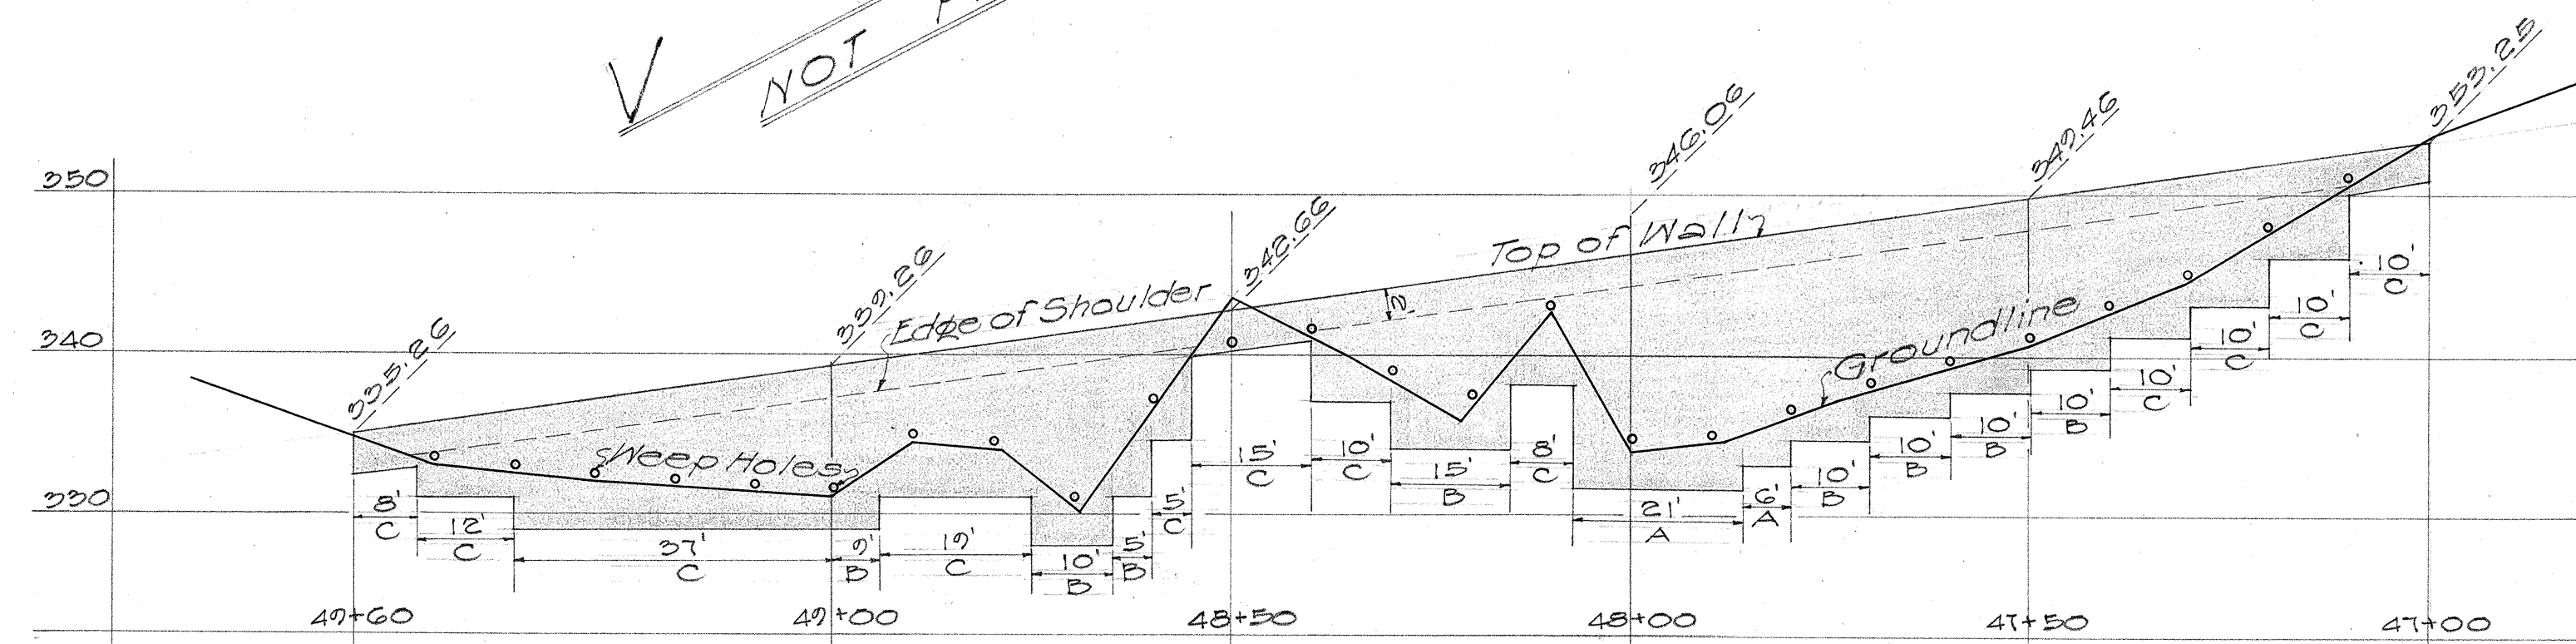
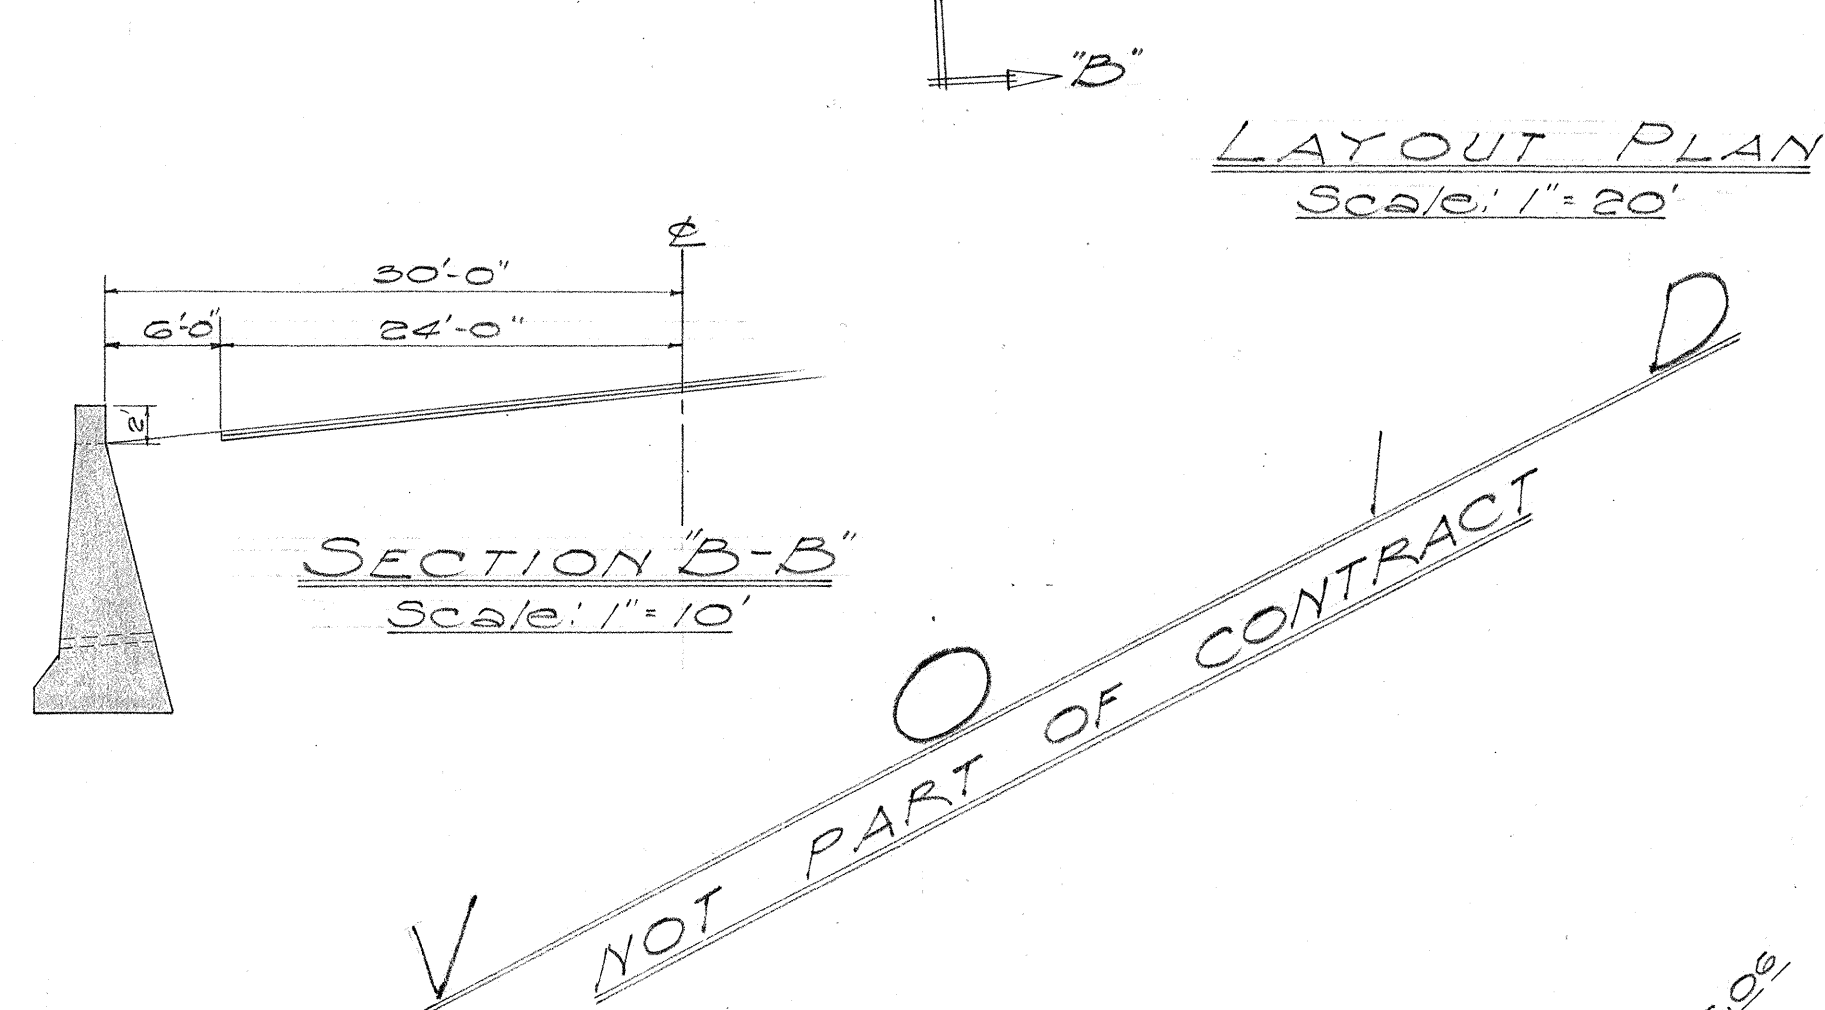
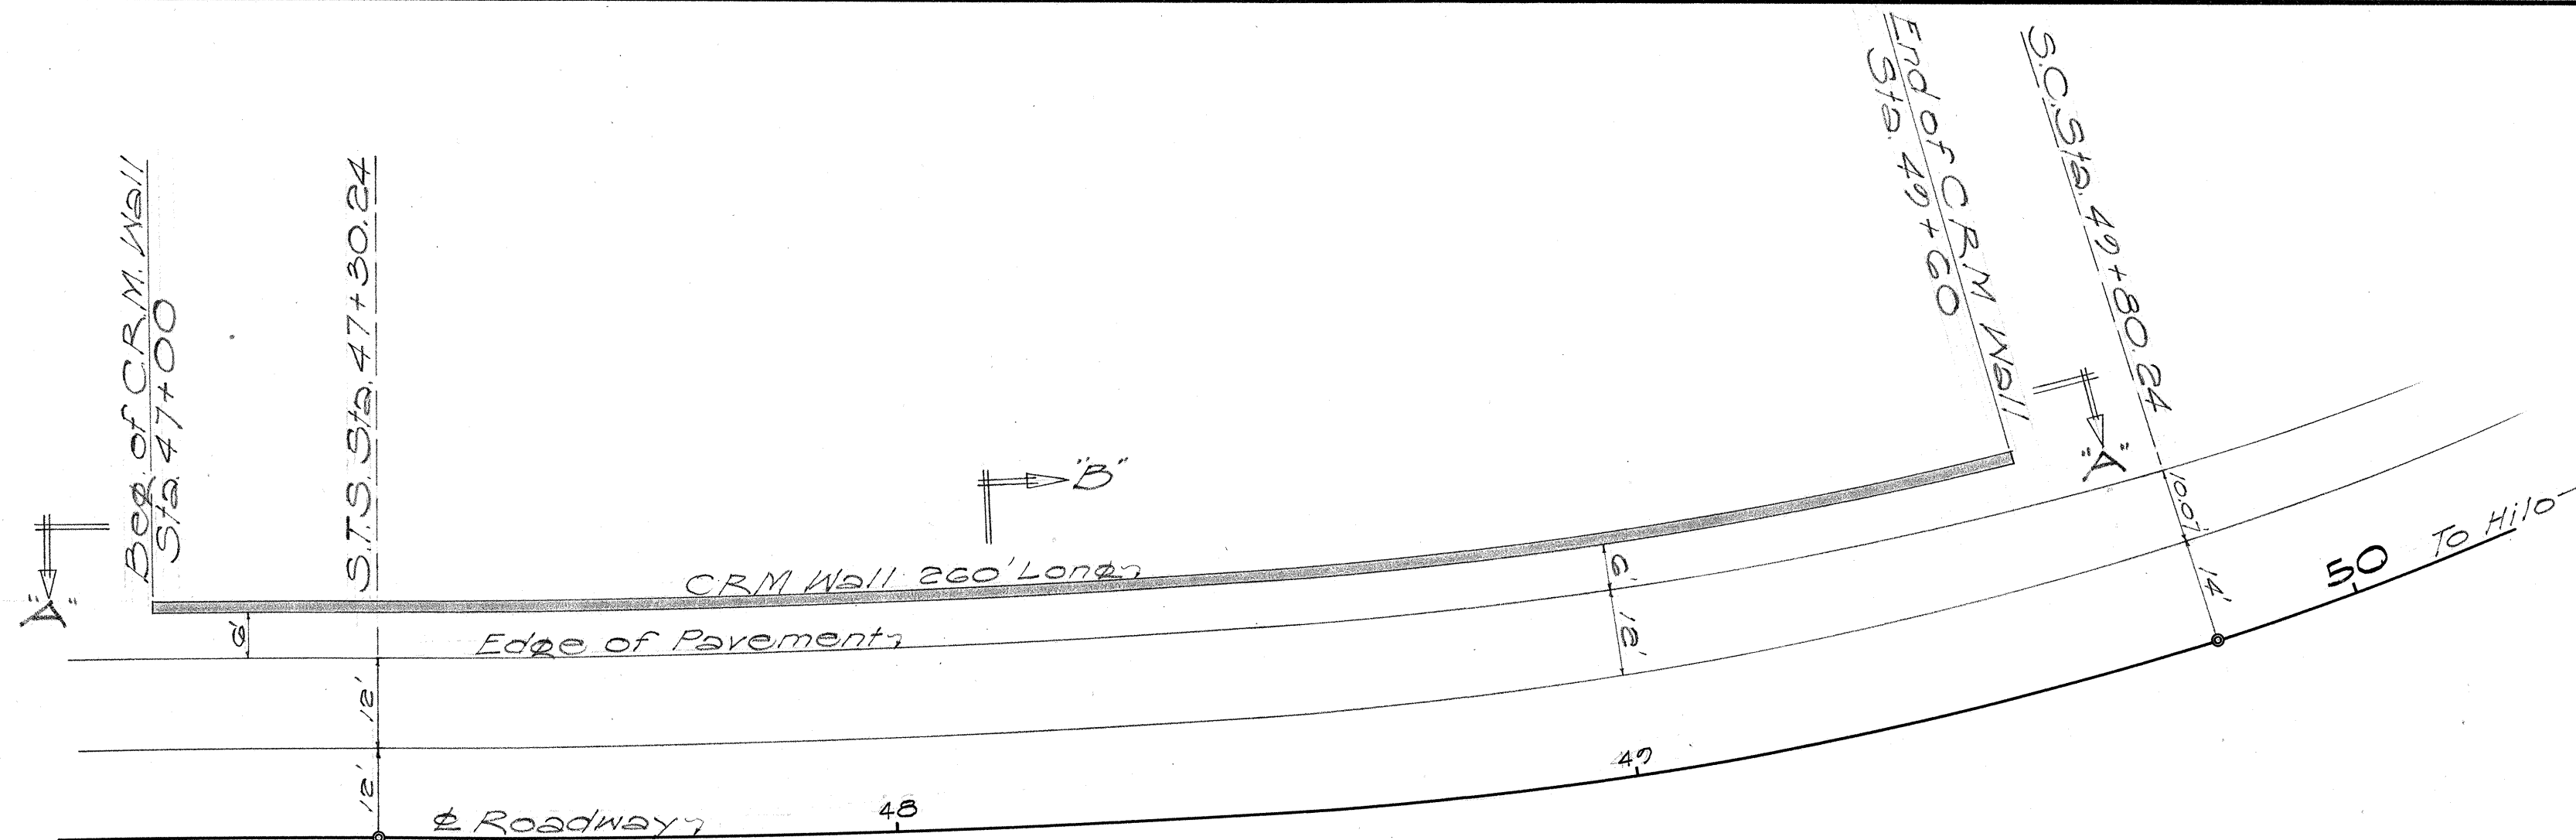


FED. ROAD DIST. NO.	STATE	FED. AID PROJ. NO.	FISCAL YEAR	SHEET NO.	TOTAL SHEETS
HAWAII	HAW	SDR 3(17)	1952	14	25

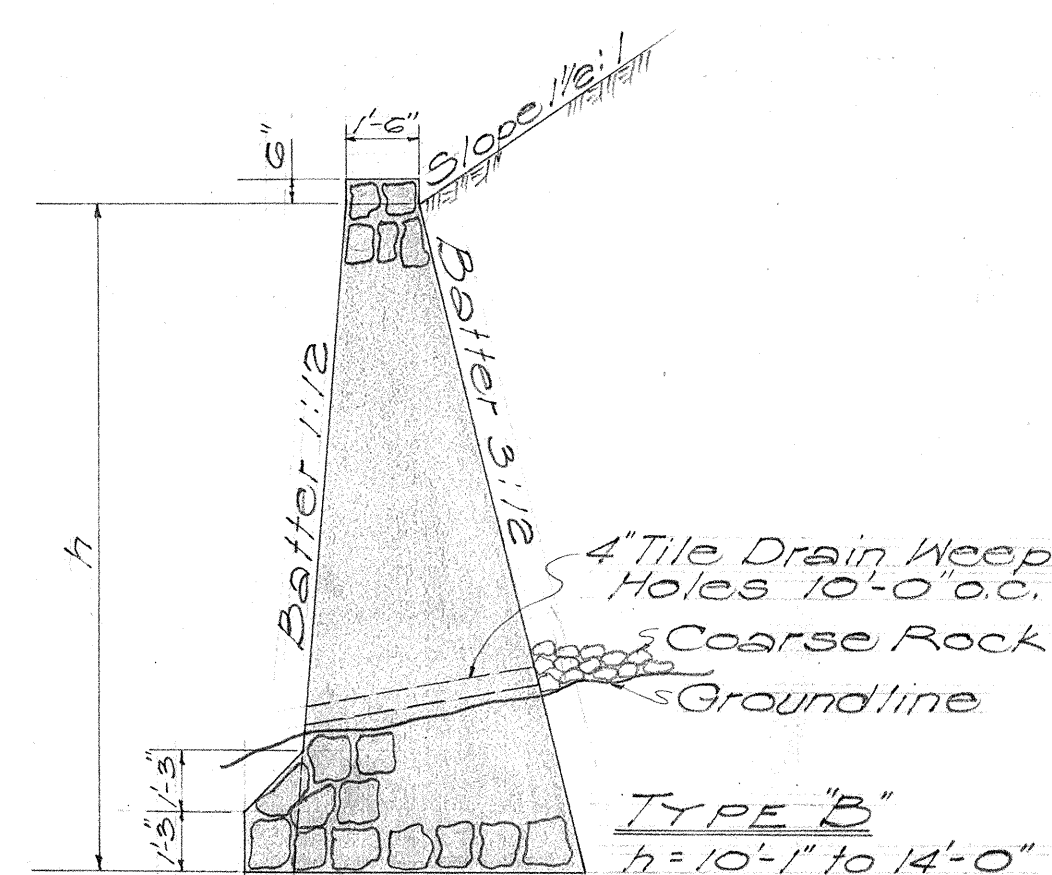


ELEVATION "A-A"
Scale: Vert. 1"=10'
Horiz. 1"=20'

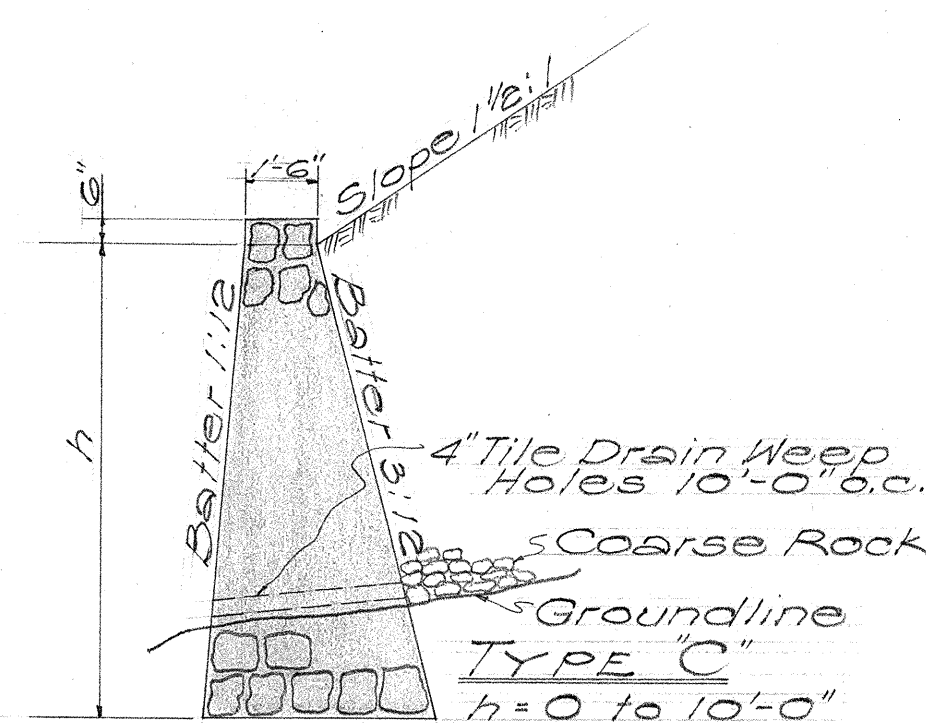


DETAILS OF C.R.M. WALLS
Scale: 1/4"=1'-0"

Standard Wood Guard Rail
w/Conc. Posts.
Sta. 76+00 to 77+35

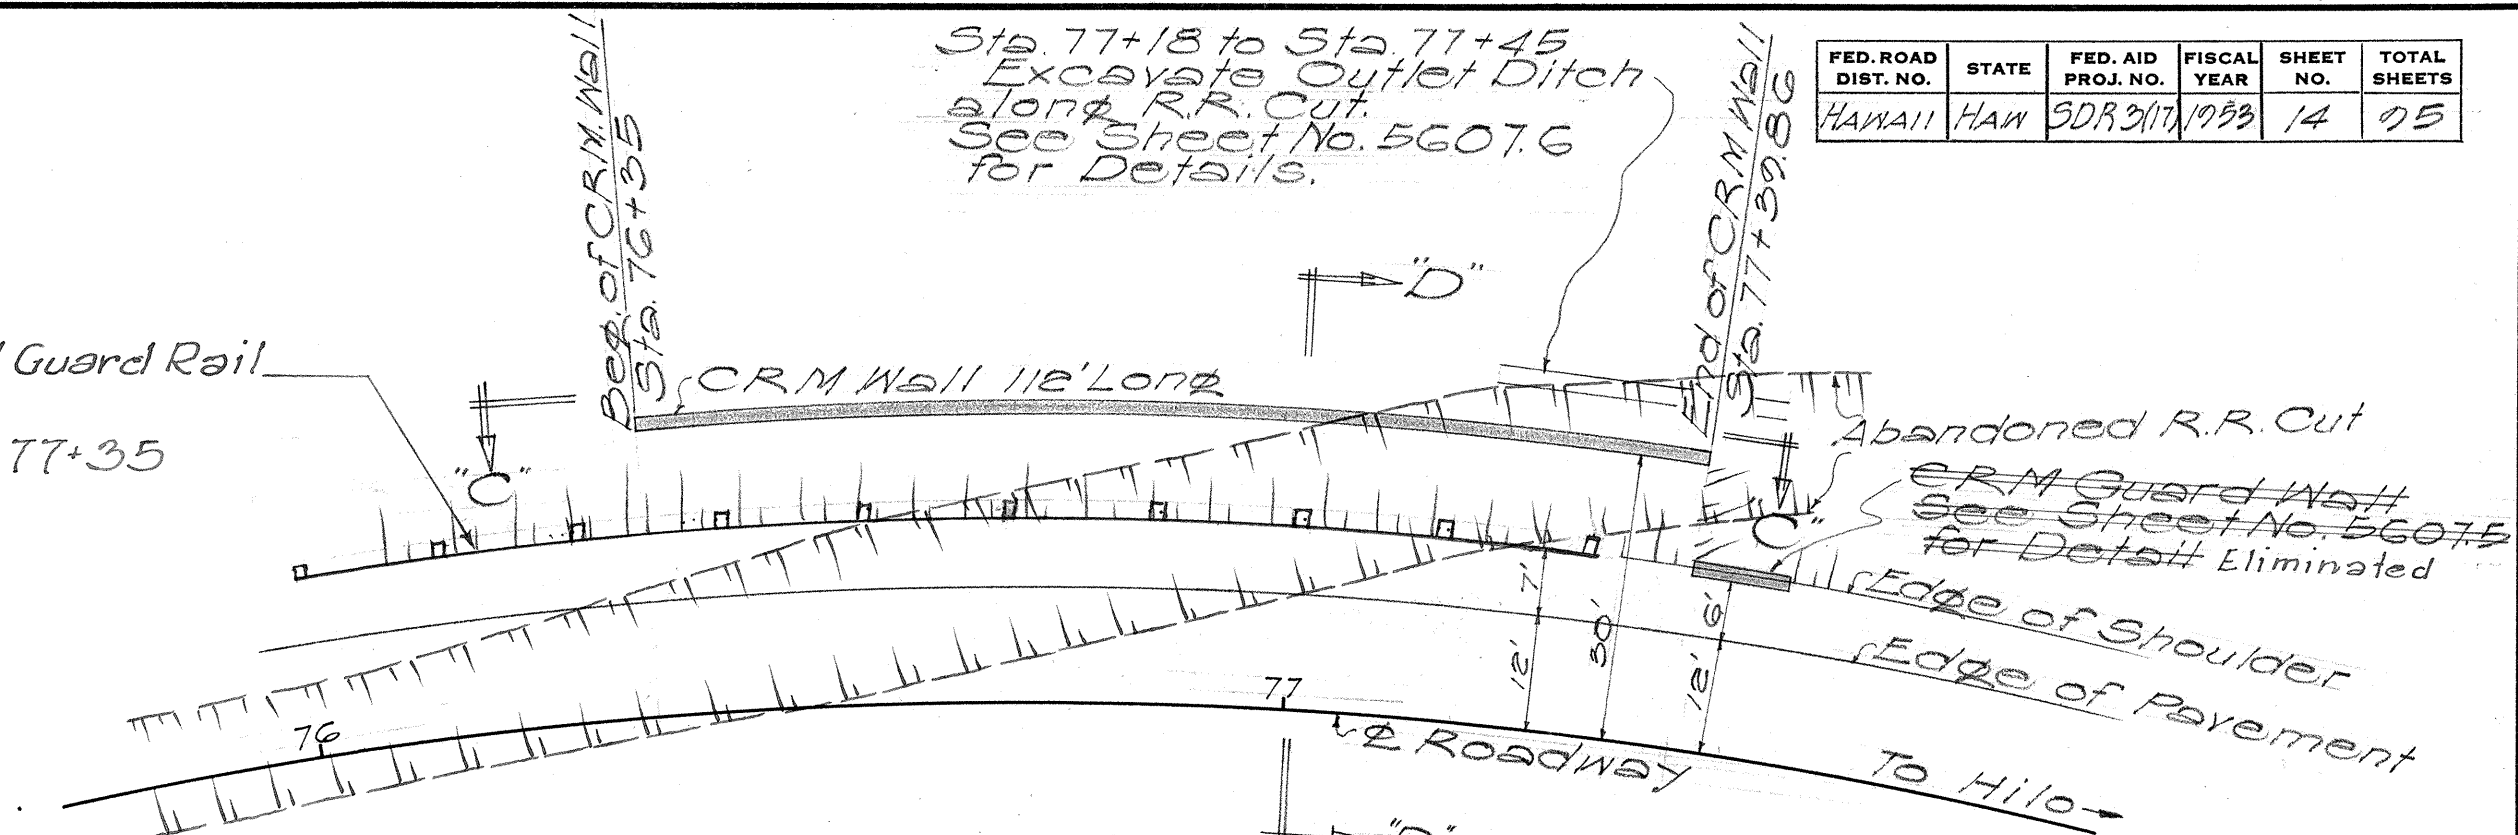


LAYOUT PLAN
Scale: 1"=20'

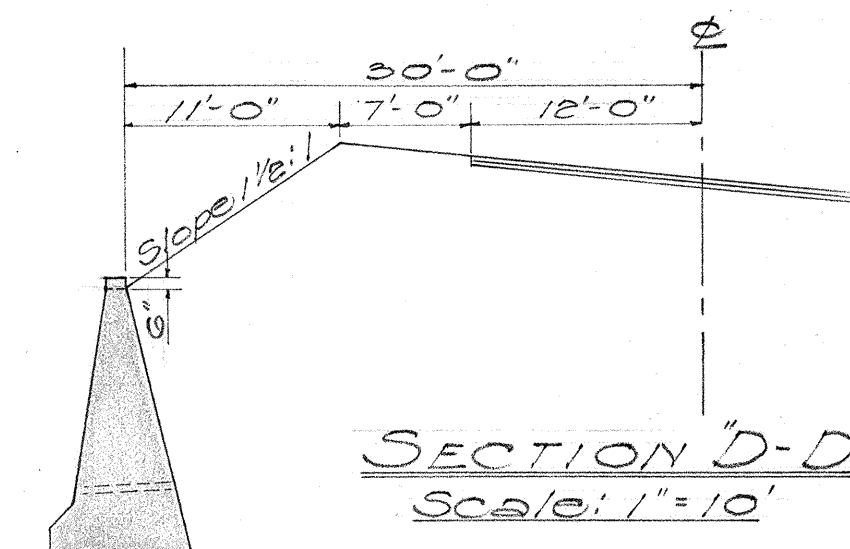


SECTION "D-D"
Scale: 1"=10'

LOCATION	CRM C.T.	STRUC. EXC. C.T.
Sta. 47+00 to Sta. 49+60	242	150
Sta. 76+35 to Sta. 77+35	242	150
TOTAL	484	300

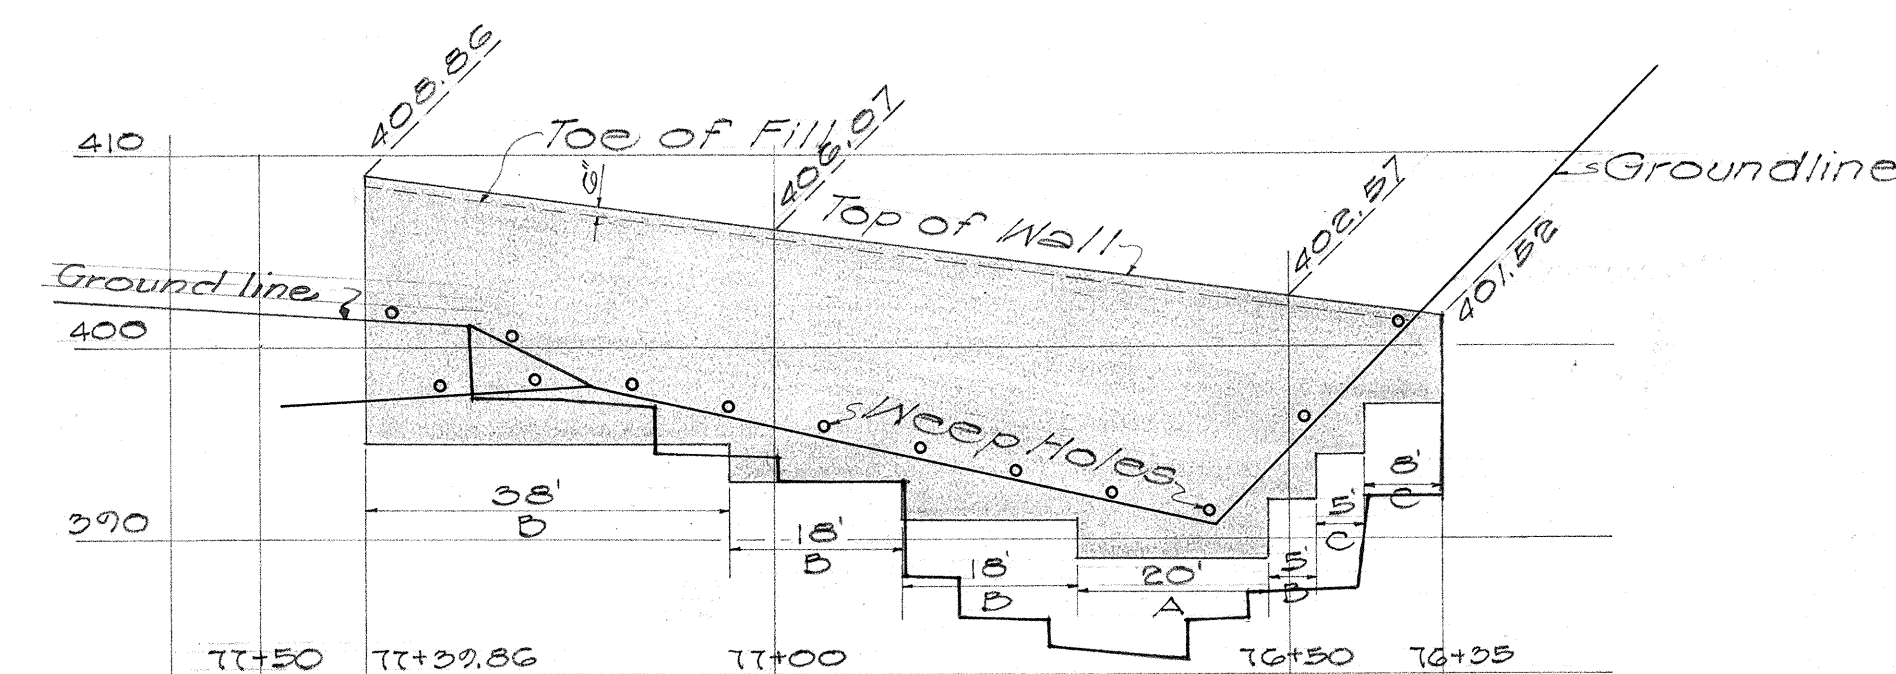

ELEVATION "C-C"
Scale: Vert. 1"=10'
Horiz. 1"=20'

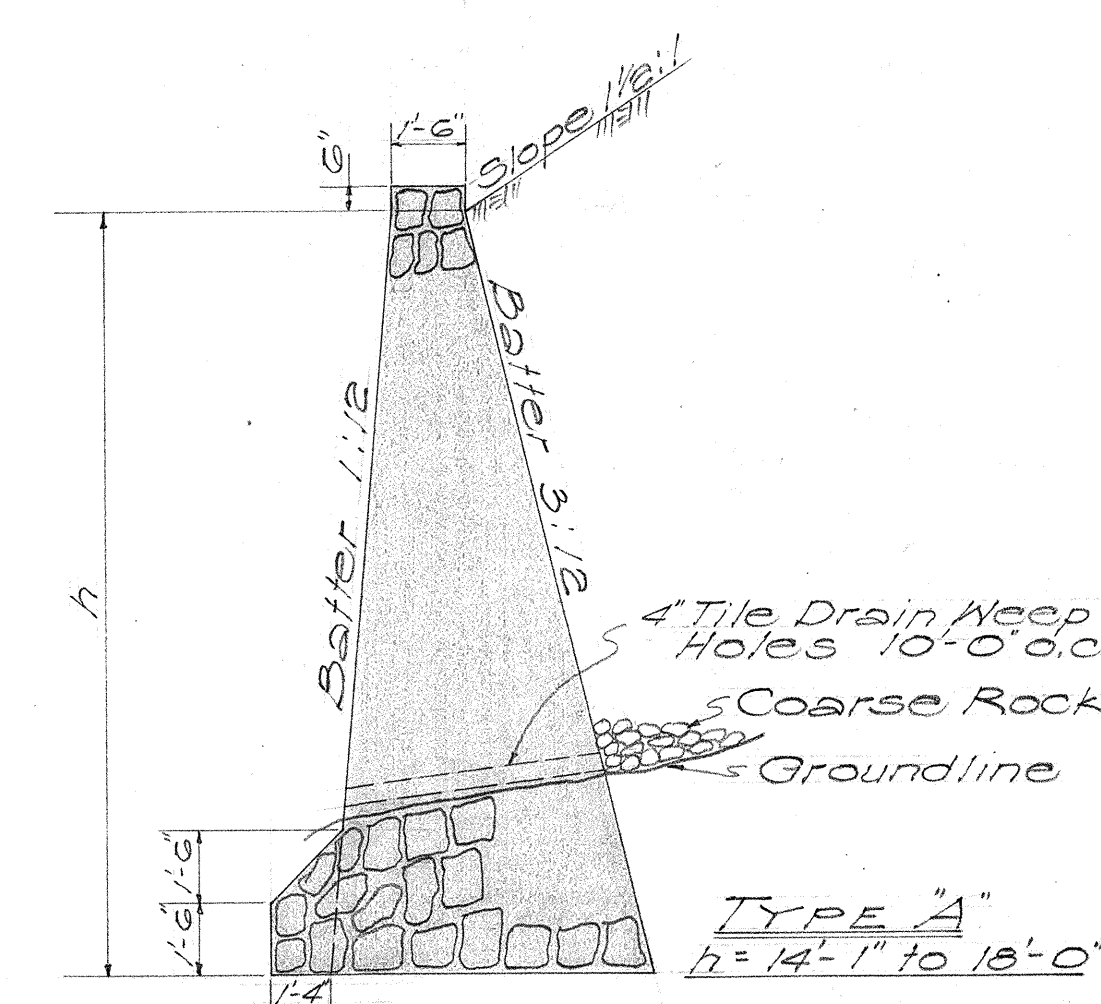

TERRITORIAL HIGHWAY DEPARTMENT
TERRITORY OF HAWAII
CEMENT RUBBLE MASONRY WALL
HAWAII BELT ROAD
Sta. 47+00 to Sta. 49+60
Sta. 76+35 to Sta. 77+35
Proj. No. SDR 3 (17)

Scales: As Noted July 1952

SHEET NO. OF SHEETS

5607.14

DESIGNED BY	DATE
TRACED BY	
QUANTITIES BY	
CHECKED BY	
NOTE BOOK NO.	