


INDEX TO DRAWINGS	
SHEET	DESCRIPTION
1	TITLE SHEET
2	TYPICAL SECTION
3	BORROW PIT
4-7B	PLAN & PROFILE, TRAFFIC SIGNS
8	SOIL PROFILE
9-13	STANDARD DETAILS
14	C.R.M. WALL
15-25	BOX CULVERT DETAILS
26	STANDARD BRIDGE DETAILS
27-34	KILAUI BRIDGE CROSS SECTIONS

CONVENTIONAL SIGNS USED	
Centerline	155
Boundary Line	or,
Fences (Noted)	x x or,
Existing Roadway	
Box Culvert	
Circular Culvert	
Bridge	
Railroad	or,
Tree (Large)	or,
Telephone Pole	OTP
Electric Line Pole	XEP
Water Main	W4 Ws
Water Valve	XWV
Water Valve Manhole	WVH
Storm Drain Manhole	DMH
Sewer Manhole	SMH
Fire Hydrant	FH
Warning & Regulatory Signs	Type
Centerline Monuments	©

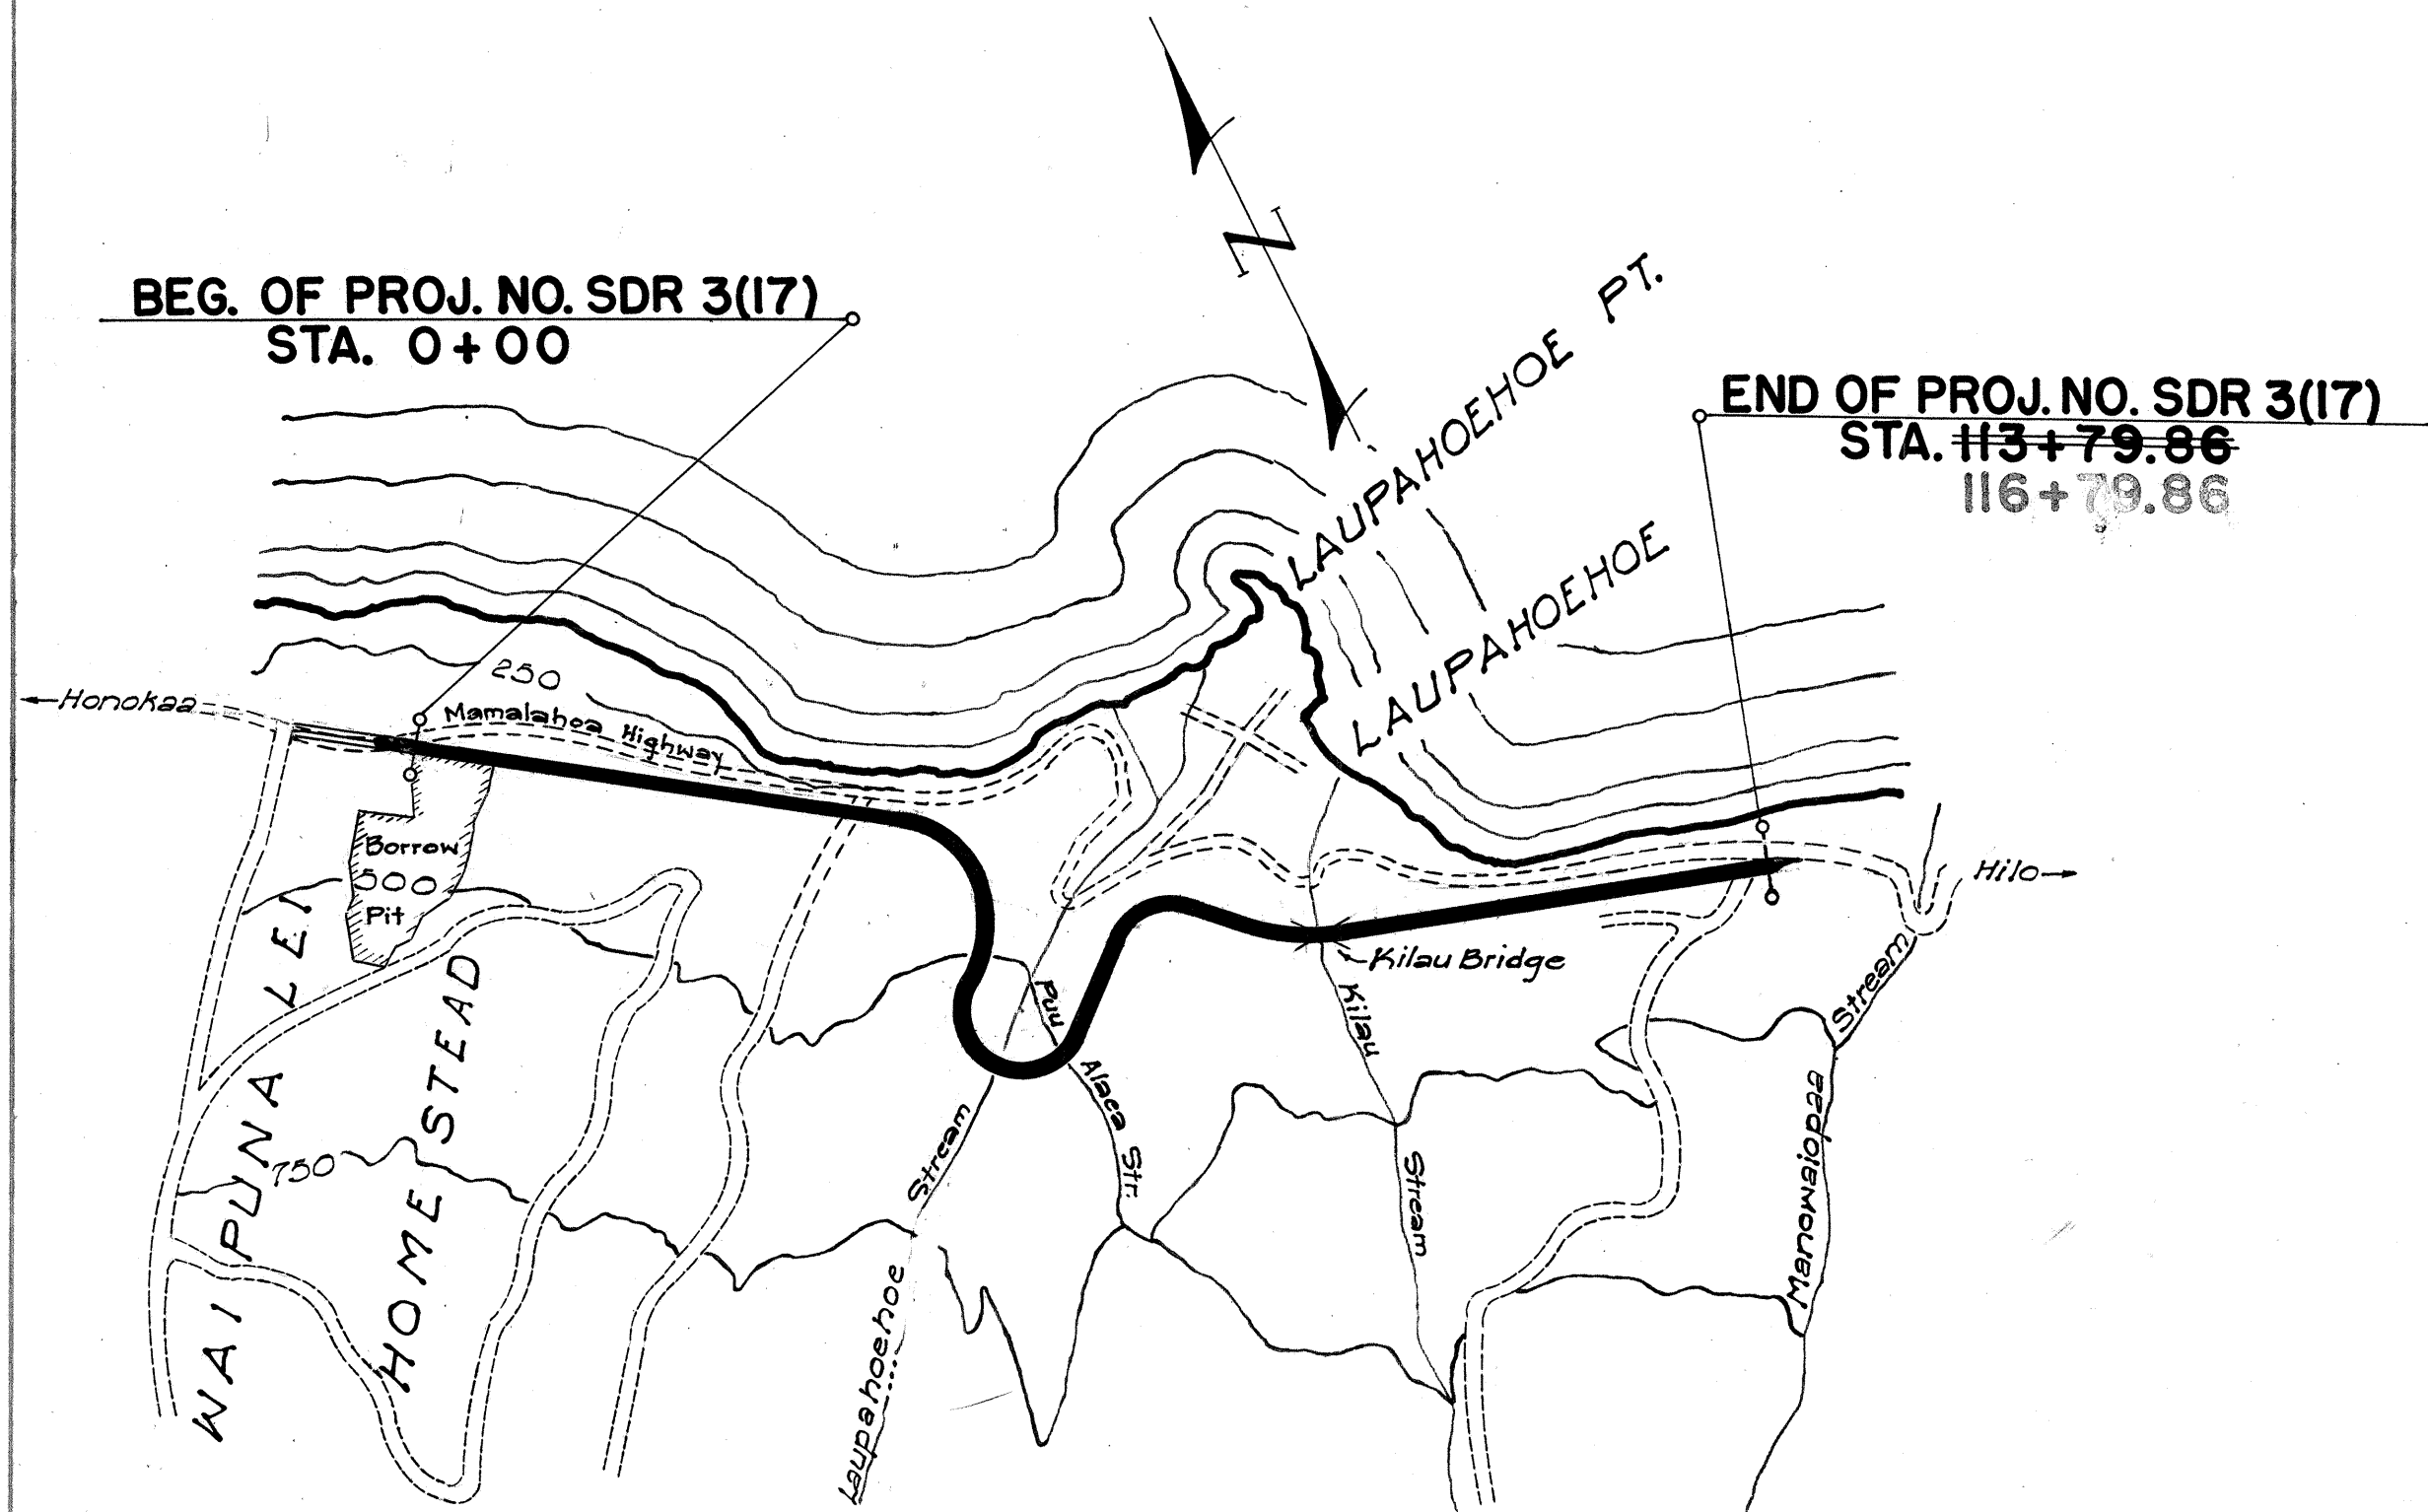


LAYOUT OF PROJECT
SCALE: 1:15,625

GROSS LENGTH OF PROJECT = 2.212 MILES
BRIDGES OVER 20'-0" SPAN = 0.043 MILE
NET LENGTH OF ROADWAY = 2.169 MILES

TERRITORY OF HAWAII
TERRITORIAL HIGHWAY DEPARTMENT
HONOLULU T.H.

PLANS OF
HAWAII BELT ROAD
SEISMIC WAVE DAMAGE REHABILITATION PROJECT NO. S.D.R. 3(17)
DISTRICT OF NORTH HILO
ISLAND OF HAWAII

SCALES	
PLAN	1 INCH = 100 FT.
PROFILE	HOR. 1 INCH = 100 FT. VER. 1 INCH = 10 FT.
CROSS SECTION	HOR. 1 INCH = 10 FT. VER. 1 INCH = 10 FT.

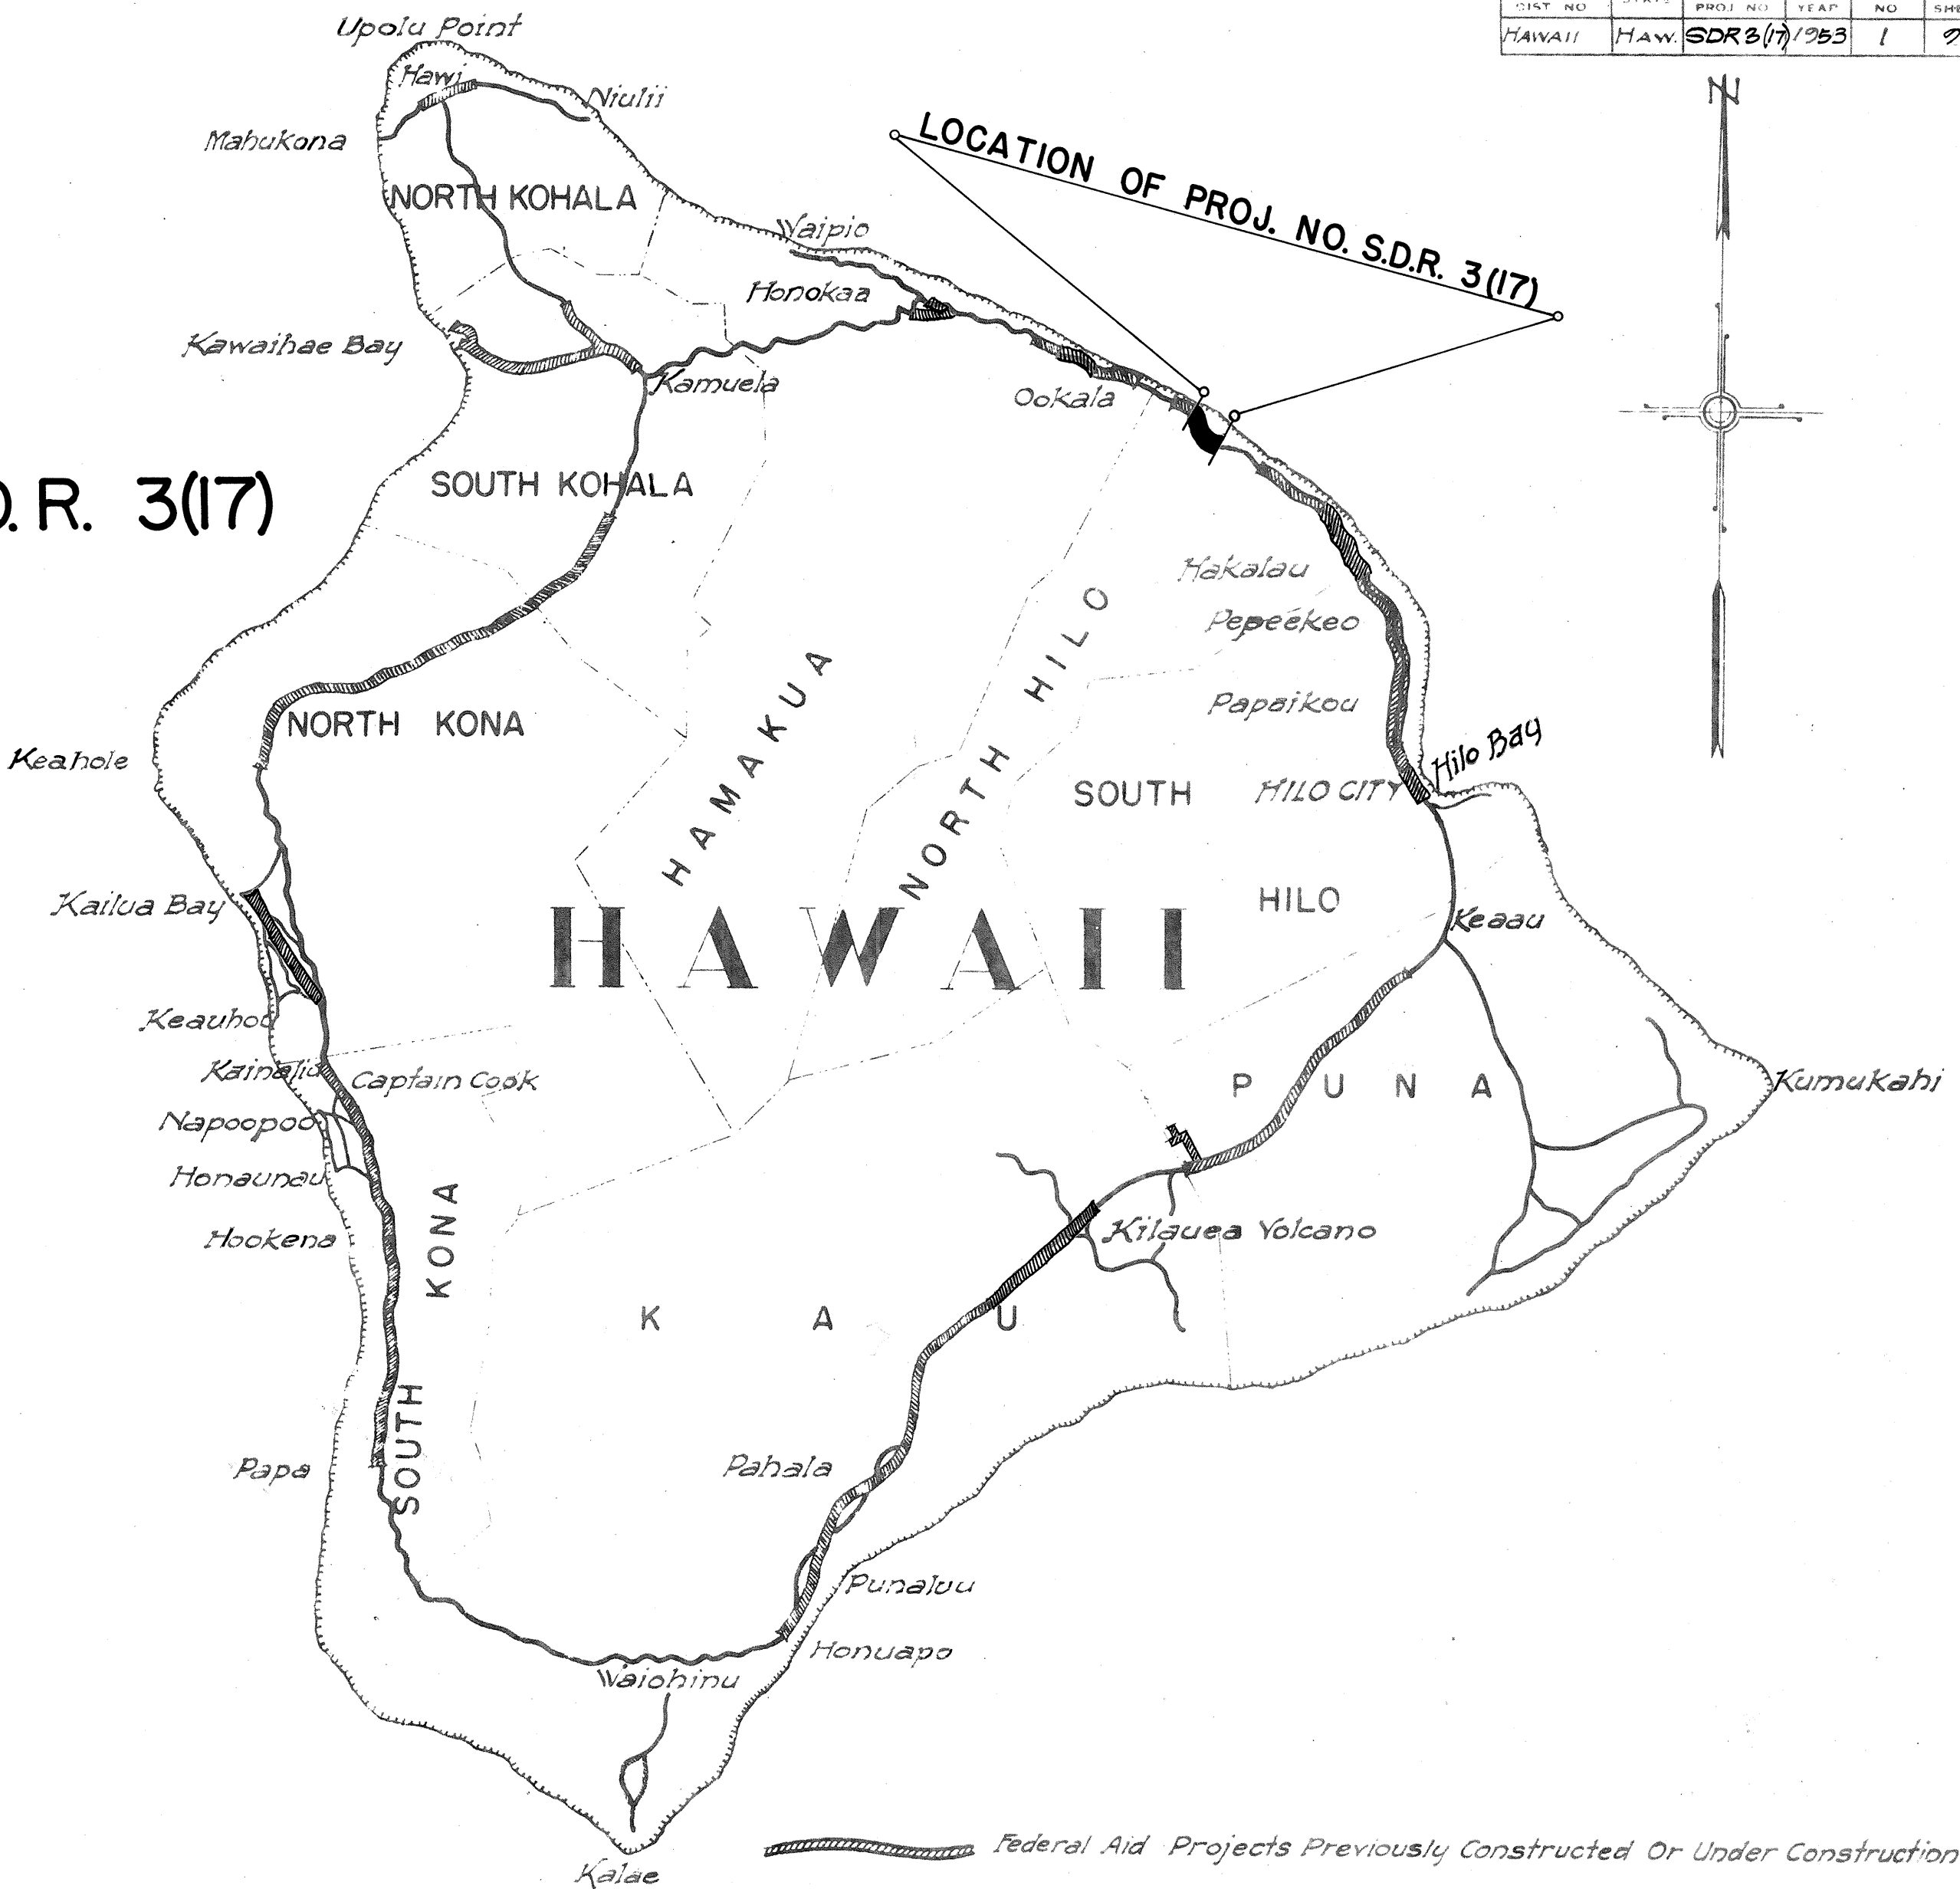

NOTE:
ALL CHANGES MADE DURING CONSTRUCTION
HAVE BEEN NOTED IN RED IN THESE
TRACINGS AND CHECKED BY
Charles A. [Signature]
PROJECT ENGINEER
1/10/55
DATE

APPROVED: *[Signature]* DATE 4/29/53
TERRITORIAL HIGHWAY ENGINEER

DEPARTMENT OF COMMERCE BUREAU OF PUBLIC ROADS	
RECOMMENDED FOR APPROVAL:	
DISTRICT ENGINEER	DATE
APPROVED:	
DIVISION ENGINEER	DATE