


FED. ROAD DIST. NO.	STATE	FED. AID PROJ. NO.	FISCAL YEAR	SHEET NO.	TOTAL SHEETS
Hawaii	Haw.	SDP3(5)	1955	3	46

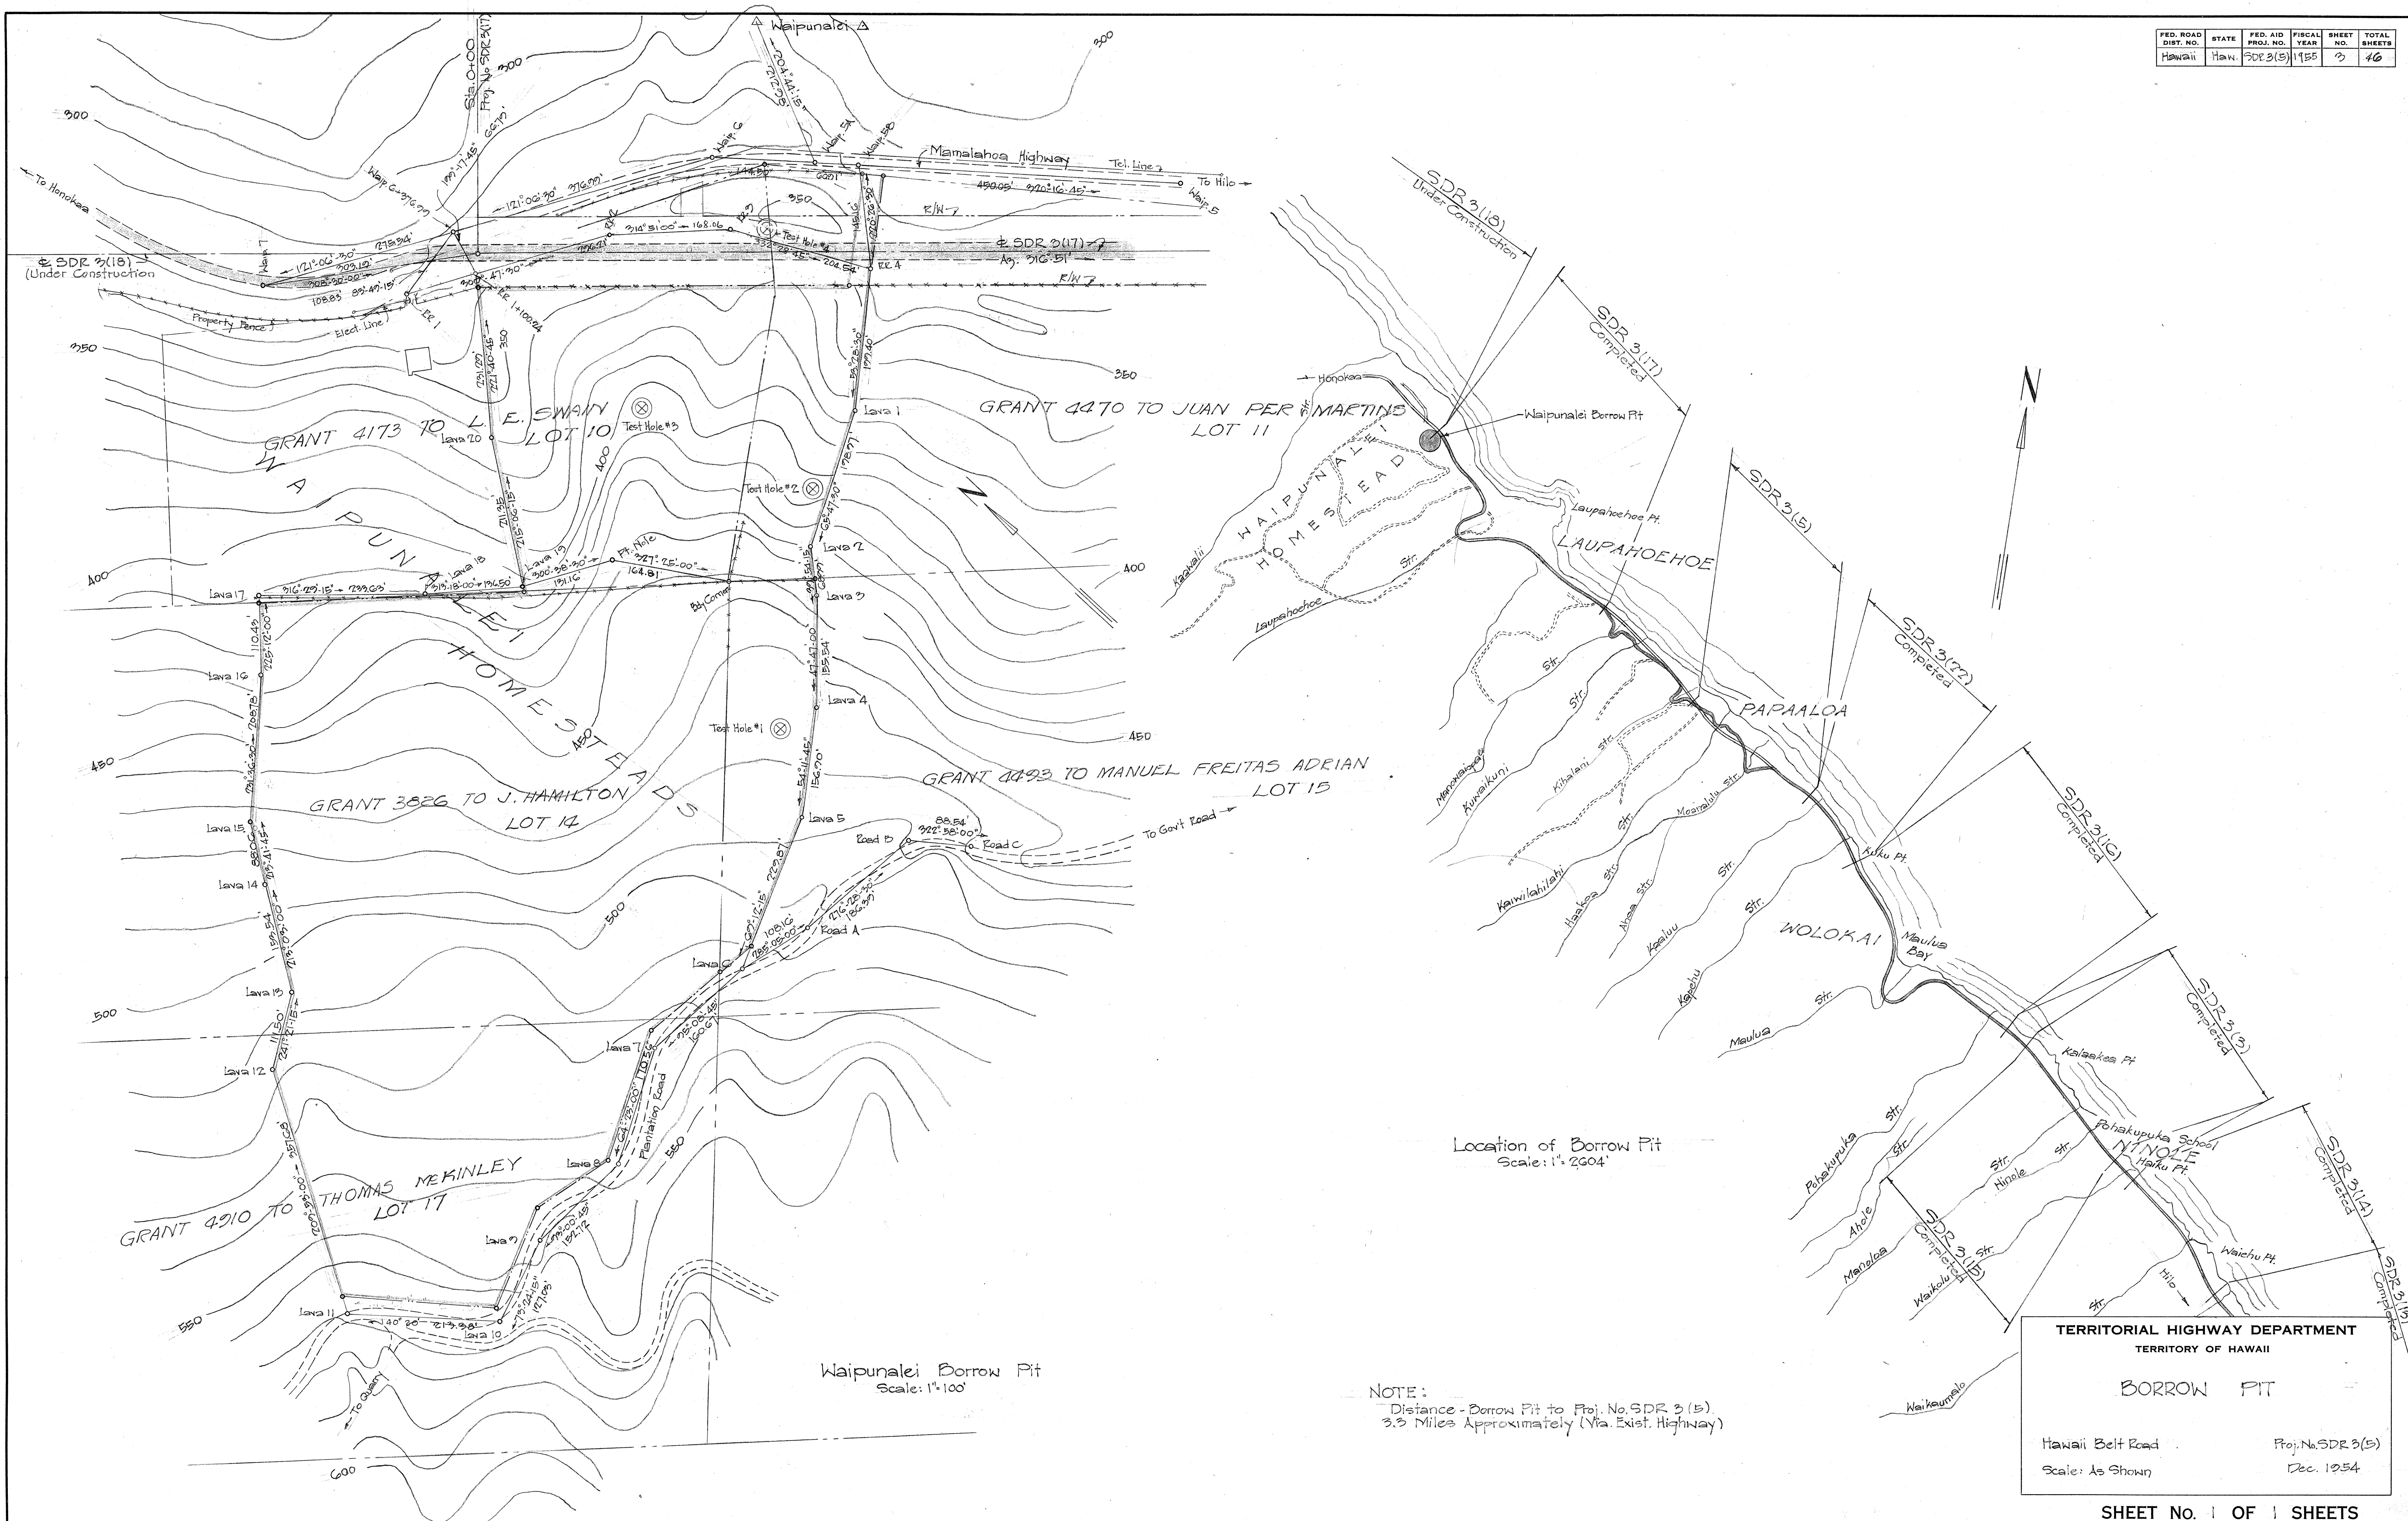

ORIGINAL PLAN	SURVEY PLOTTED BY _____	DATE _____
NOTE BOOK No. _____	DRAWN BY _____	_____"
	DESIGNED BY _____	_____"
	TRACED BY _____	_____"
	QUANTITIES BY _____	_____"
	QUANTITIES CHECKED BY _____	_____"
	CHECKED BY _____	_____"