



PLAN	SURVEYED	DATE
NOTE BOOK	BY	
NO.		


PROFILE	SURVEYED	DATE
NOTE BOOK	BY	
NO.		

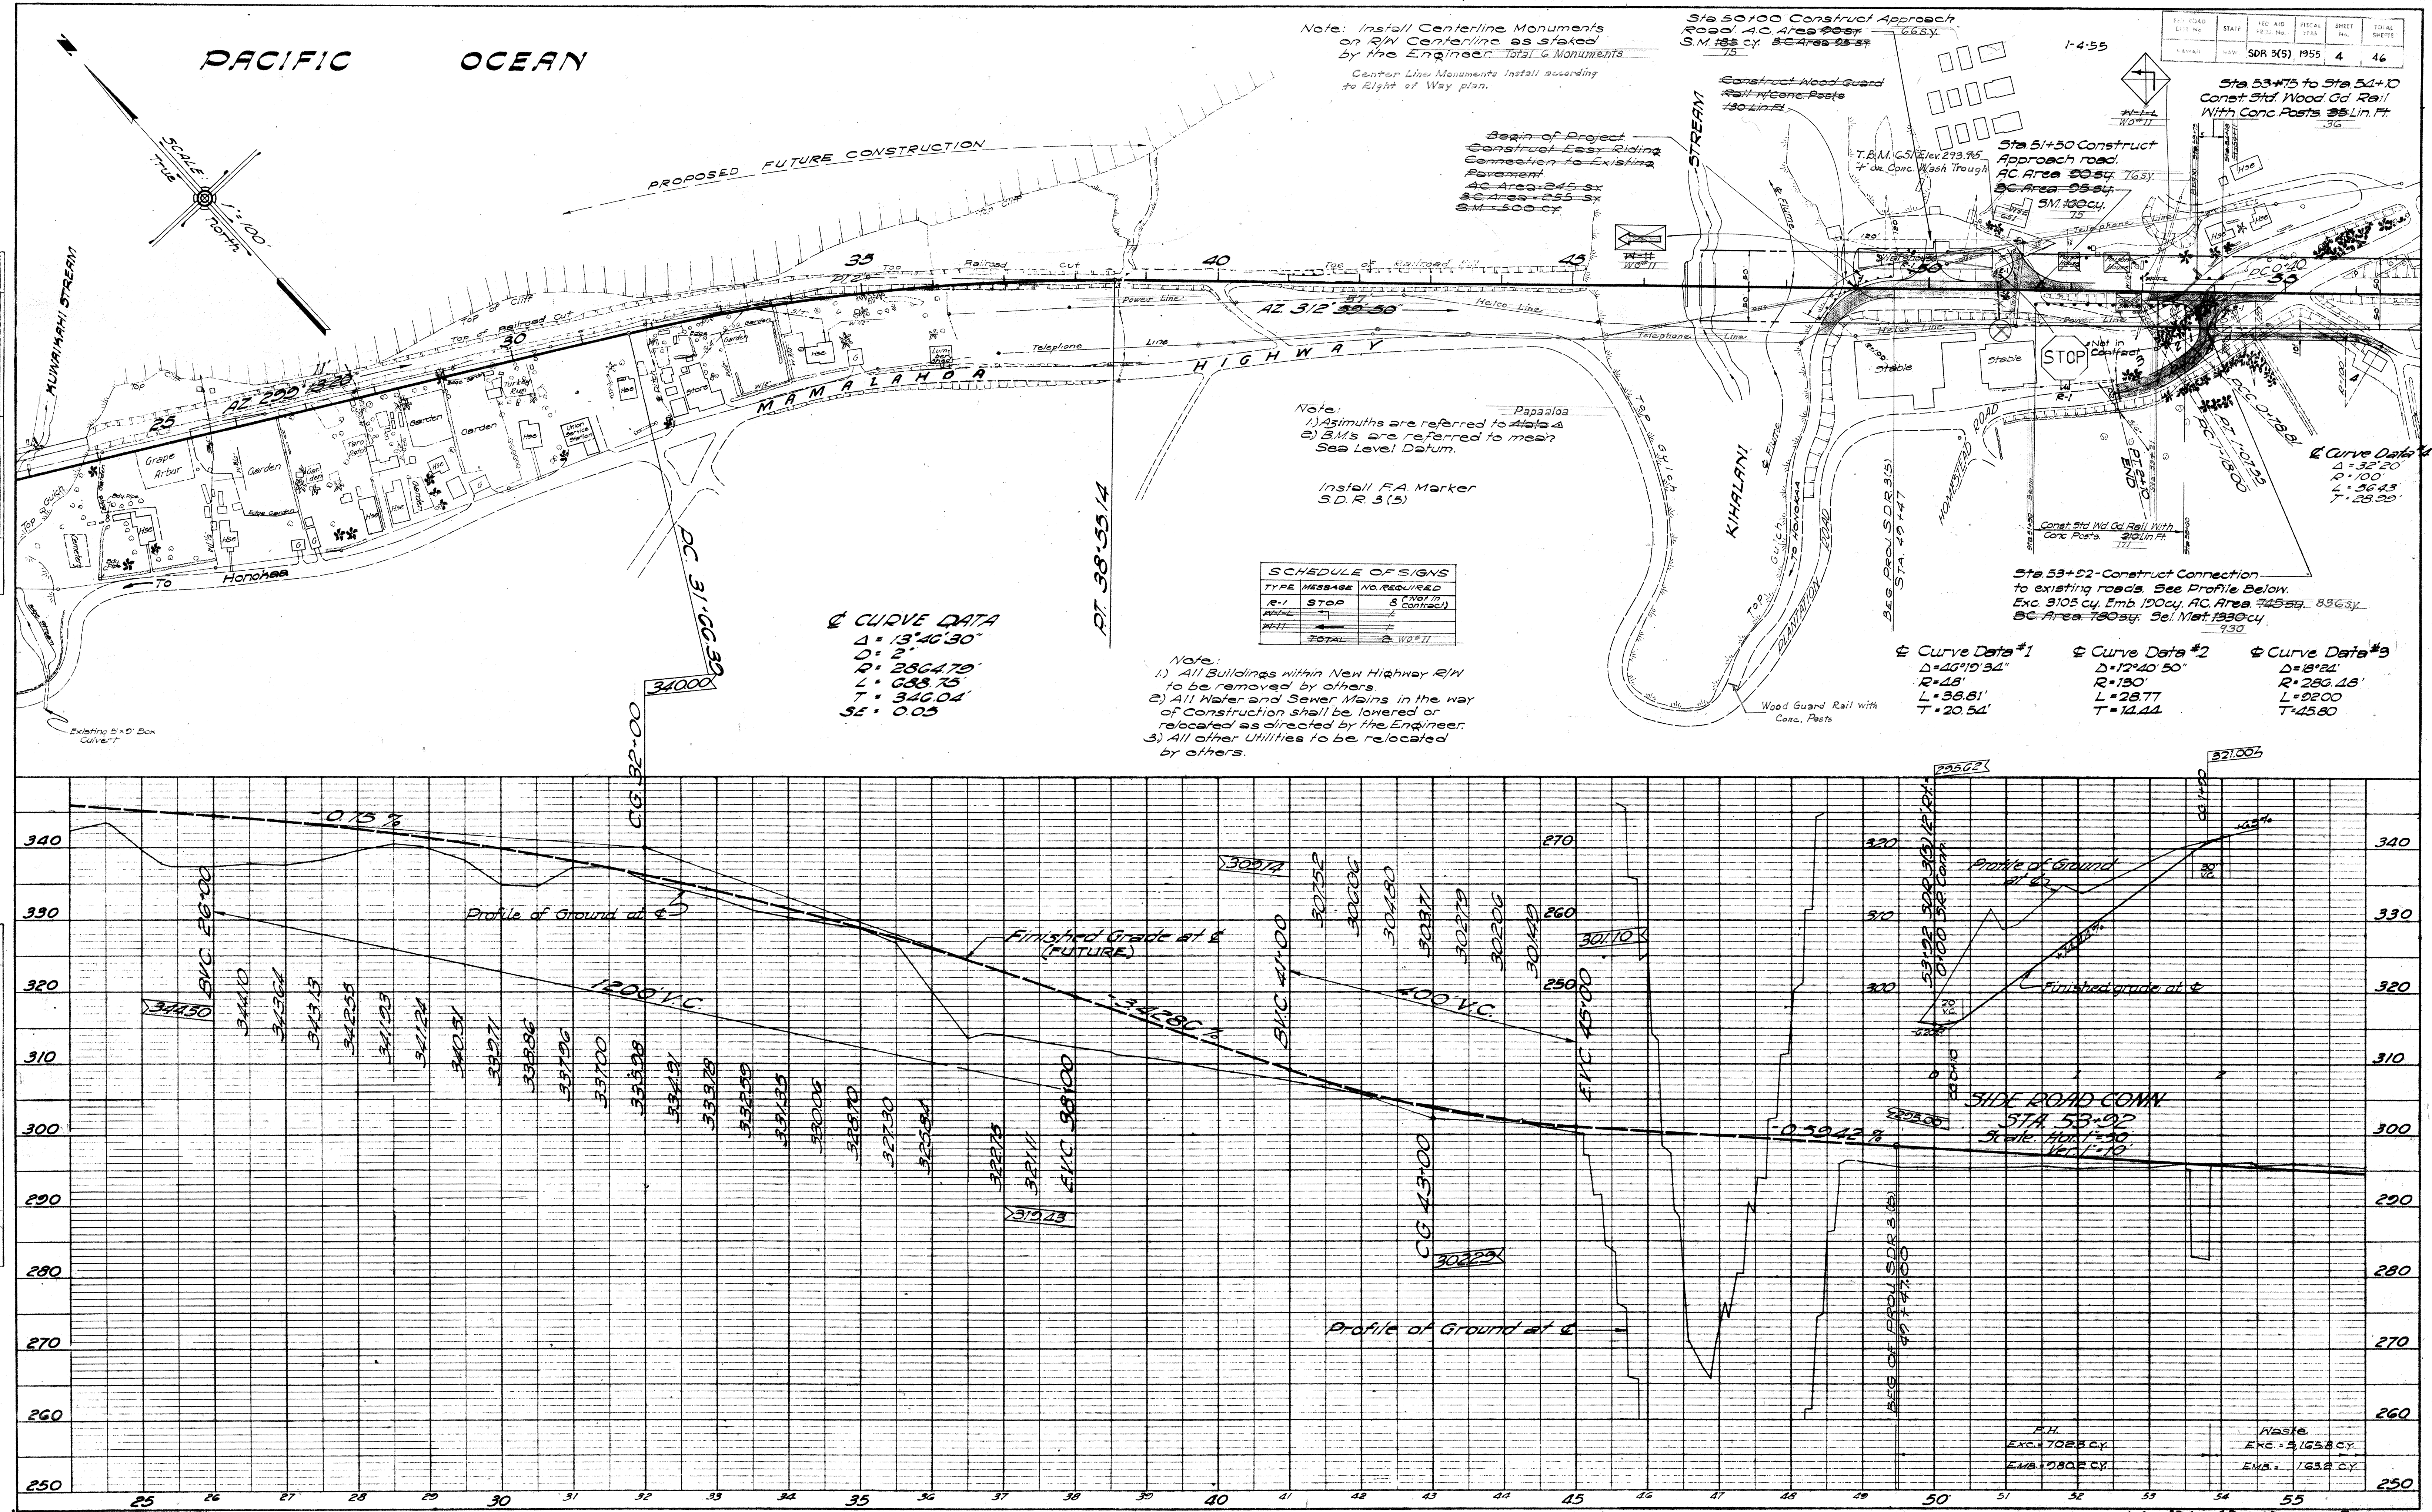

PROFILE	SURVEYED	BY	DATE
NOTE BOOK	PLOTTED		
	GRADES CHECKED		
	B. M.'S. NOTED		
NO.	STRUCTURE NOTATIONS CH'KD.		

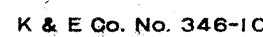

5 7 2 2 5

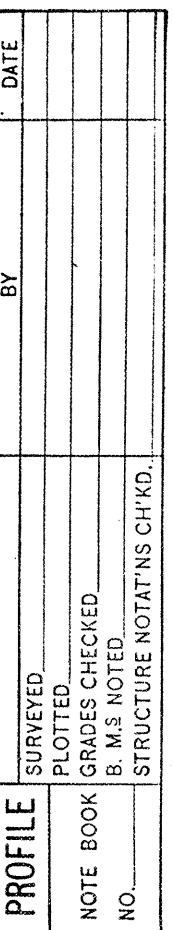[illegible]

5 7 2 2 . 6