

INDEX TO DRAWINGS	
SHEET	DESCRIPTION
1	TITLE SHEET
2	TYPICAL SECTION
3	BORROW PIT LOCATION
4-6	PLAN & PROFILE
7	SOIL PROFILE
8	INTERSECTION DETAIL
9-12	STANDARD DETAILS
13-14	5'-X-5' FLUME CULVERT DETAILS DELETED 2-4-55
15	STANDARD BRIDGE DETAILS
16-24	KAIWILAHILAHI BRIDGE
25-34	MOANALULU BRIDGE
35-45	CROSS SECTIONS
46	SEWER LINE RELOCATION

TERRITORY OF HAWAII

TERRITORIAL HIGHWAY DEPARTMENT

HONOLULU T.H.

PLANS OF

HAWAII BELT ROAD


SEISMIC WAVE DAMAGE REHABILITATION PROJ. NO. S.D.R. 3 (5)

DISTRICT OF NORTH HILO

ISLAND OF HAWAII

SCALES


PLAN	-----	1 INCH = 100 FT.
PROFILE	-----	HOR. 1 INCH = 100 FT.
		VER. 1 INCH = 10 FT.
CROSS SECTION	-----	HOR. 1 INCH = 10 FT.
		VER. 1 INCH = 10 FT.

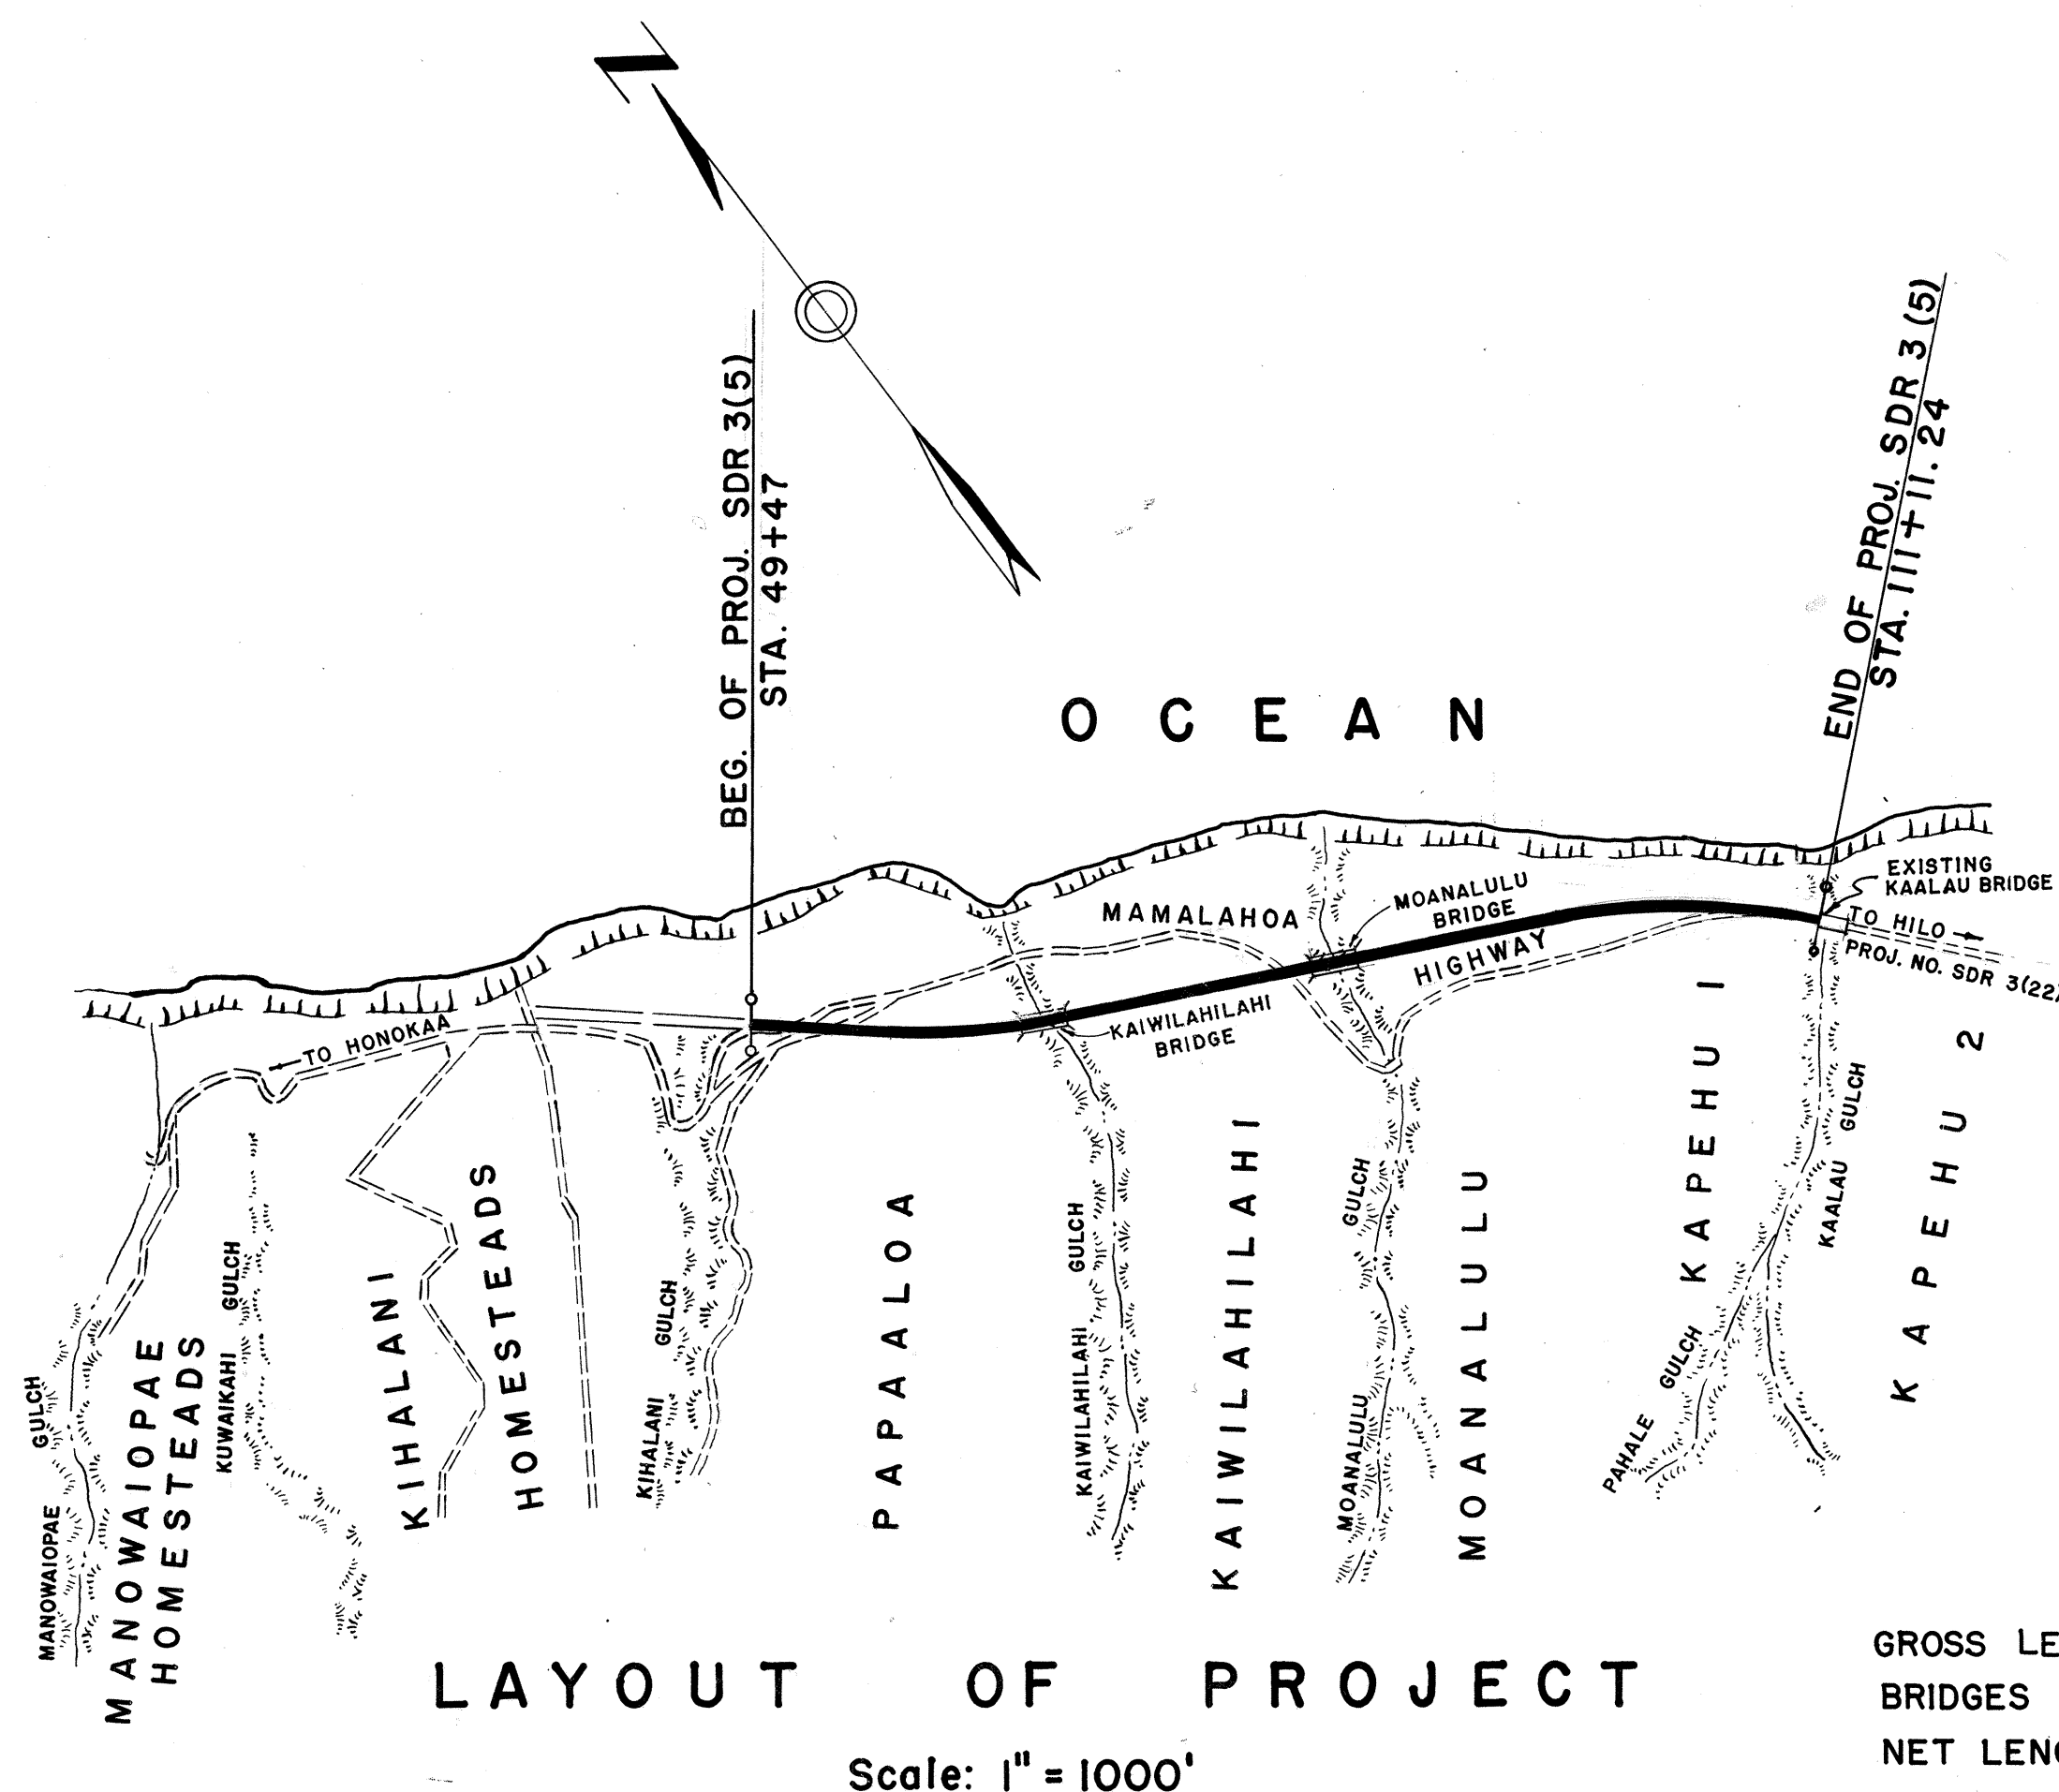

GROSS LENGTH OF PROJ. 1.167 MILES

BRIDGES OVER 20'-0" SPAN 0.088 MILE

NET LENGTH OF ROADWAY 1.079 MILES

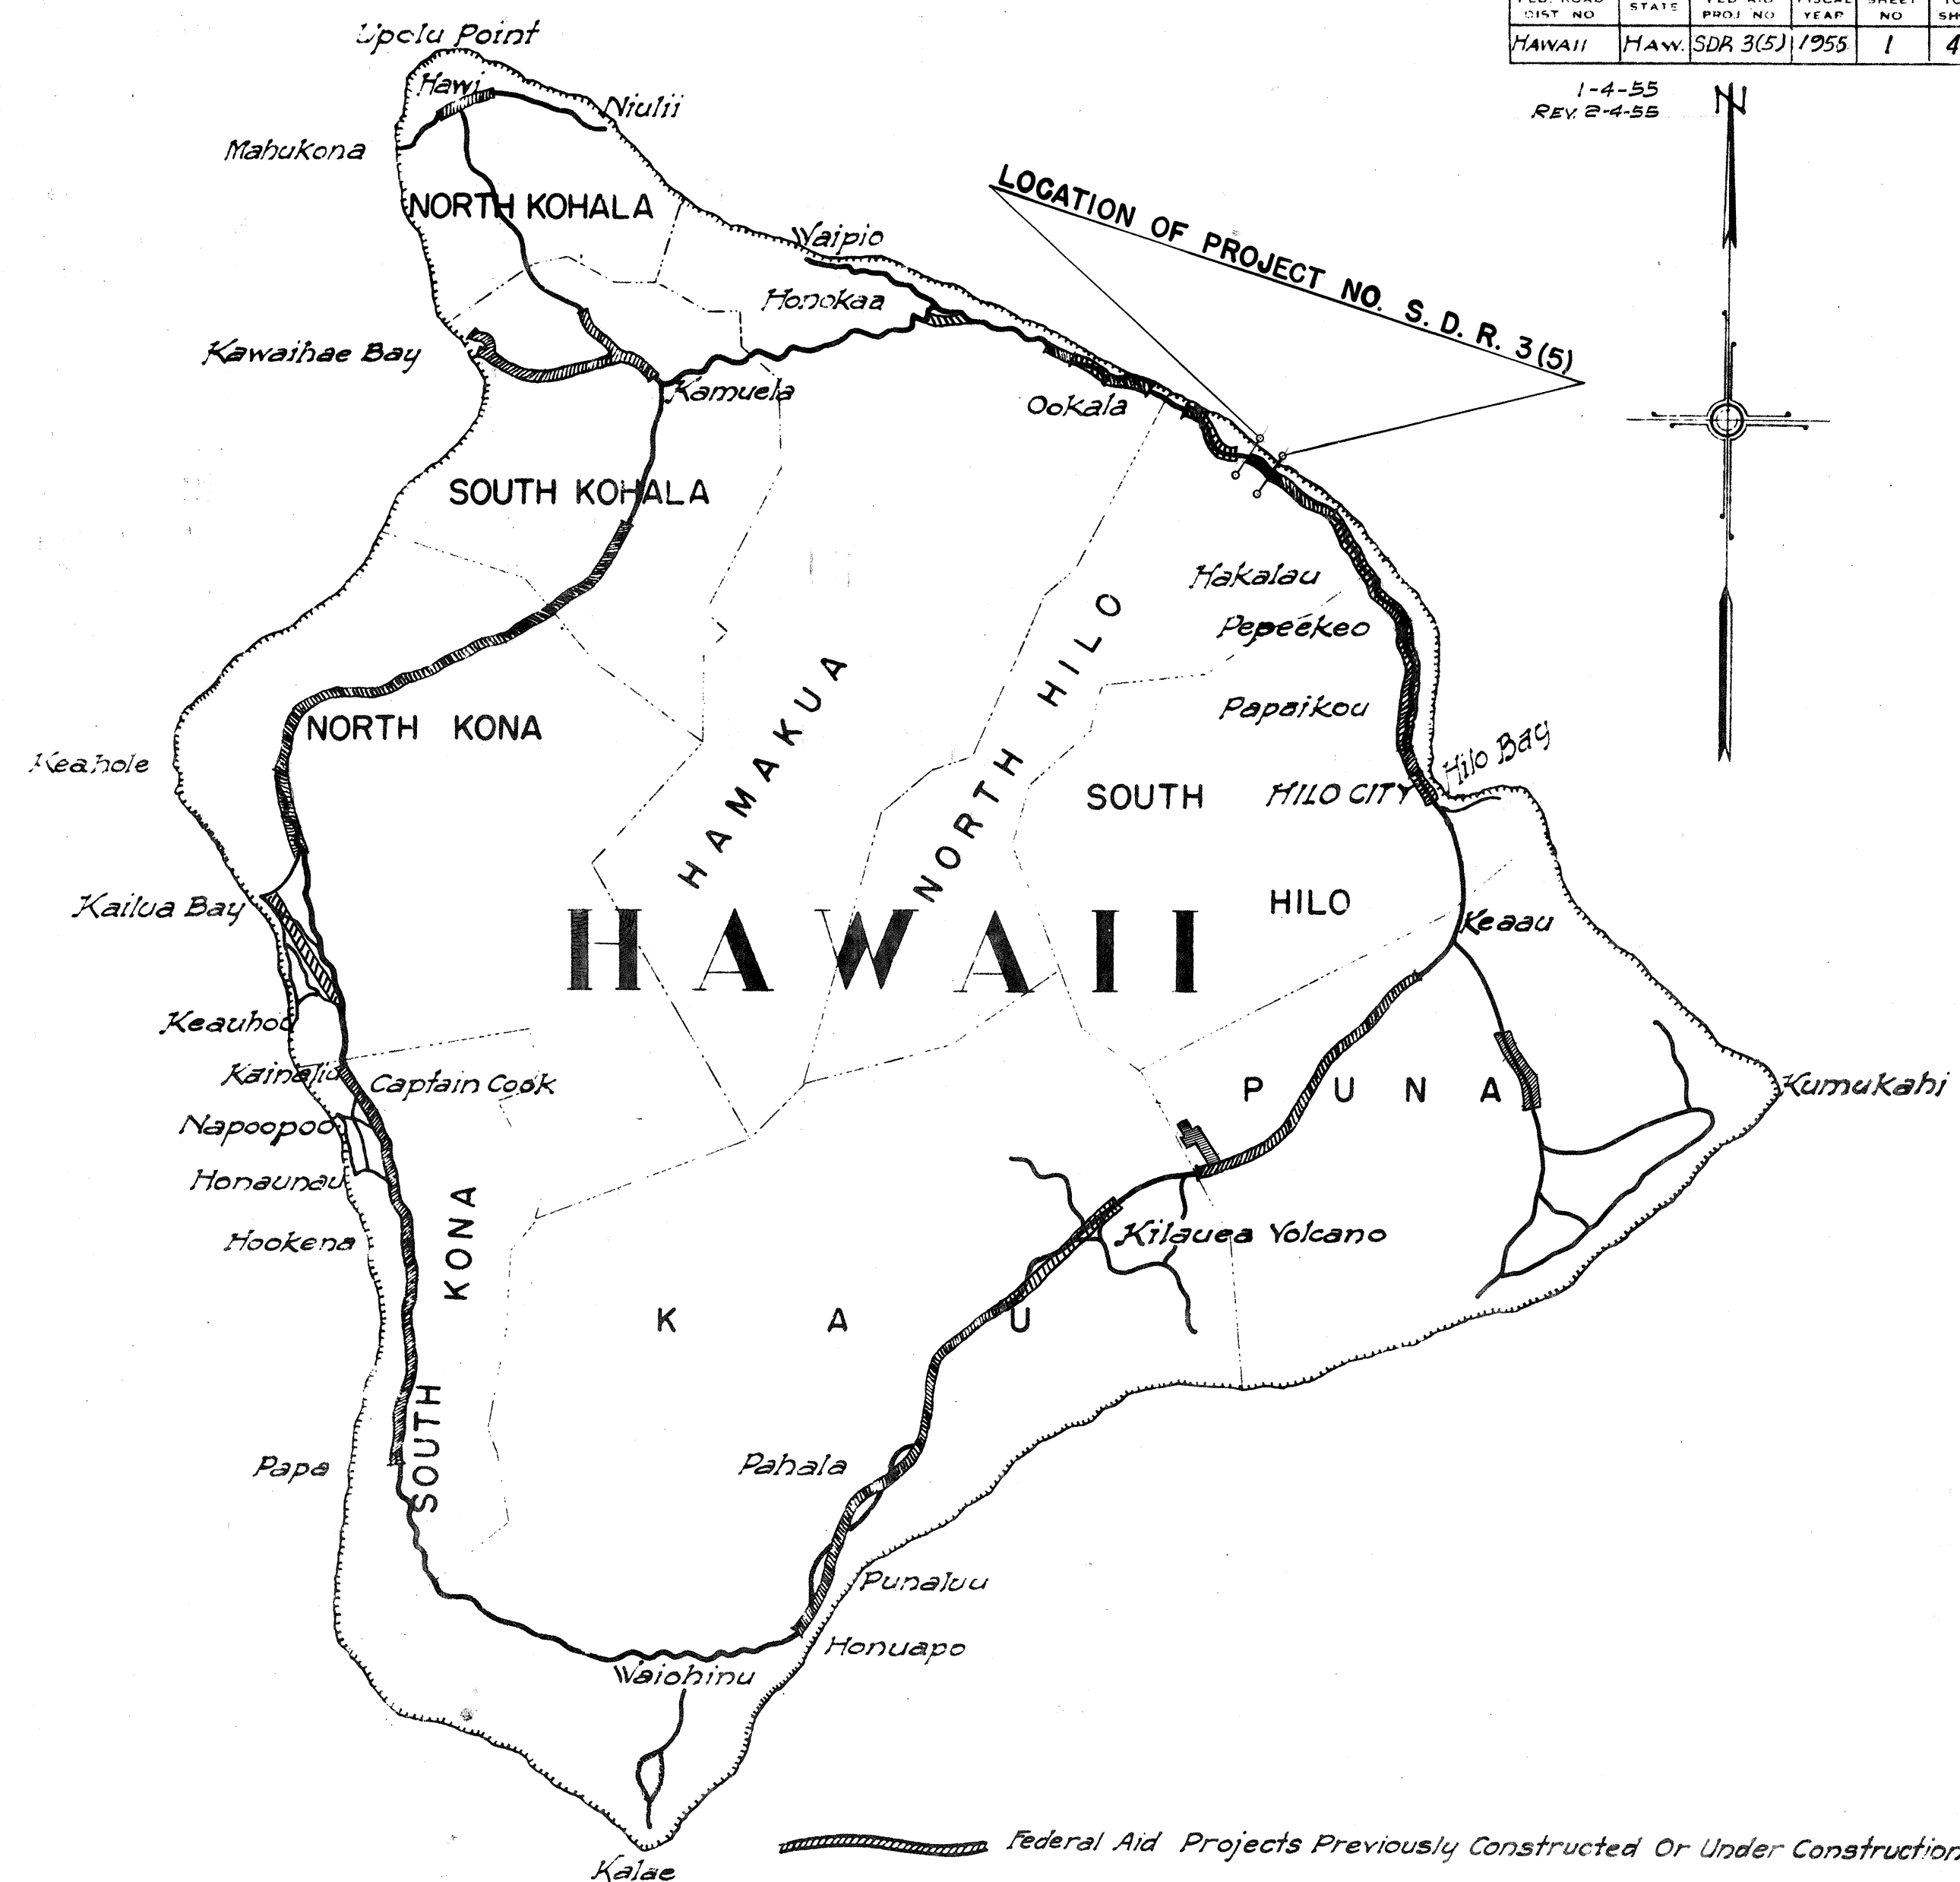

NOTE:

ALL CHANGES MADE DURING CONSTRUCTION

HAVE BEEN NOTED IN RED ON THESE

TRACINGS AND CHECKED BY:

E.C. Moon

PROJECT ENGINEER

9-6-56

DATE

APPROVED: DATE 12-23-54

B.W.E. Mitter

TERRITORIAL HIGHWAY ENGINEER

DEPARTMENT OF COMMERCE

BUREAU OF PUBLIC ROADS

APPROVED:

DISTRICT ENGINEER

DATE

FED. ROAD DIST. NO.	STATE	FED. AID PROJ. NO.	FISCAL YEAR	SHEET NO.	TOTAL SHEETS
HAWAII	HAW.	SDR 3(5)	1955	1	46

1-4-55

REV. 2-4-55