
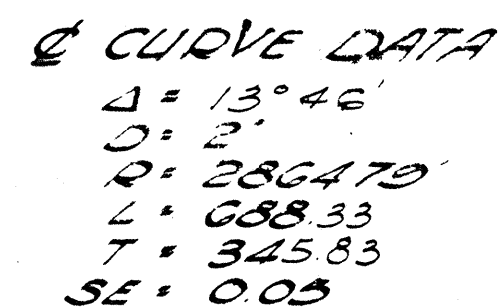


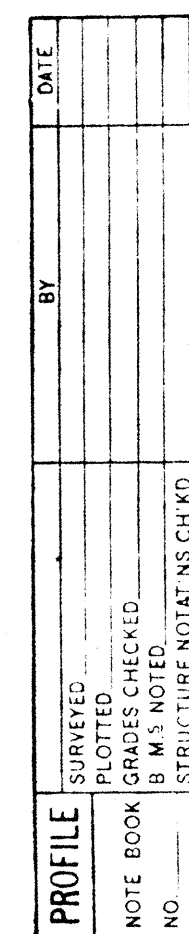

NOTE:

- 1- All Utilities to be relocated by others.
- 2- Azimuths are referred to "Papagosa" Δ
- 3- B.M.'s are referred to Mean Sea Level Datum.
- 4- Install & Mon. on R/W Centerline as sketched by the Engineer

Install F.A. Marker
F-SPR-019-2(1)

Install Additional Number
Plate F-SDR-010-2(1)

