

INDEX TO DRAWINGS	
SHEET	DESCRIPTION
1	TITLE SHEET
2	TYPICAL SECTION
3	BORROW PIT LOCATION
4	PLAN & PROFILE
5-7	STANDARD DETAILS
8-16	KIHALANI BRIDGE
17	STANDARD BRIDGE DETAILS
18	CROSS SECTIONS

TERRITORY OF HAWAII

TERRITORIAL HIGHWAY DEPARTMENT

HONOLULU T.H.

PLANS OF

HAWAII BELT ROAD

FEDERAL AID PROJECT F-SDR-019-2(I)

DISTRICT OF NORTH HILO

ISLAND OF HAWAII

PLAN

PROFILE

CROSS SECTION



1 INCH = 100 FT.

HOR. 1 INCH = 100 FT.

VER. 1 INCH = 10 FT.

HOR. 1 INCH = 10 FT.

VER. 1 INCH = 10 FT.

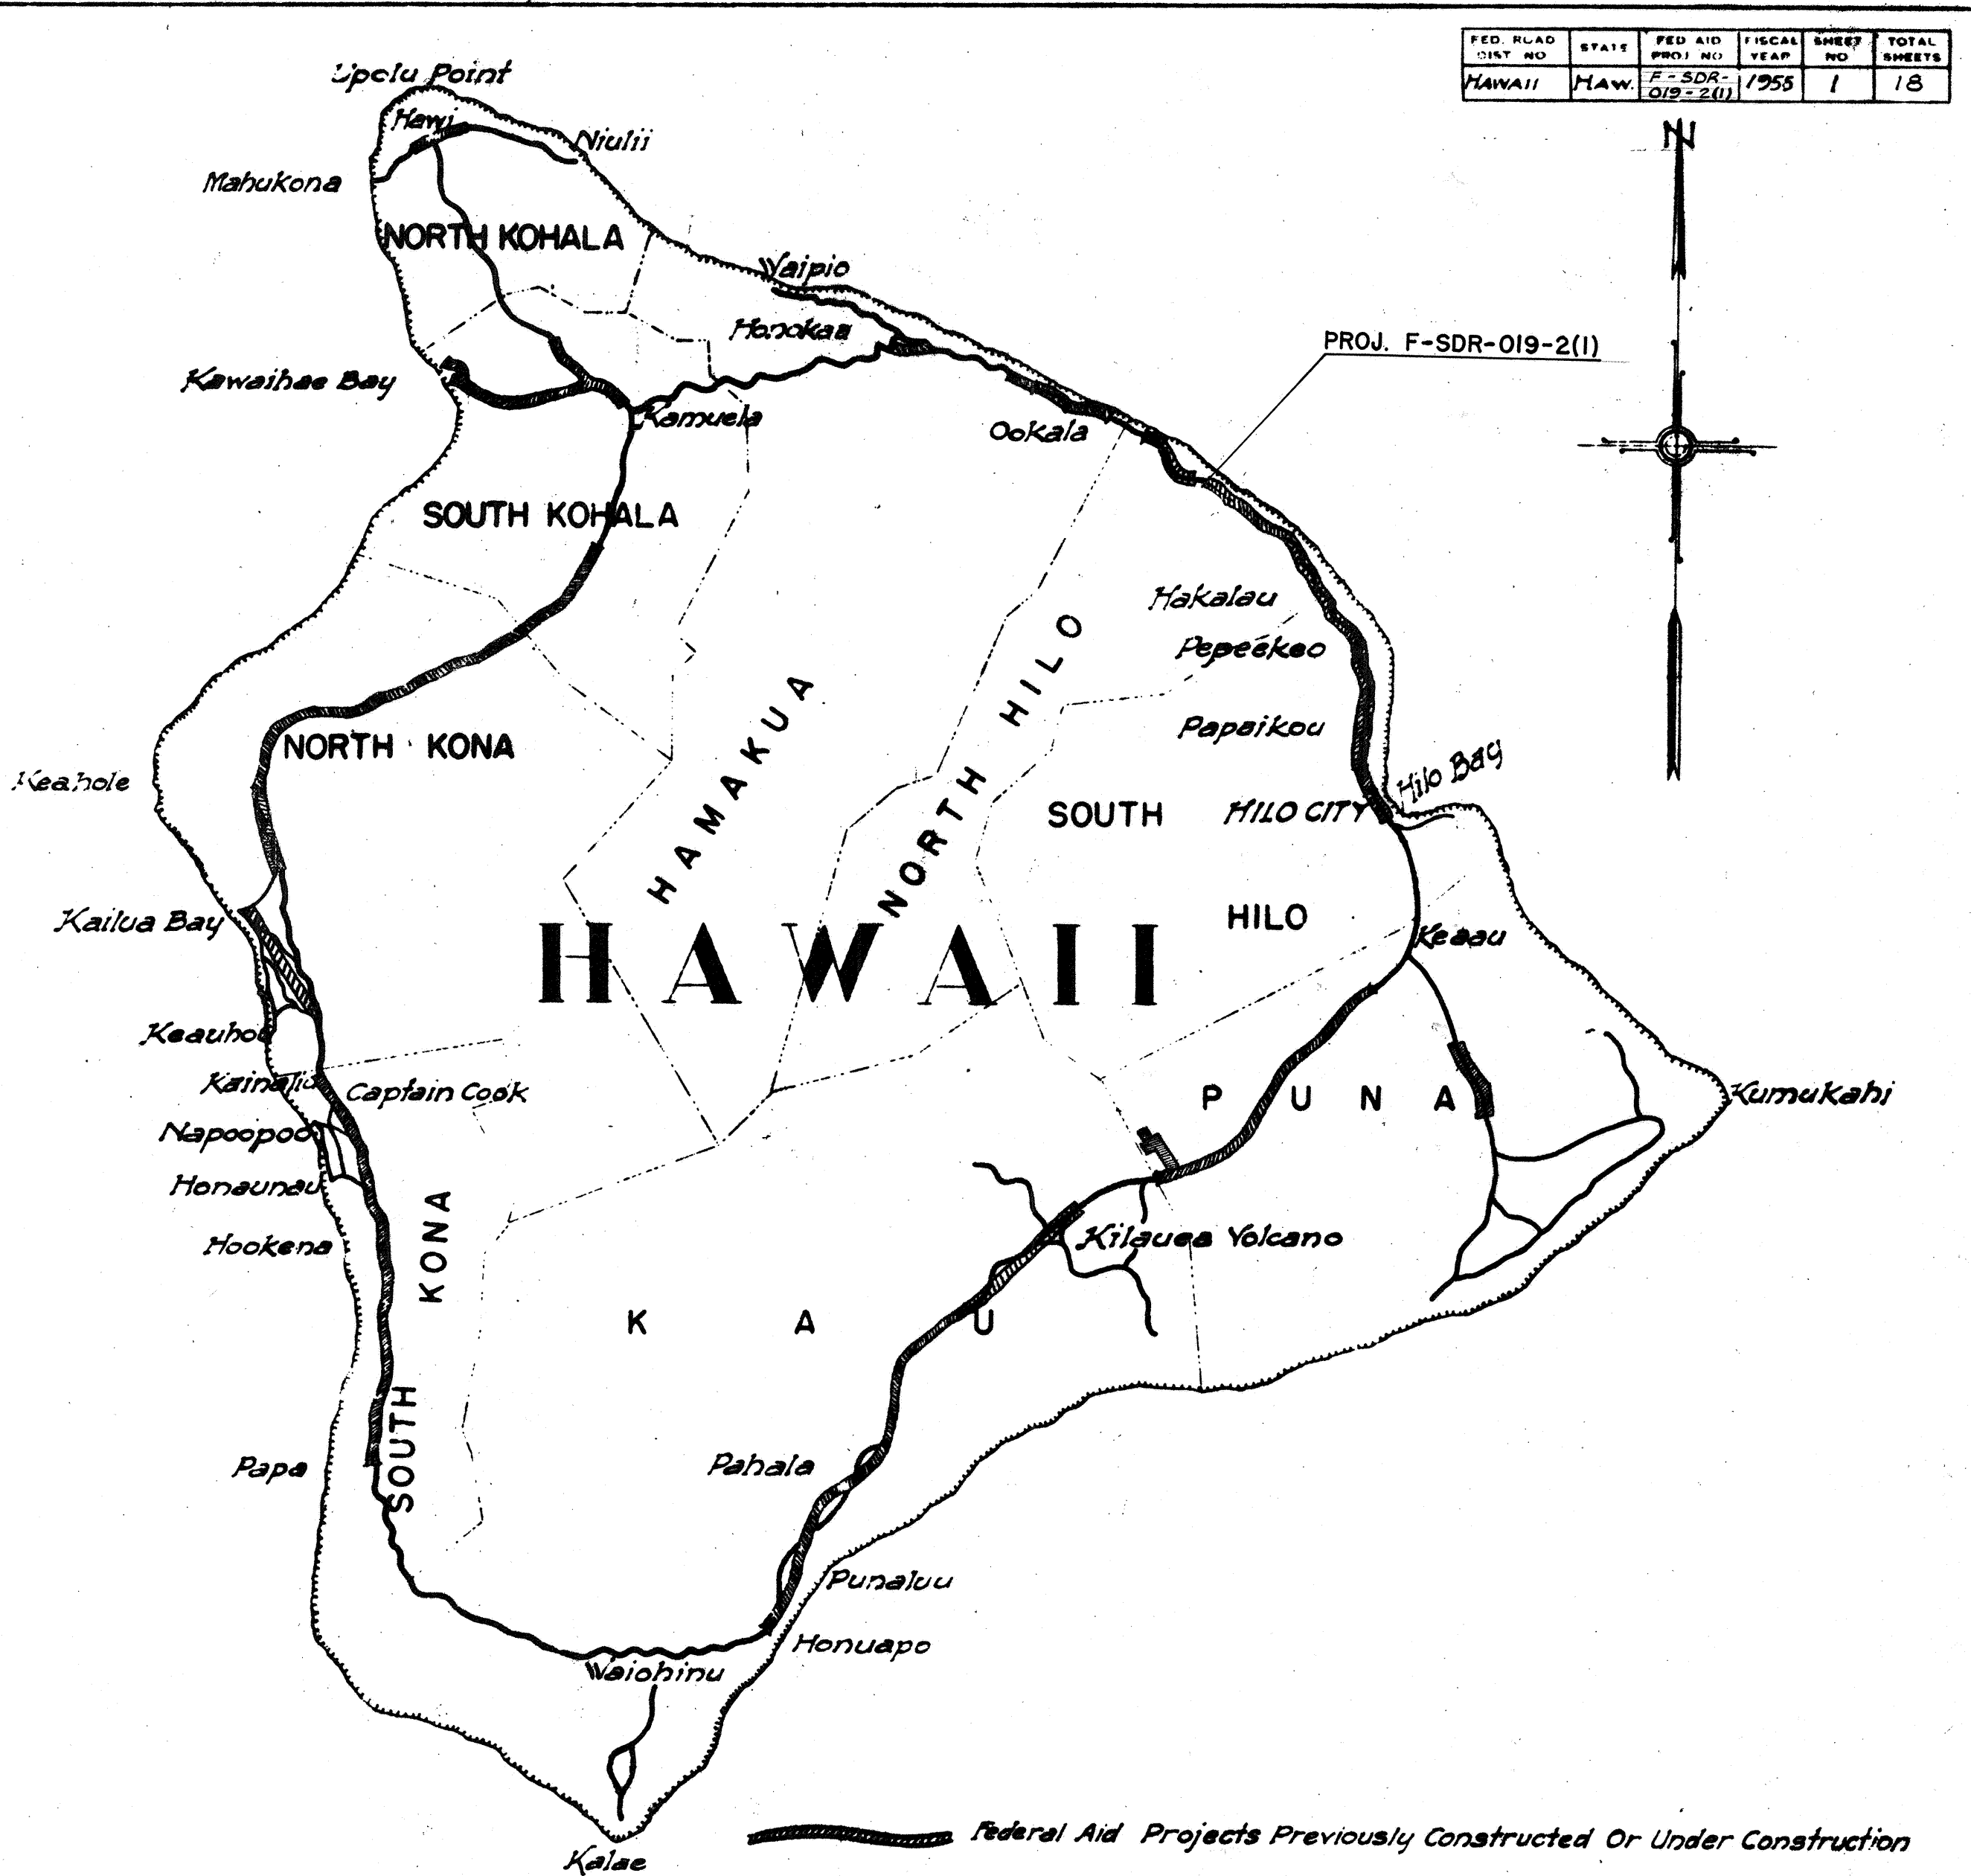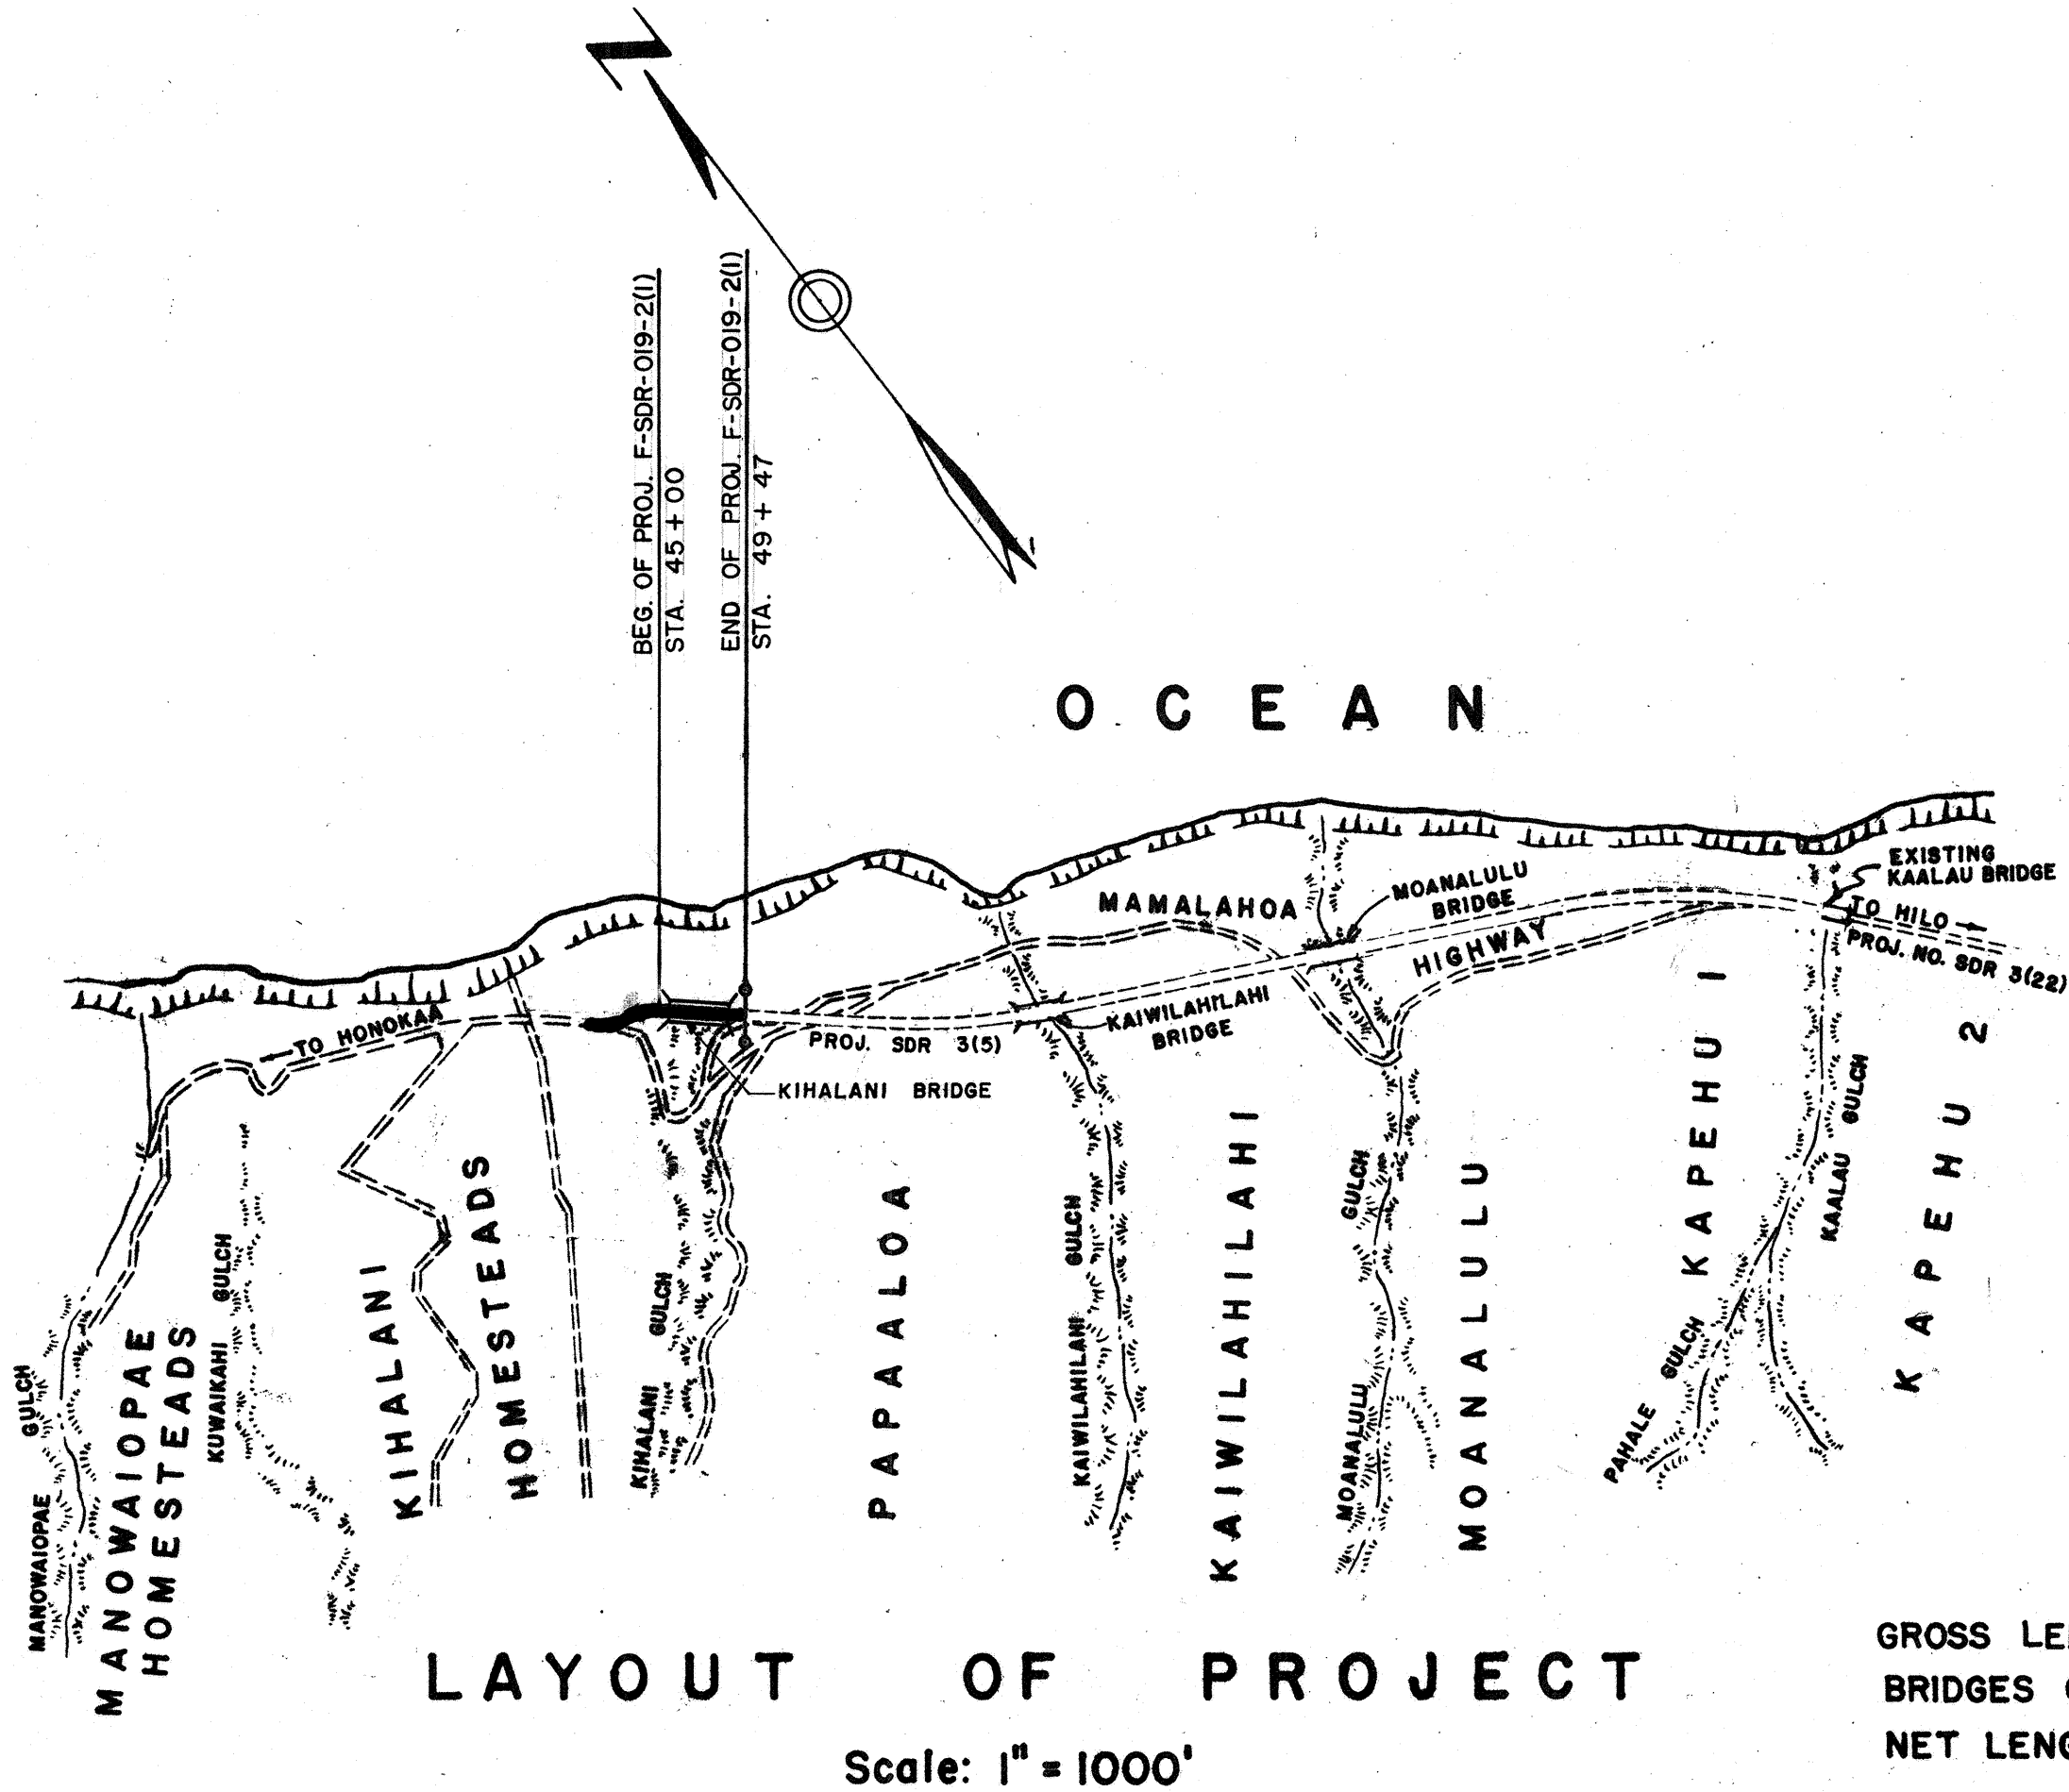

NOTE:

ALL CHANGES MADE DURING CONSTRUCTION

HAVE BEEN NOTED IN RED ON THESE

TRACINGS AND CHECKED BY:

PROJECT ENGINEER

DATE

APPROVED: DATE 7-13-55

TERRITORIAL HIGHWAY ENGINEER

DEPARTMENT OF COMMERCE

BUREAU OF PUBLIC ROADS

APPROVED:

DISTRICT ENGINEER DATE