



FED. ROAD DIST. NO.	STATE	FED. AID PROJ. NO.	FISCAL YEAR	SHEET NO.	TOTAL SHEETS
HAWAII	HAW.	F-019-2(3)	1956	10	45

JULY 17, 1956

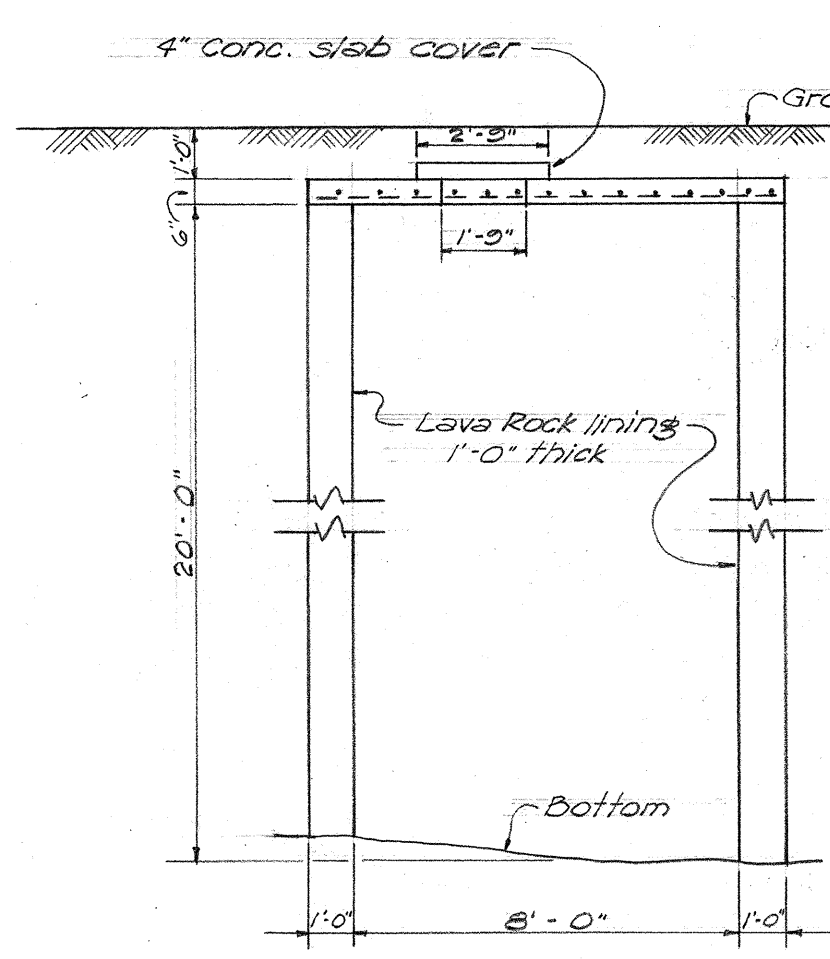

SECTION

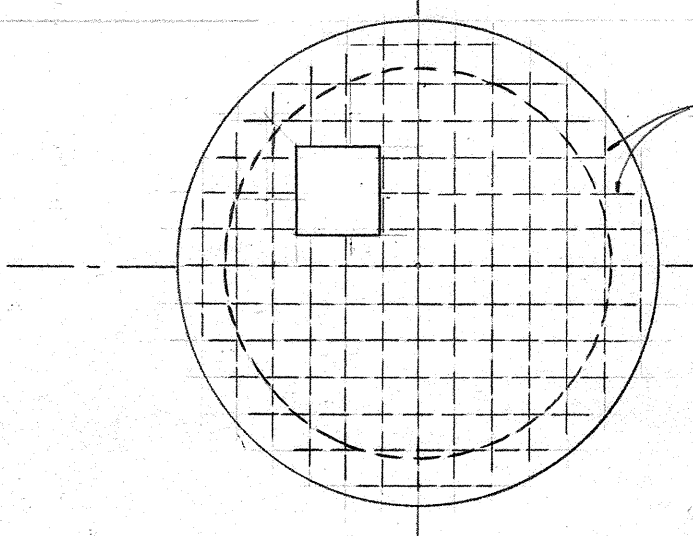


PLAN OF SLAB REINFORCING

NOTE:
Depth of cesspool to meet requirements of Territorial Board of Health.

CESSPOOL DETAILS

Scale: 1/4"=1'-0"

PROJ. F-019-2(3)
295° 11'

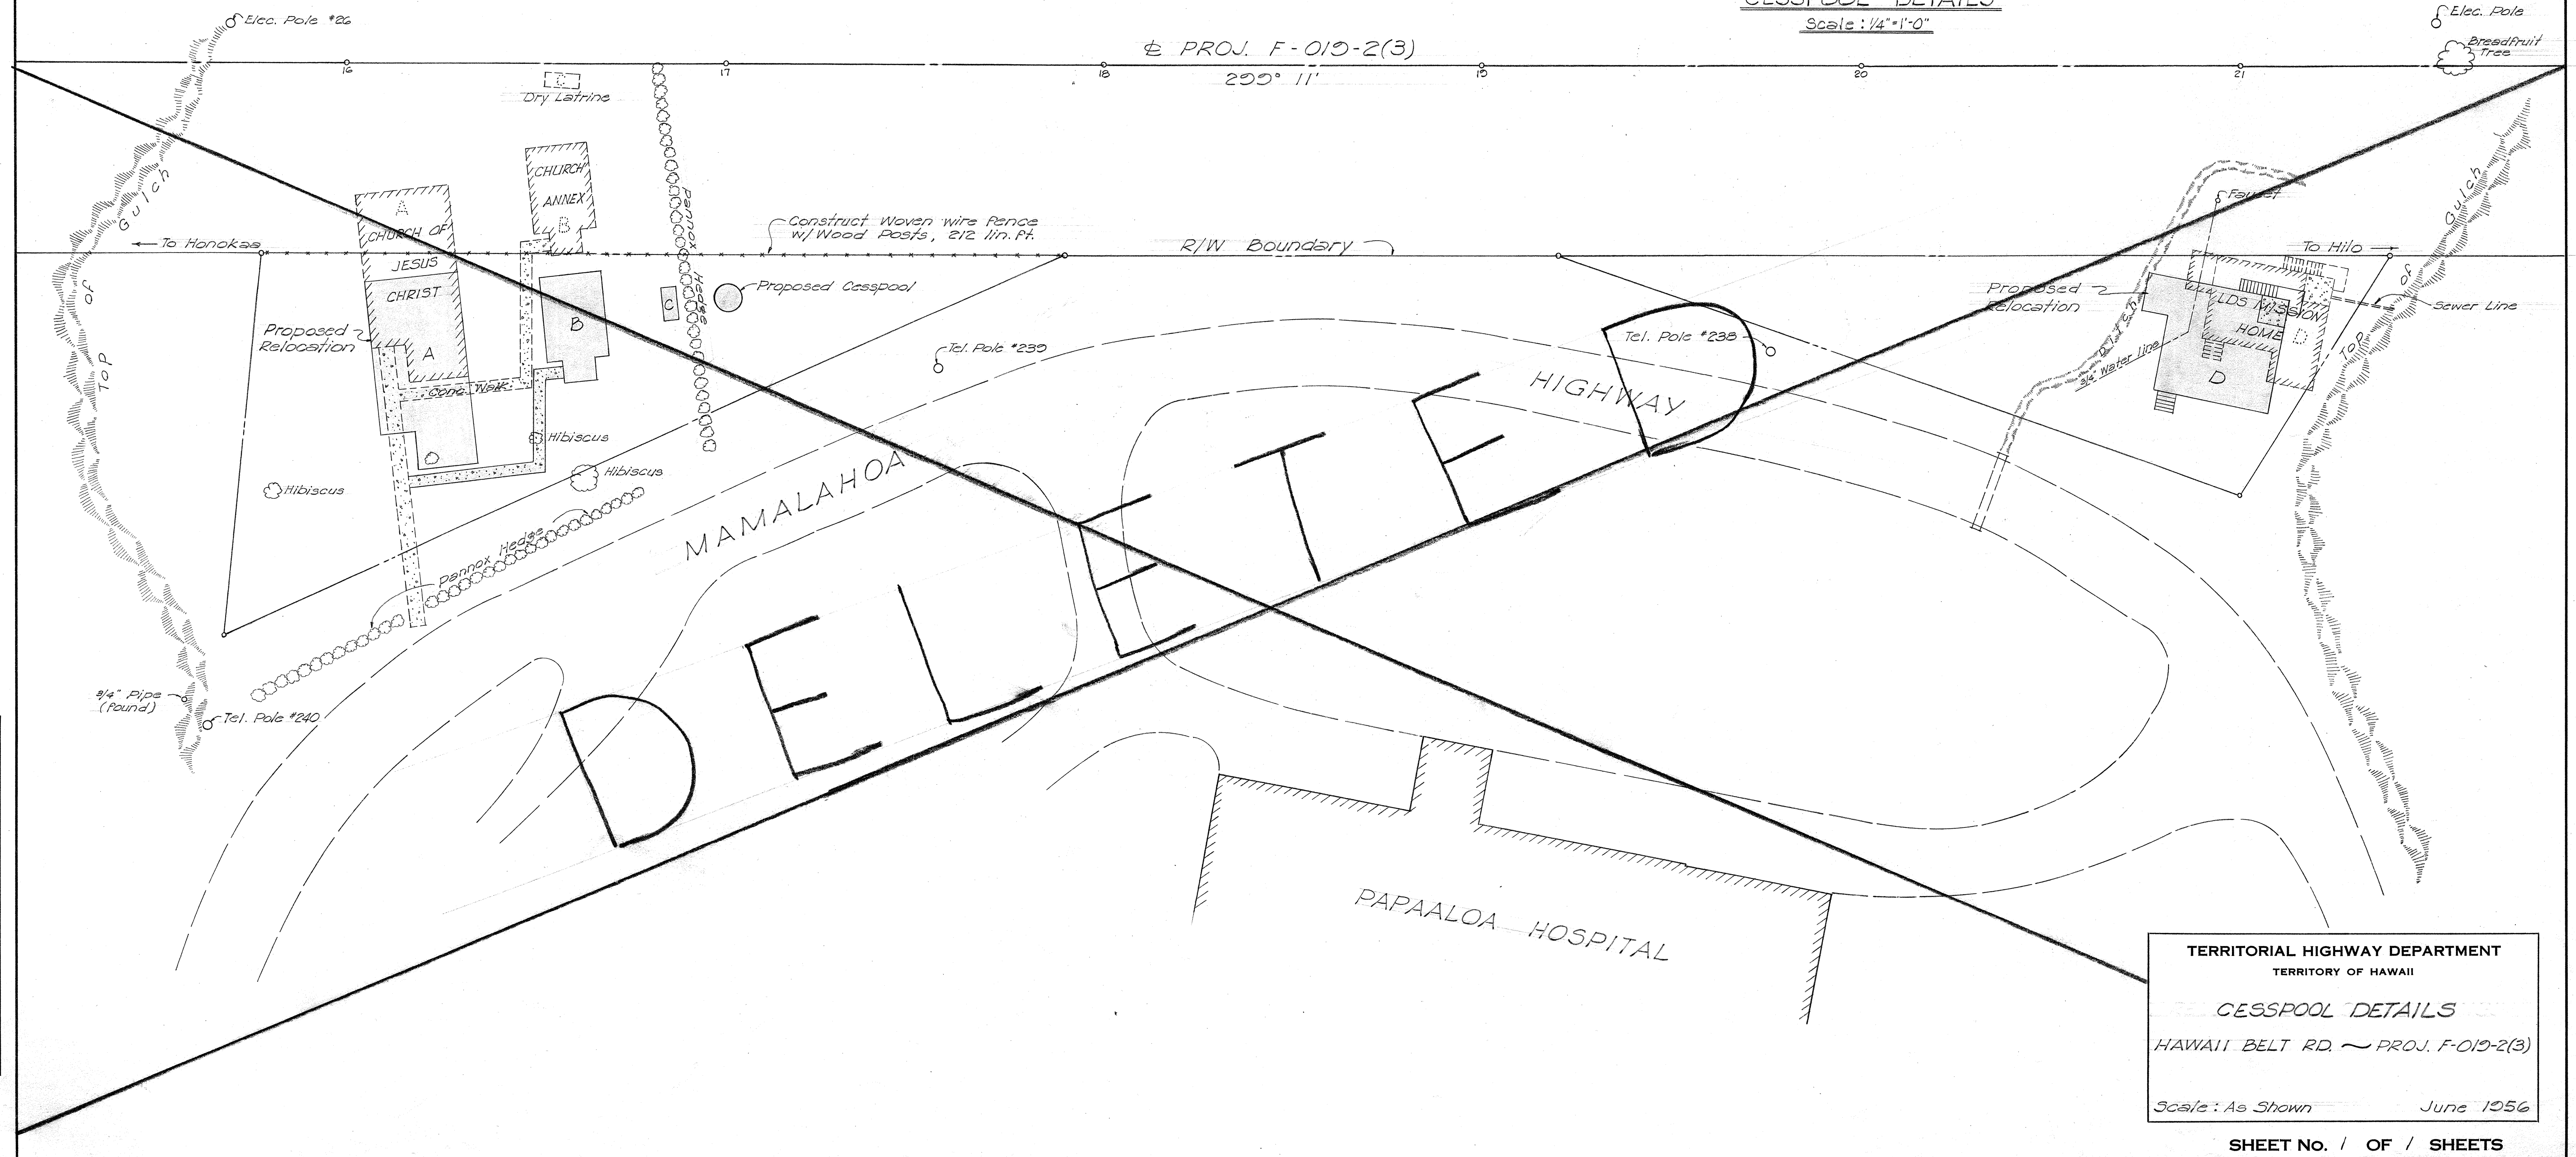

SURVEY PLOTTED BY	DATE
DESIGNED BY	"
DRAWN BY	"
CHECKED BY	"
QUANTITIES CHECKED BY	"
NOTE BOOK	"
NO.	"

TERRITORIAL HIGHWAY DEPARTMENT
TERRITORY OF HAWAII

CESSPOOL DETAILS
HAWAII BELT RD. ~ PROJ. F-019-2(3)

Scale: As Shown June 1956