

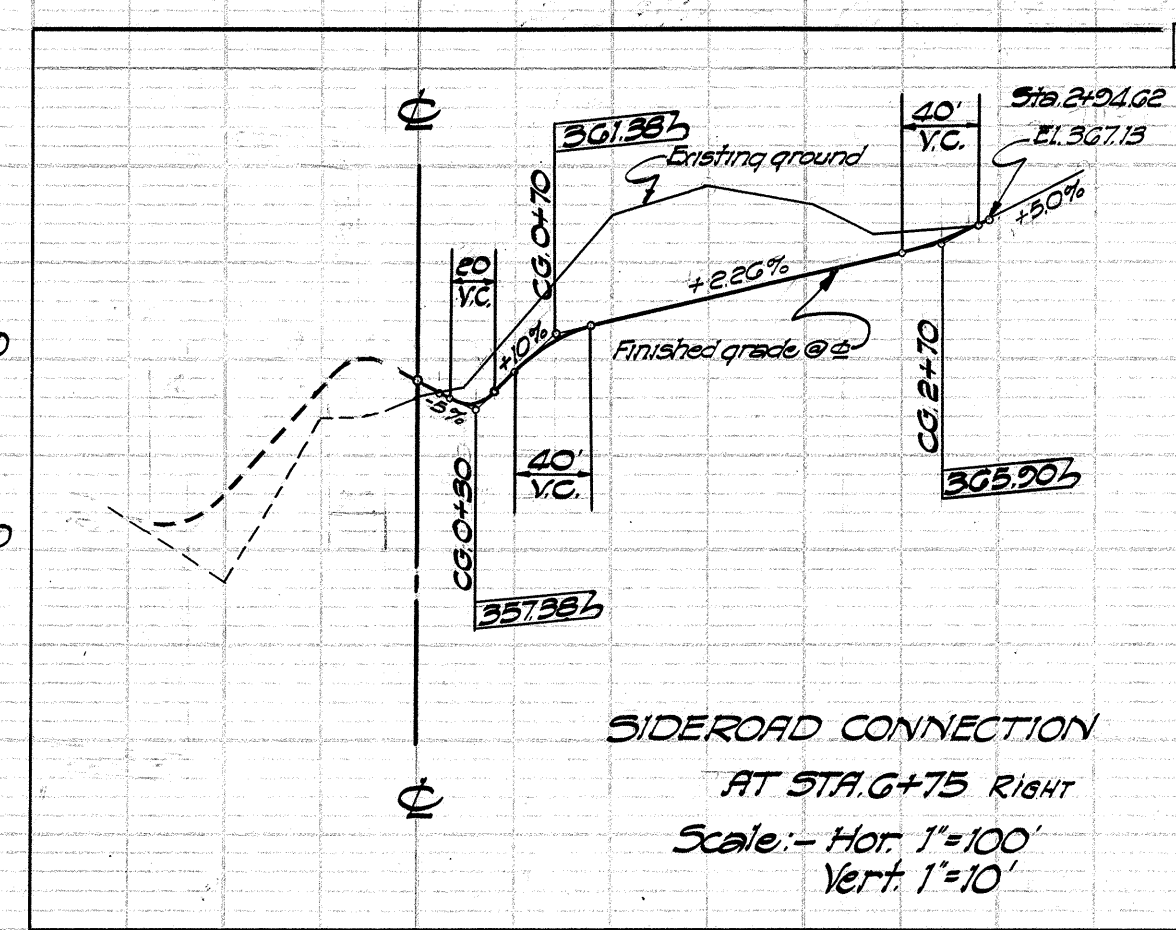


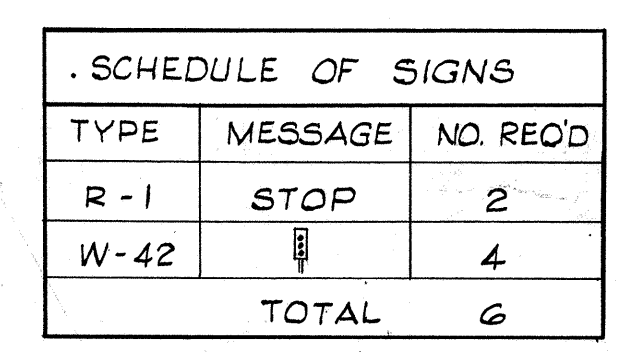

PACIFIC OCEAN

FED. ROAD DIST. NO.	STATE	FED. AID PROJ. NO.	FISCAL YEAR	SHEET NO.	TOTAL SHEETS
HAWAII	HAW.	F-019-2(3)	1956	5	45

JULY 17, 1956

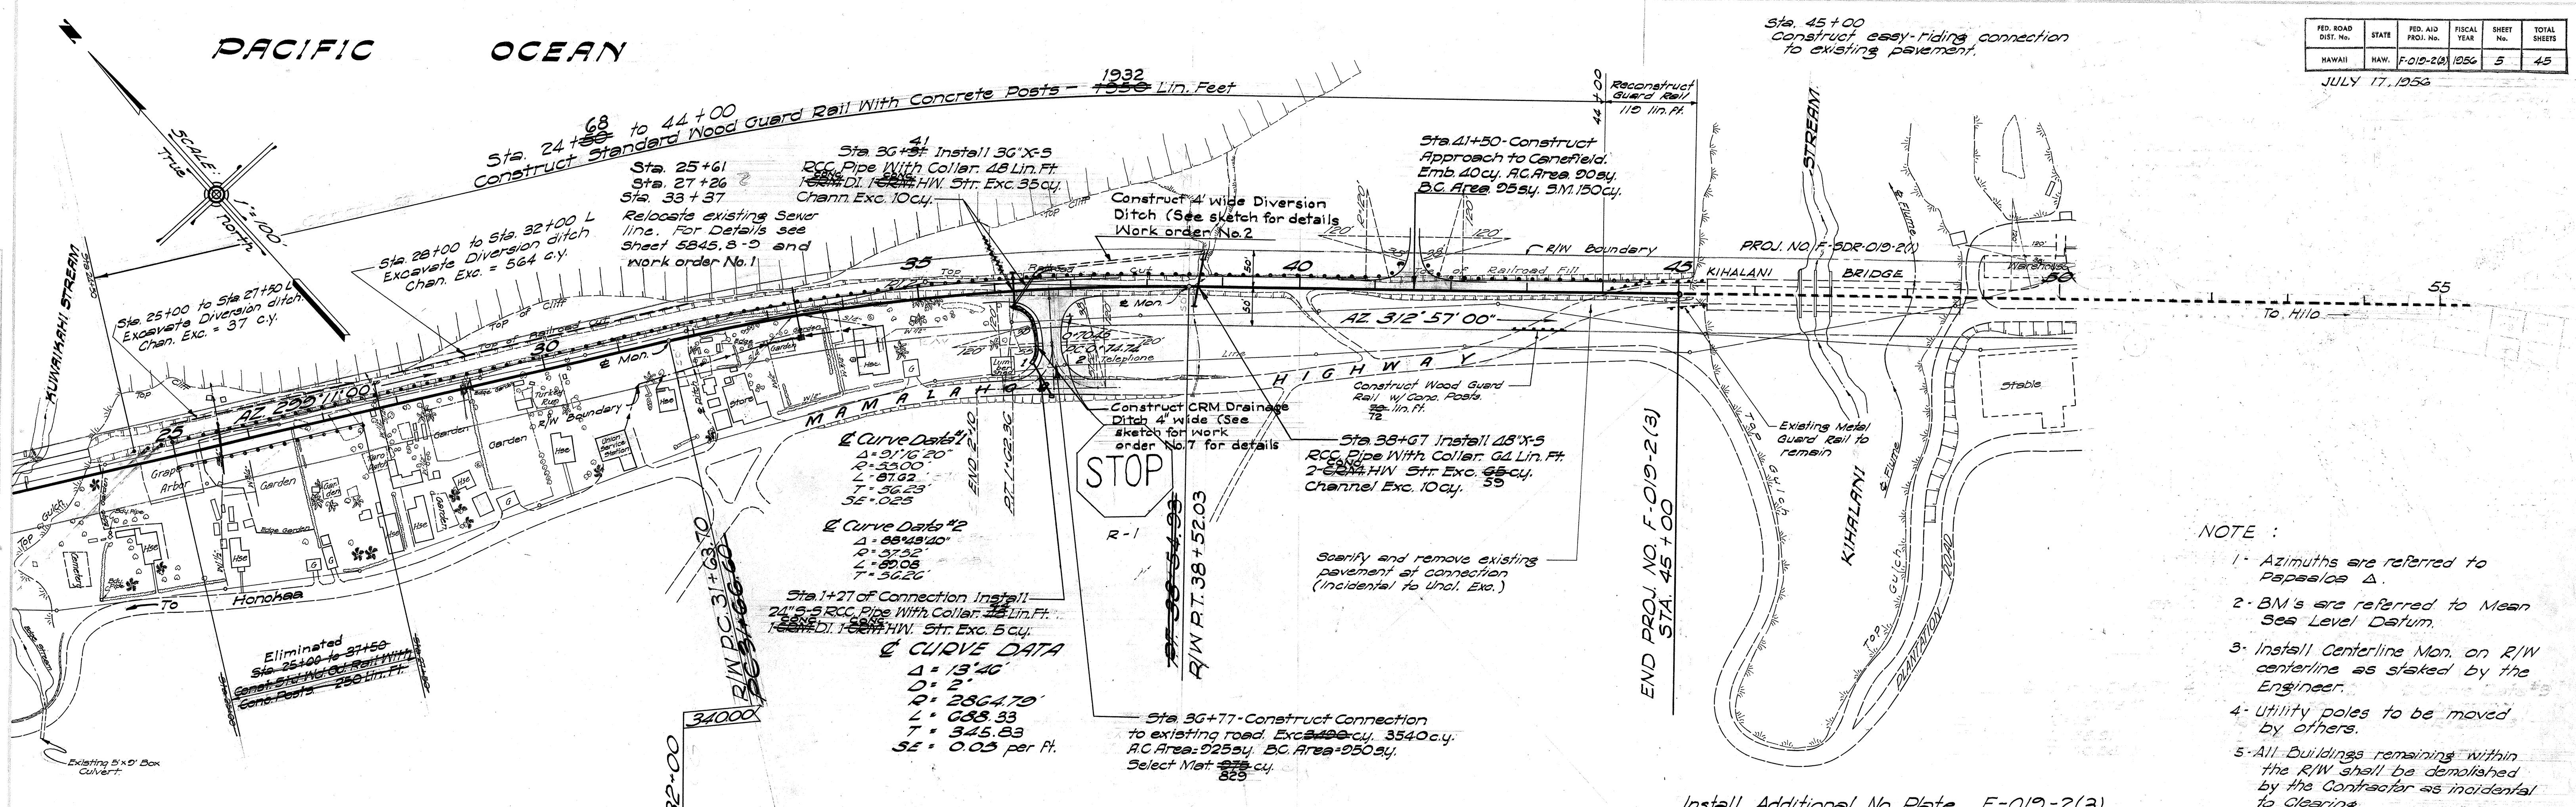

- NOTE:
- 1- Azimuths are referred to Papaea/oa Δ .
 - 2- BM's are referred to Mean Sea Level Datum.
 - 3- Install Centerline Mon. on R/W centerline as stated by the Engineer.
 - 4- Utility poles to be moved by others.
 - 5- All Buildings remaining within the R/W shall be demolished by the Contractor as incidental to clearing.

