
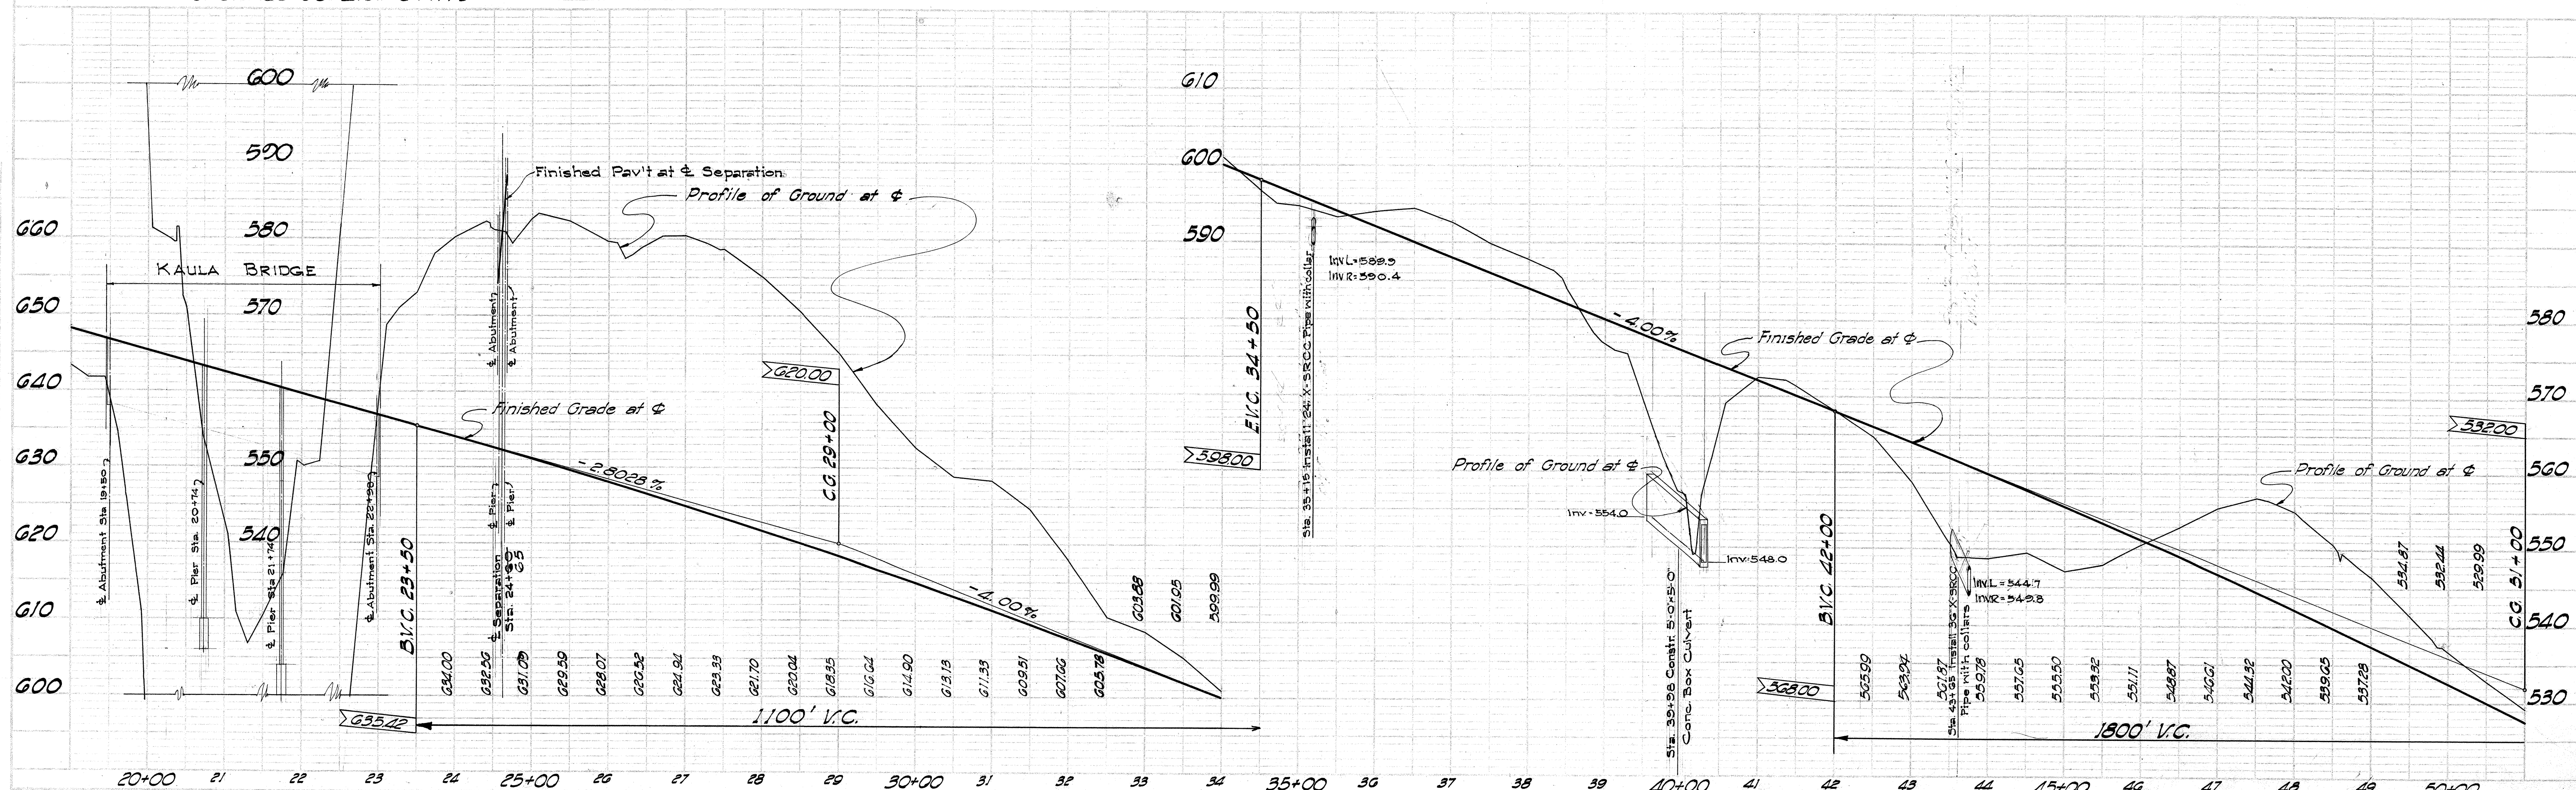


¢ CURVE DATA

$\Delta = 35^\circ 03' 30''$
 $D = 2^\circ 30'$
 $R = 2291.83$
 $L = 1402.33$
 $T = 723.89$
 $SE = 0.06$ per ft.

¢ CURVE DATA

$\Delta = 41^\circ 23' 30''$
 $D = 3^\circ$
 $R = 1909.86'$
 $L = 1382.50'$
 $T = 723.10'$
 $SE = 0.07$ per ft.

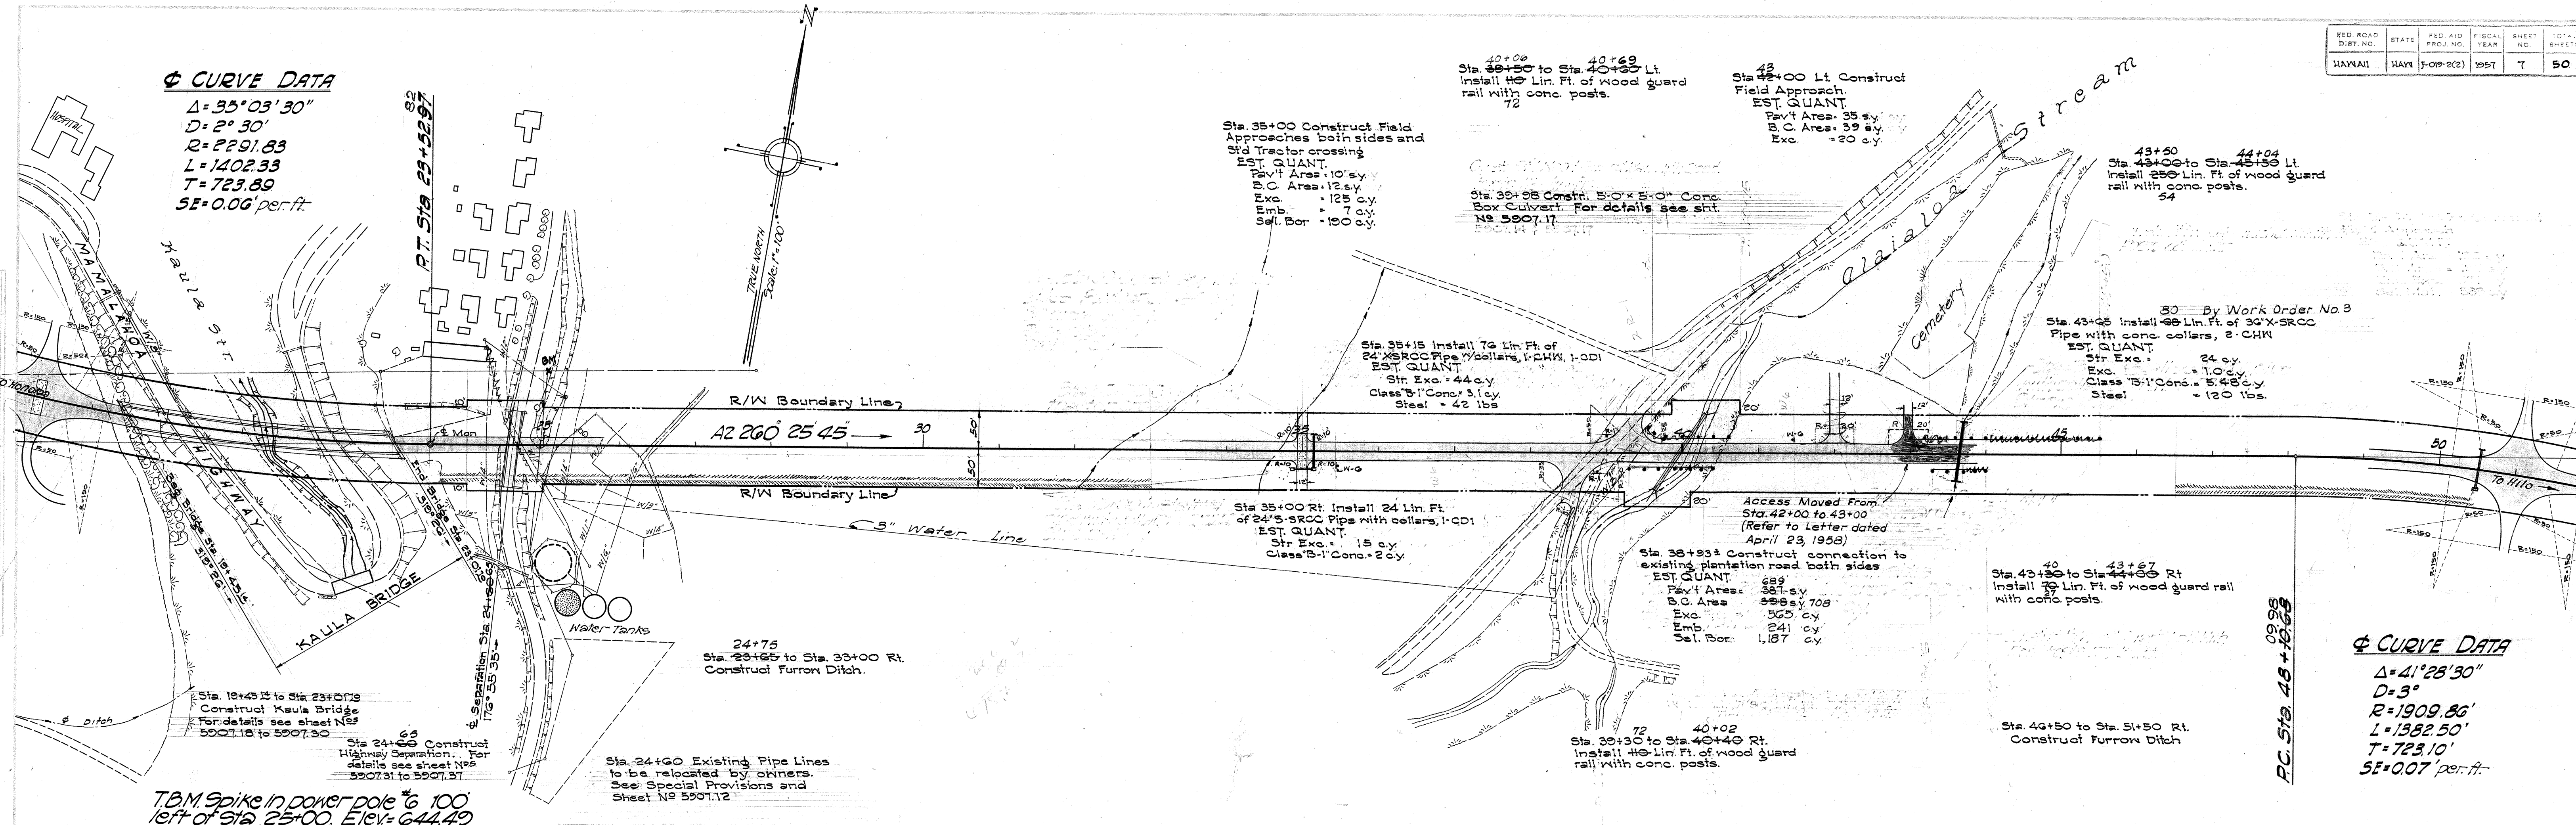

5907.7

PLAN	SURVEYED	DATE
NO.	BY	
NOTE BOOK	PLOTTED	
NO.	RT OF WAY CHECKED	

PROFILE	SURVEYED	DATE
NO.	BY	
NOTE BOOK	PLOTTED	
NO.	RT OF WAY CHECKED	

