

FED. ROAD DIST. NO.	STATE	FED. AID PROJ. NO.	FISCAL YEAR	SHEET NO.	TOTAL SHEETS
HAWAII	HAWAII	DF-019-2(5)	1958	10	85

Sta. 350+25 Constr. Conc. Jacket for C.I. Water Pipe.
See Detail Below.
Est. Quant.
"B-1" Conc. 2 c.y.
Struc. Exc. 12 c.y.


Relocated 24" gate valves, pressure regulators and 4"x6" reducers
See note below

Relocated meter box and valve
See note below

EPR Curve Data
Δ = 10' 00"
R = 500'
T = 43.74'
L = 81.21'

Sta. 349+60.00 to Sta. 352+42.74 Rt.
Constr. Connection from Mamalahoe Hwy.
Est. Quant.
Pav't Area = 277 s.y. 336
B.C. Area = 300 s.y. 350
Exc. = 3 c.y. 0
Sel. Mat. = 104 c.y. 40

Note -
Relocation of 24" gate valves, pressure regulators, 4"x6" reducers, meter box, etc., shall be incidental to the applicable sizes of galvanized pipes called for in the proposal.

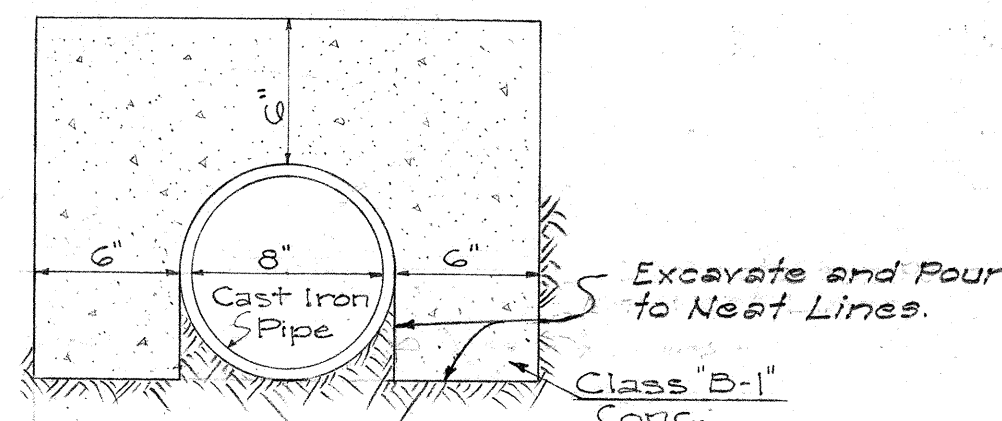

TYPICAL SECTION OF CONC. JACKET
Scale: 1/2" = 1'

TERRITORIAL HIGHWAY DEPARTMENT
TERRITORY OF HAWAII

PIPE LINE RELOCATION AND
MAMALAHOA HIGHWAY CONNECTION
HAWAII BELT ROAD
PROJ. NO. DF-019-2(5)

Scale: 1" = 20'-0"
Dec. 1957

For detail of intersection see
sheet no. 5954.15

DATE	_____
SURVEY PLOTTED BY	_____
DRAWN BY	_____
TRACED BY	_____
QUANTITIES CHECKED BY	_____
CHECKED BY	_____
ORIGINAL PLAN	_____
NOTE BOOK NO.	_____