


INDEX TO DRAWINGS	
SHEET	DESCRIPTION
1	TITLE SHEET
2	TYPICAL SECTION
3-9	PLAN and PROFILE
10	PIPE LINE RELOCATION and MAMALAHOA HWY CONNECTION
11	PIPE LINE RELOCATION and PARKING for PAAULO STORE
12-15	INTERSECTION DETAILS
16-21	KAUMOALI BRIDGE
22-29	WAI PUNAHINA BRIDGE
30-42	DETAILS of REINF. CONC. BOX CULVERTS
43-85	CROSS SECTIONS


SCALE	
PLAN	1 in. = 100 ft.
PROFILE	HOR. 1 in. = 100 ft.
	VER. 1 in. = 10 ft.
CROSS SECTION	HOR. 1 in. = 10 ft.
	VER. 1 in. = 10 ft.

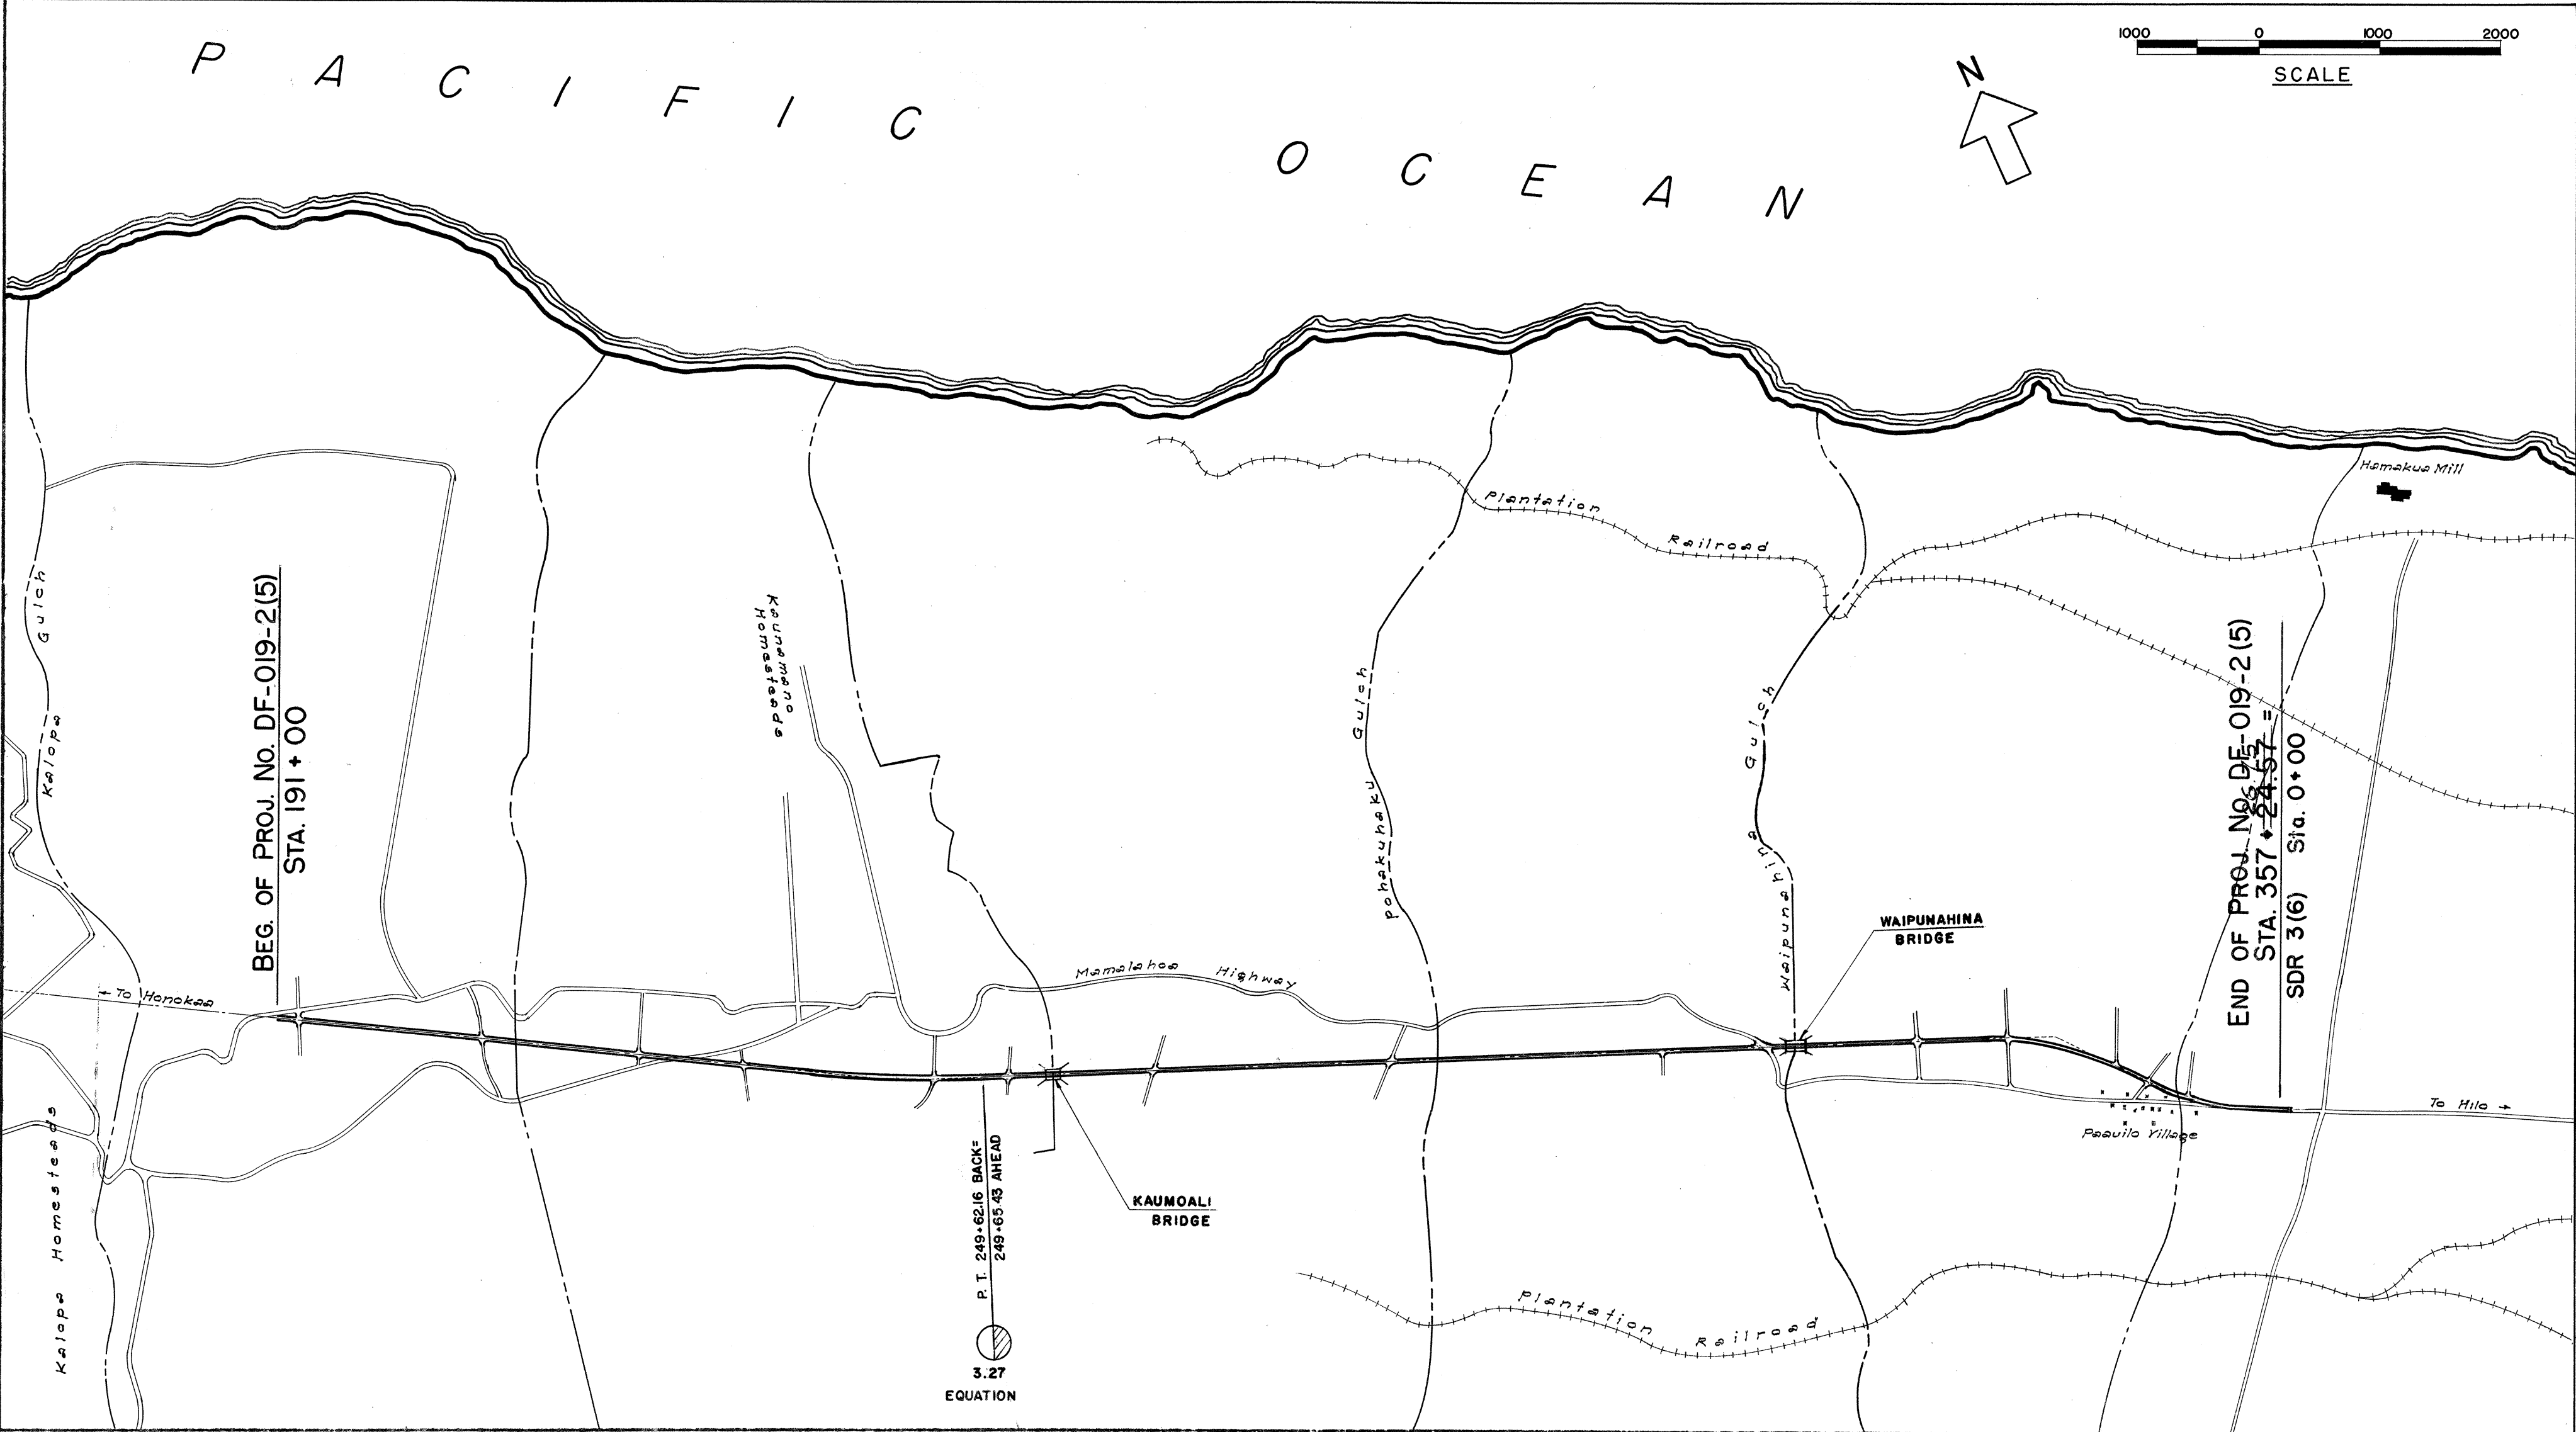

TERRITORY OF HAWAII
TERRITORIAL HIGHWAY DEPARTMENT
HONOLULU T.H.

PLANS OF HAWAII BELT ROAD

PROJECT NO. DF-019-2(5)
DISTRICT OF HAMAKUA
ISLAND OF HAWAII

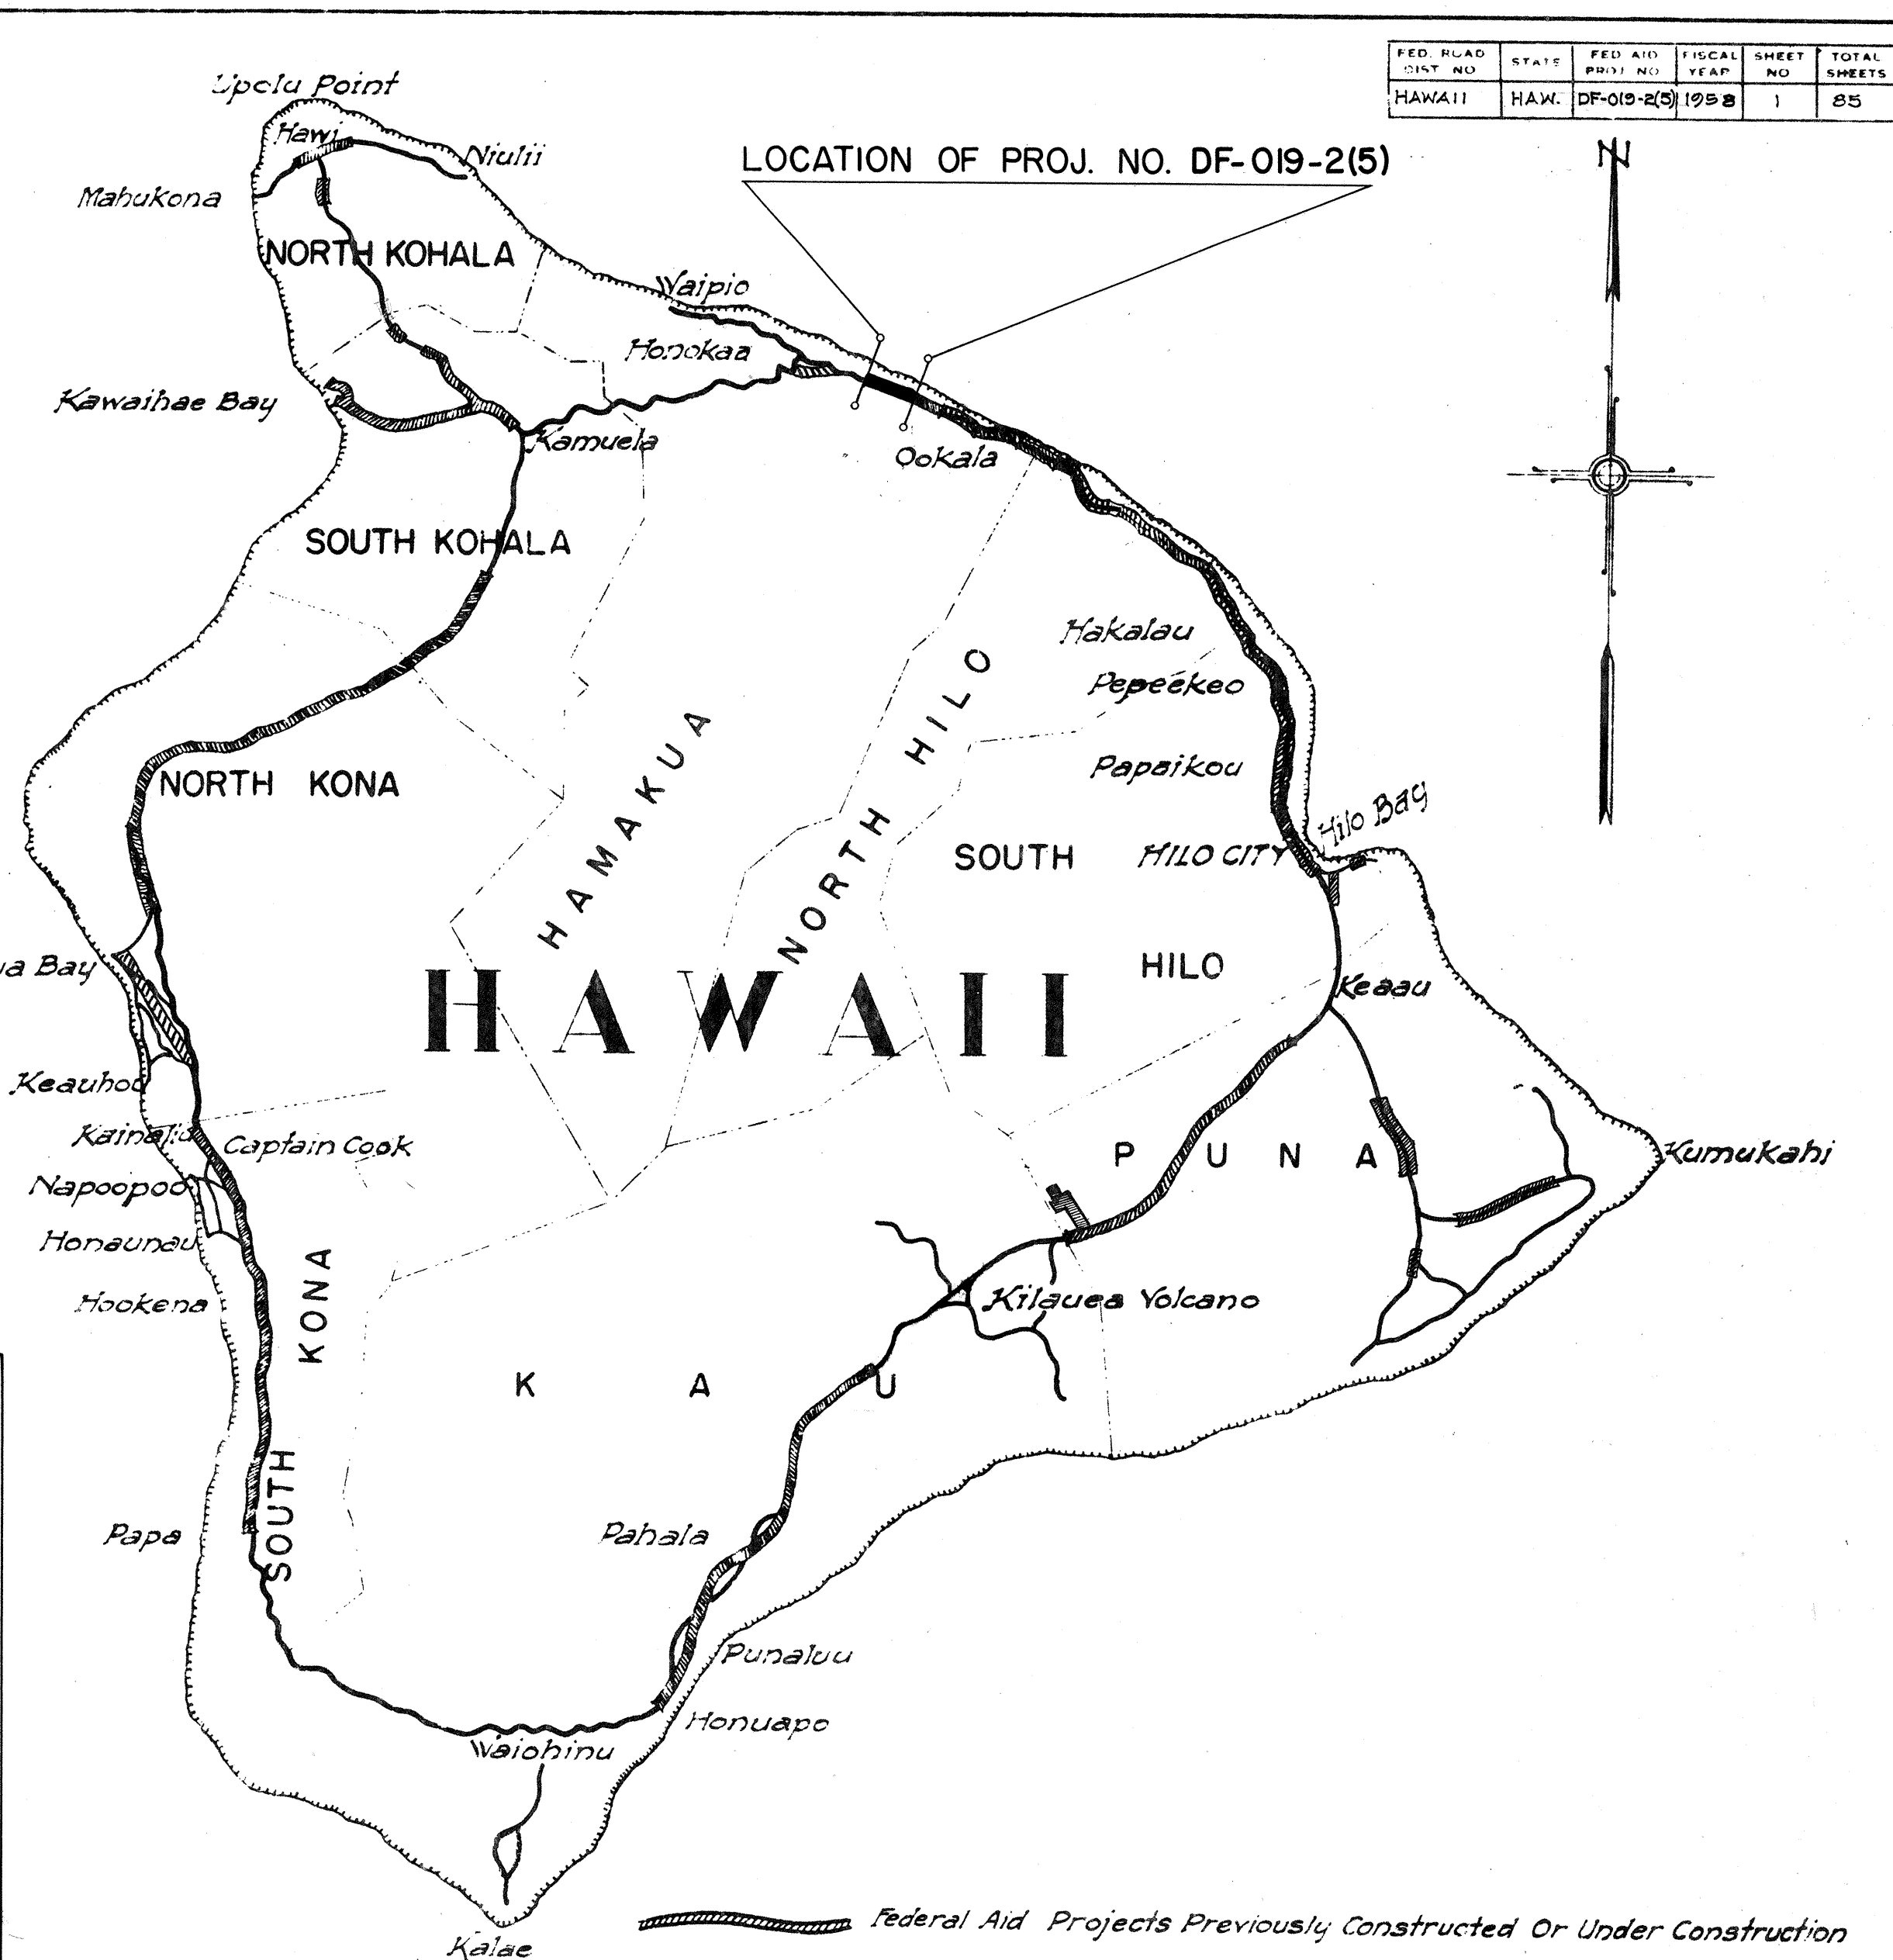

ROADWAY ----- 3.096 MI.
BRIDGES ----- 0.052 MI.
GROSS LENGTH of PROJECT - 3.148 MI.

NOTE:
ALL CHANGES MADE DURING
CONSTRUCTION HAVE BEEN
NOTED IN THESE TRACINGS
IN RED AND CHECKED BY

Alfredson
DISTRICT ENGINEER
February 1, 1960
DATE

APPROVED: *Wm. Wachtel*
TERRITORIAL HIGHWAY ENGINEER
DATE 4/13/58

DEPARTMENT OF COMMERCE
BUREAU OF PUBLIC ROADS
APPROVED: _____
DIVISION ENGINEER DATE