




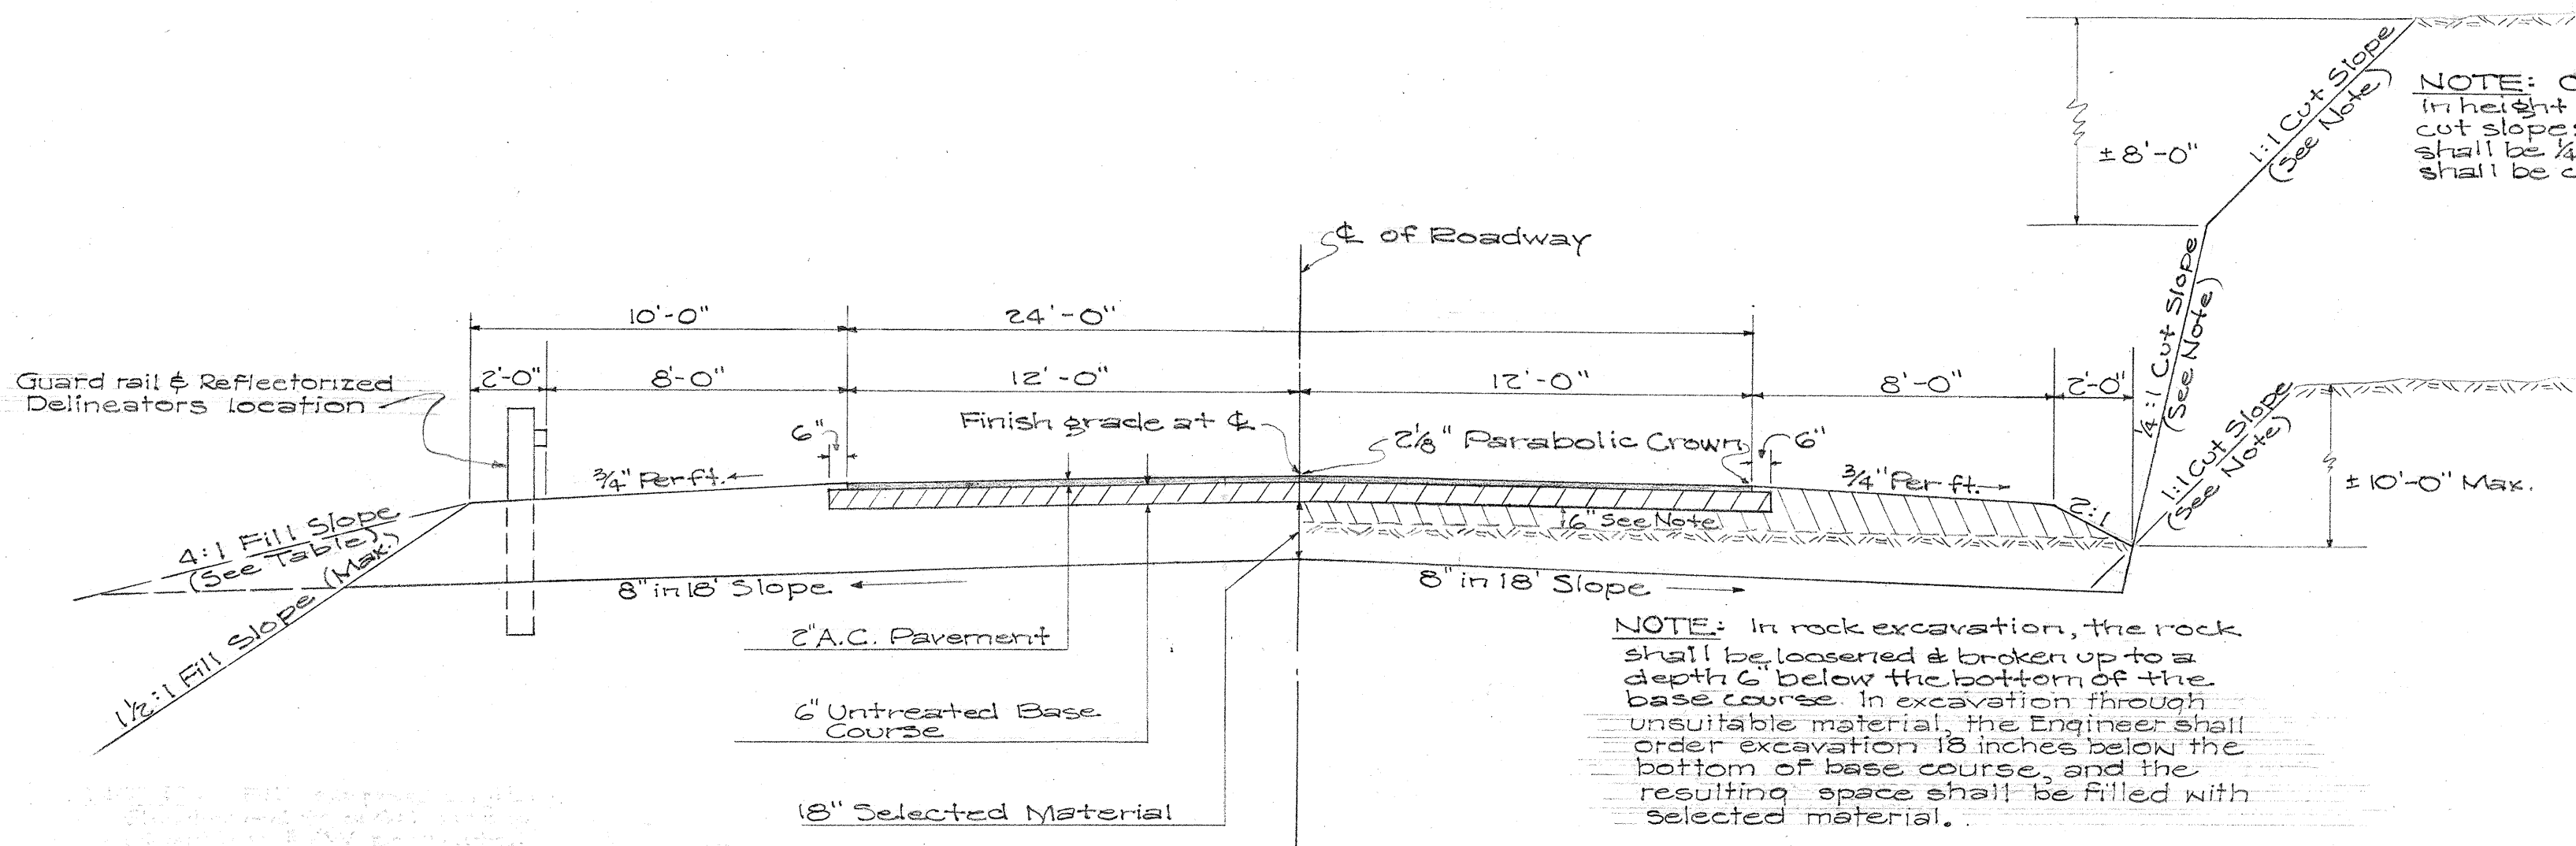

TYPICAL SECTION ON TANGENT
Sta. 185+00 to Sta. 310+00
Scale: 1/4" = 1'-0"

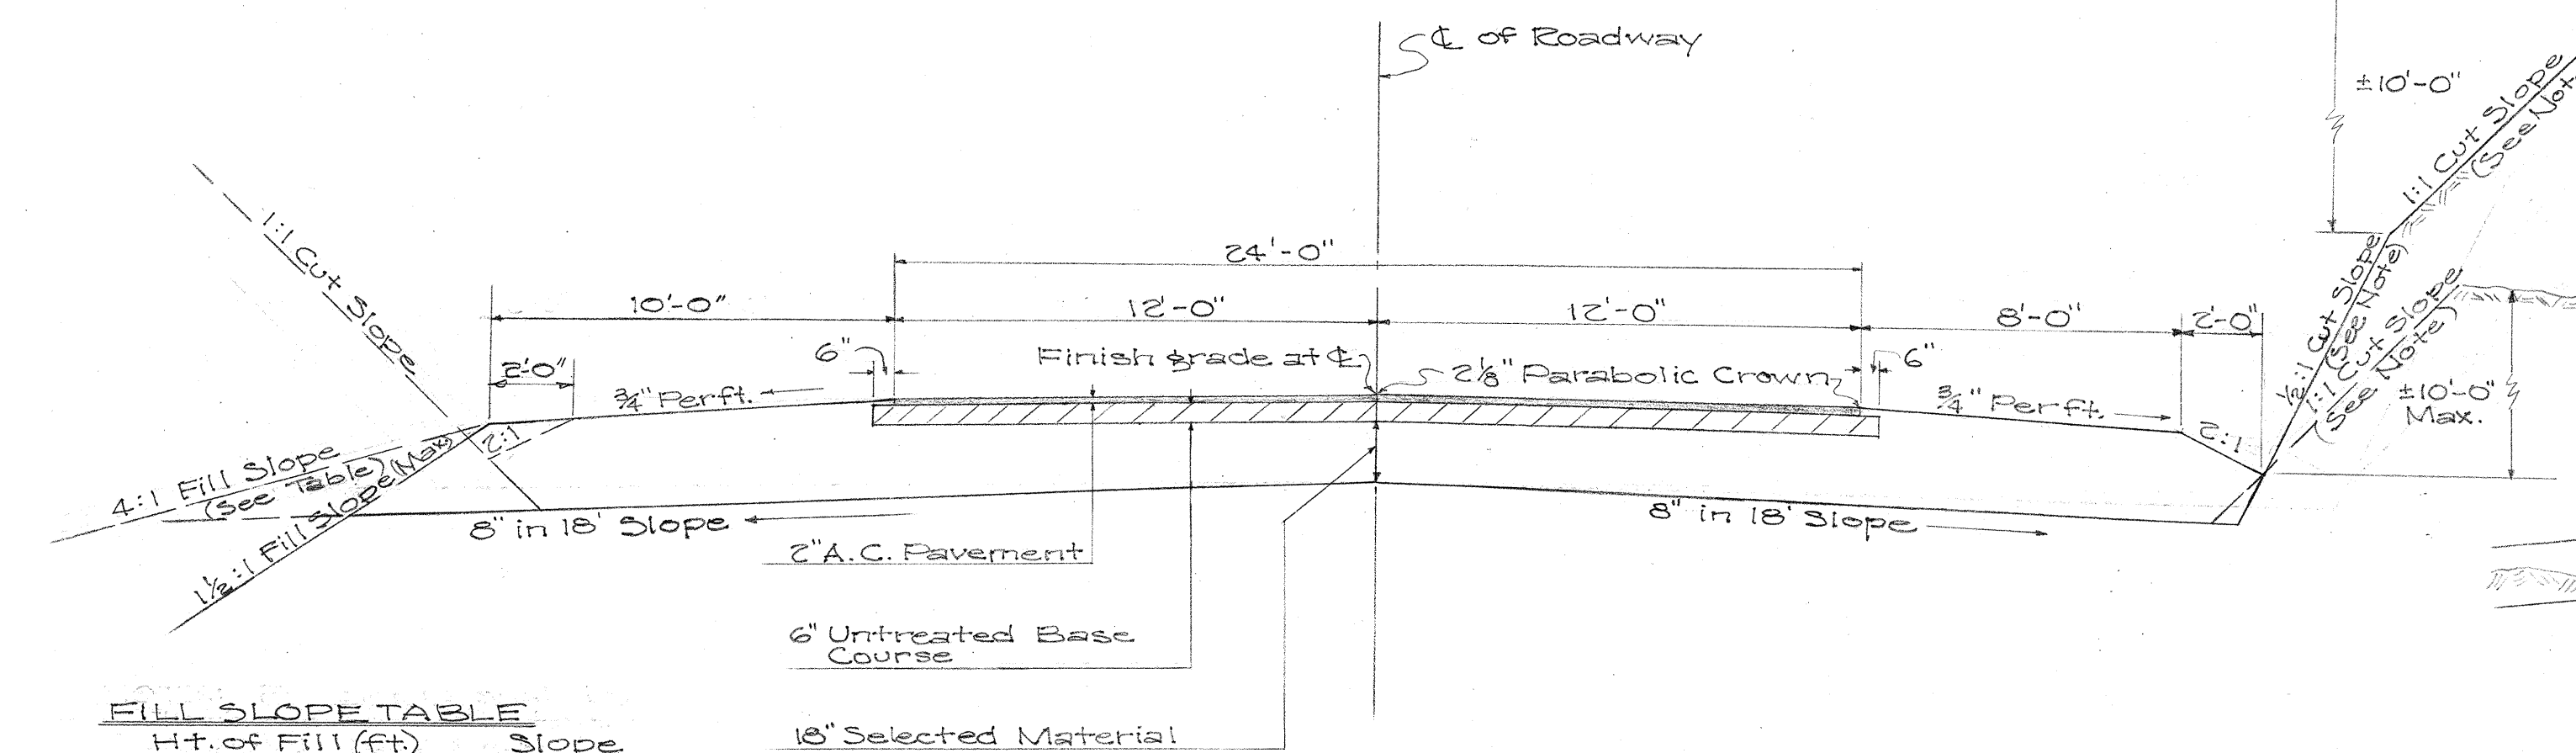


TYPICAL SECTION ON TANGENT
Sta. 310+00 to Sta. 357+24
Scale: 1/4" = 1'-0"

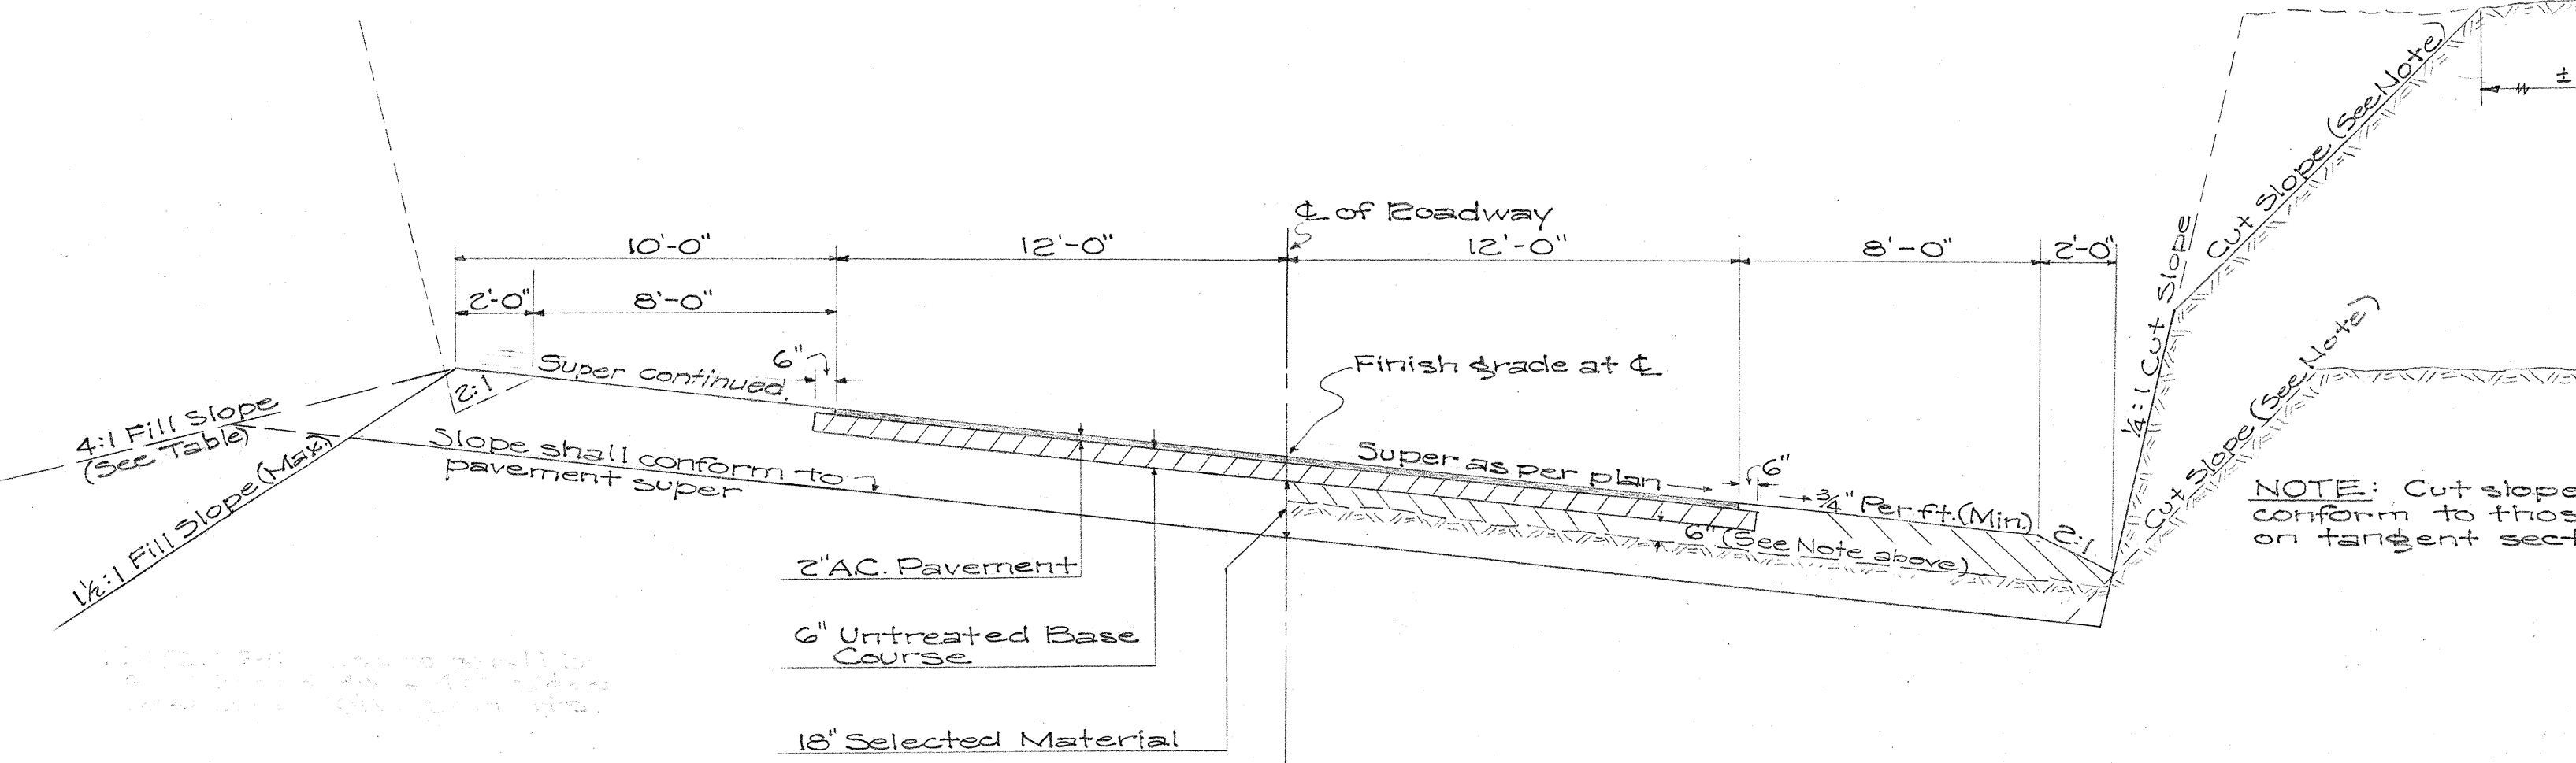


TYPICAL SECTION ON CURVE
Scale: 1/4" = 1'-0"

GENERAL NOTES:


1. Pavement - The pavement shall be asphalt concrete, Mix III laid in one layer of 2 inches compacted thickness.
2. Prime Coat - Prime coat shall be slow curing liquid asphalt applied at the approximate rate of 0.55 of a gallon per square yard.
3. Base Course - The base course shall be Untreated, Base consisting of mineral aggregate, (1/2 to No. 200), laid in one layer of 6" compacted thickness.
4. Sub-base Course - The subbase course shall be selected material from the roadway excavation, 18" thick, laid in 3 layers of 6 inches compacted thickness.

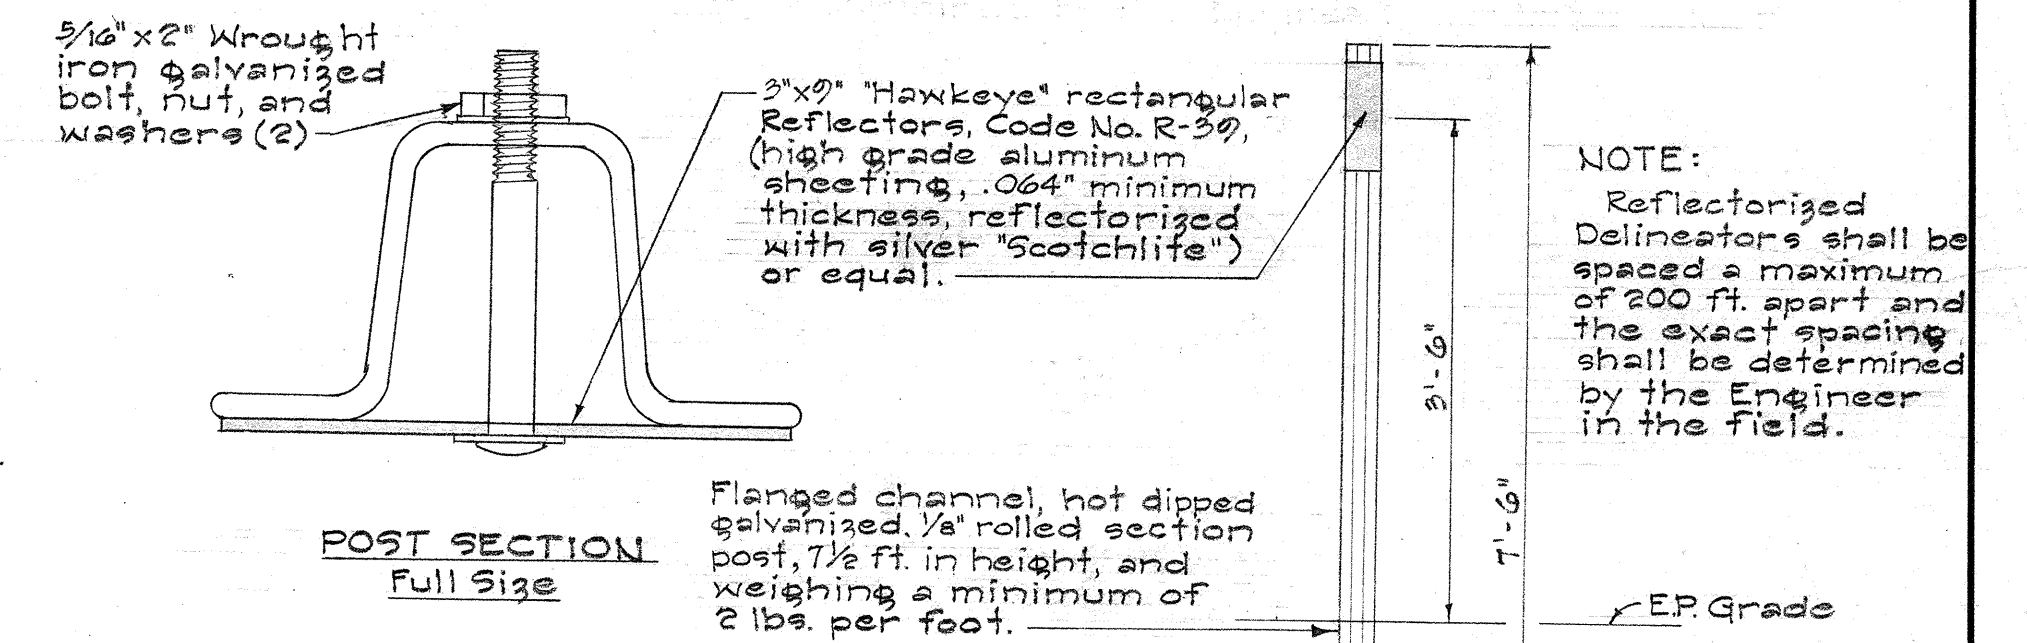


DETAIL OF REFLECTORIZED DELINEATOR

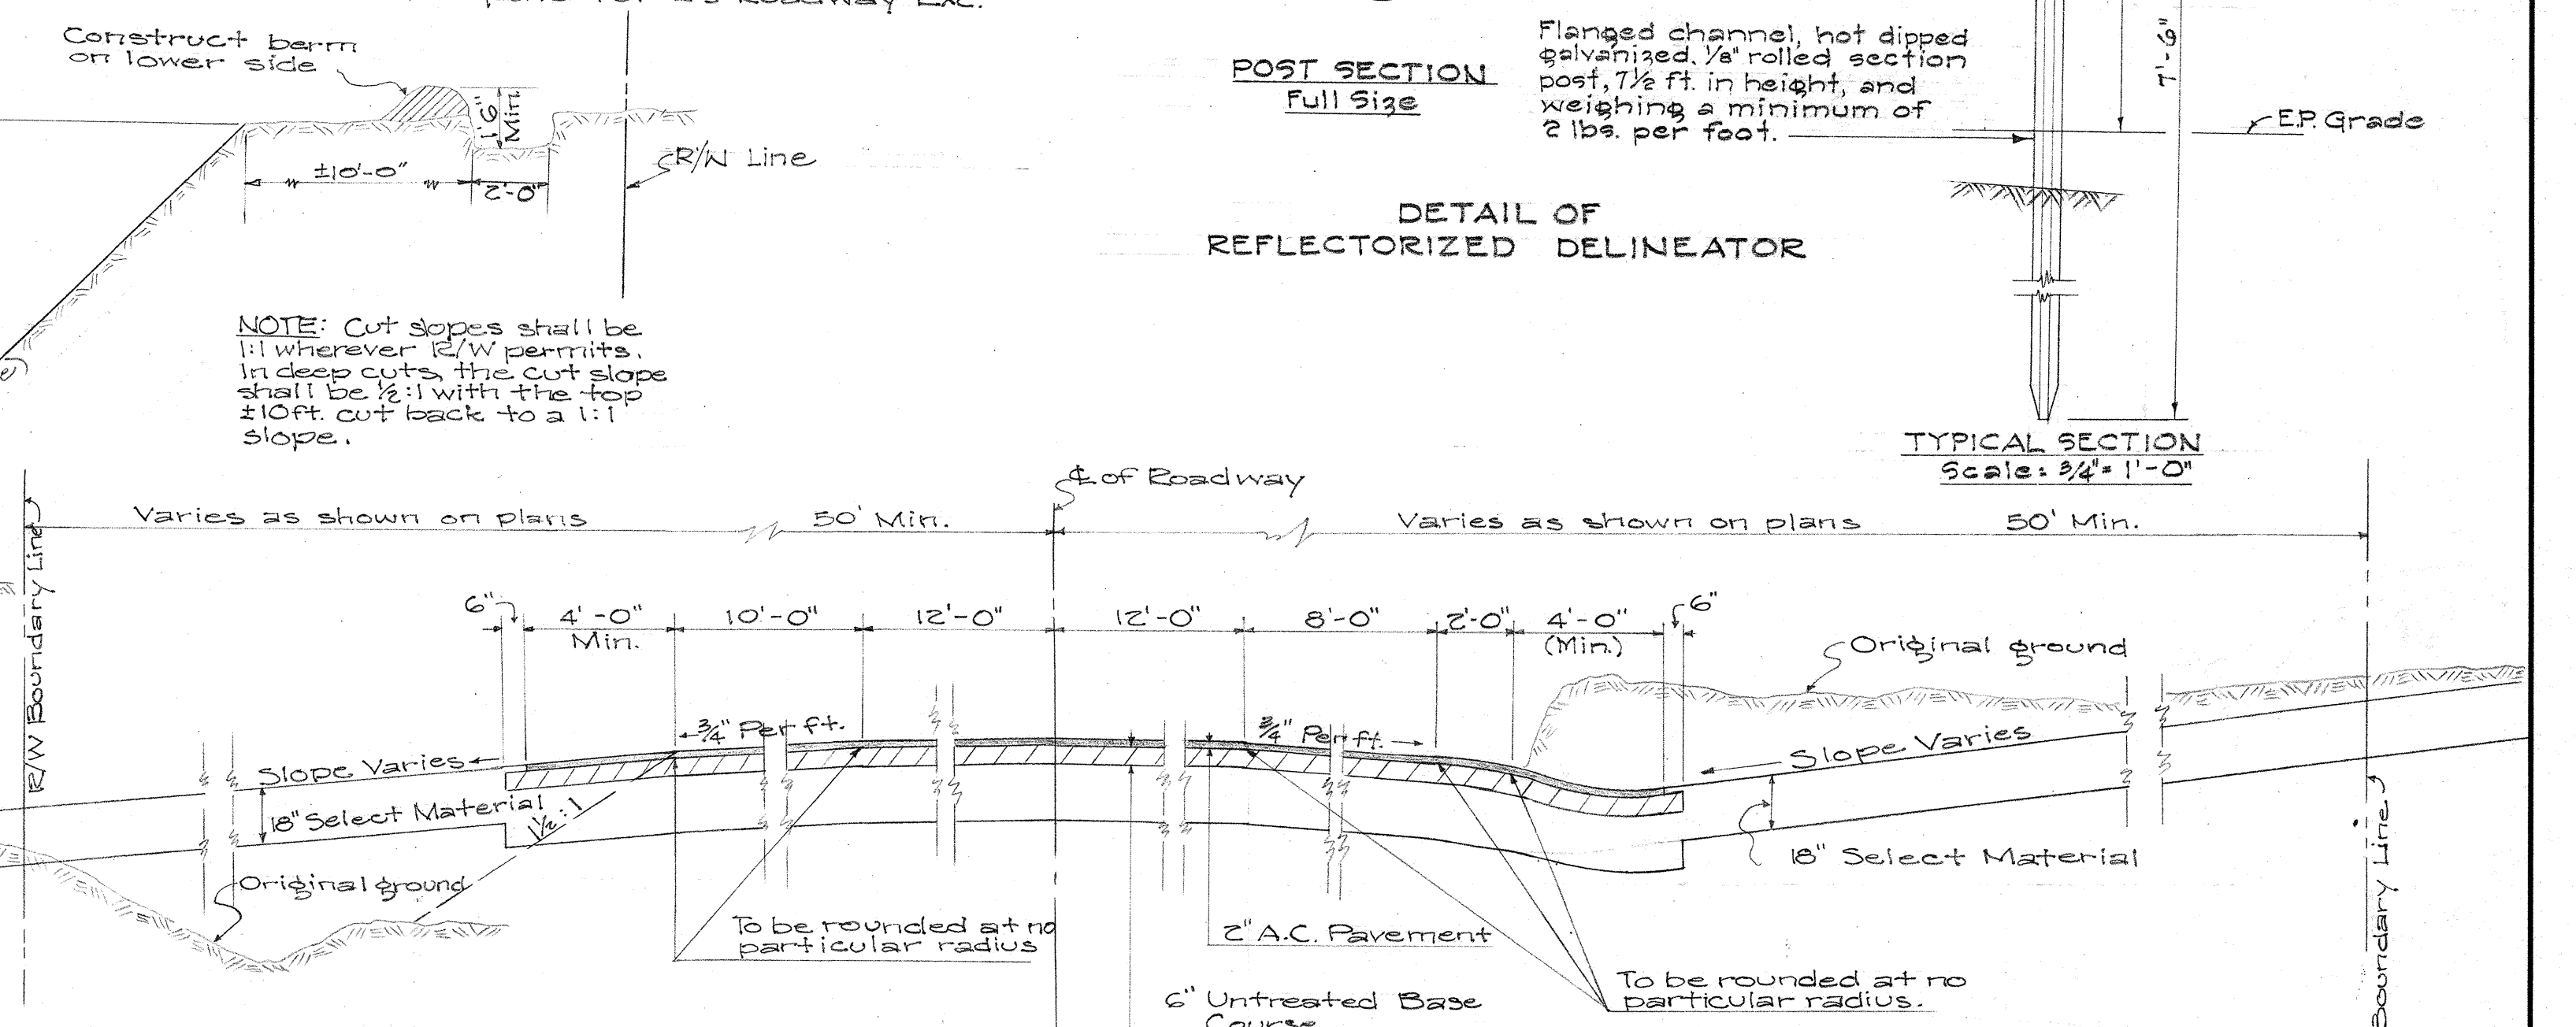

DETAIL OF SIDEROAD APPROACHES
Scale: 1/4" = 1'-0"

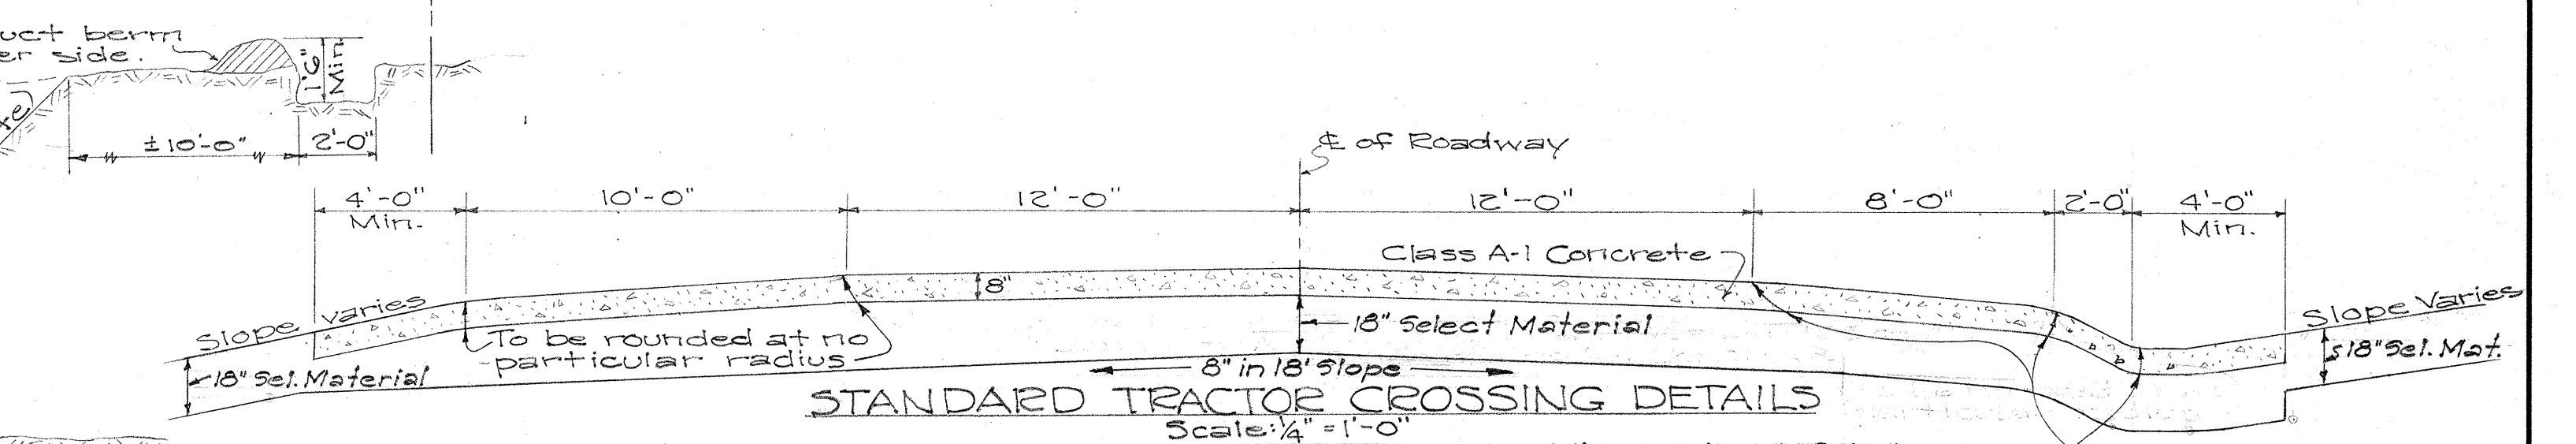

STANDARD TRACTOR CROSSING DETAILS
Scale: 1/4" = 1'-0"

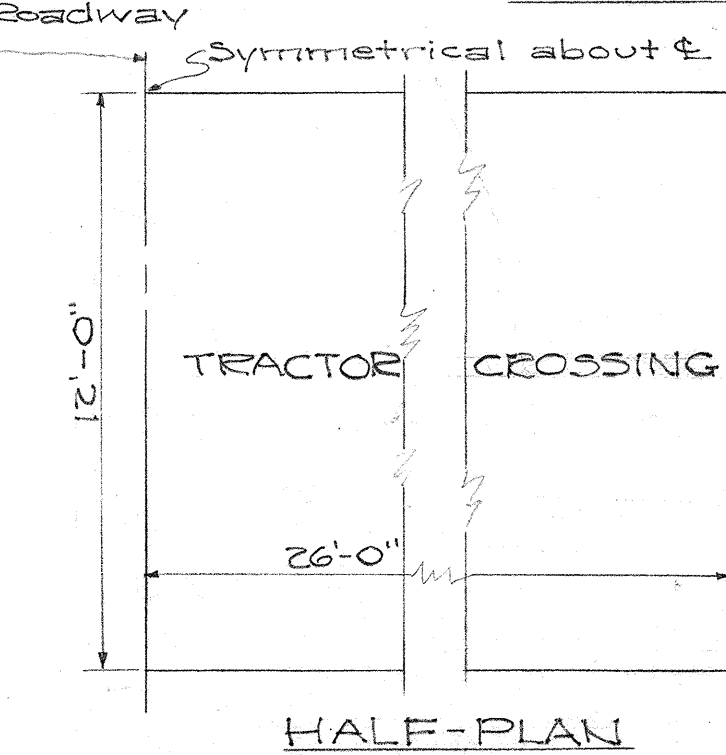

TERRITORIAL HIGHWAY DEPARTMENT
TERRITORY OF HAWAII
TYPICAL SECTIONS
& TRACTOR CROSSING DETAILS
HAWAII BELT ROAD
Proj. No. DF-019-2(3)
Scale as noted March 1958

DATE: _____
DESIGNED BY: _____
DRAWN BY: _____
CHECKED BY: _____
ORIGINAL PLAN NO. _____
NOTE BOOK NO. _____