
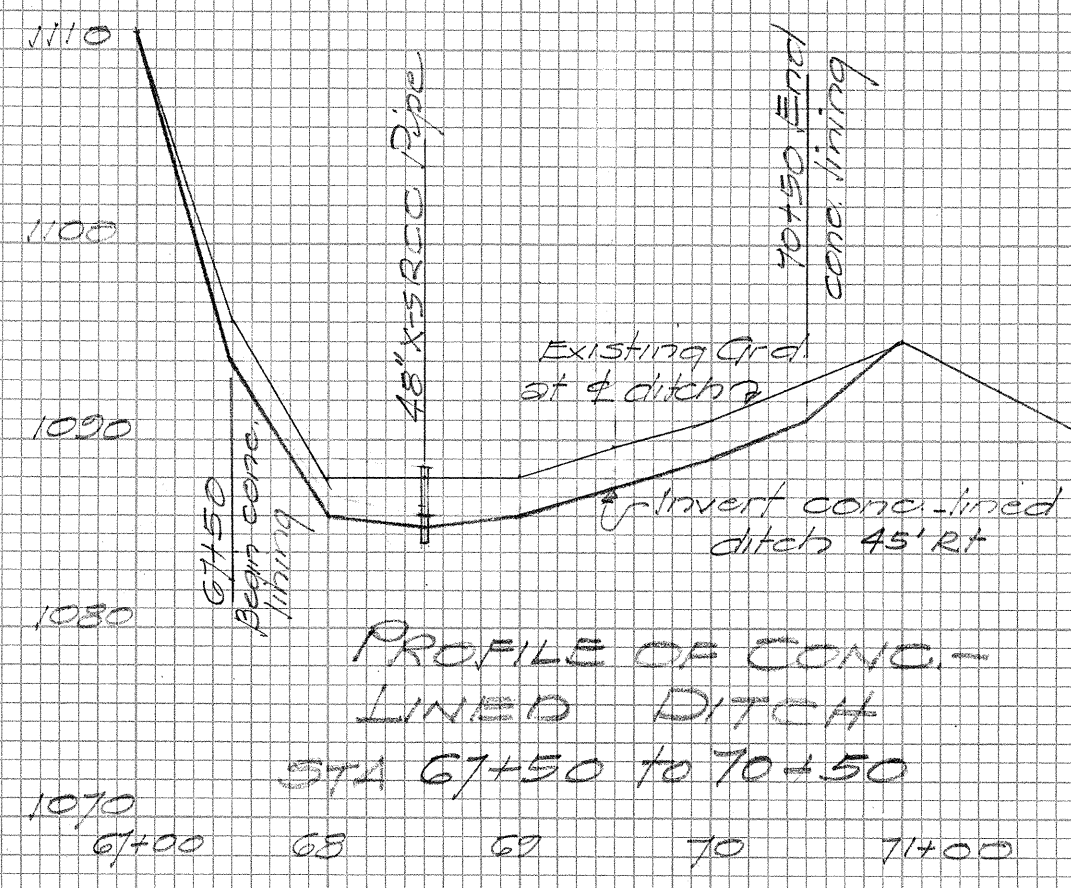
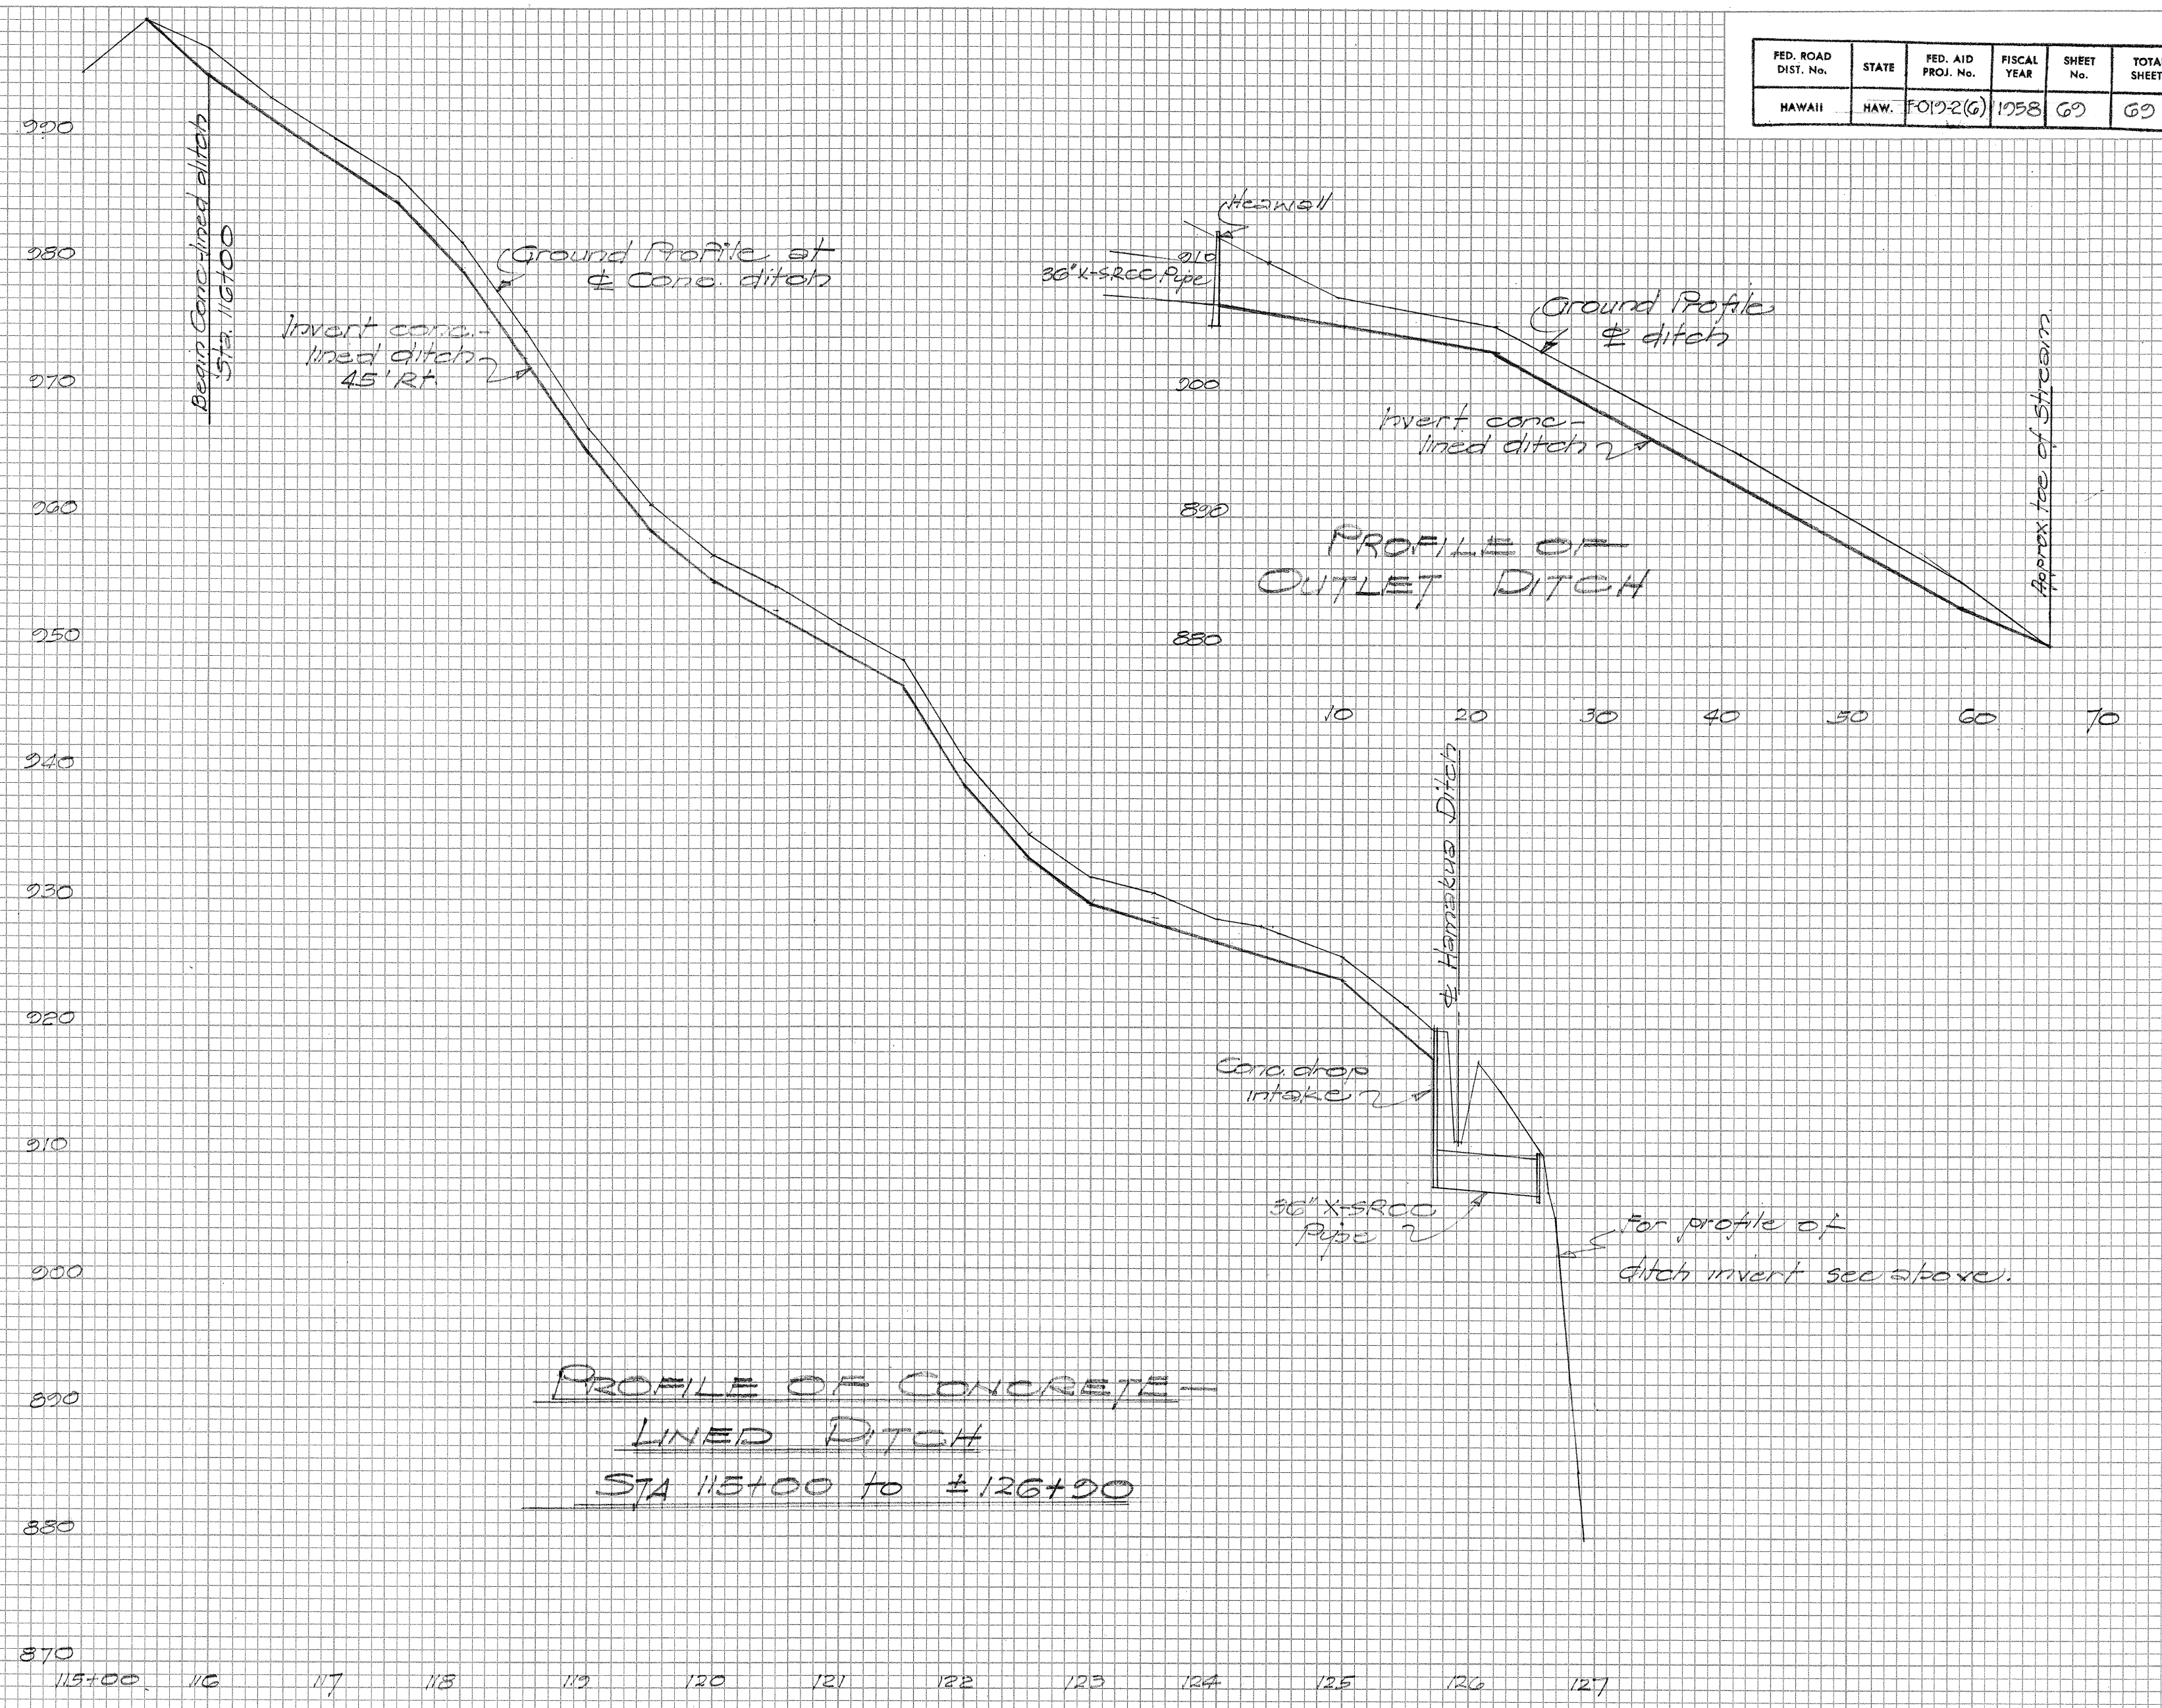
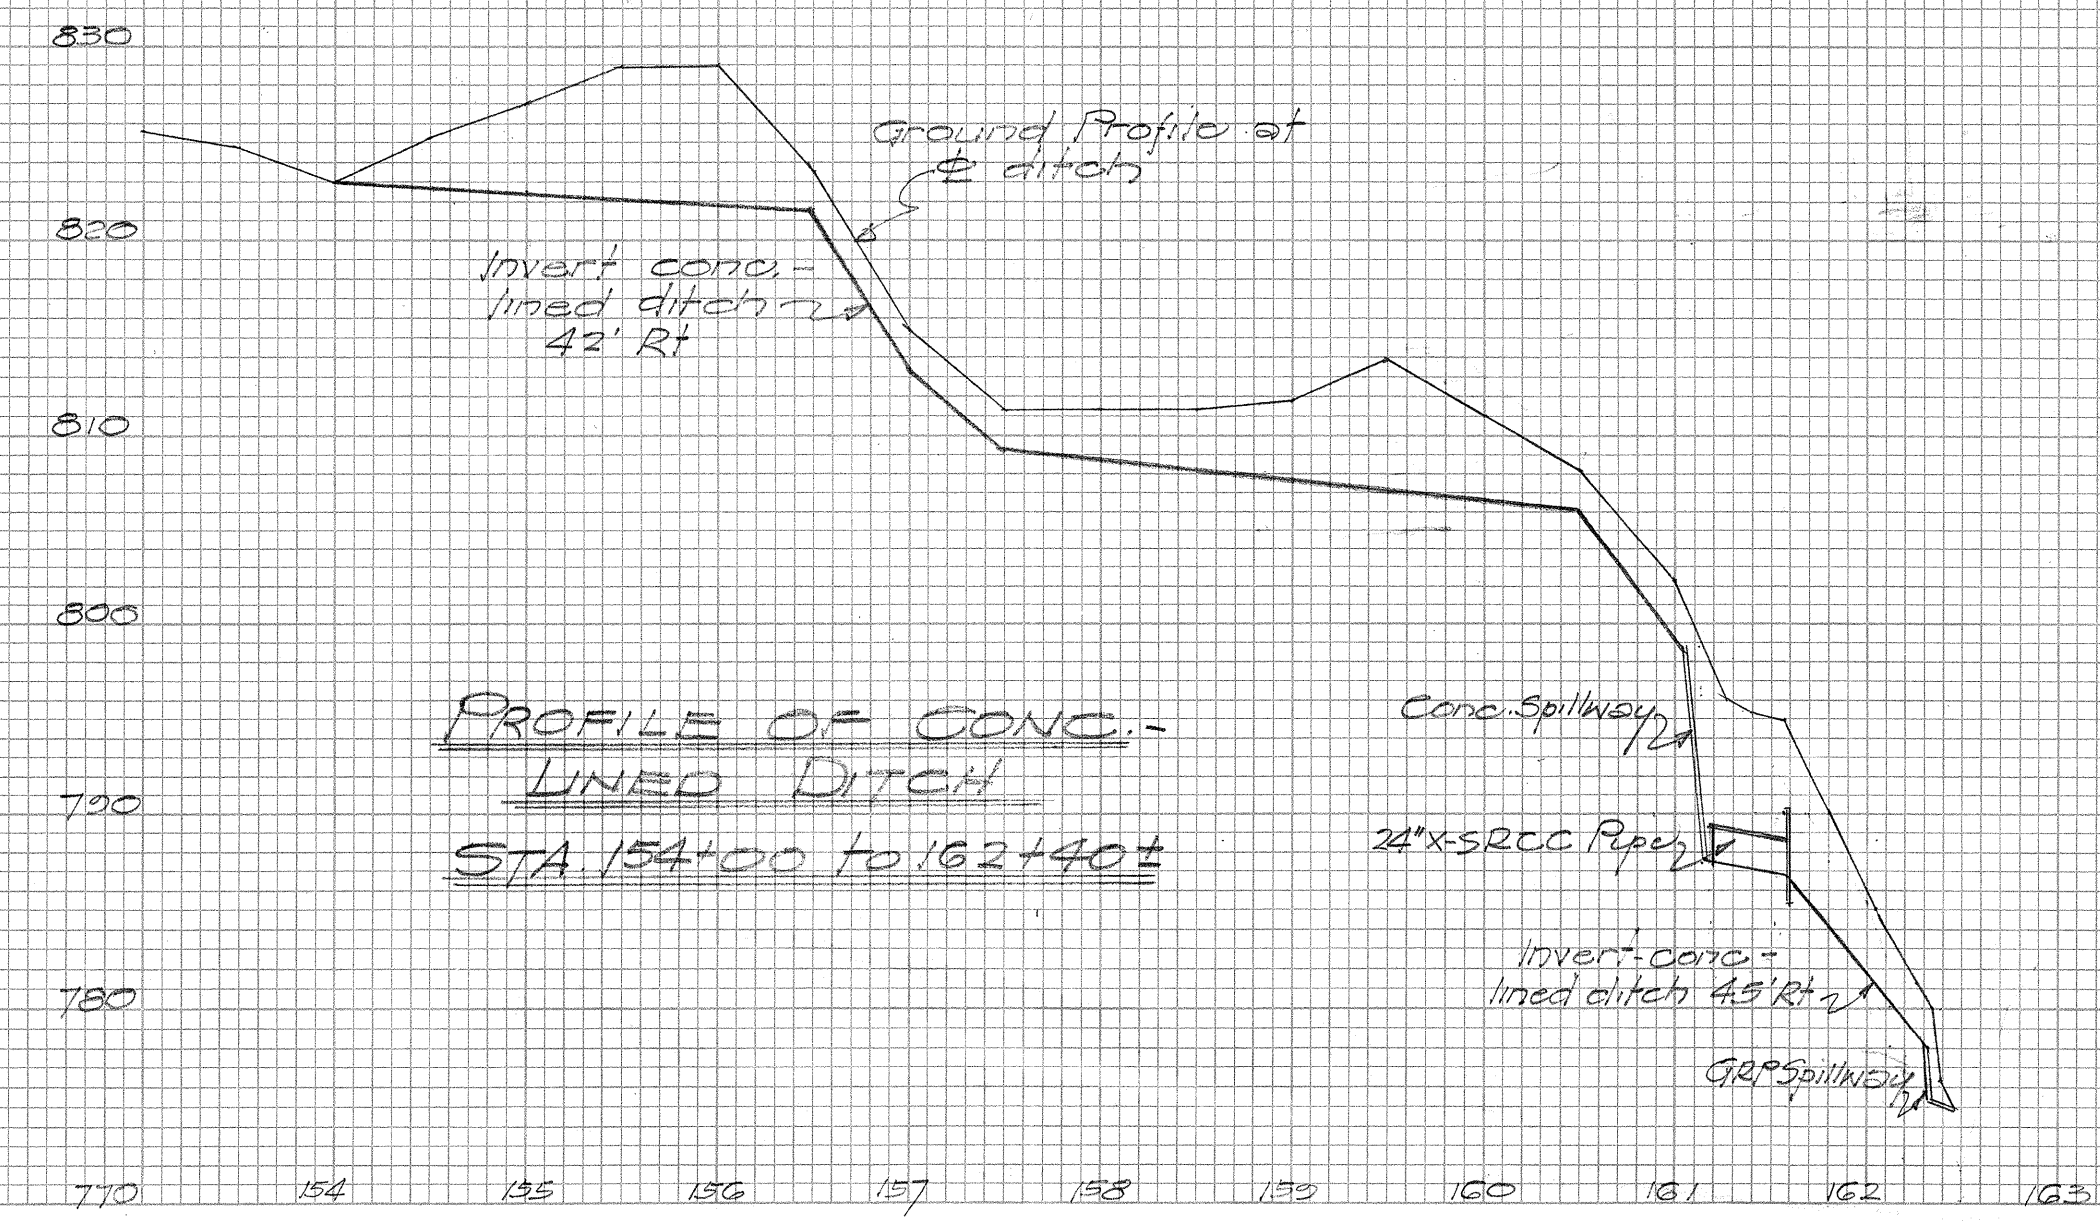
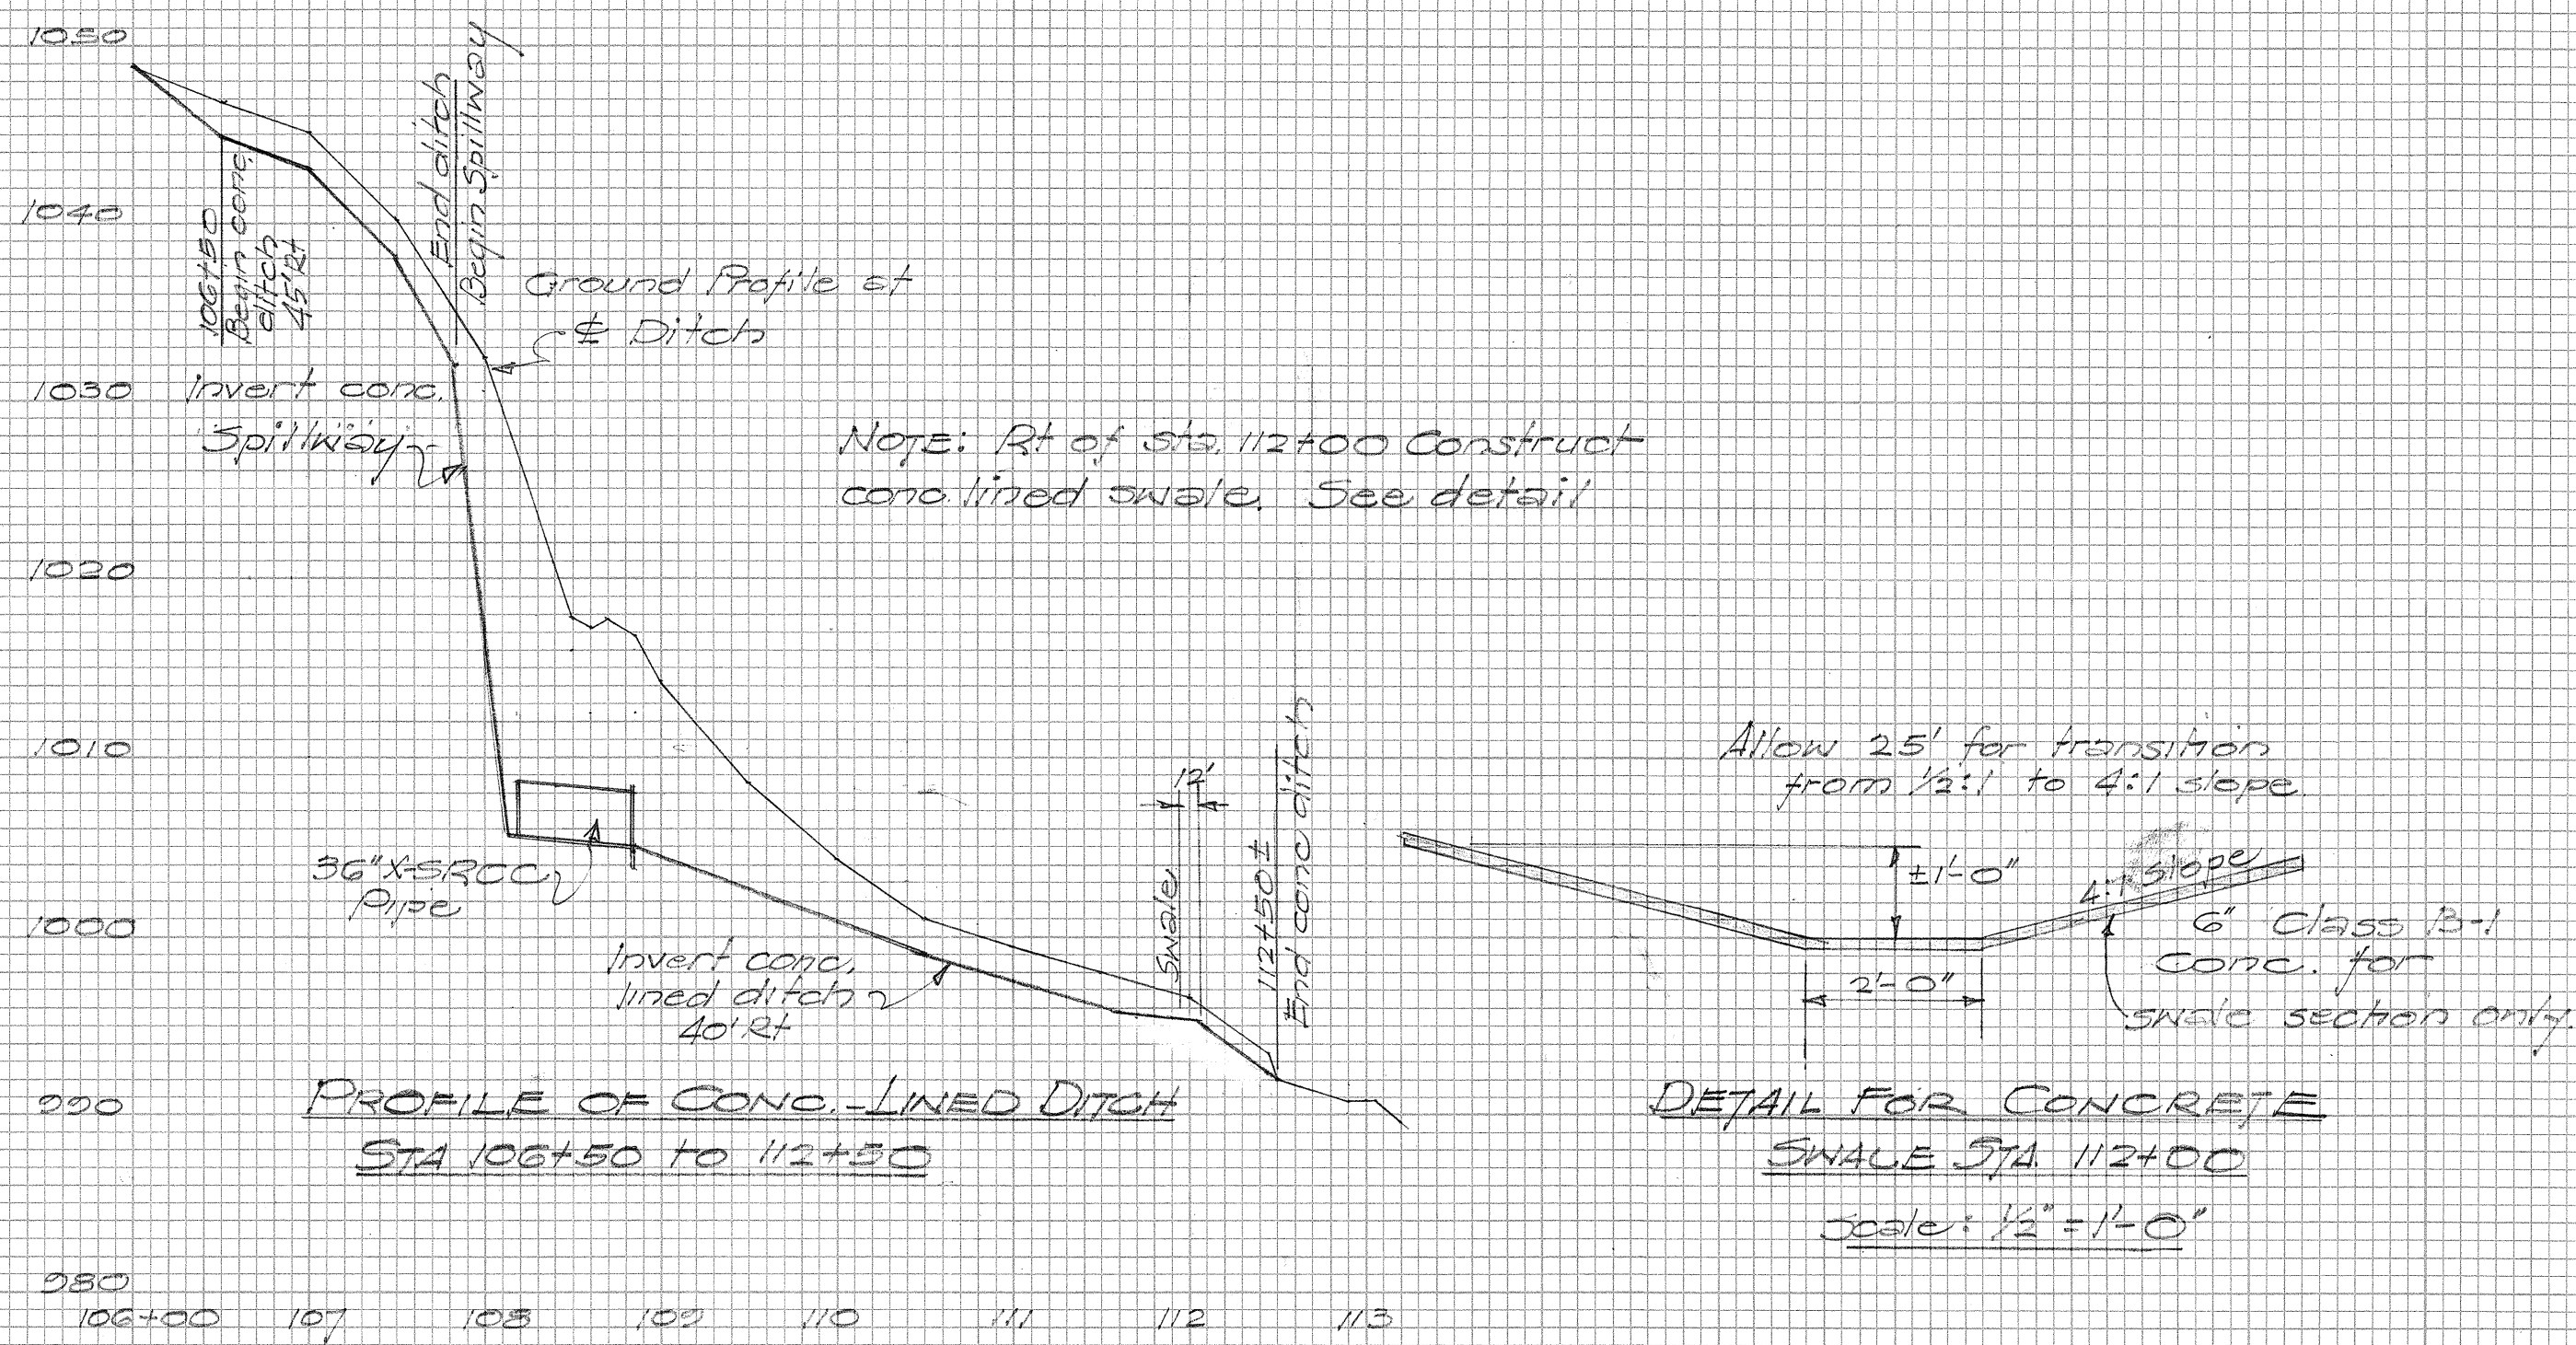


FED. ROAD DIST. No.	STATE	FED. AID PROJ. No.	FISCAL YEAR	SHEET No.	TOTAL SHEETS
HAWAII	HAW.	F002(6)	1958	69	69

FINAL SURVEY	DATE	BY
NOTE BOOK		
TEMPLATE		
AREAS		
FIELD CHECKED		

ORIGINAL SURVEY	DATE	BY
NOTE BOOK		
TEMPLATE		
AREAS		
FIELD CHECKED		

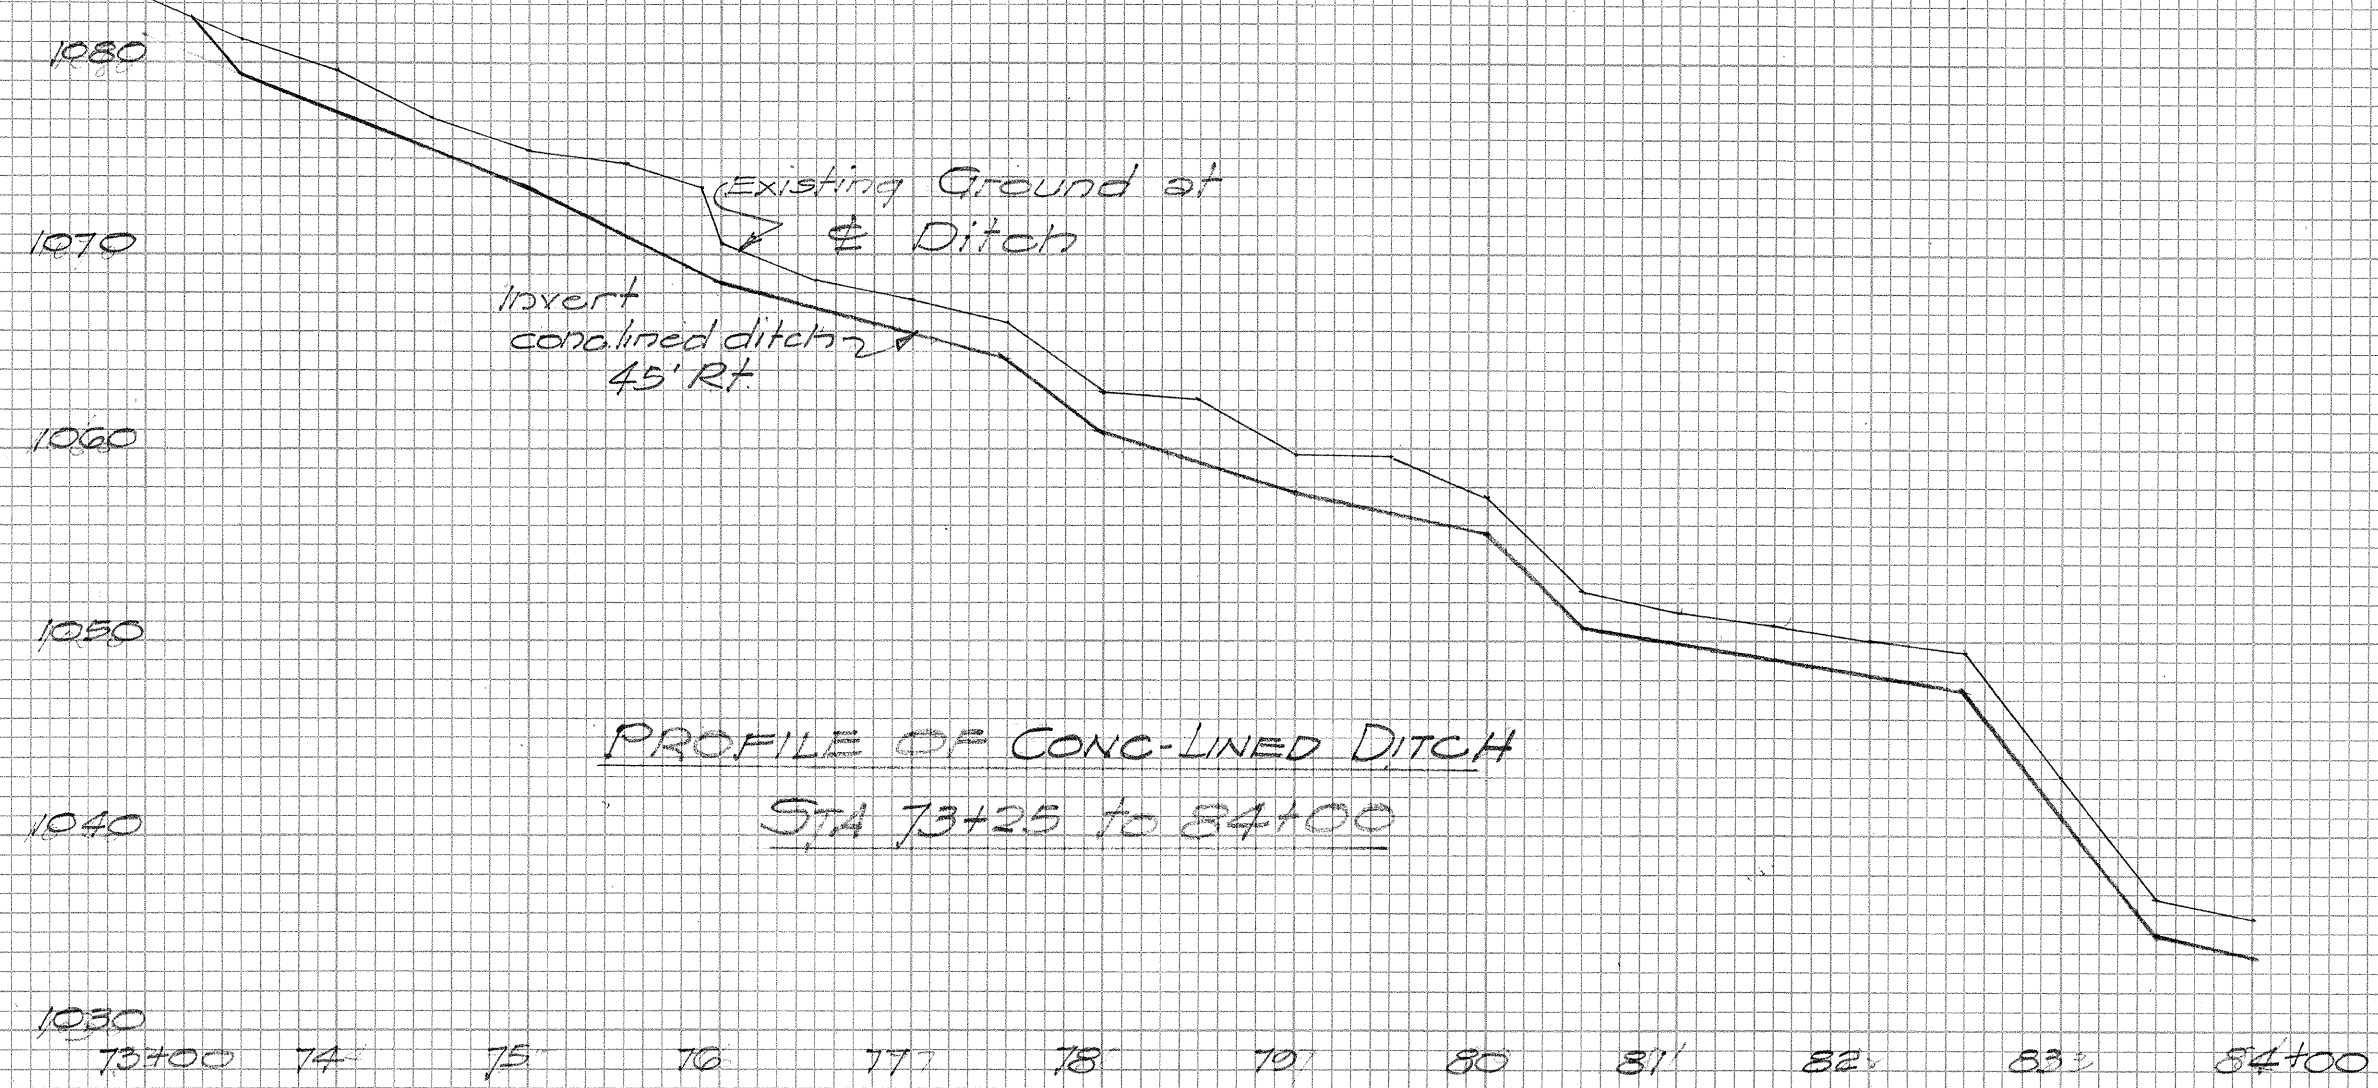

PROFILE OF DIVERSION DITCHES
HAWAII BELT ROAD
PROJ. F-012-2(G)
Scale as shown.