

INDEX TO DRAWINGS	
SHEET	DESCRIPTION
1	TITLE SHEET
2	TYPICAL SECTION
3-7	PLAN and PROFILE
8	BORROW PIT LOCATION
9	FLAT SLAB DETAIL
10-17	CONC. BOX CULVERT DETAILS
18-29	KAWAILIILII BRIDGE DETAILS
30-41	KALOPA BRIDGE DETAILS
42-68	GROSS SECTIONS
69	DIVERSION DITCH PROFILE



TERRITORY OF HAWAII
TERRITORIAL HIGHWAY DEPARTMENT
HONOLULU T.H.

PLANS OF
HAWAII BELT ROAD
PROJECT NO. F-019-2 (6)

DISTRICT OF HAMAKUA
ISLAND OF HAWAII

SCALE

PLAN ----- 1 in. = 100 ft.
PROFILE ----- HOR. 1 in. = 100 ft.
----- VER. 1 in. = 10 ft.
CROSS SECTION ----- HOR. 1 in. = 10 ft.
----- VER. 1 in. = 10 ft.

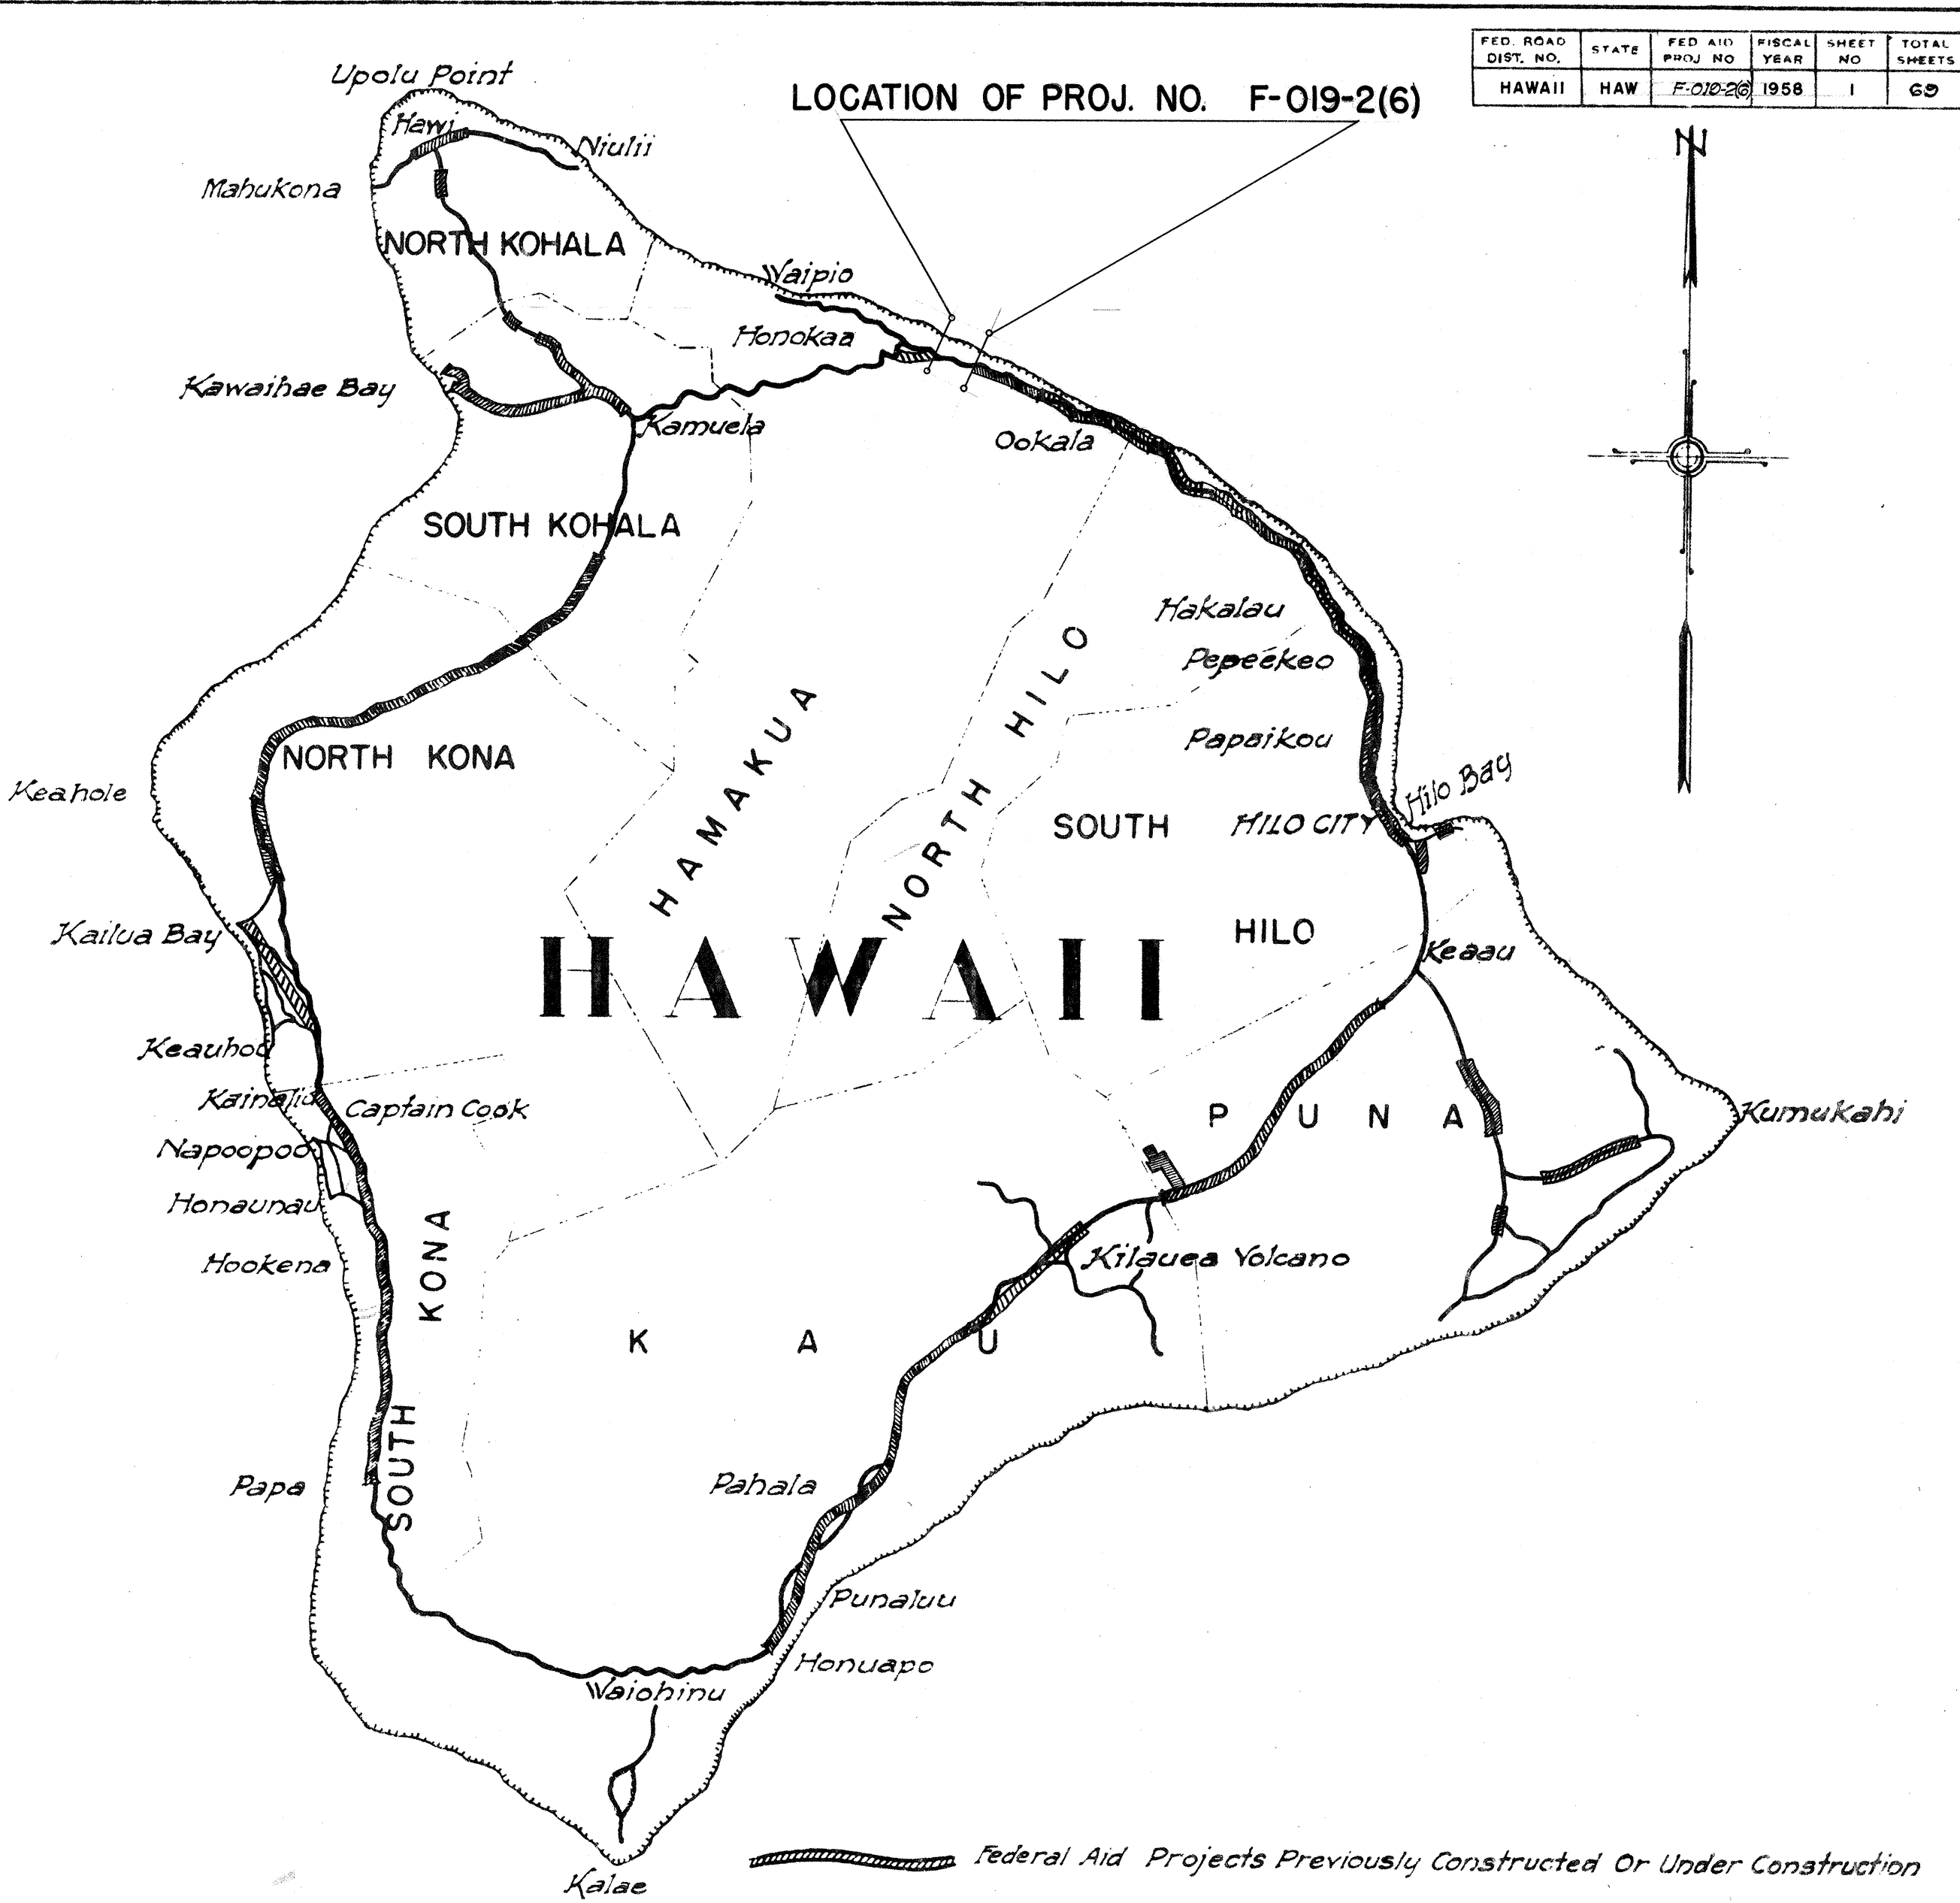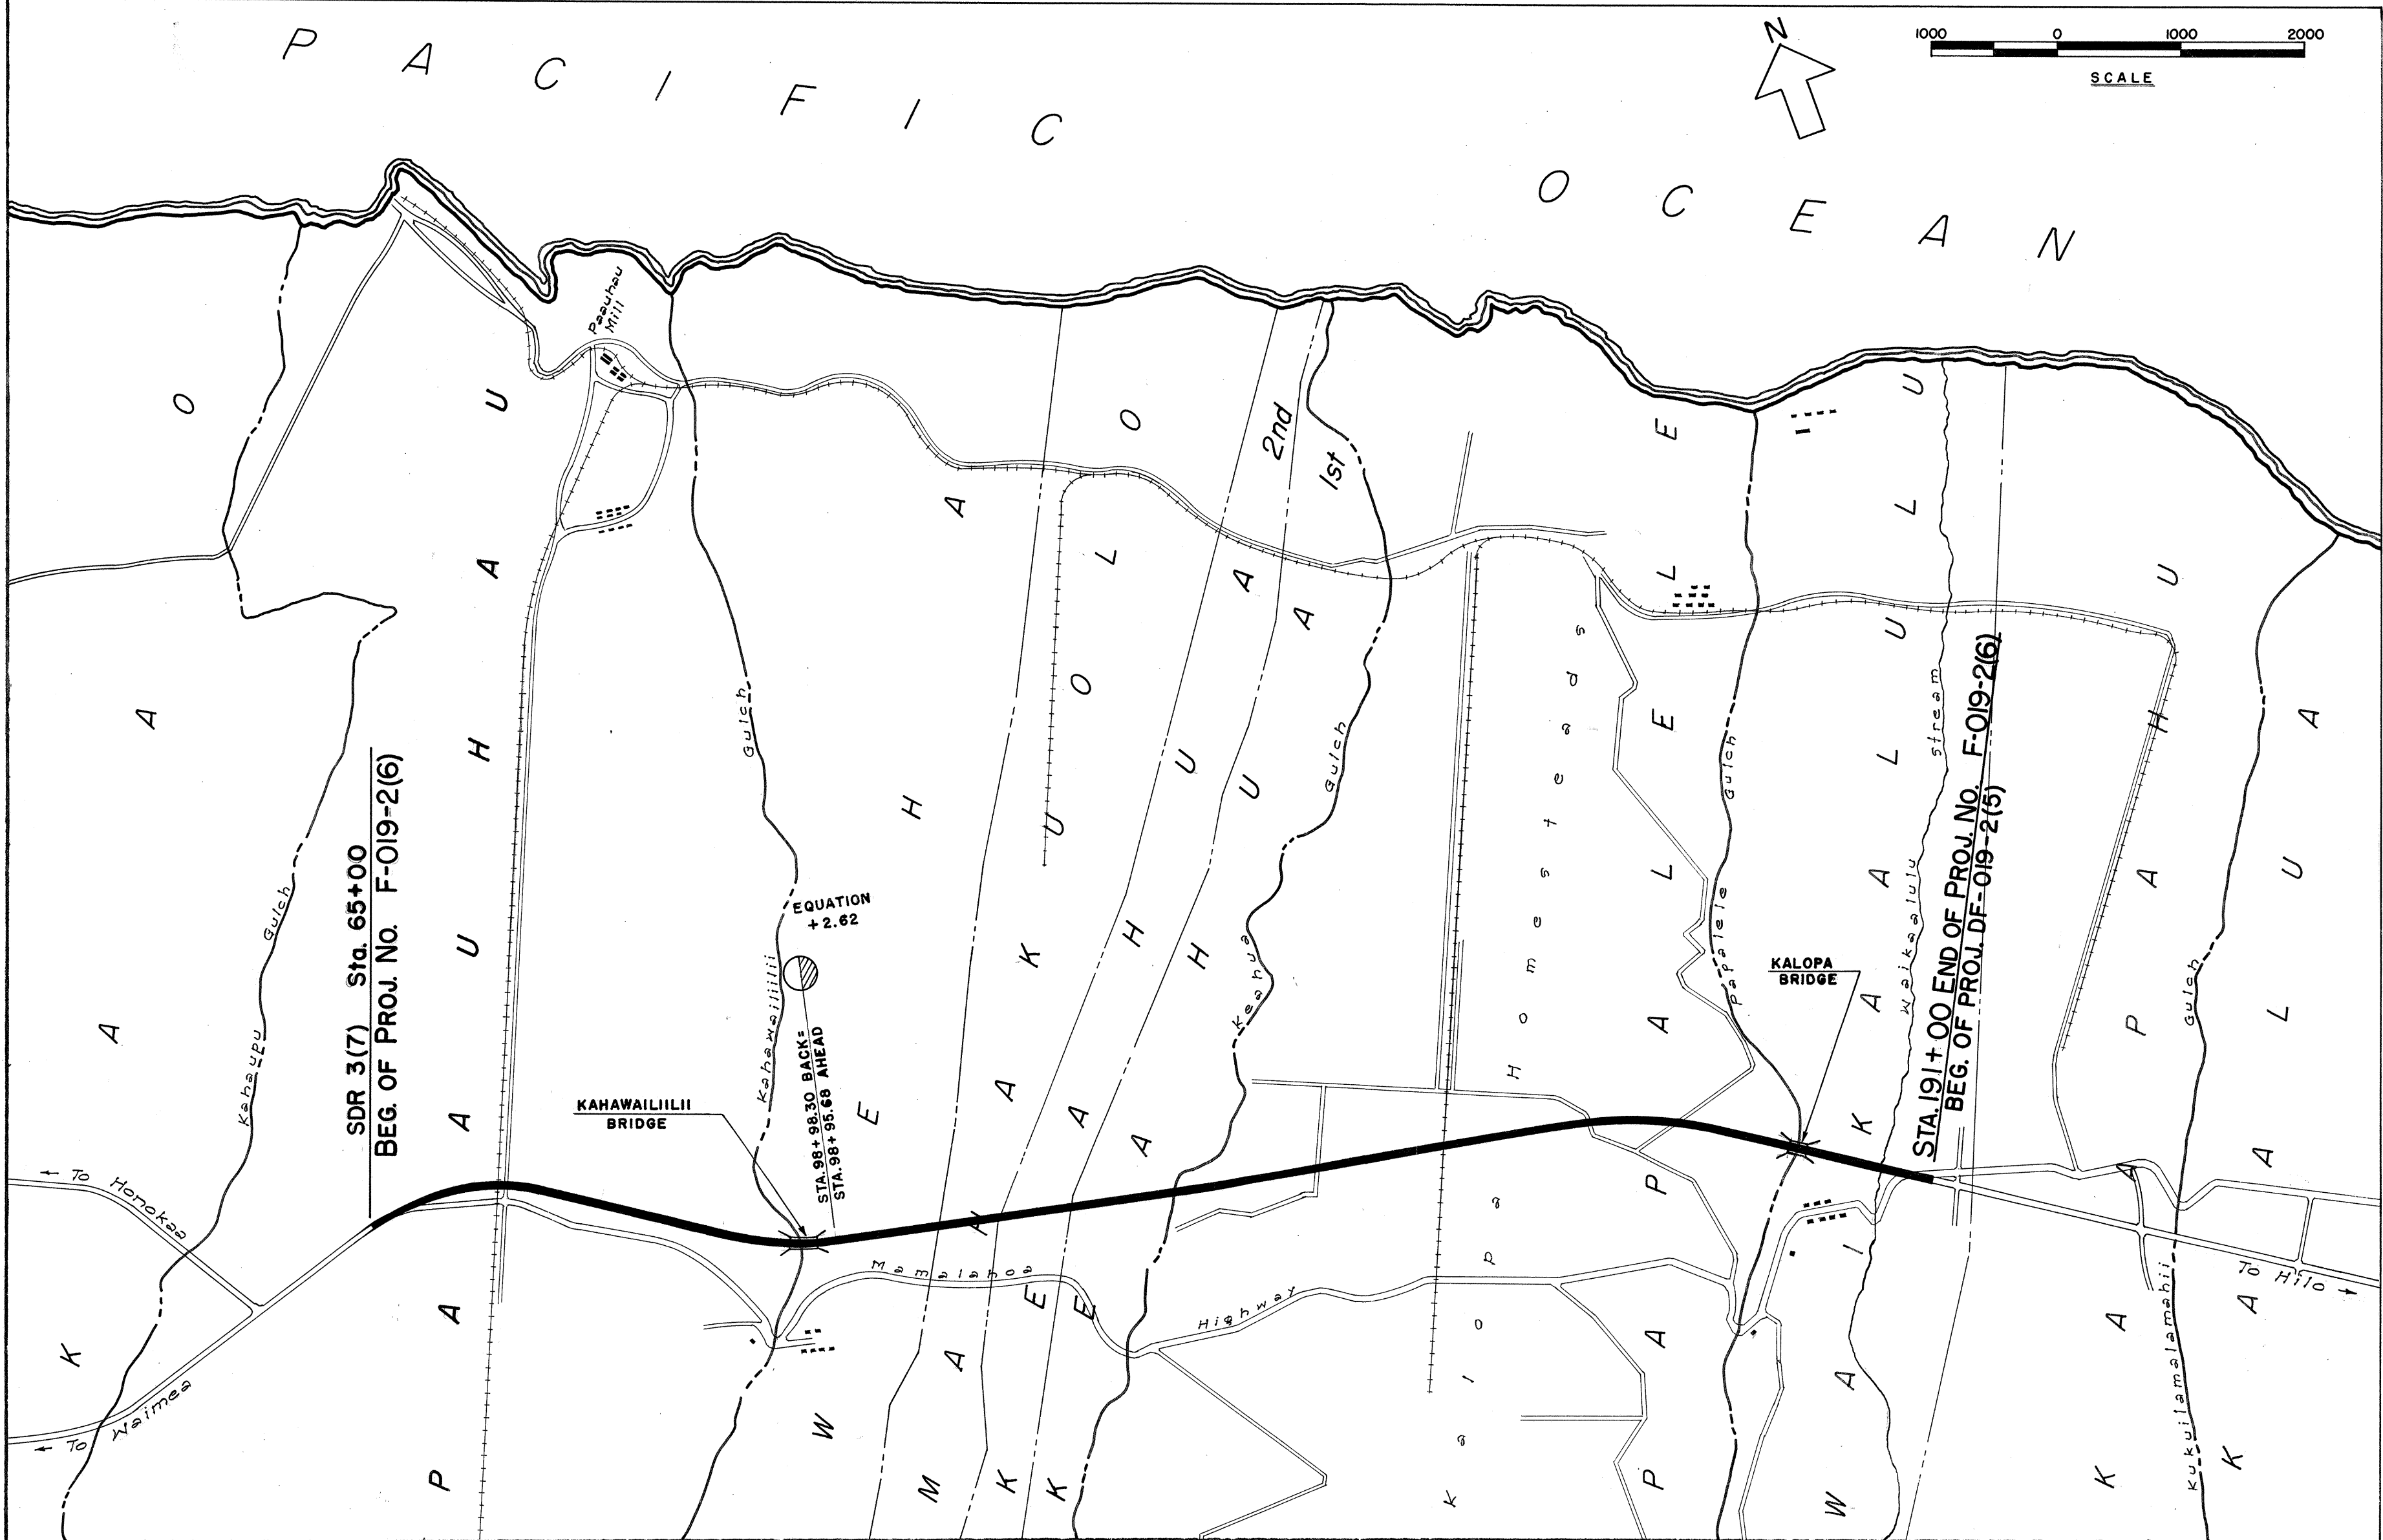

"AS BUILT" PLAN

NOTE: ALL CHANGES MADE DURING CONSTRUCTION
HAVE BEEN NOTED IN RED ON THESE TRACINGS
AND CHECKED BY:

[Signature]
DISTRICT ENGINEER
DATE: 8/23/60

ROADWAY ----- 2.283 MI.
BRIDGES ----- .104 MI.
GROSS LENGTH of PROJECT - 2.387 MI.

APPROVED: *[Signature]* DATE 9/22/58
TERRITORIAL HIGHWAY ENGINEER

DEPARTMENT OF COMMERCE
BUREAU OF PUBLIC ROADS

APPROVED: _____
DIVISION ENGINEER DATE