
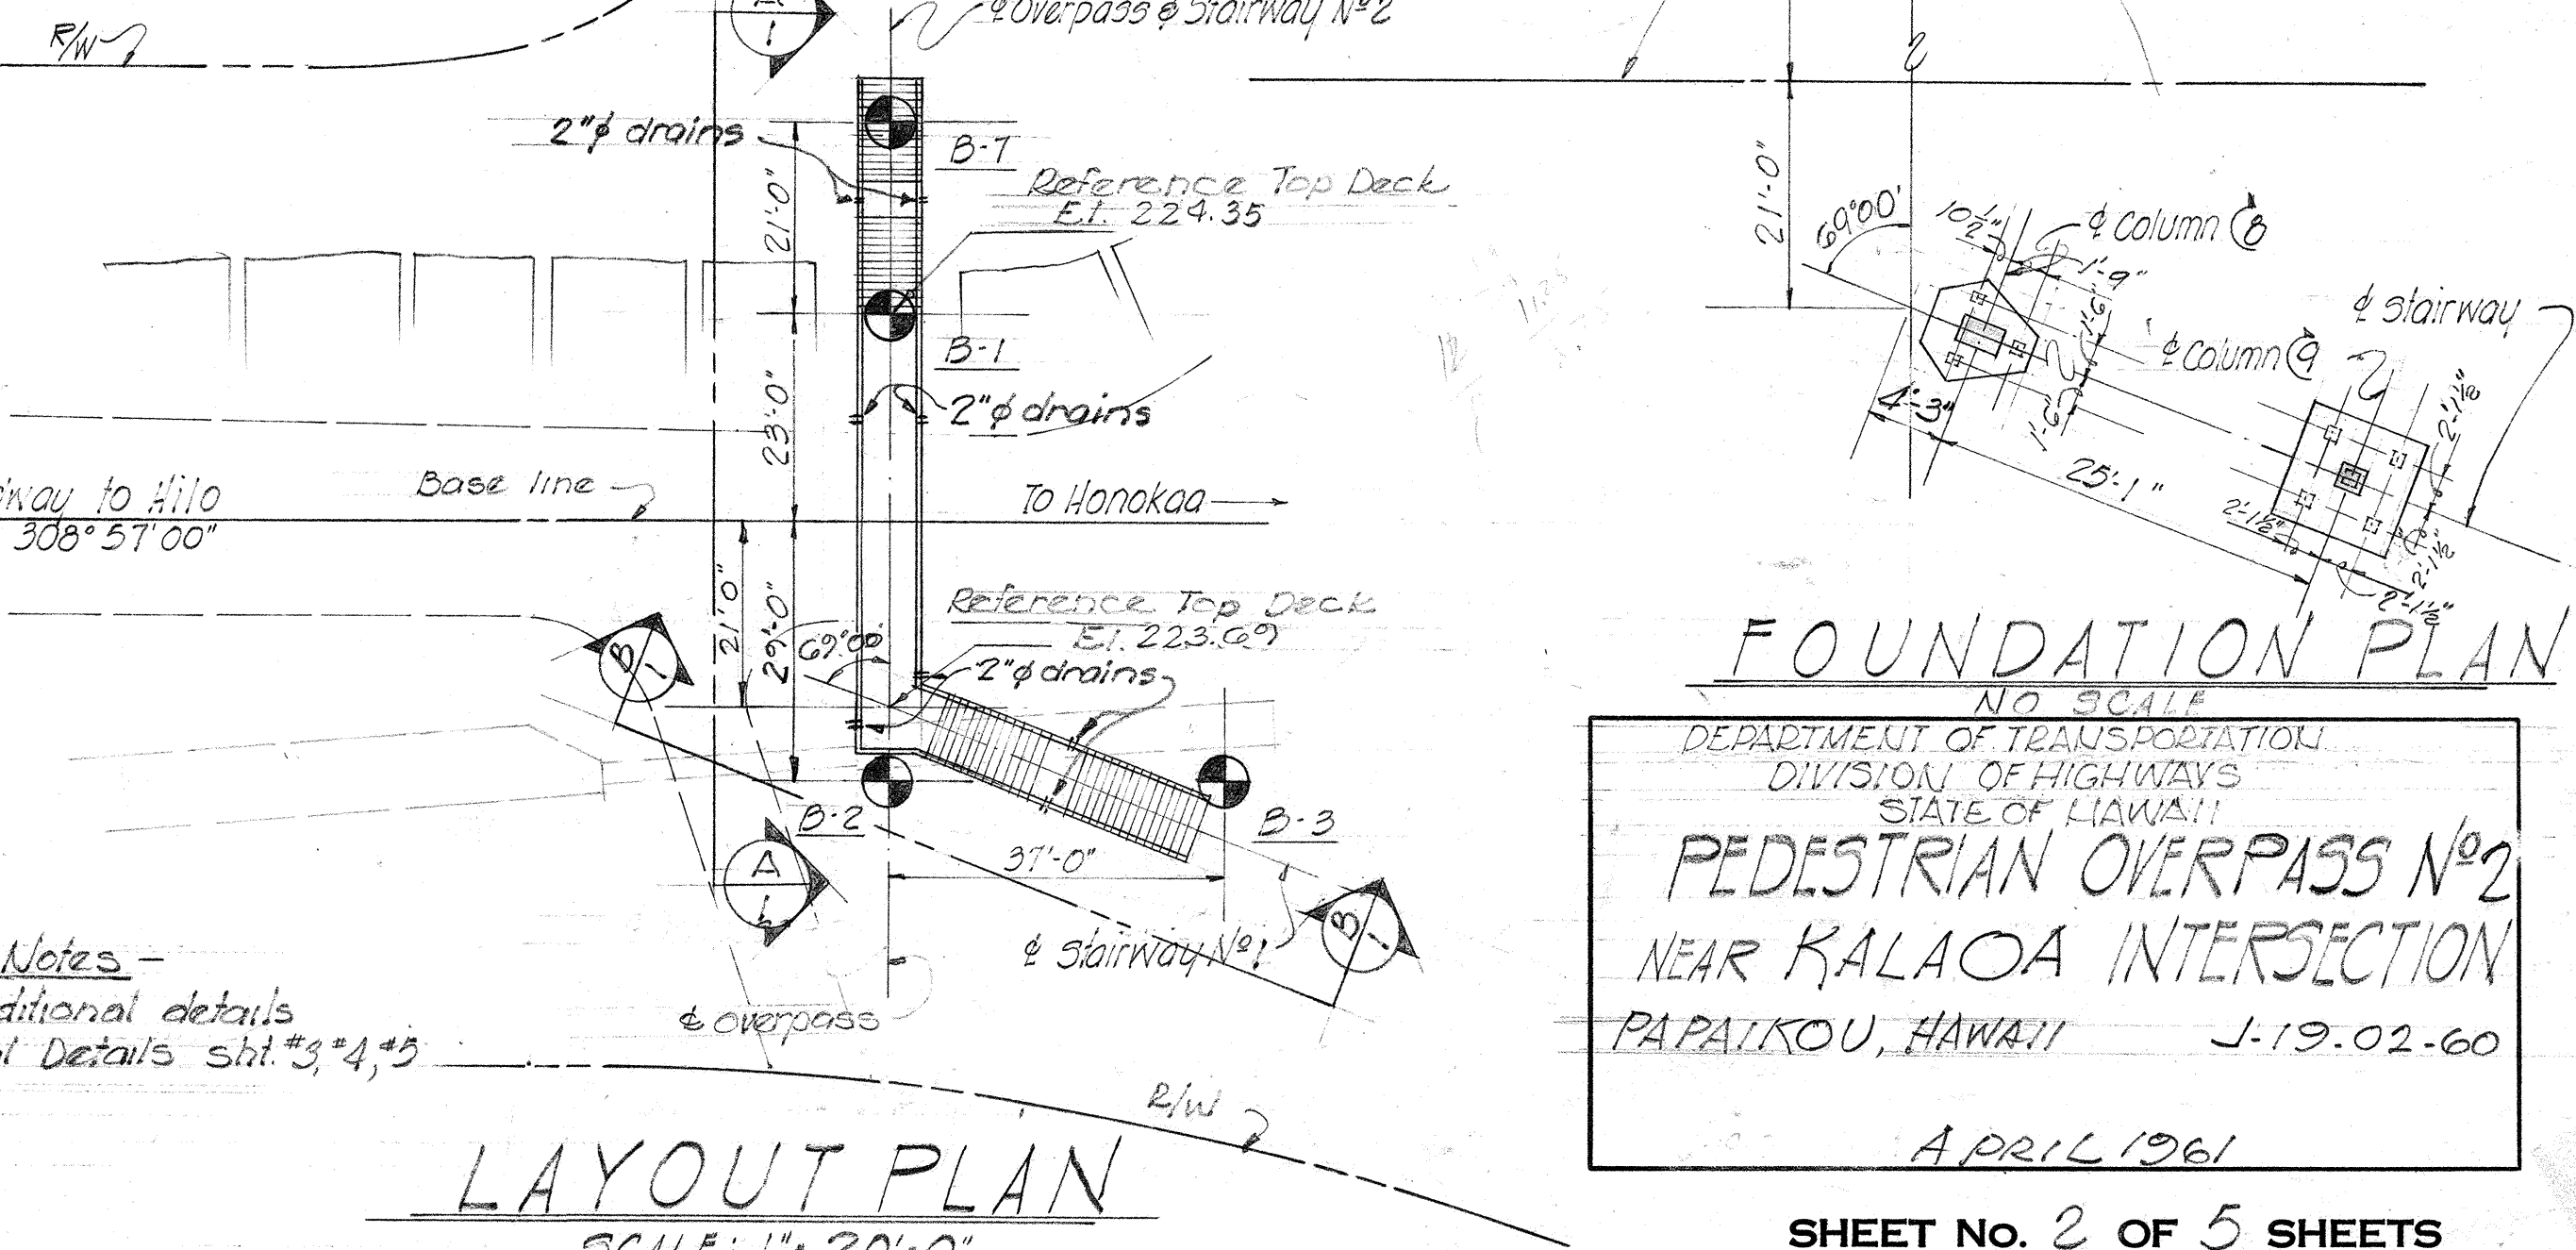
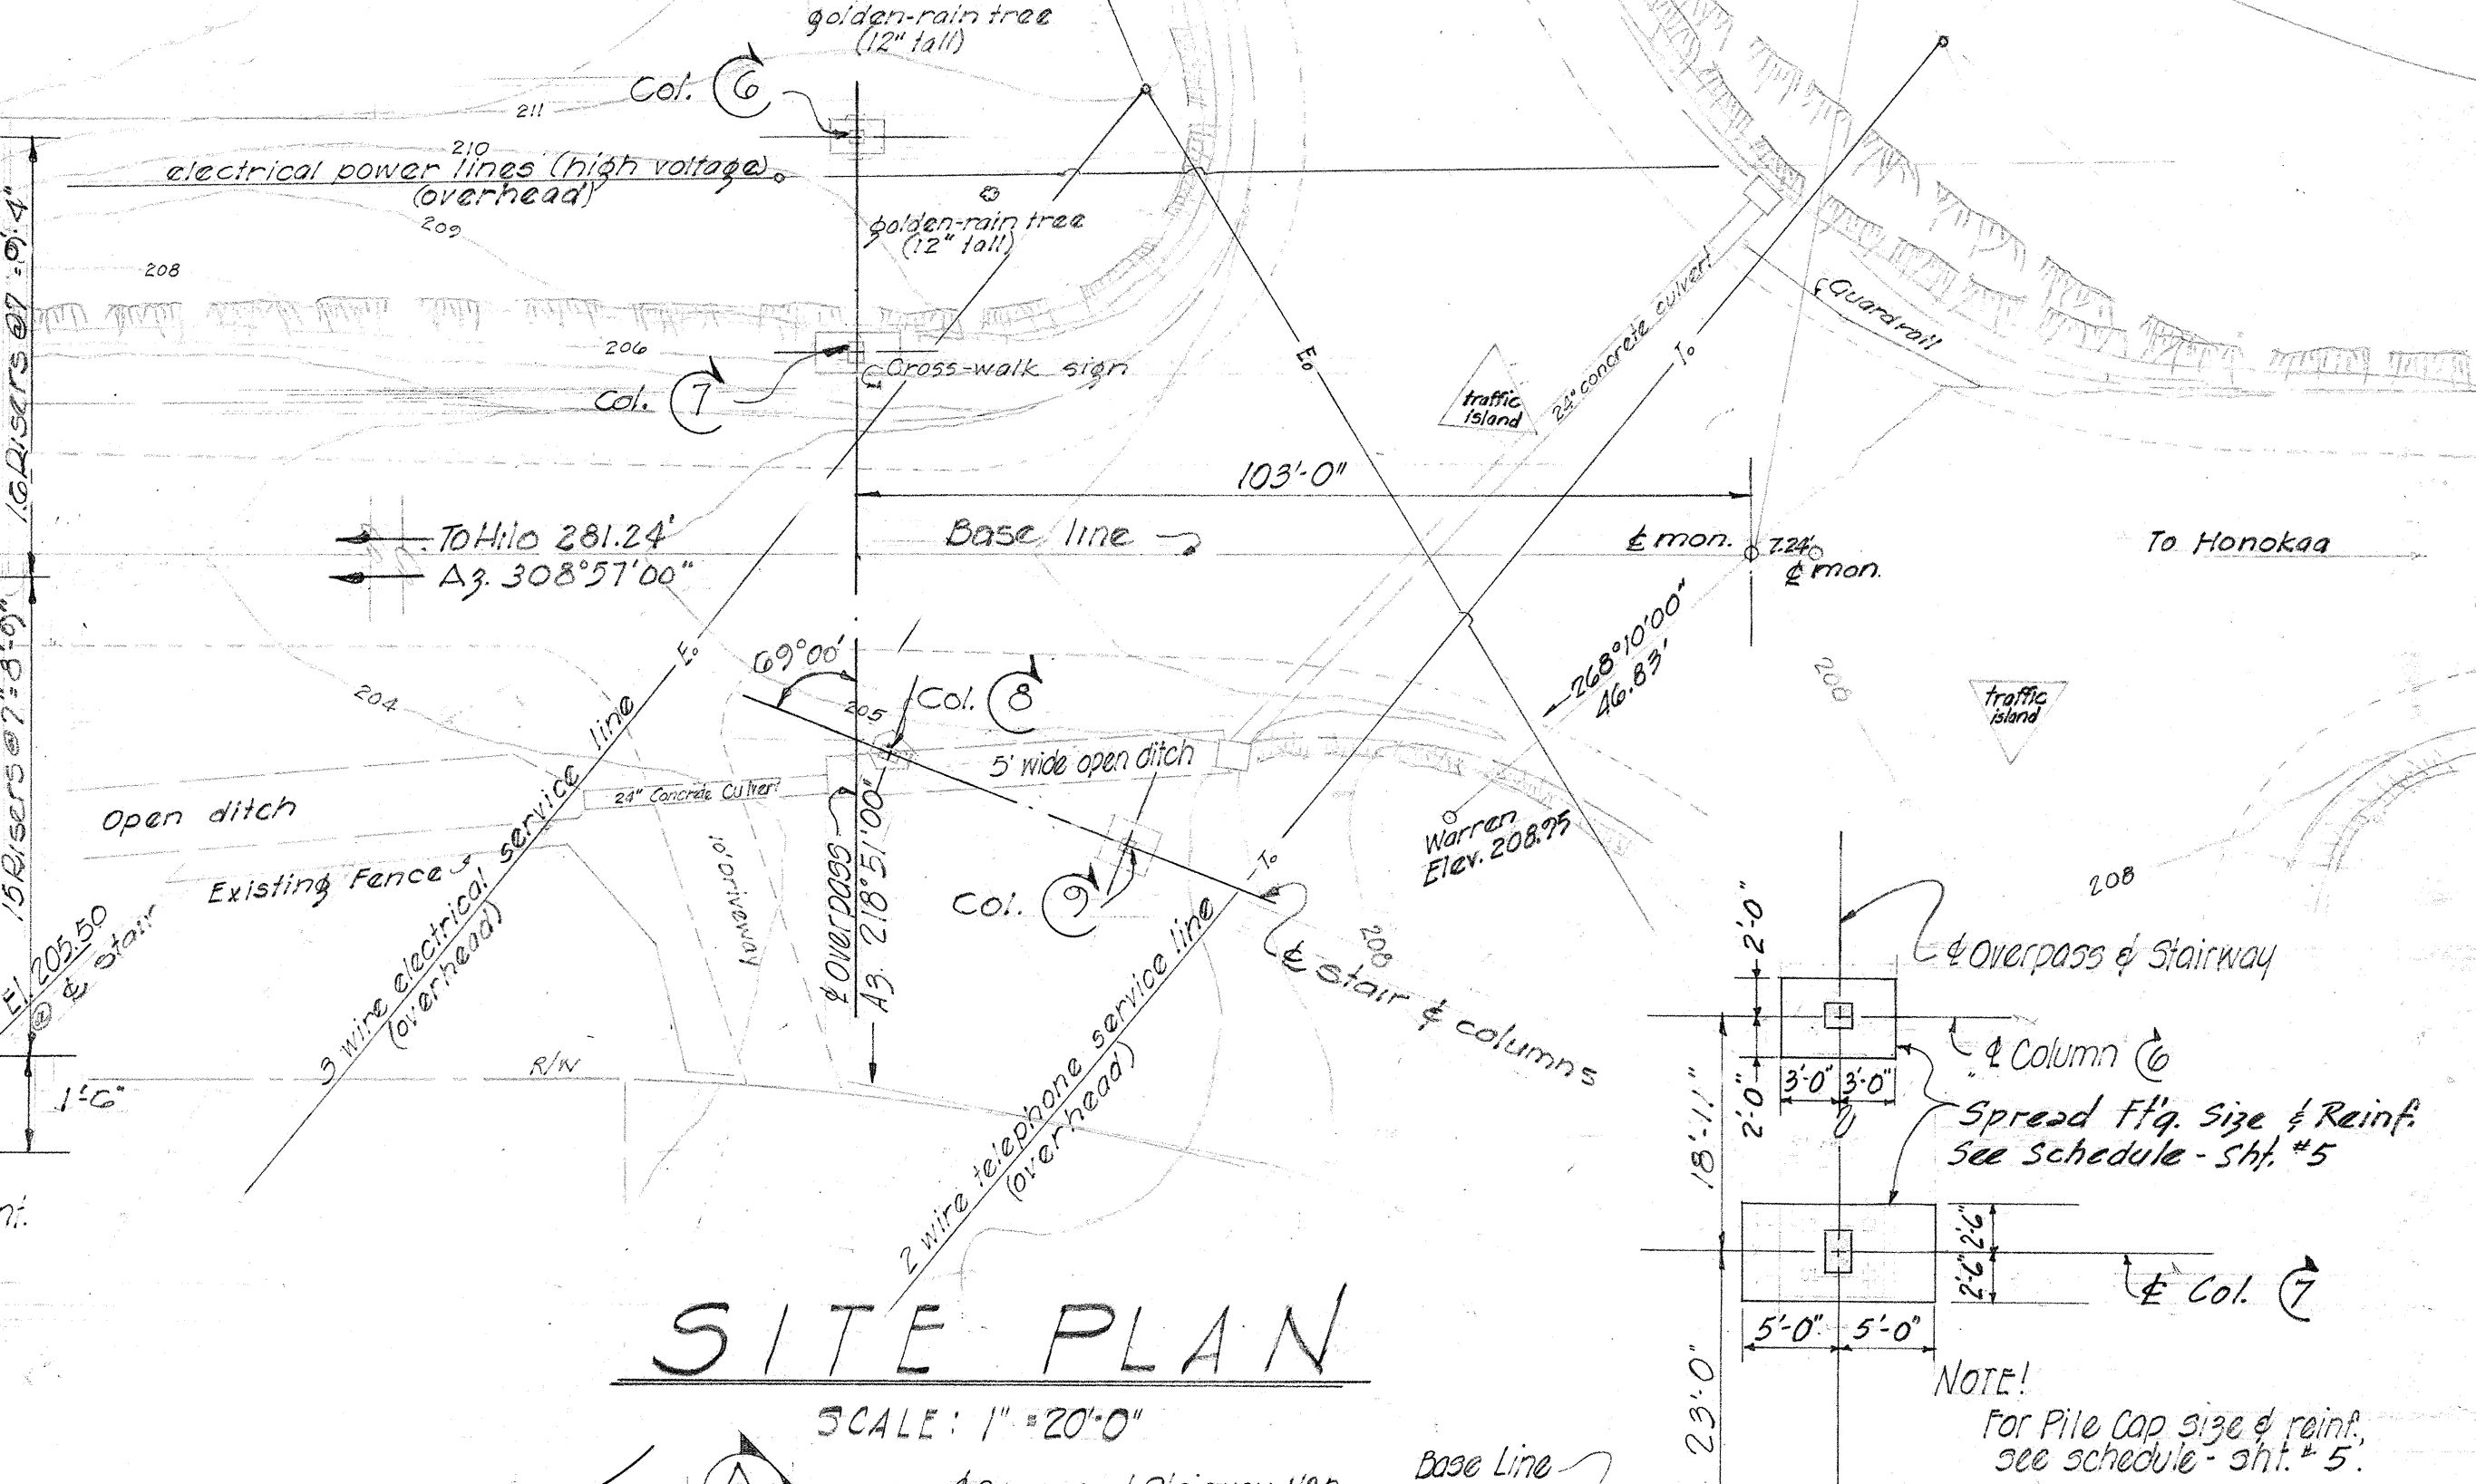
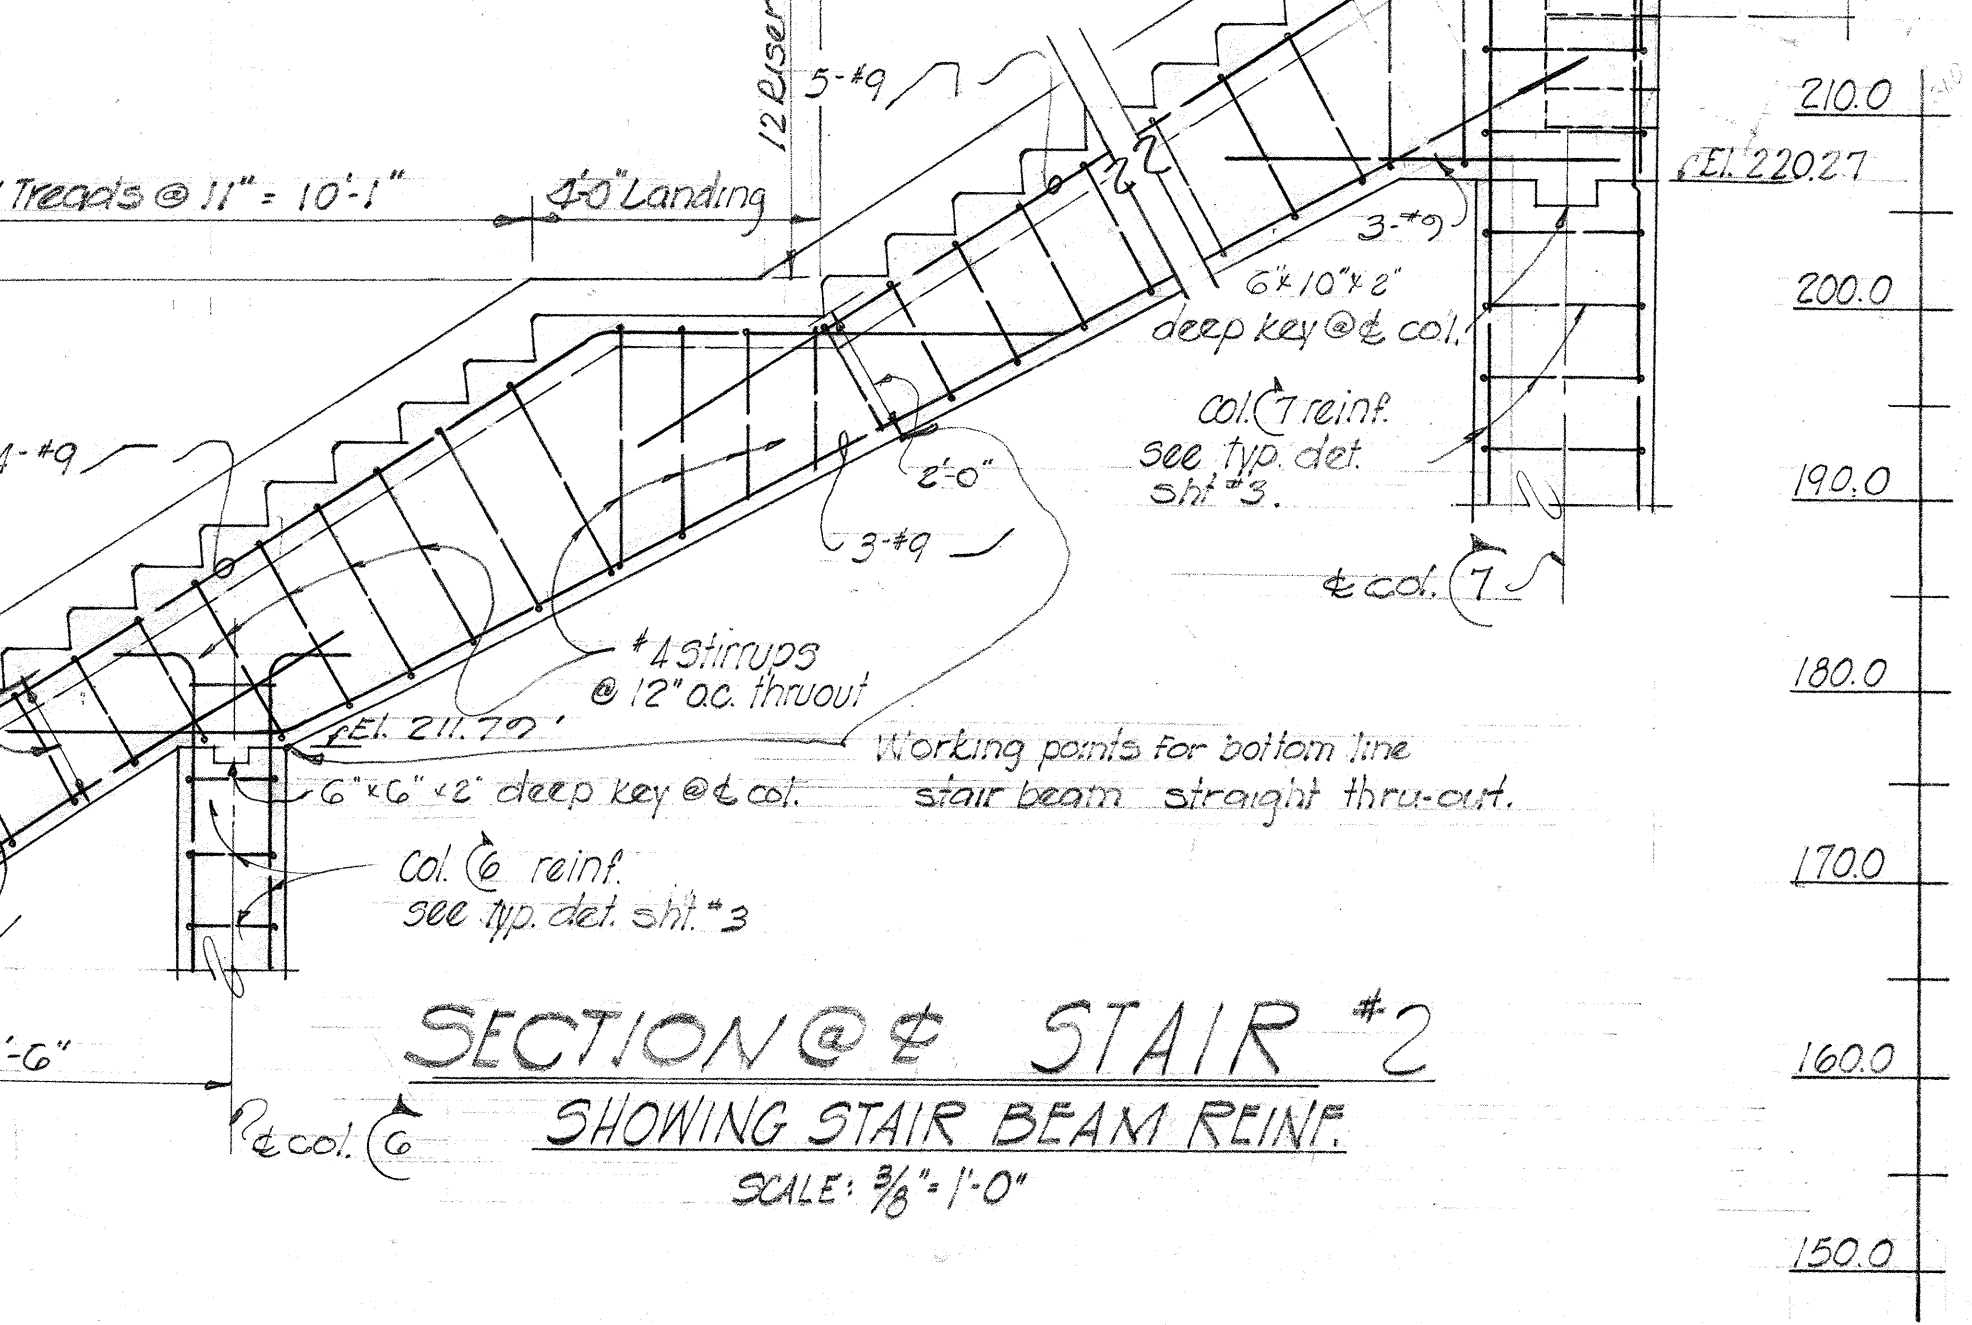
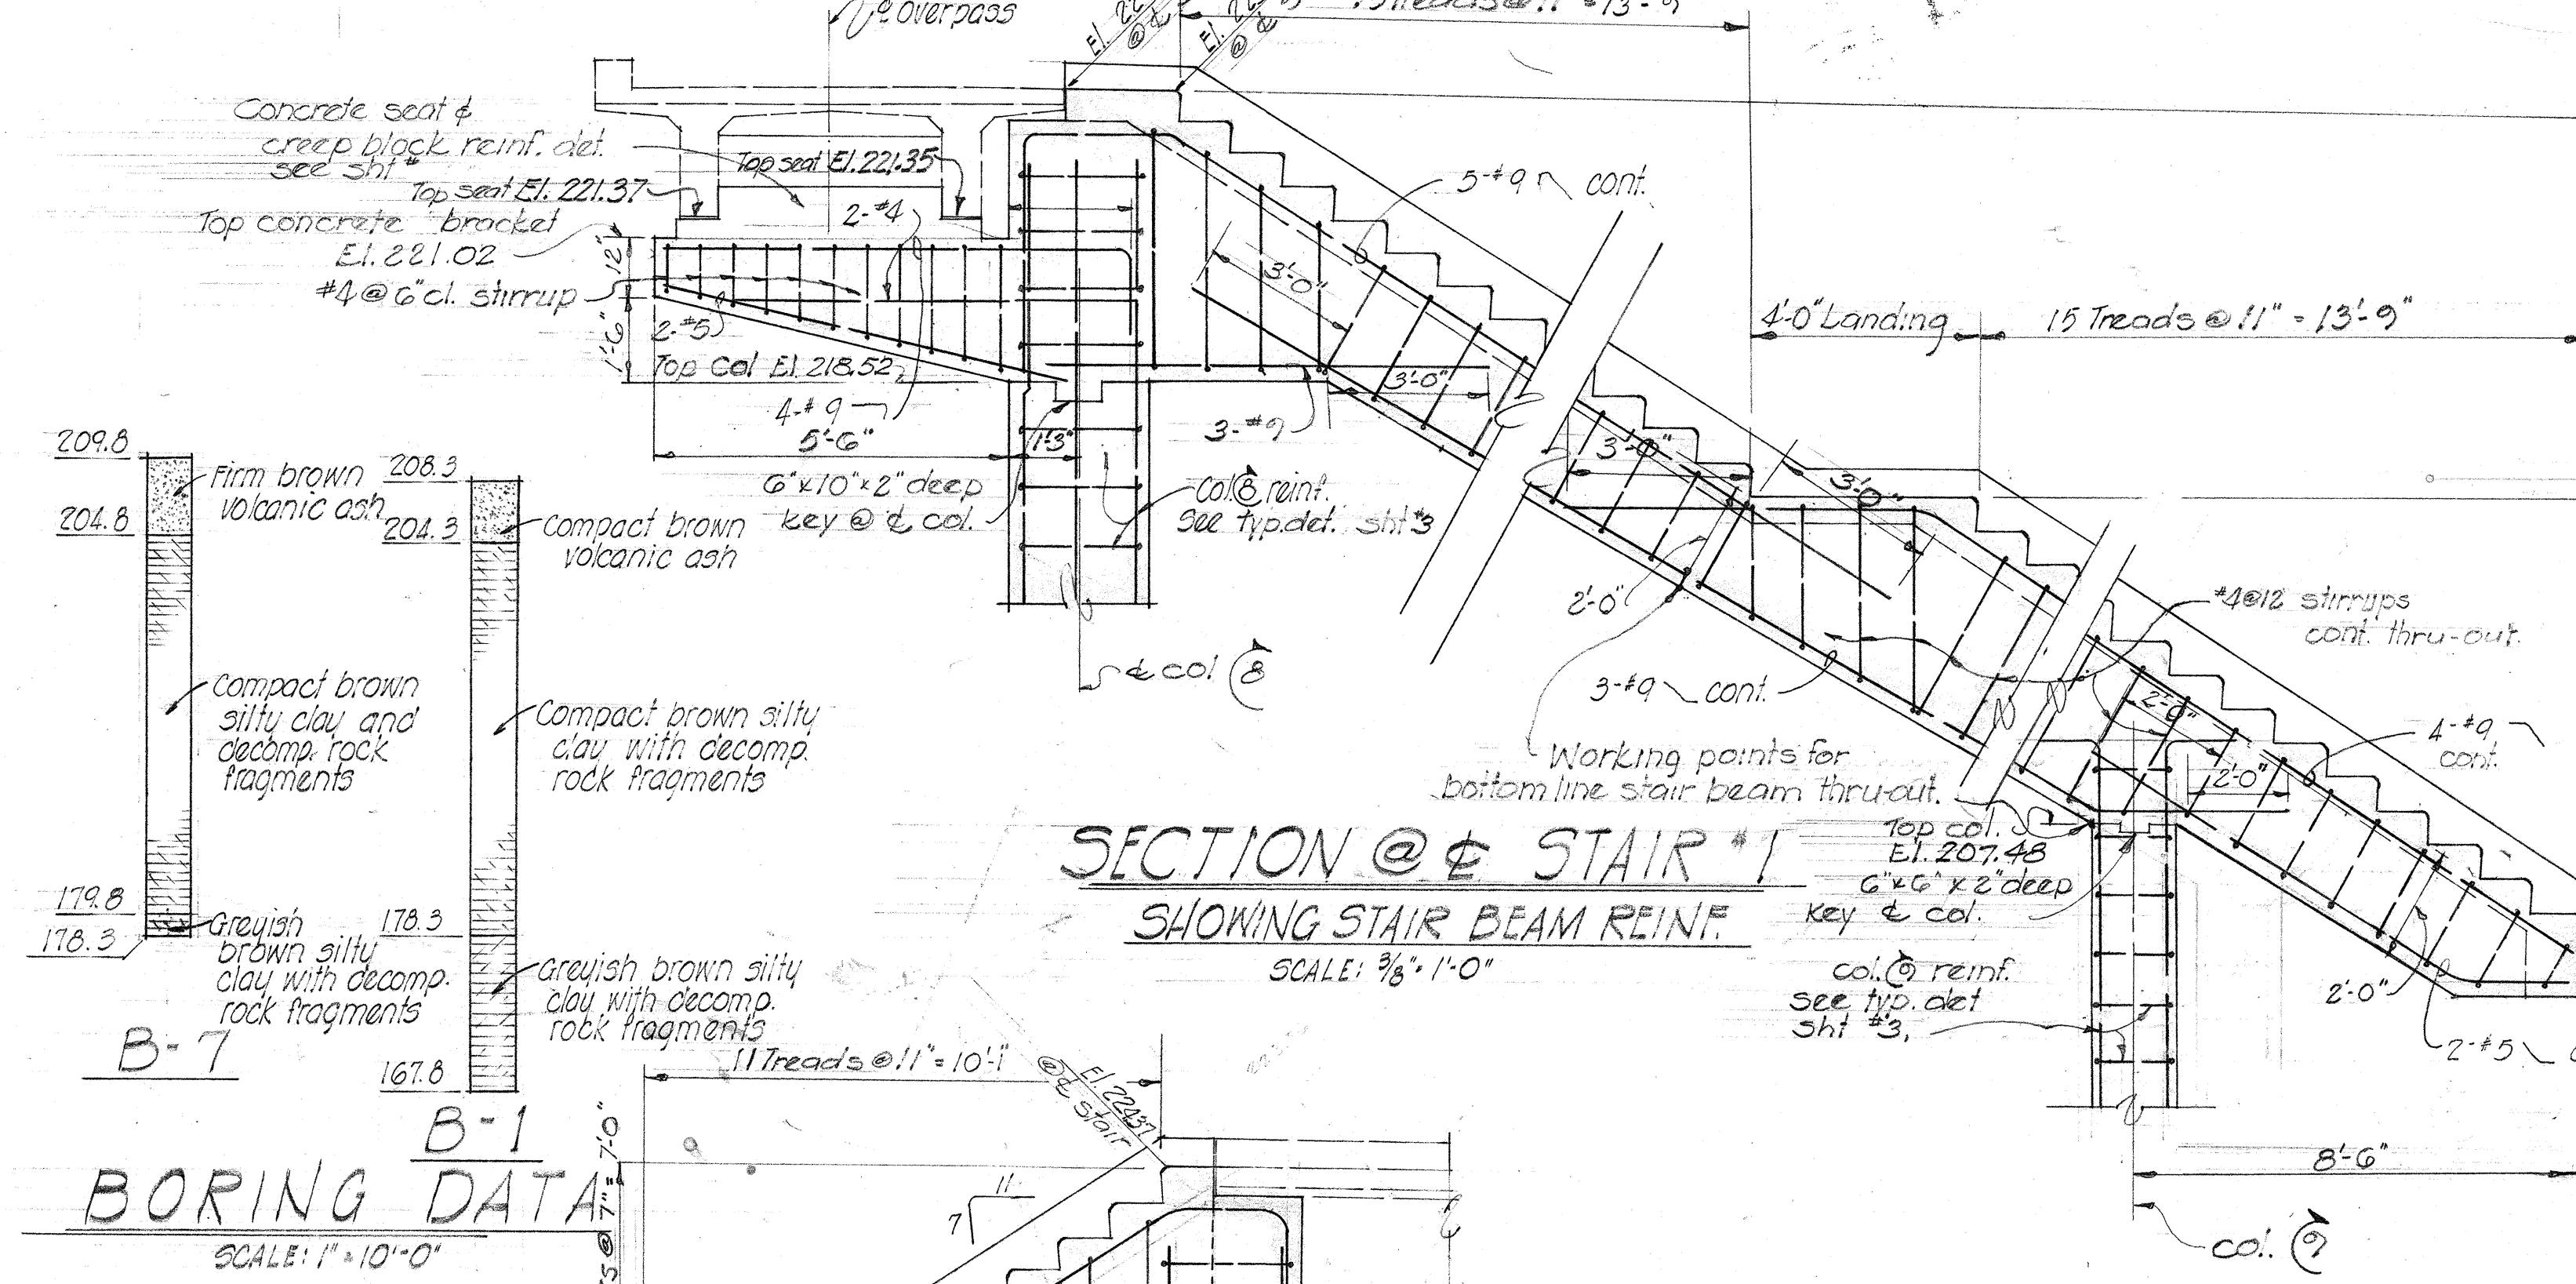


ESTIMATED QUANTITIES

FED. ROAD DIST. NO.	STATE	PROJ. NO.	FISCAL YEAR	SHEET NO.	TOTAL SHEETS
HAW.	1-19-02-60	1901	3	6	

Class A-1 concrete	Lump sum	(48,000 yd)
Reinforcing Steel	Lump sum	(7,900 lbs)
Structural Exc.		49.00 yd
Railing		229.0 Lin. Ft.
Piles		211.0 Lin. Ft.
Prestress T-Grinder		101.0 Lin. Ft.

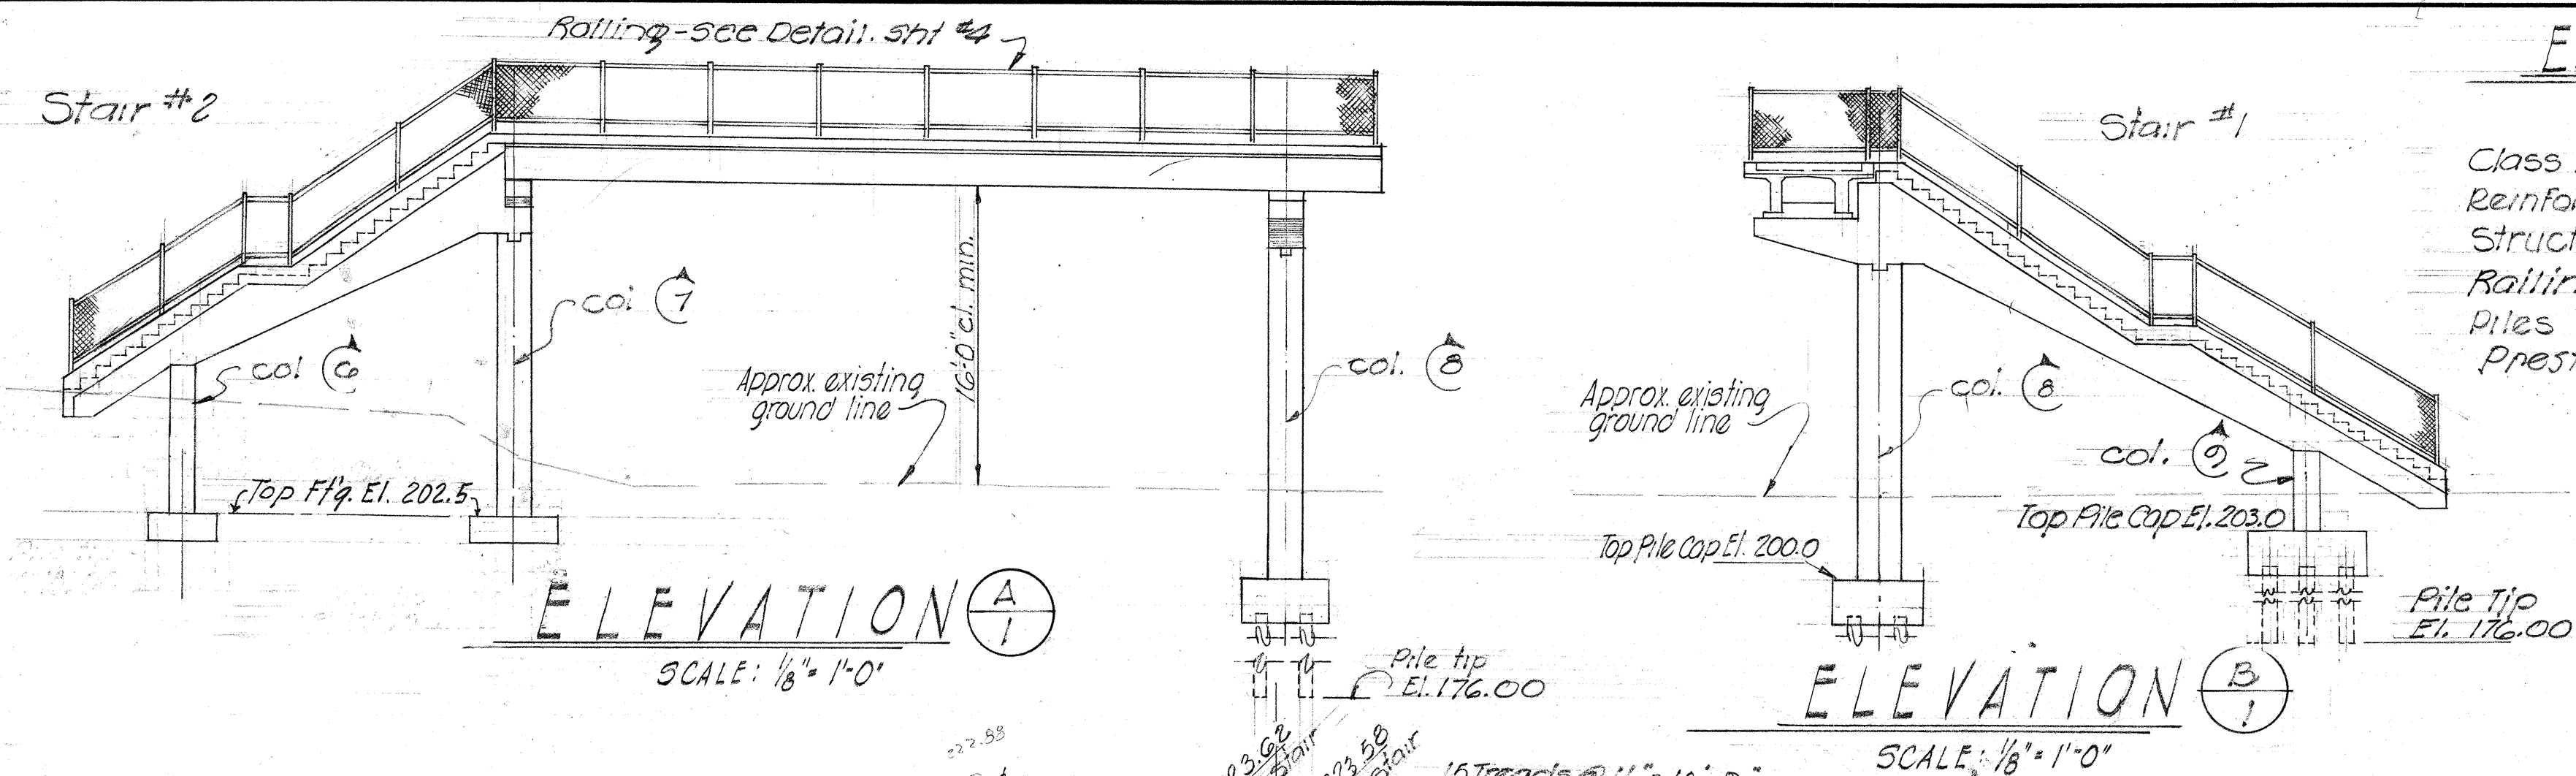

NO. 90414
DEPARTMENT OF TRANSPORTATION
DIVISION OF HIGHWAYS
STATE OF HAWAII
PEDESTRIAN OVERPASS No. 2
NEAR KALAOA INTERSECTION
PAPA'IKOU, HAWAII
J-19-02-60
APRIL 1961

SURVEY PLOTTED BY	DATE
DRAWN BY	
CHECKED BY	
ORIGINAL PLAN	
NOTE BOOK	
NO.	