
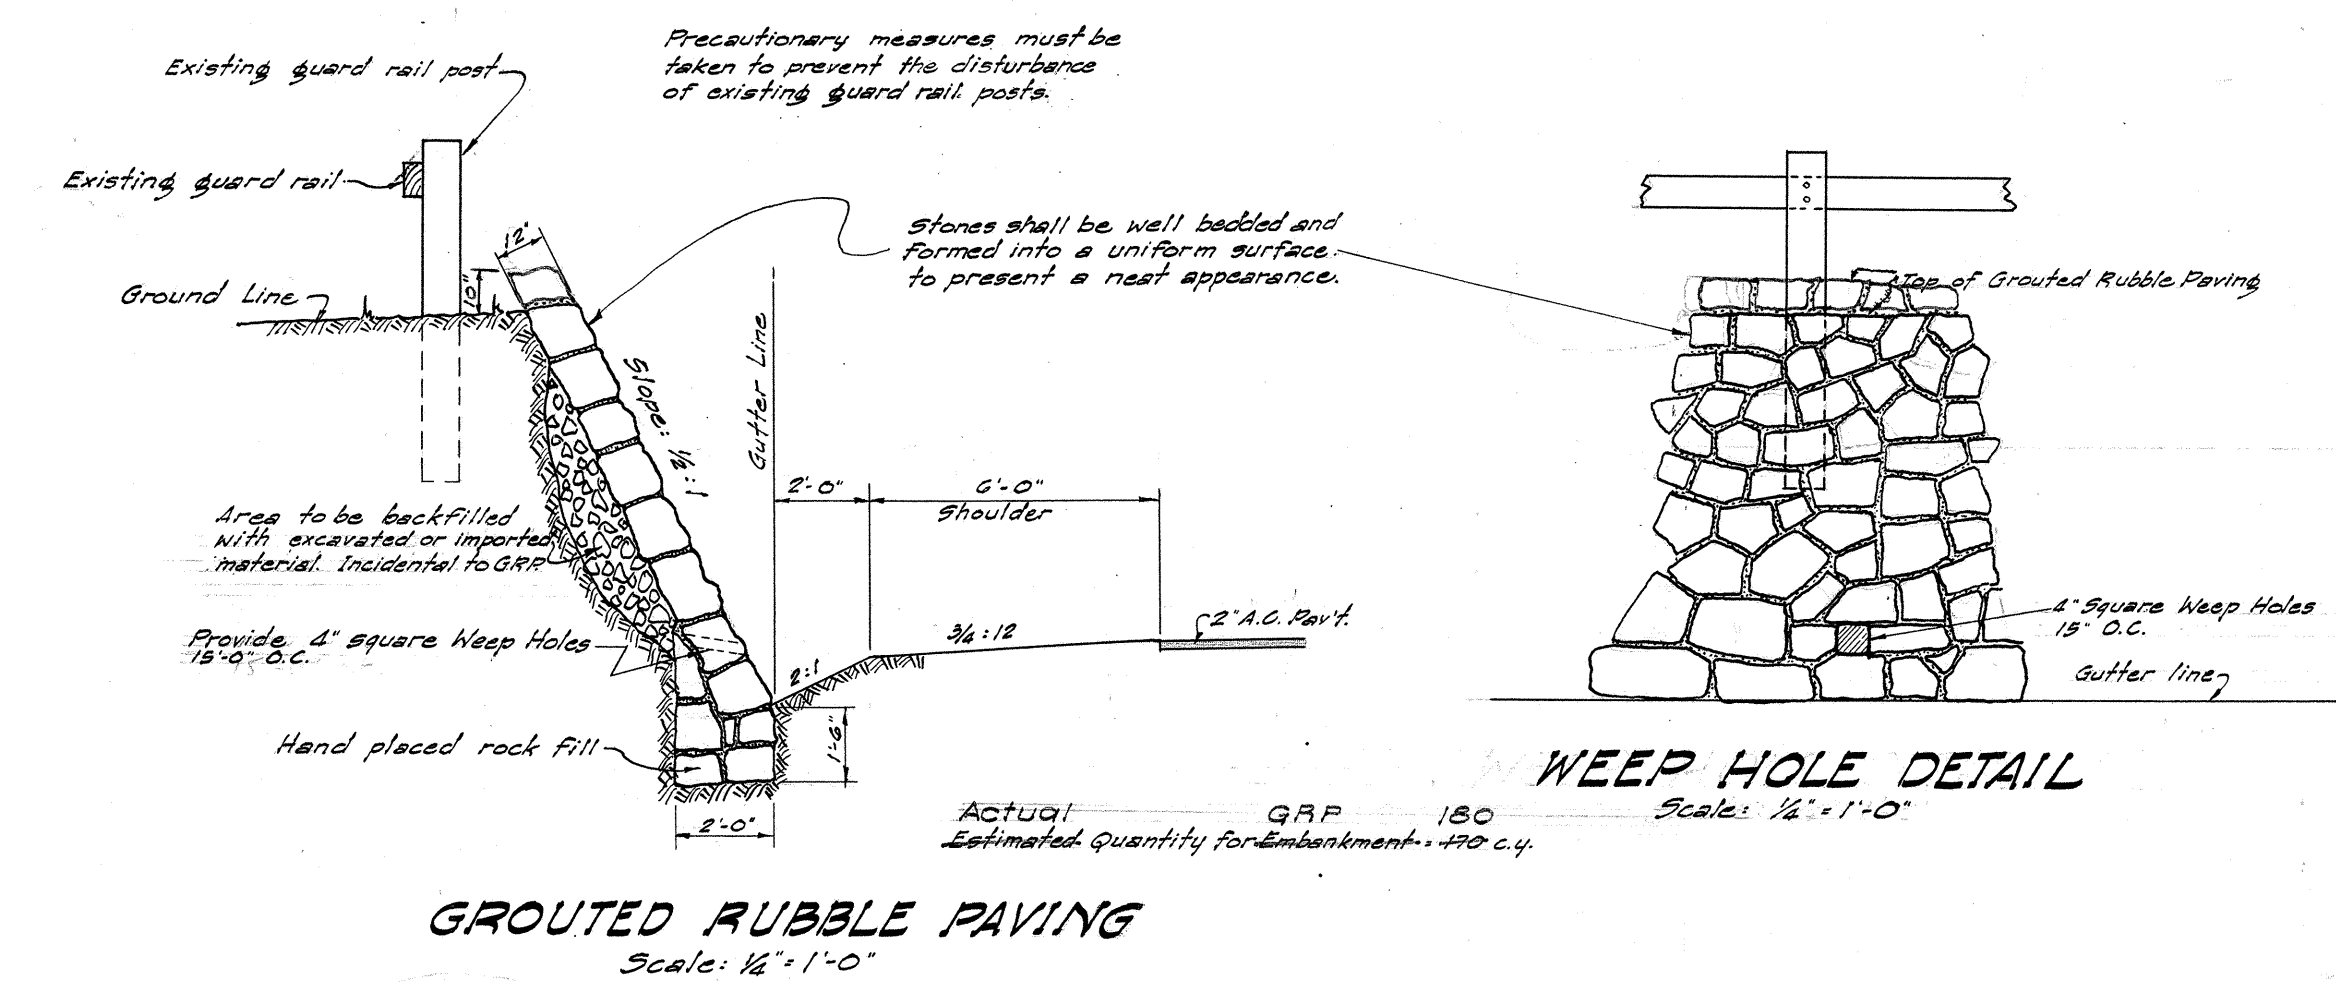
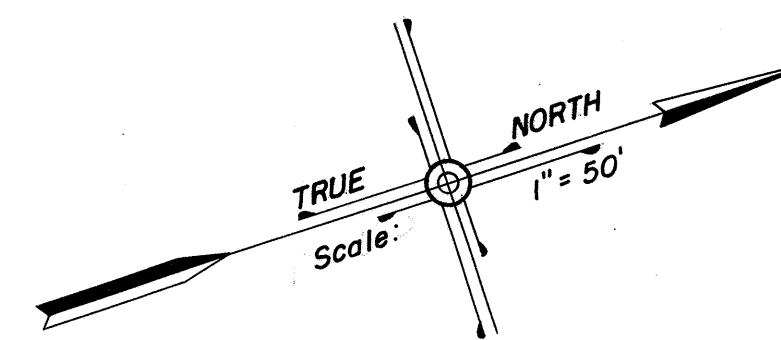


PLAN
SURVEYED
PLOTTED
NOTE BOOK
PT. OF WAY CHECKED
NO.

PROFILE
SURVEYED
PLOTTED
NOTE BOOK
B. & S. NOTED
NO. 272-
STRUCTURE NOTATIONS CH'G.

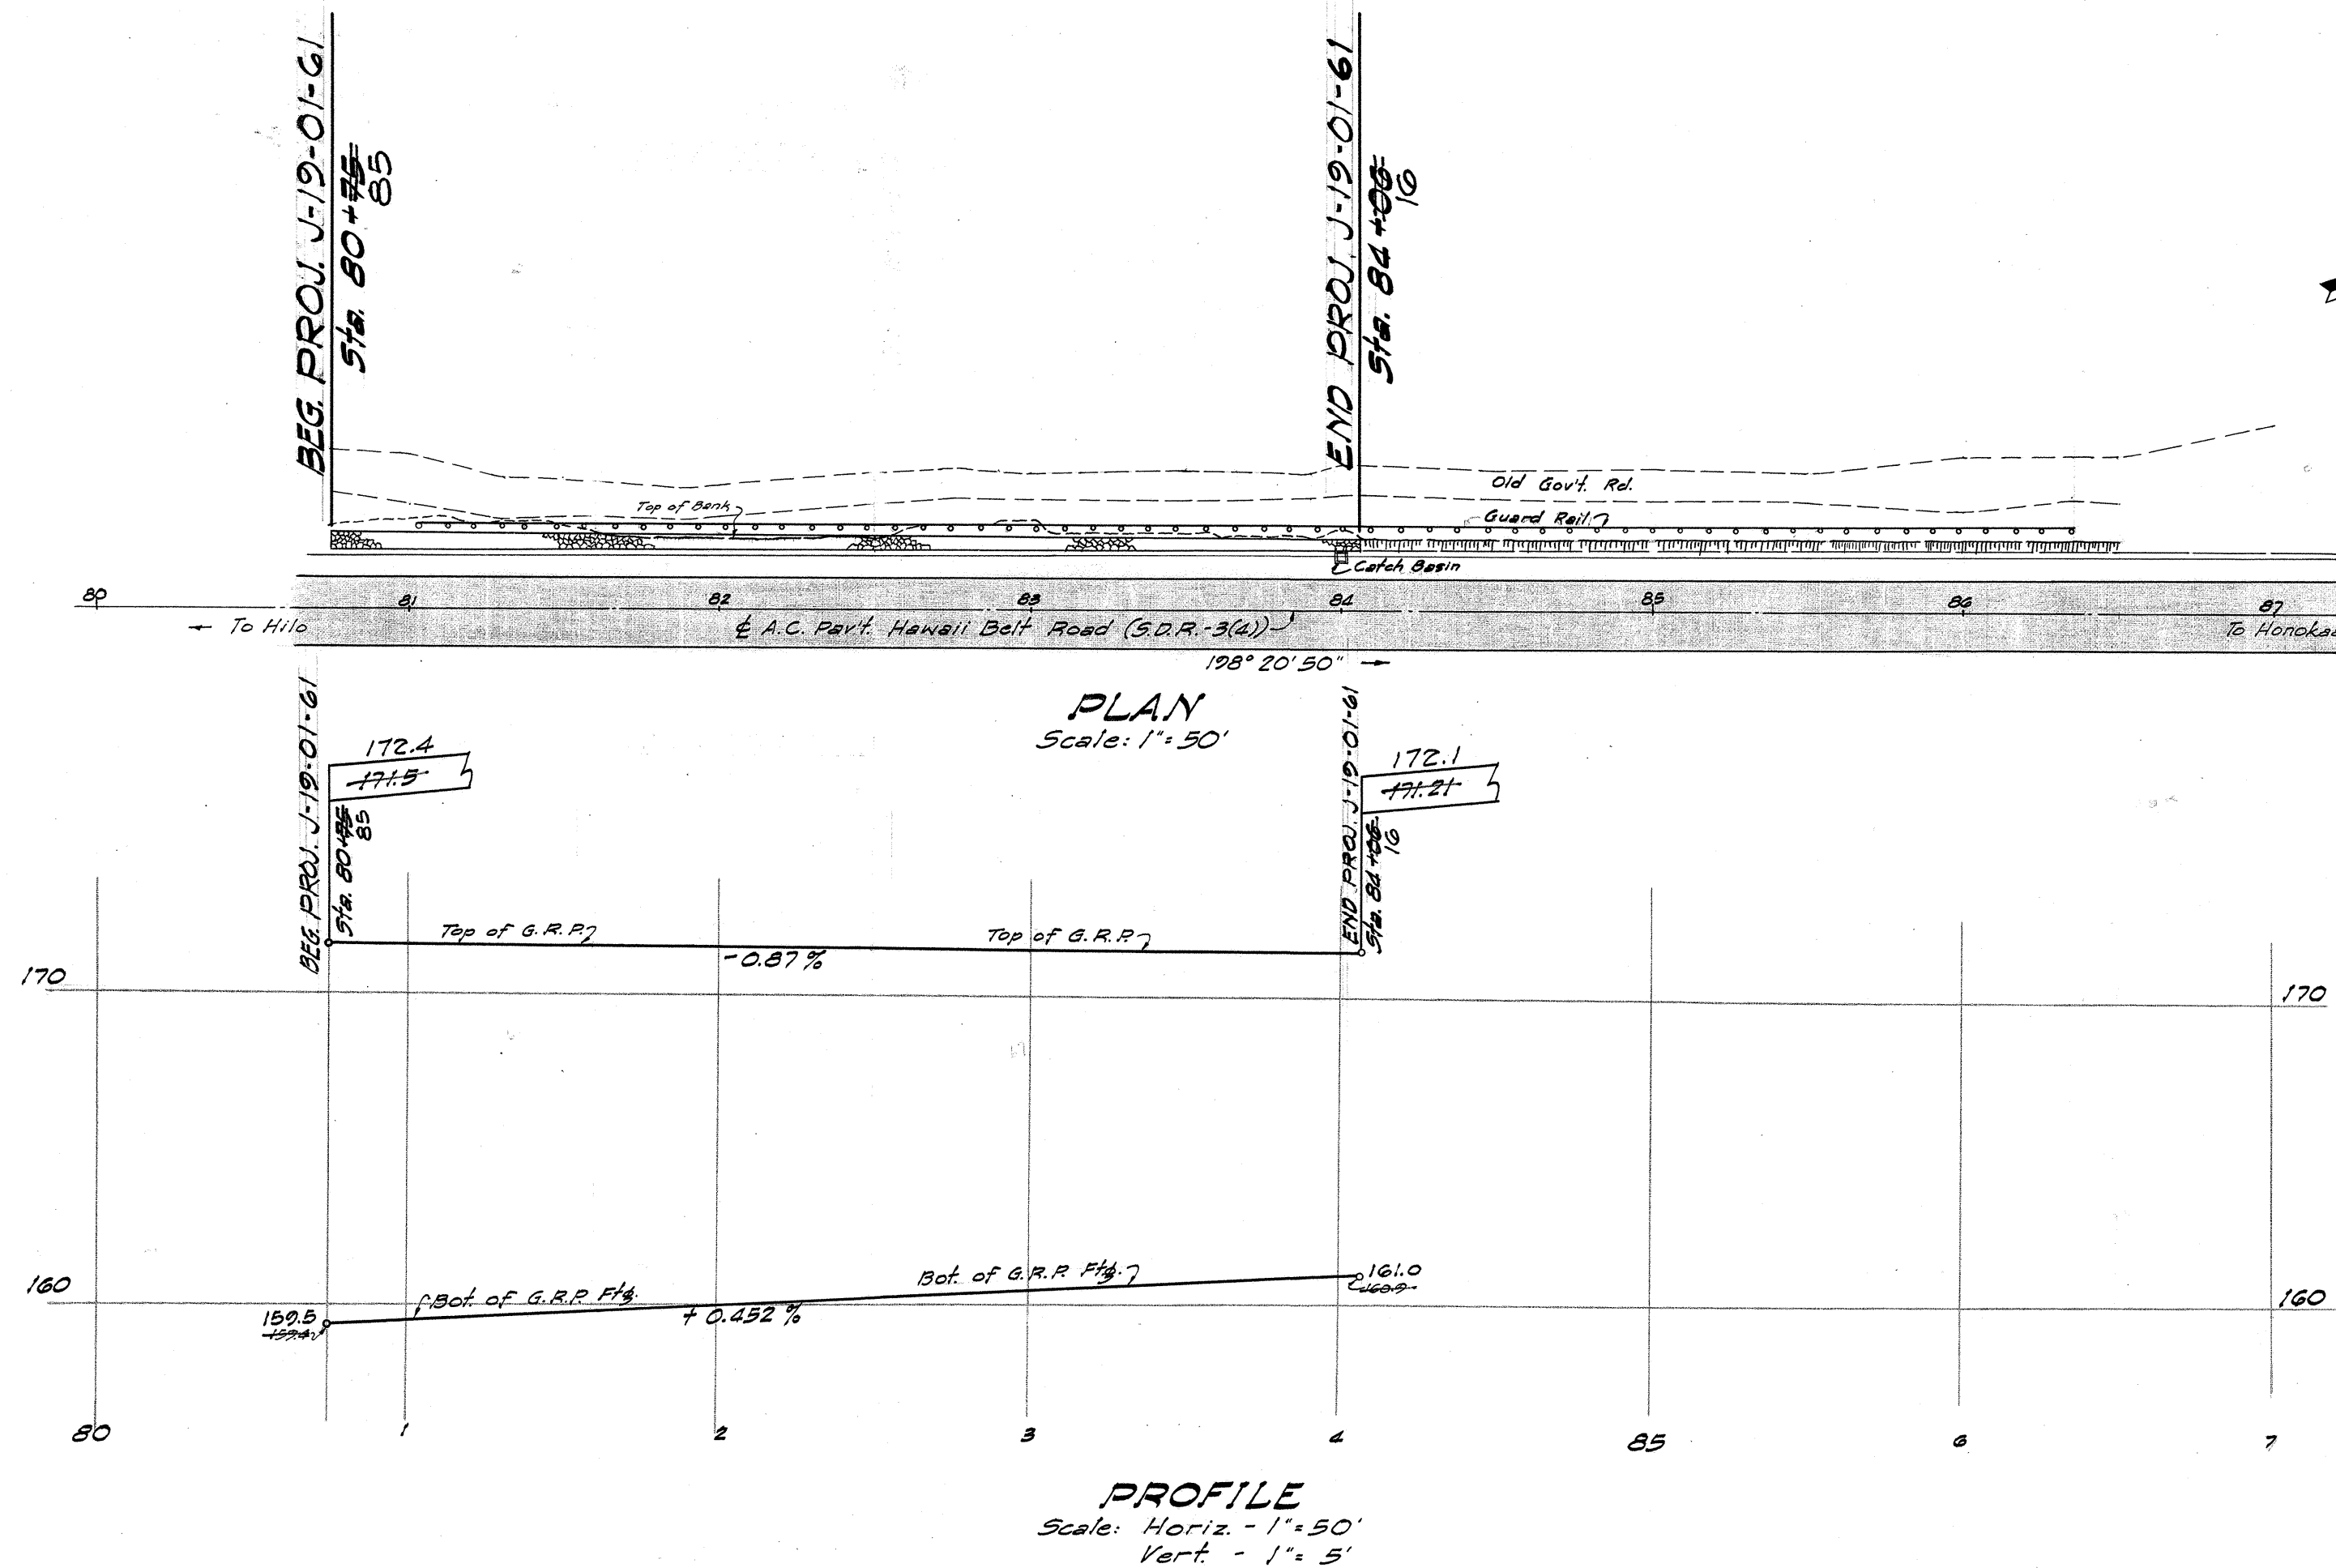

DEPARTMENT OF TRANSPORTATION
HIGHWAYS DIVISION
STATE OF HAWAII

PLAN OF
GROUTED RUBBLE PAVING AT PUUEOPAKU
PROJECT NO. J-19-01-61

DISTRICT OF SOUTH HILO
ISLAND OF HAWAII

Scale: As Noted Date: October 2, 1961

