

DIST. No.	STATE	PROJ. No.	FISCAL YEAR	SHEET No.	TOTAL SHEETS
HAWAII	HAW	J-19-01-61	1961	1	2

STATE OF HAWAII

DEPARTMENT OF TRANSPORTATION

HIGHWAYS DIVISION

AS-BUILT

PLANS OF


HAWAII BELT ROAD

GROUTED RUBBLE PAVING AT PUUEOPAKU

PROJECT NO. J-19-01-61

DISTRICT OF SOUTH HILO

ISLAND OF HAWAII

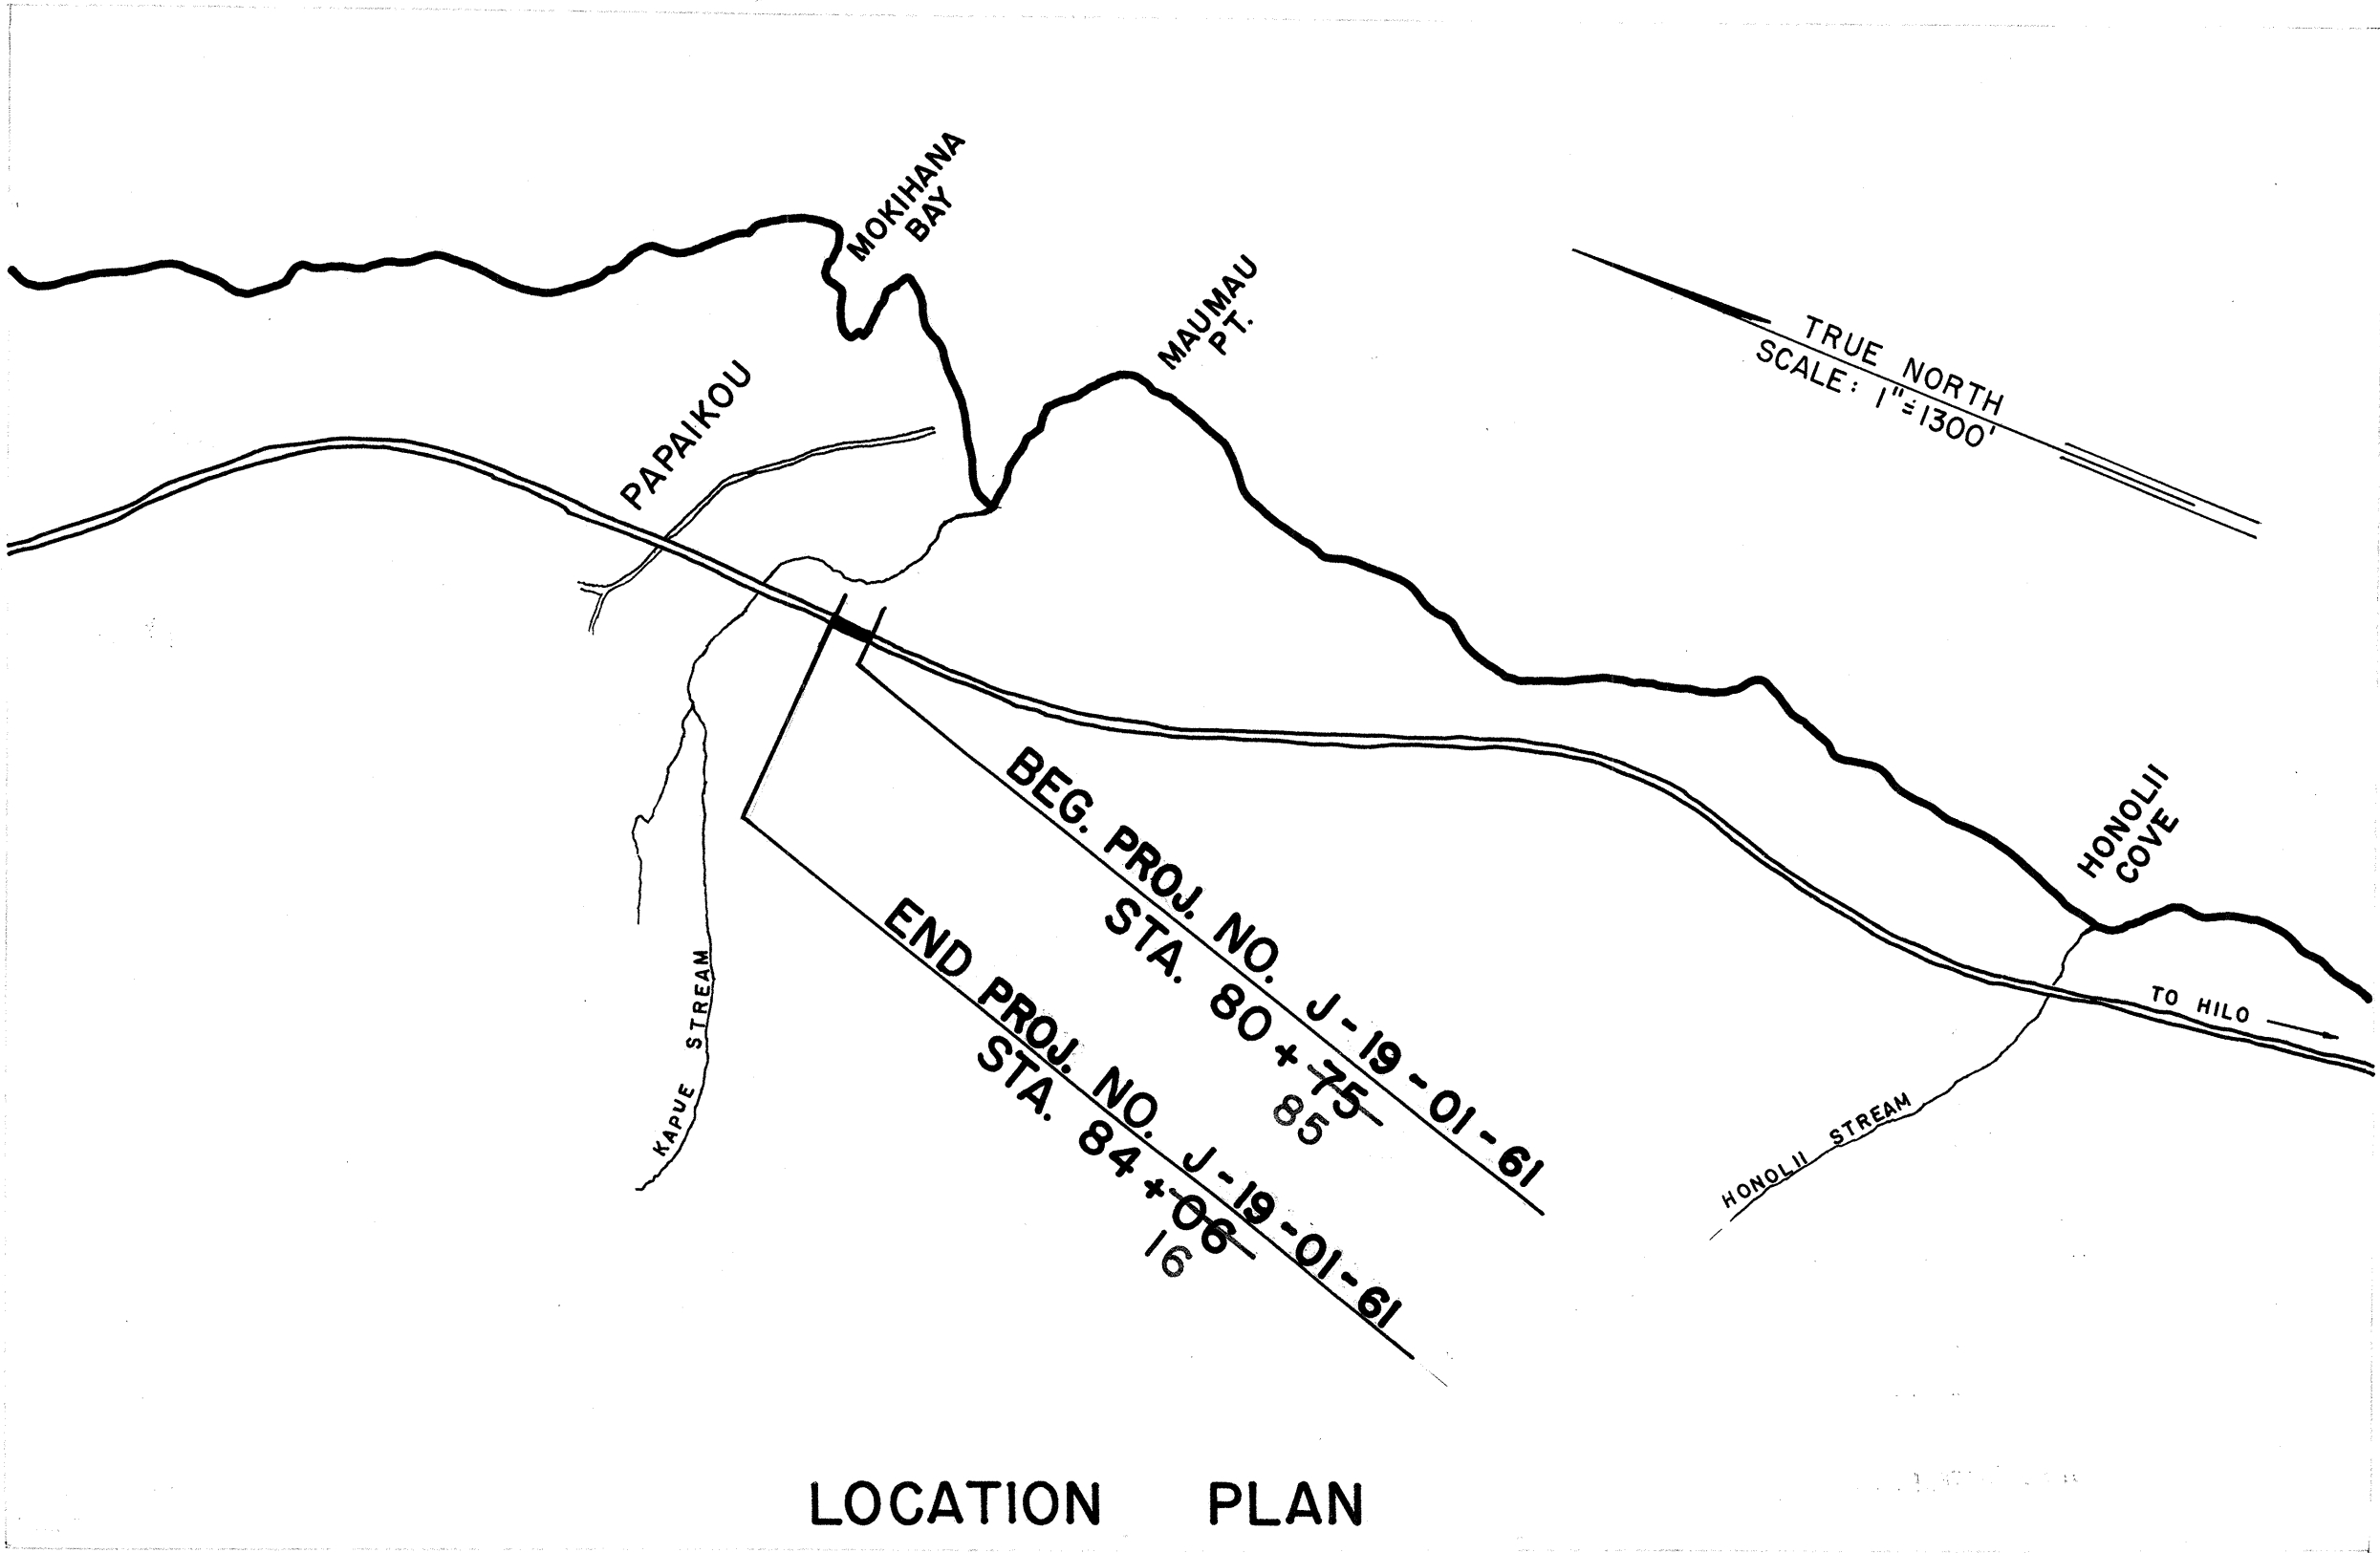

NOTE:

ALL CHANGES MADE DURING CONSTRUCTION

HAVE BEEN NOTED IN RED ON THESE

TRACINGS AND CHECKED BY:

[Signature]

PROJECT ENGINEER

11/13/67

DATE

APPROVED

DATE

[Signature]

DIRECTOR OF TRANSPORTATION

SURVEY PLOTTED BY	DATE
DRAWN BY	
TRACED BY	
QUANTITIES CHECKED BY	
CHECKED BY	
ORIGINAL PLAN No.	