



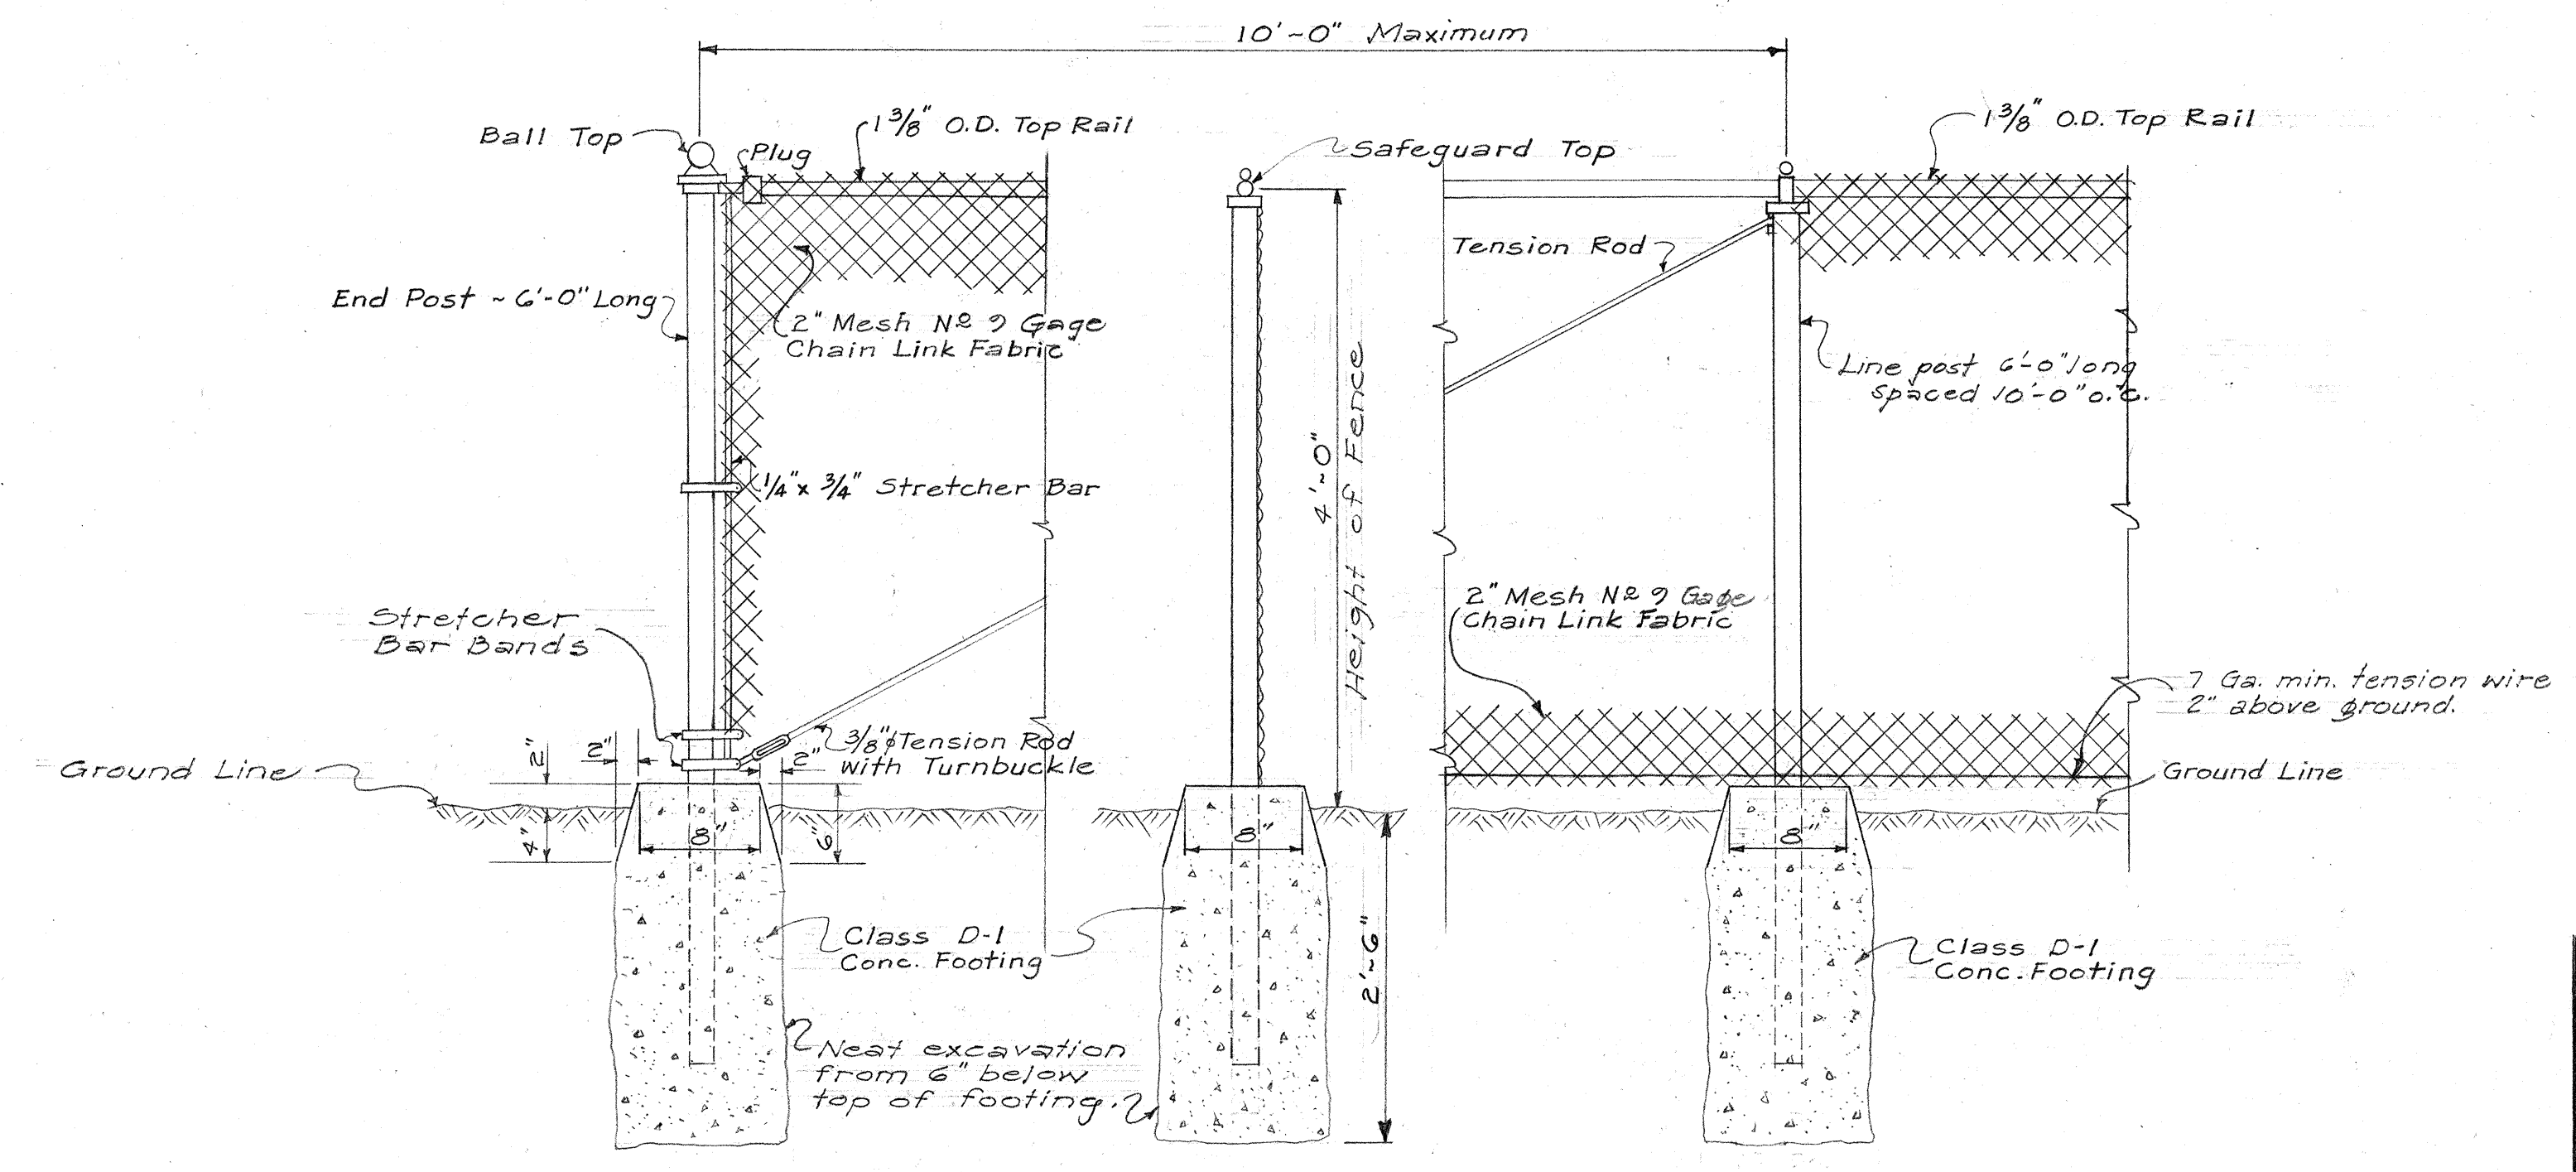

ELEVATION AT END POST    TYPICAL SECTION    ELEVATION AT LINE POST

DETAIL OF CHAIN LINK FENCE

NOT DRAWN TO SCALE

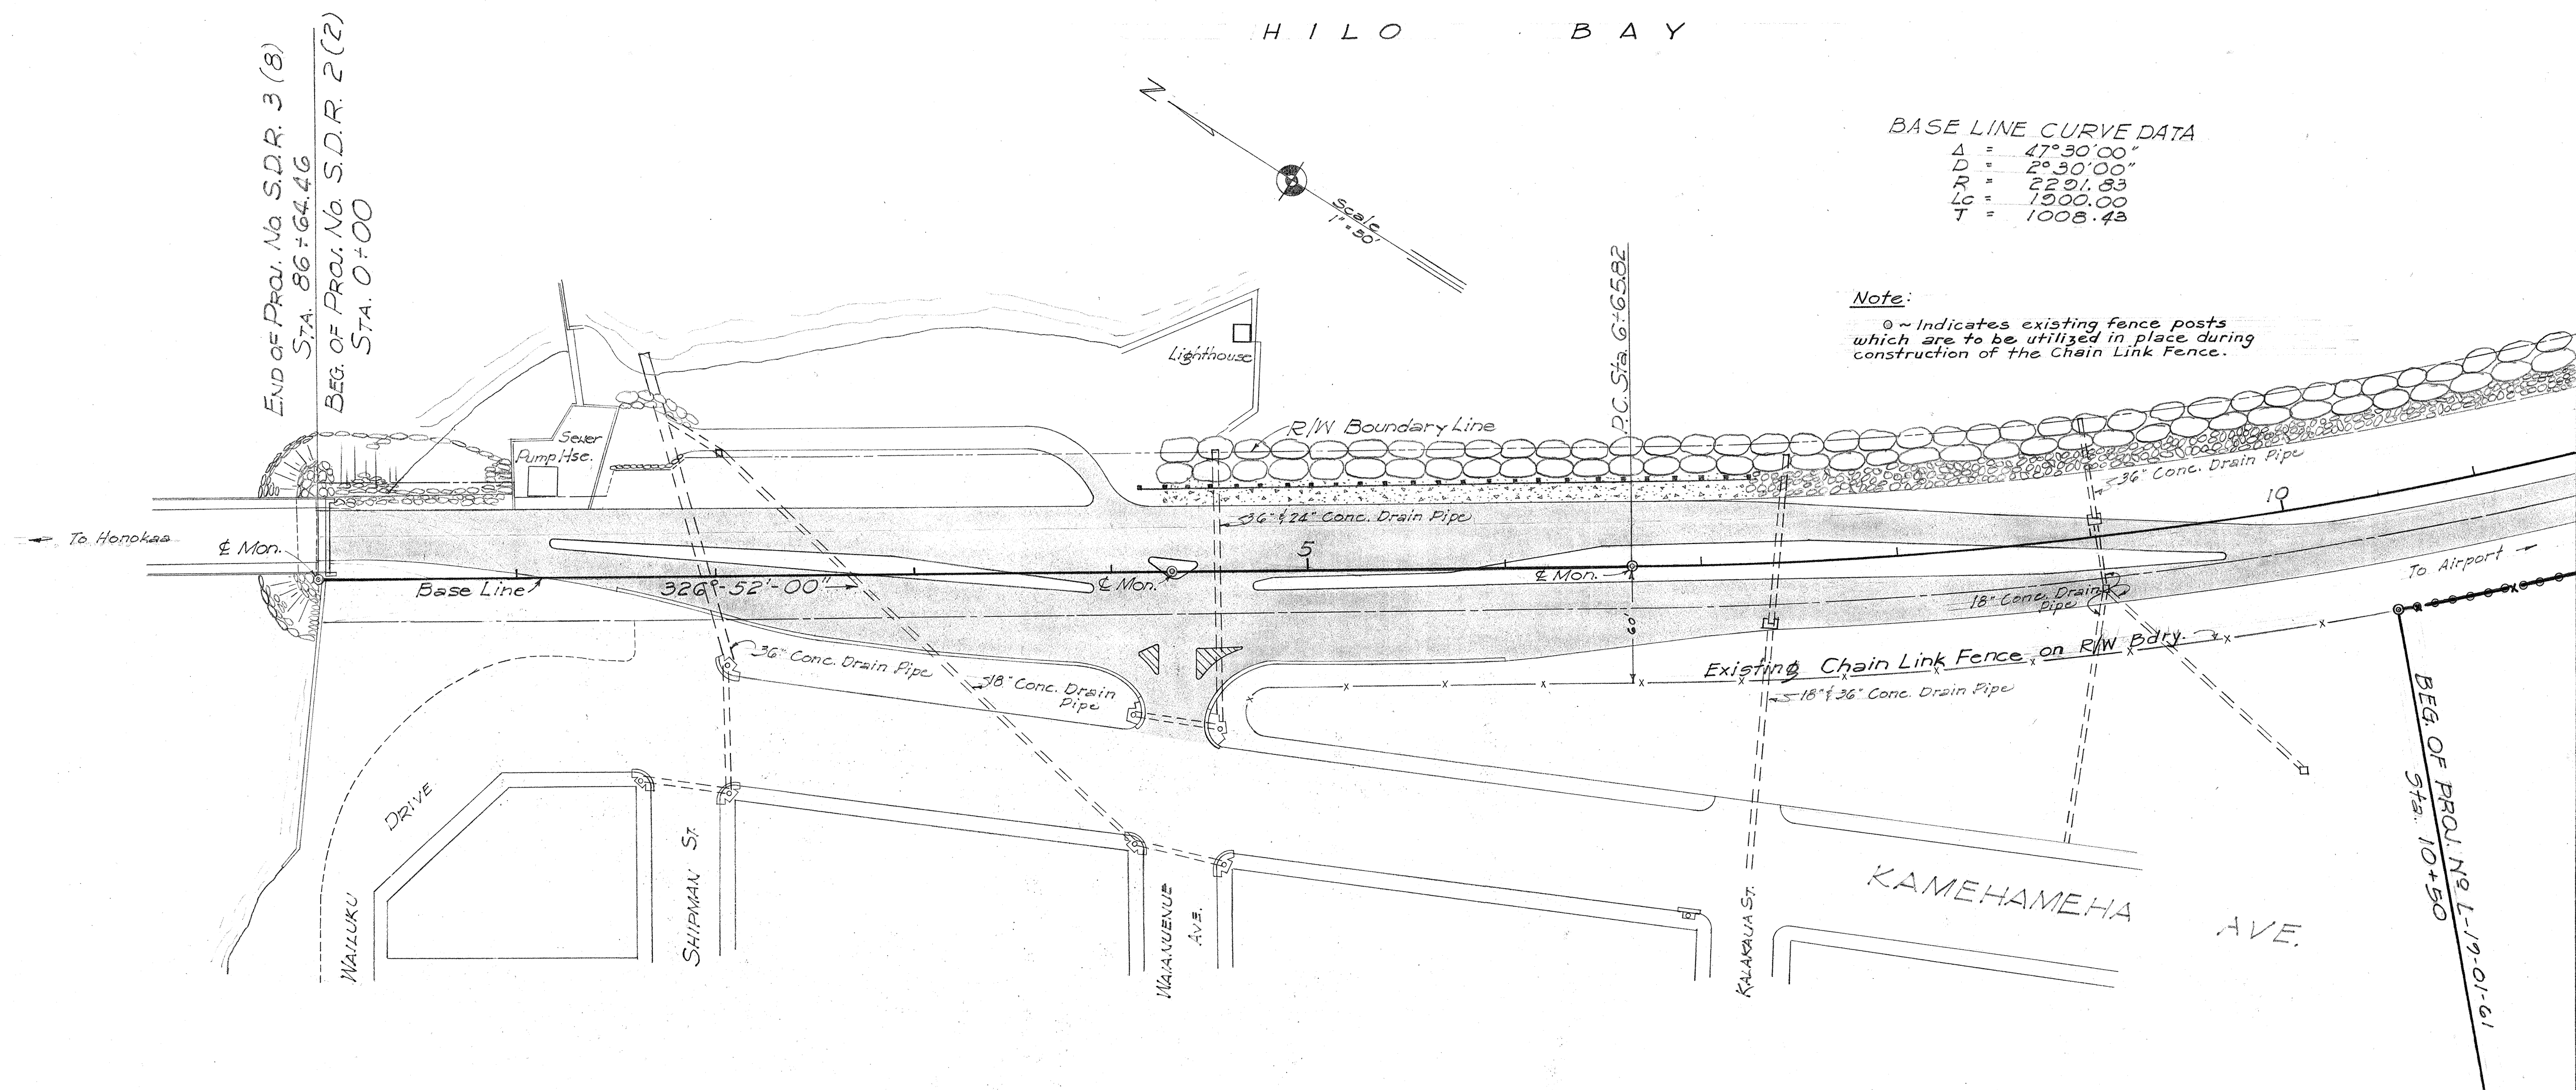