



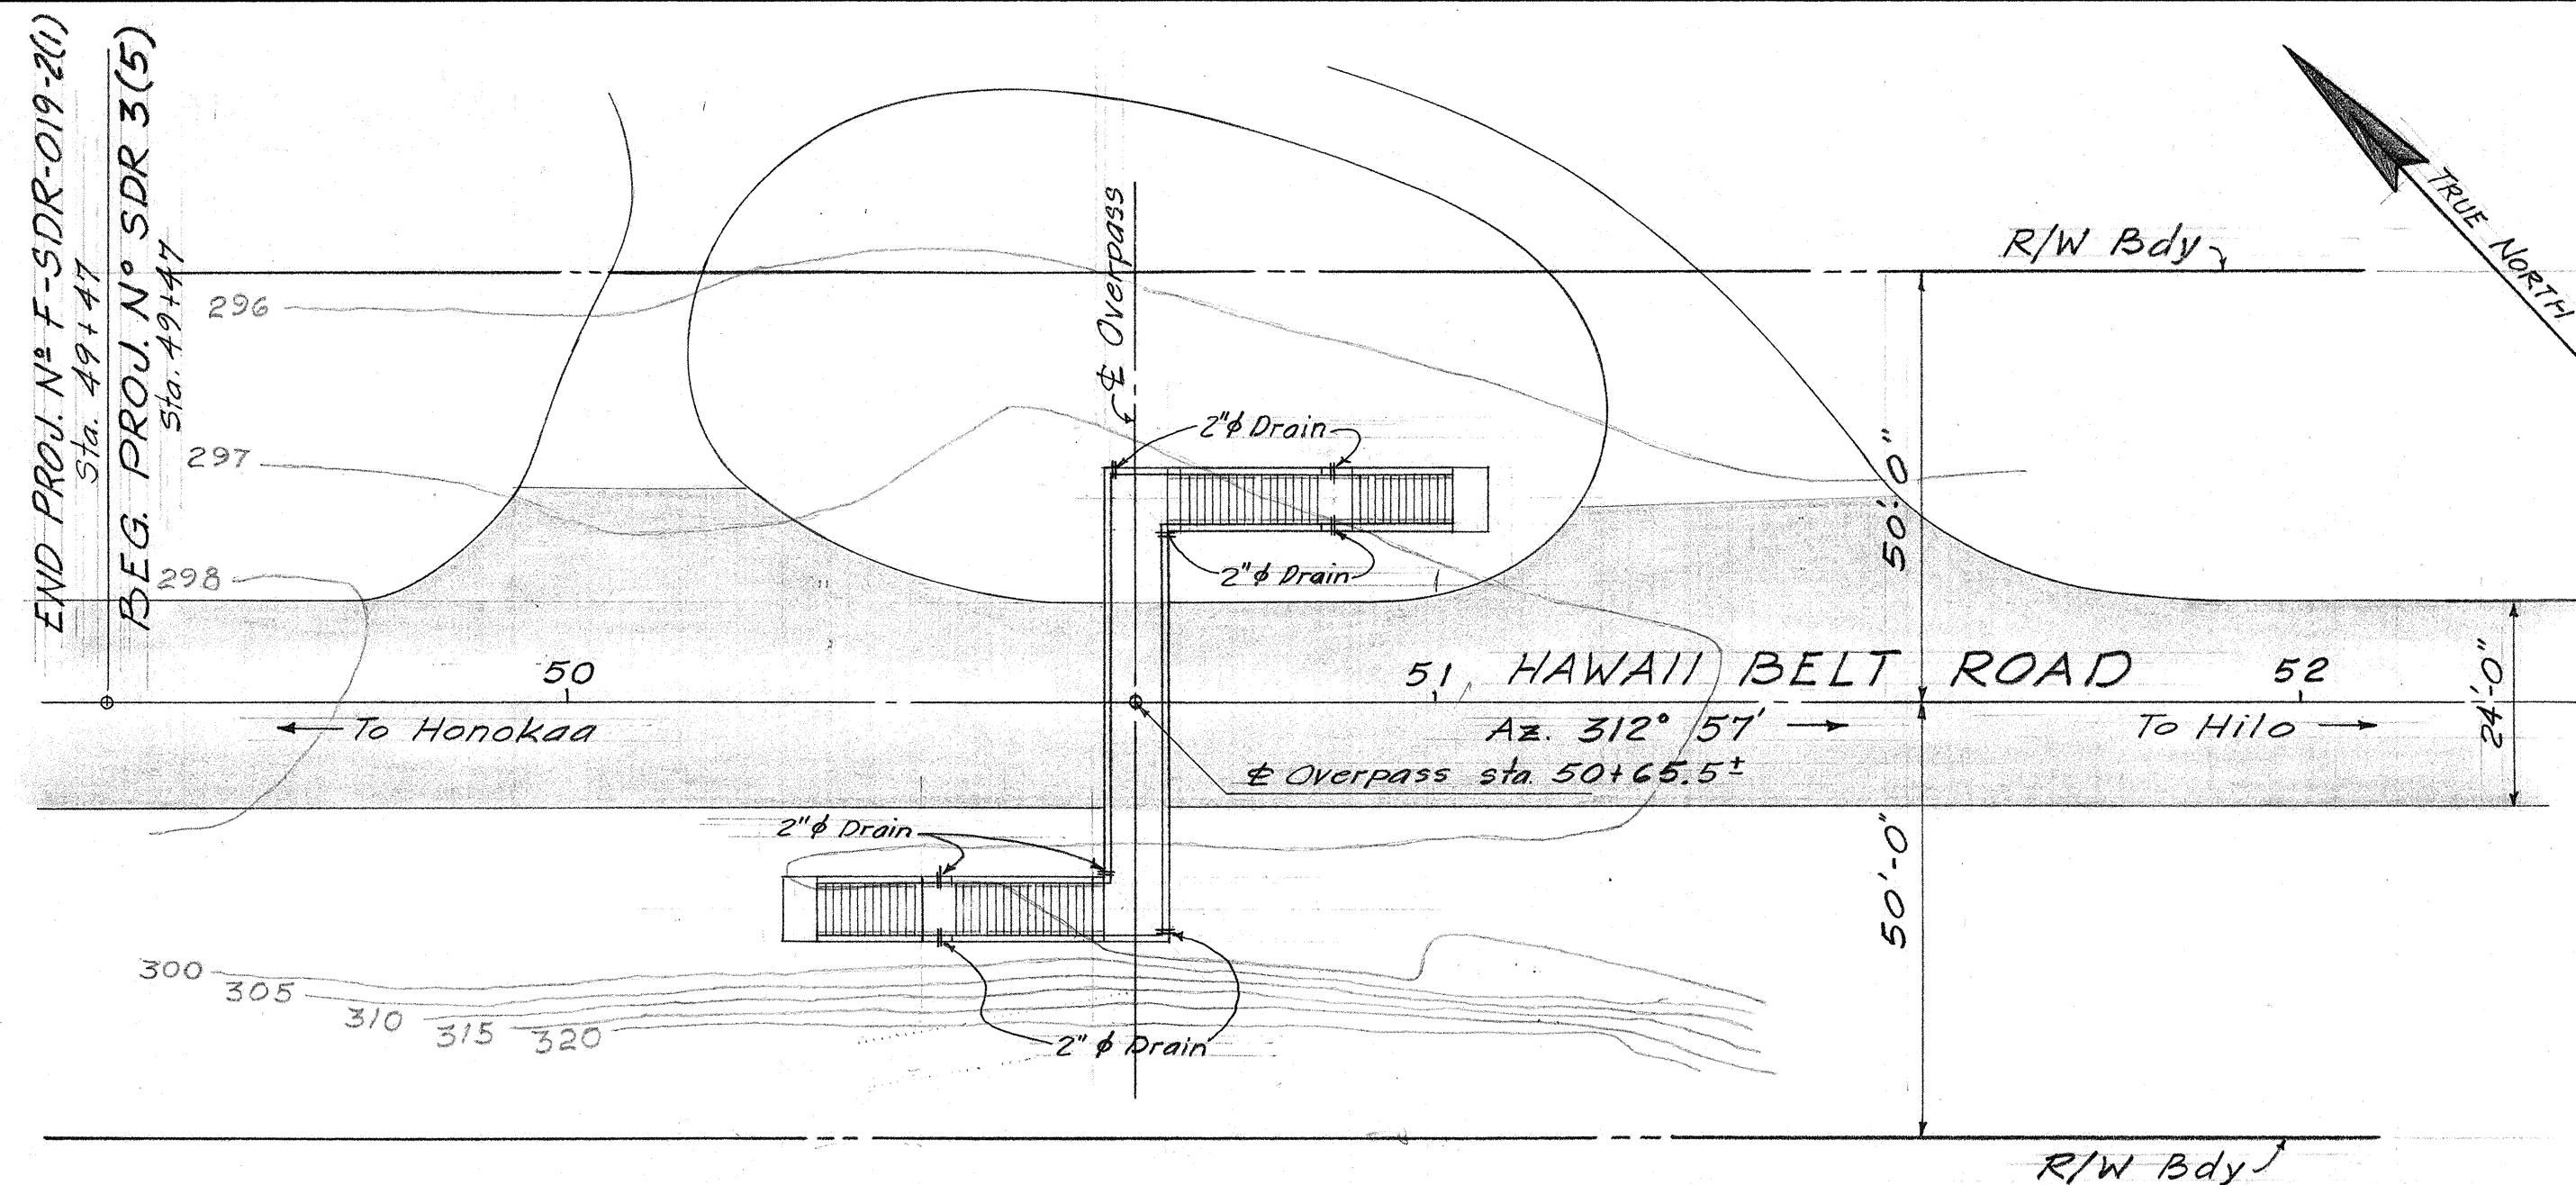


SITE PLAN
Scale: 1" = 20'

FOUNDATION PLAN
Scale: 1" = 20'

LAYOUT PLAN
Scale: 1" = 20'

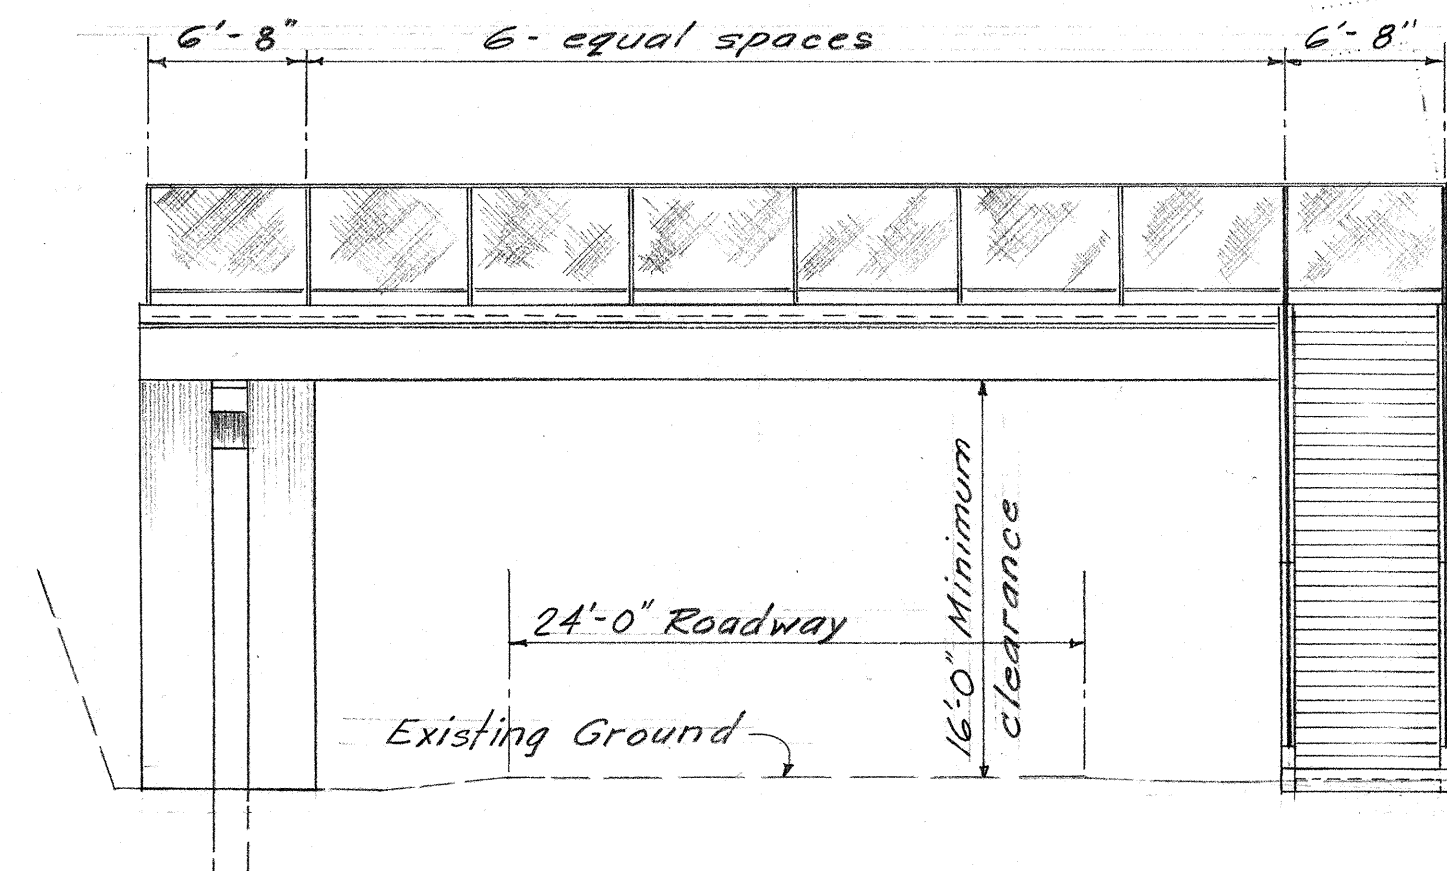


ELEVATION ~ OVERPASS
Scale: 1/8" = 1'-0"

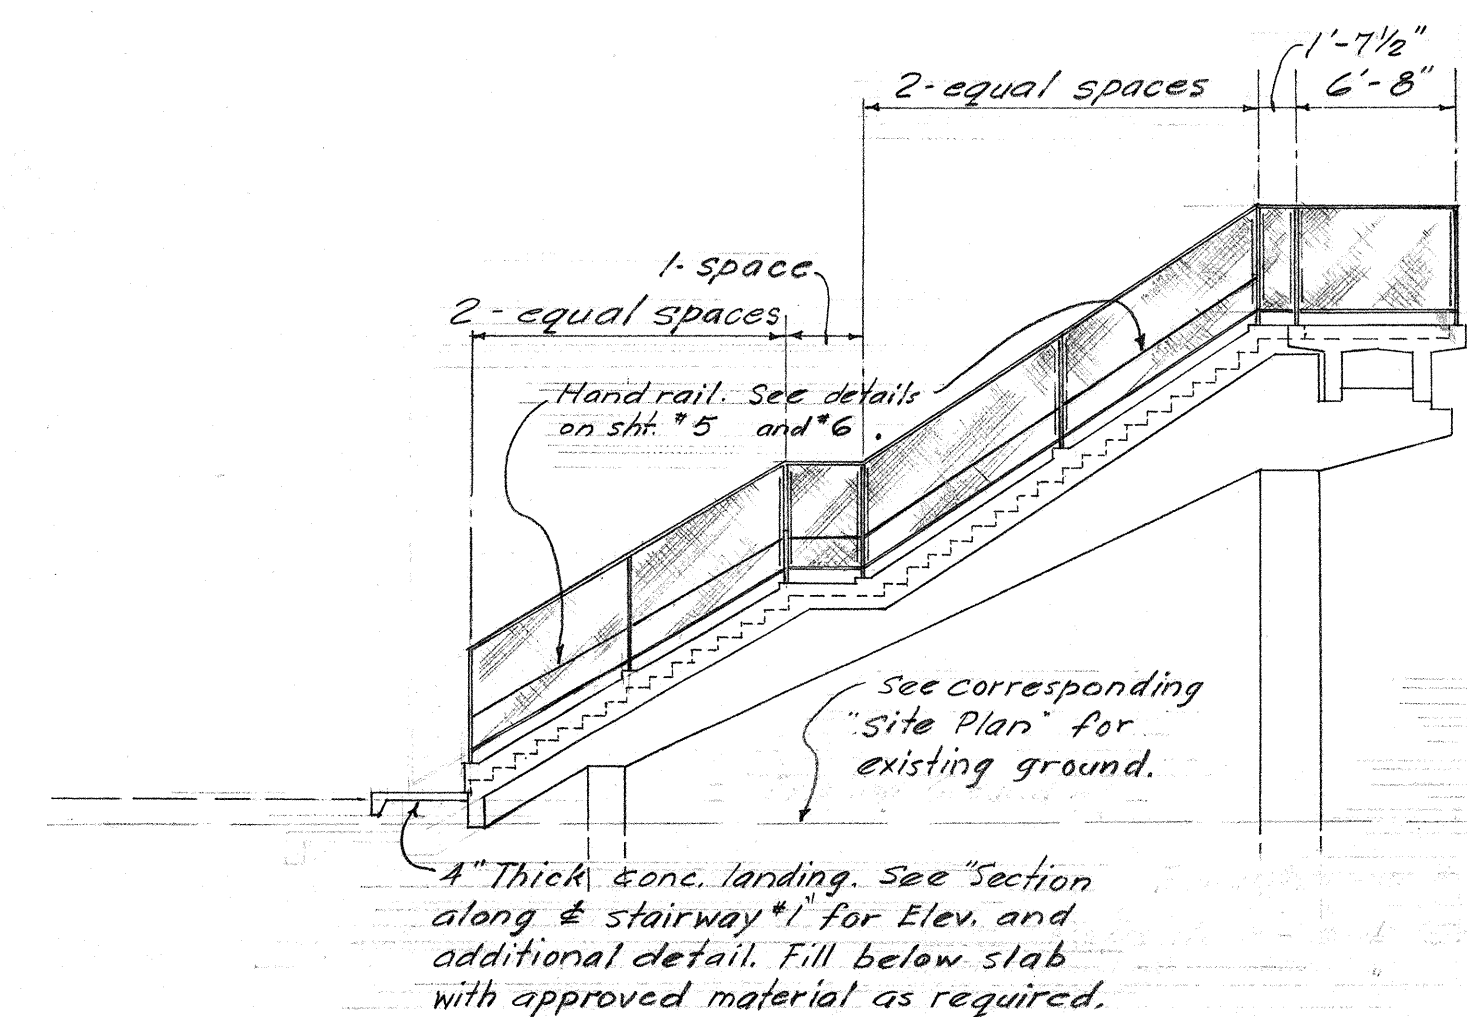

ELEVATION ~ STAIRWAY #1
(ELEVATION ~ STAIRWAY #2 SIMILAR EXCEPT OPPOSITE HAND)
(PAAUULO PEDESTRIAN OVERPASS ELEV. ~ STAIRWAY #3 SIMILAR)


ESTIMATED QUANTITY

Class A-1 Concrete	Lump Sum (53.0 c.y.)
Reinf. Steel	Lump Sum (8,440.0 lbs.)
Structure Excavation	51.0 c.y.
Railing	280.0 L.F.
Prestressed Conc. Tee	110.0 L.F.

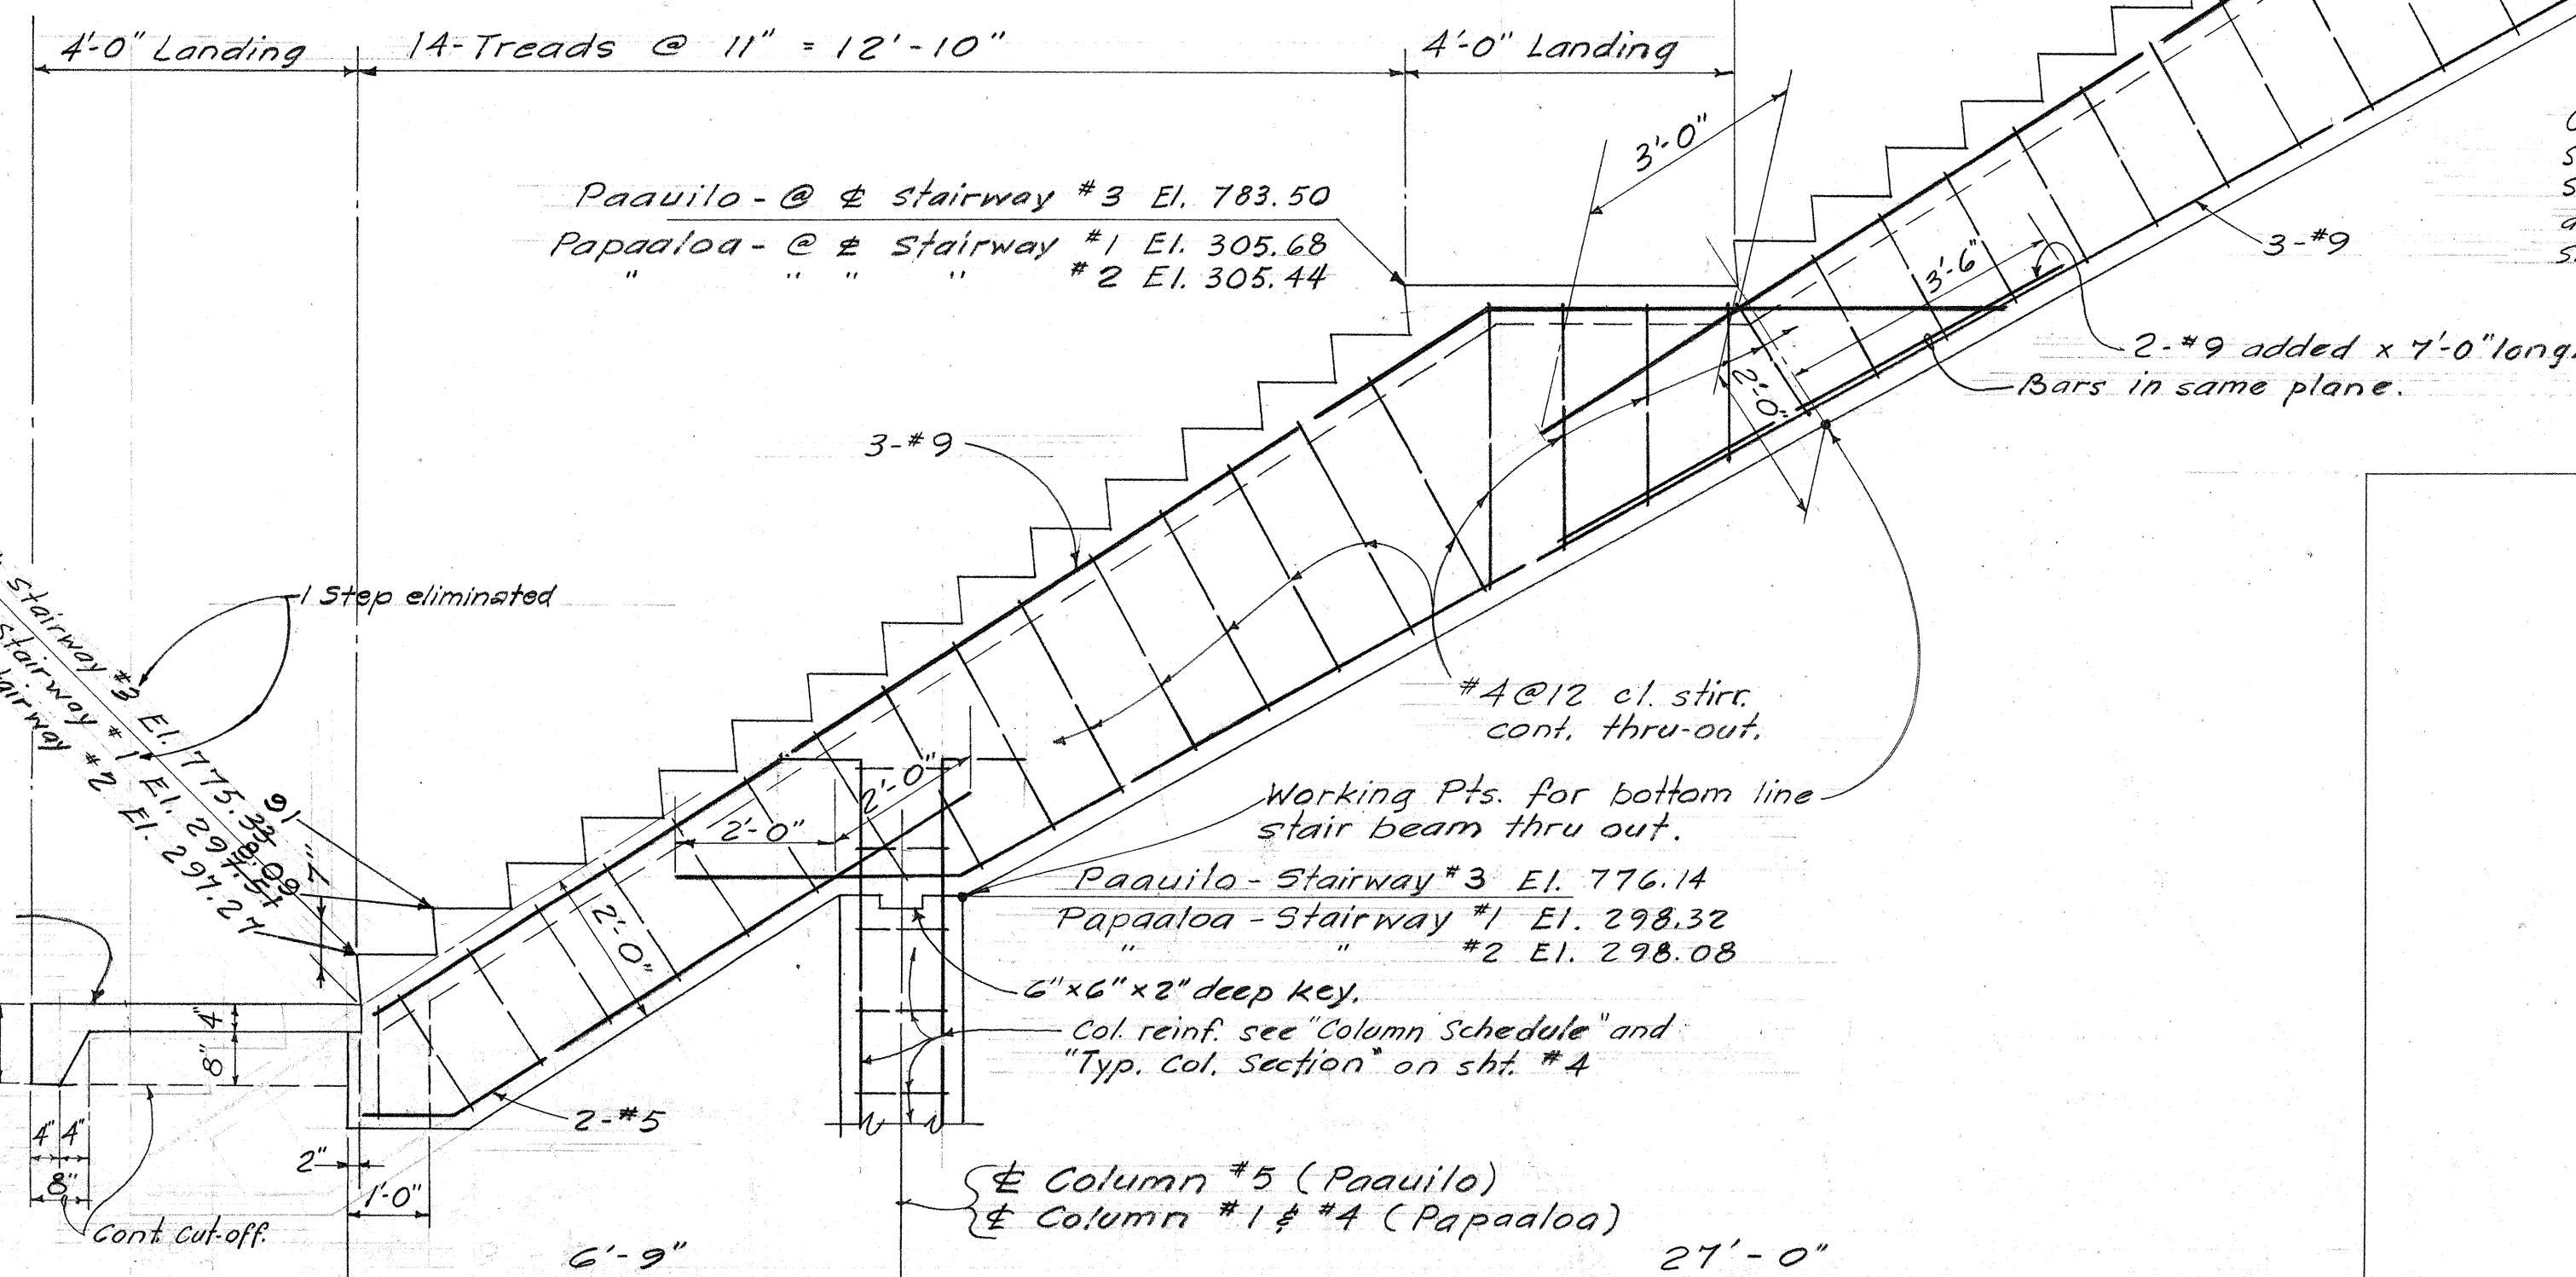

SECTION @ STAIRWAY N#1
Scale: 1/2" = 1'-0"

SECTION @ STAIRWAY N#2 & PAAUULO - SECTION @ STAIRWAY N#3 SIMILAR

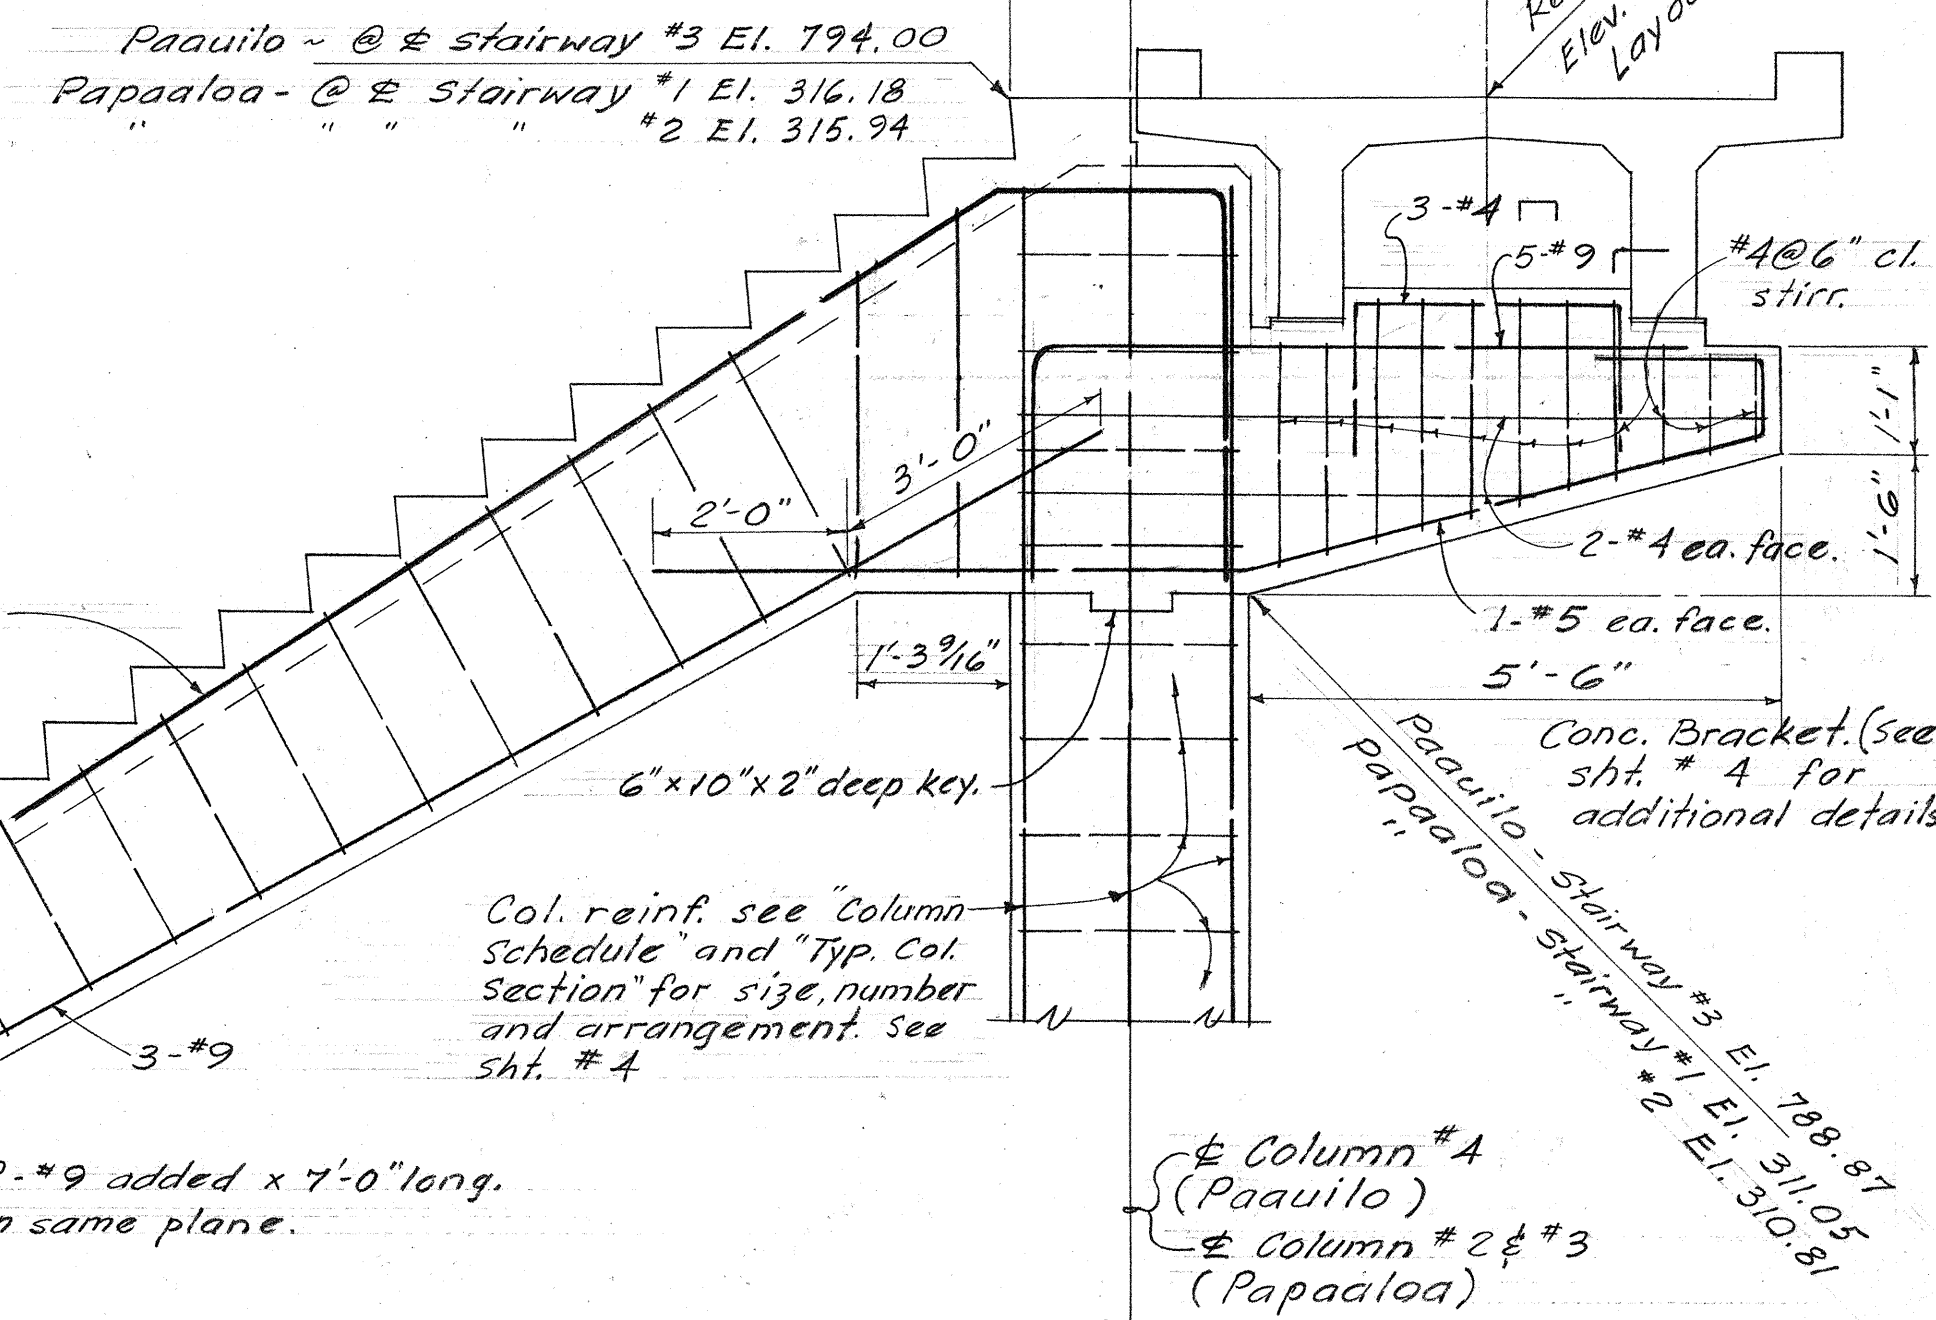

STATE OF HAWAII
DEPARTMENT OF TRANSPORTATION
HIGHWAYS DIVISION
PEDESTRIAN OVERPASS
AT
PAPAALOA
Sta. 50+65.5 ±
Hawaii Belt Road
H-19-01-63
May, 1963

SHEET No. 3 OF 6 SHEETS