




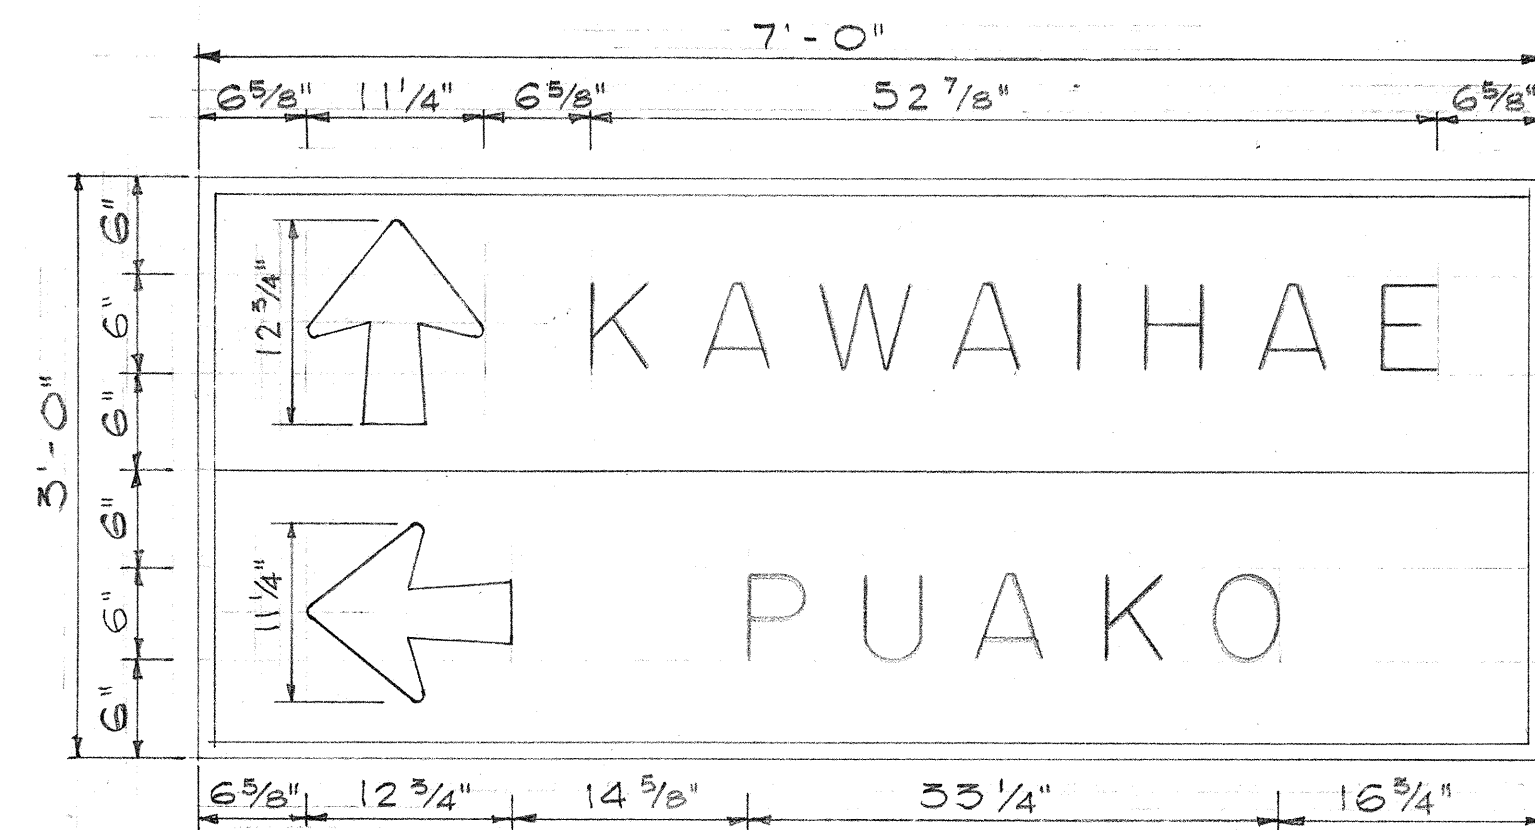


D-1

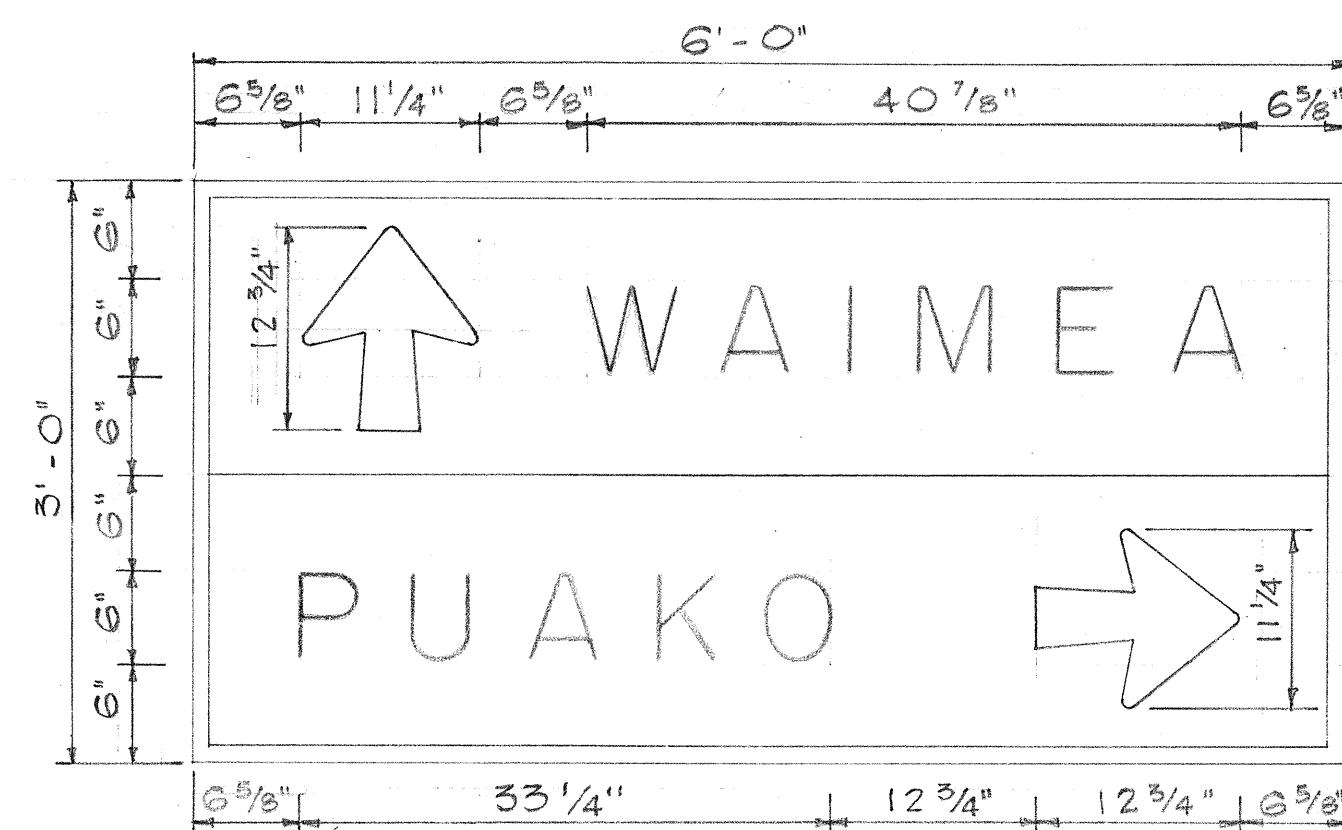


D-2

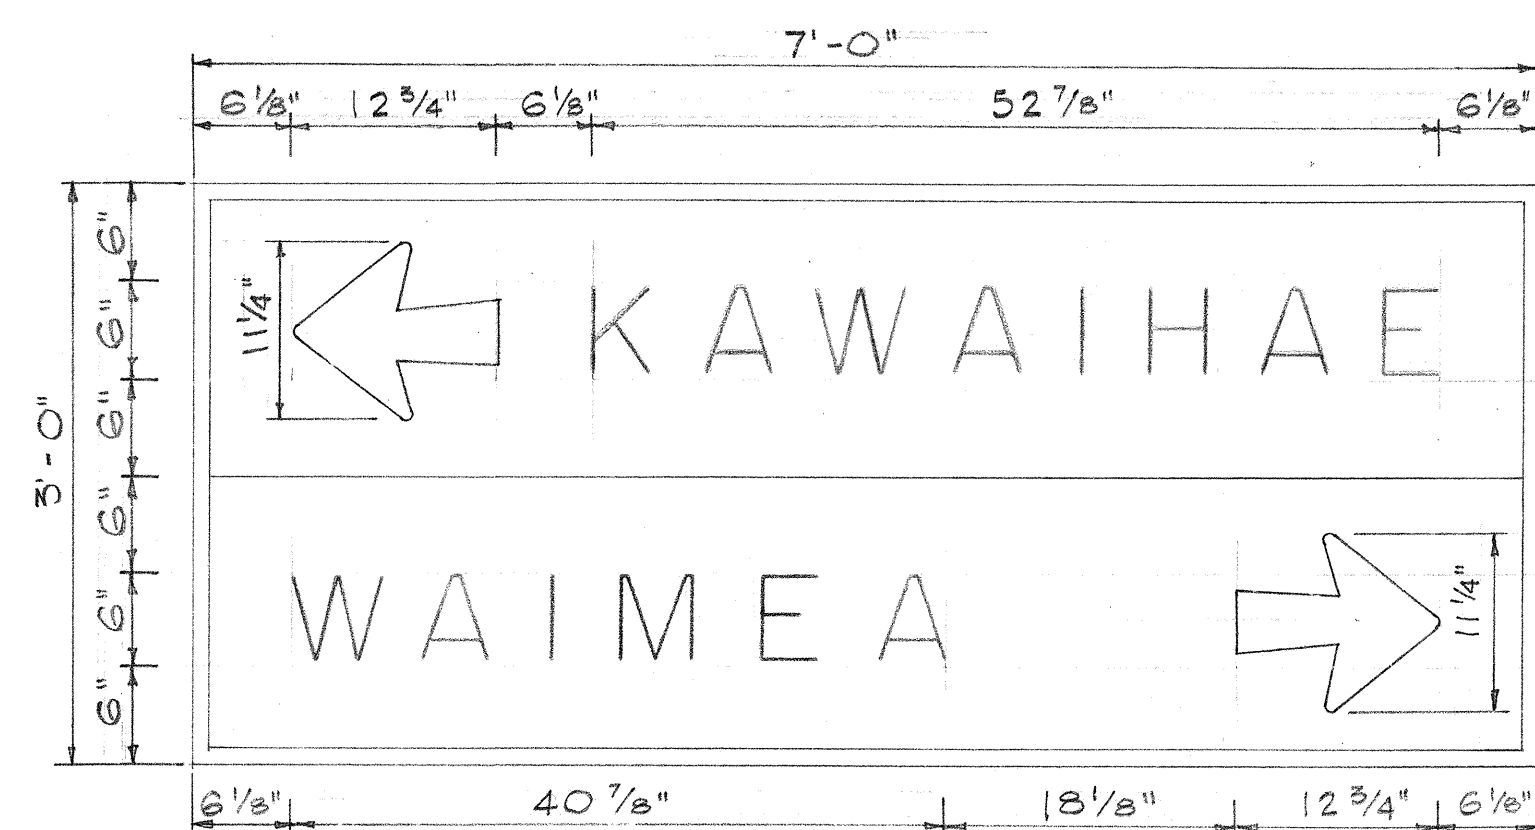


D-3

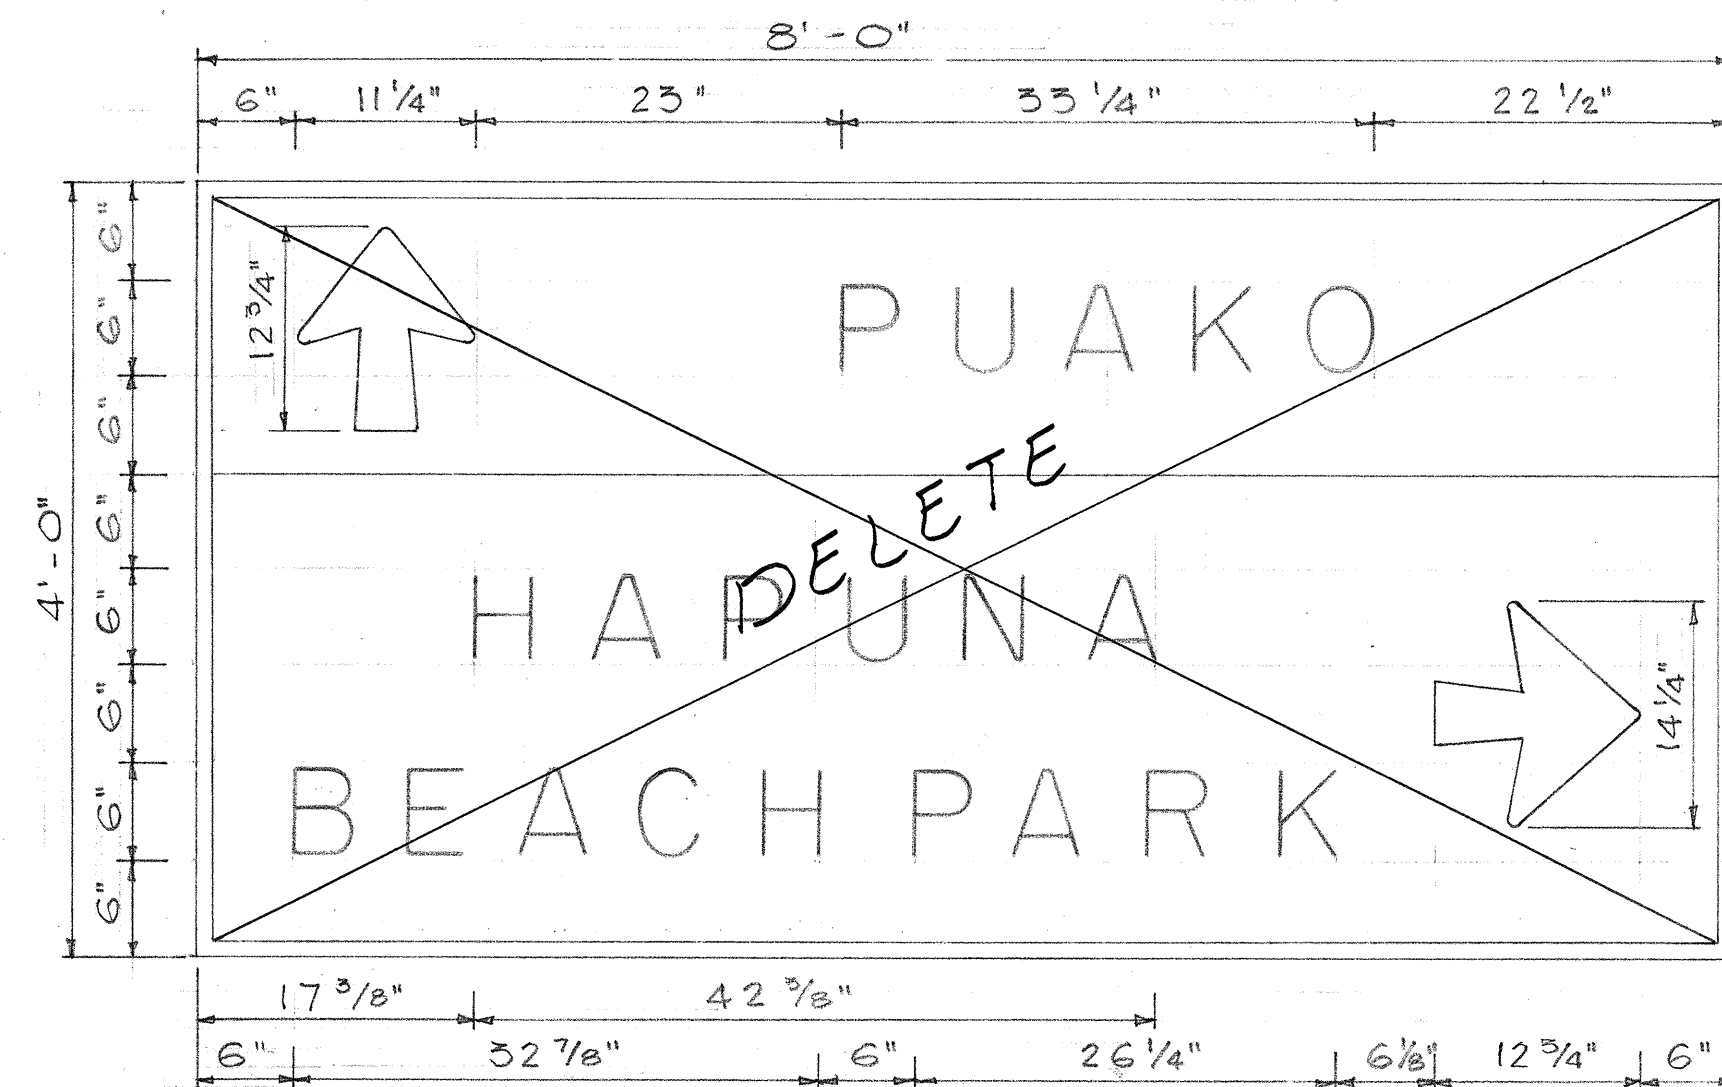

D-4

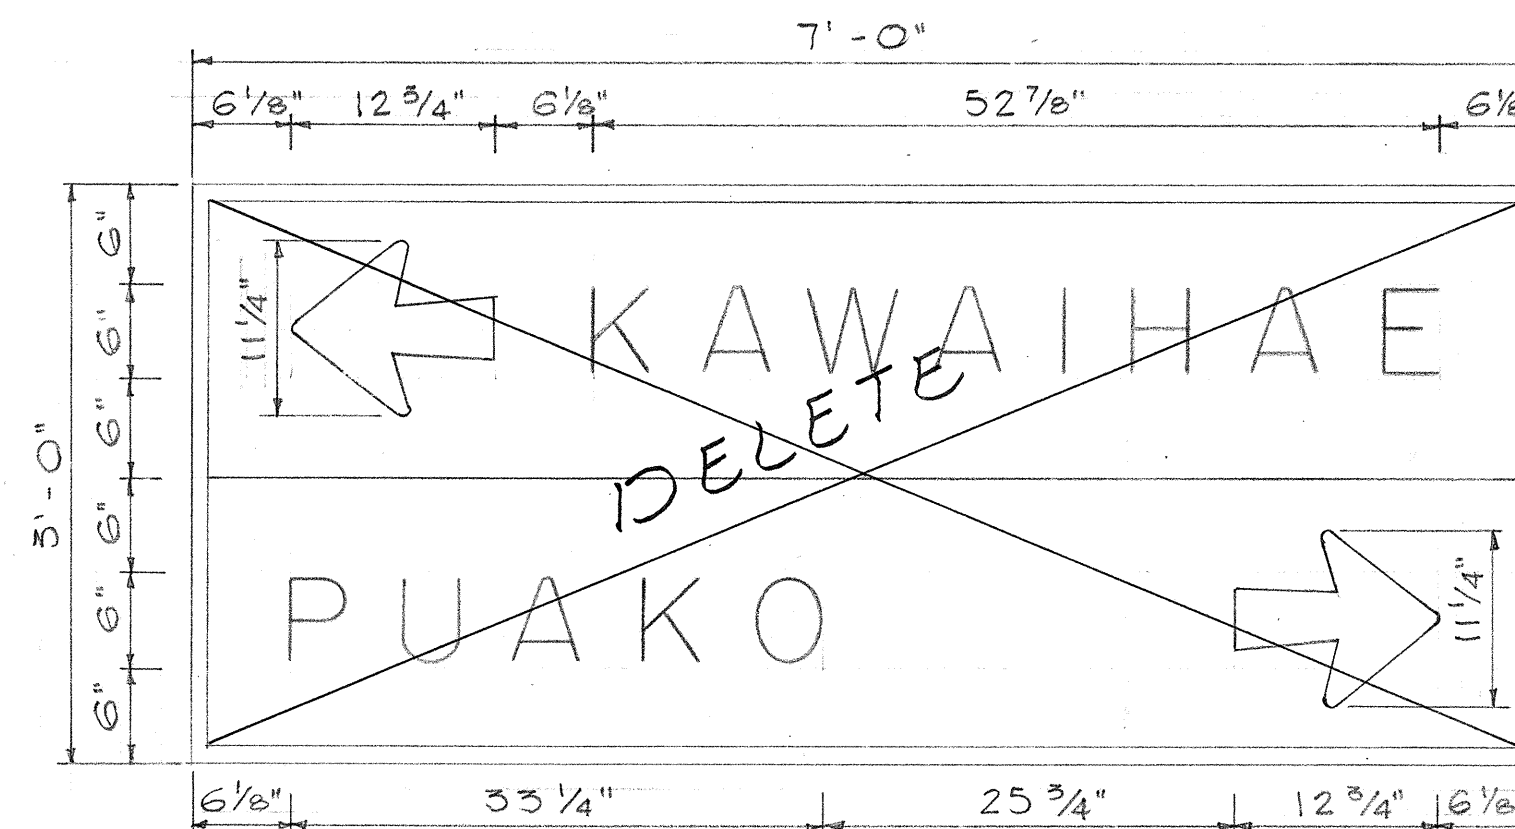

D-5

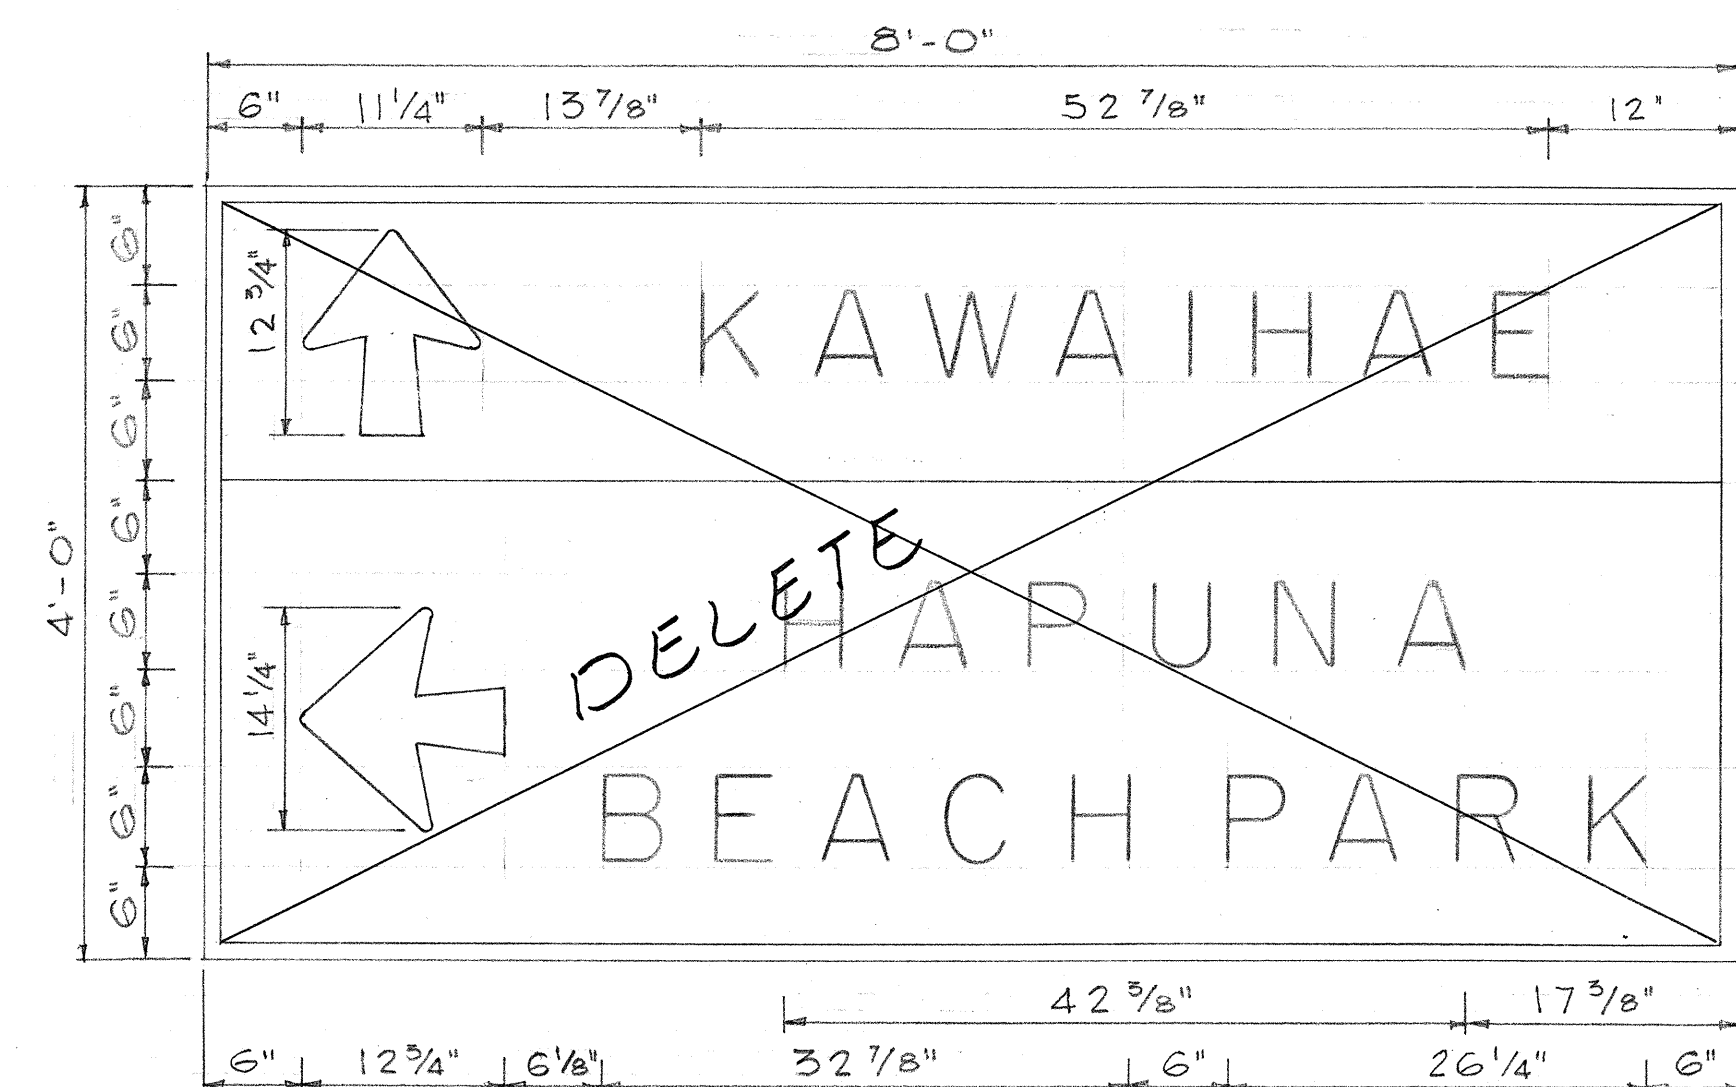

D-6

GENERAL NOTES - DESTINATION SIGNS

1. Sign message shall be lettered in upper case according to "Standard Alphabets For Highway Signs," Bureau of Public Roads, 1952.
2. Arrows shall conform with details as shown on plans.
3. All borders shall conform with detail sheet "Extruded Aluminum Destination Signs, Post and Frames".
4. Letters, Symbols and borders shall be reflectorized cut-outs or demountable copies. Destination signs will use reflectorized cut-outs.
5. All reflectorized cut-outs shall be embossed and shall be fastened on sign panel with blind rivets. See Special Provisions.

ORIGINAL	SURVEY PLOTTED BY	DATE
PLAN	DRAWN BY	" "
NOTE BOOK	QUANTITIES BY	" "
No.	CHECKED BY	" "

STATE OF HAWAII
DEPARTMENT OF TRANSPORTATION
HIGHWAYS DIVISION

DESTINATION SIGNS

KAWAIHAE - PUAKO ROAD
PROJ. NO. G-3257-01-60

SCALE: AS SHOWN

SHEET No. OF SHEETS