



PLAN	DATE	BY	CHKD	REV	NO.
SURVEYED					
NOTED					
NOTE BOOK					
RT OF WAY CHECKED					

PROFILE	DATE	BY	CHKD	REV	NO.
SURVEYED					
NOTED					
NOTE BOOK					
RT OF WAY CHECKED					

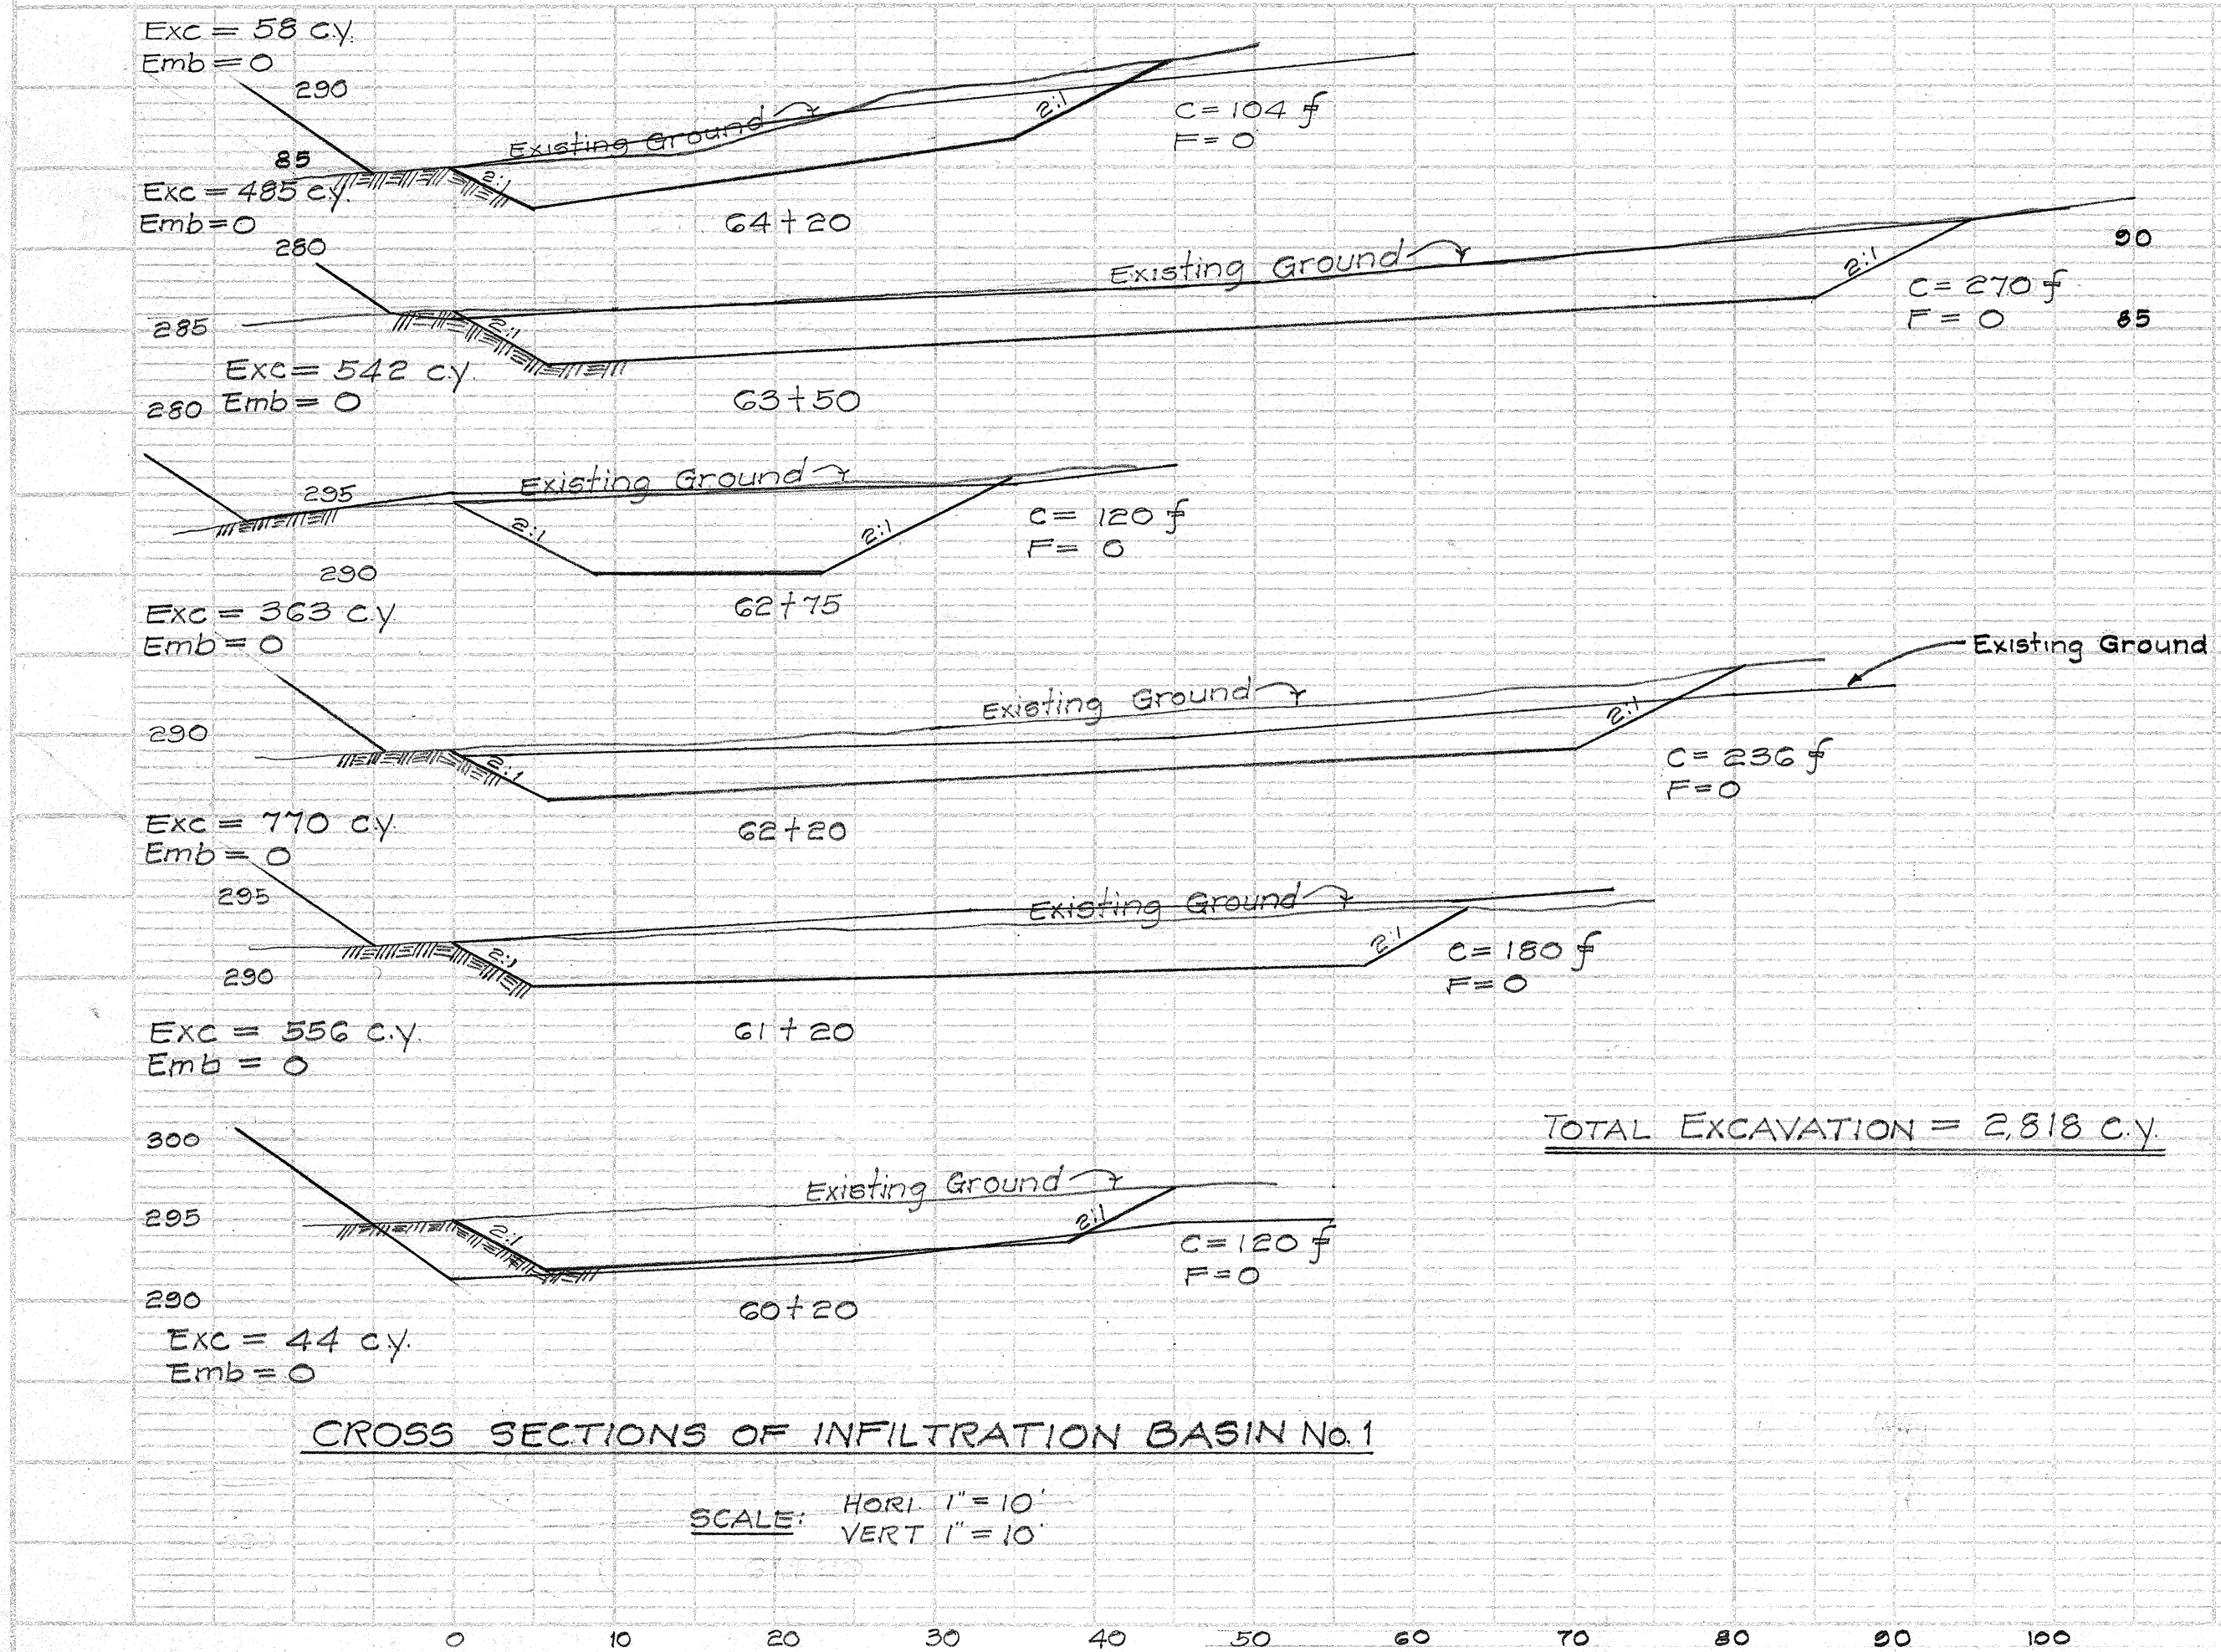

NOTE:
Roadway Embankment between Sta. 59+70 and Sta. 62+00 and also between Sta. 72+00 and Sta. 74+00 shall be constructed with Imported Borrow Material.
Removing of unsuitable material from areas on which Imported Borrow Embankment is to be constructed shall not be paid for separately but shall be considered as incidental to the item of Roadway Excavation.

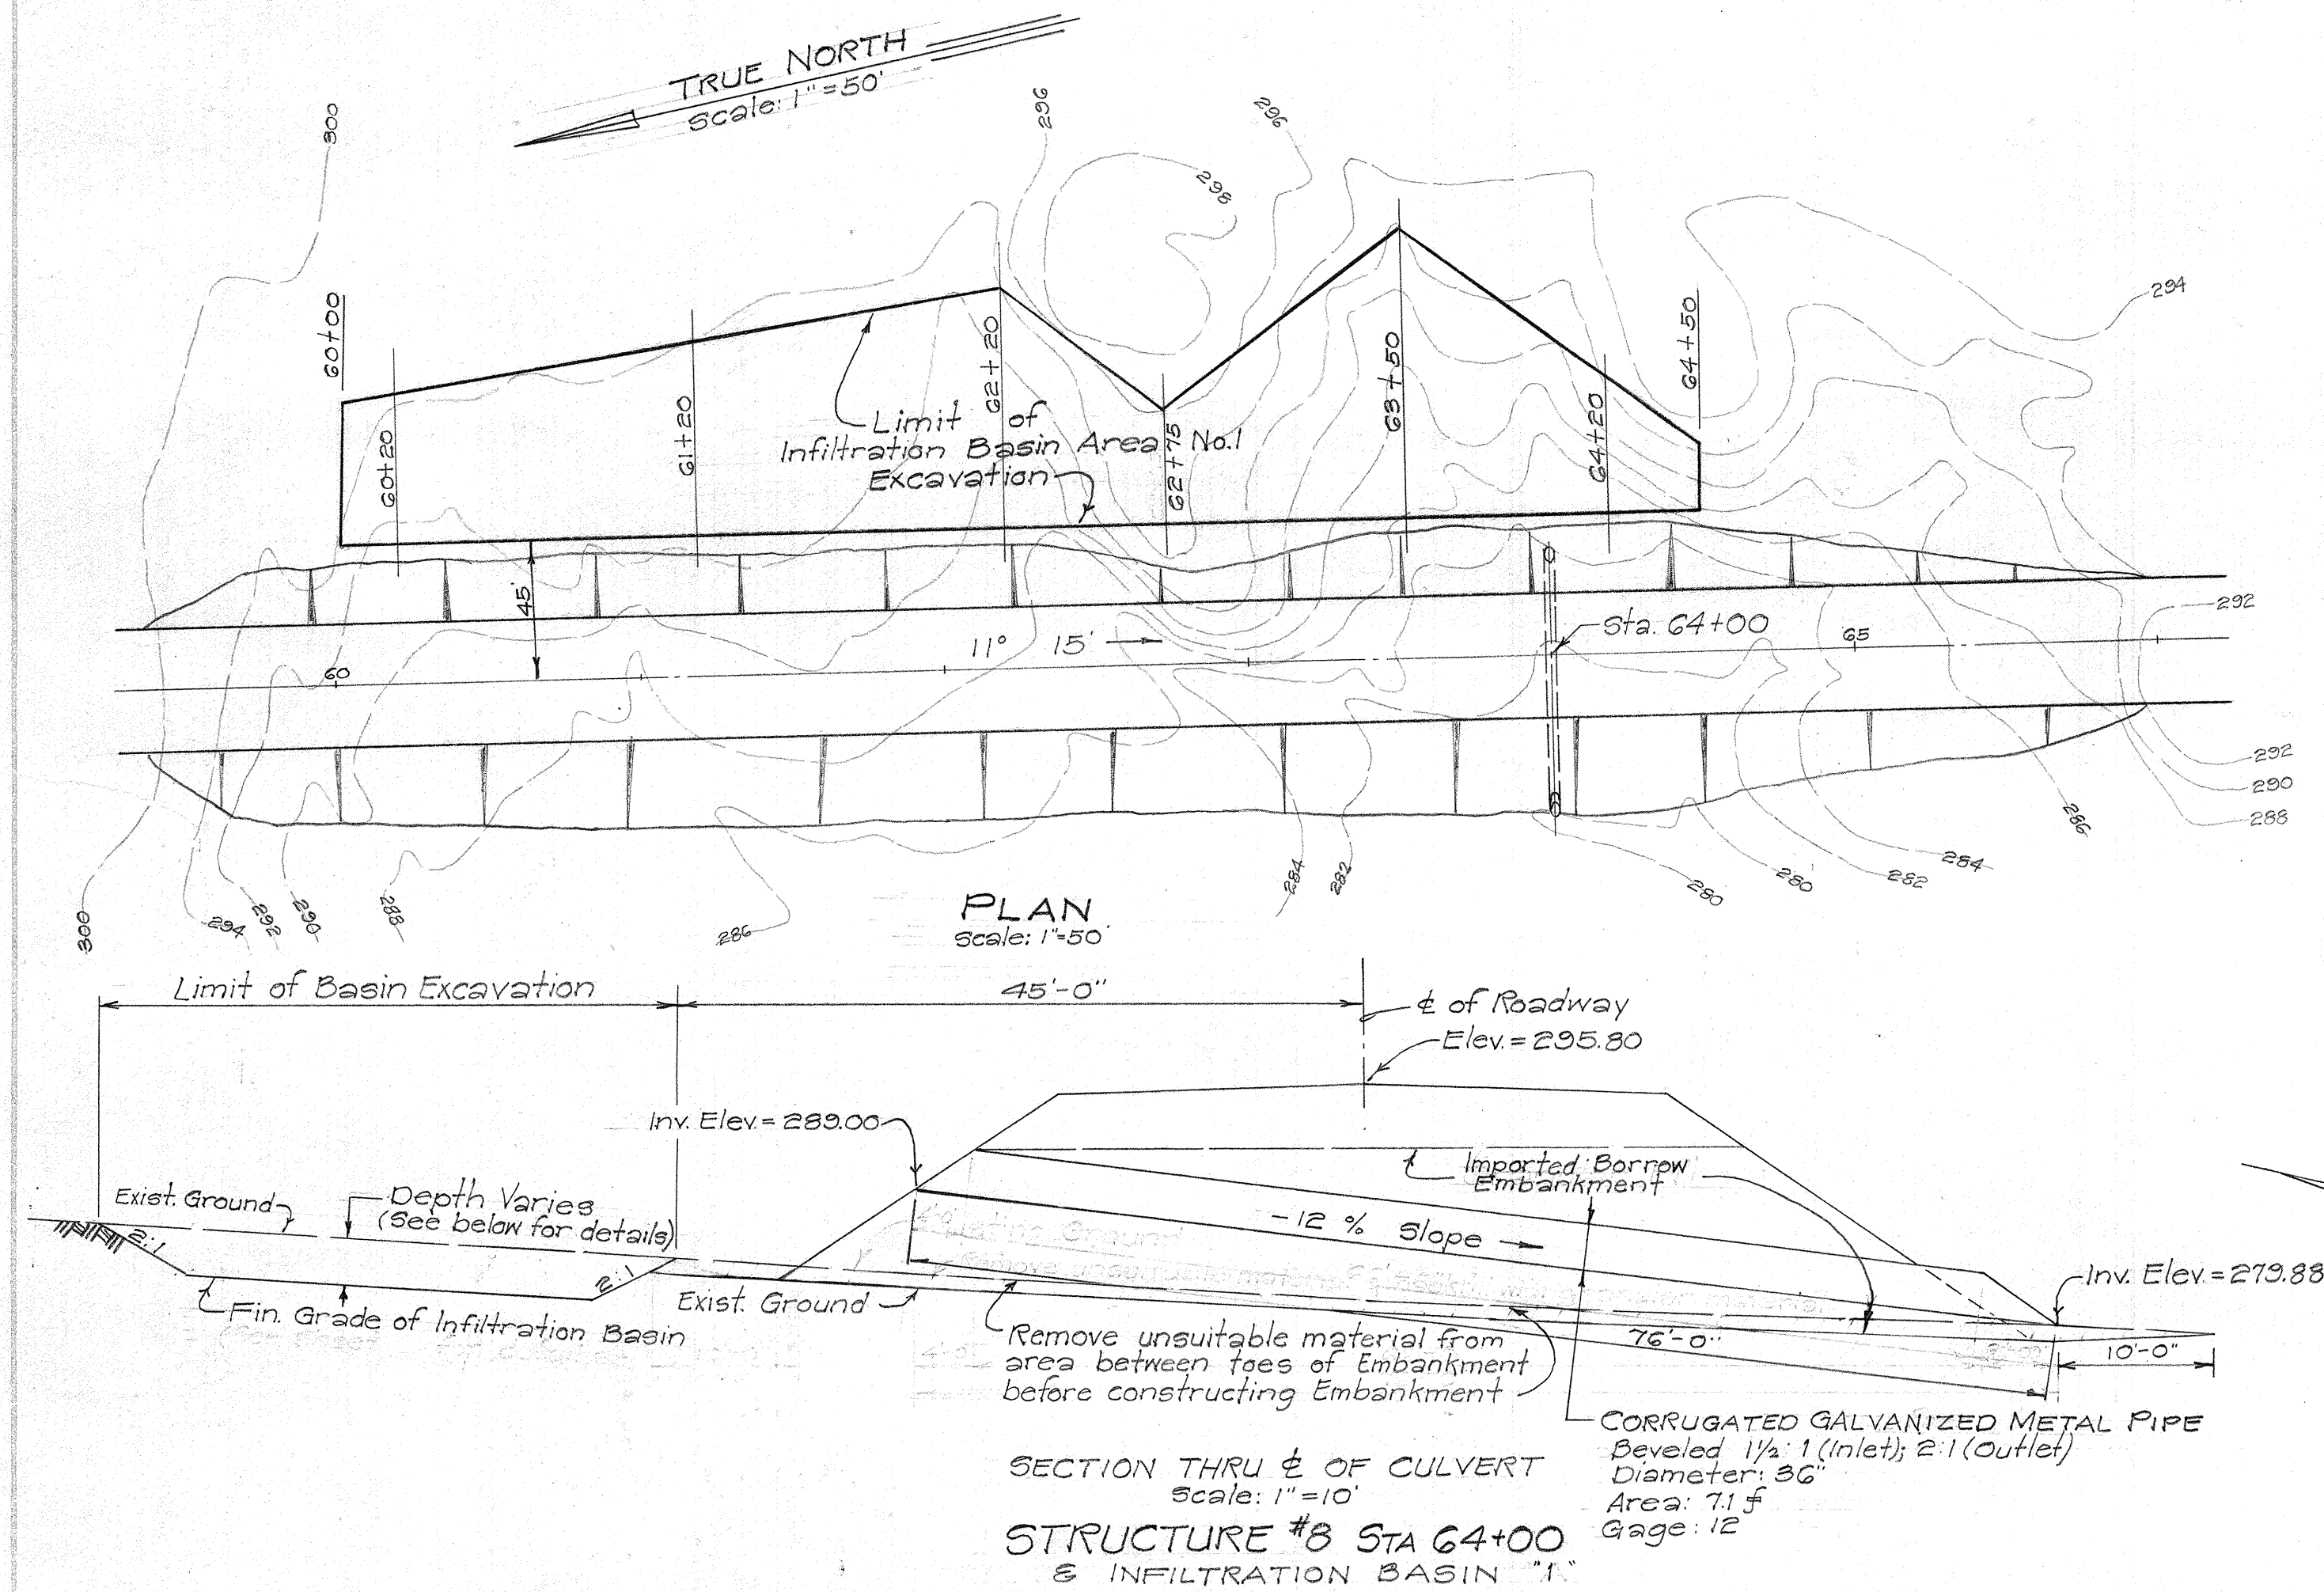