

INDEX TO DRAWINGS	
SHEET	DESCRIPTION
1	TITLE SHEET
2	TYPICAL SECTIONS
3	CORAL STOCKPILE SITE PLAN
4-II	PLAN AND PROFILE
12-13	DETAIL PLAN OF INTERSECTION
14-20	STRUCTURES — CULVERTS
21	INFILTRATION BASINS
22-25	WATER SYSTEM
26	DESTINATION SIGNS
27-30	STANDARD DETAILS

STATE OF HAWAII

DEPARTMENT OF TRANSPORTATION

HIGHWAYS DIVISION

"AS BUILT" PLANS OF

KAWAIHAE-PUAKO ROAD

HAWAII PROJECT NO. G-3257-01-60

DISTRICT OF SOUTH KOHALA


ISLAND OF HAWAII

SCALES

PLAN----- 1 INCH = 100 FT.

PROFILE----- HOR. 1 INCH = 100 FT.

VER. 1 INCH = 10 FT.

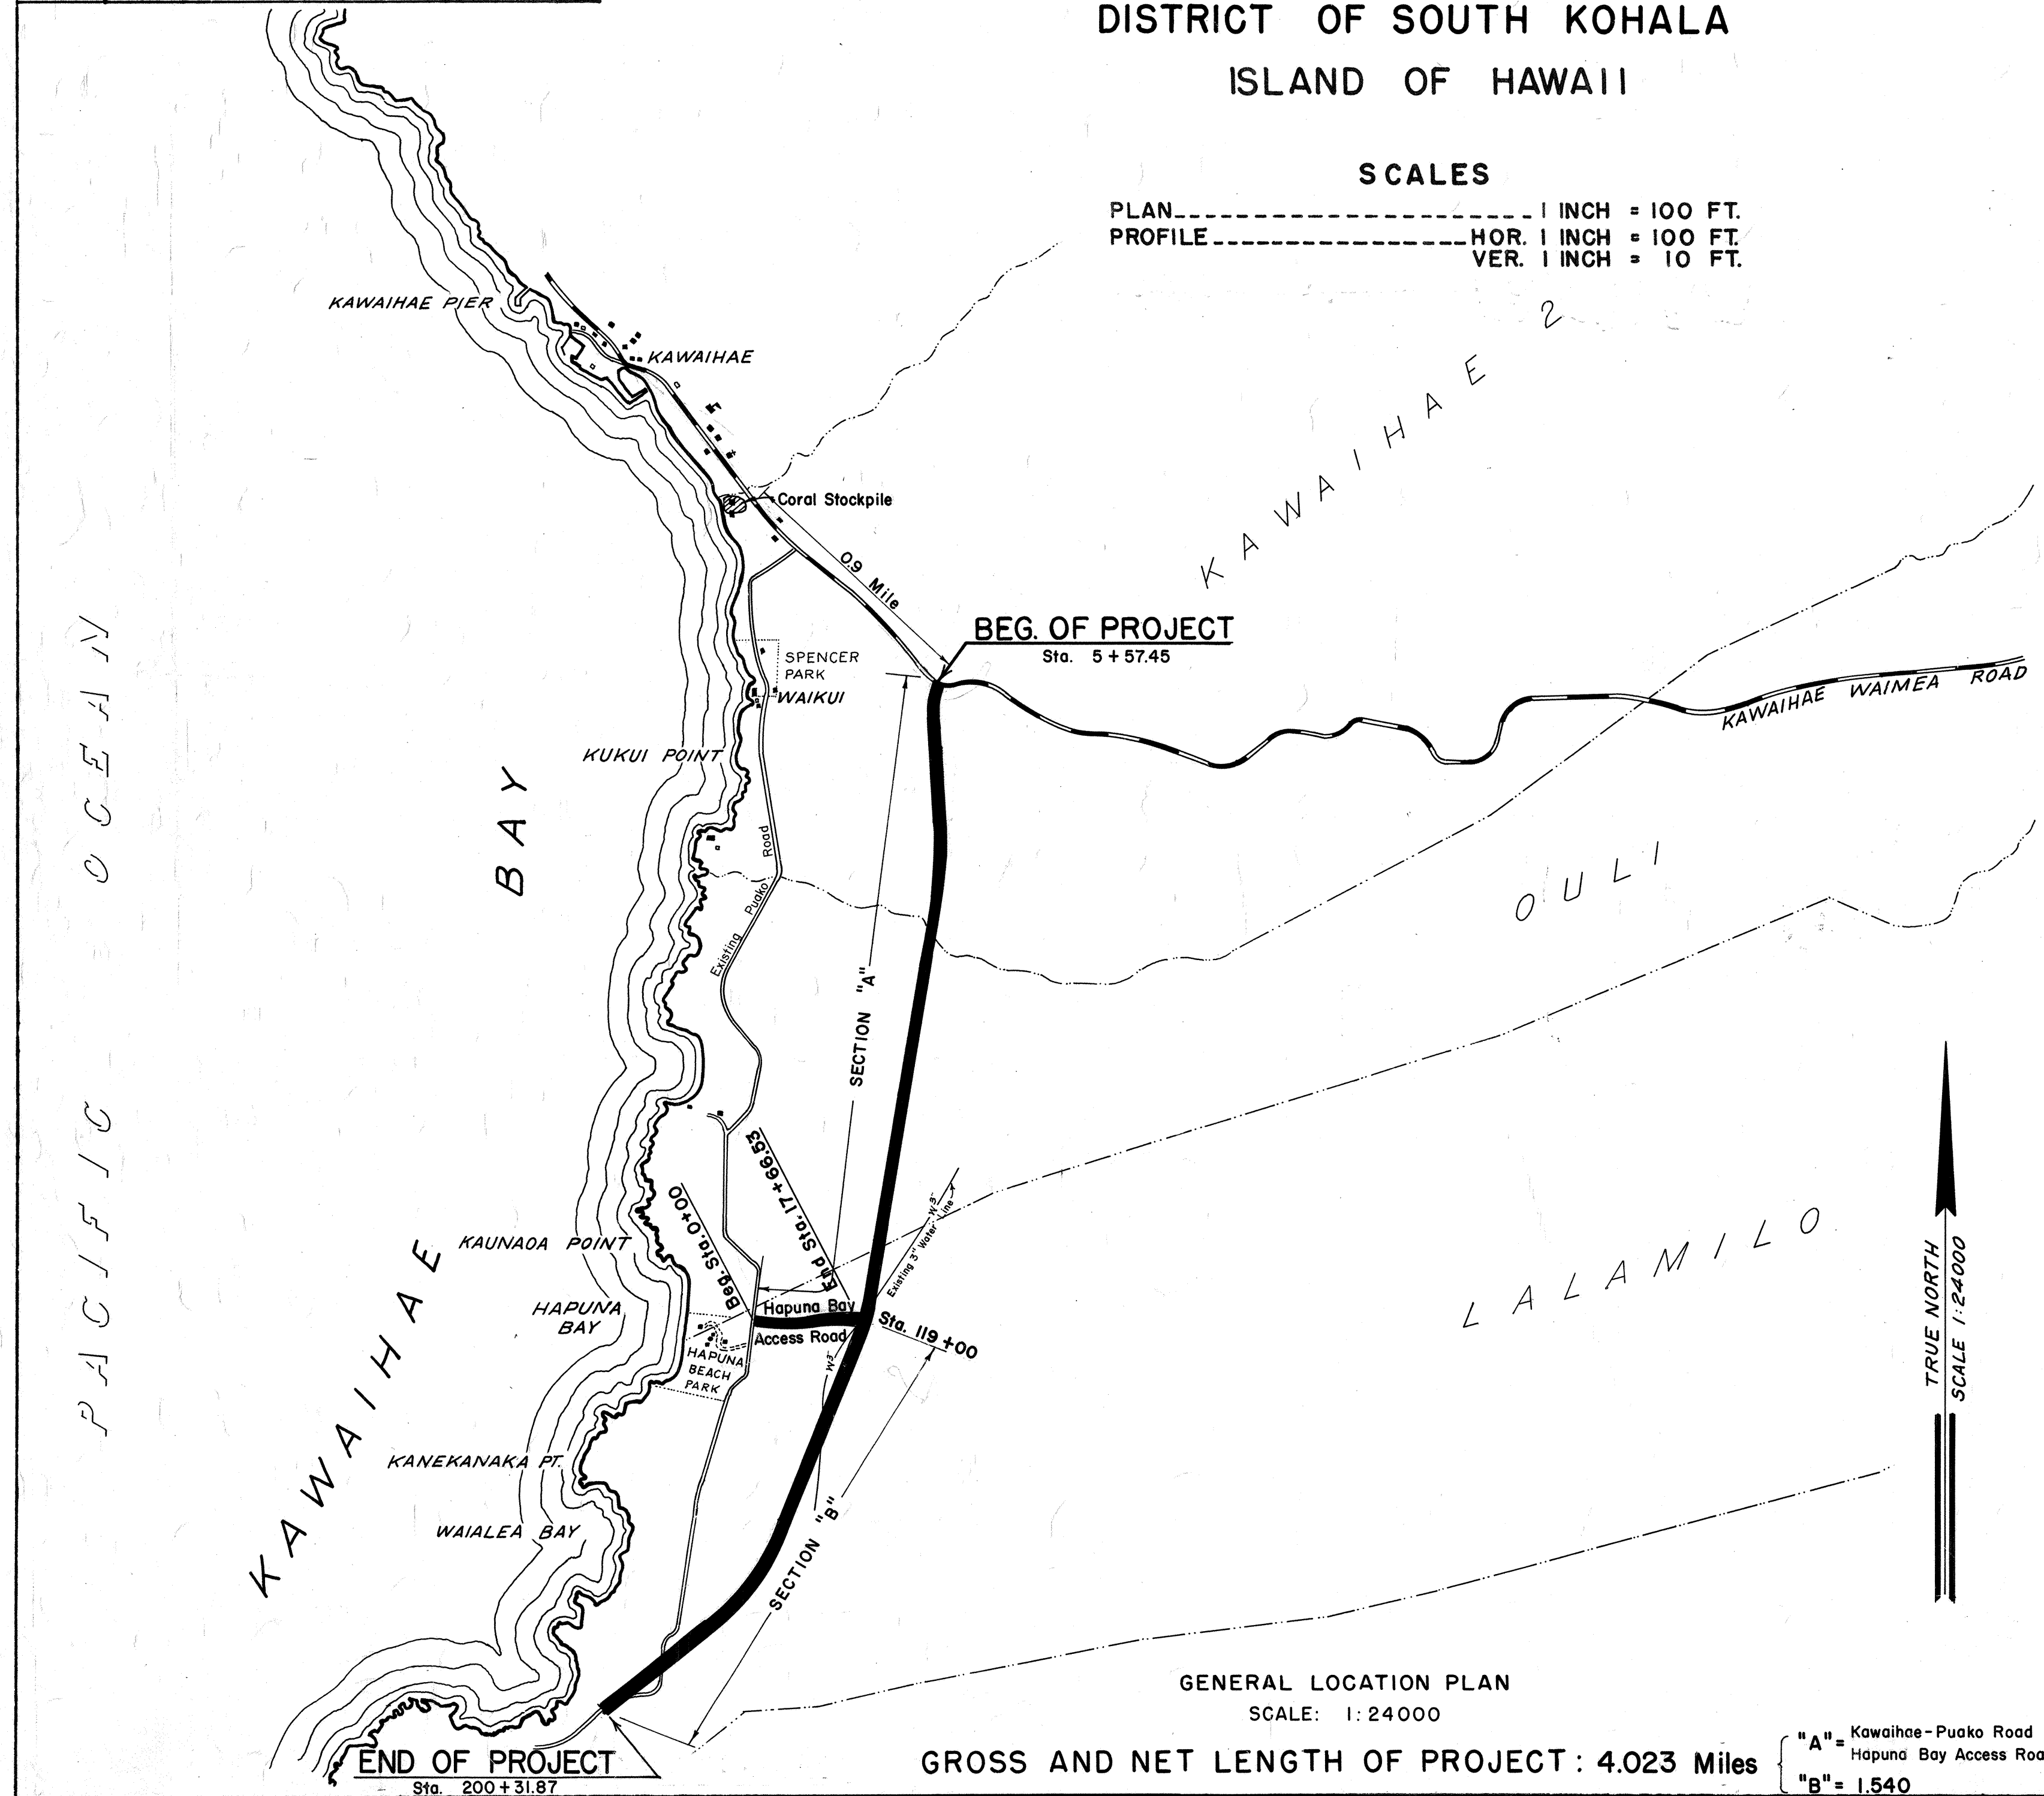

LOCATION OF PROJECT

NOTE: ALL CHANGES MADE DURING

CONSTRUCTION ARE SHOWN IN

RED ON THESE TRACINGS AND

CHECKED BY

Severick

PROJECT ENGINEER

June 30, 1964

DATE

AUTHORIZED BY:

ROADWAY - ACT 23, SLH 1960, ITEM IC-3(H), ALLOTMENT

SYMBOL G-3257

ACT 195, SLH 1961, SECTION I, ITEM D-III-8

ALLOTMENT SYMBOL B-3225

ACT 30, SLH 1962, SECTION I, ITEM D-3j,

ALLOTMENT SYMBOL B-3265

WATER SYSTEM - ACT 195, SLH, 1961, SECTION I, ITEM D-II-7

APPROVED: DATE Feb. 4, 1963

Severick

DIRECTOR OF TRANSPORTATION

"A" = Kawaihae-Puako Road = 2.148

Hapuna Bay Access Road = 0.335

"B" = 1.540


GENERAL LOCATION PLAN

SCALE: 1:24000

GROSS AND NET LENGTH OF PROJECT: 4.023 Miles

TRUE NORTH

SCALE 1:24000

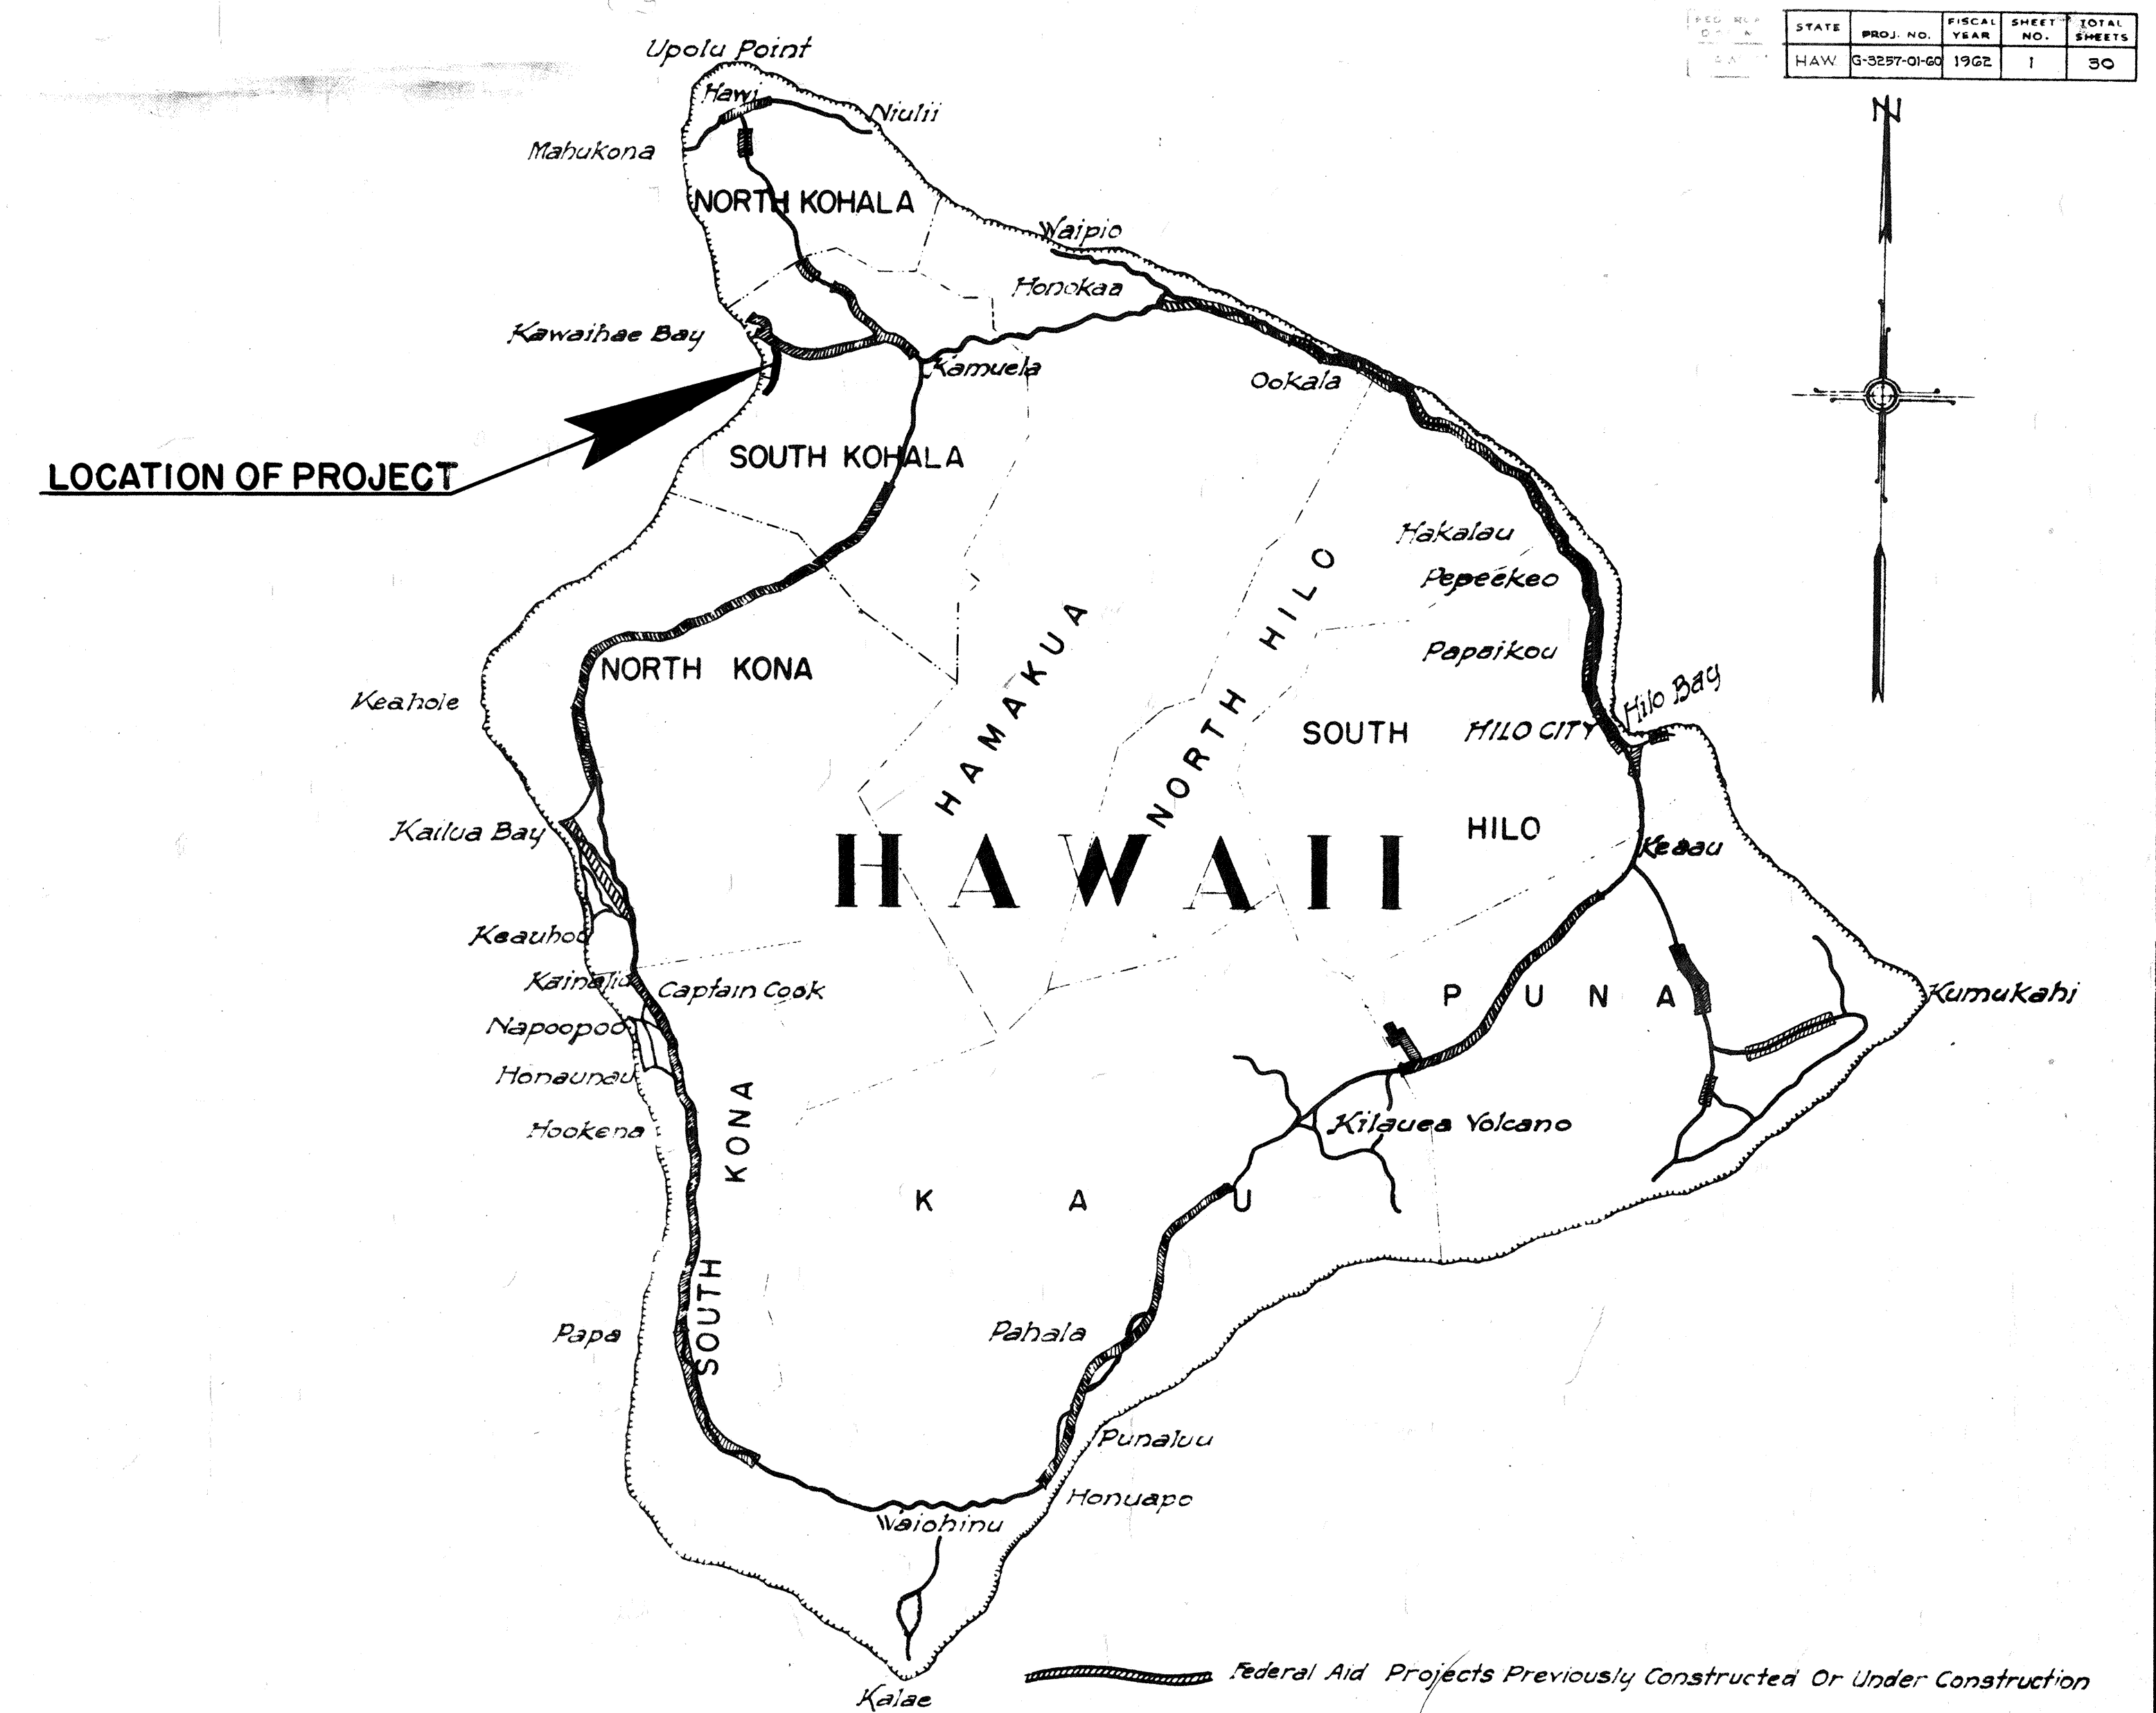

DATE

DESIGNED BY

DRAWN BY

CHECKED BY

NOTED BY

NOTED BY