


DIST. No.	STATE	PROJ. No.	FISCAL YEAR	SHEET No.	TOTAL SHEETS
HAWAII	HAW.	H-1202-63	1963	5	6

DATE	BY	SURVEYED	PLOTTED	NOTE BOOK	AREAS CHECKED

DATE	BY	SURVEYED	PLOTTED	NOTE BOOK	AREAS CHECKED

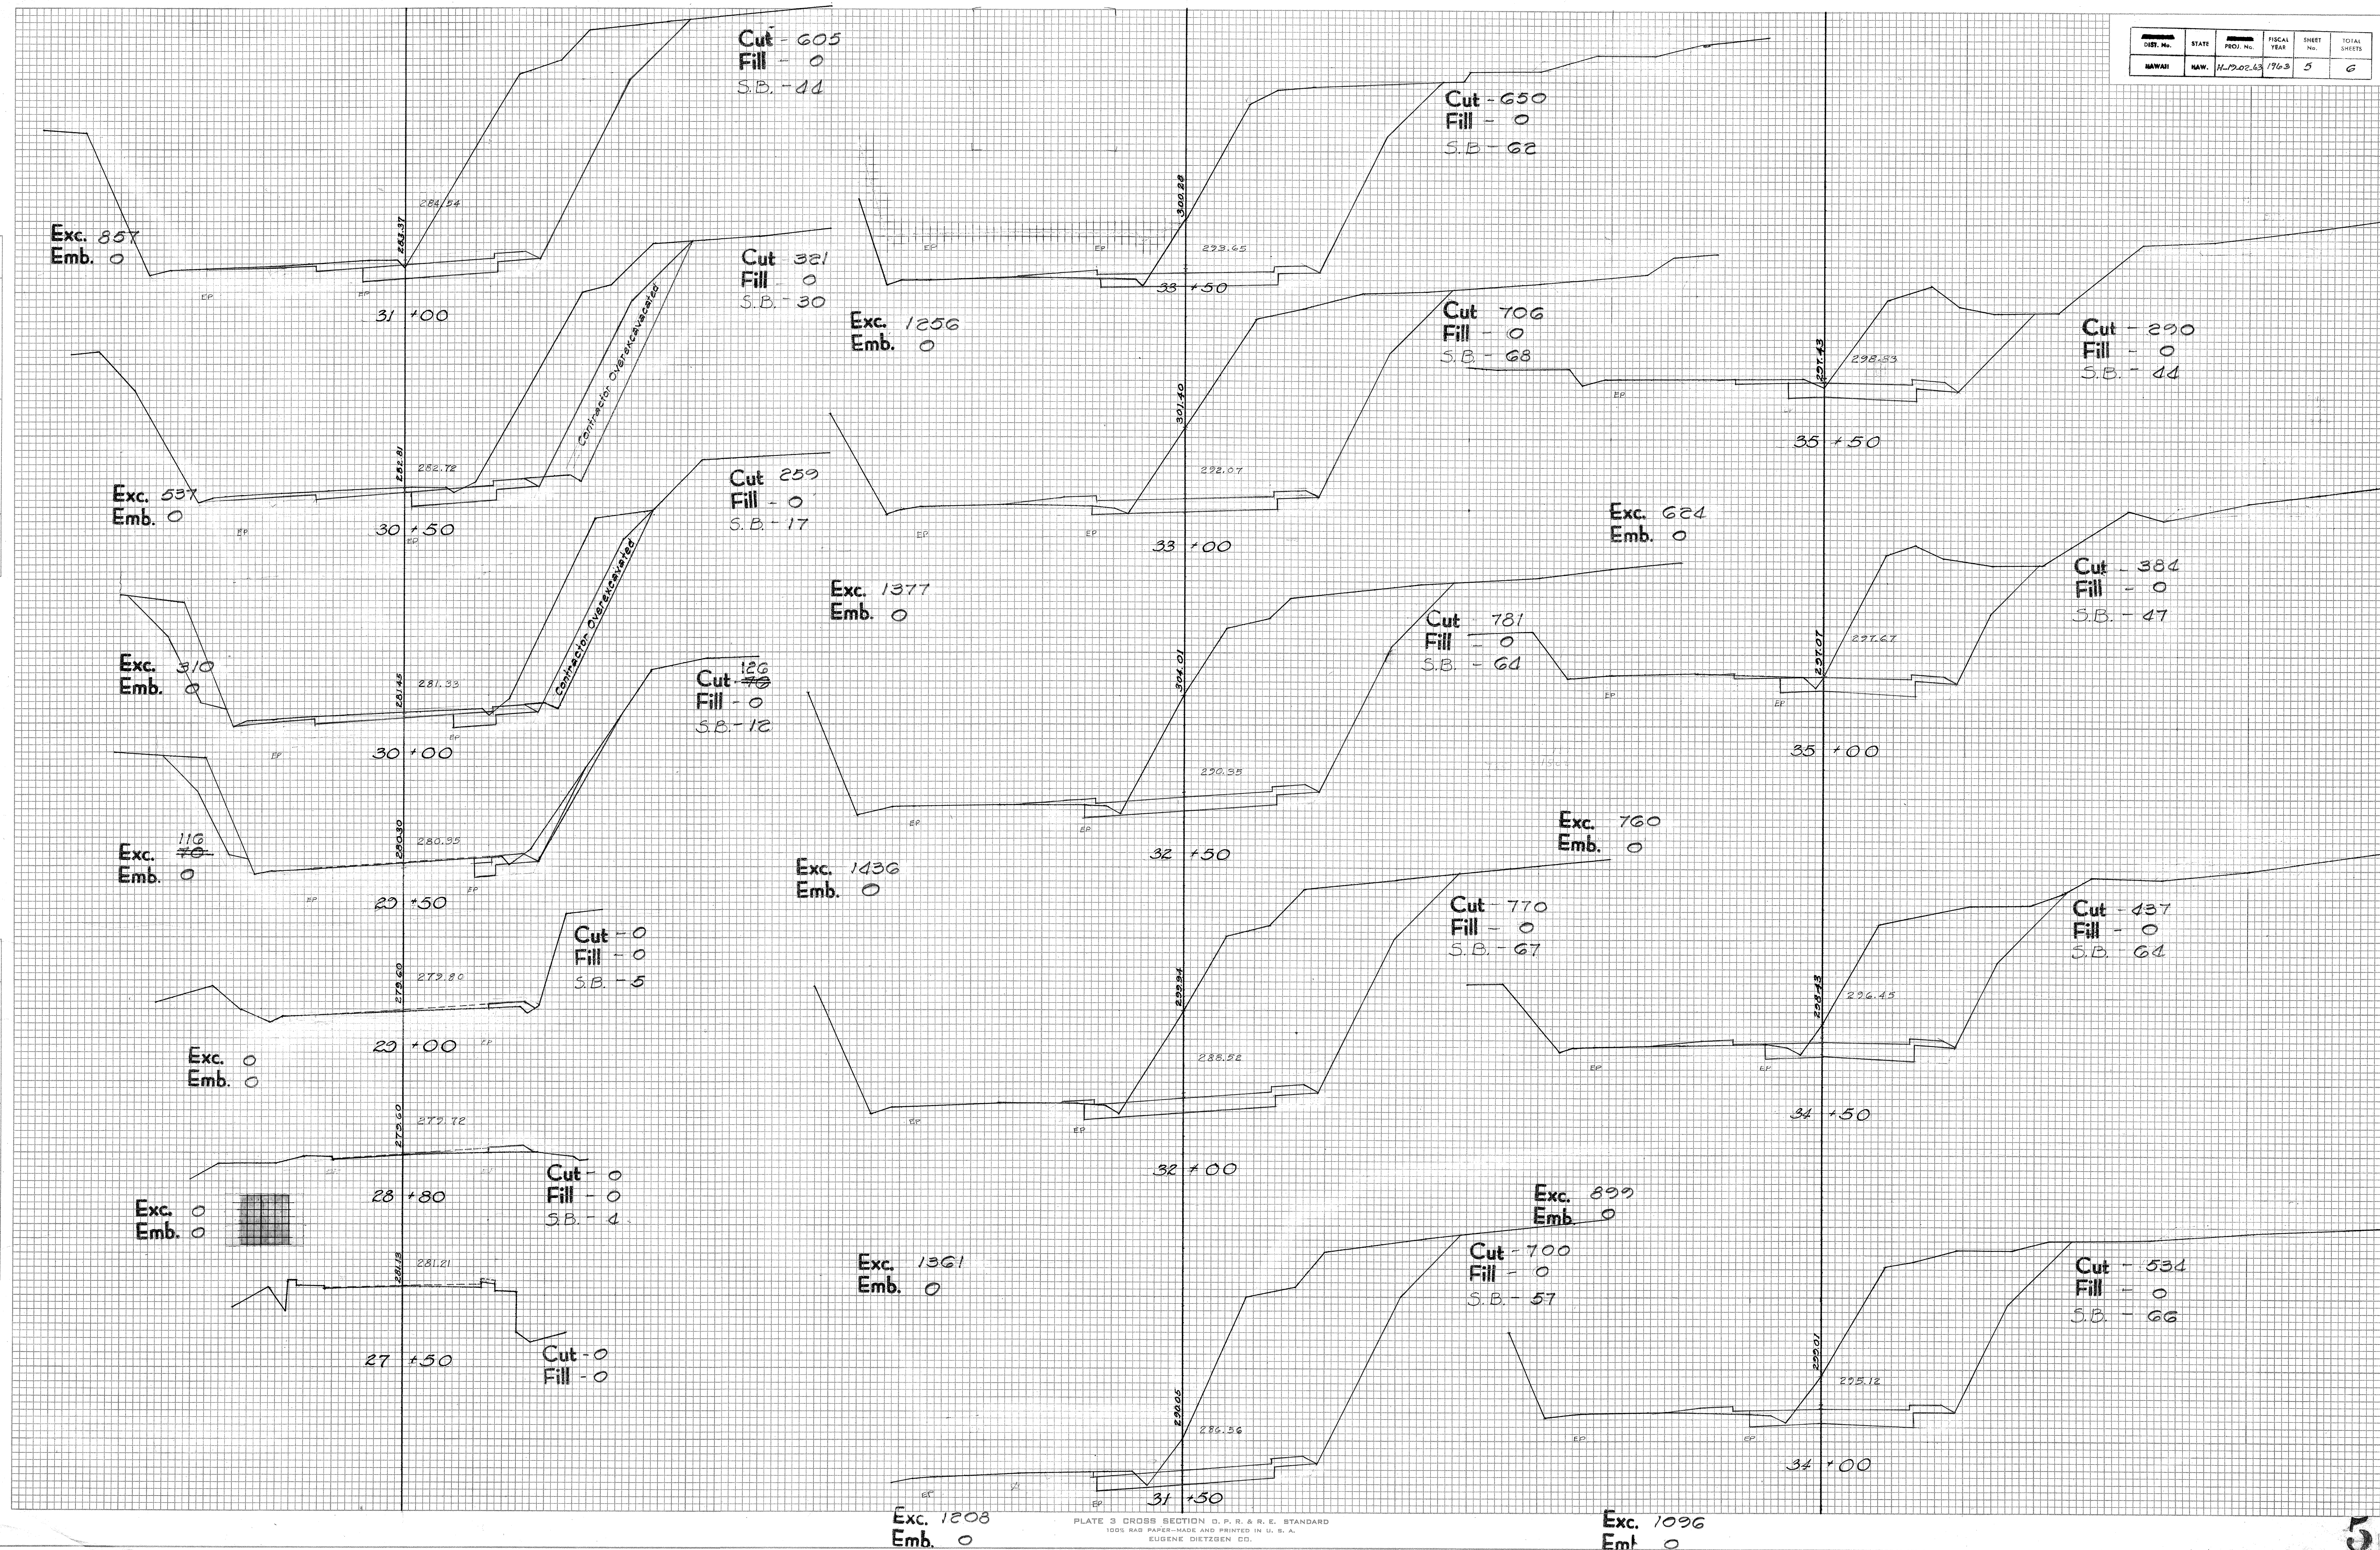

DATE	BY	FINAL SURVEY	SURVEYED	PLOTTED	DATE	AREAS CHECKED

DATE	BY	ORIGINAL SURVEY	SURVEYED	PLOTTED	DATE	AREAS CHECKED

