

| INDEX TO DRAWINGS |                          |
|-------------------|--------------------------|
| SHEET             | DESCRIPTION              |
| 1                 | TITLE SHEET              |
| 2-3               | TYPICAL SECTION & DETAIL |
| 4                 | PLAN AND PROFILE         |
| 5-6               | CROSS SECTIONS           |
|                   |                          |
|                   |                          |
STATE OF HAWAII

DEPARTMENT OF TRANSPORTATION

HIGHWAYS DIVISION

"PLANS OF  
"AS BUILT"

HAWAII BELT ROAD

REALIGN & WIDEN KAPEHU BRIDGE APPROACH

(PORTIONS OF SDR-3(16) & SDR-3(22))

HAWAII PROJECT NO. H-19-02-63

DISTRICT OF NORTH HILO

ISLAND OF HAWAII

PLAN

PROFILE

CROSS SECTION

-----

-----

-----

1 INCH = 100 FT.




1 INCH = 100 FT.

1 INCH = 10 FT.

1 INCH = 10 FT.

1 INCH = 10 FT.

1 INCH = 10 FT.

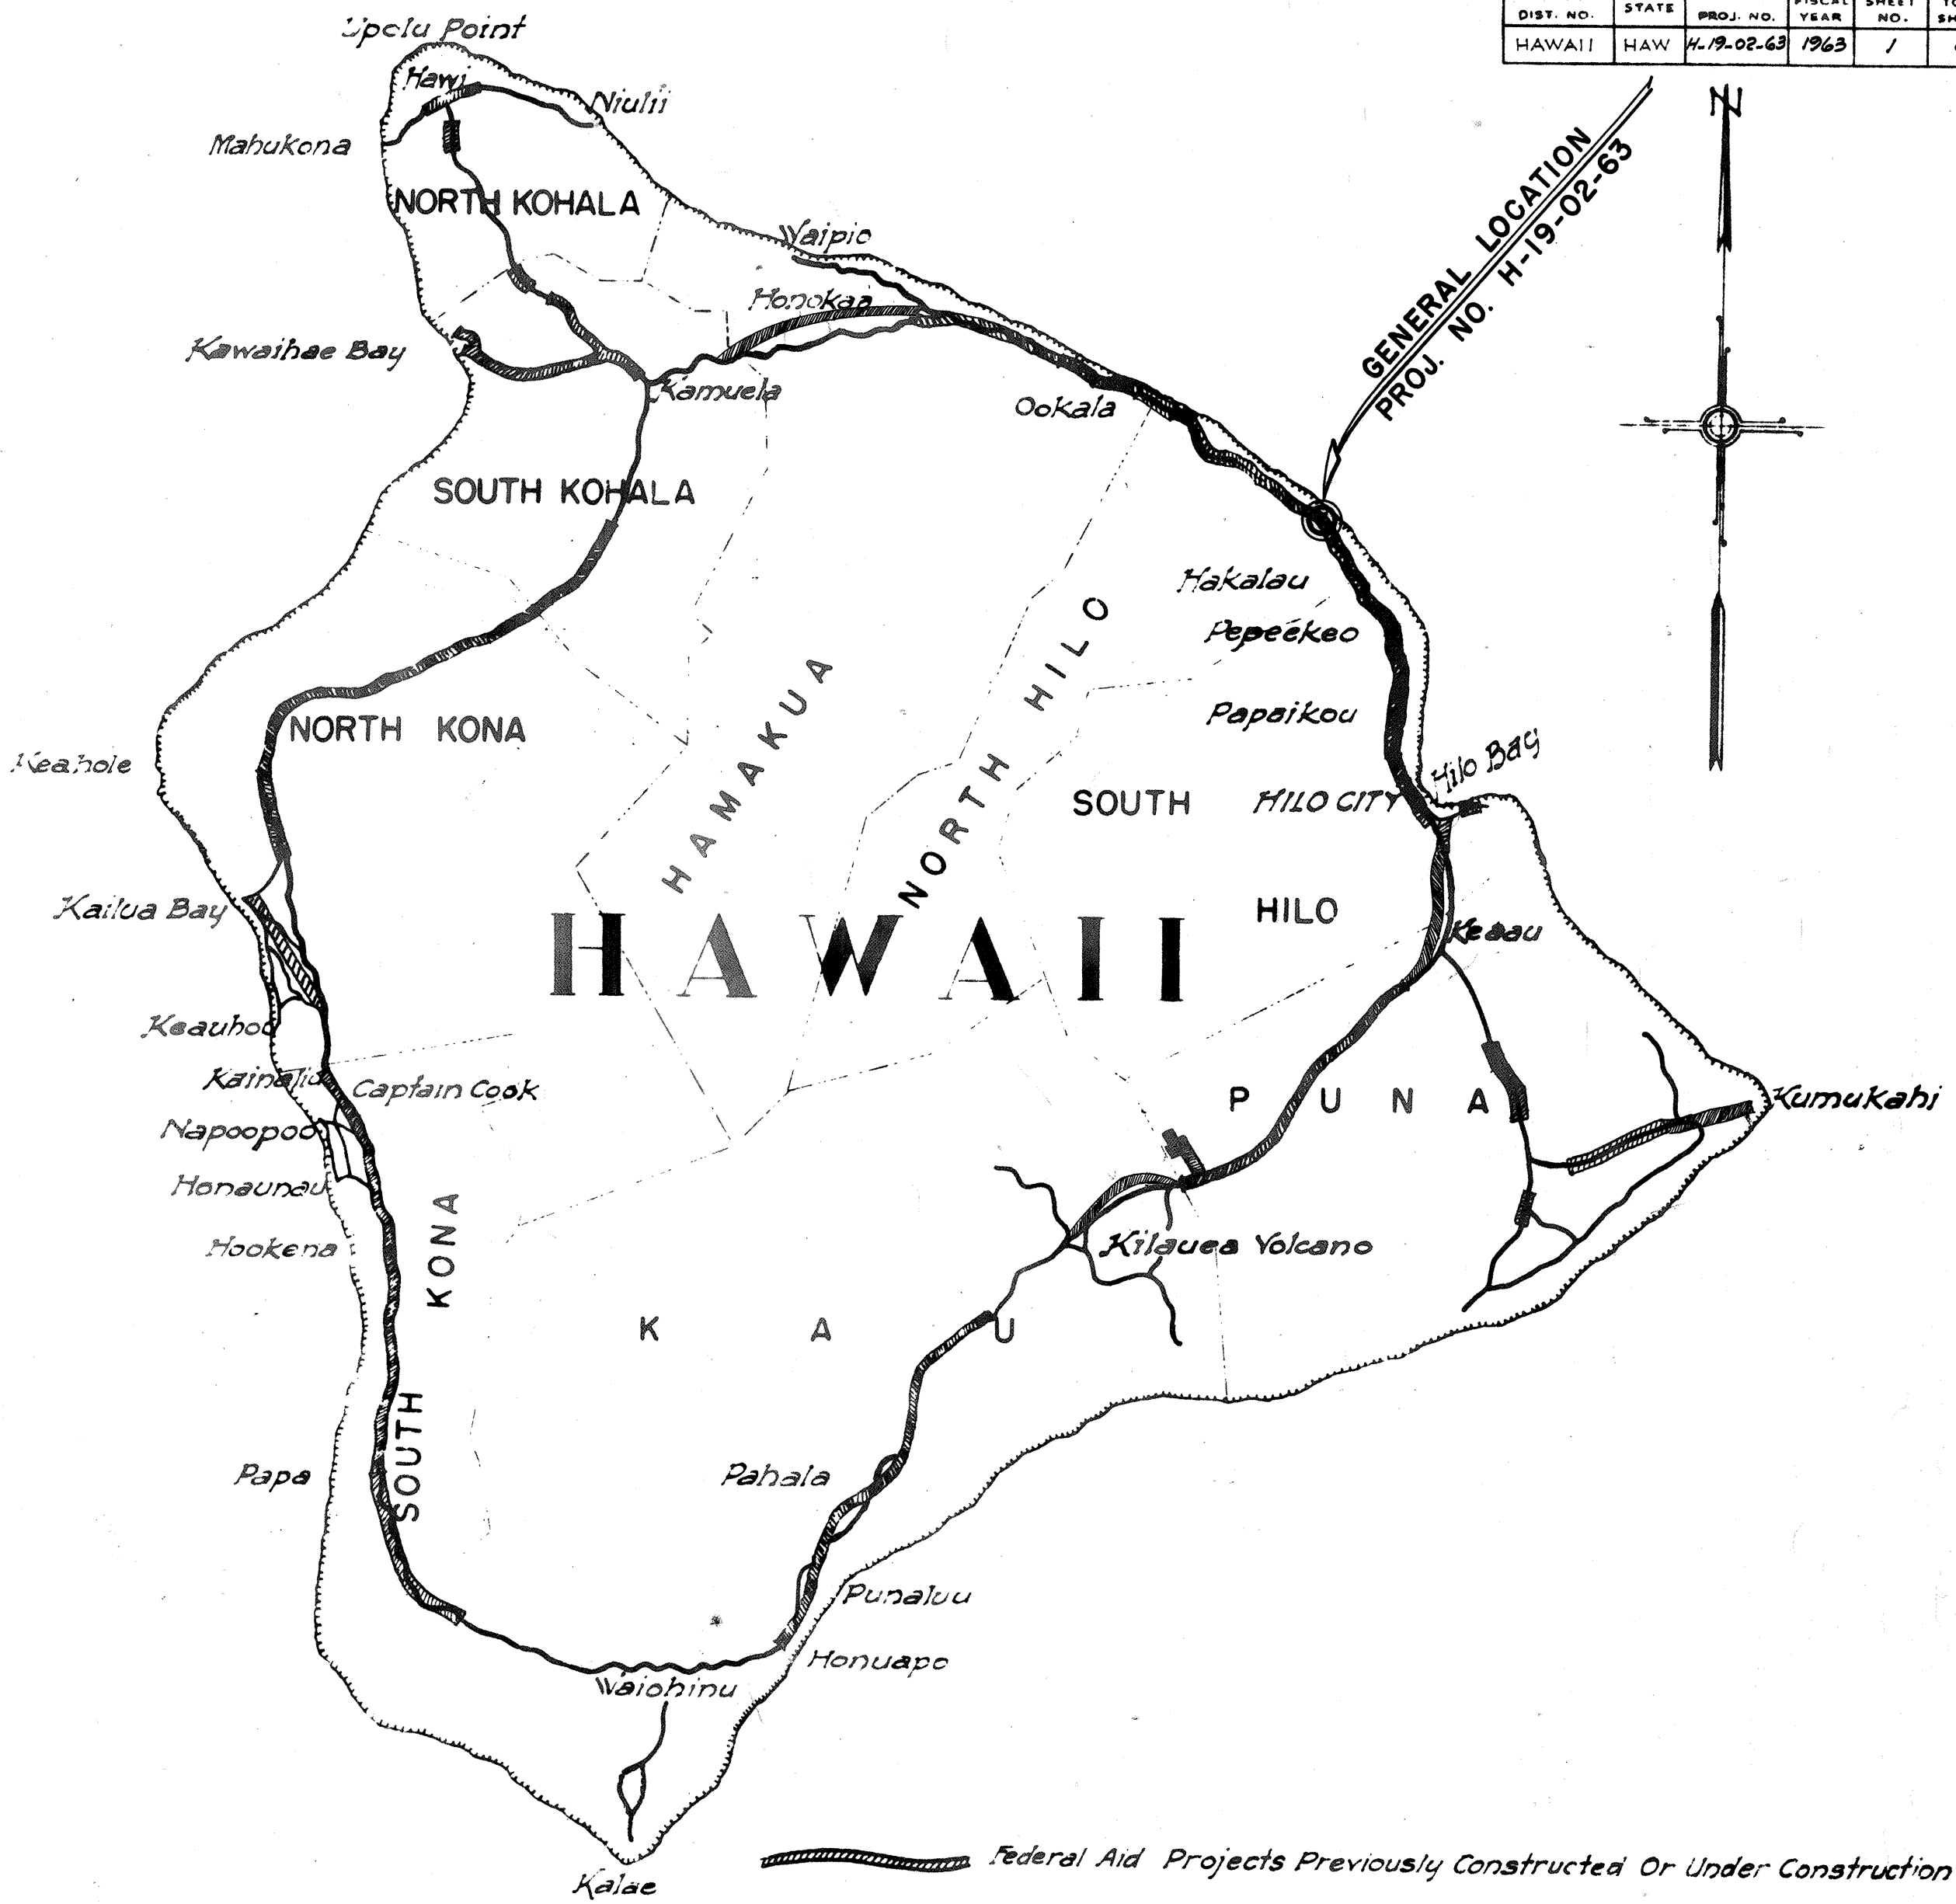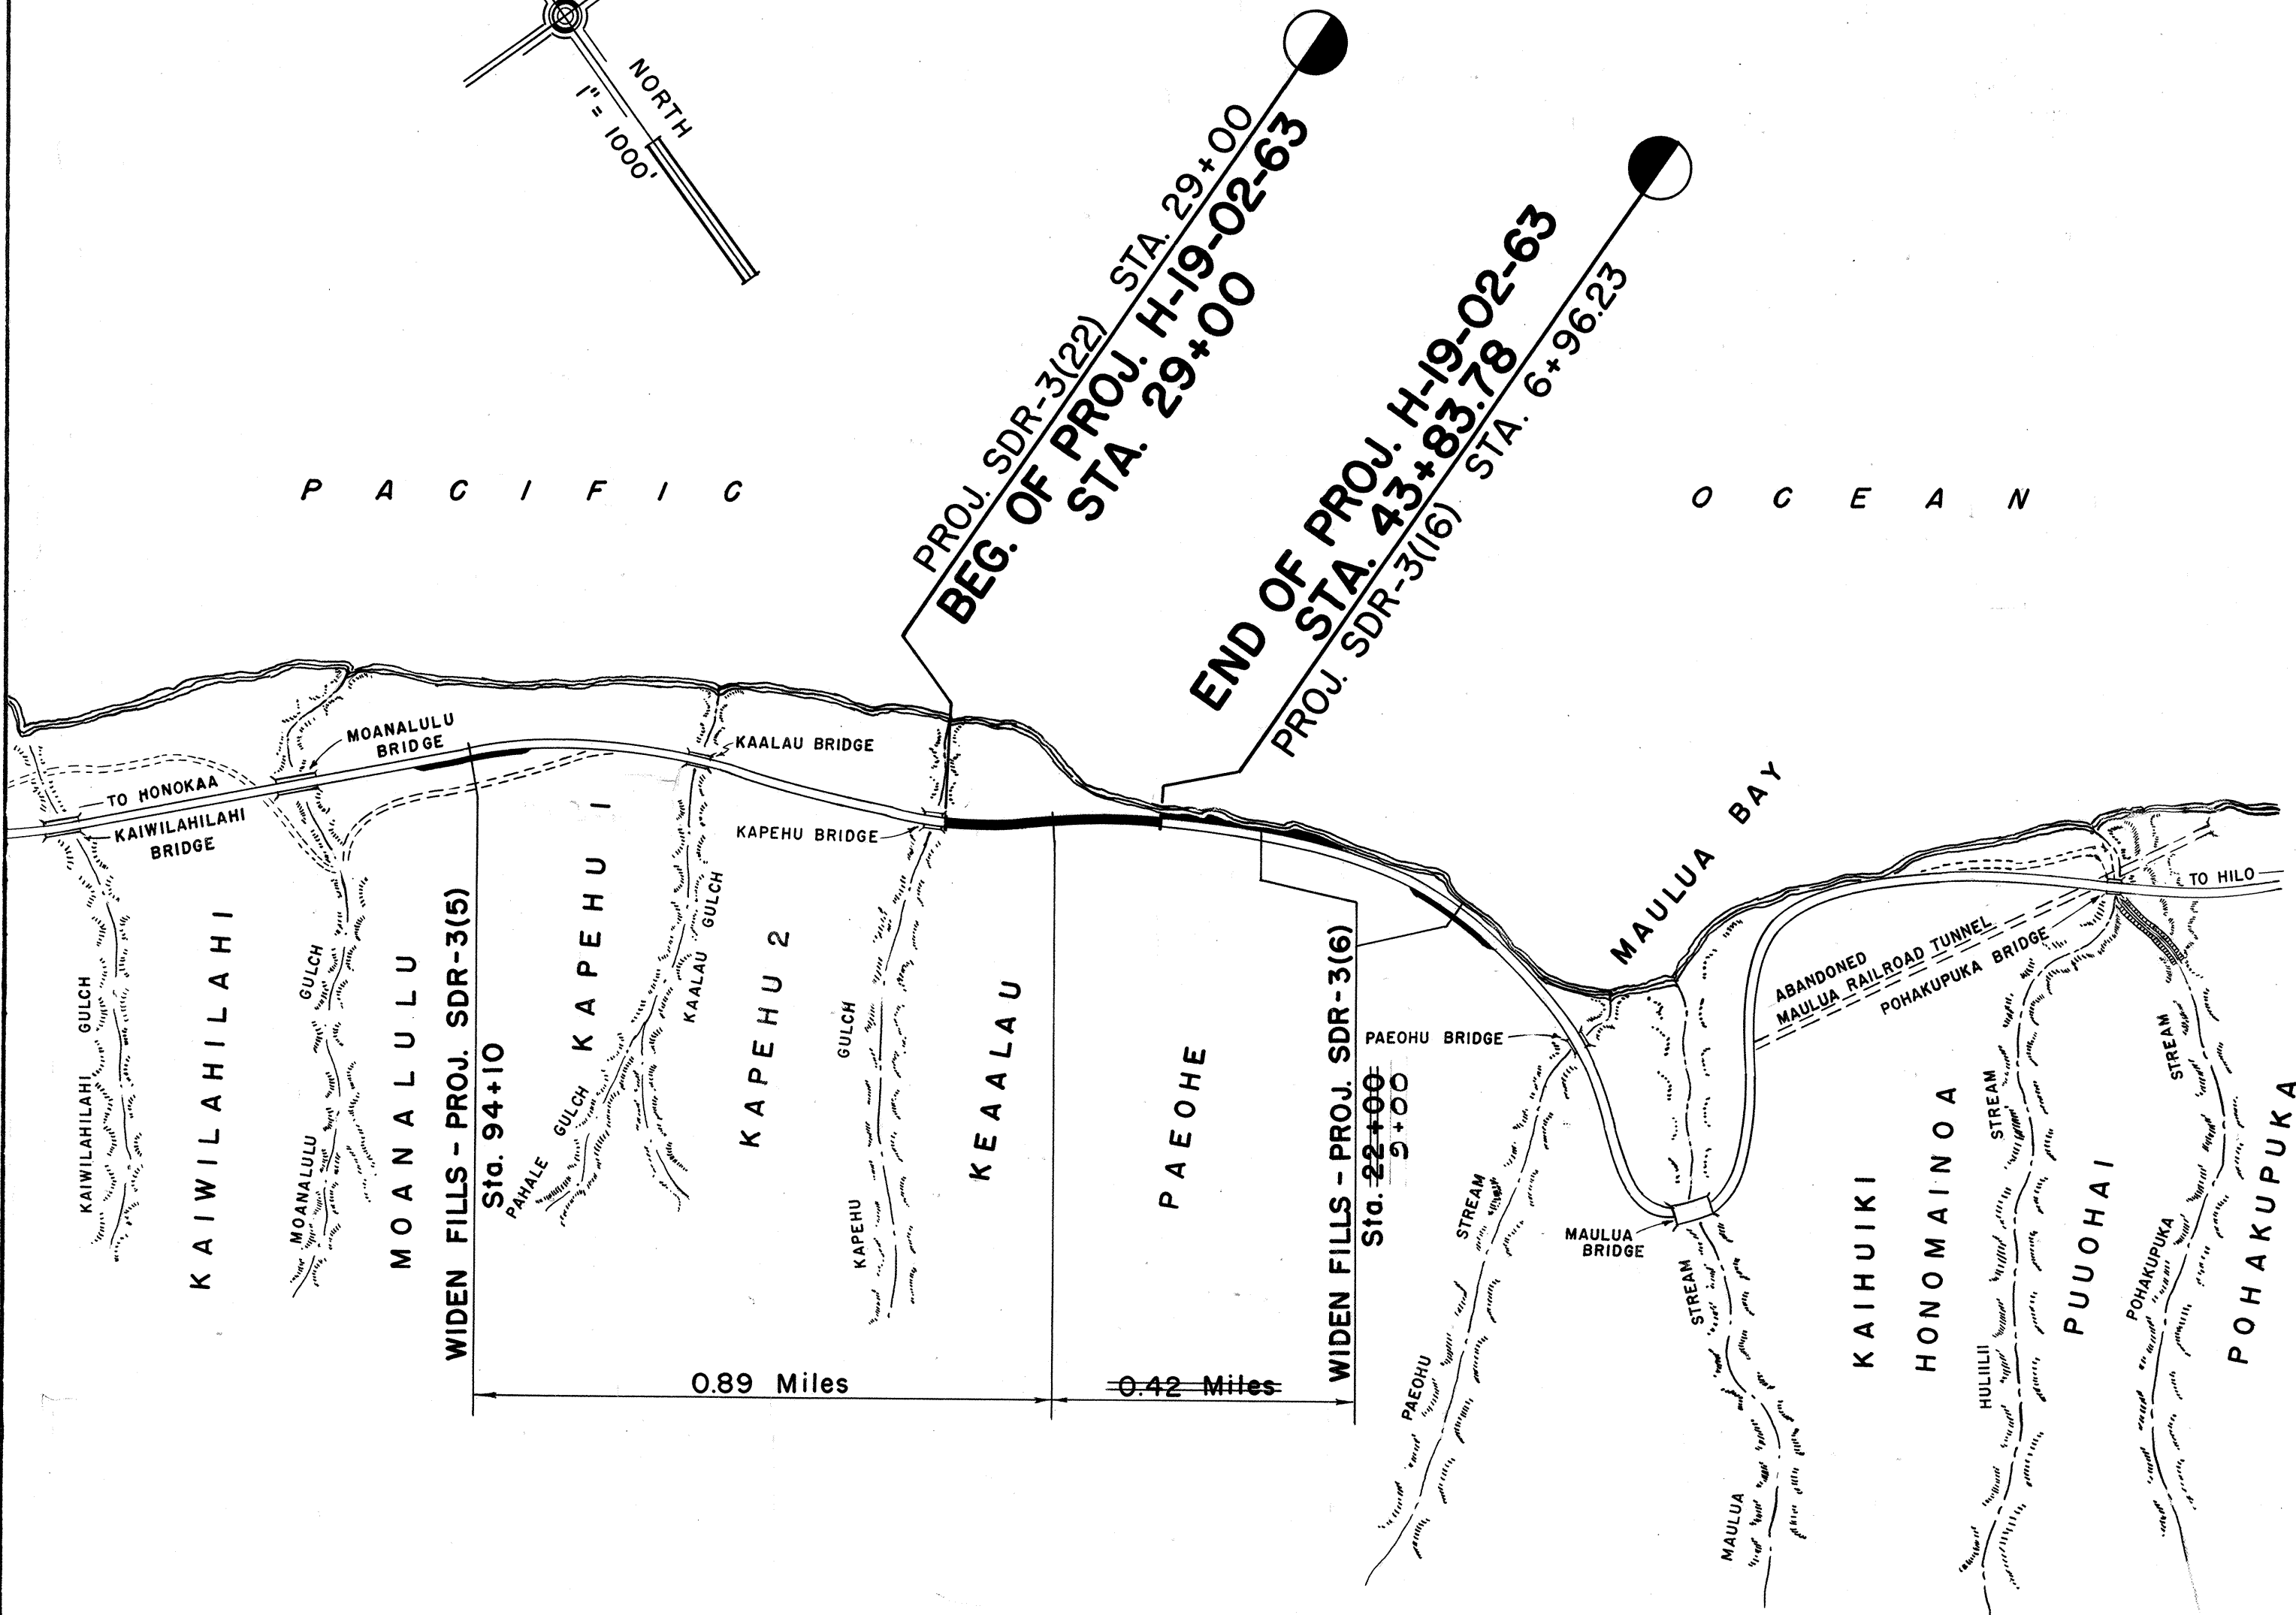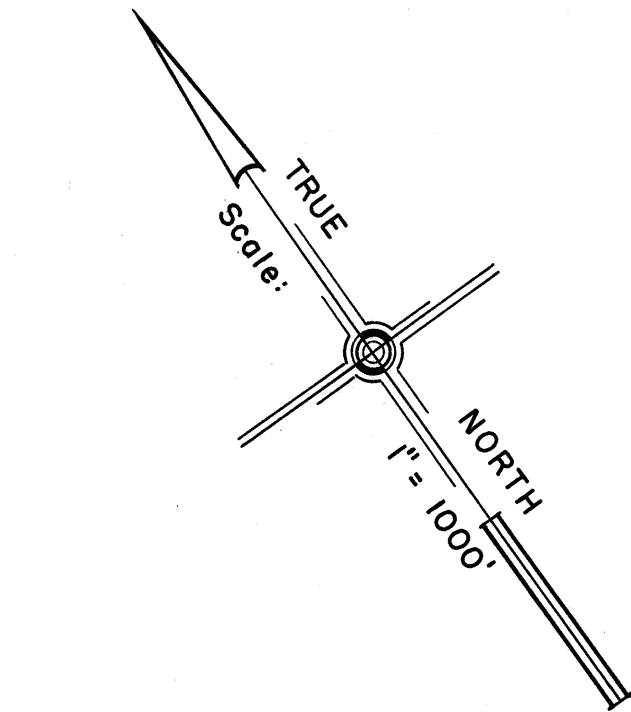

NOTE: ALL CHANGES MADE DURING CONSTRUCTION ARE SHOWN IN RED ON THESE TRACINGS AND ARE CHECKED BY

George T. Kodani  
 PROJECT ENGINEER  
 July 9, 1964  
 DATE

LAYOUT OF PROJECT

GROSS & NET LENGTH OF PROJECT: 0.281 Miles

APPROVED: DATE: 23 Aug 63

J. J. Matunda  
 DIRECTOR OF TRANSPORTATION