




PLAN	SURVEYED	BY	DATE
NOTE BOOK	PLOTTED		
NO.	ALIGNMENT CHECKED		
	RT. OF WAY CHECKED		

PROFILE	SURVEYED	BY	DATE
NOTE BOOK	PLOTTED		
NO	B MS NOTED		
	STRUCTURE NOTATIONS CHKD		

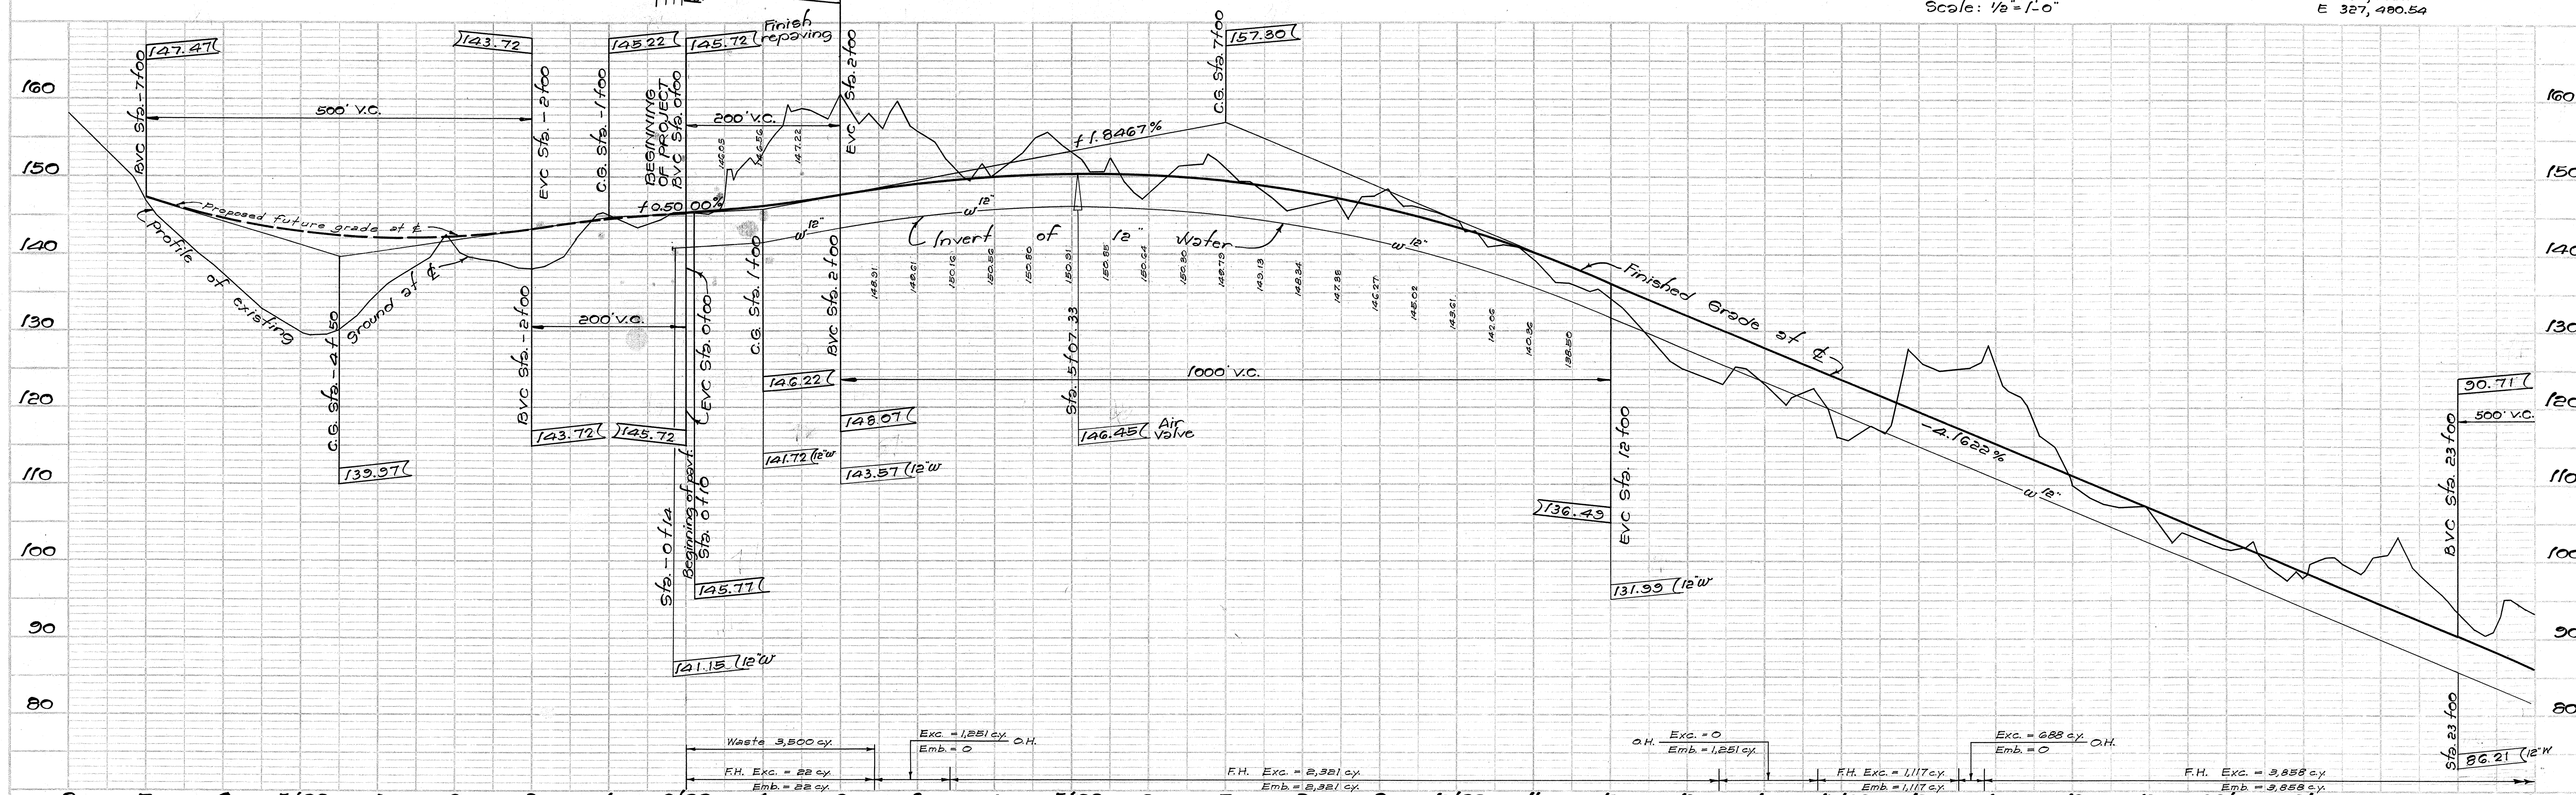



PLAN	SURVEYED	DATE
NO.	BY	
NOTE BOOK	FLIPPED	
NO.	ALIGNED	
NO.	RT OF WAY CHECKED	

PROFILE	SURVEYED	DATE
NO.	BY	
NOTE BOOK	FLIPPED	
NO.	ALIGNED	
NO.	STRUCTURE NOTES CHECKED	

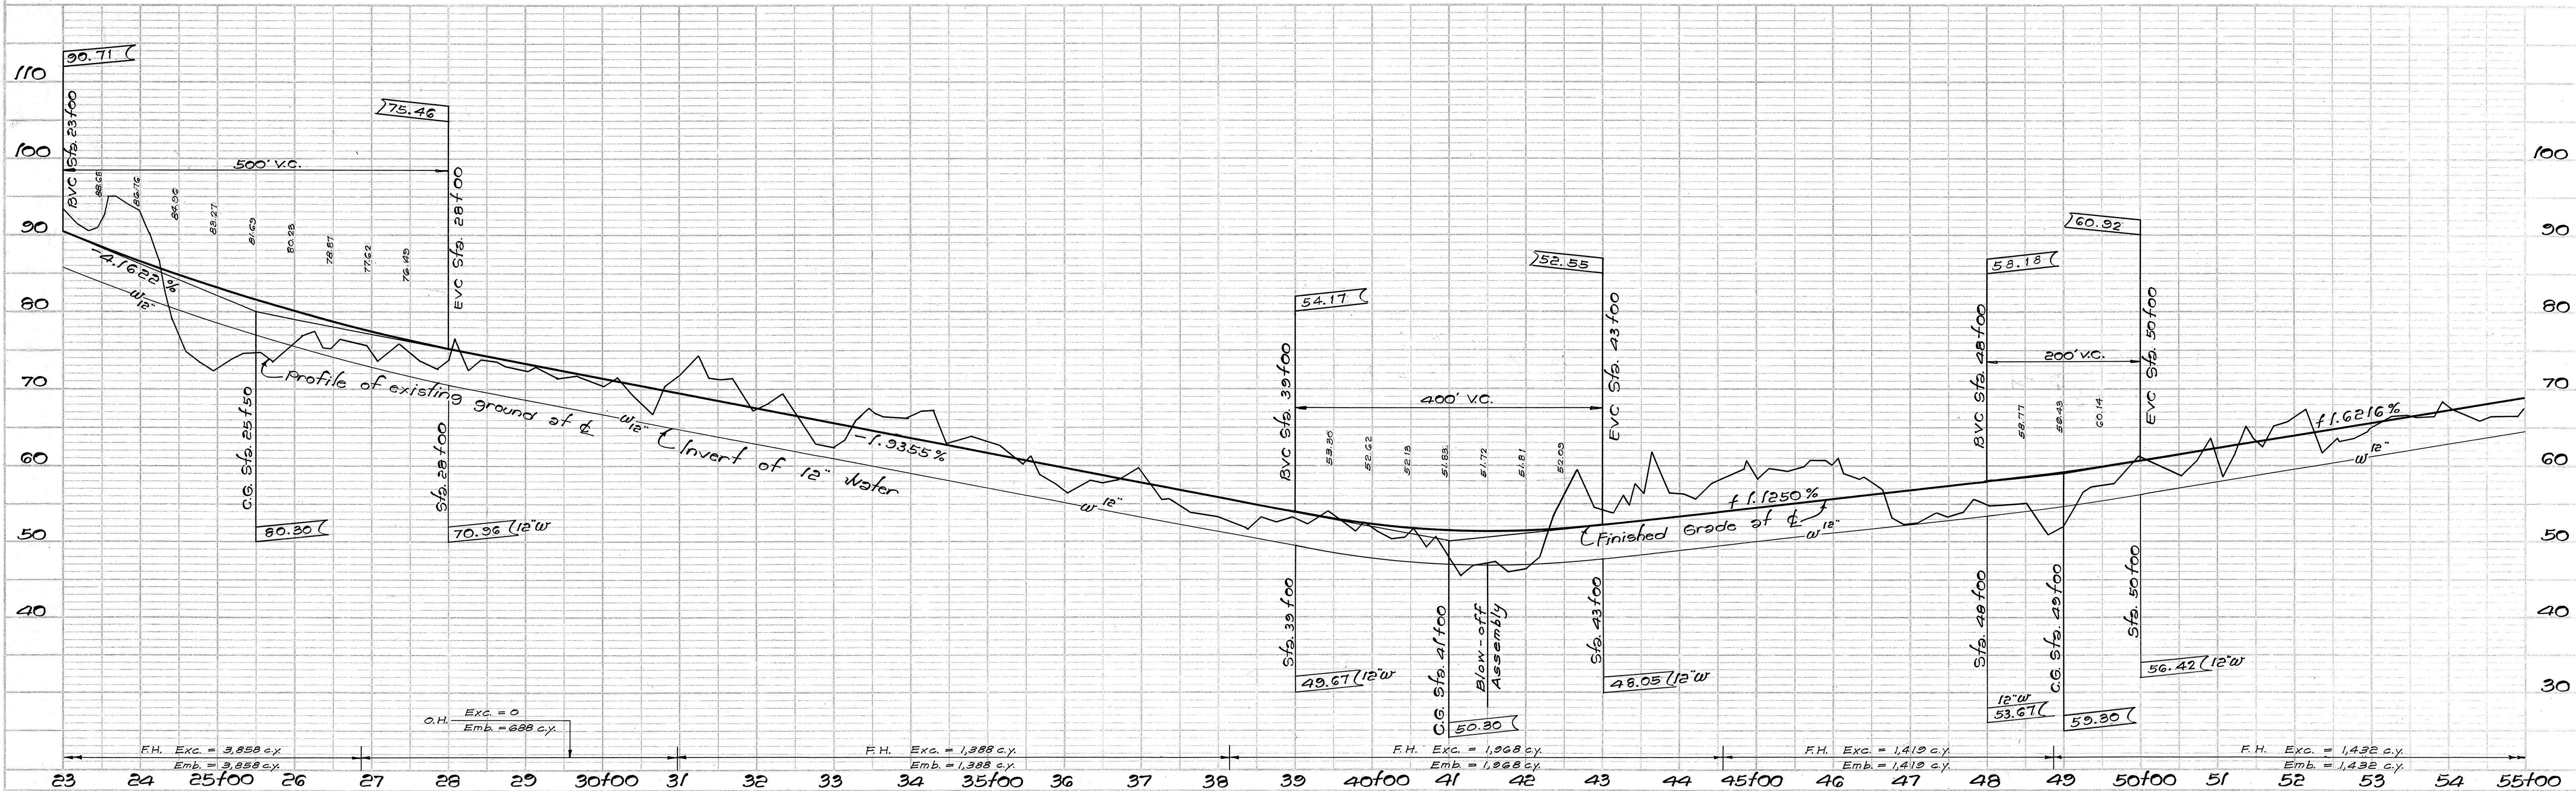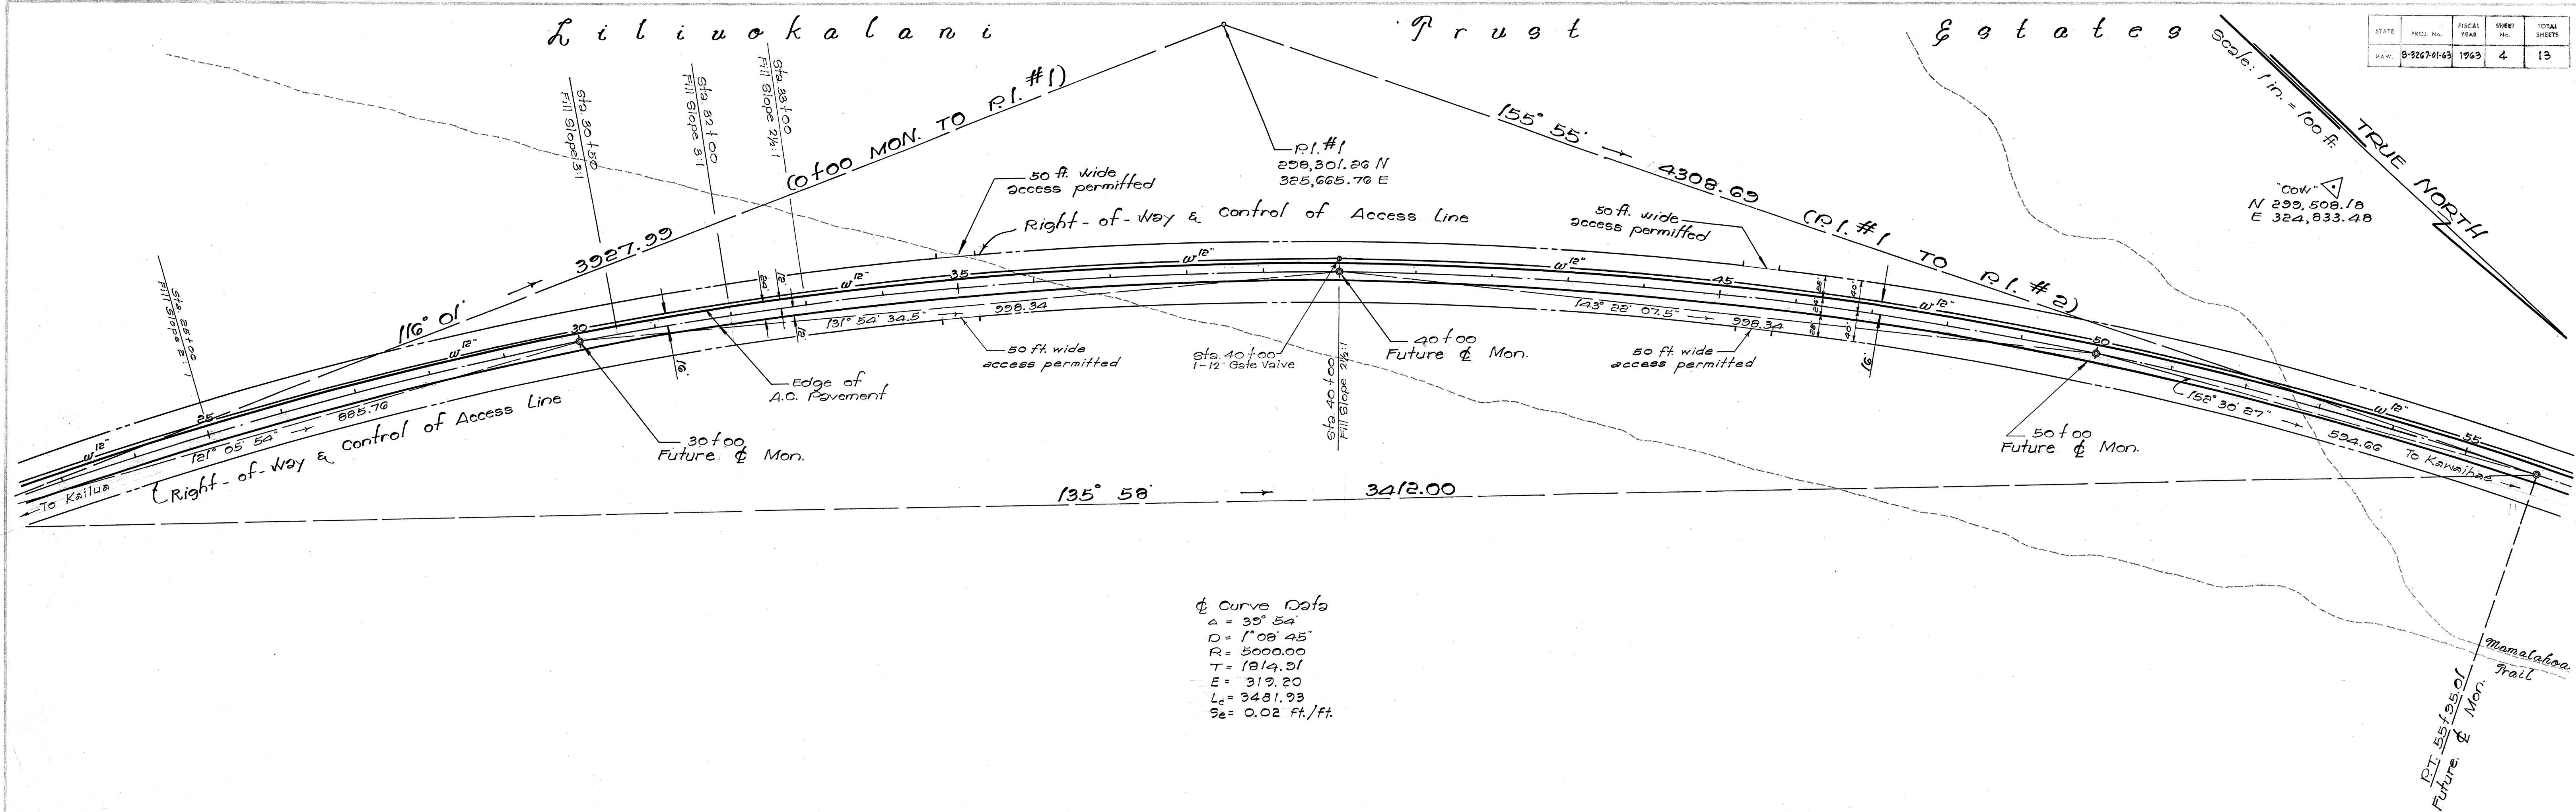

PLAN	SURVEYED	DATE
NO.		
NOTE BOOK		
ALIGNED CHECKED		
RT. OF WAY CHECKED		

PROFILE	SURVEYED	DATE
NO.		
NOTE BOOK		
GRADES CHECKED		
STRUCTURE NOTATIONS CHECKED		

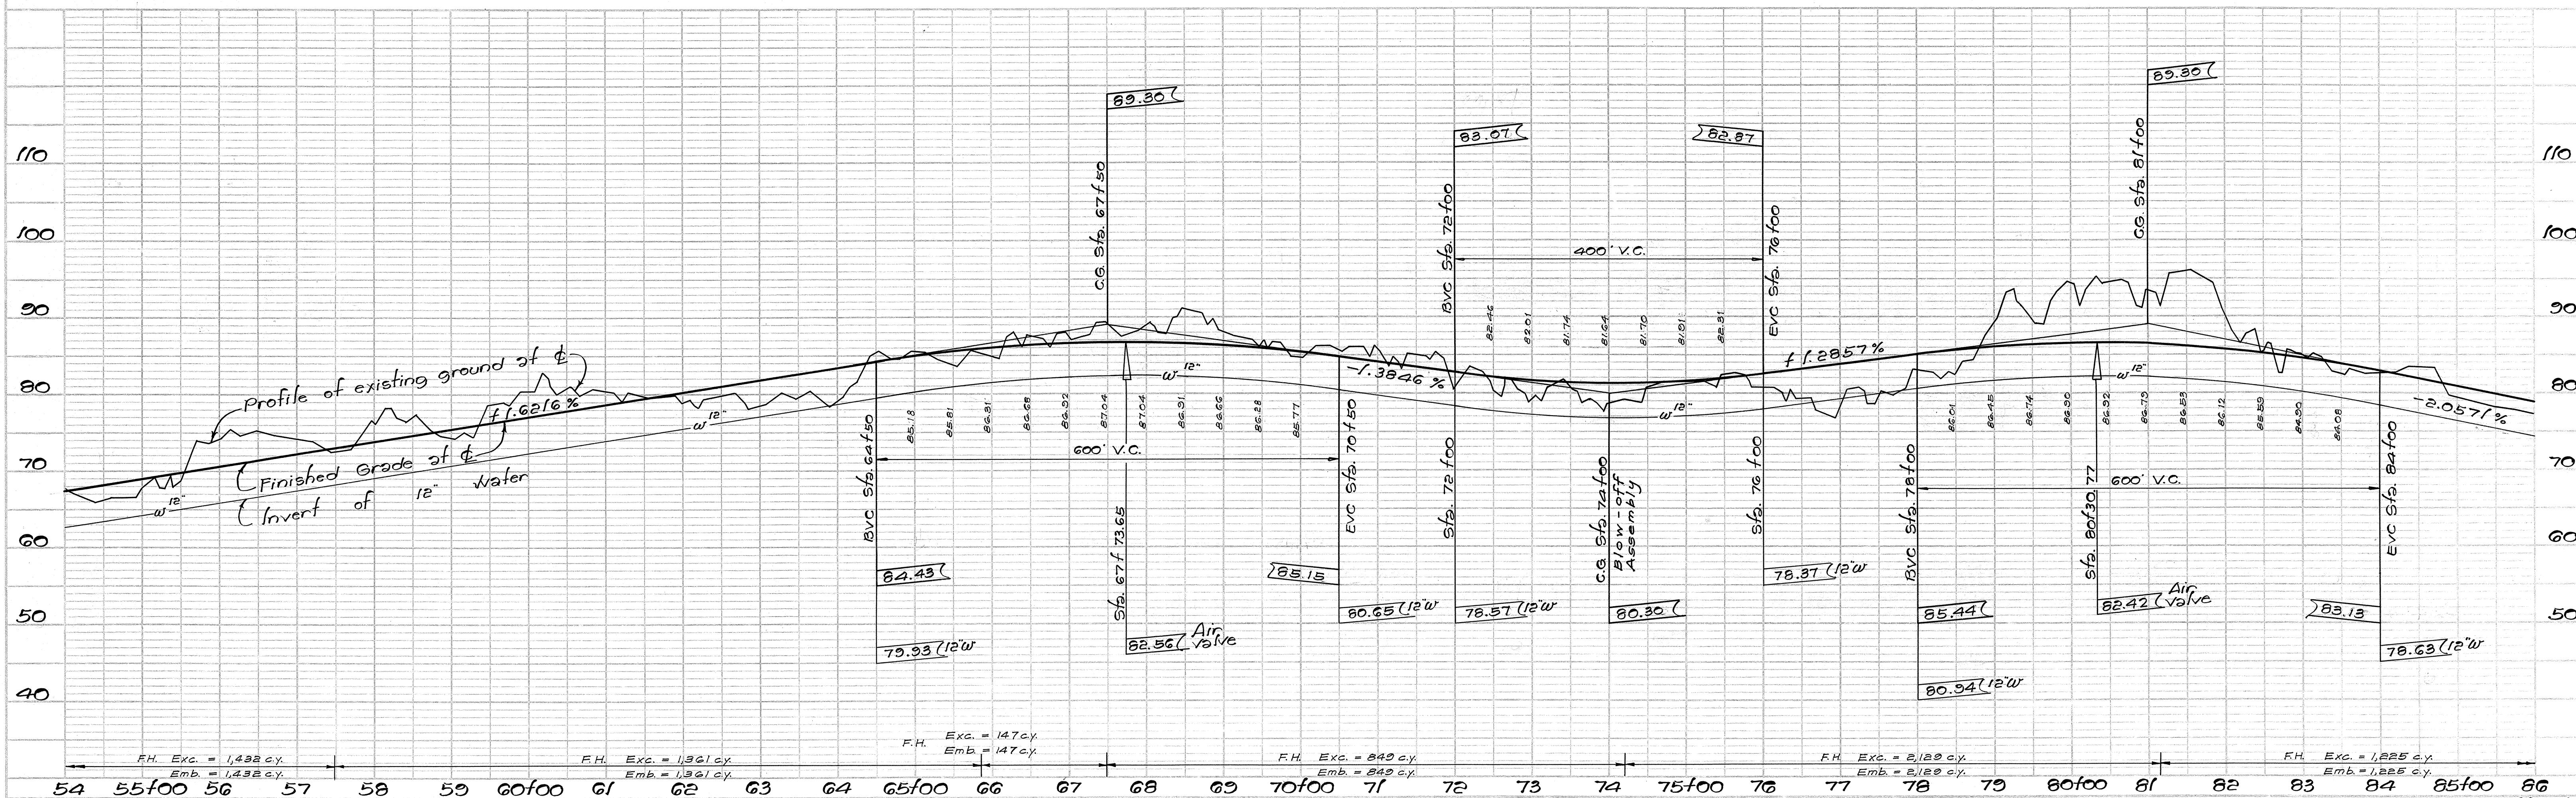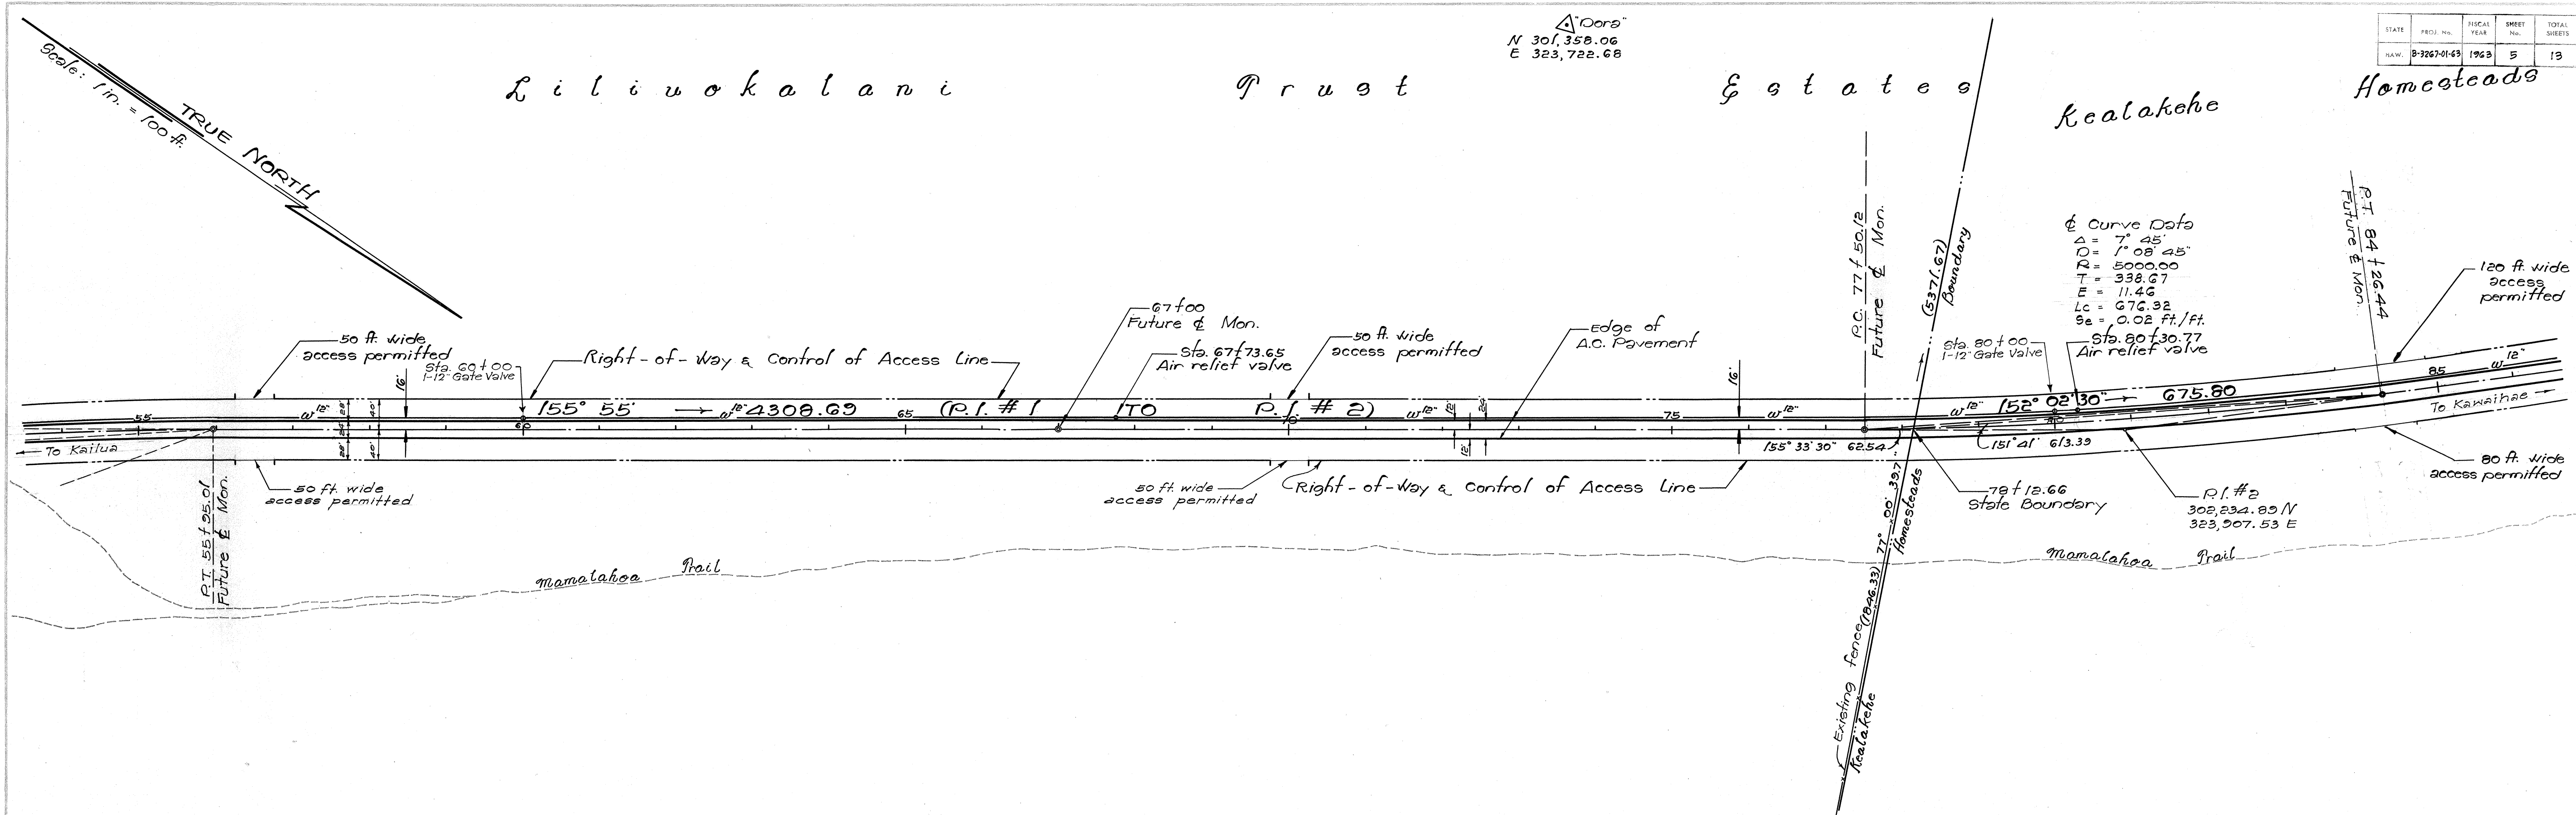


K e a l a k e h e

H o m e g t e a d g

"Jean" Δ
N 304,835.92
E 321,710.93
N 304,880.08
E 321,730.05

STATE	PROJ. NO.	FISCAL YEAR	SHEET NO.	TOTAL SHEETS
HAW.	8-3267-01-63	1963	6	13

PLAN	SURVEYED	DATE
NOTE BOOK ALIGNED CHECKED		
RT. OF WAY CHECKED		
NO.		

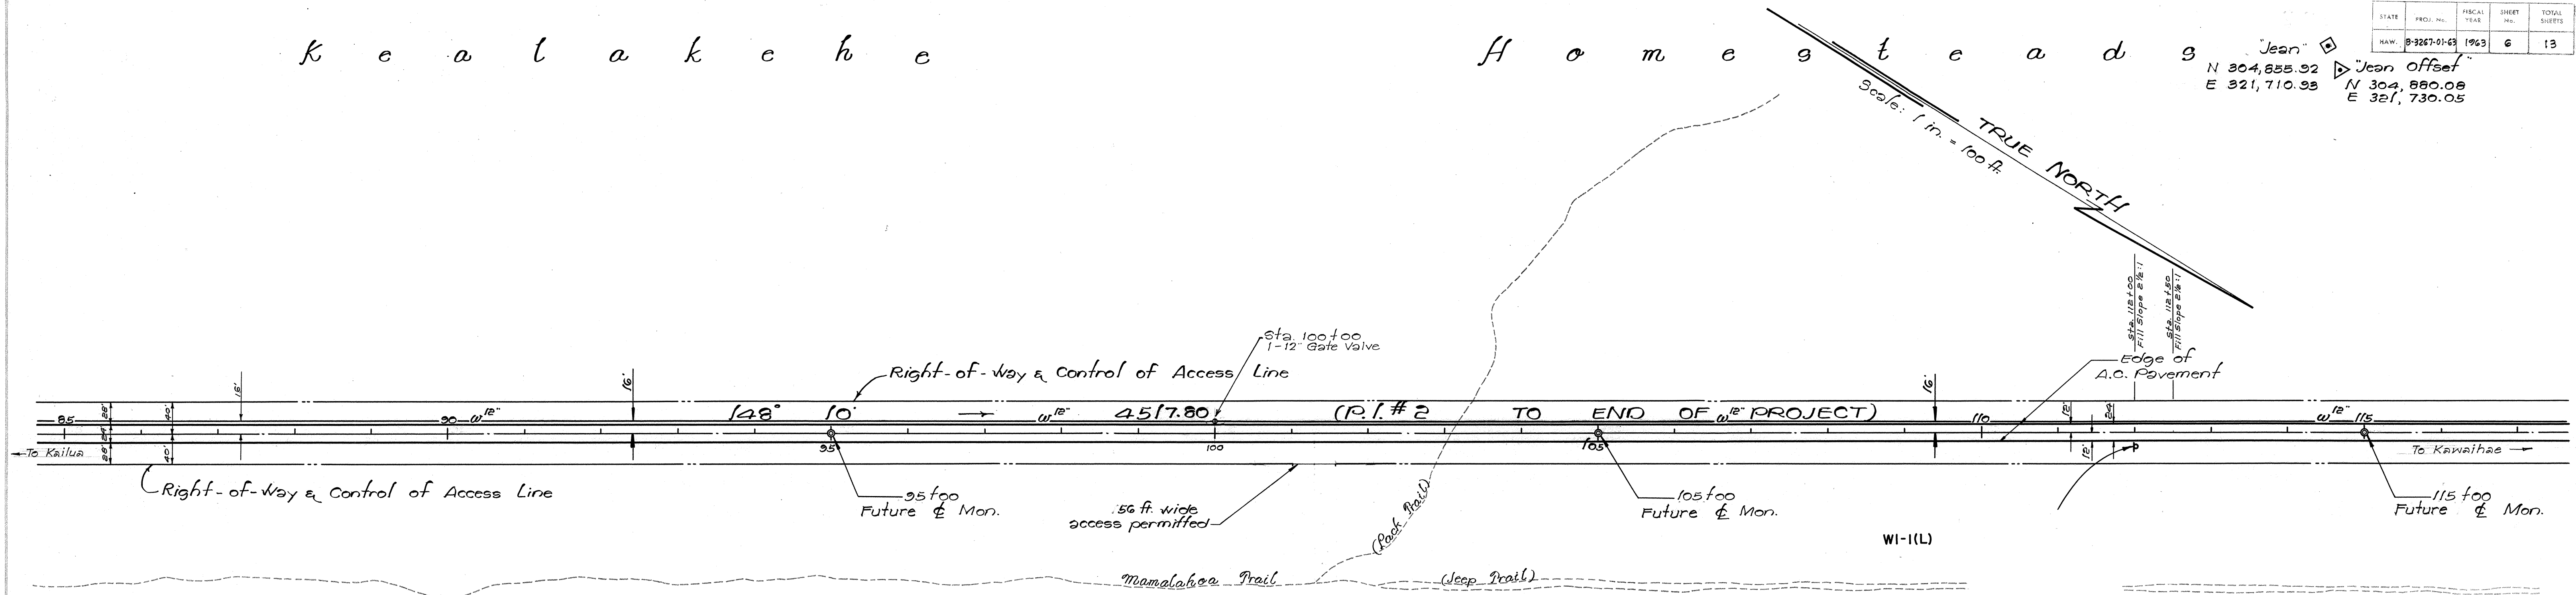


PROFILE	SURVEYED	DATE
NOTE BOOK GRADES CHECKED		
STRUCTURE NOTATION CHKD.		
NO.		



PLATE 1 - PLAN-PROFILE OF P. R. & D. E. STANDARD
HUFFEL & EISEN CO., NEW YORK

PLAN	DATE	BY
SURVEYED		
DESIGNED		
NOTED		
NO.		

PROFILE	DATE	BY
SURVEYED		
DESIGNED		
NOTED		
NO.		

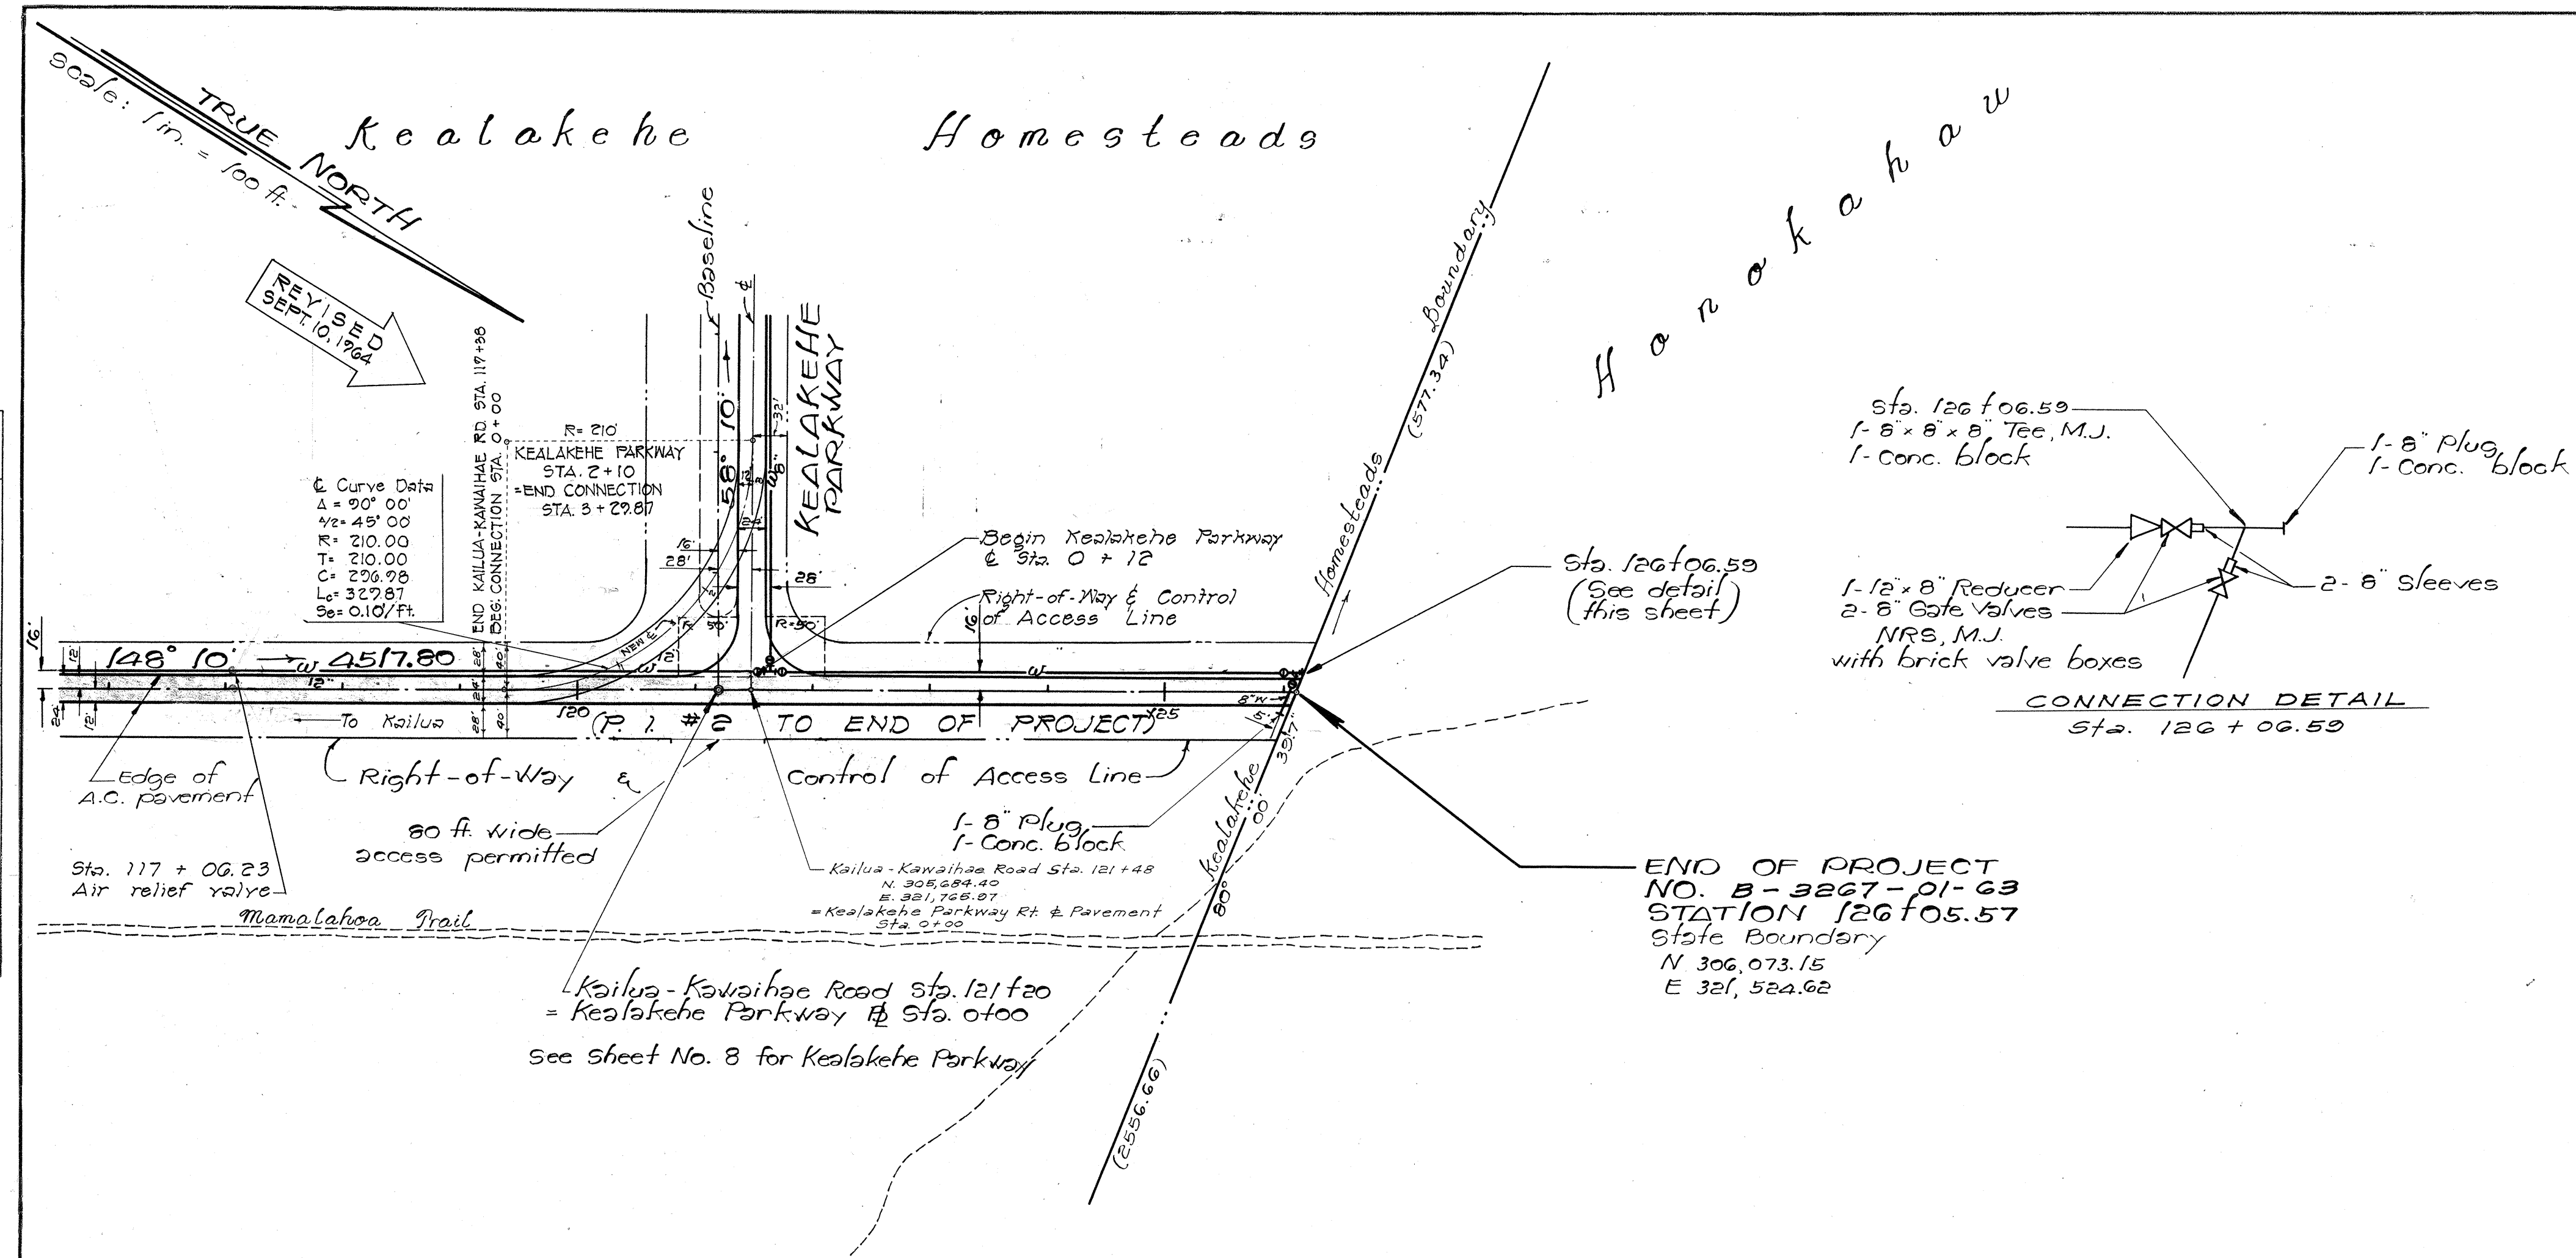

POINTS OF ACCESS		
STATION	WIDTH OF ACCESS	
	LEFT	RIGHT
9 + 50	50	50
21 + 50	50	50
35 + 00	50	50
45 + 50	50	50
56 + 50	50	50
70 + 00	50	50
84 + 26.44	120	80
101 + 50	—	56
121 + 20	—	80



PLAN	DATE	BY
SURVEYED		
NOTED		
ALIGNED		
CHECKED		
RT. OF WAY		
NO.		

PROFILE	DATE	BY
SURVEYED		
NOTED		
GRADES		
CHECKED		
STRUCTURE NOTATIONS		
NO.		

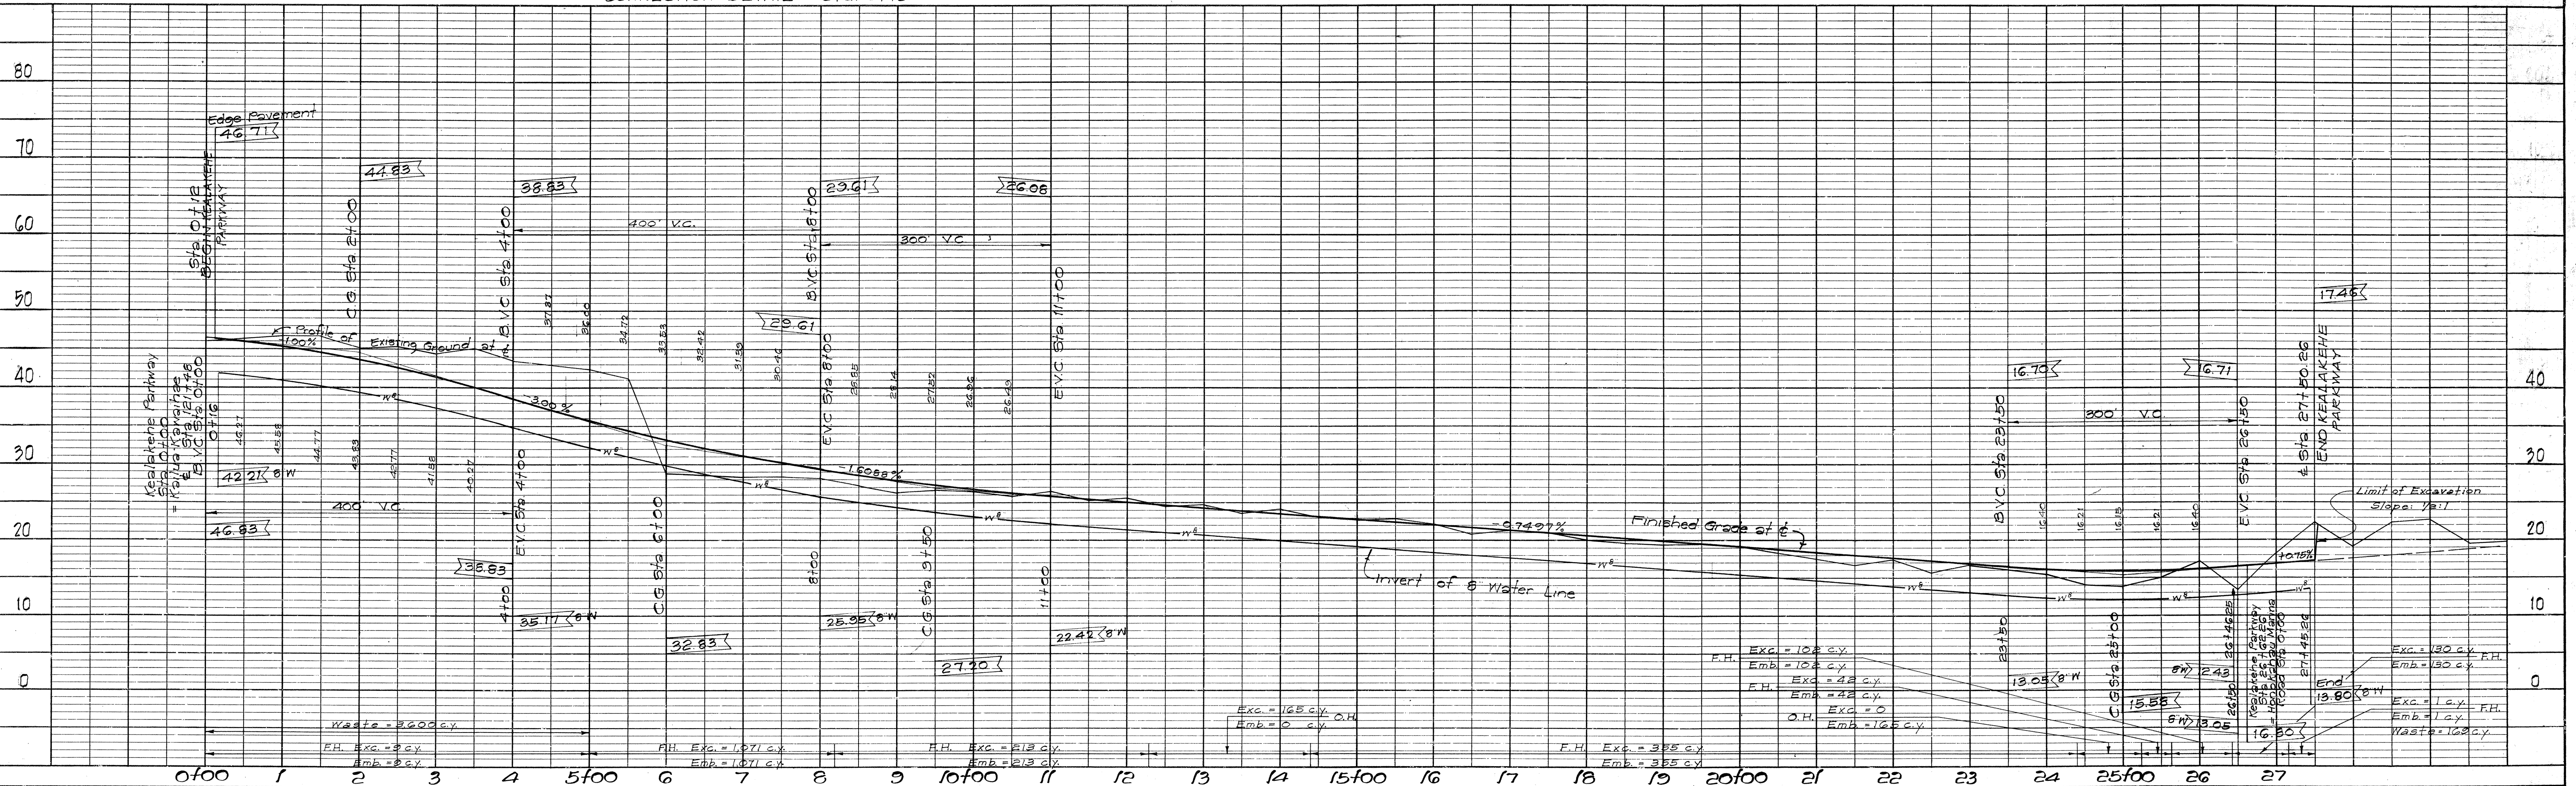
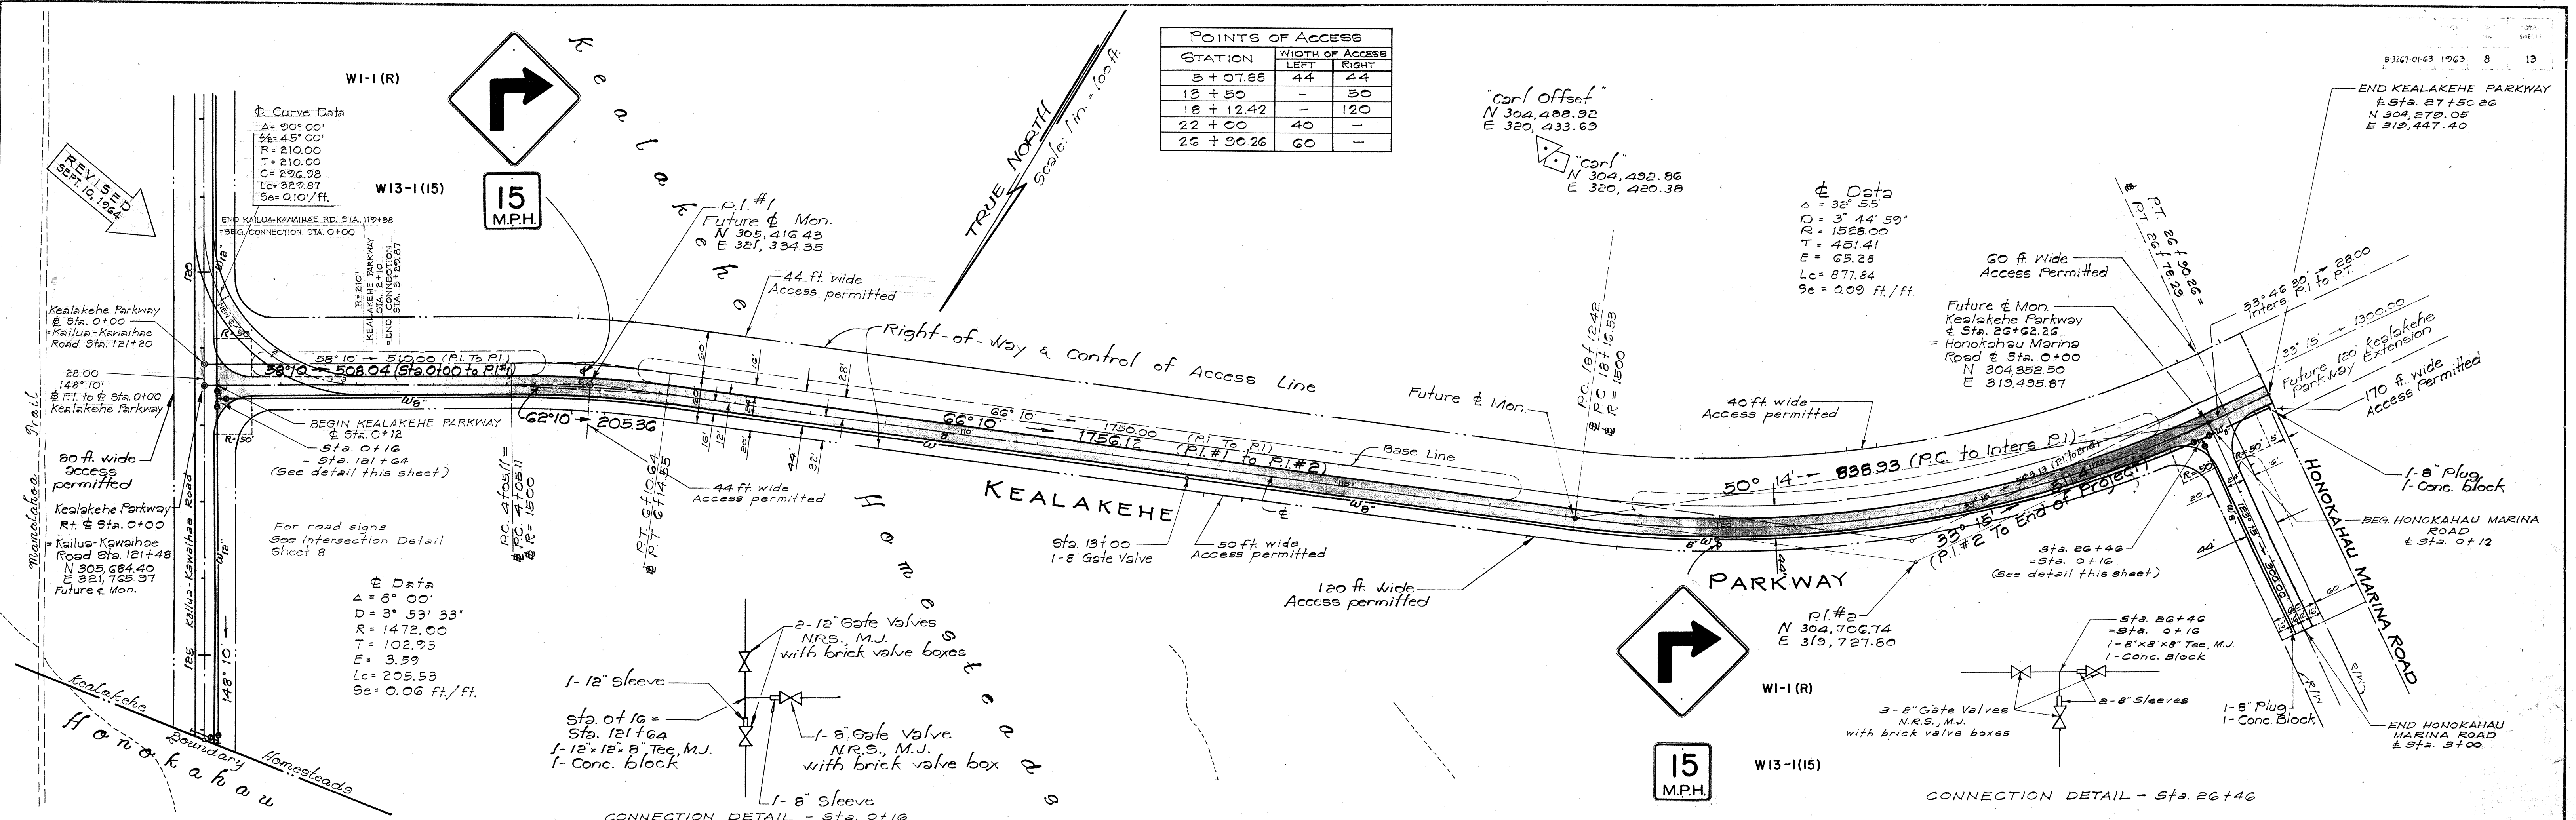


PLATE 1-PLAN-PROFILE O. P. R. & R. E. STANDARD
 KEUFFEL & ESSER CO., NEW YORK.

(REVISED)