
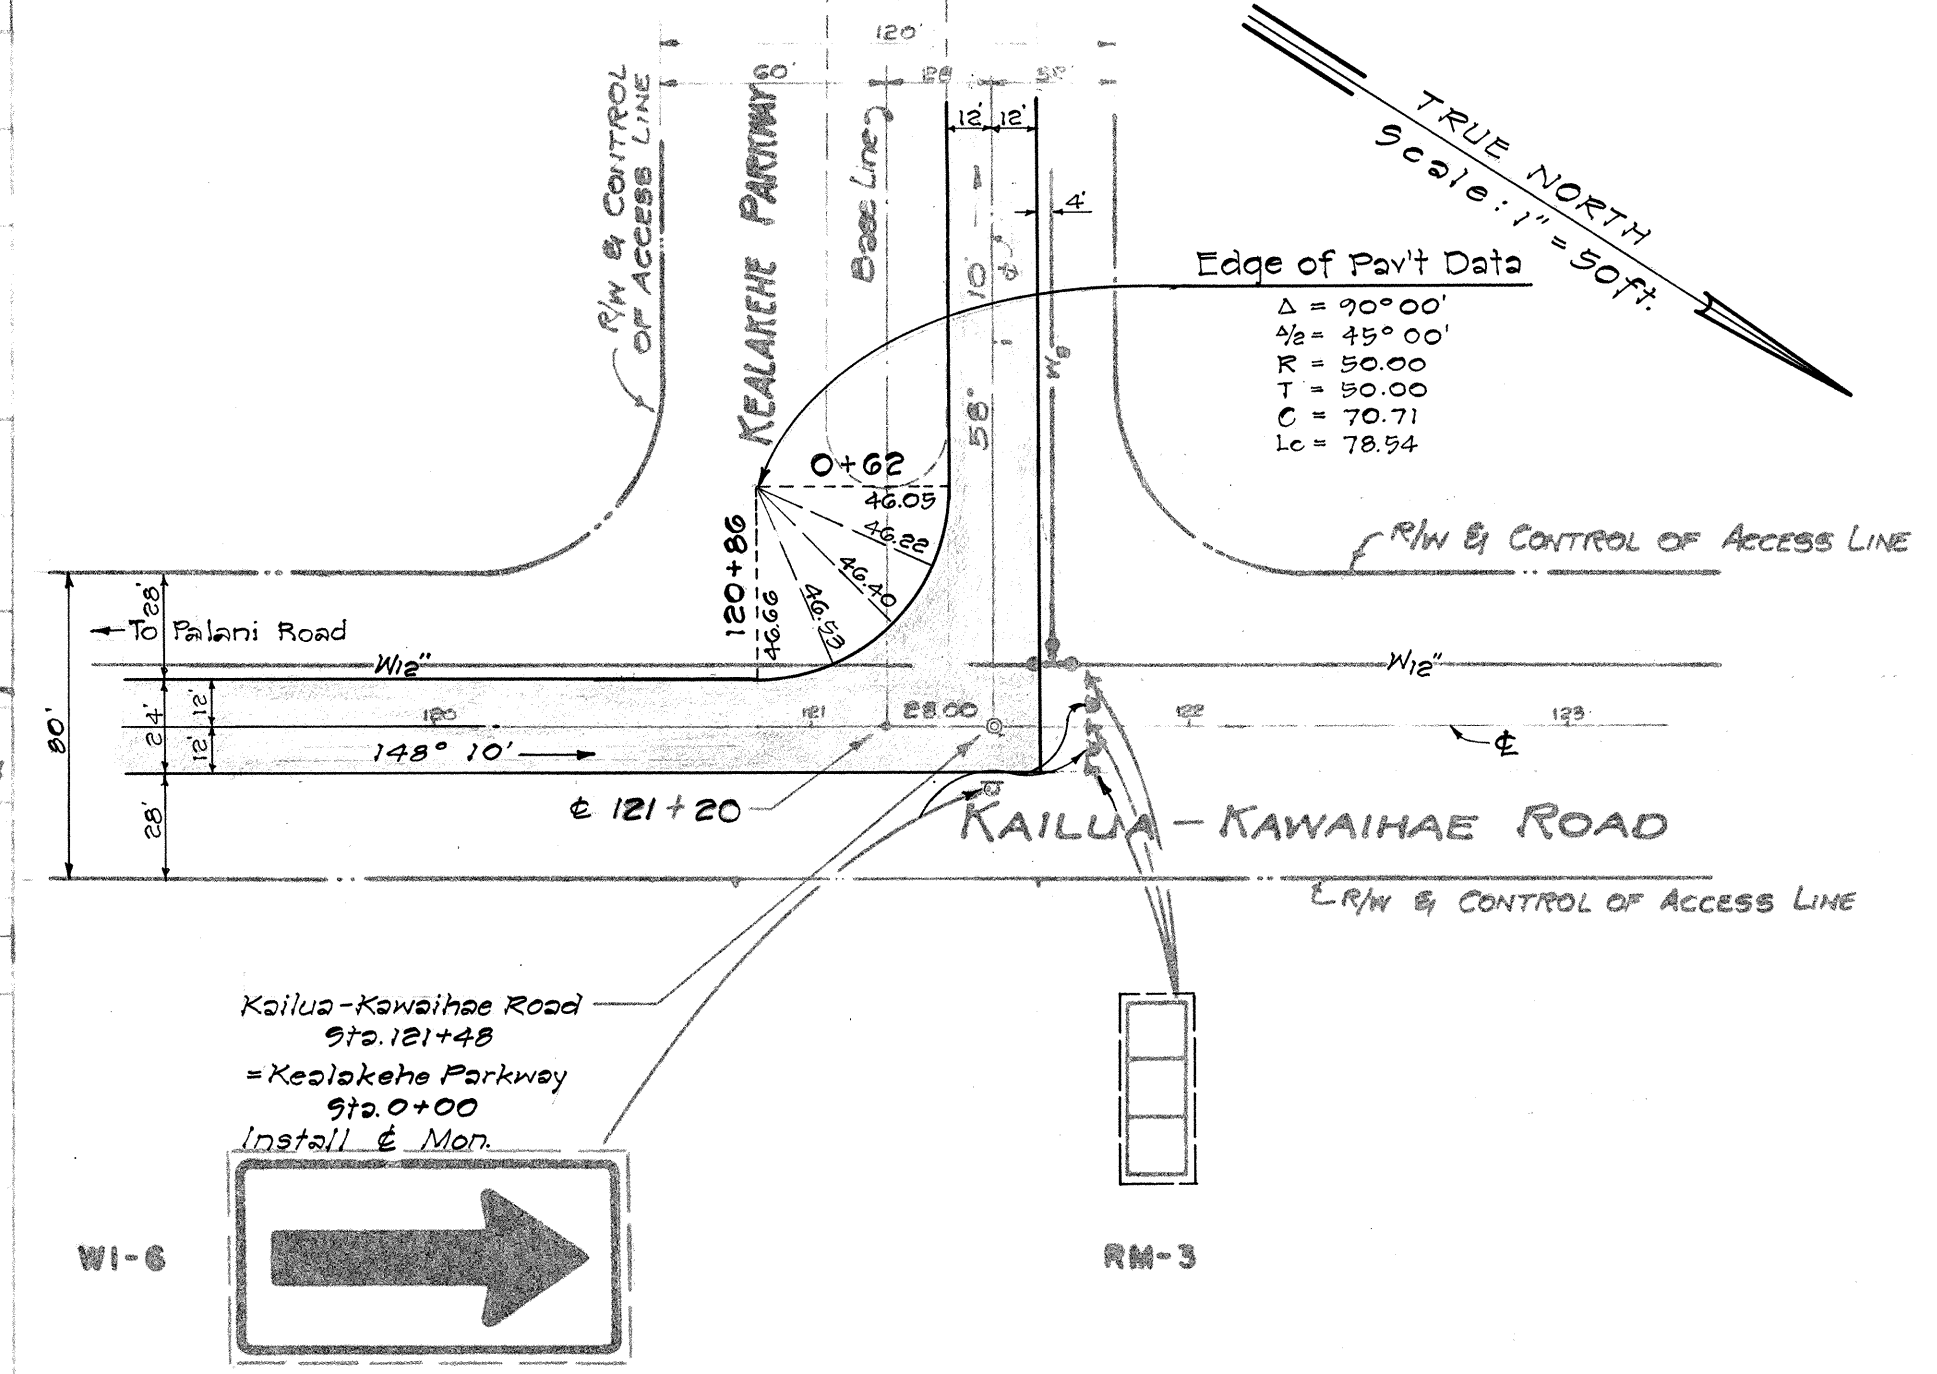
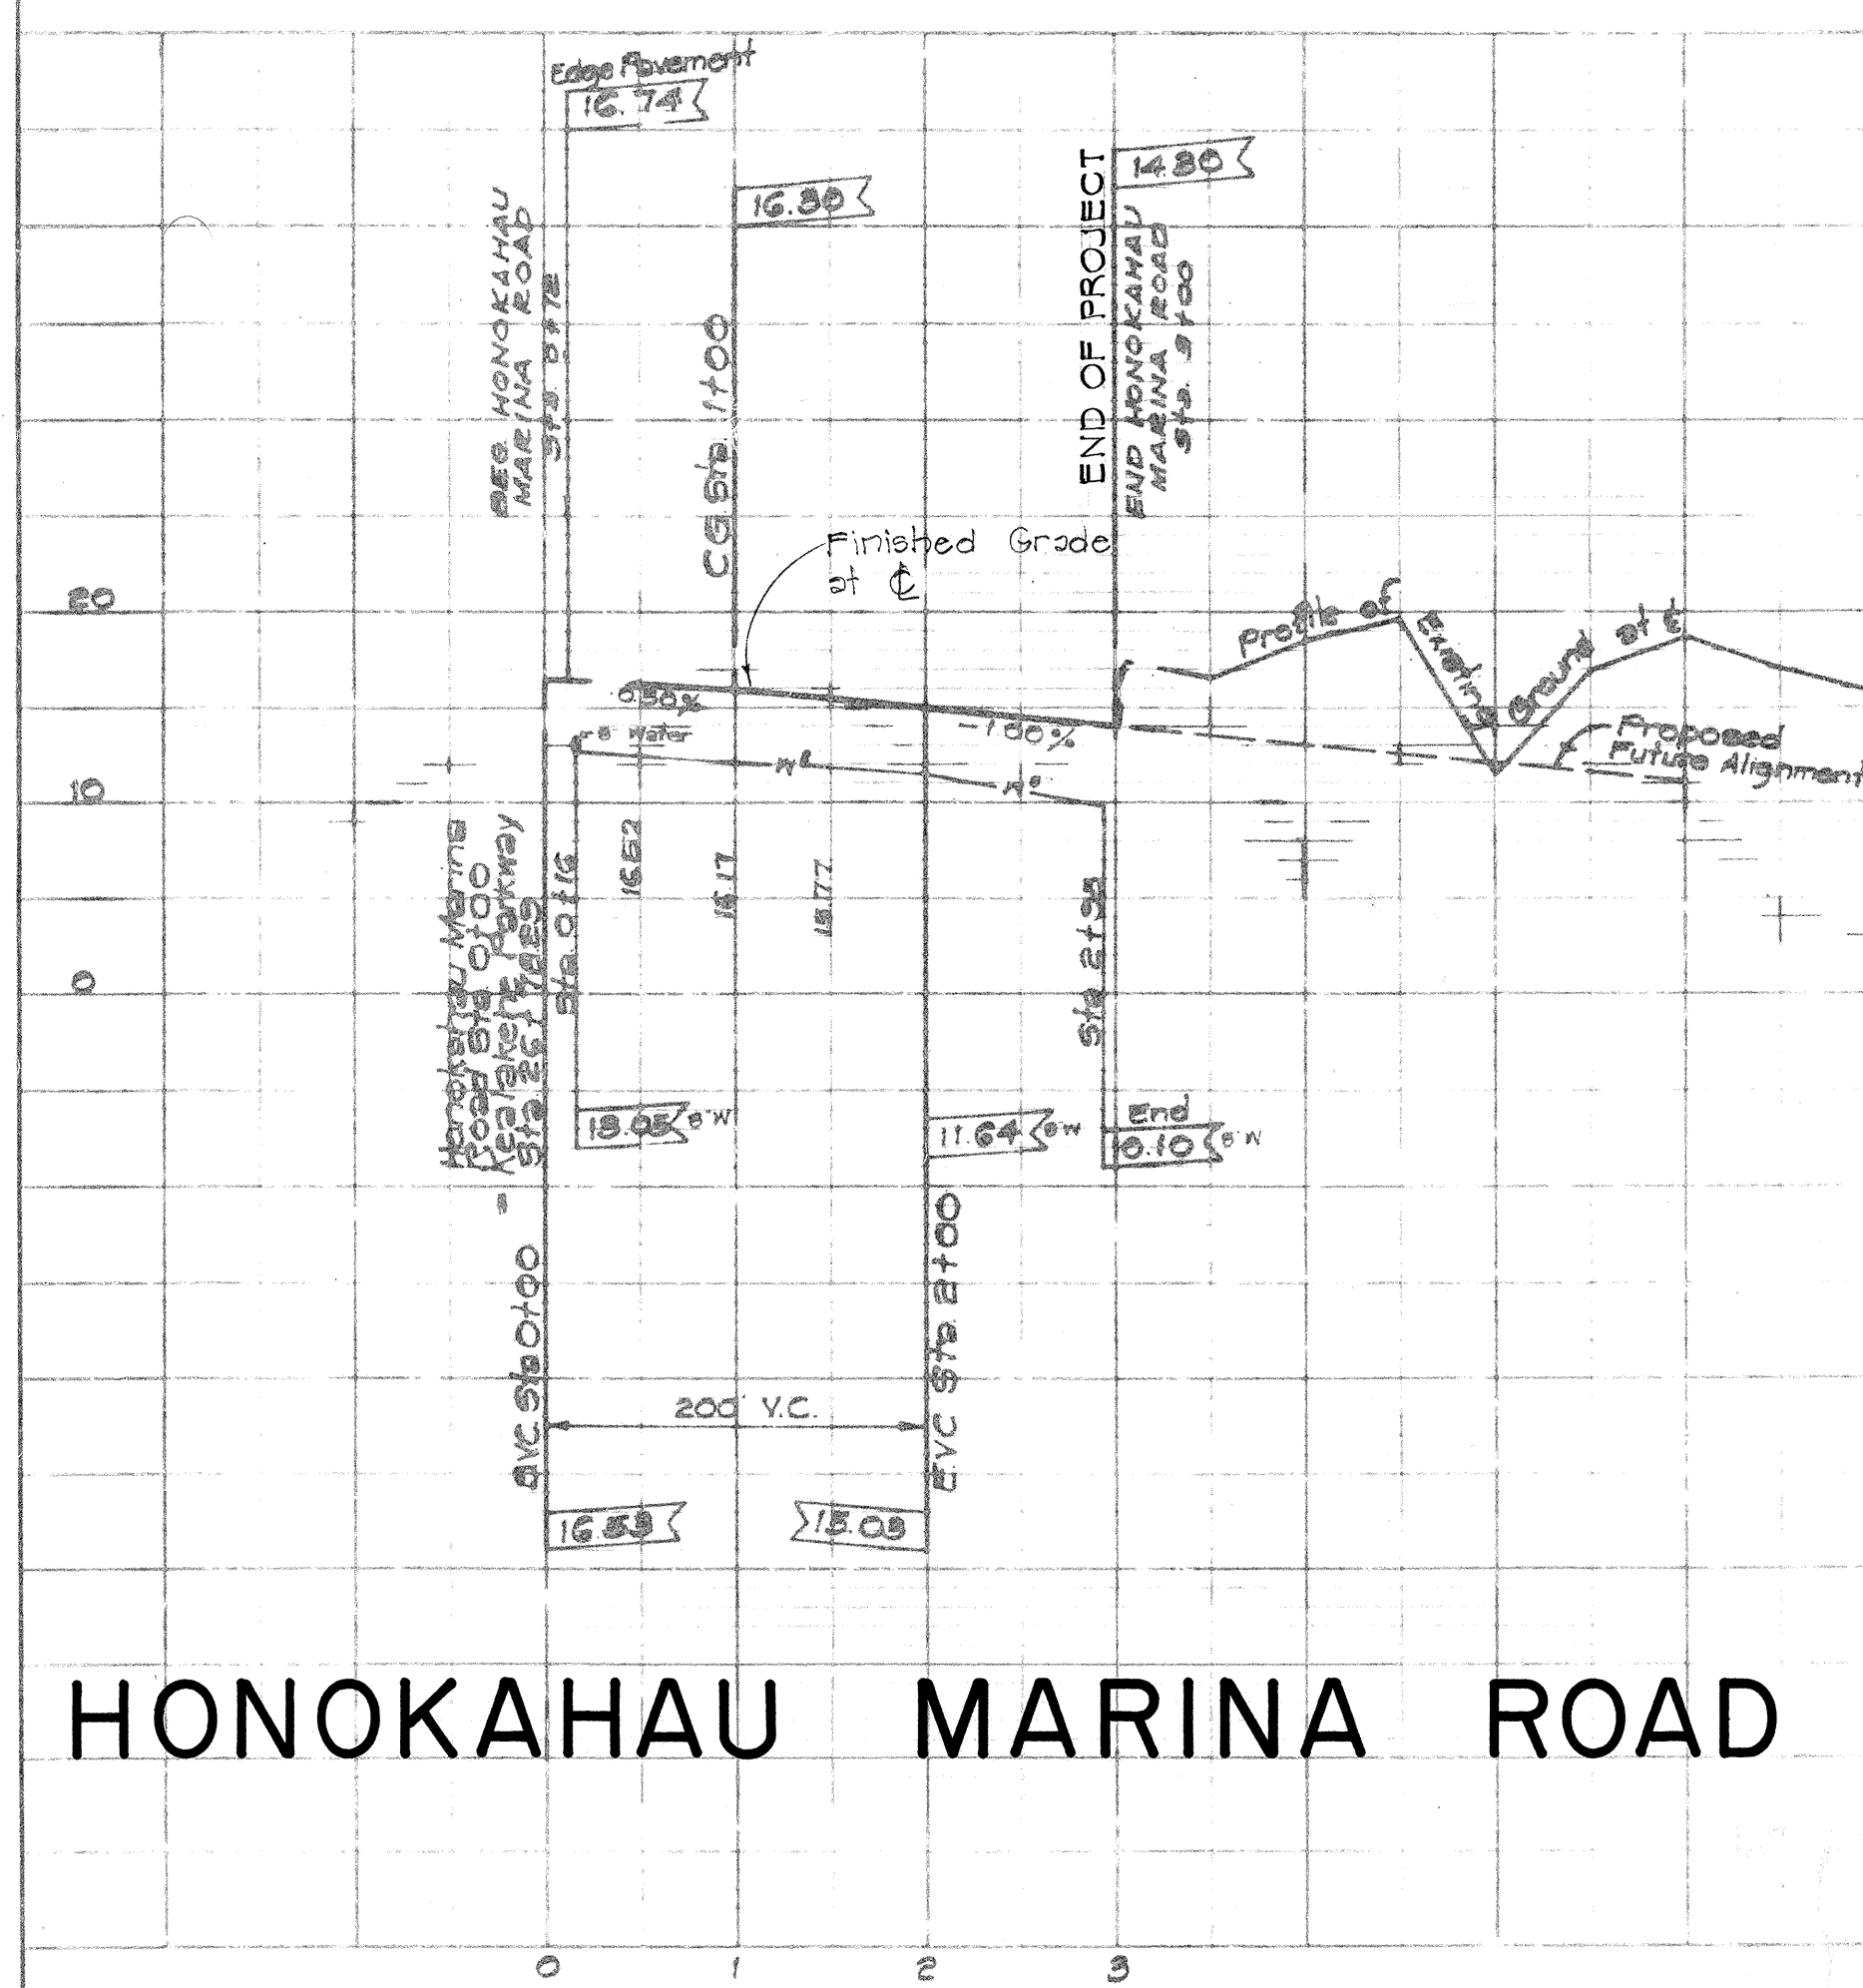
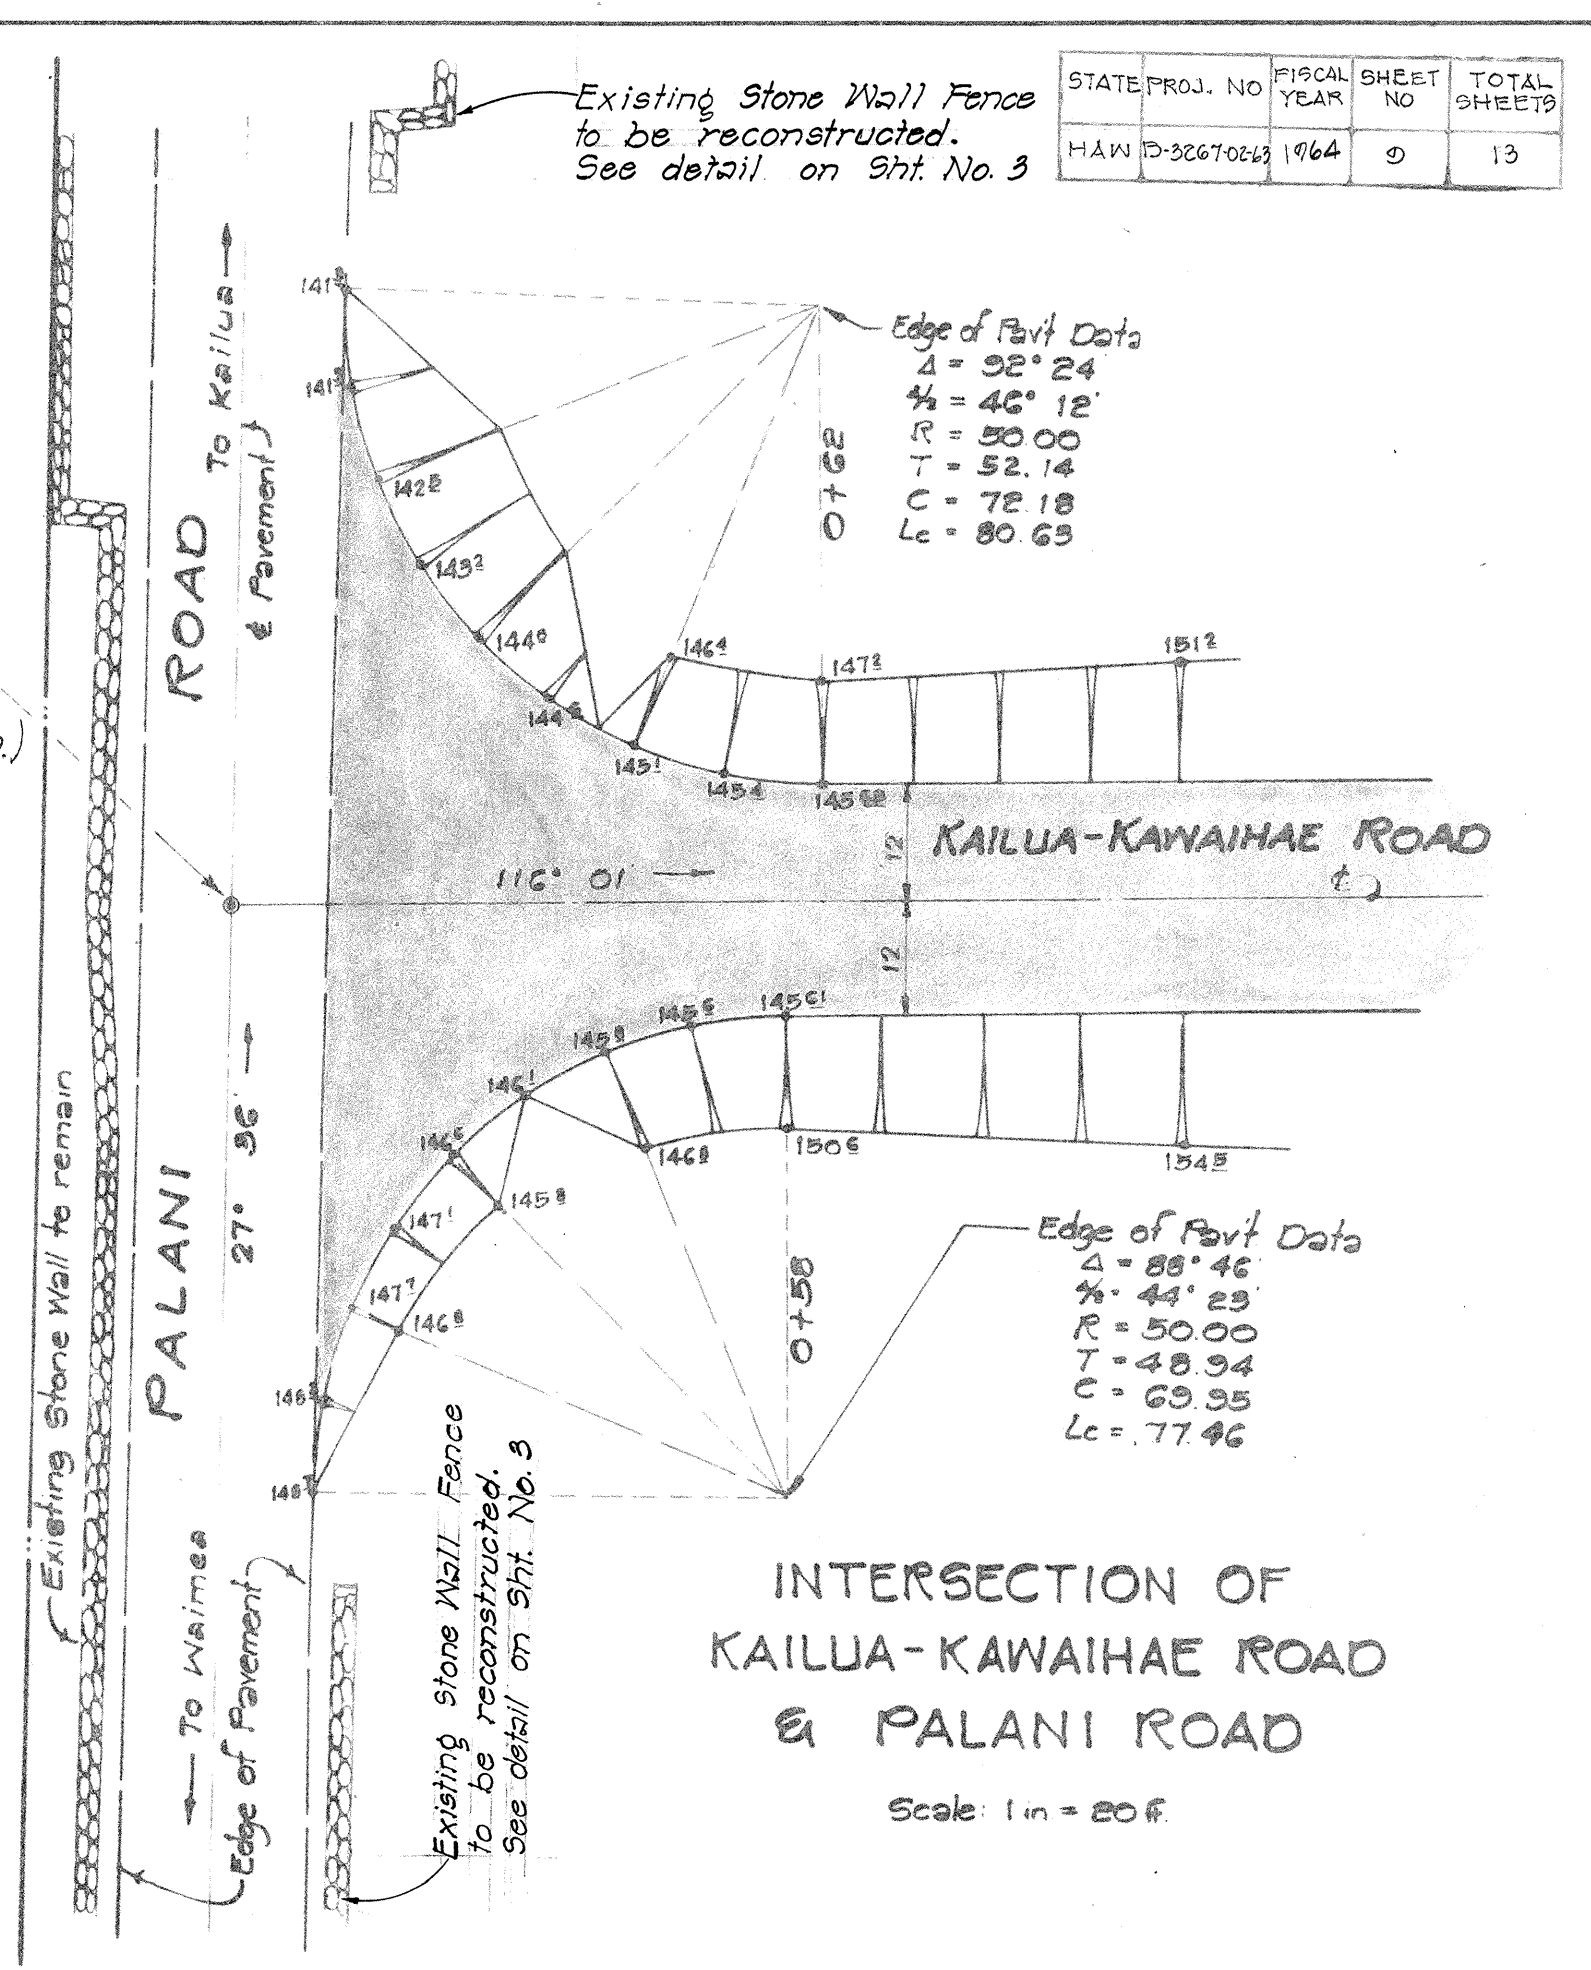
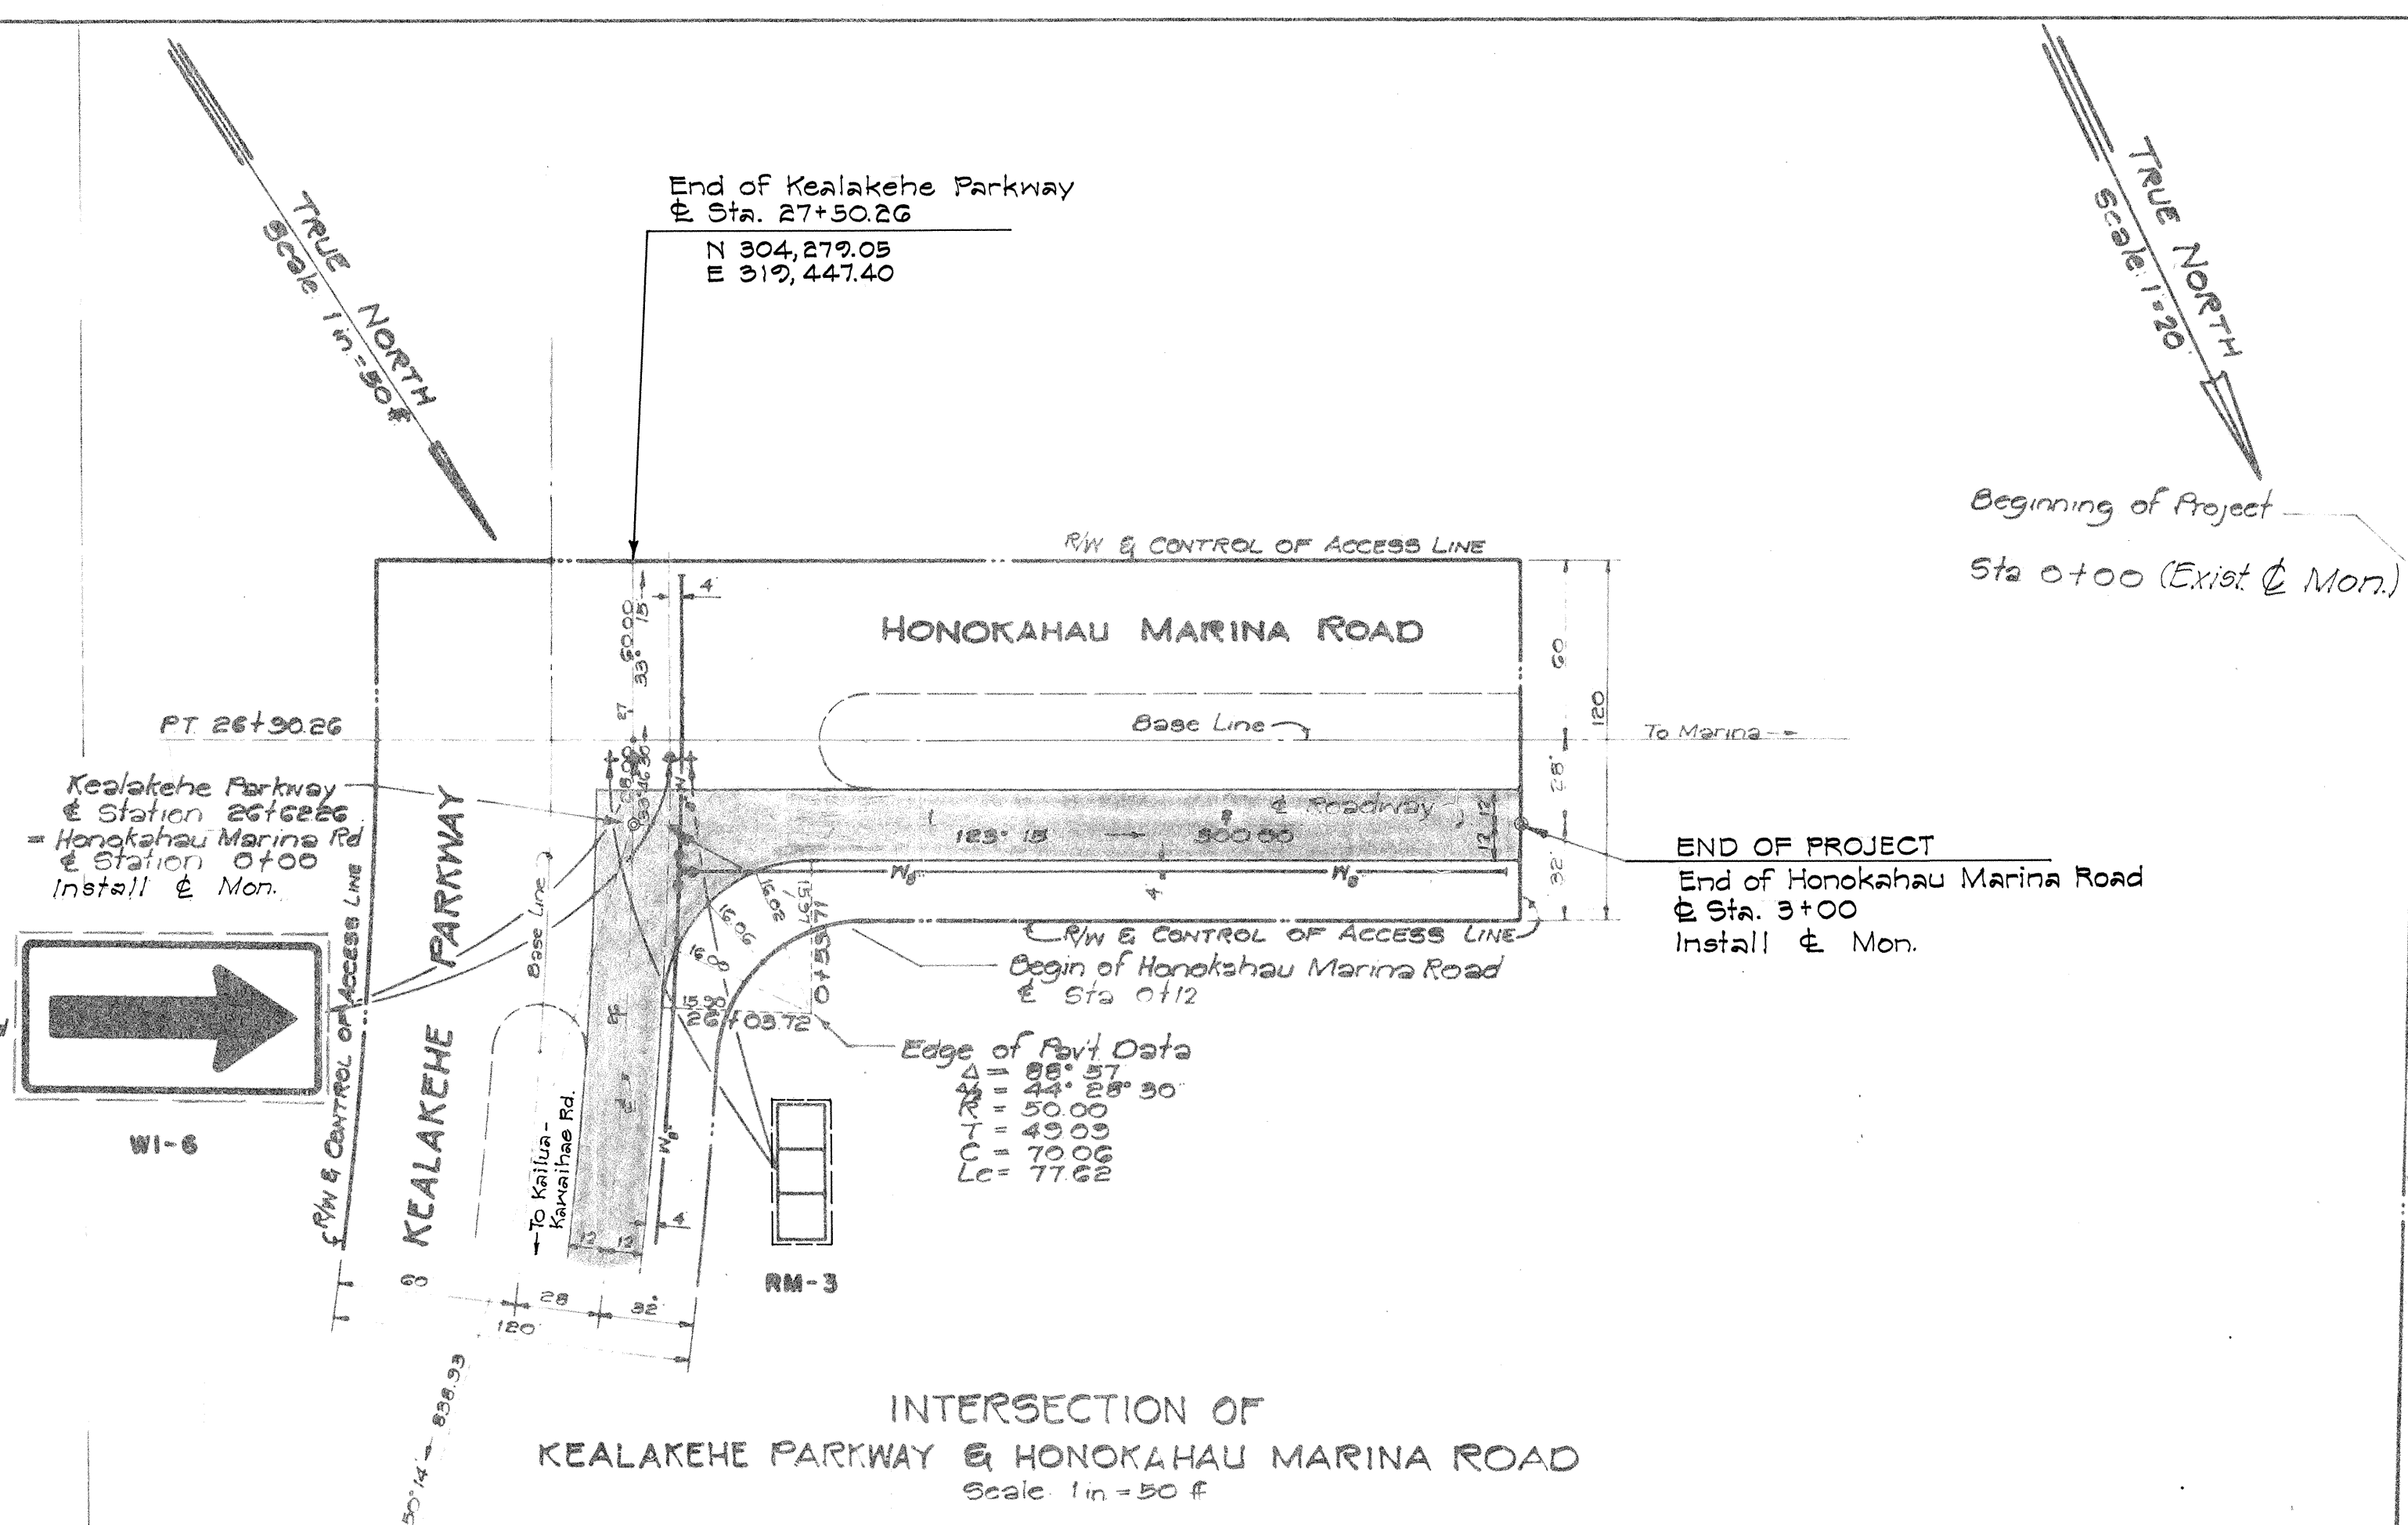


STATE PROJ. NO.	FISCAL YEAR	SHEET NO.	TOTAL SHEETS
HAW 10-3067063	1964	9	13

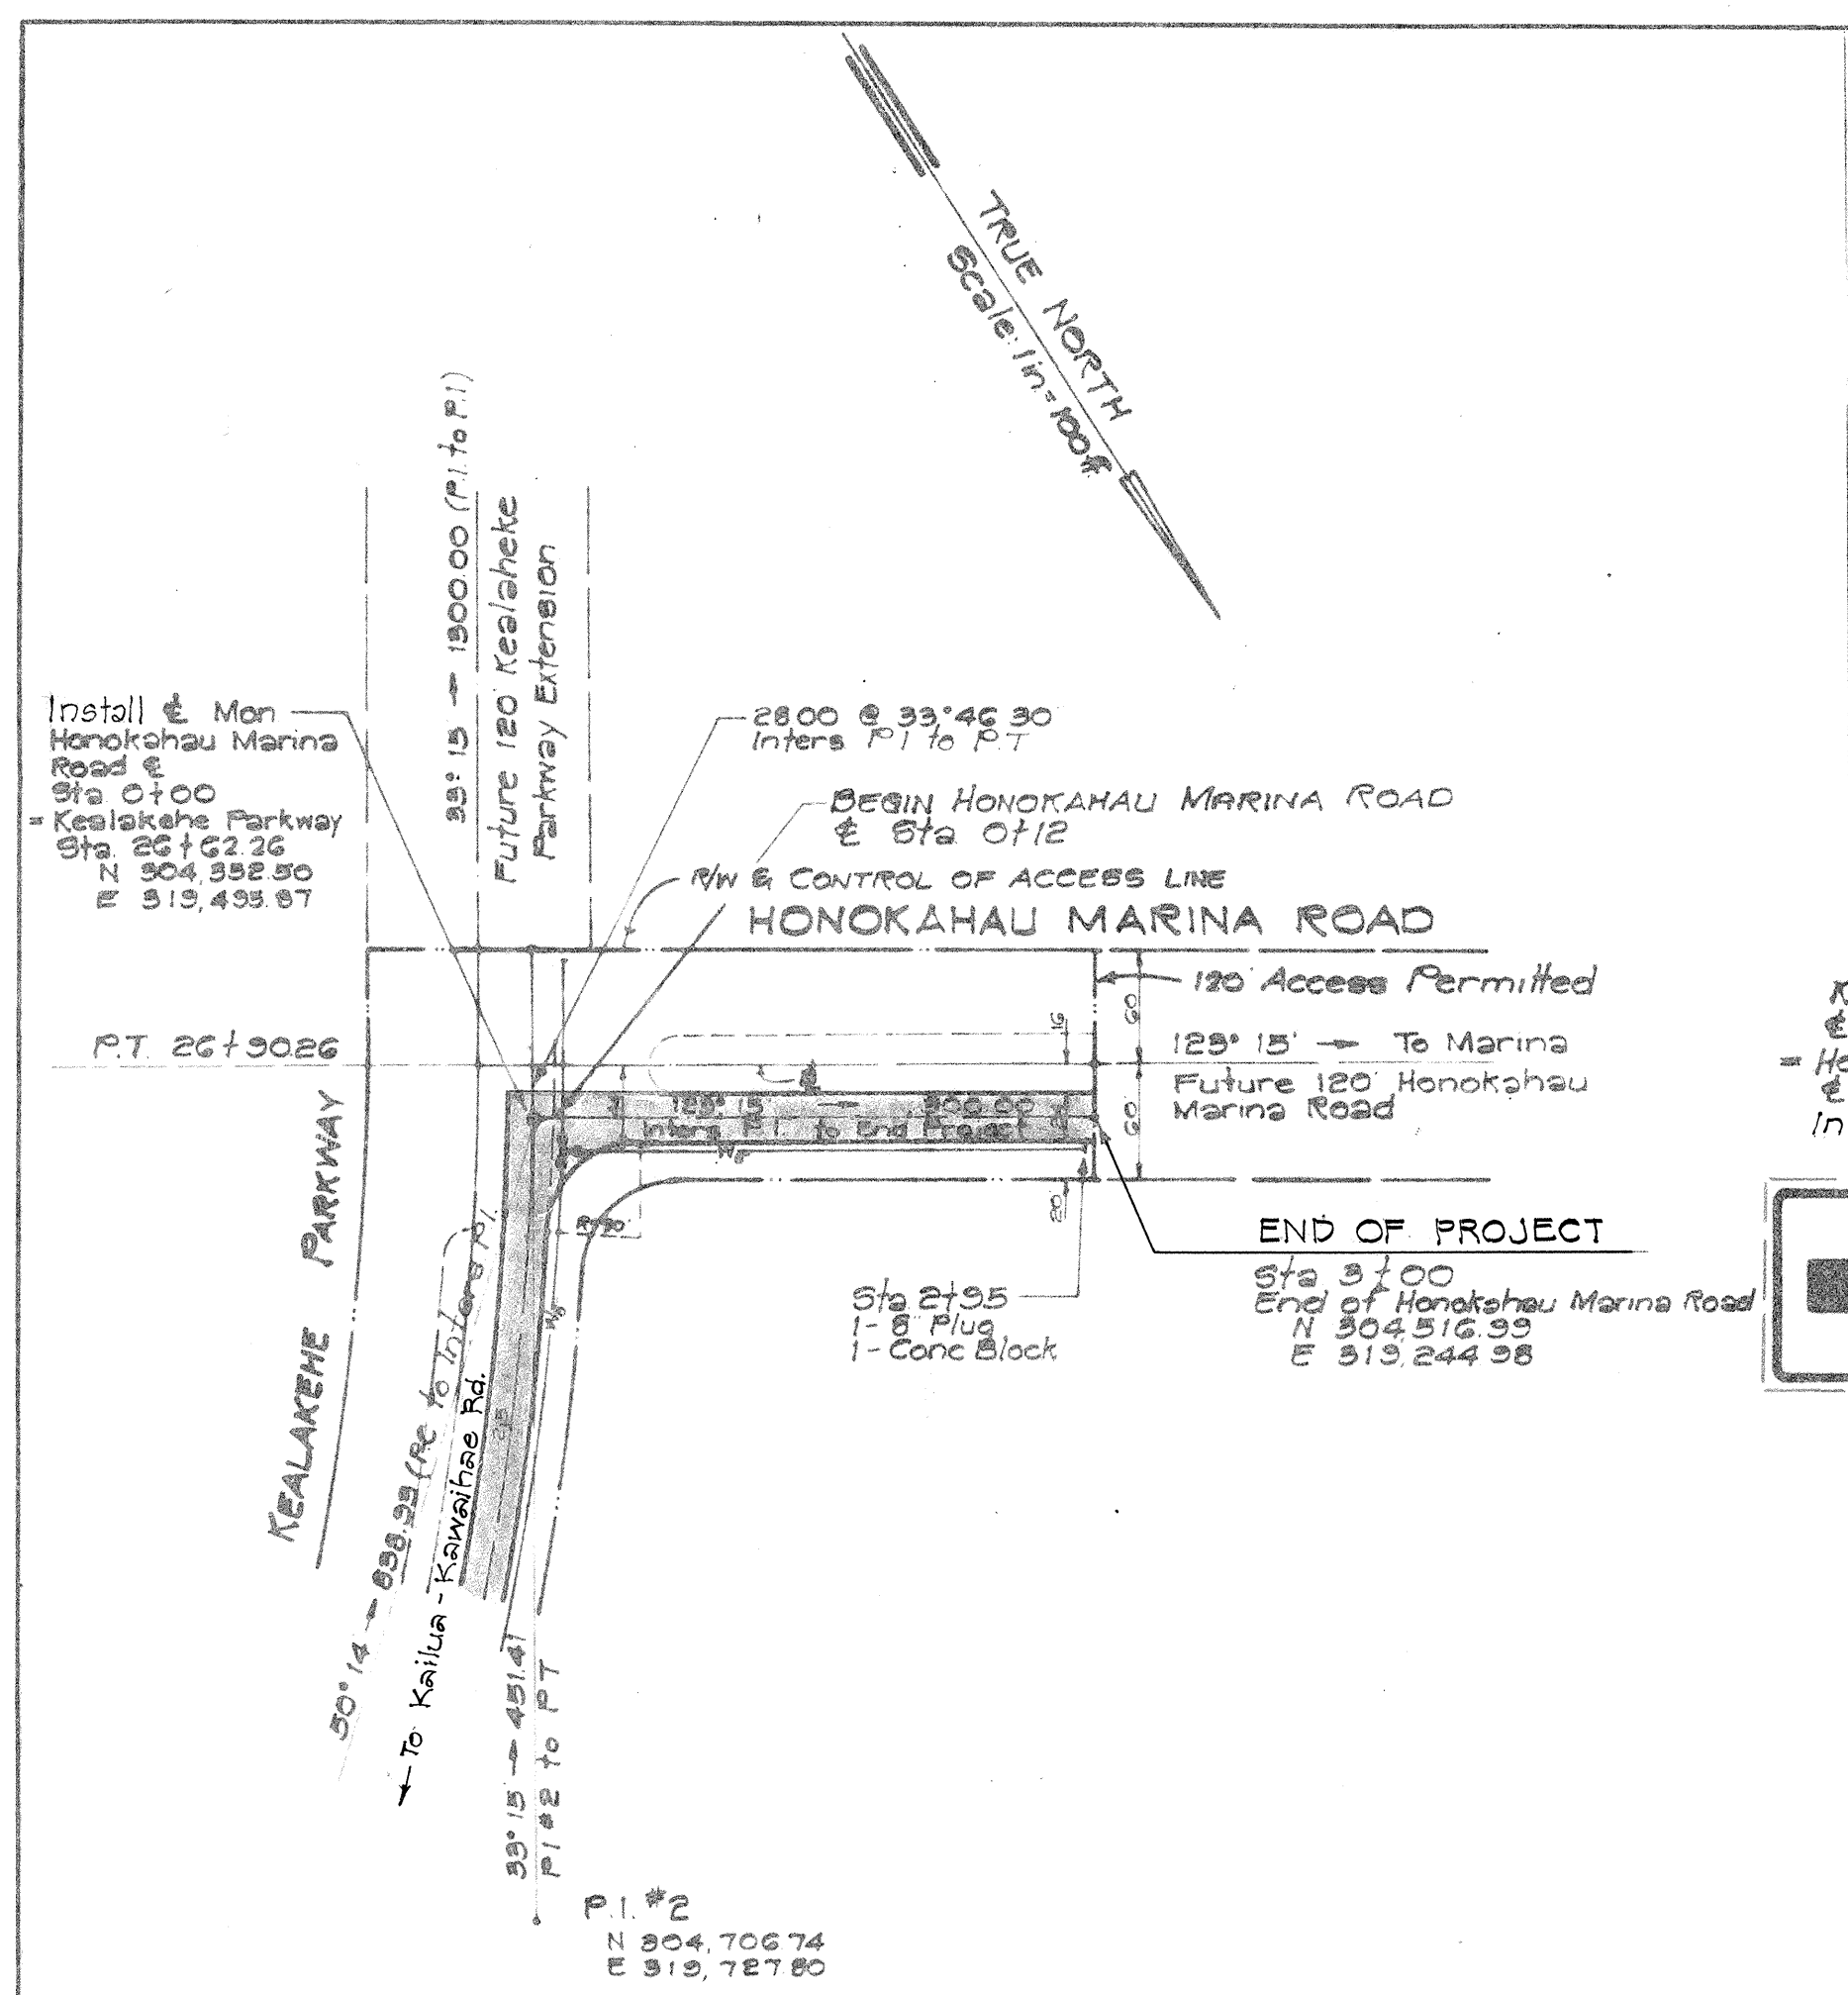

CONNECTION DETAIL
CONNECTION BETWEEN KAILUA-KAWAIIHAE ROAD AND KEALAKEHE PARKWAY
Scale: 1" = 50 ft.

HONOKAHAU MARINA ROAD

STATE OF HAWAII
DEPARTMENT OF TRANSPORTATION
HIGHWAYS DIVISION

INTERSECTION DETAILS

KAILUA-KAWAIIHAE ROAD
PROJECT No. B-3267-02-63

Scale: As noted
SHEET No. 1 OF 1 SHEETS