

INDEX TO DRAWINGS	
SHEET	DESCRIPTION
1	TITLE SHEET
2	TYPICAL SECTIONS
3-8	PLAN AND PROFILE
9	INTERSECTION DETAILS
10	DESTINATION SIGNS
11-13	STANDARD DETAILS

STATE OF HAWAII

DEPARTMENT OF TRANSPORTATION

HIGHWAYS DIVISION

"AS BUILT" PLANS FOR THE

PAVING OF KAILUA-KAWAIHAE ROAD

SECTION 1-KAILUA TO HONOKAHAU

HAWAII PROJECT NO. B-3267-02-63

DISTRICT OF NORTH KONA

ISLAND OF HAWAII

SCALES


PLAN ----- 1 INCH = 100 FT.

PROFILE ----- HOR. 1 INCH = 100 FT.


VER. 1 INCH = 10 FT.

TRUE NORTH

SCALE 1"=4000'

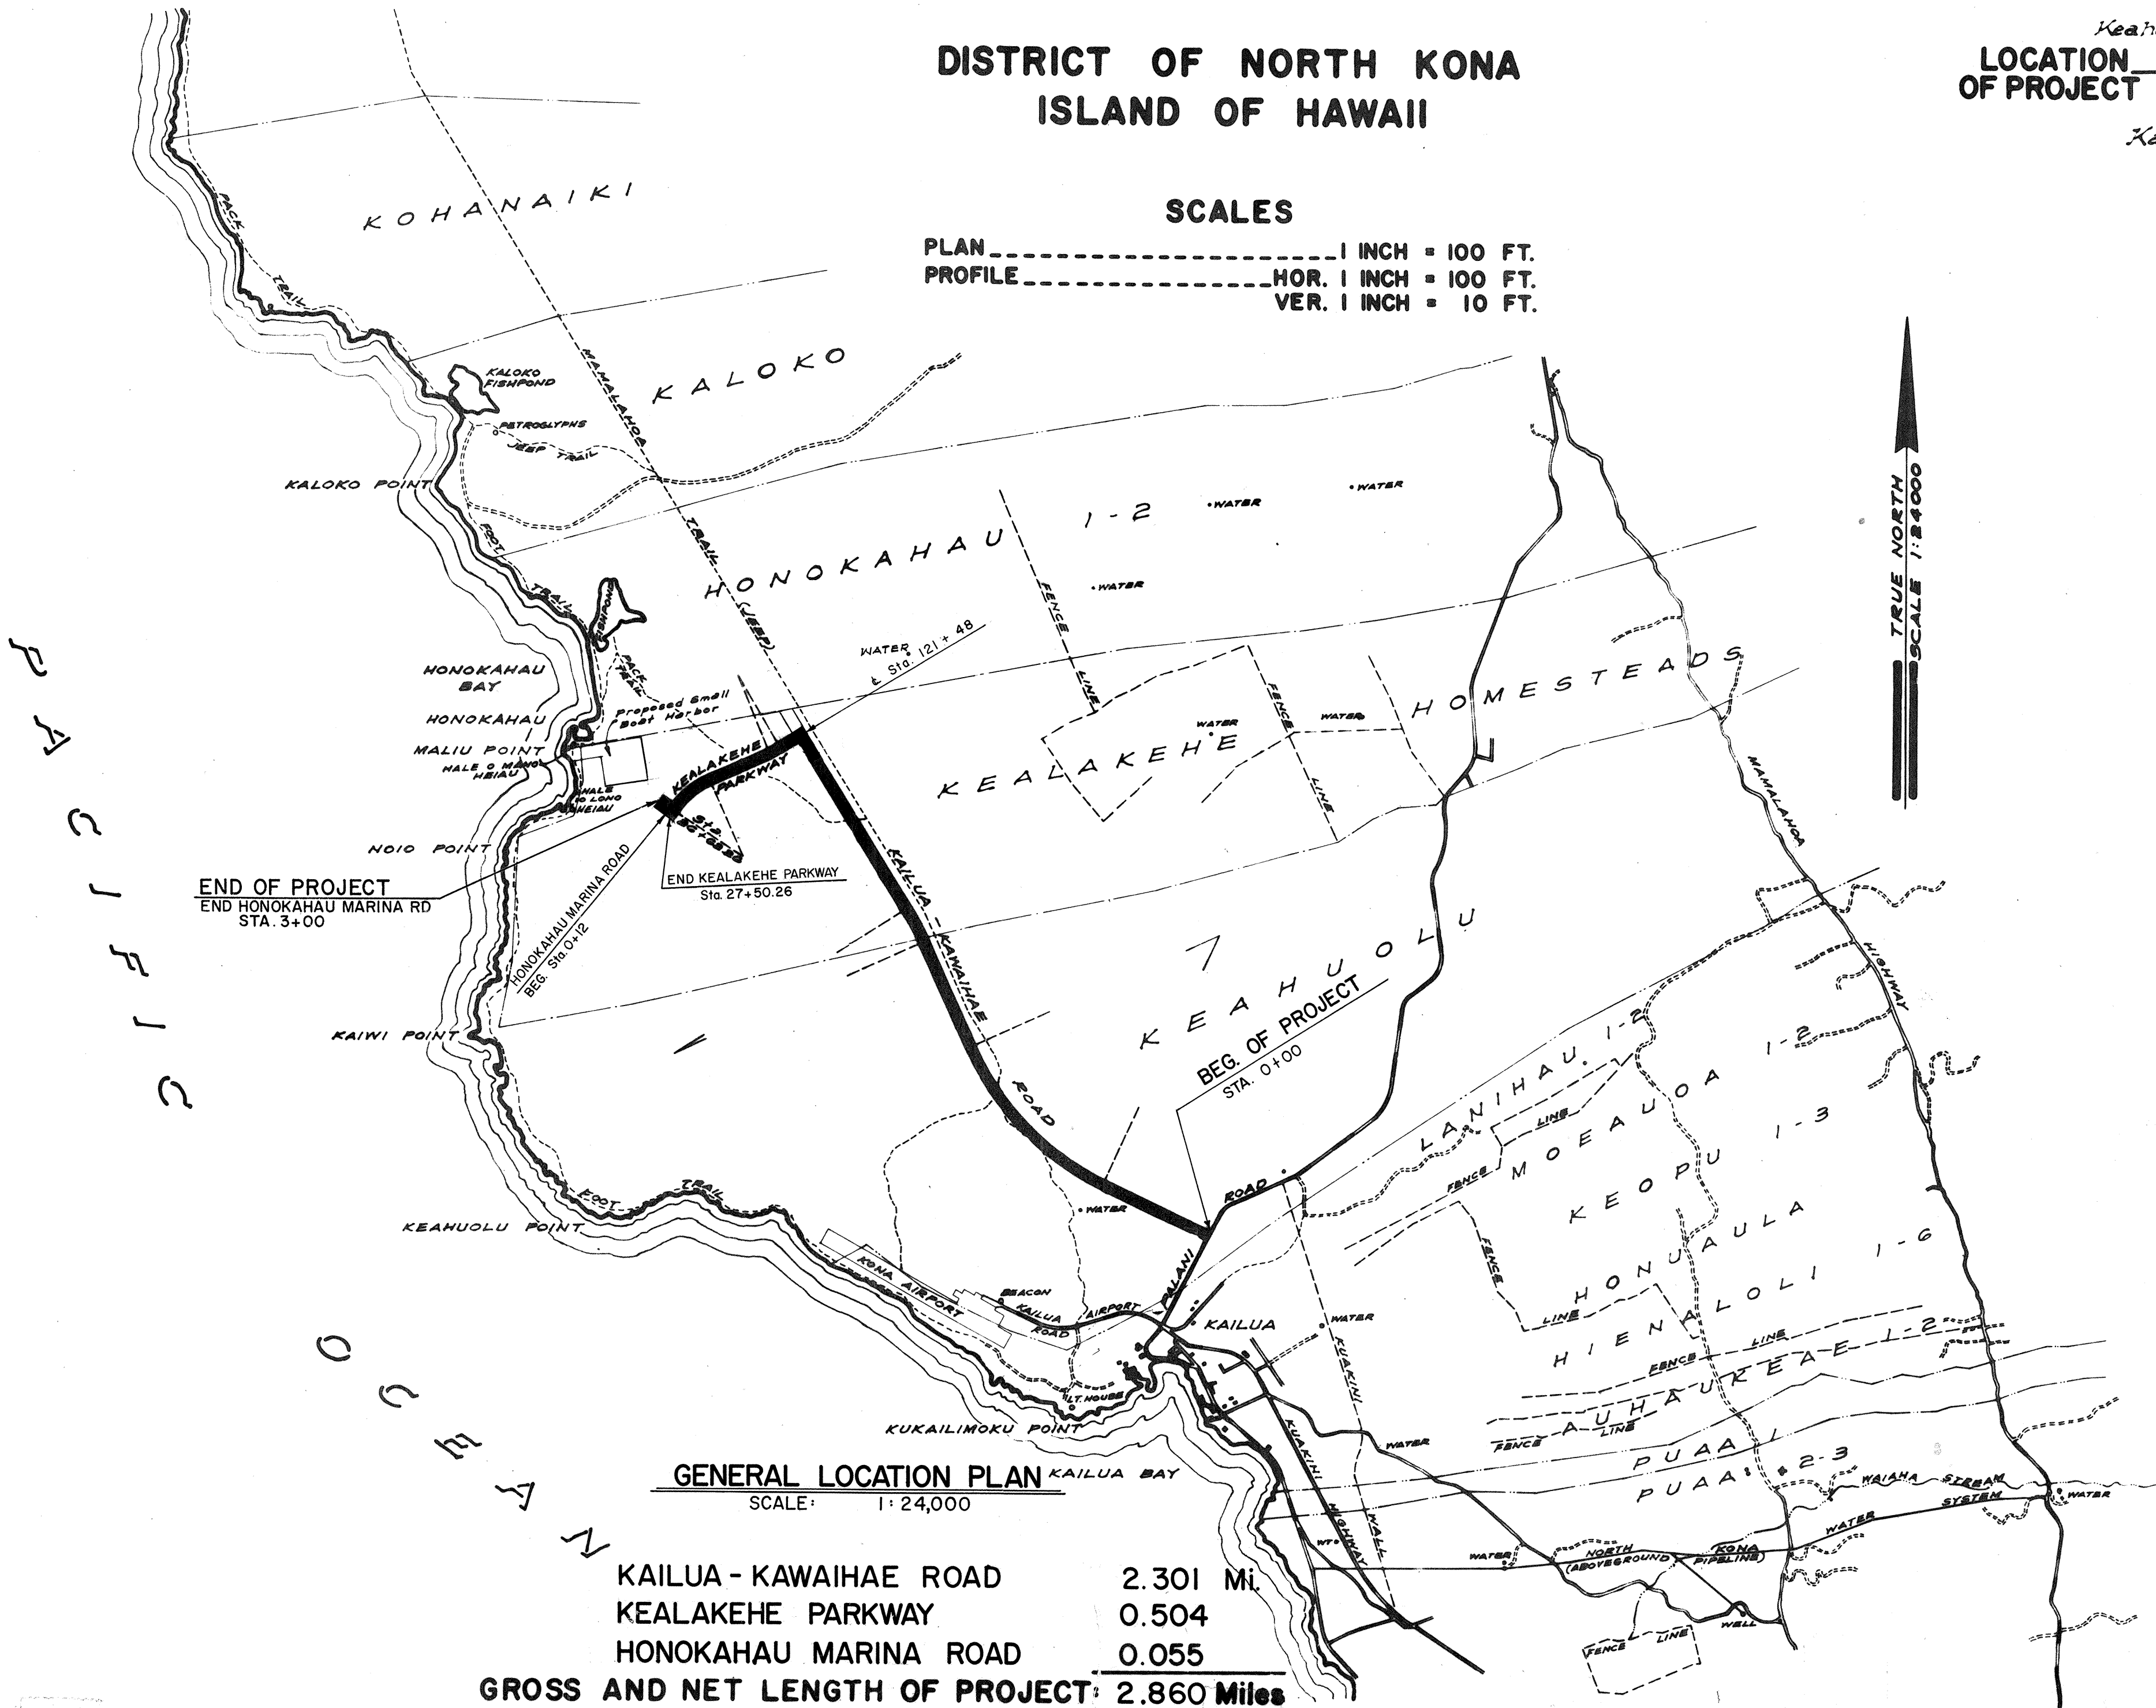

STATE	PROJ. NO.	FISCAL YEAR	SHEET NO.	TOTAL SHEETS
HAW.	B-3267-02-63	1964	1	13

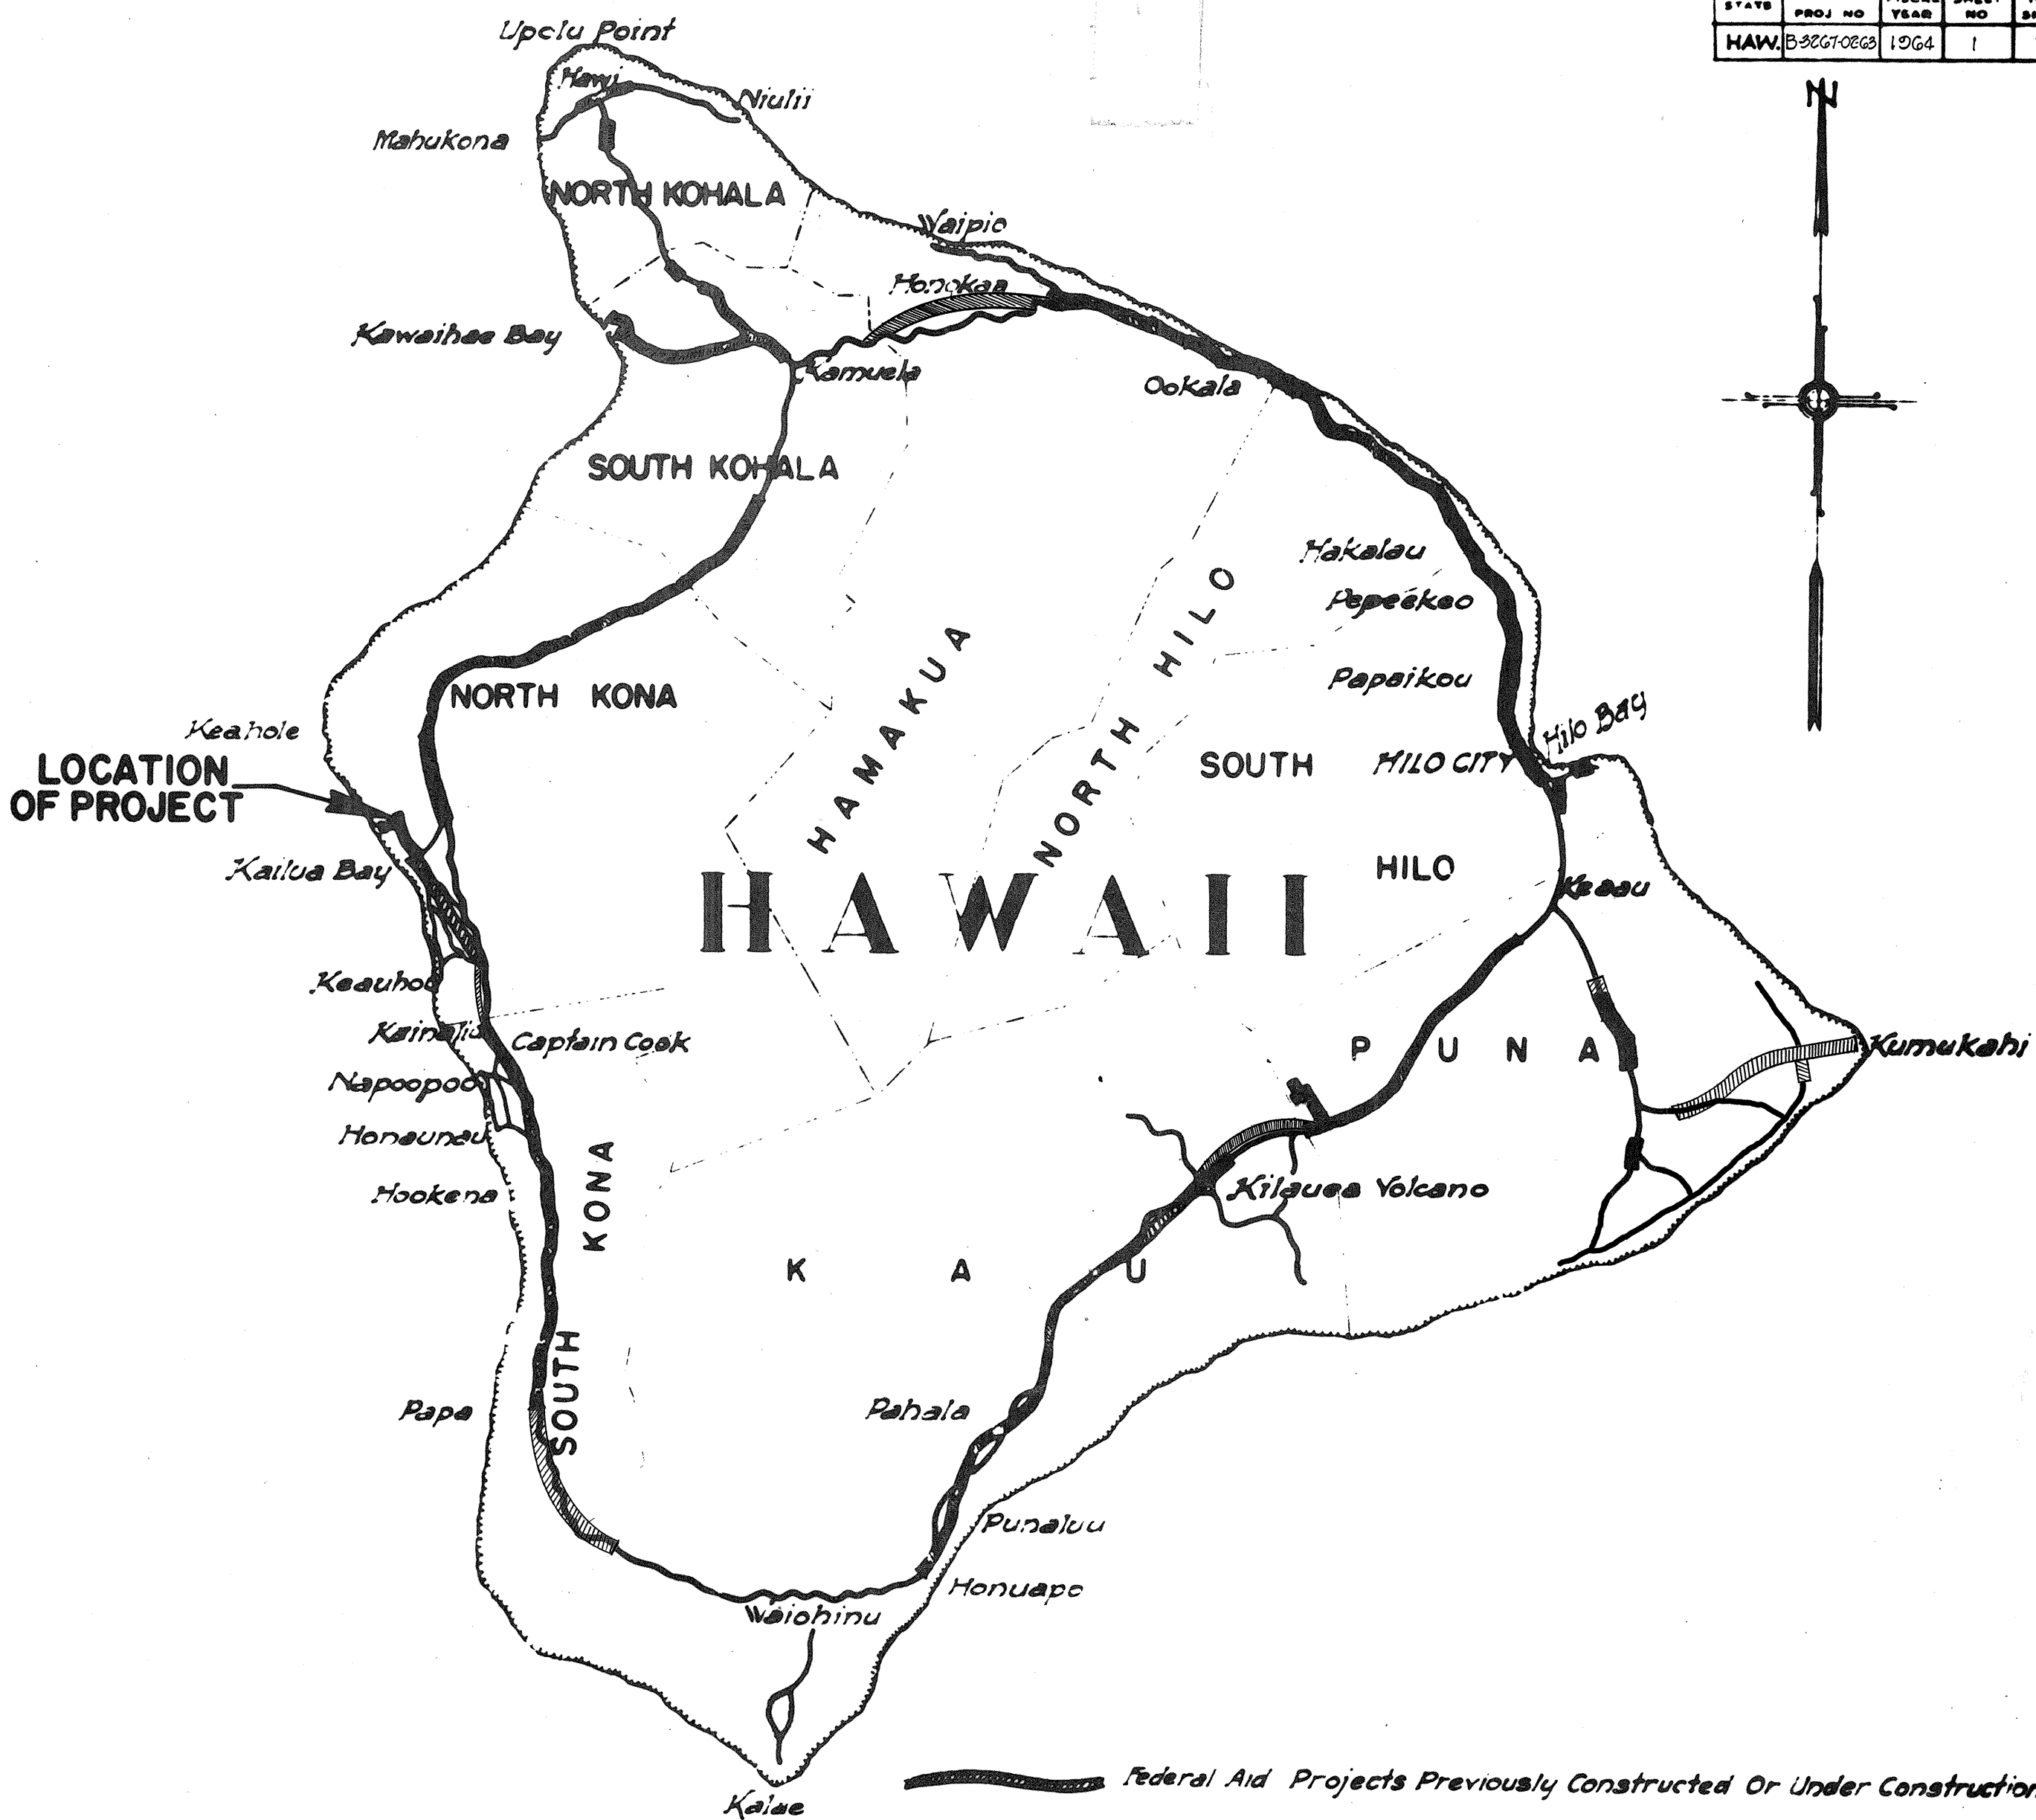

NOTE:

ALL CHANGES MADE DURING CONSTRUCTION HAVE BEEN NOTED IN RED ON THESE TRACINGS AND CHECKED BY:

PROJECT ENGINEER

DATE

AUTHORIZED BY:

ACT. 30, SLH 1962, SECTION I, ITEM D-3-1,

ALLOTMENT SYMBOL B-62-344-D

ACT 52, SLH 1964, SECTION I, ITEM D-2-r,

ALLOTMENT SYMBOL B-64-344-D

APPROVED: DATE OCT. 1, 1964

Kaipo F. Kaula

ACTING DIRECTOR OF TRANSPORTATION