
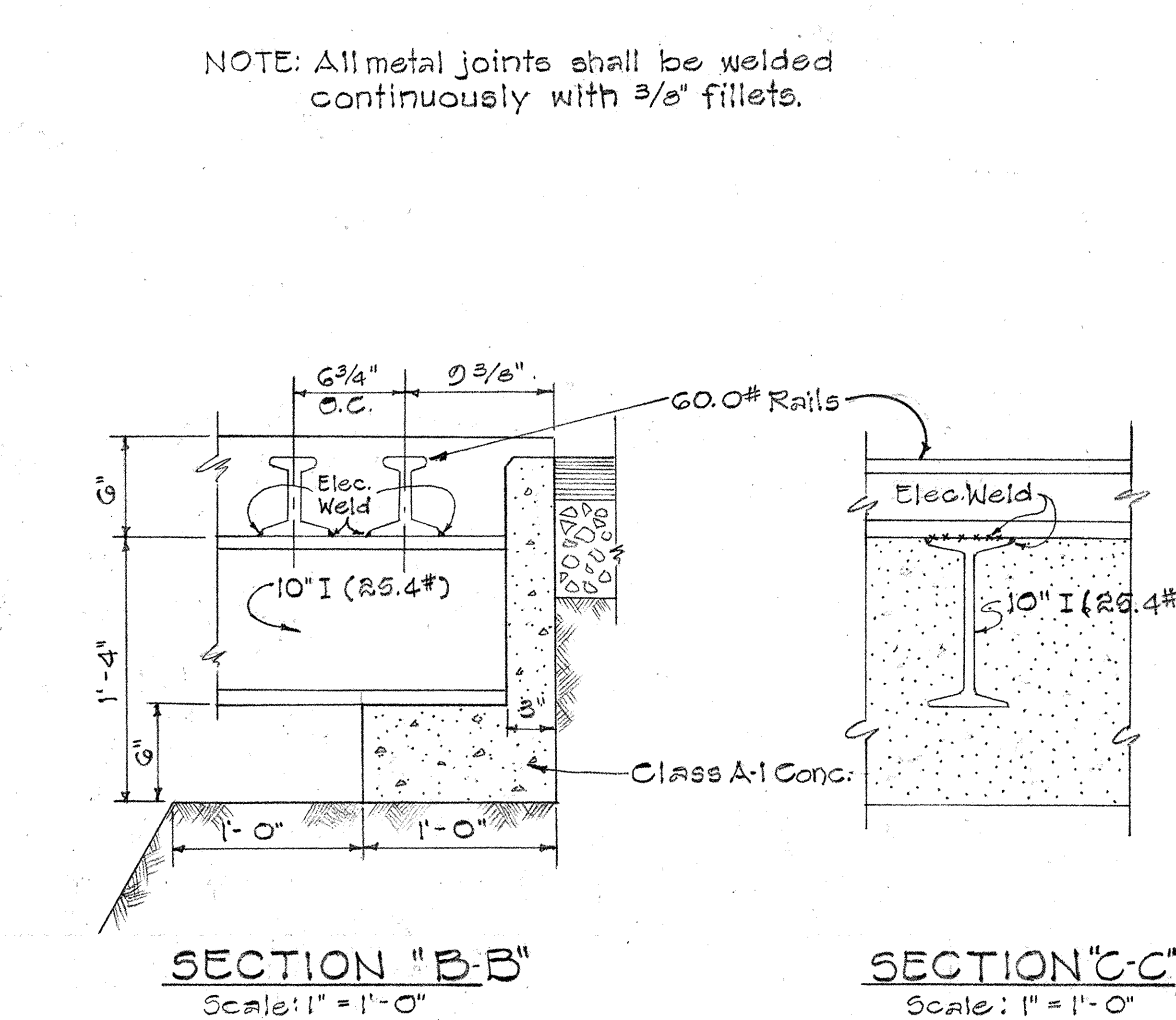
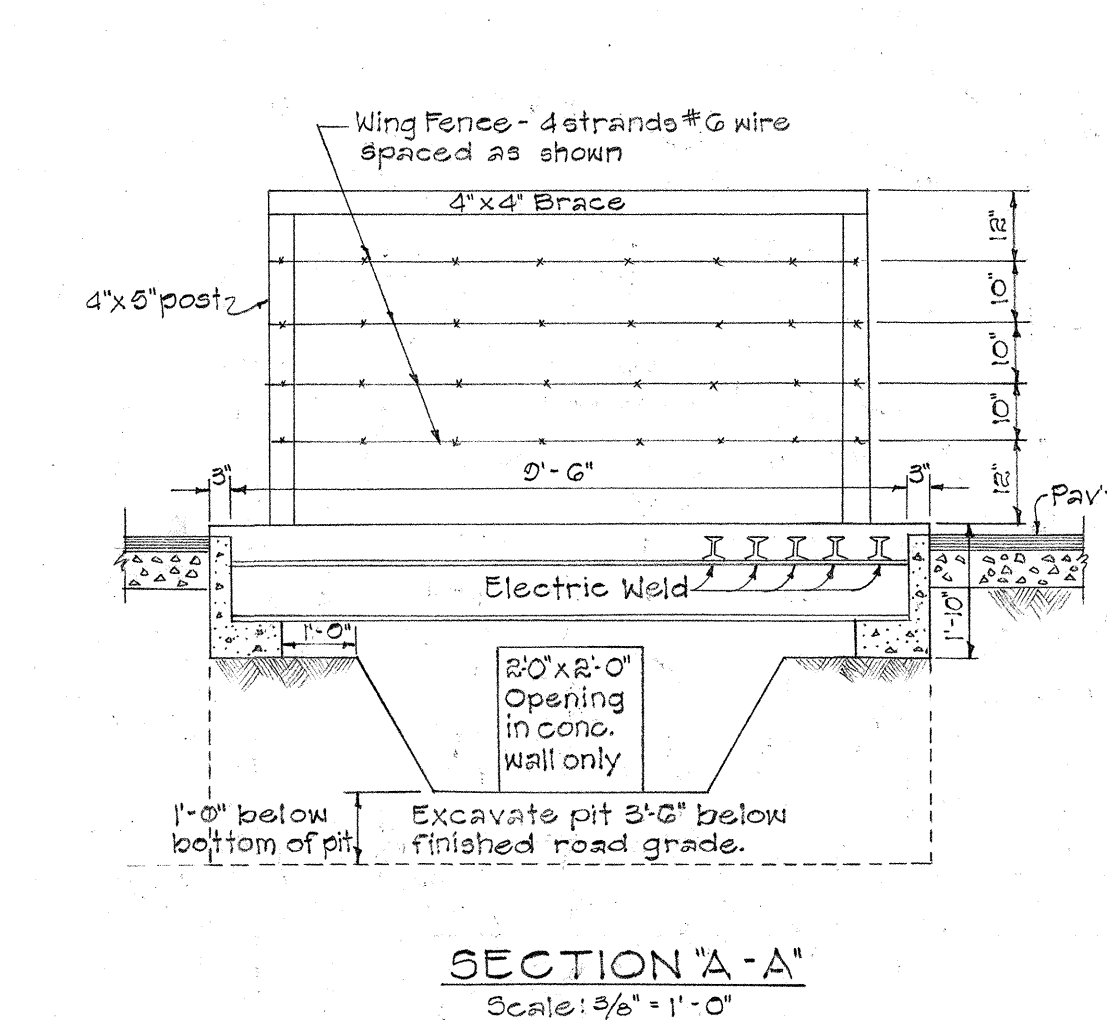
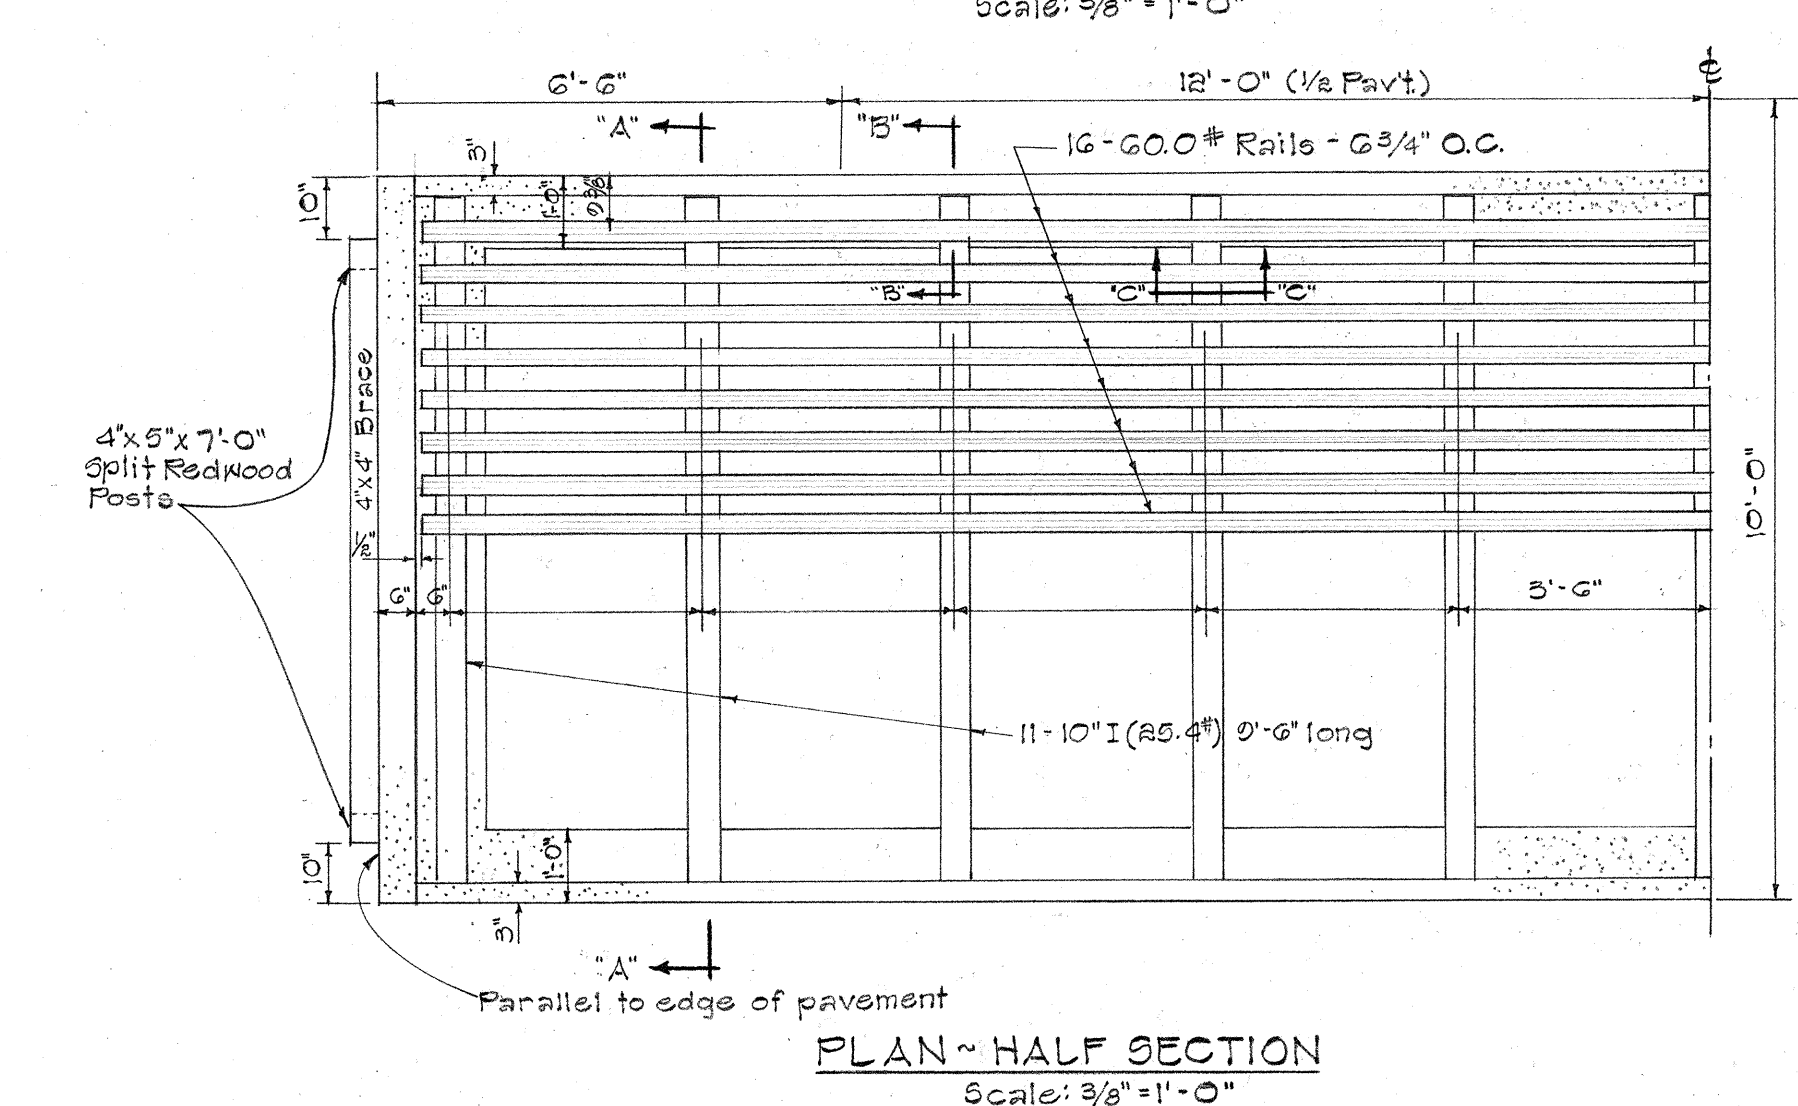
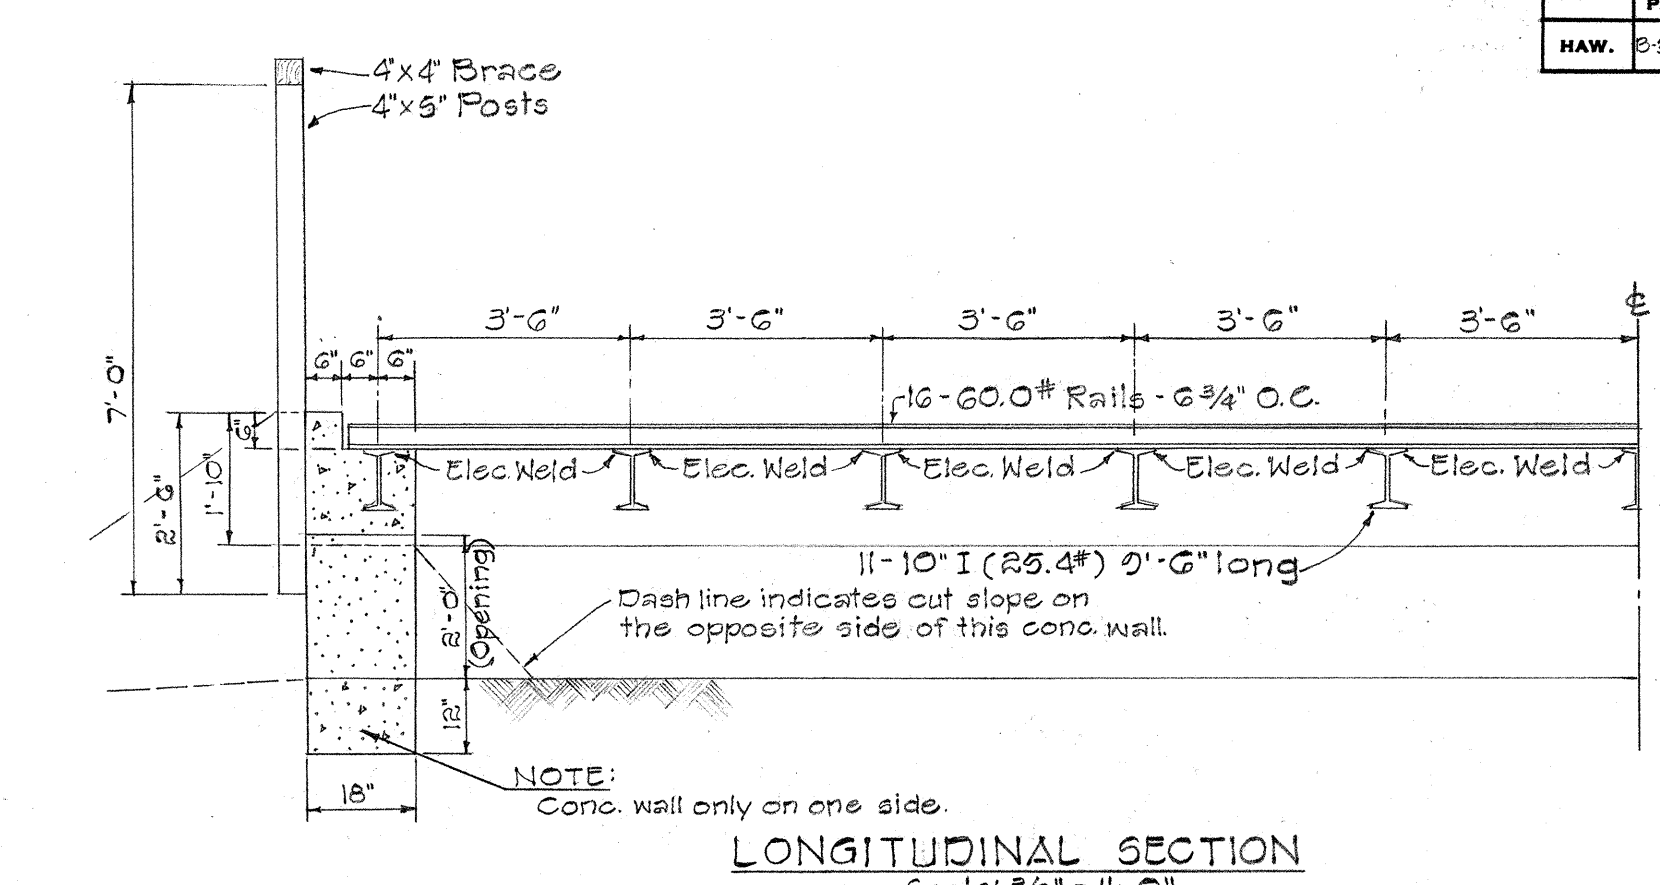
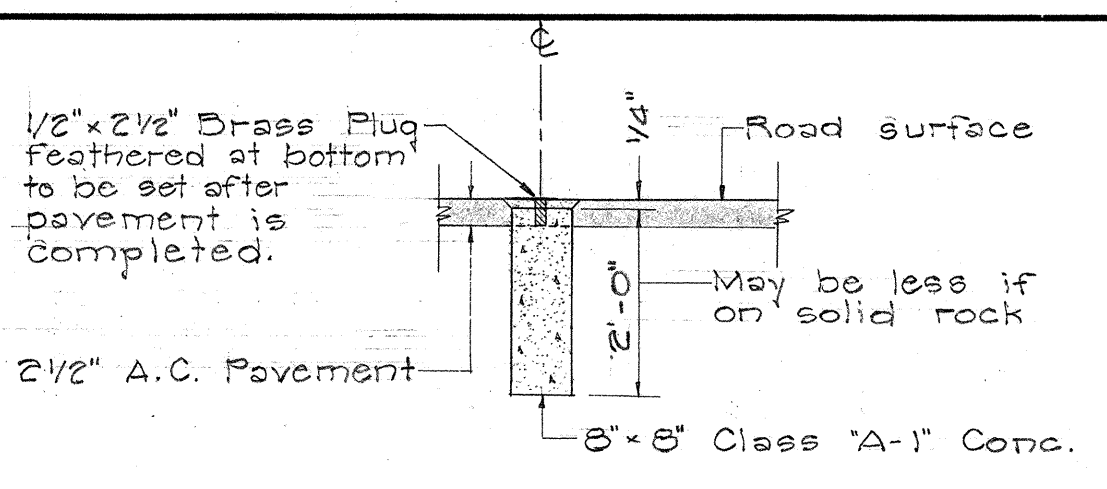
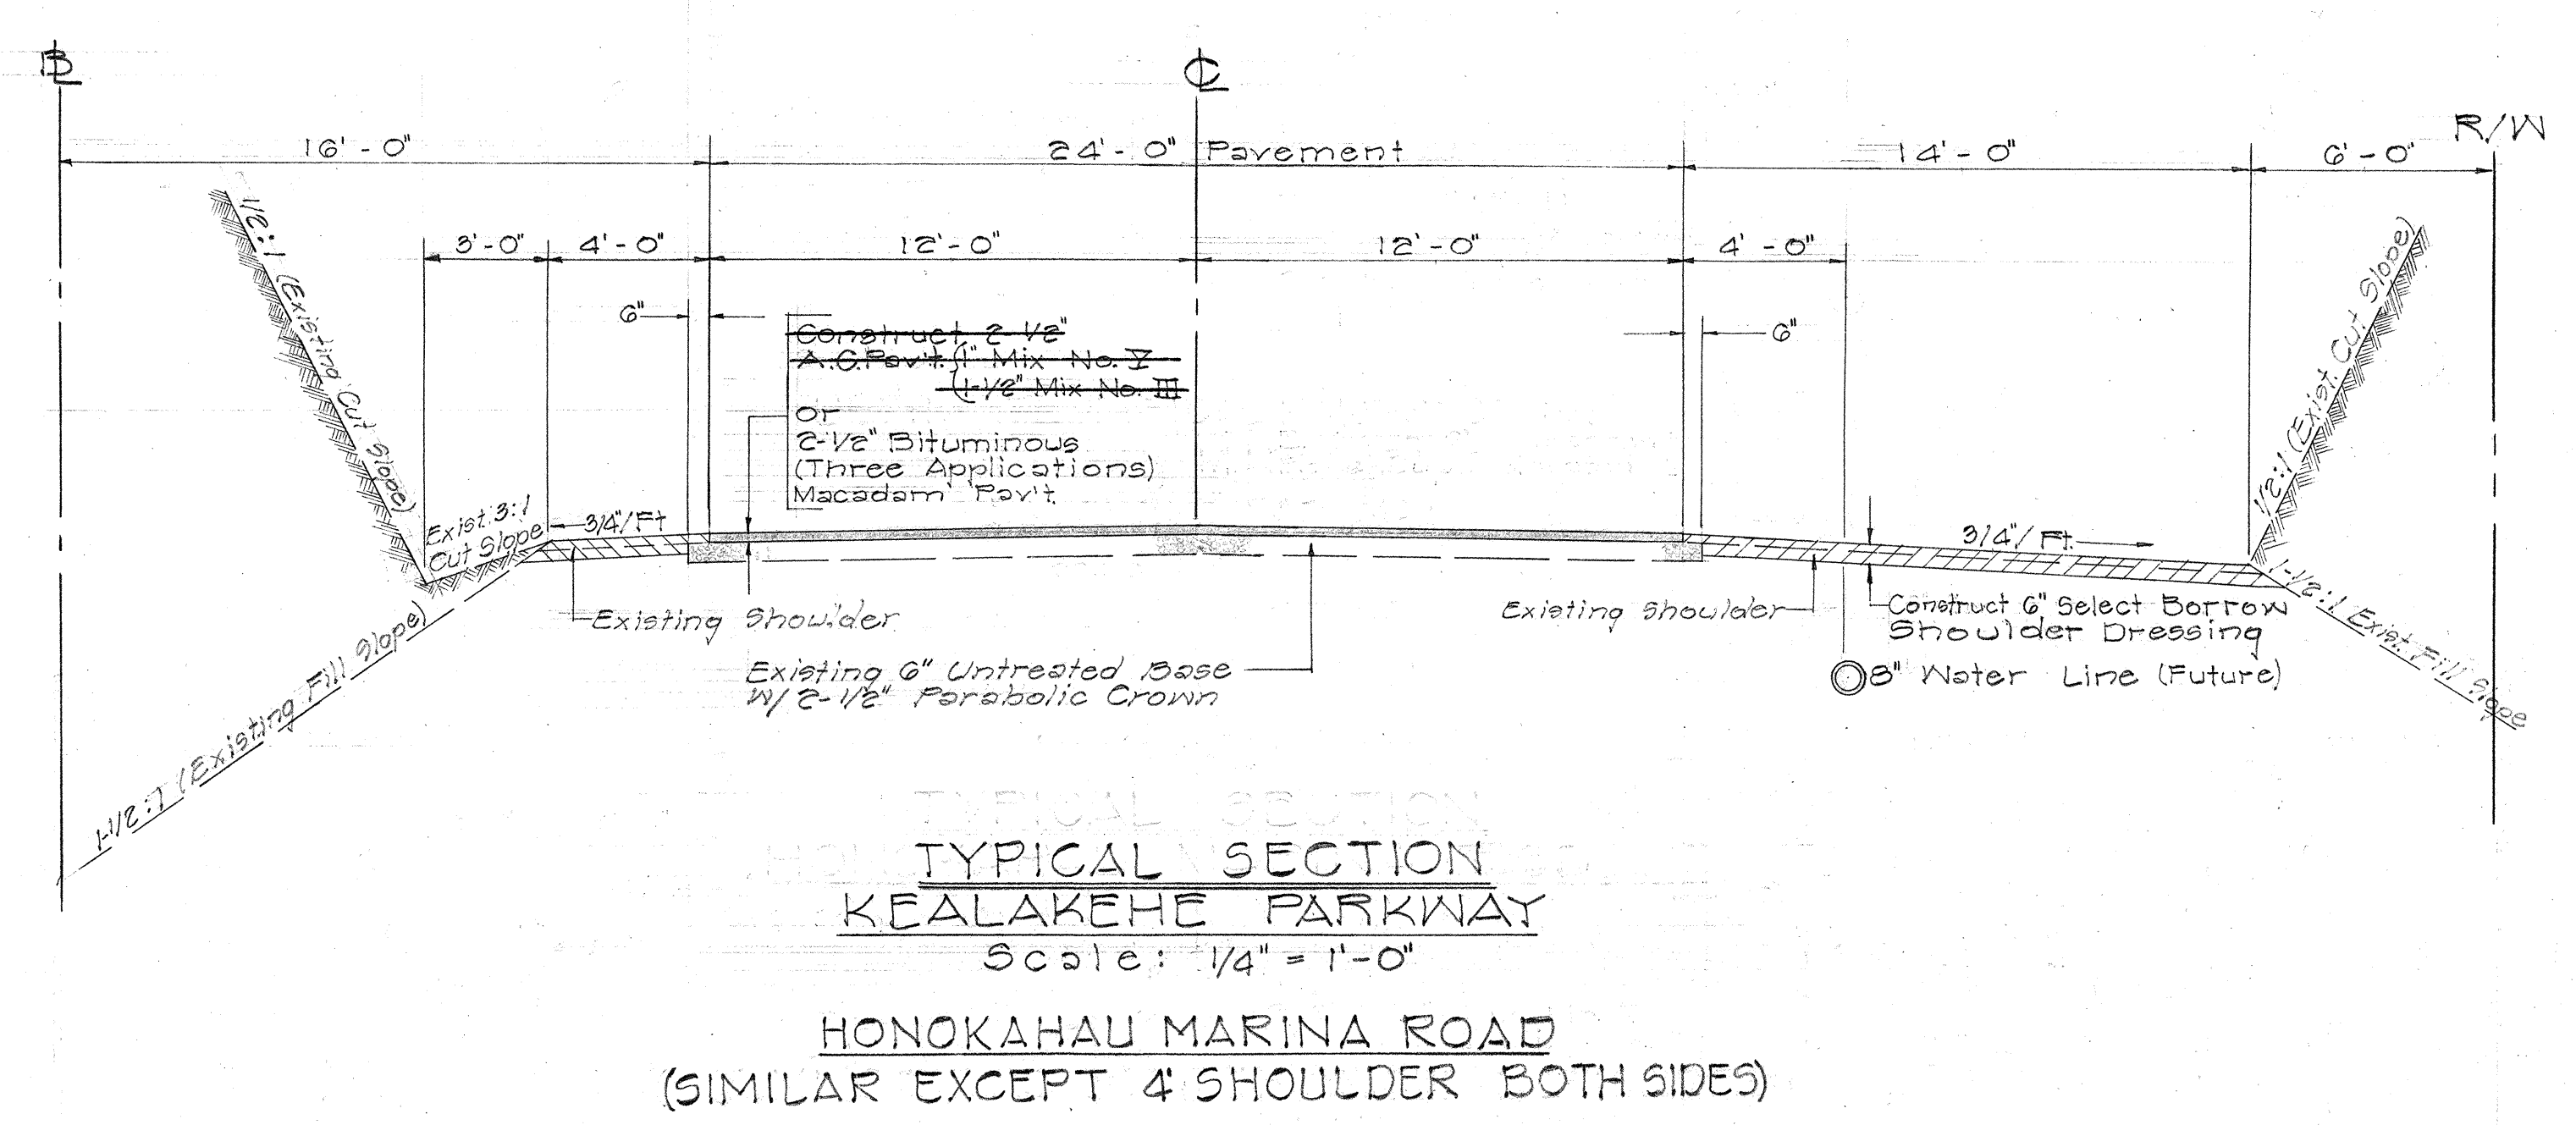
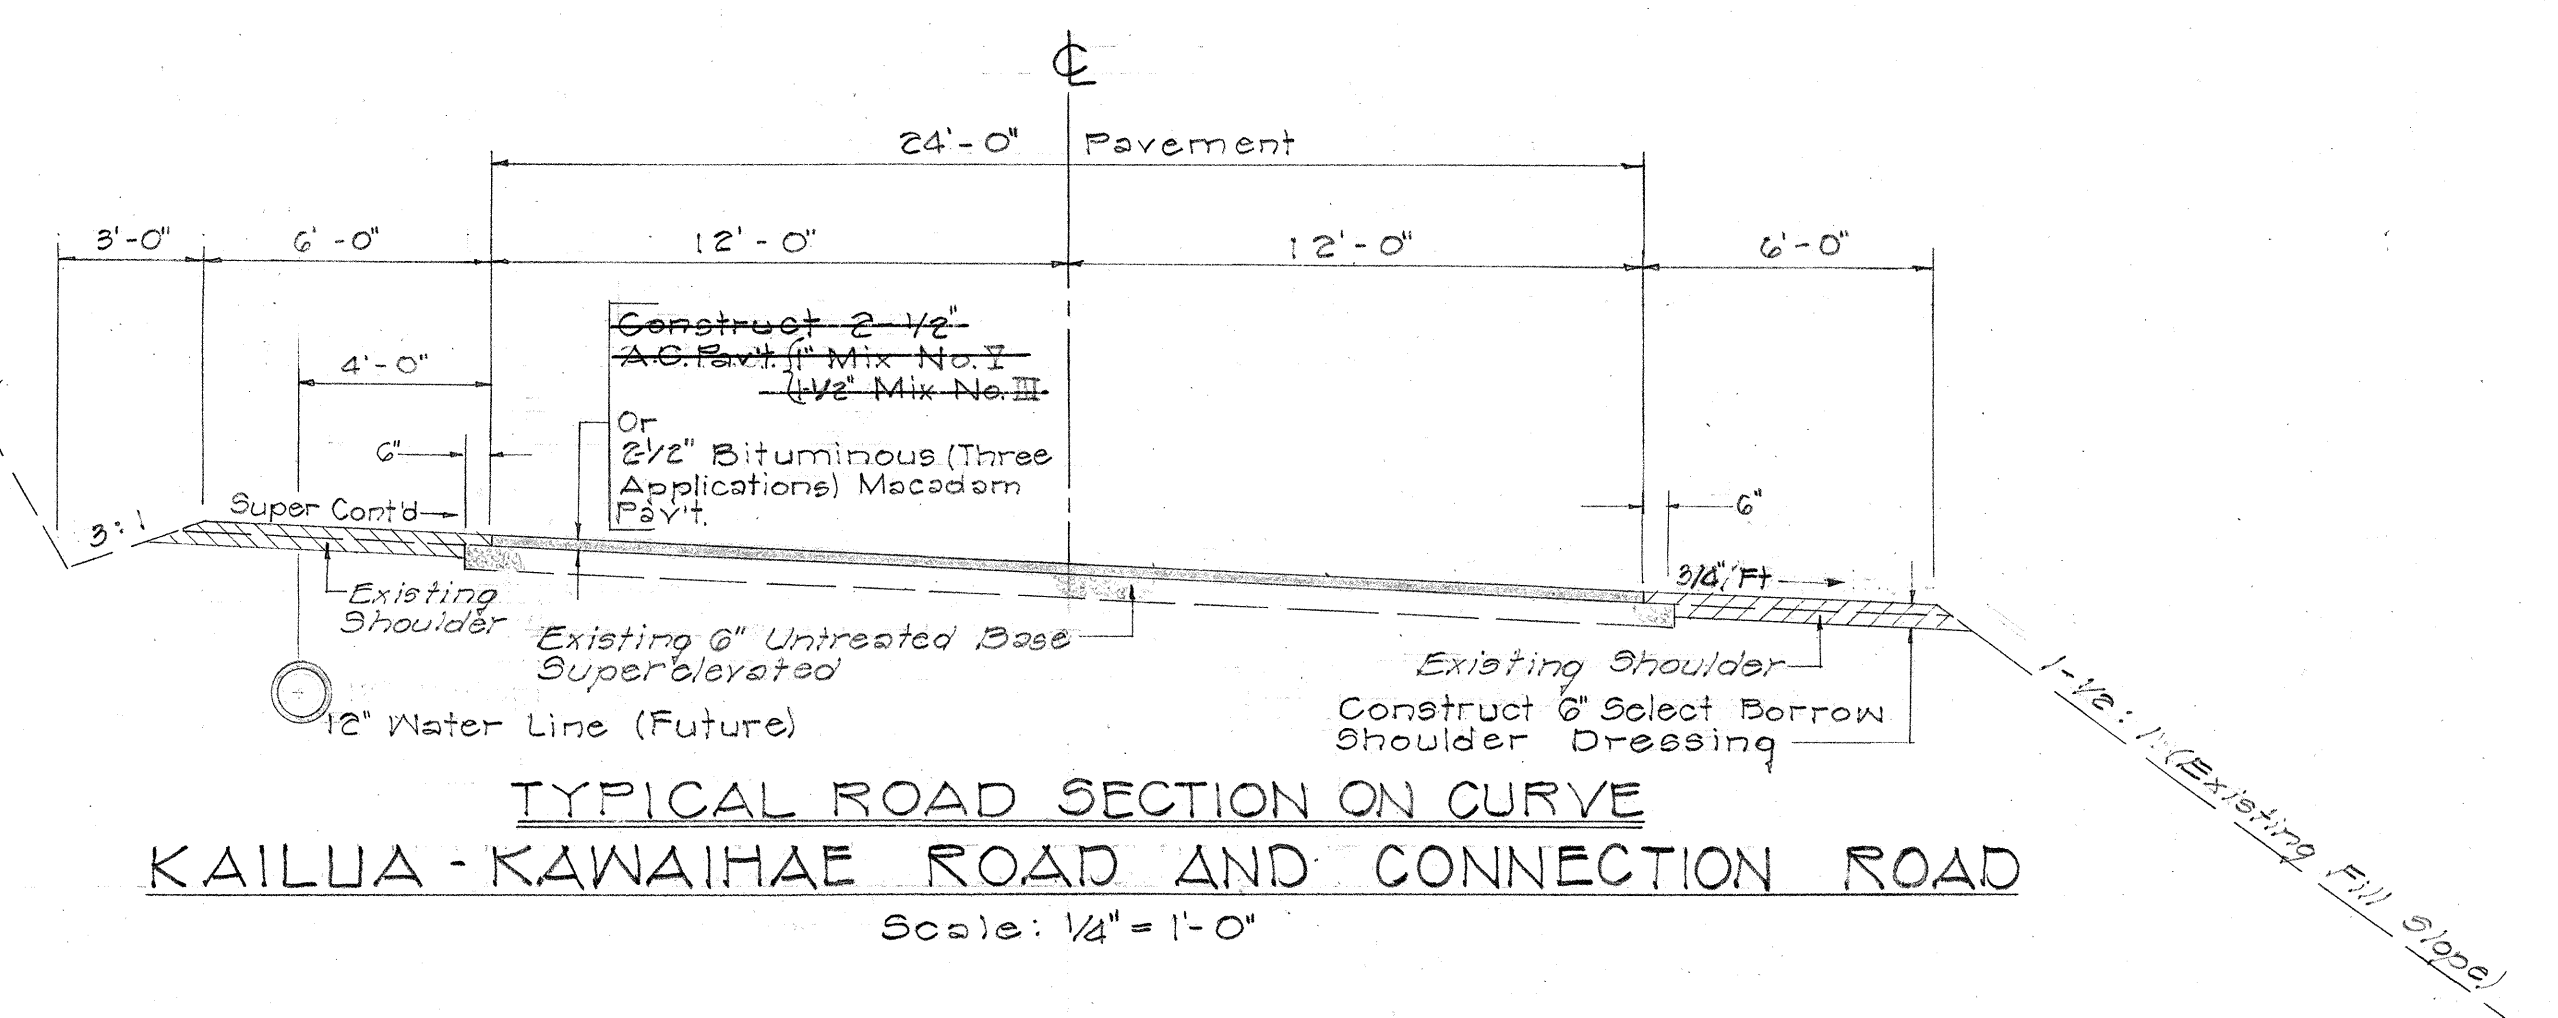


STATE	PROJ. NO.	FISCAL YEAR	SHEET NO.	TOTAL SHEETS
HAW.	B-3267-02-64	1964	2	13

NOTE: 1. Water Lines are not included in this contract.
2. Thicknesses shown for pavements and shoulders are for compacted thicknesses.

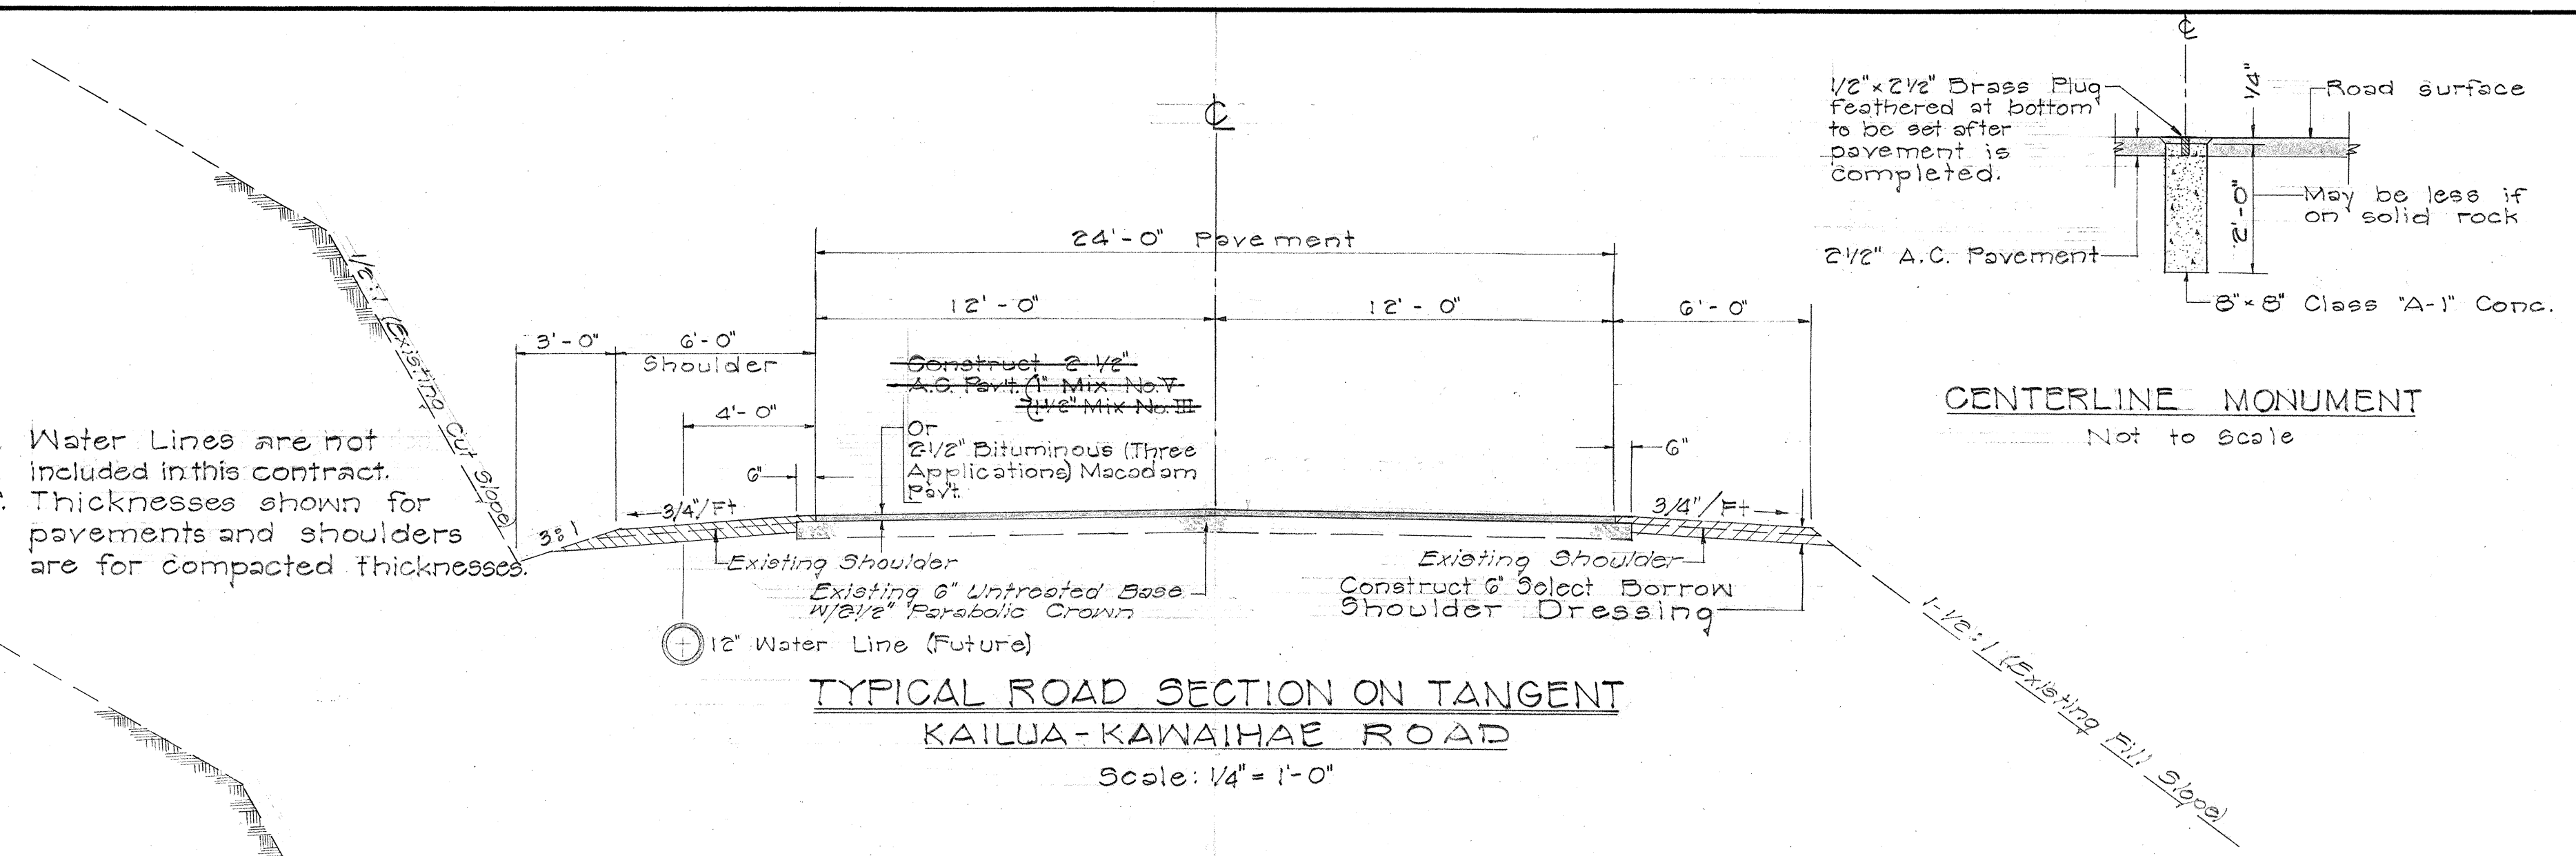

CATTLE GUARD DETAILS
Scale: as noted

NOTE: Cattle Guard at Sta. 3+70 includes:
(Under Change Order No. 2, Feb. 5, 1965)
1. 50 lb. Rails in lieu of 60 lb. Rails.
2. Two Additional 10-I-25.4 Steel Beams and One Additional Rail.

STATE OF HAWAII
DEPARTMENT OF TRANSPORTATION
HIGHWAYS DIVISION

TYPICAL SECTIONS
AND
STANDARD DETAILS
KAILUA-KAWAIHAE ROAD
PROJECT No. B-3267-02-64
Scales: As Noted
Sept. 1964

SHEET No. 1 OF 1 SHEETS

DATE	_____
SURVEY PLOTTED BY	_____
PLAN	_____
DESIGNED BY	_____
NOTE BOOK	_____
QUANTITIES BY	_____
CHECKED BY	_____
No.	_____