

INDEX TO DRAWINGS	
SHEET	DESCRIPTION
1	TITLE SHEET
2	LOCATION PLAN AND TYPICAL SECTIONS
REPLACEMENT OF KAIEIE, KALAOA, HANAWI, AND WAIAMA STREAM BRIDGES	
3-12	ALTERNATE "A"
13-23	ALTERNATE "B"
24-33	ALTERNATE "A-I", "A-II", "A", & "B" (AS NOTED)
34-39	STANDARD DETAILS
40	CONSTRUCTION IDENTIFICATION SIGN
41	STATE ROUTE AND AUXILIARY MARKERS

STATE OF HAWAII

DEPARTMENT OF TRANSPORTATION

HIGHWAYS DIVISION

"AS BUILT" PLANS OF

REPLACEMENT OF

KAIEIE, KALAOA, HANAWI & WAIAMA


STREAM BRIDGES

ON HAWAII BELT ROAD IN THE VICINITY OF ONOMEA

PROJECT NO. F-019-2(8)

DISTRICT OF SOUTH HILO

ISLAND OF HAWAII

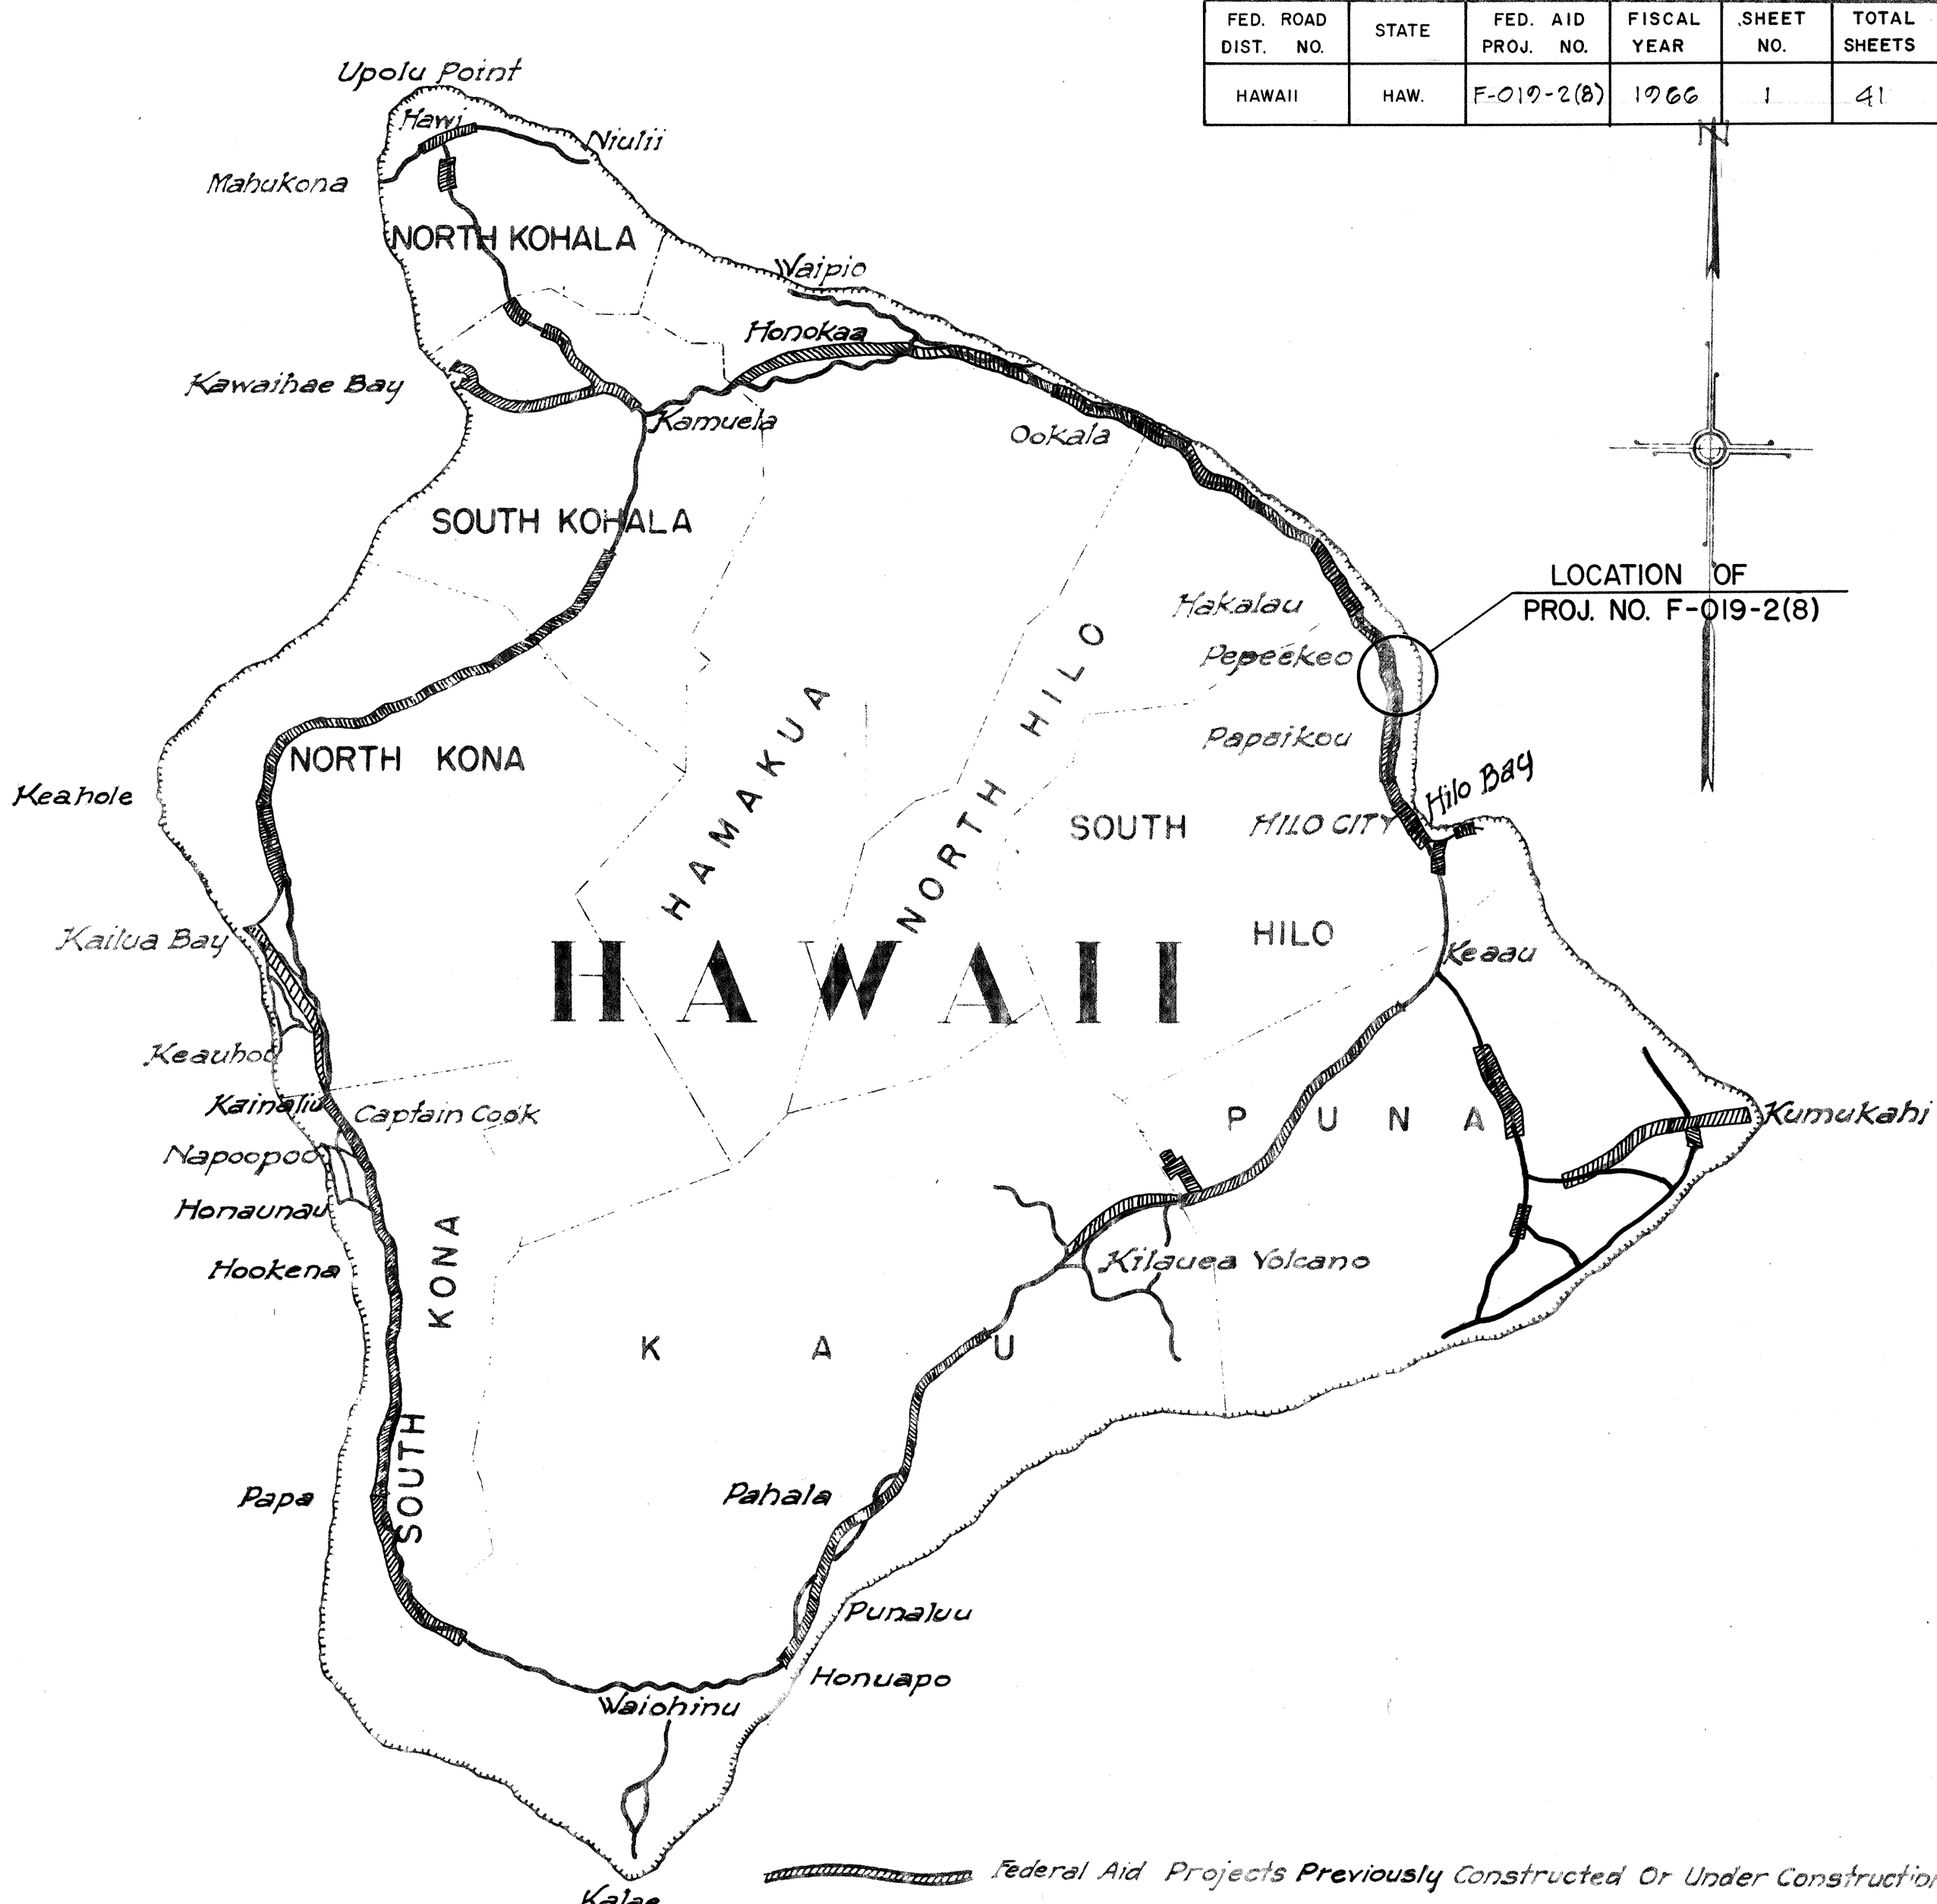

NOTE:
ALL CHANGES MADE DURING CONSTRUCTION
HAVE BEEN NOTED IN RED ON THESE
TRACINGS AND CHECKED BY:

Kari Kigaki
PROJECT ENGINEER
5/7/69
DATE


DESIGN CLASSIFICATION

ADT (1966) _____ 2,900
DESIGN ADT (1986) _____ 4,800
DHV _____ 530
D _____ 60/40

APPROVED: *John M. Lee* DATE: 11-1-66
DIRECTOR OF TRANSPORTATION

DEPARTMENT OF COMMERCE
BUREAU OF PUBLIC ROADS
APPROVED: *John M. Lee* 11-14-66
DIVISION ENGINEER DATE

ORIGINAL PLAN
DATE: NOV. 66
SURVEY PLOTTED BY: R. TERADA
DRAWN BY: _____
NOTES: _____
CHECKED BY: _____

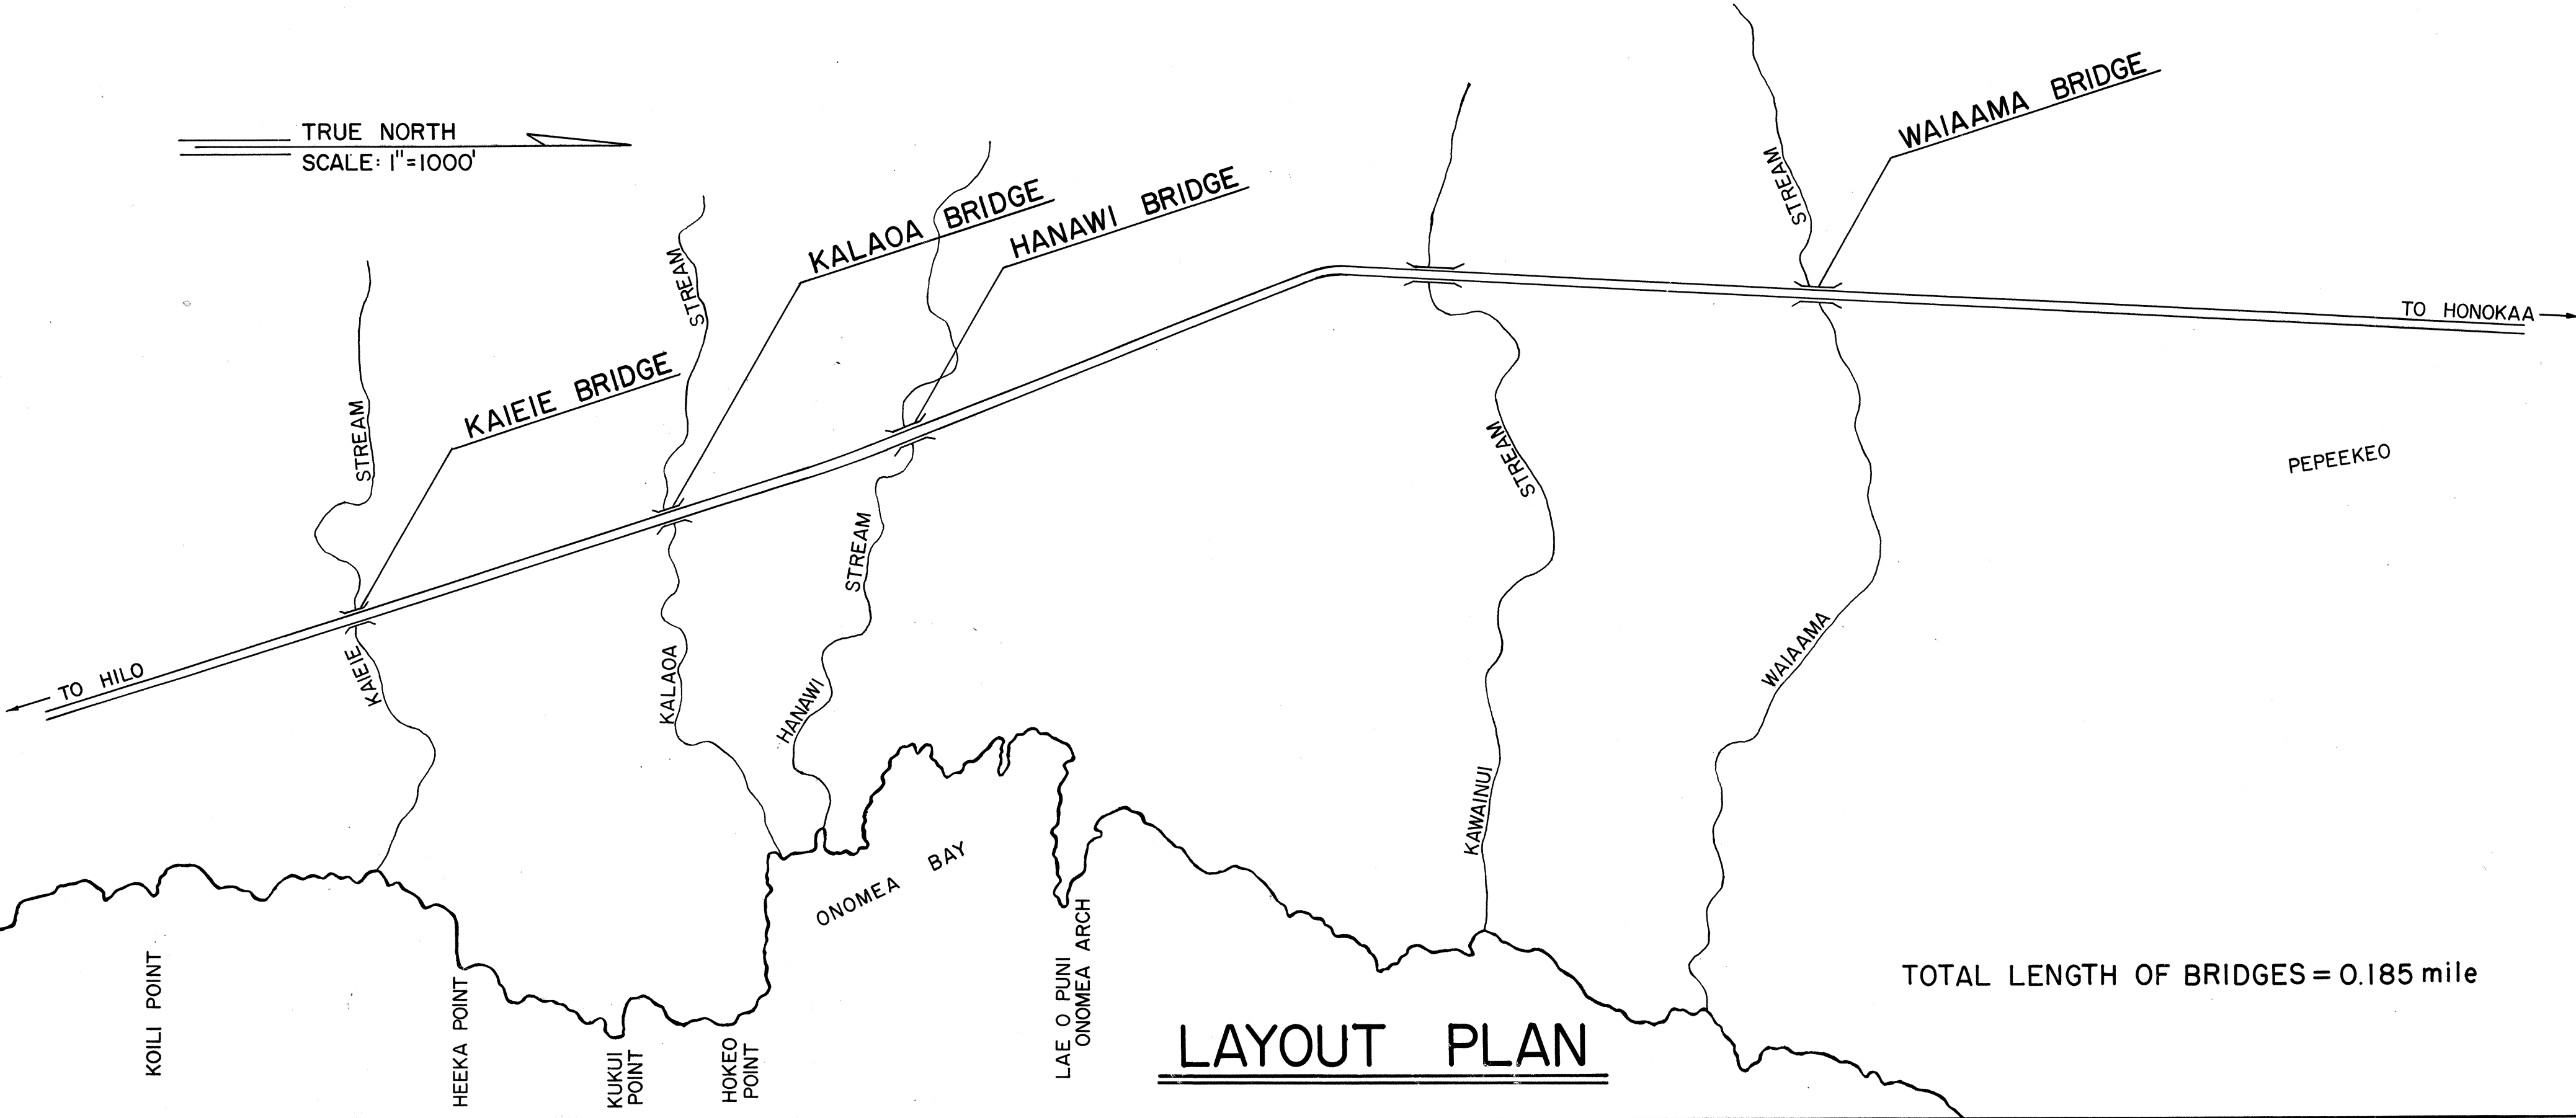

LAYOUT PLAN

TOTAL LENGTH OF BRIDGES = 0.185 mile