

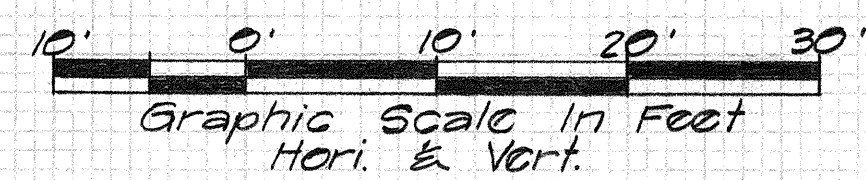
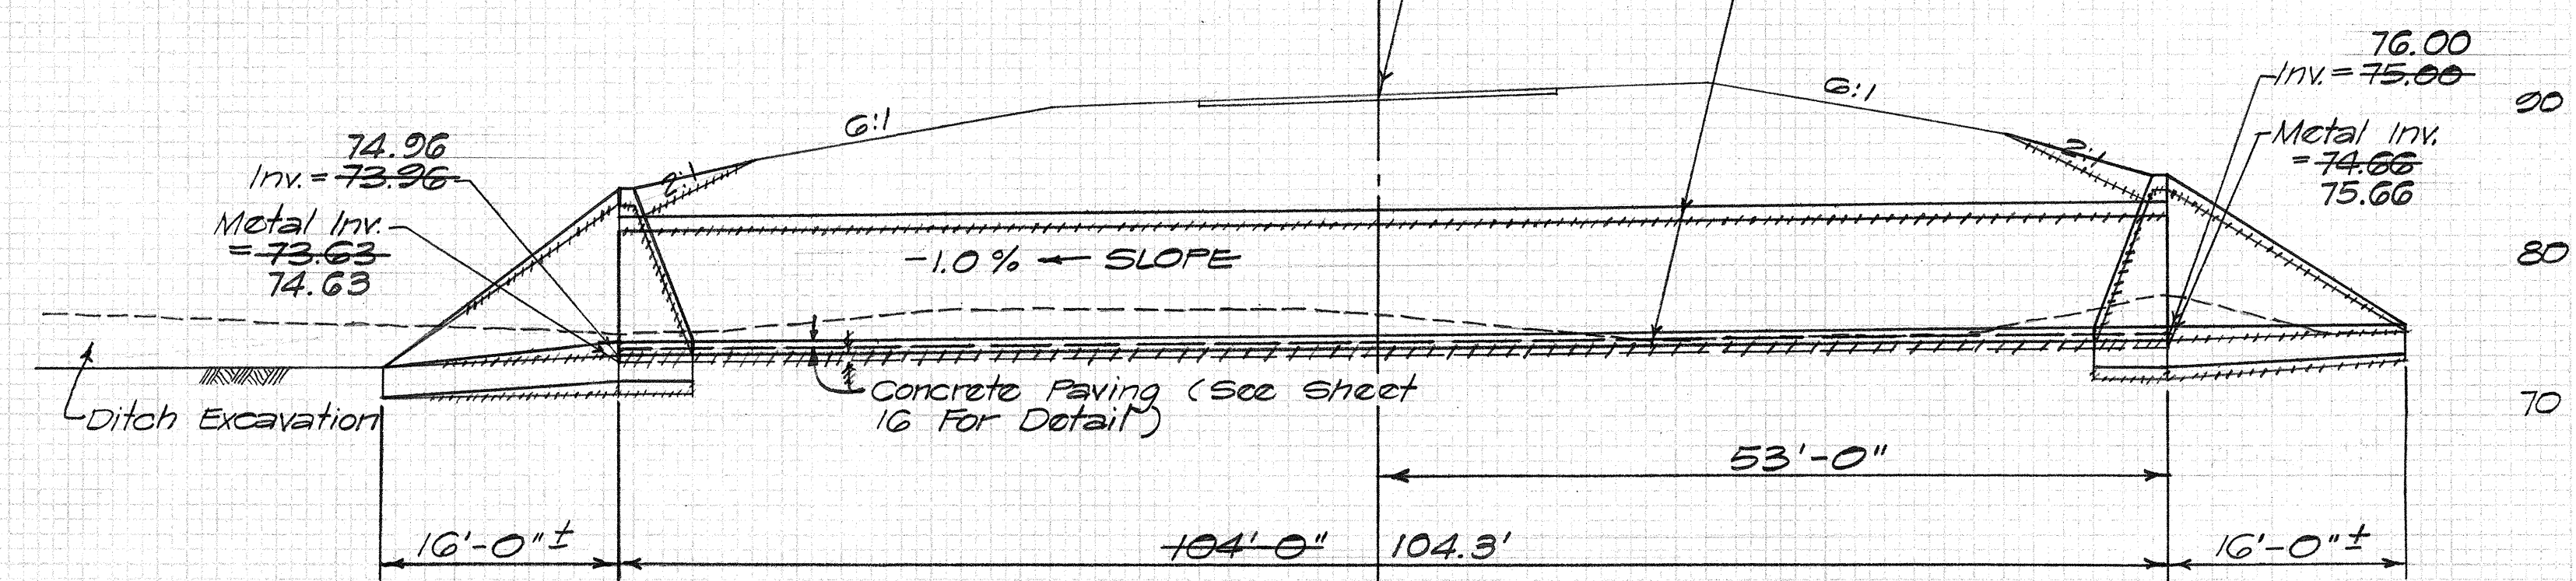
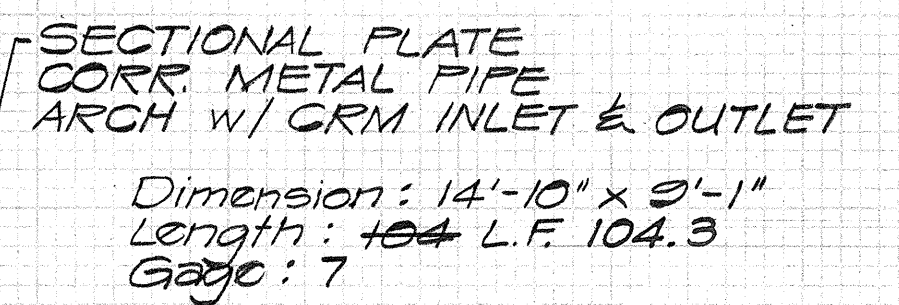
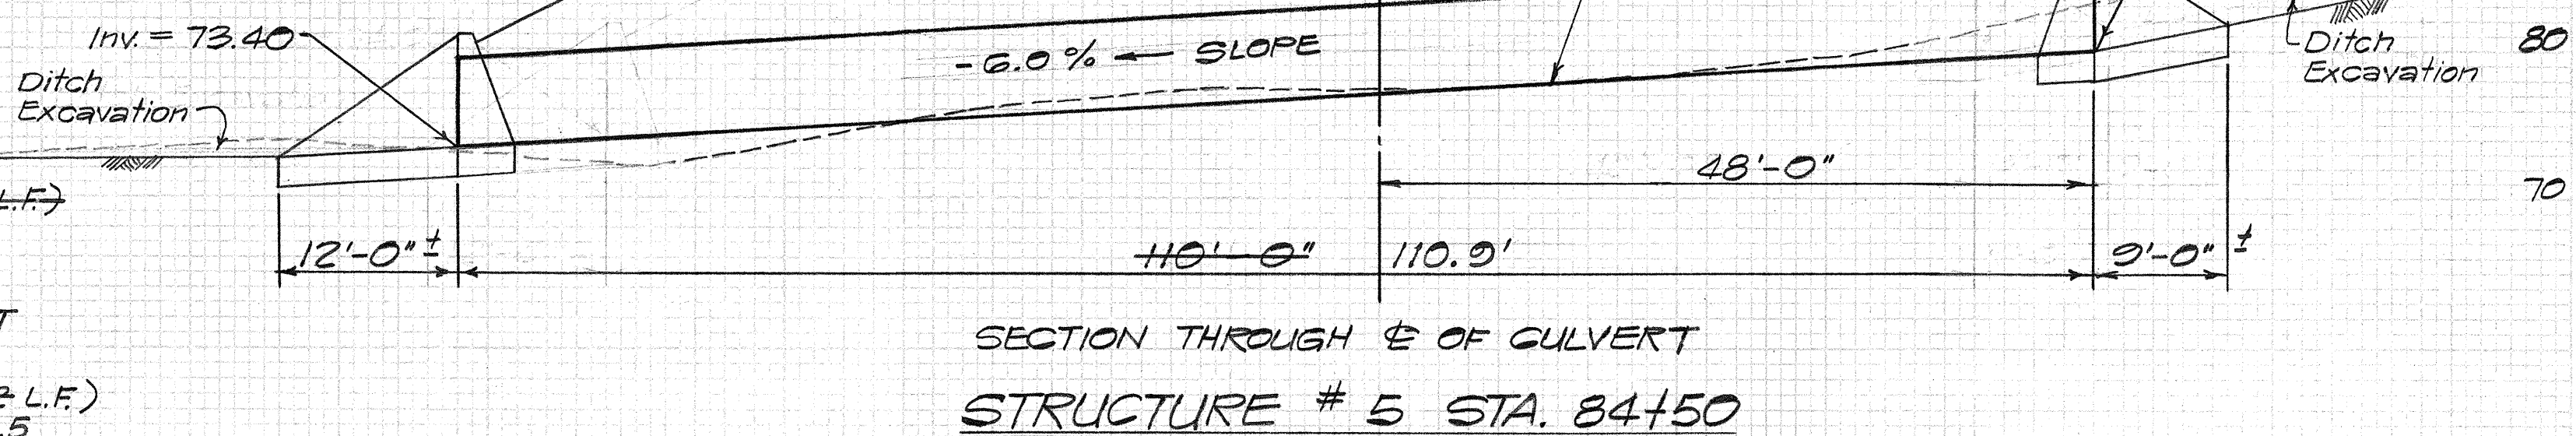
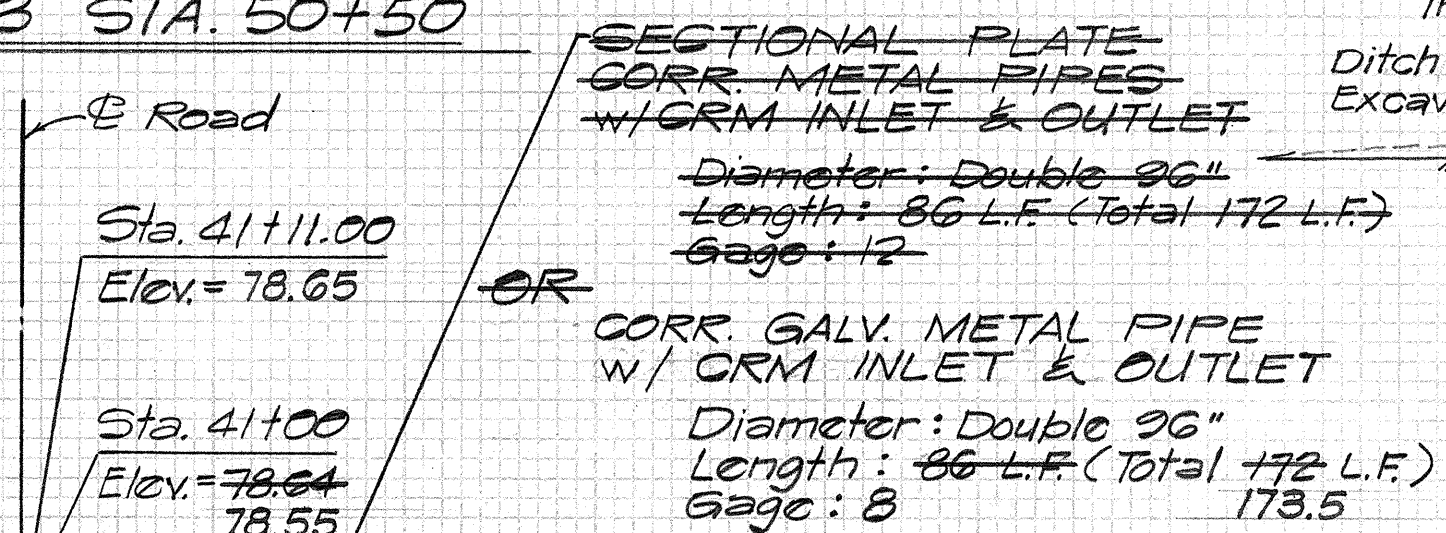


STATE	PROJECT NO.	FISCAL YEAR	SHEET NO.	TOTAL SHEETS
HAWAII	80-66-7-352		13	17

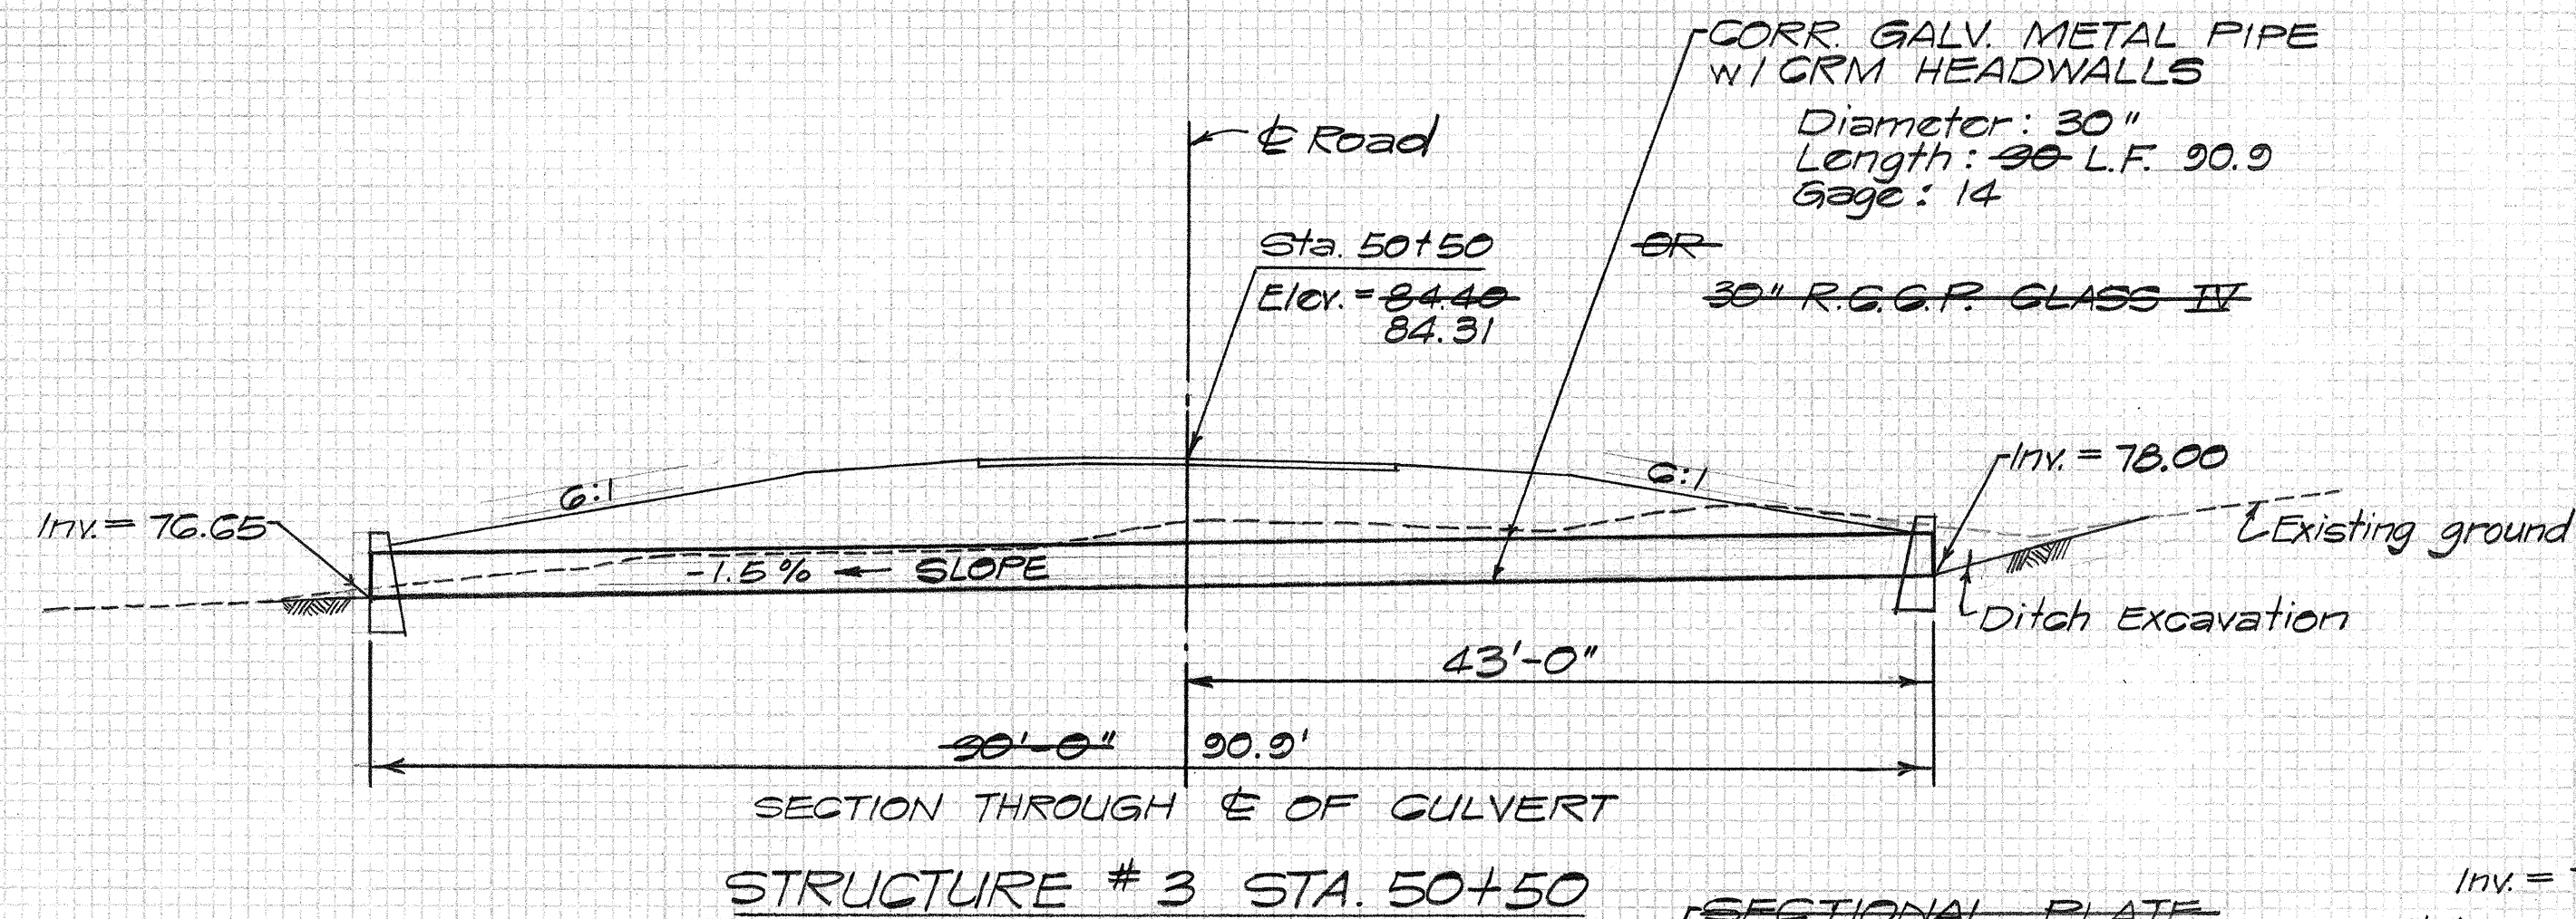

THIS WORK WAS PREPARED BY
ME OR UNDER MY SUPERVISION.

Brian L. Gray
Signature

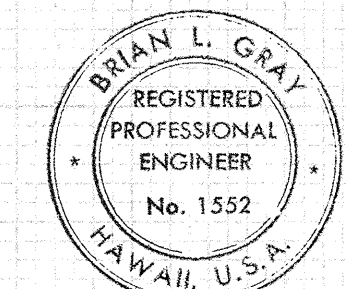


STATE OF HAWAII
DEPARTMENT OF TRANSPORTATION
HIGHWAYS DIVISION


CULVERTS
STRUCTURES #1, 2, 3, 4 & 5
KAILUA-KAWAIHAE ROAD
PROJ. NO. 80-66-7-352

SCALE: AS NOTED


SHEET No. 1 OF 3 SHEETS

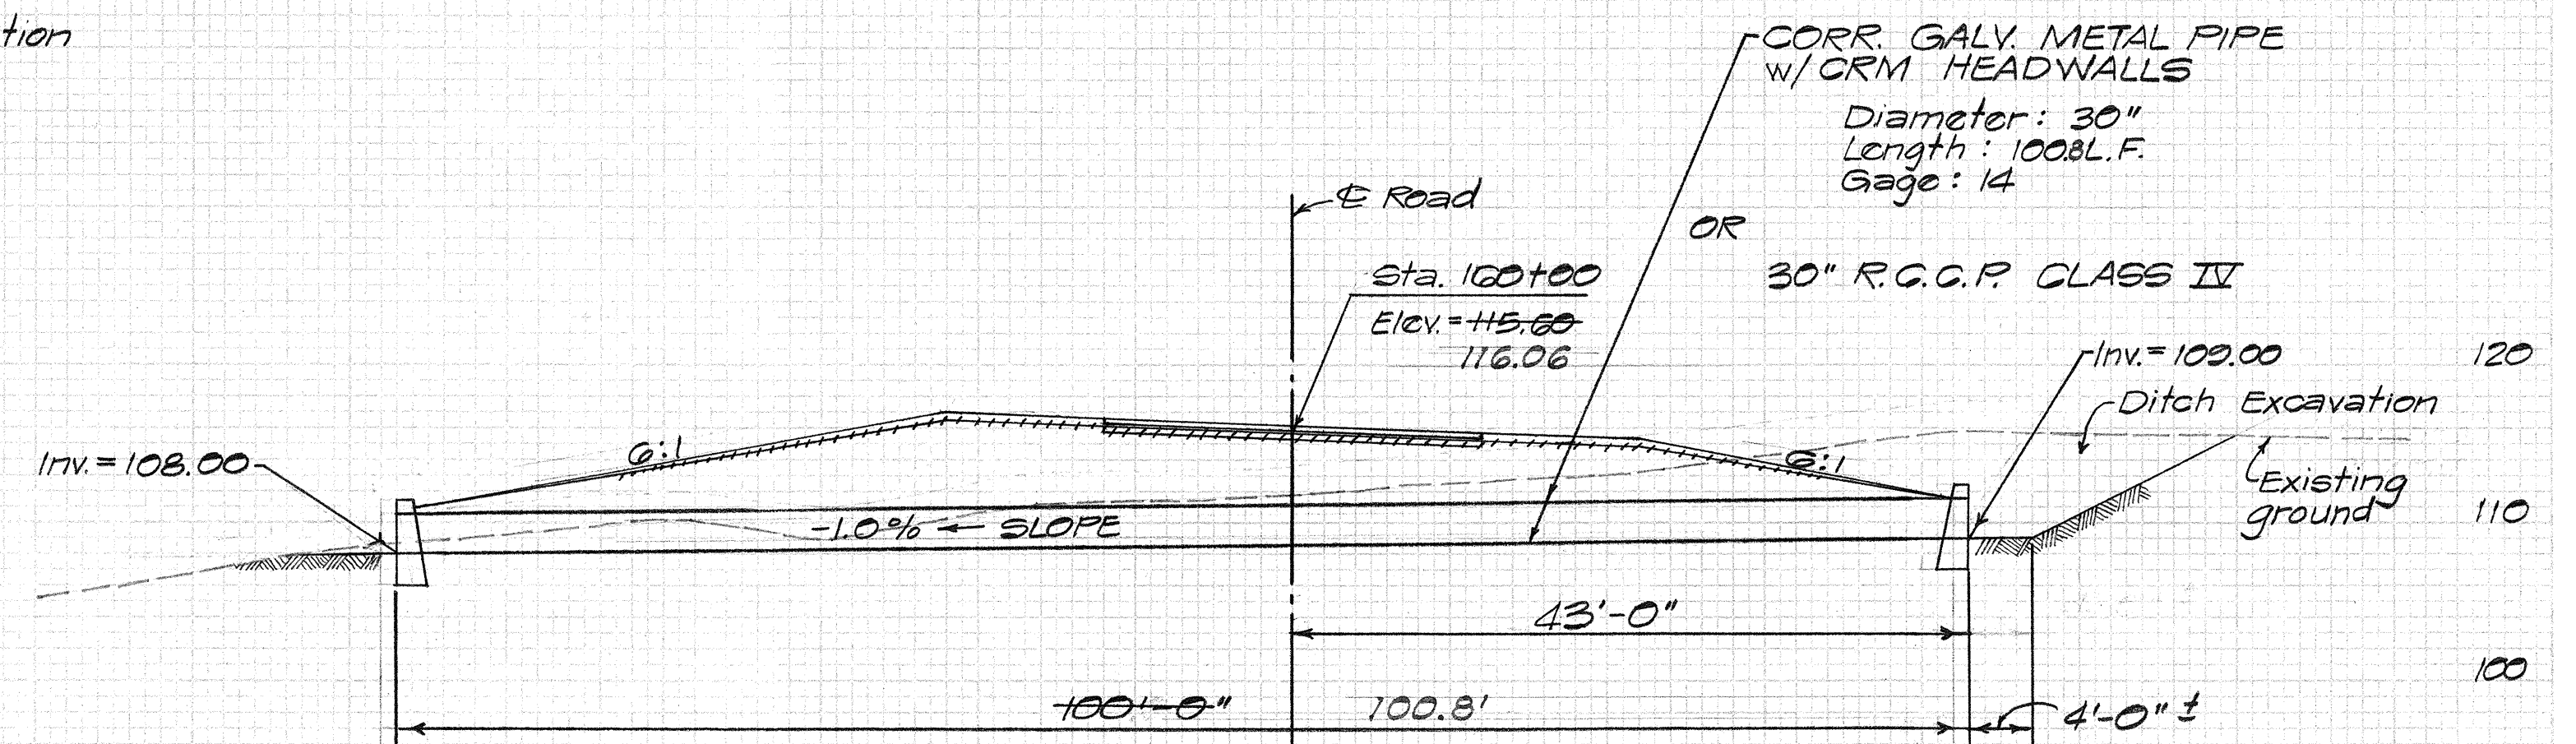


STATE	PROJECT NO.	FISCAL YEAR	SHEET NO.	TOTAL SHEETS
HAWAII	80-66-7-352		15	17

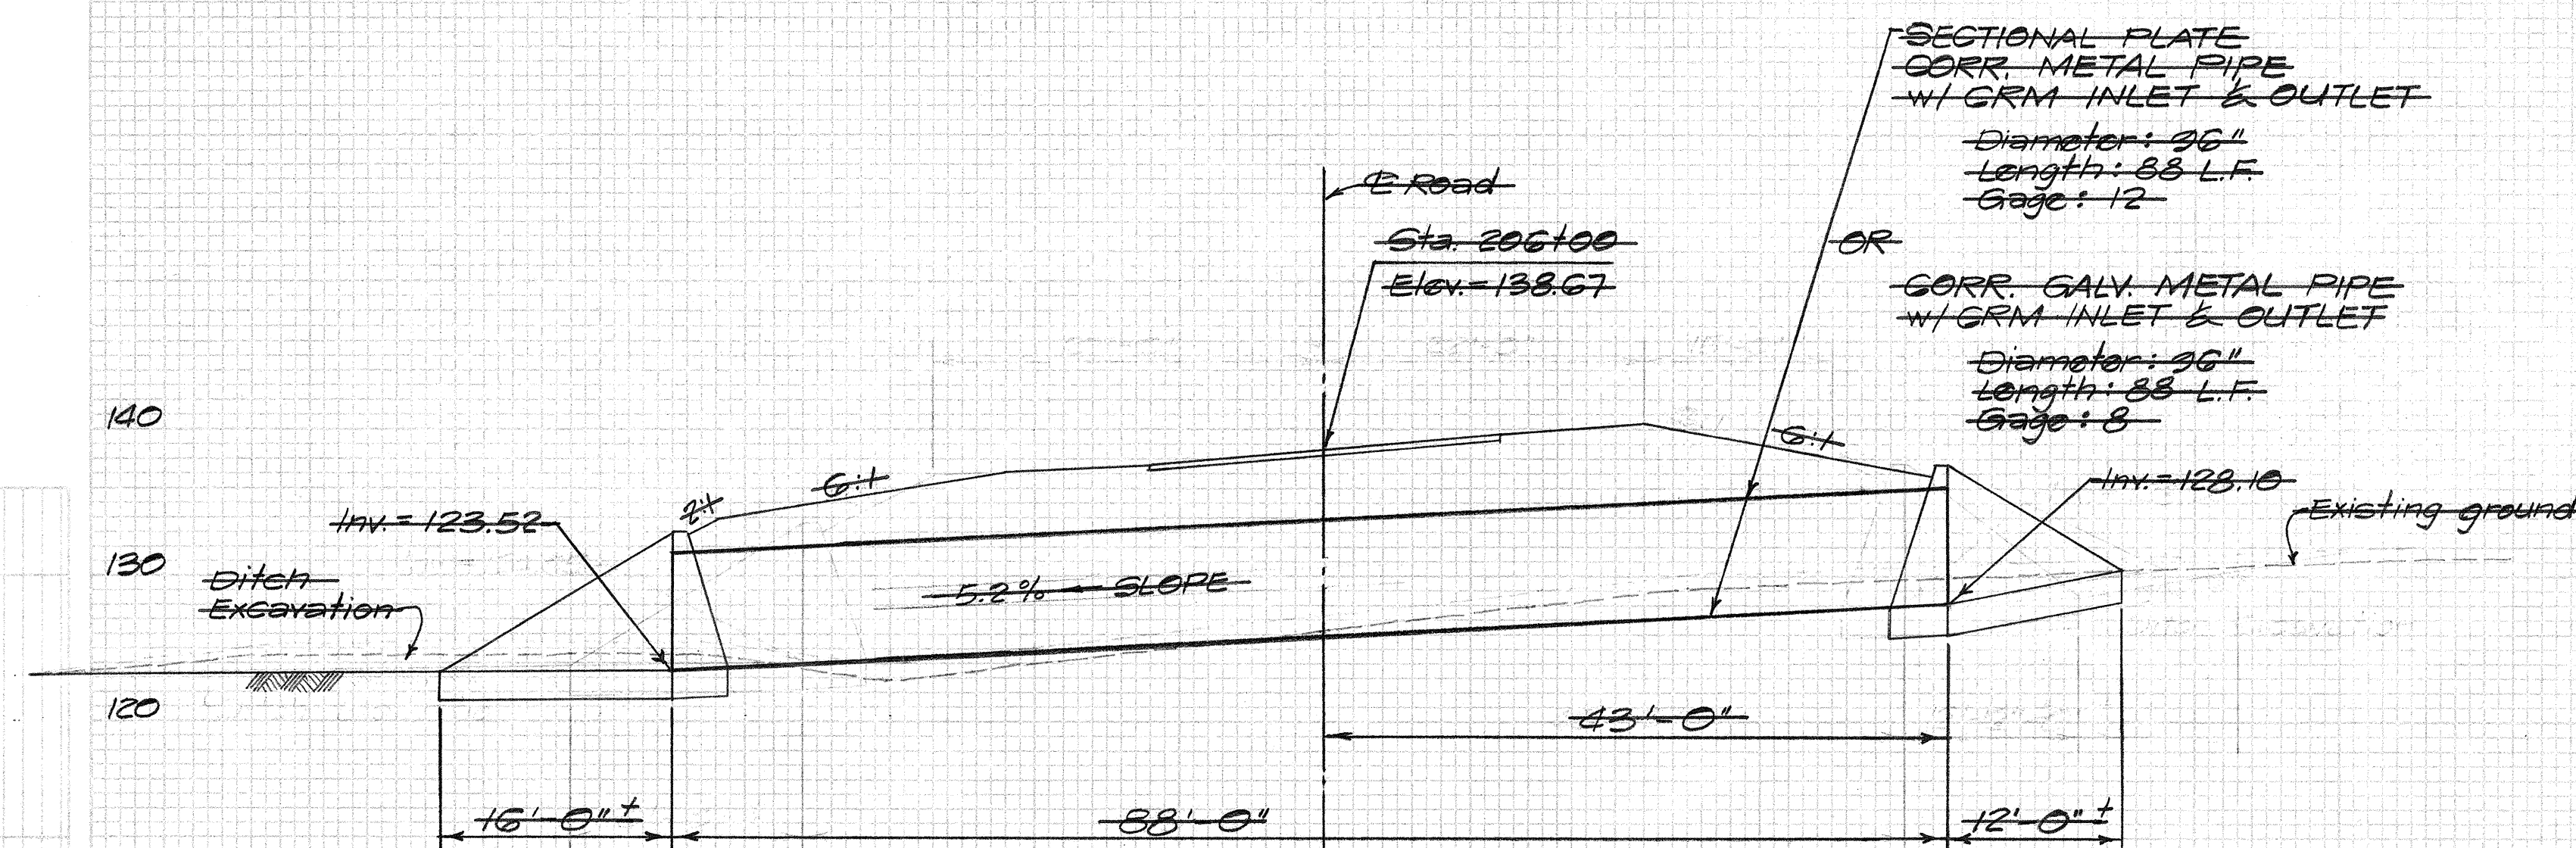



SECTION THROUGH E OF CULVERT
STRUCTURE #13 STA. 206+00
(DELETED BY C.C.O. #2)

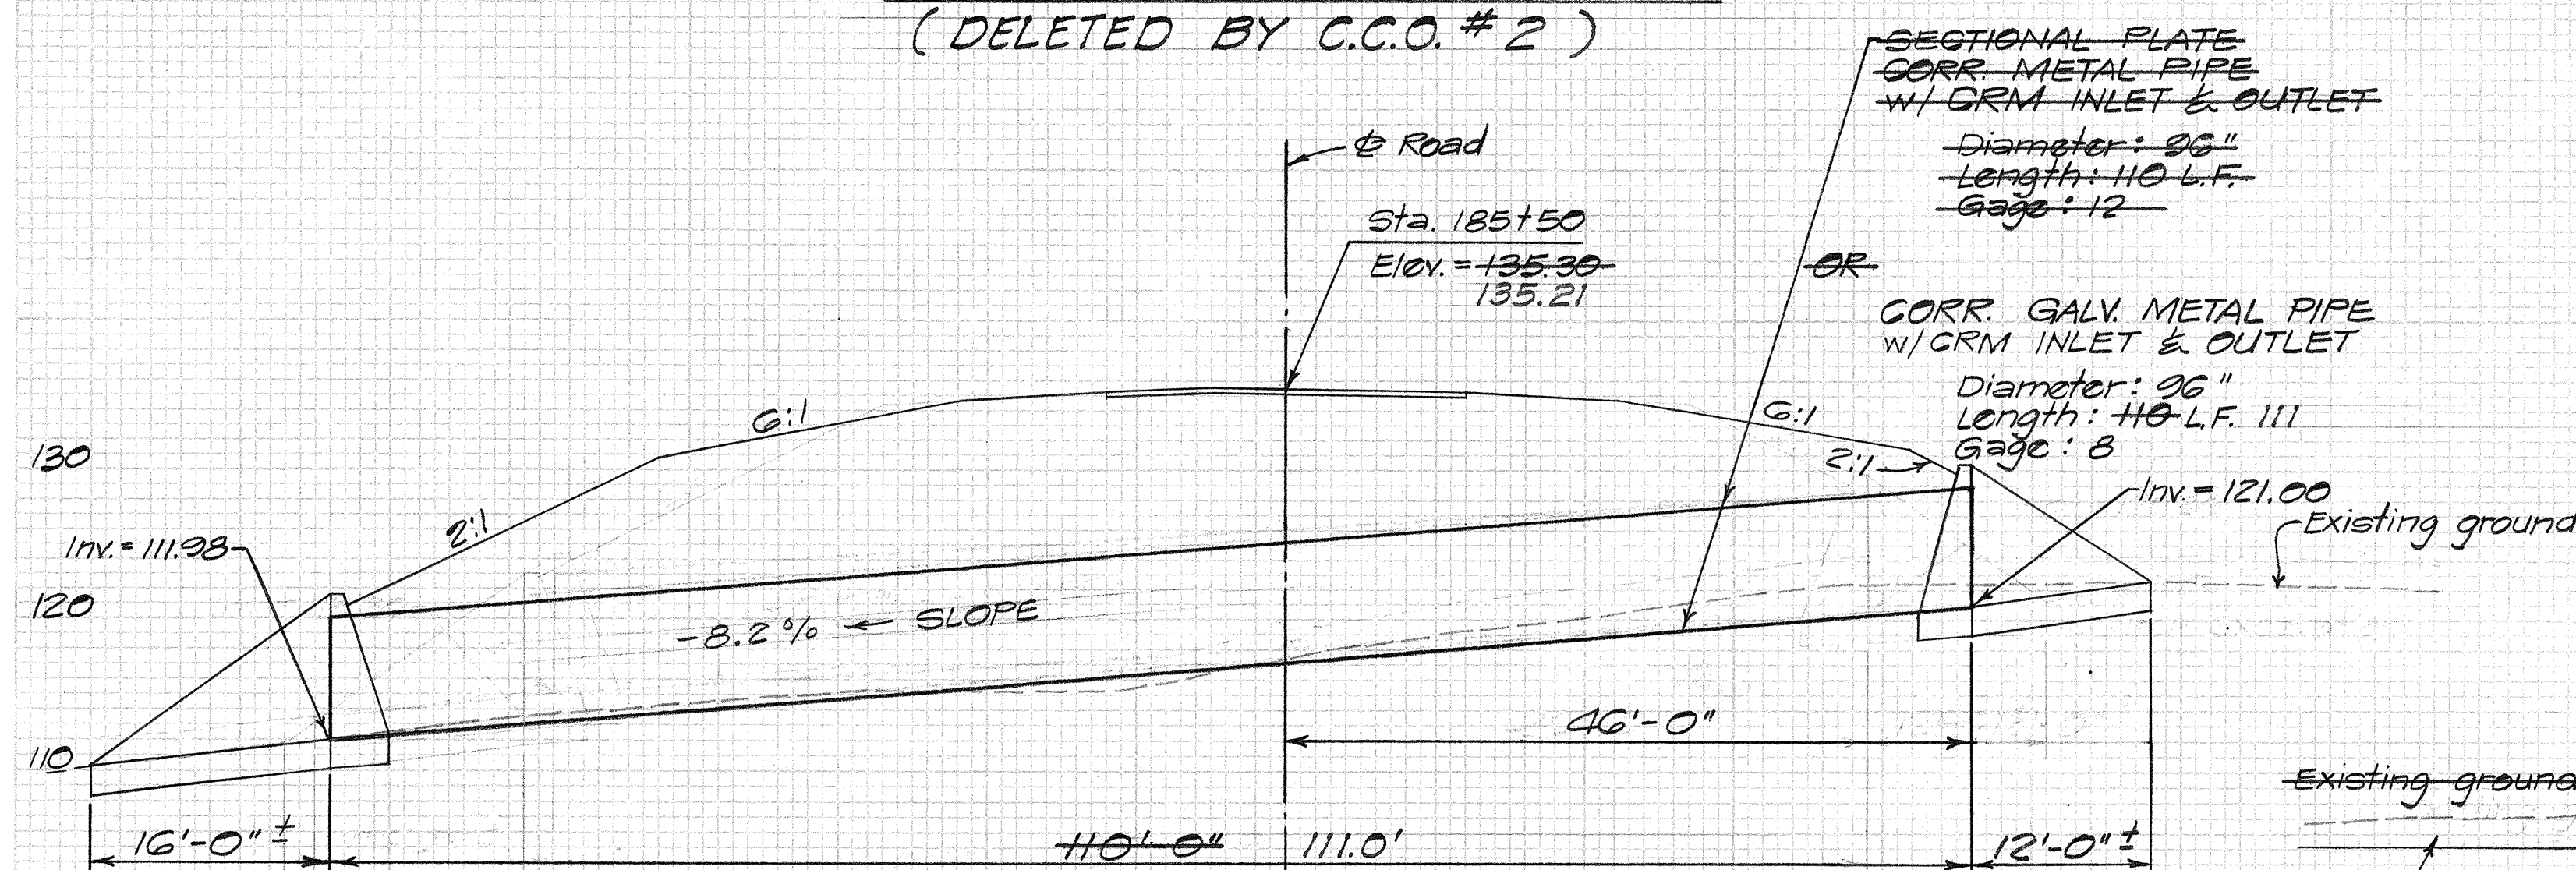

SECTION THROUGH E OF CULVERT
STRUCTURE #12 STA. 185+50

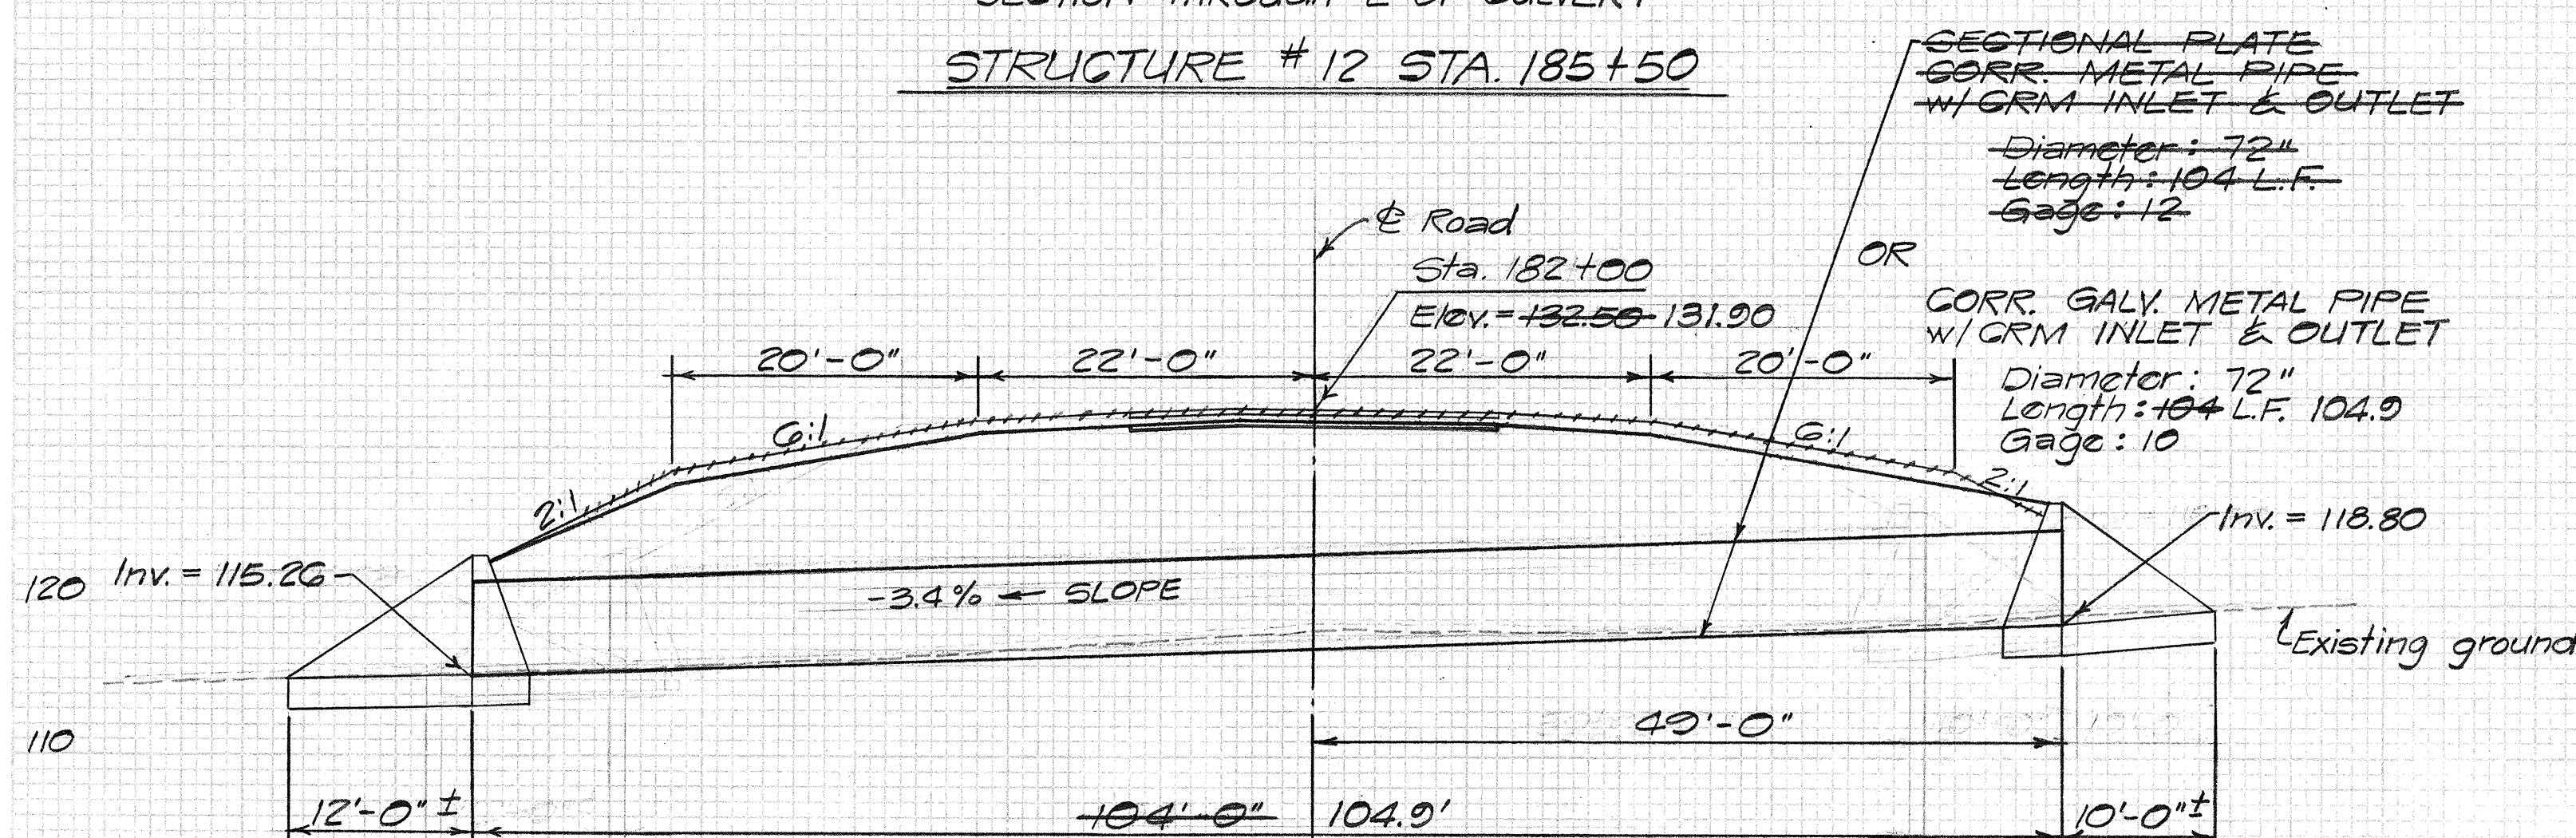


SECTION THROUGH E OF CULVERT
STRUCTURE #11 STA. 182+00

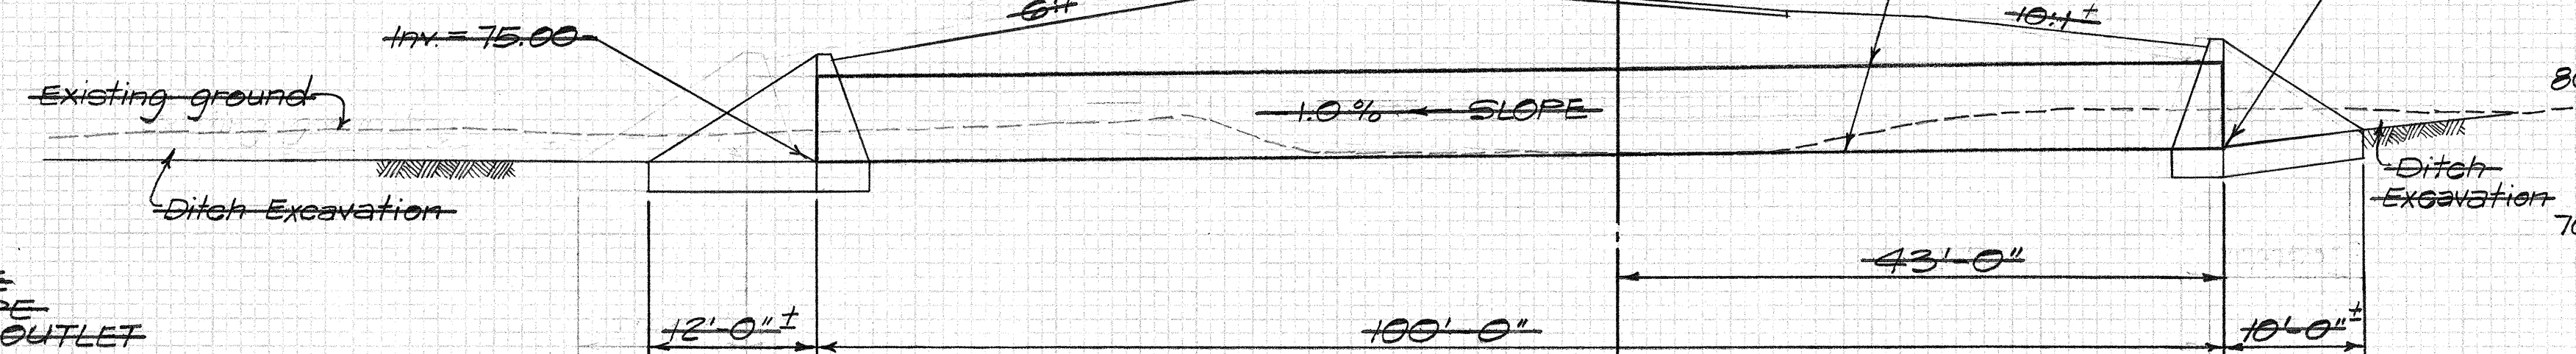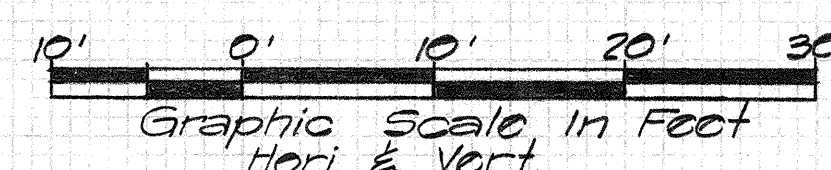

SECTION THROUGH E OF CULVERT
STRUCTURE #14 STA. 241+00
(DELETED BY C.C.O. #2)

THIS WORK WAS PREPARED BY
ME OR UNDER MY SUPERVISION.
Signature

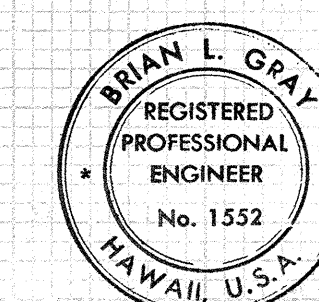

STATE OF HAWAII
DEPARTMENT OF TRANSPORTATION
HIGHWAYS DIVISION

CULVERTS
STRUCTURES #11, 12, 13 & 14
KAILUA - KAWAIHAE ROAD
PROJ. NO. 80-66-7-352

SCALE: AS NOTED

SHEET No. 3 OF 3 SHEETS