

INDEX TO DRAWINGS	
SHEET NO.	DESCRIPTION
C01	TITLE SHEET
2-C02S	TYPICAL ROADWAY SECTIONS
3-12	PLAN & PROFILE
13-15	STRUCTURES - CULVERTS
16	MISCELLANEOUS DETAILS
17	MASS DIAGRAM
C018S-C031S	CROSS SECTIONS
*17S-1-17S-29	CROSS SECTIONS

*Cross Sections tracings 17S-1 to 17S-29
received with field posted "As Built" plans

STATE OF HAWAII
DEPARTMENT OF TRANSPORTATION
HIGHWAYS DIVISION

"AS BUILT" PLANS FOR
KAILUA-KAWAIHAE ROAD


HONOKOHAU TO KEAHOLE
(GRADING)

PROJECT NO. BD 66-7-352

DISTRICT OF NORTH KONA
ISLAND OF HAWAII


SCALES

PLAN ----- 1 INCH = 100 FT.
PROFILE ----- HOR. 1 INCH = 100 FT.
VER. 1 INCH = 10 FT.

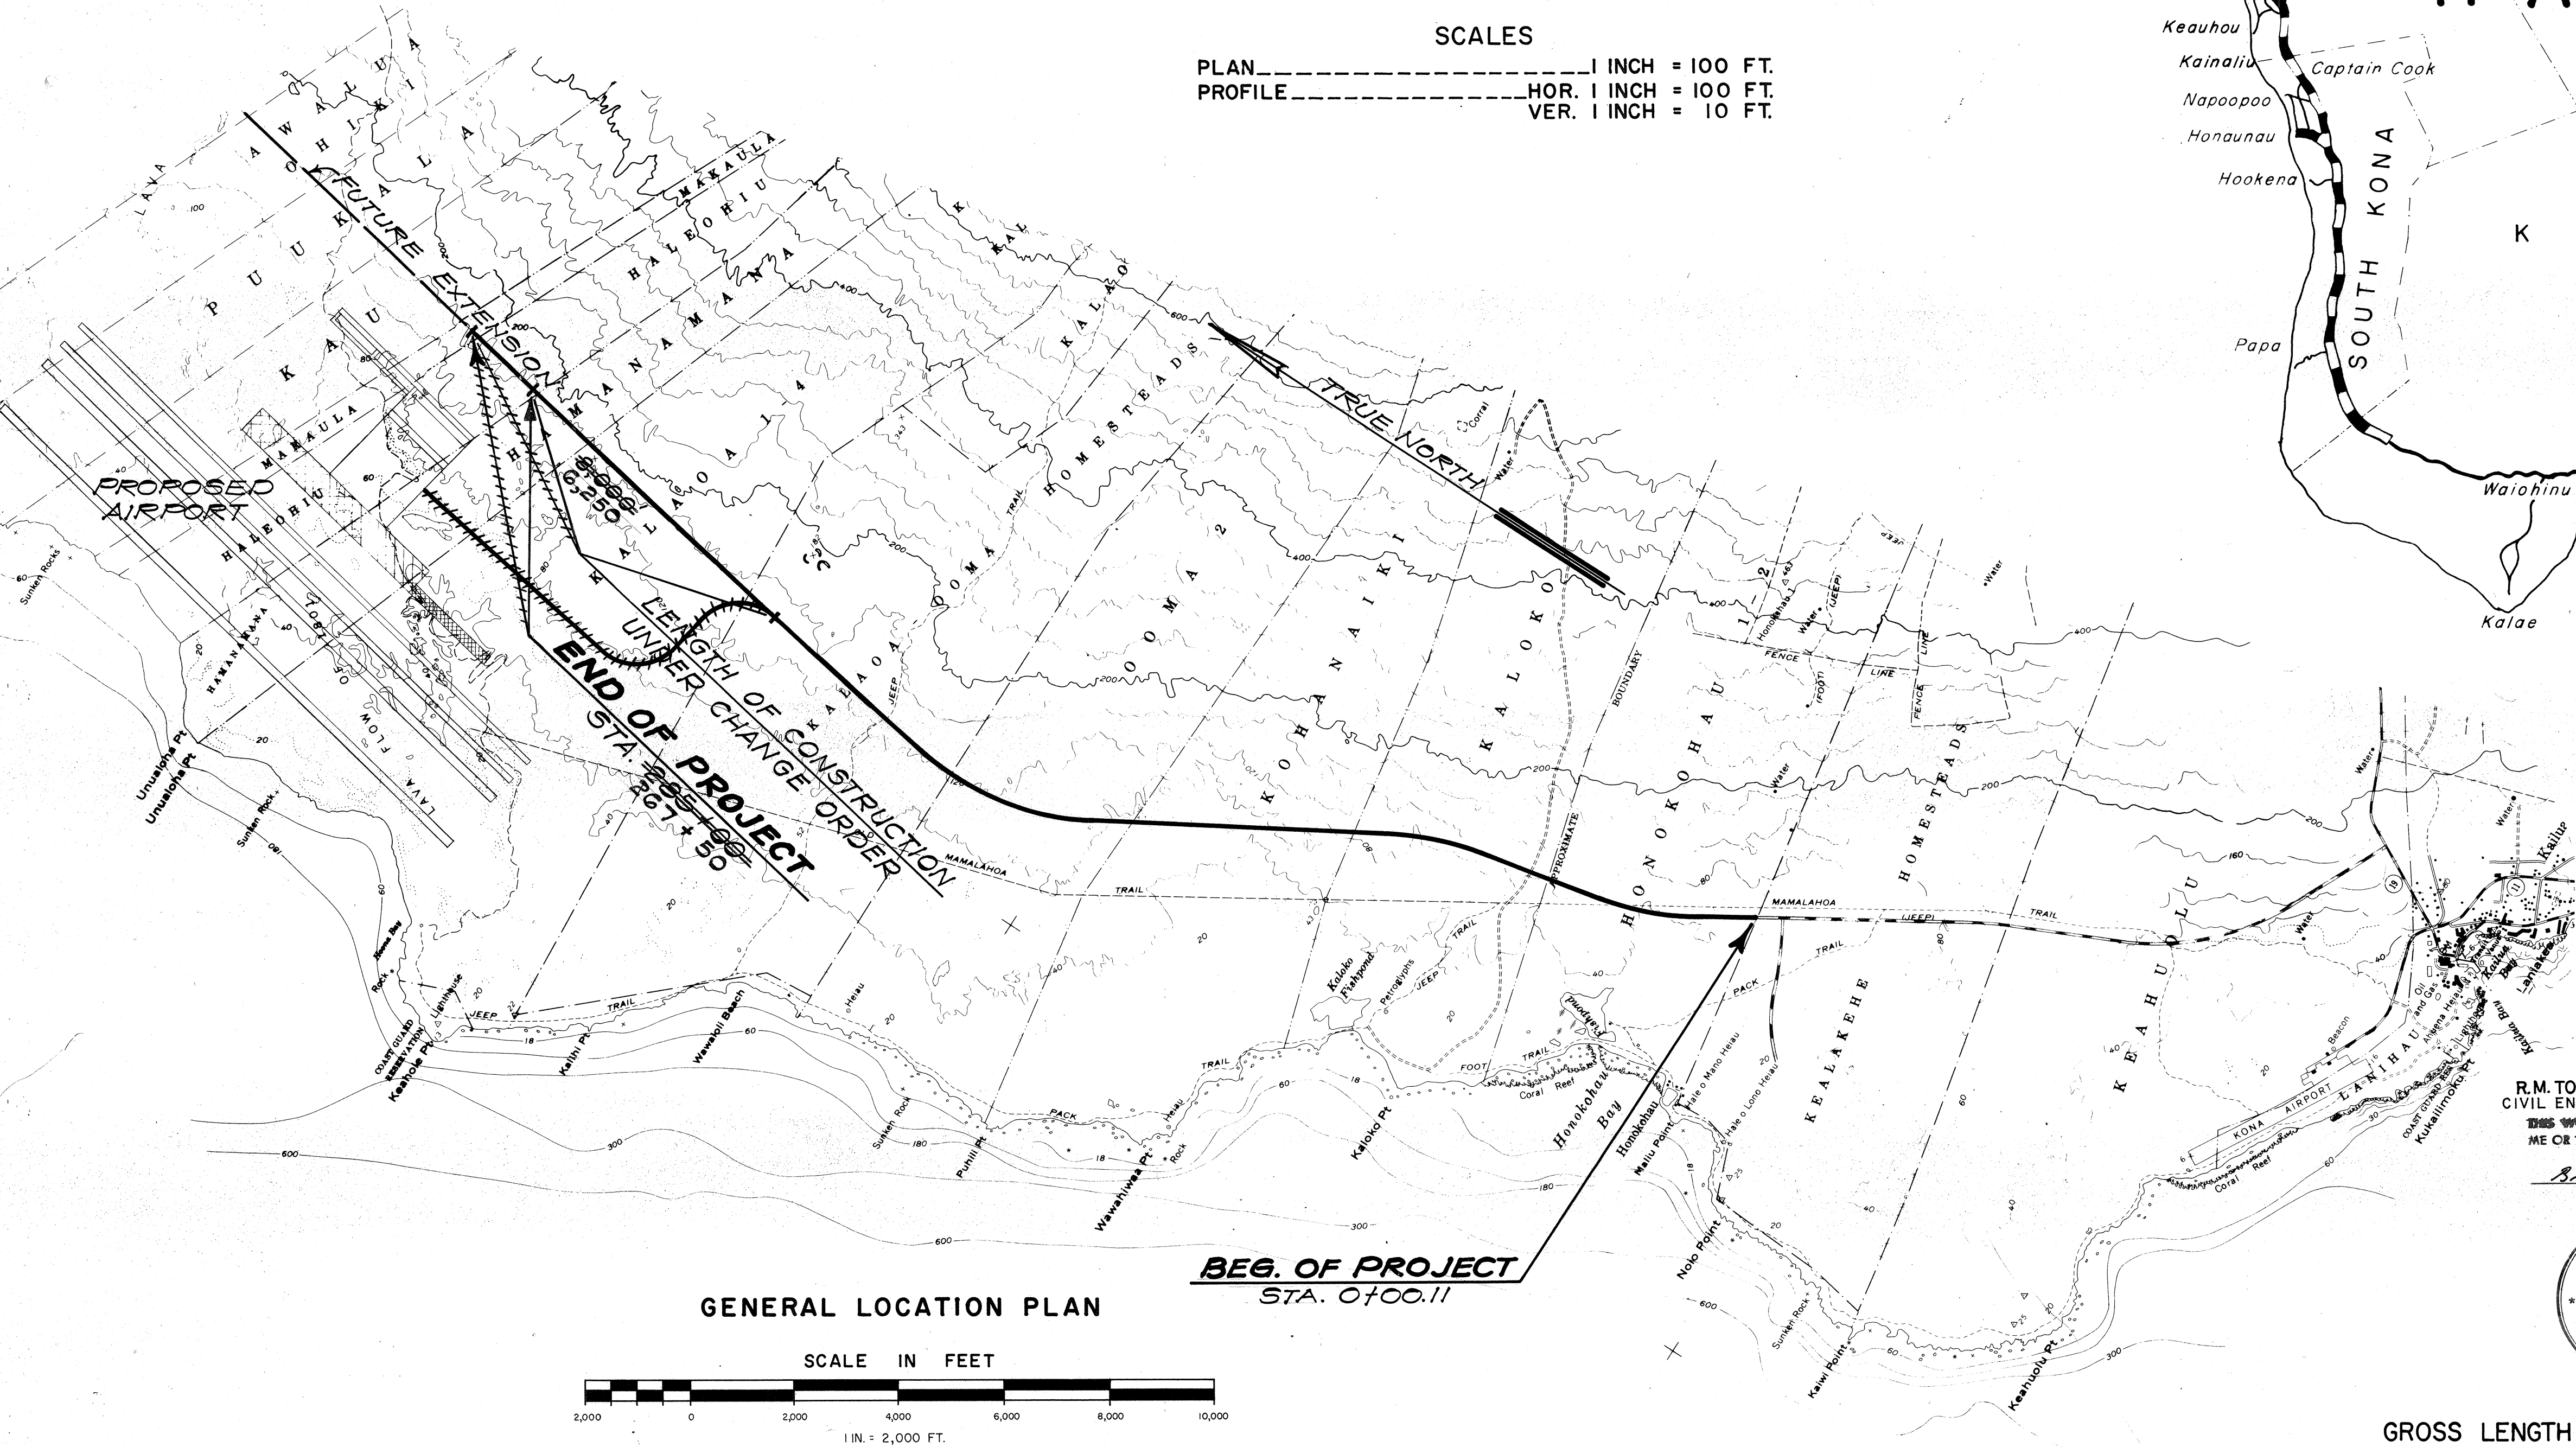


GENERAL LOCATION PLAN

SCALE IN FEET

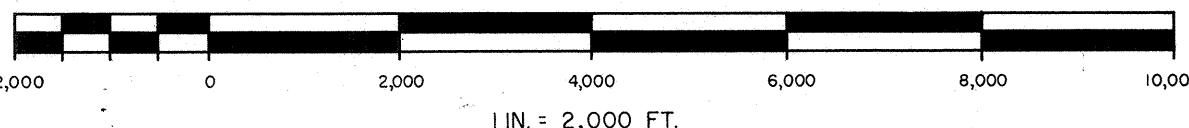

Revised : Feb. 7, 1969

STATE	PROJECT NO.	FISCAL YEAR	SHEET NO.	TOTAL SHEETS
HAWAII	BD 66-7-352	1969	1	17

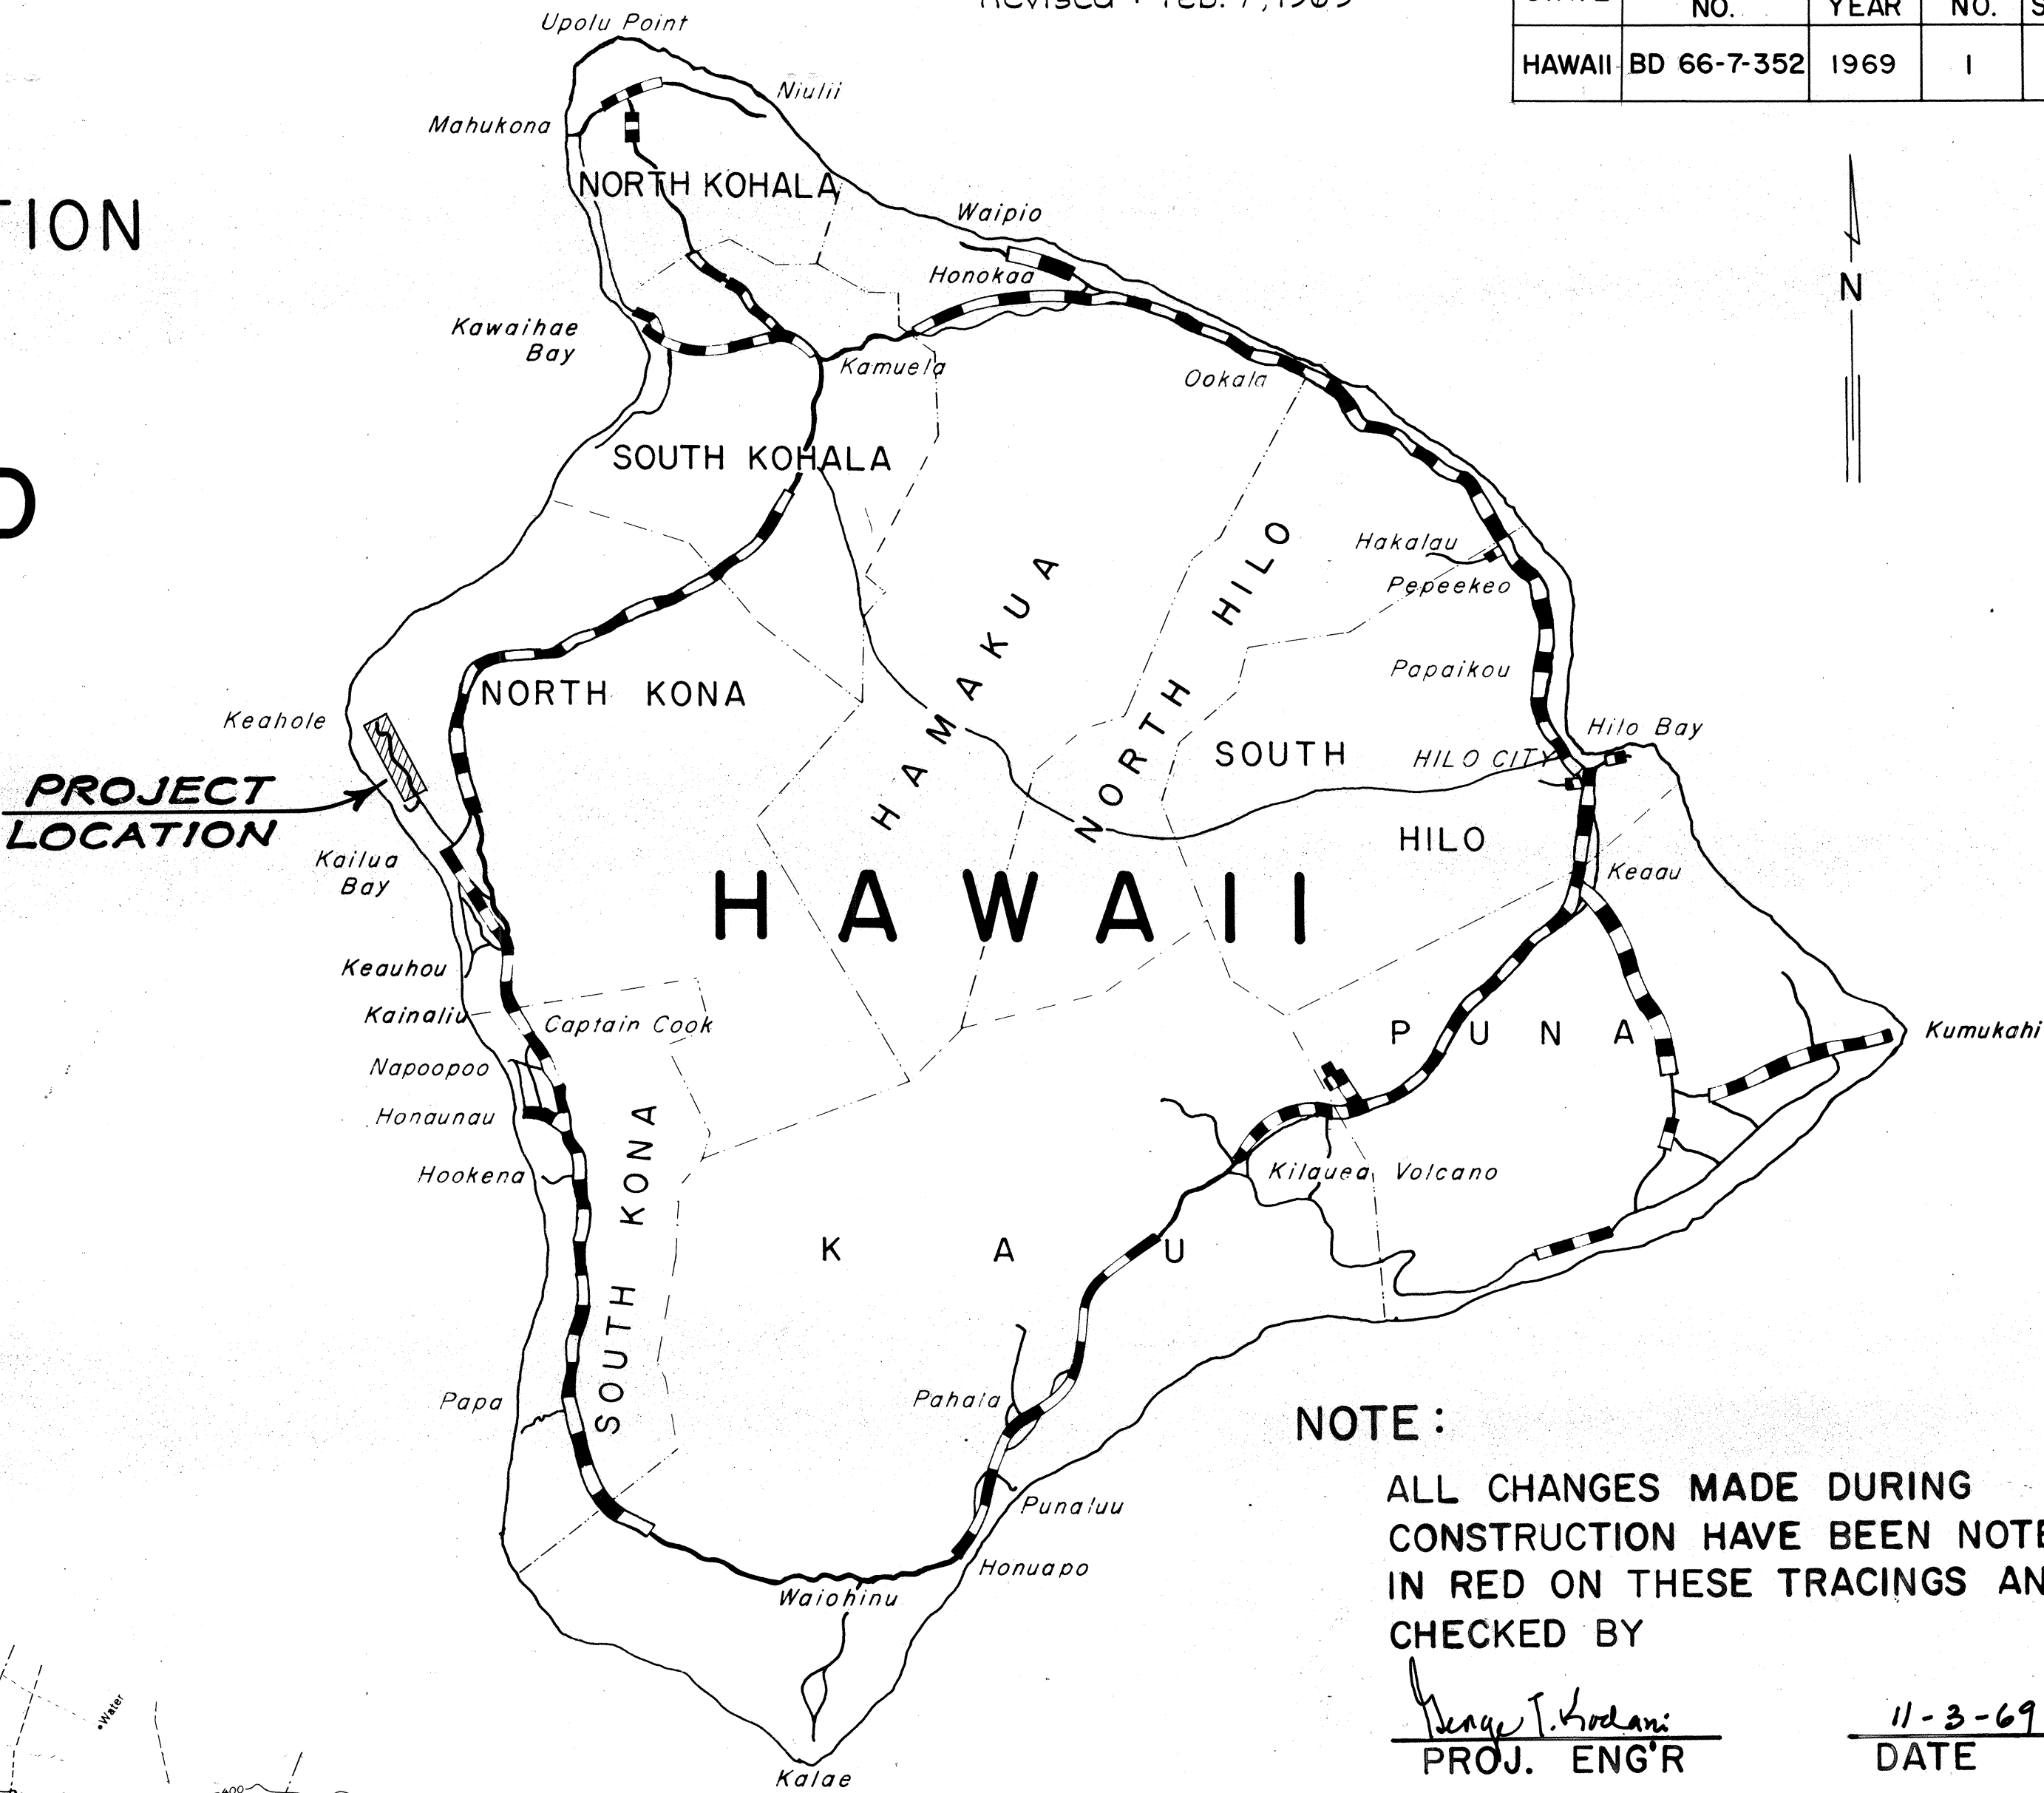

NOTE:
ALL CHANGES MADE DURING
CONSTRUCTION HAVE BEEN NOTED
IN RED ON THESE TRACINGS AND
CHECKED BY
George J. Gordon
PROJ. ENGR
11-3-69
DATE

Federal Aid Projects Previously Constructed Or Under Construction

DESIGN CLASSIFICATION

CURRENT ADT (1968)	1570
INTERIM ADT (1978)	3200
DESIGN ADT (1988)	4800
DHV	480
D	55/45
T	10 %
T24	10 %
V	70 MPH

R.M. TOWILL CORPORATION
CIVIL ENGINEERS & SURVEYORS
THIS WORK WAS PREPARED BY
ME OR UNDER MY SUPERVISION.

Brian L. Gray
Signature



DEPARTMENT OF TRANSPORTATION
STATE OF HAWAII

APPROVED:
John B. McArthur
DIR. OF TRANSPORTATION
4/23/68
DATE

GROSS LENGTH OF PROJECT - 5.066 MILES

DESIGNED BY: LEO I. FLEMING

C01