

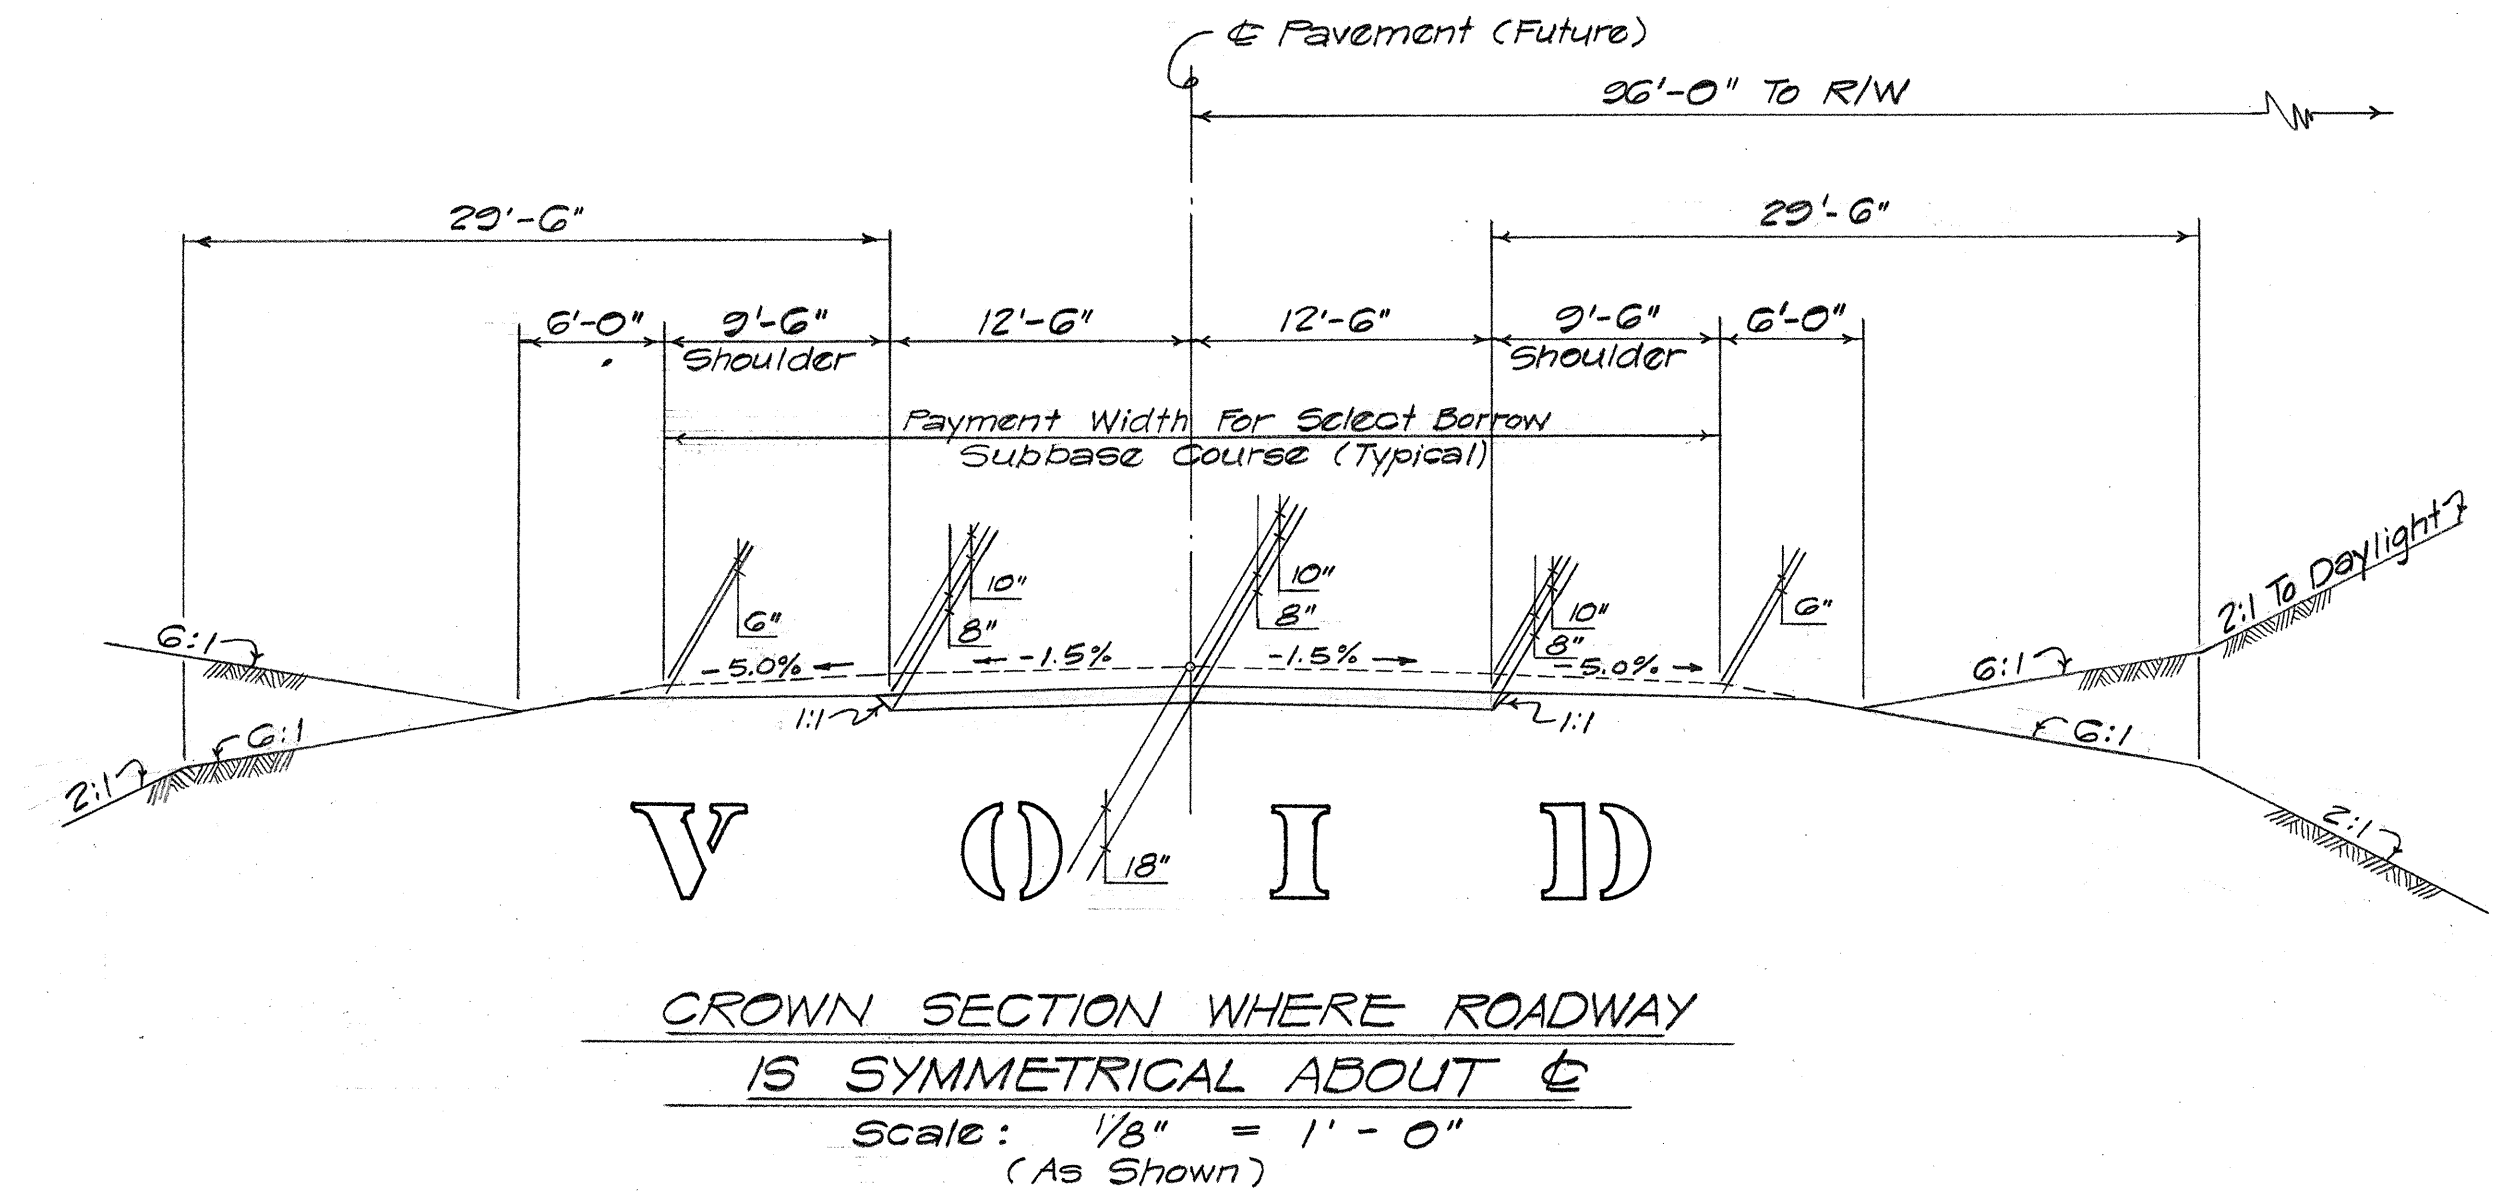
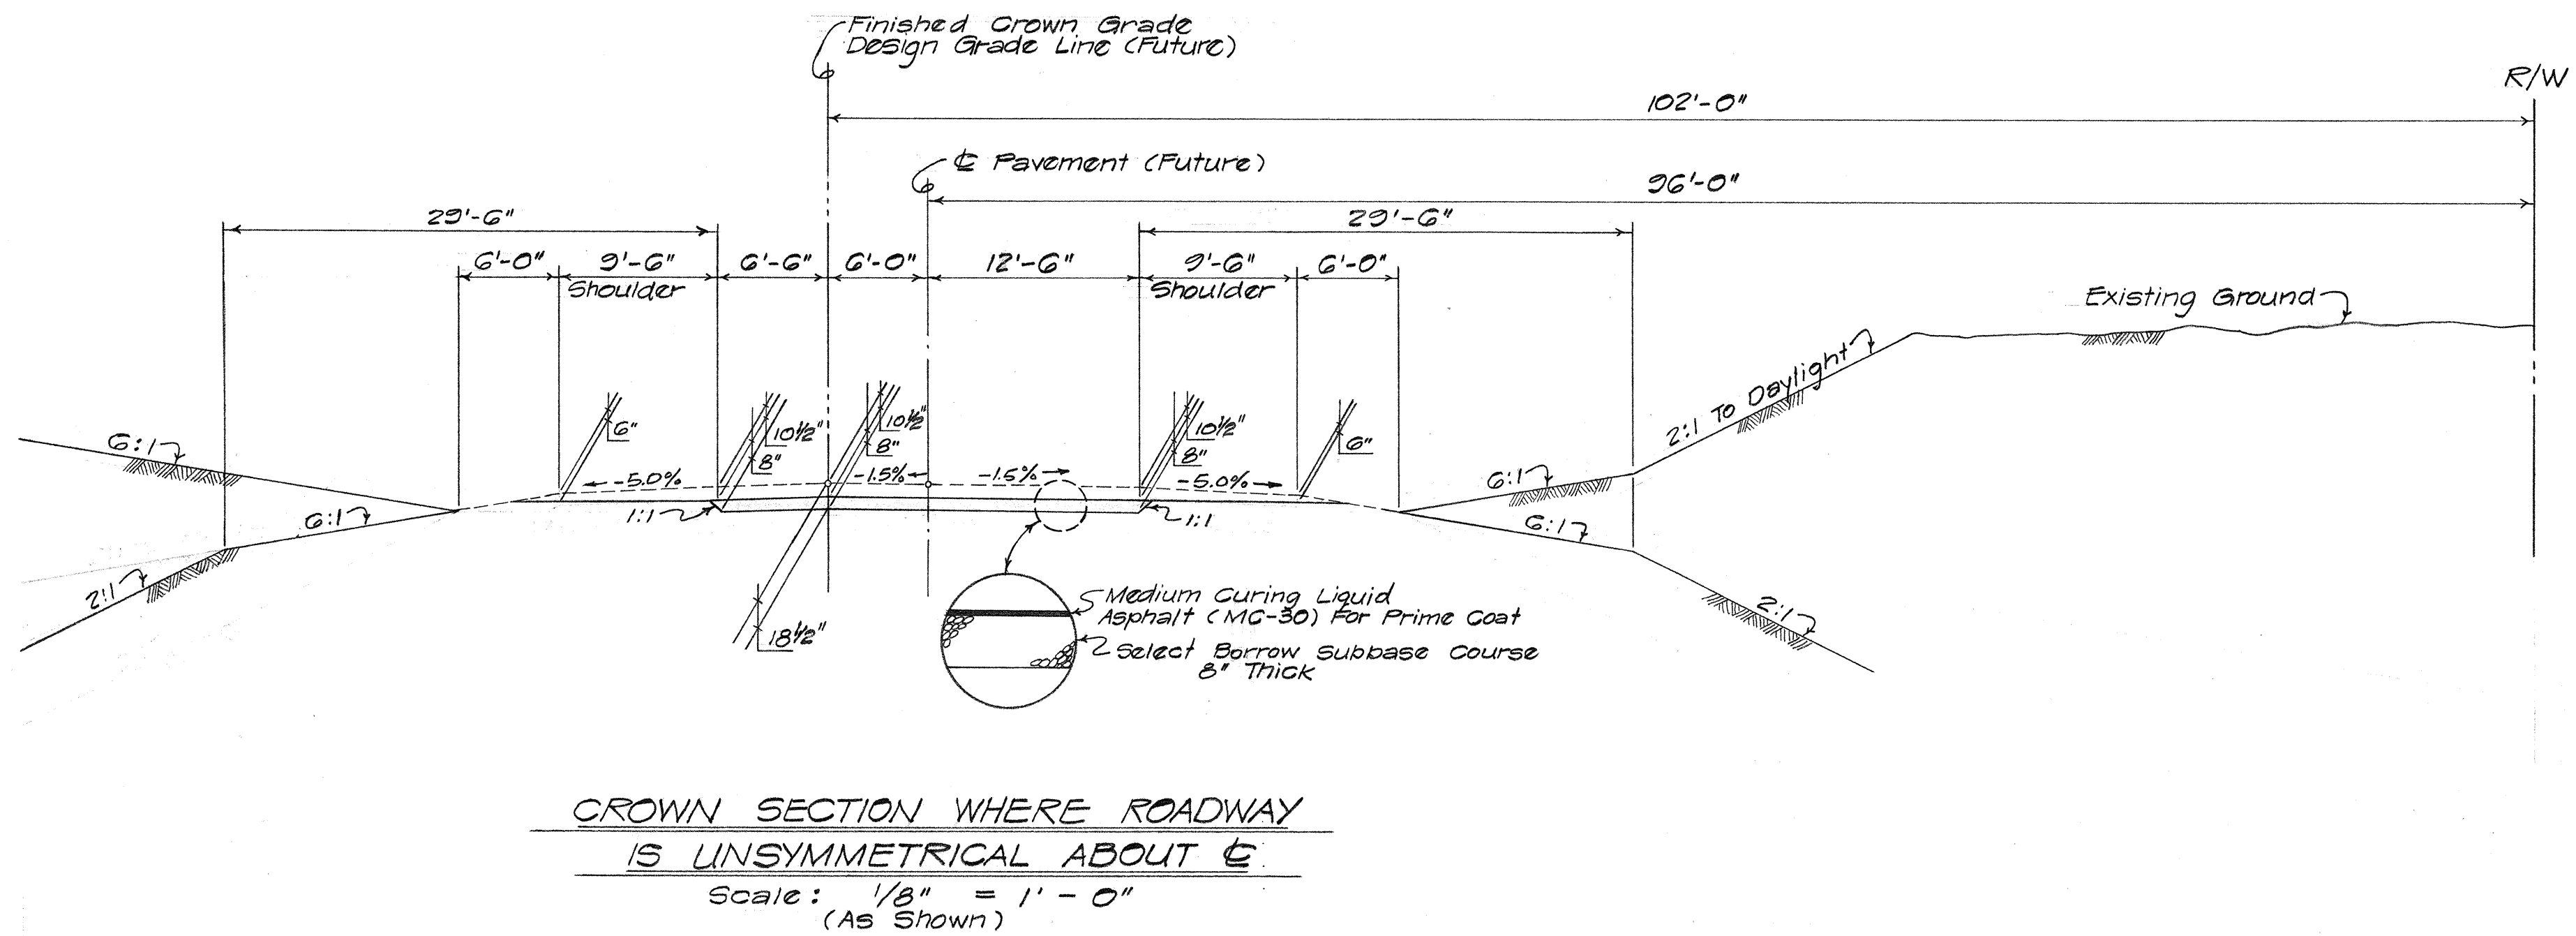
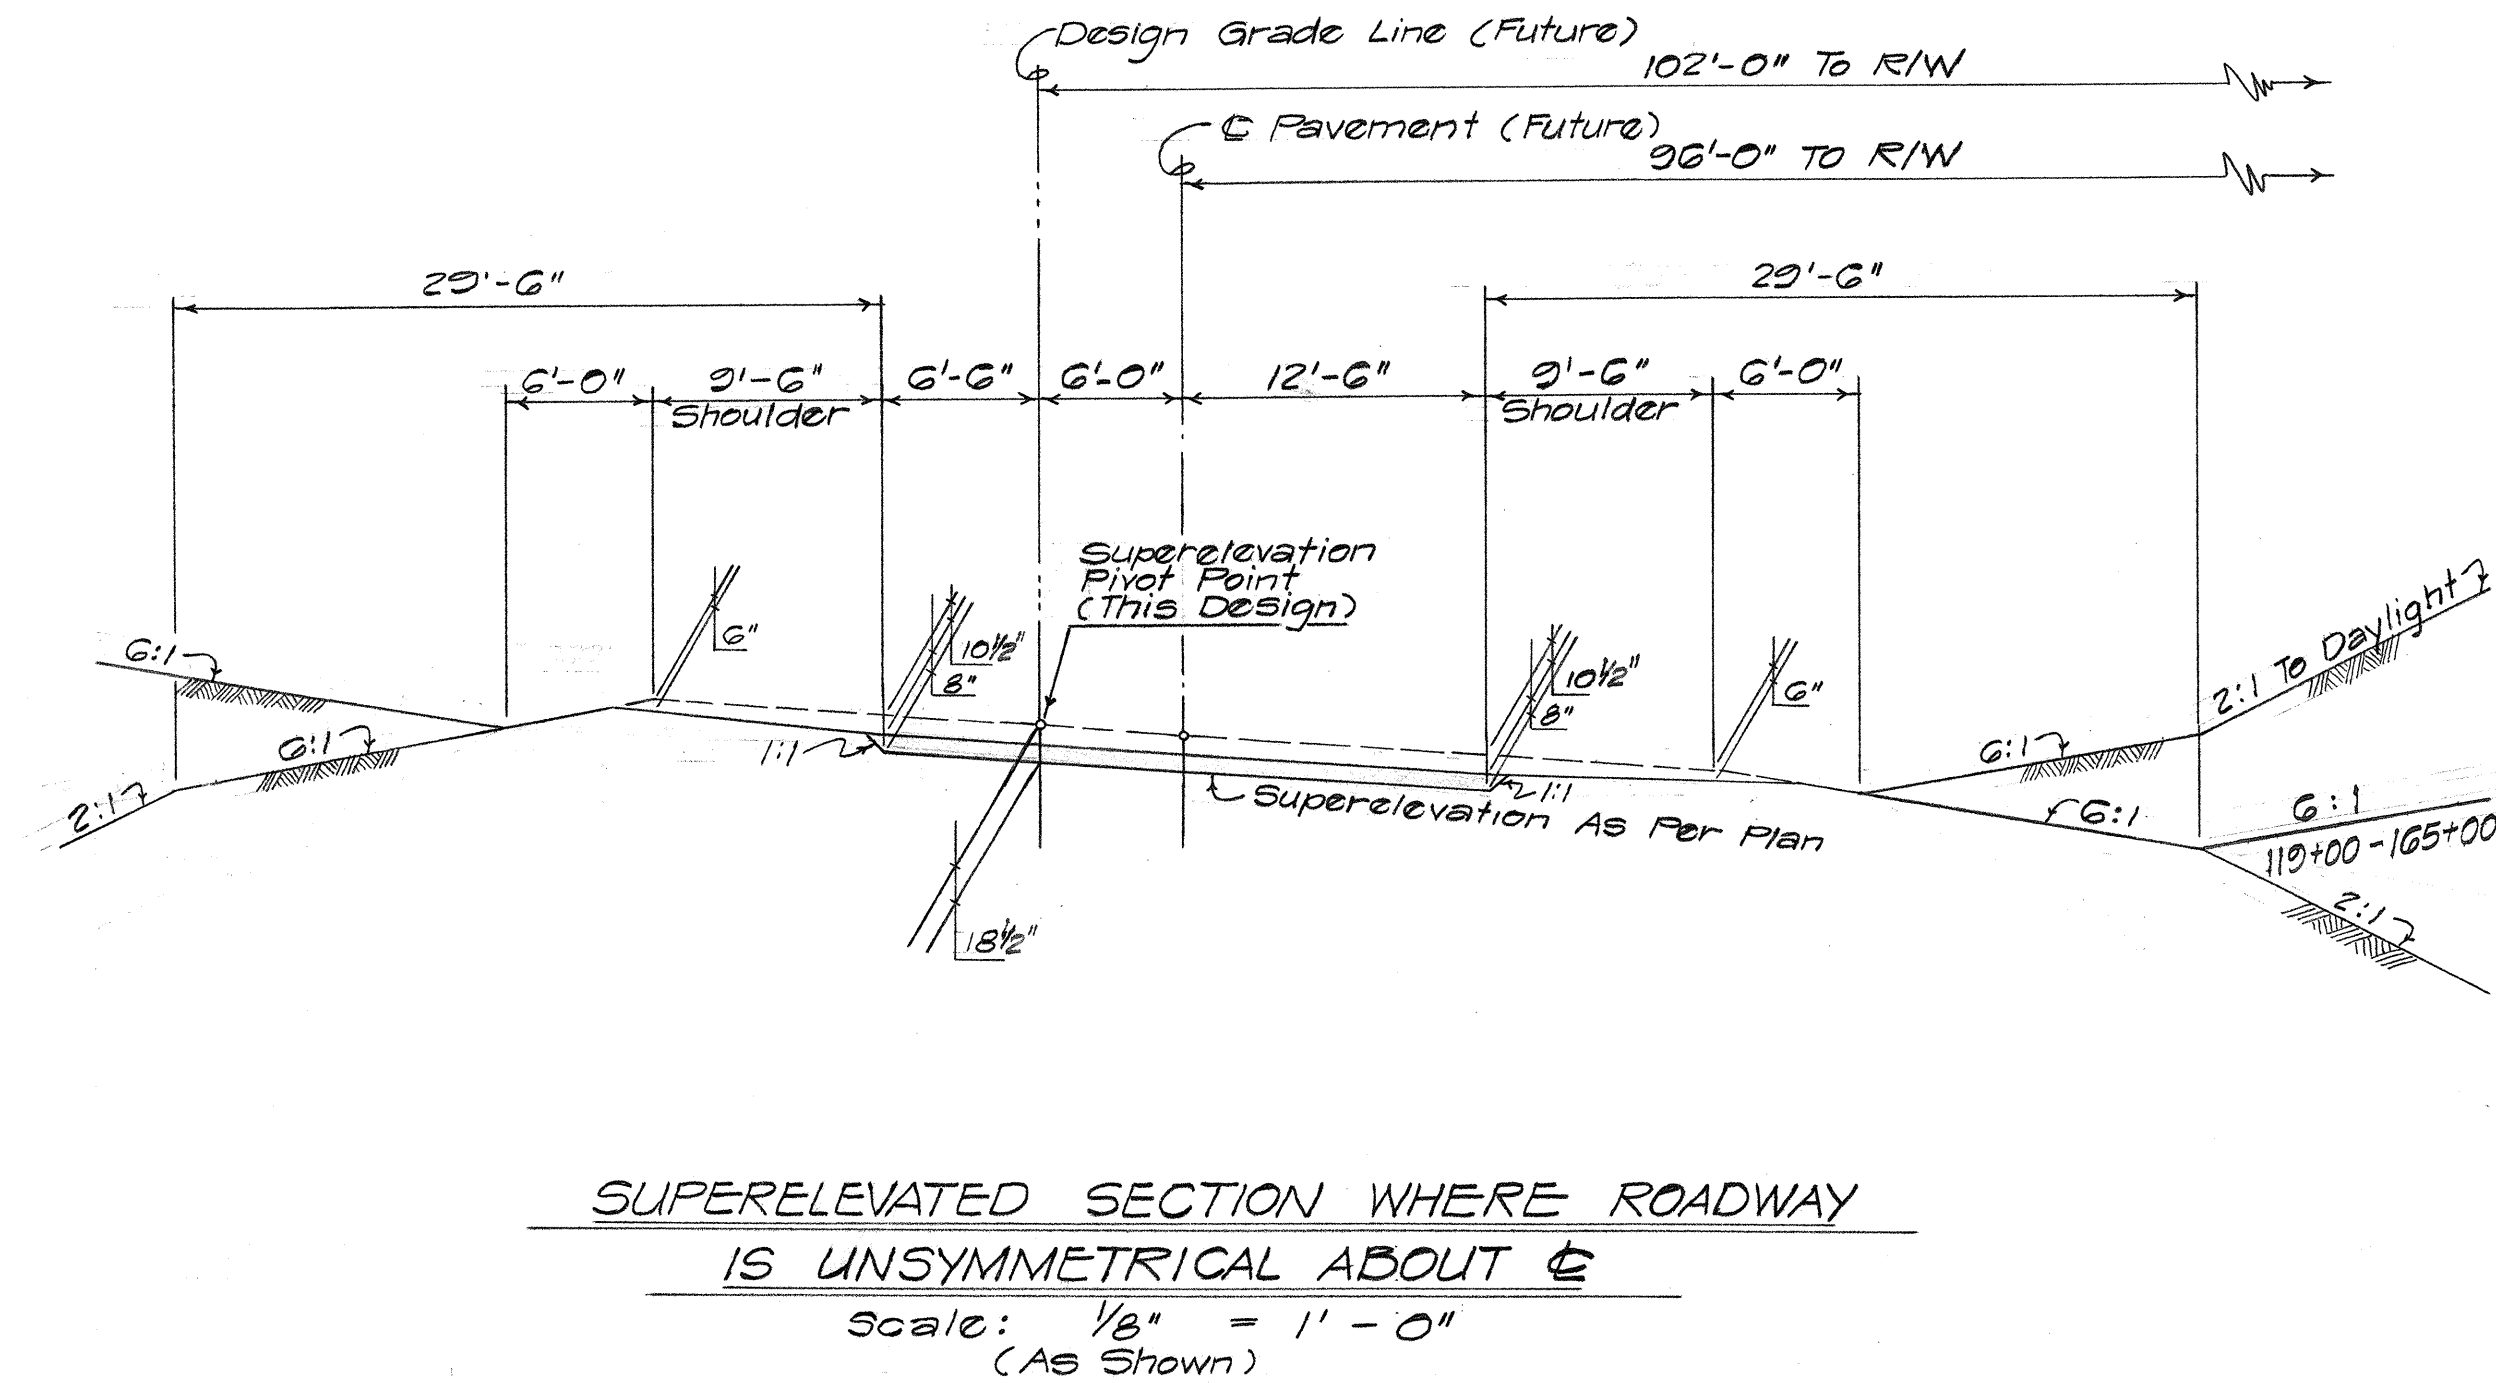
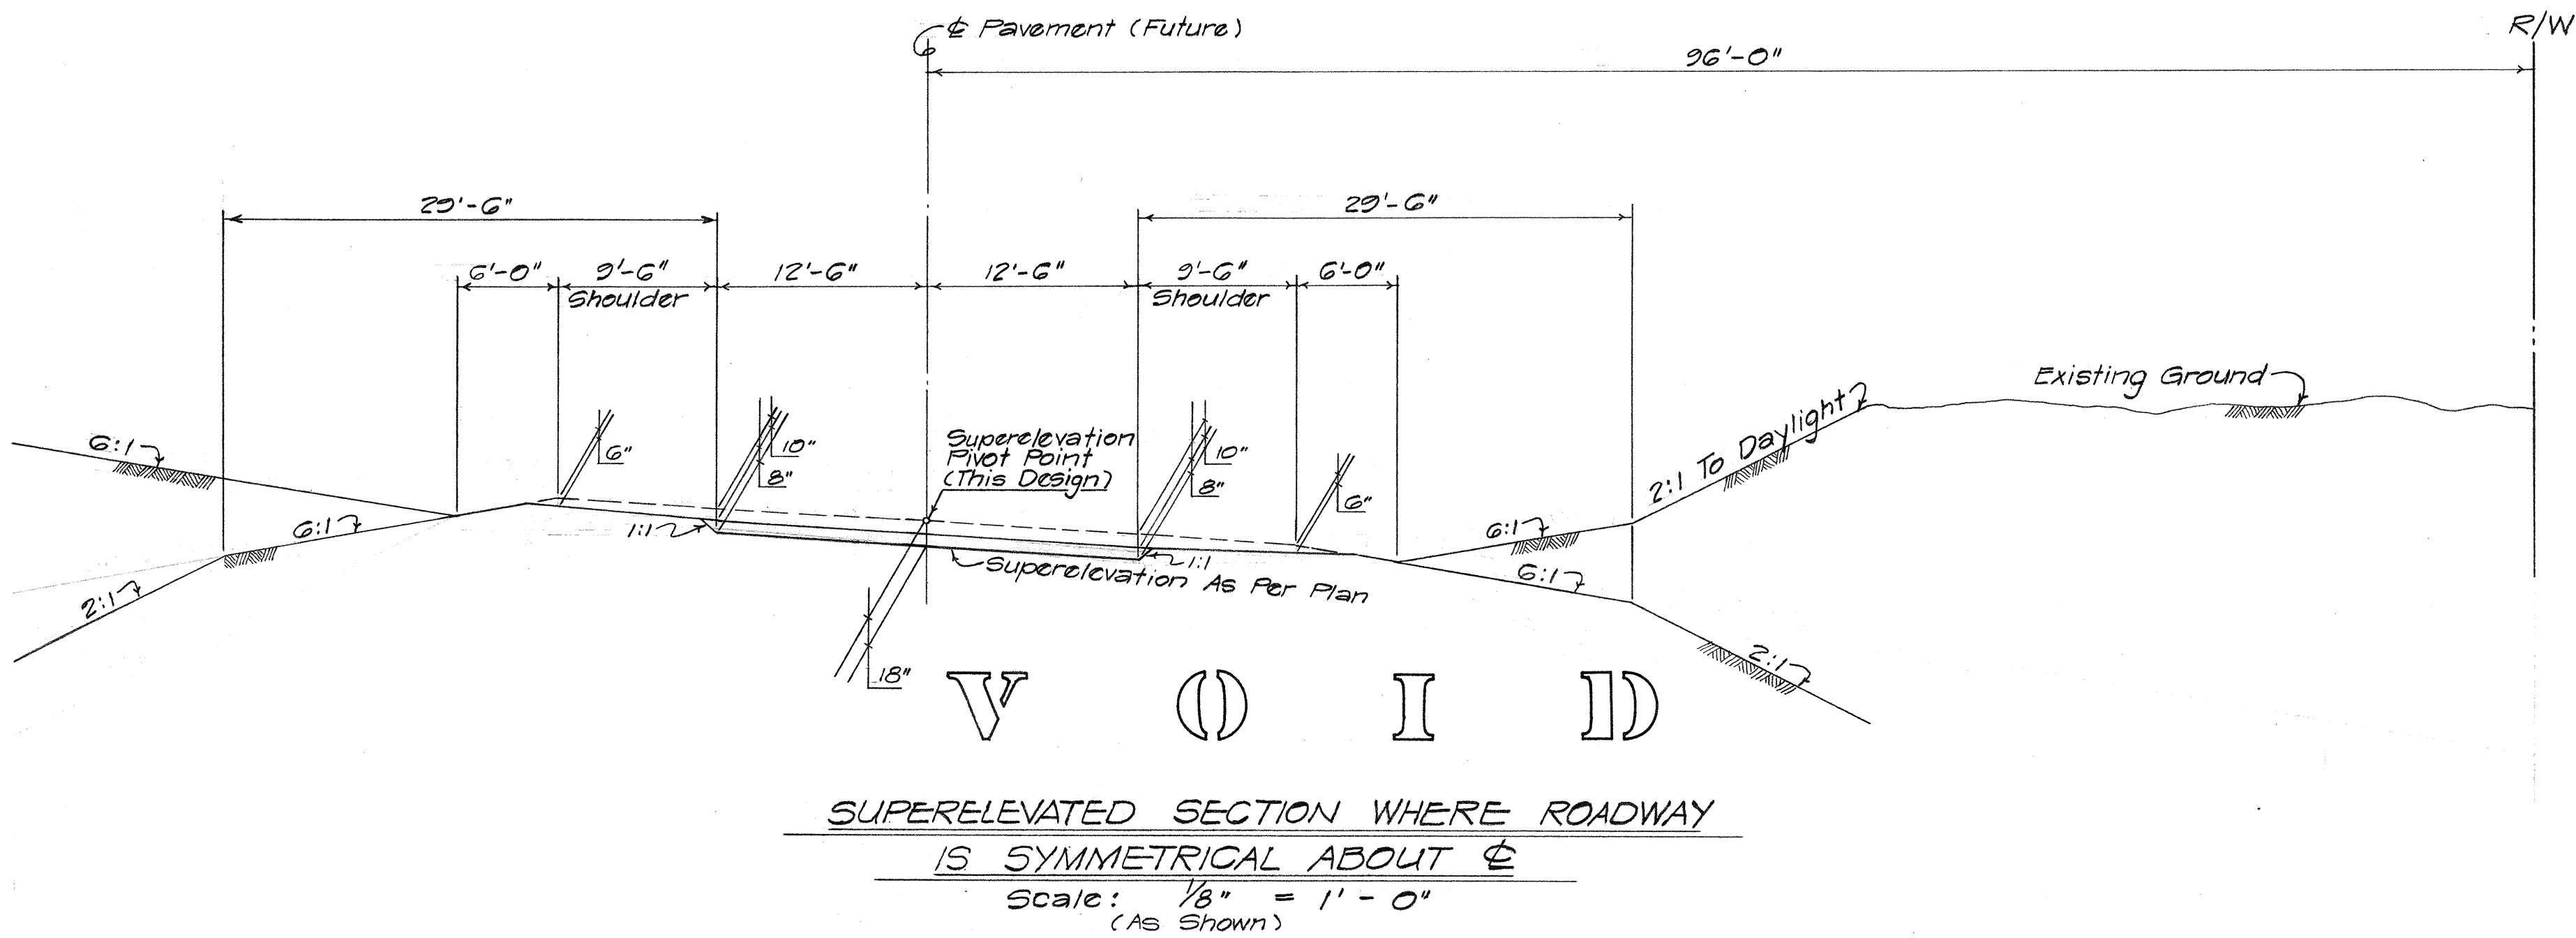


STATE	PROJECT NO.	FISCAL YEAR	SHEET NO.	TOTAL SHEETS
HAWAII	BD-66-7-352		2	17

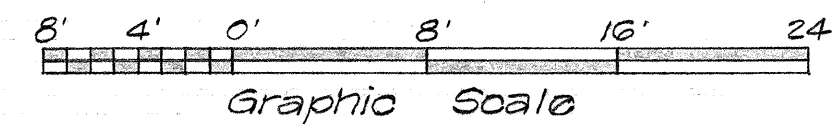

NOTE:
In General, 2:1 Fill Slopes Occur Beyond 42' From C Pavement

THIS WORK WAS PREPARED BY
ME OR UNDER MY SUPERVISION,
Brian L. Gray
Signature


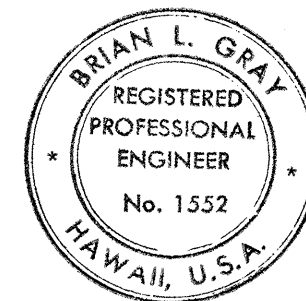


STATE OF HAWAII
DEPARTMENT OF TRANSPORTATION
HIGHWAYS DIVISION

TYPICAL ROADWAY
SECTIONS
KAILUA-KAWAIHAE ROAD
PROJ. NO. BD 66-7-352

SCALE: AS NOTED
SHEET No. 1 OF 1 SHEETS

Date : Feb. 7, 1969

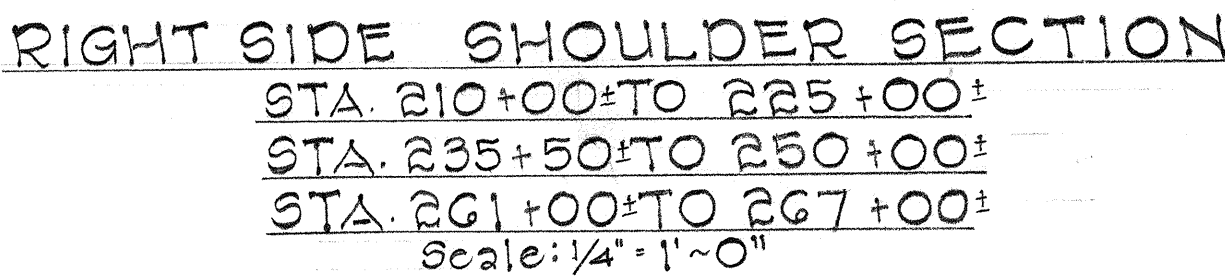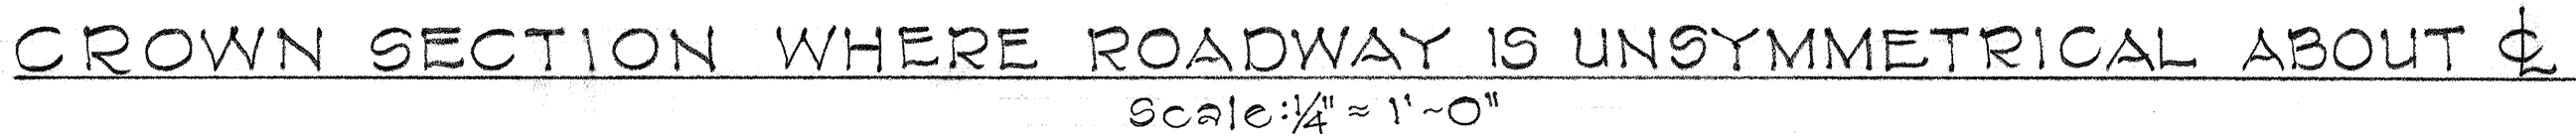

STATE OF HAWAII
DEPARTMENT OF TRANSPORTATION
HIGHWAYS DIVISION

TYPICAL ROADWAY
SECTIONS

KAILUA ~ KAWAIHAE ROAD
PROJ. NO. BD 66 ~ 7 - 352

Scale: As Noted. Jan. 1969

SHEET No. OF SHEETS

C O 2 S

ORIGINAL PLAN	SURVEY PLOTTED BY.....	DATE.....
NOTE BOOK	DRAWN BY.....	".....
	TRACED BY.....	".....
	DESIGNED BY.....	".....
	QUANTITIES BY.....	".....
No.....	CHECKED BY.....	".....