

INDEX TO DRAWINGS	
SHEET NO.	DESCRIPTION
1	TITLE SHEET
2	TYPICAL PAVING SECTIONS
3-12	PLAN & PROFILE
13-20	STANDARD DETAILS
21	DESTINATION SIGNS
* 22-31	LANDSCAPE PLANTING


* Work shown on Shi. Nos 30 & 31 were deleted from this project.

STATE OF HAWAII
DEPARTMENT OF TRANSPORTATION
HIGHWAYS DIVISION



"AS BUILT" PLANS FOR
KAILUA - KAWAIHAE ROAD
HONOKOHAU TO KEAHOLE
(PAVING)

PROJECT NO. BD 69-352
DISTRICT OF NORTH KONA
ISLAND OF HAWAII

SCALES
PLAN ----- 1 INCH = 100 FT.
PROFILE ----- HOR. 1 INCH = 100 FT.
VER. 1 INCH = 10 FT.

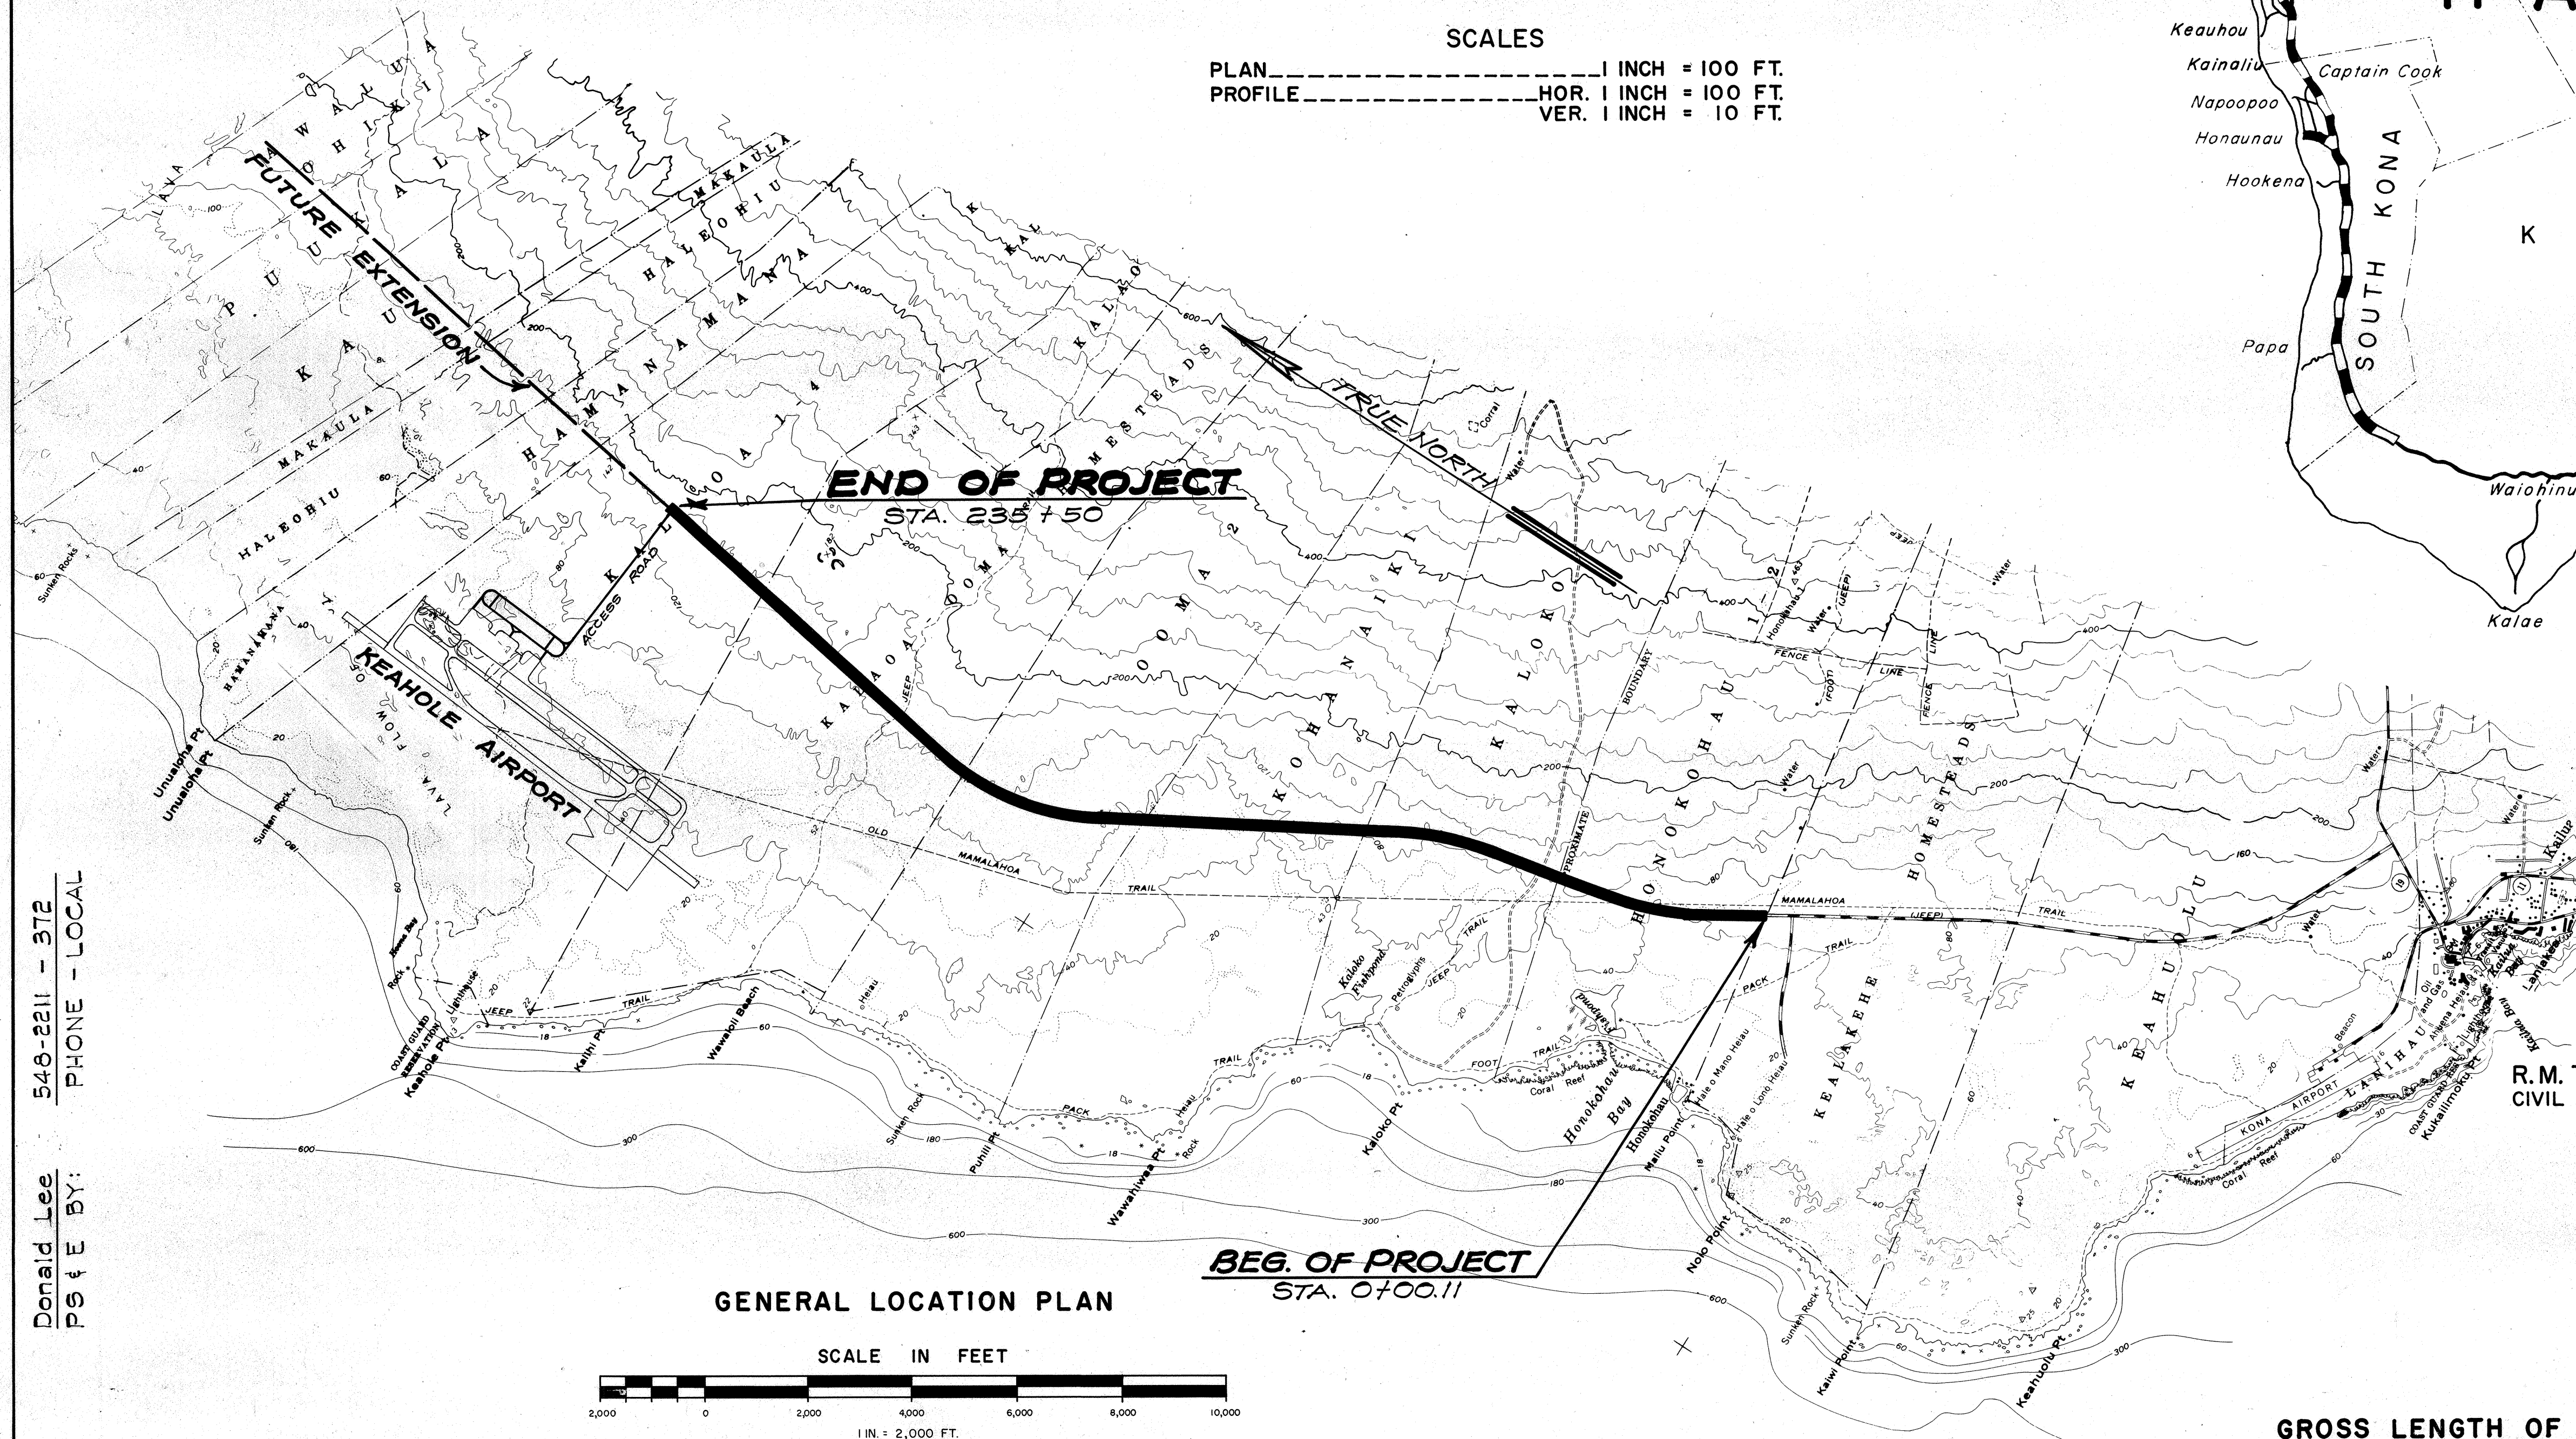


GENERAL LOCATION PLAN

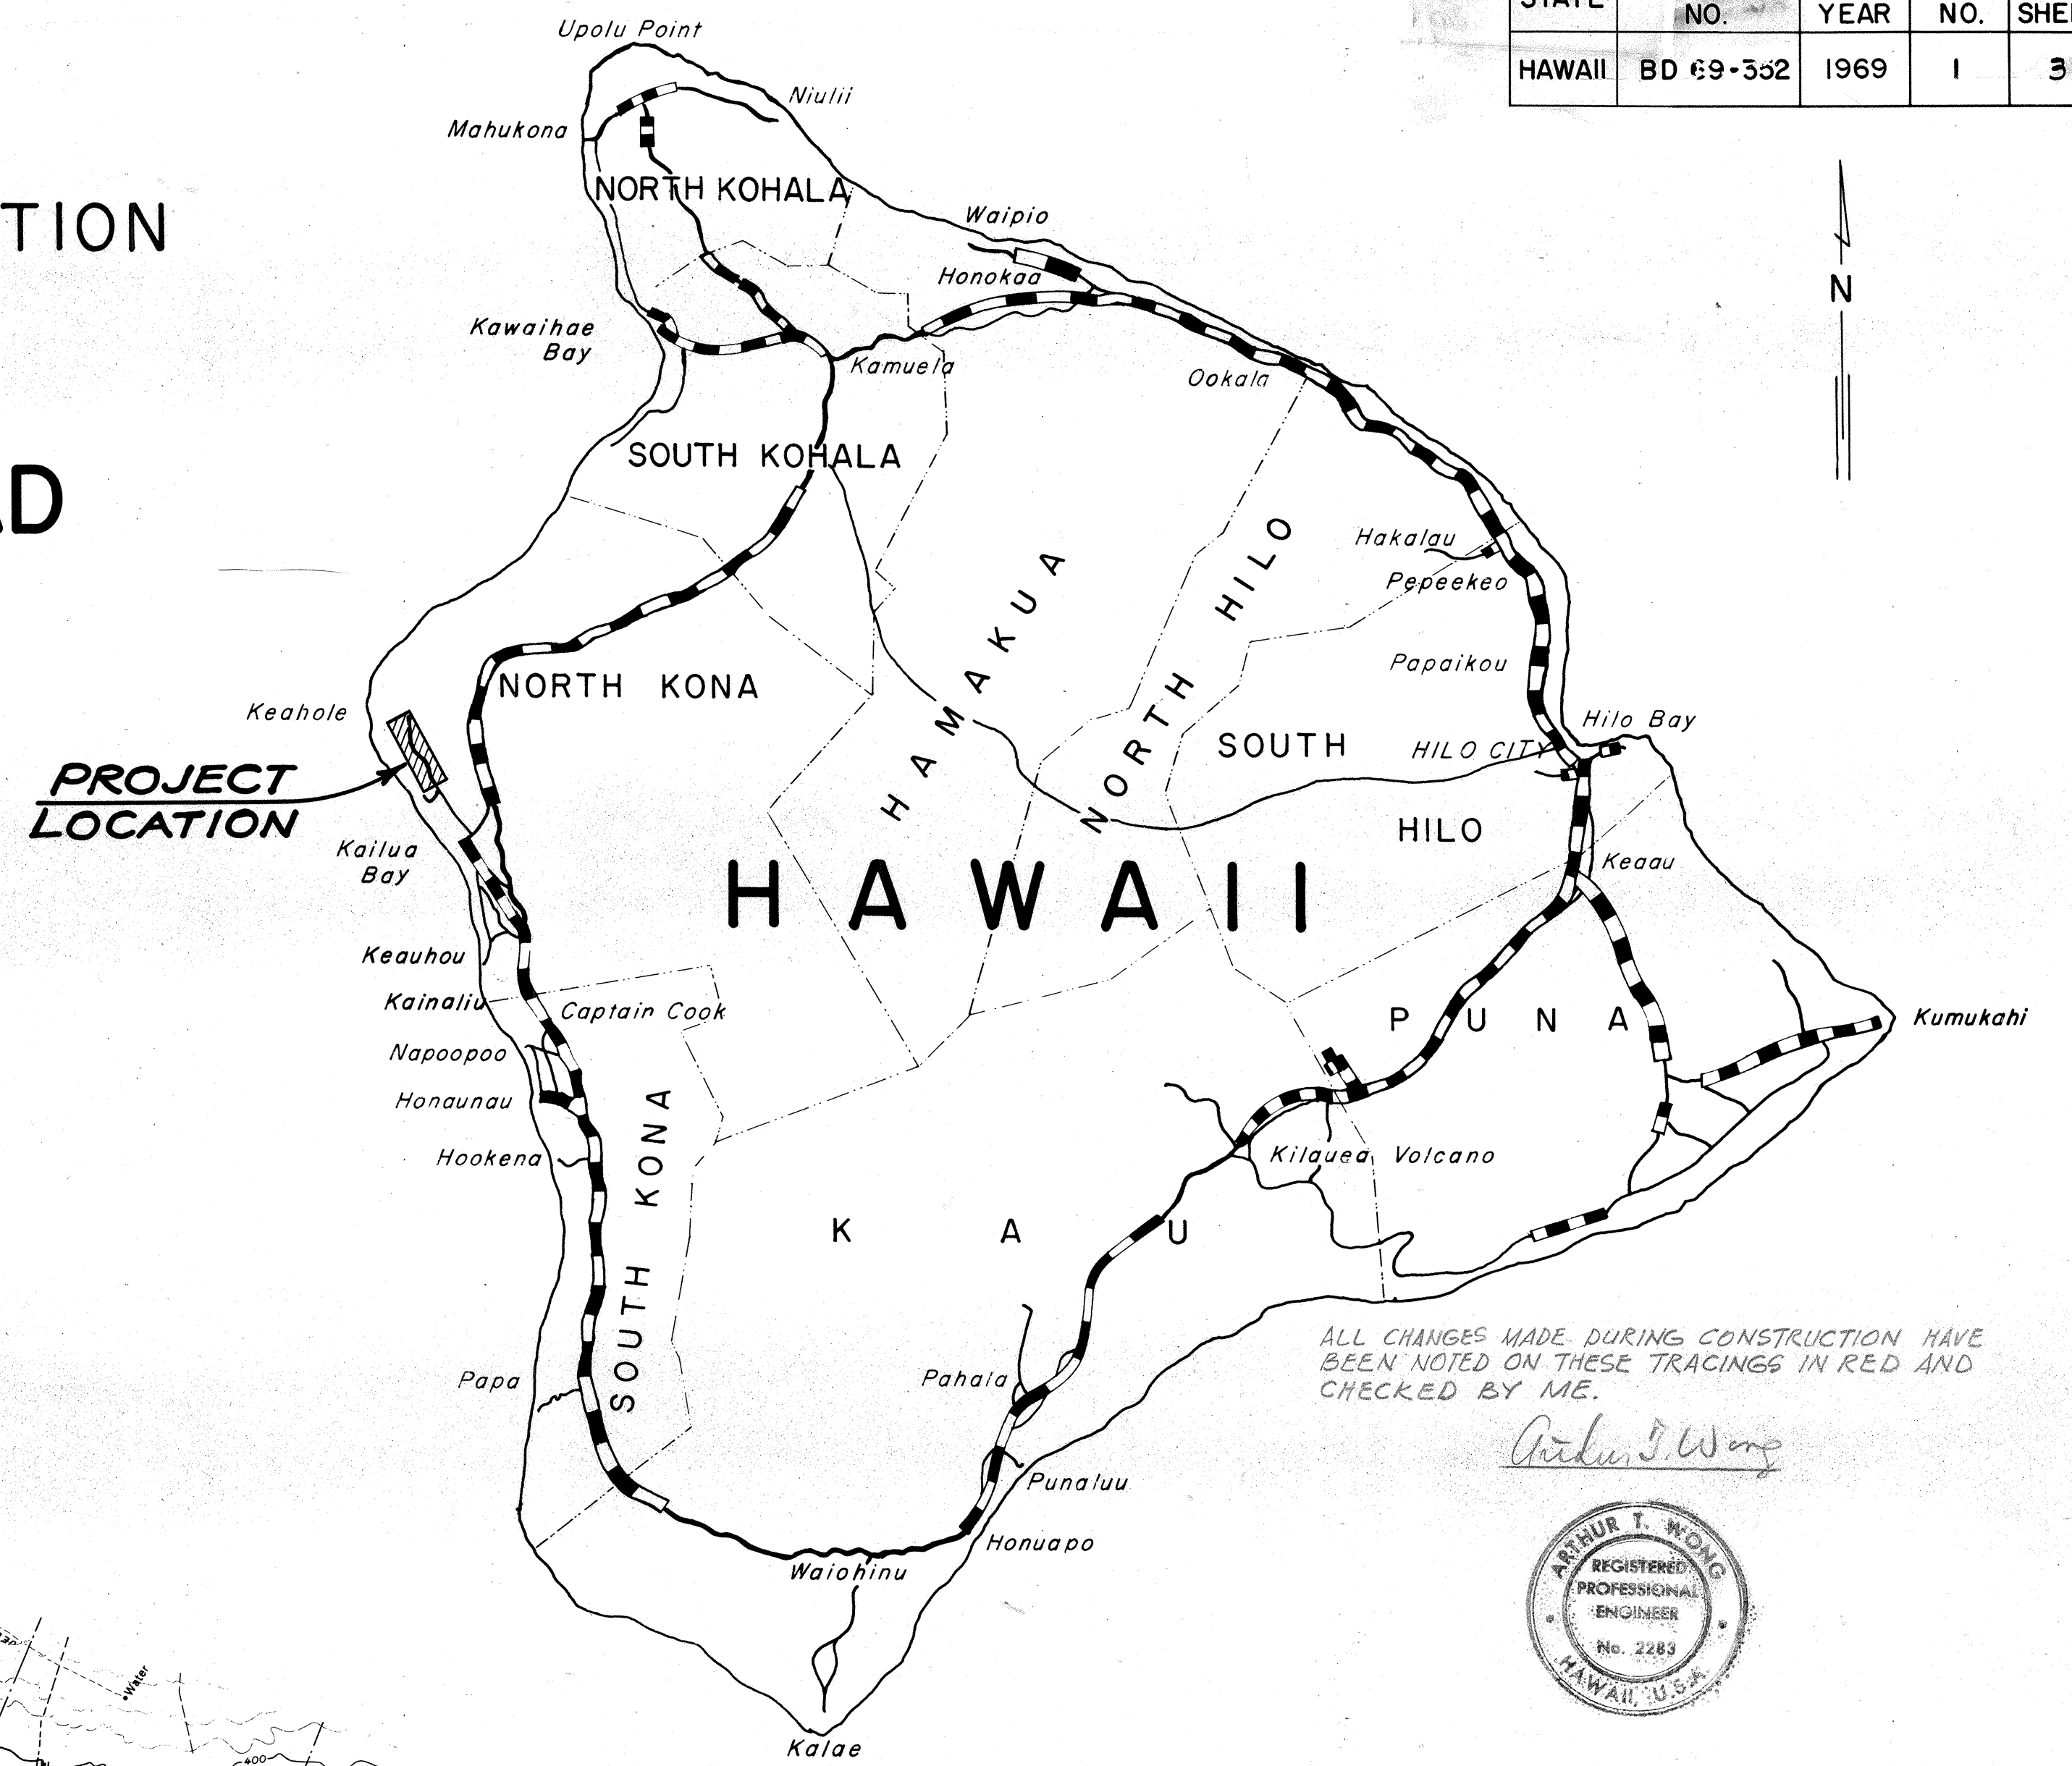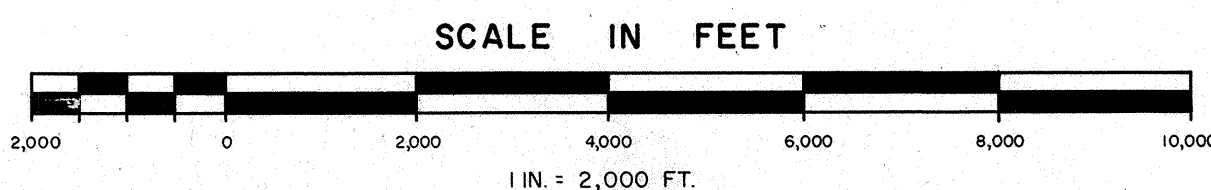

ALL CHANGES MADE DURING CONSTRUCTION HAVE BEEN NOTED ON THESE TRACINGS IN RED AND CHECKED BY ME.

Arthur J. Wong

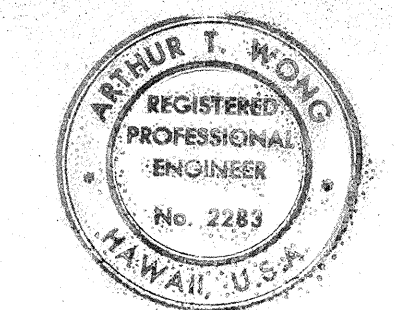

Federal Aid Projects Previously Constructed Or Under Construction


DESIGN CLASSIFICATION

CURRENT ADT (1968).....1570
INTERIM ADT (1978).....3200
DESIGN ADT (1988).....4800
DHV.....480
D.....55/45
T.....10 %
T24.....10 %
V.....70 MPH

R.M.TOWILL CORPORATION
CIVIL ENGINEERS - SURVEYORS

THIS WORK WAS PREPARED BY
ME OR UNDER MY SUPERVISION.

B. S. Wong
Signature

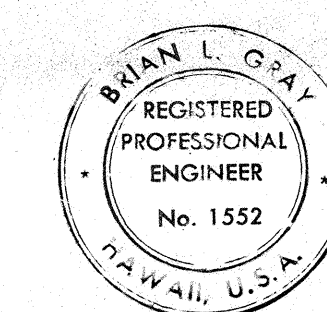

DEPARTMENT OF TRANSPORTATION
STATE OF HAWAII

APPROVED:
E. Alvey Wright 8/25/69
DIR. OF TRANSPORTATION DATE

GROSS LENGTH OF PROJECT - 4.460 MILES

DESIGNED BY: LEO I. FLEMING (ALLEN C.H. YOUNG)

Donald Lee
PS & E BY: 548-2211 - 372
PHONE - LOCAL