

INDEX TO DRAWINGS	
SHEET NO.	DESCRIPTION
1	TITLE SHEET
2 - 3	TYPICAL ROADWAY SECTIONS
4 - 14	PLAN & PROFILE (ROAD)
15 - 17	PLAN & PROFILE (WATER)
18 - 28	GRADING LIMIT PLANS
29 - 34	STRUCTURES - CULVERTS
35	MISCELLANEOUS DETAILS
36 - 37	MASS DIAGRAM
38 - 40	WATER DETAILS
41	SIGN DETAILS
42	PROJECT INFORMATION SIGN
43 - 62	STANDARD DETAILS



STATE	PROJECT NO.	FISCAL YEAR	SHEET NO.	TOTAL SHEETS
HAWAII	19 BC-01-71	1971	1	62

STATE OF HAWAII
DEPARTMENT OF TRANSPORTATION
HIGHWAYS DIVISION

"AS BUILT" PLANS FOR
KAILUA - KAWAIIHAE ROAD
ANAEHOOMALU TO HAPUNA
(GRADING)

PROJECT NO. 19 BC-01-71
DISTRICT OF SOUTH KOHALA
ISLAND OF HAWAII

PLAN ----- 1 INCH = 100 FT.
PROFILE ----- HOR. 1 INCH = 100 FT.
VER. 1 INCH = 10 FT.

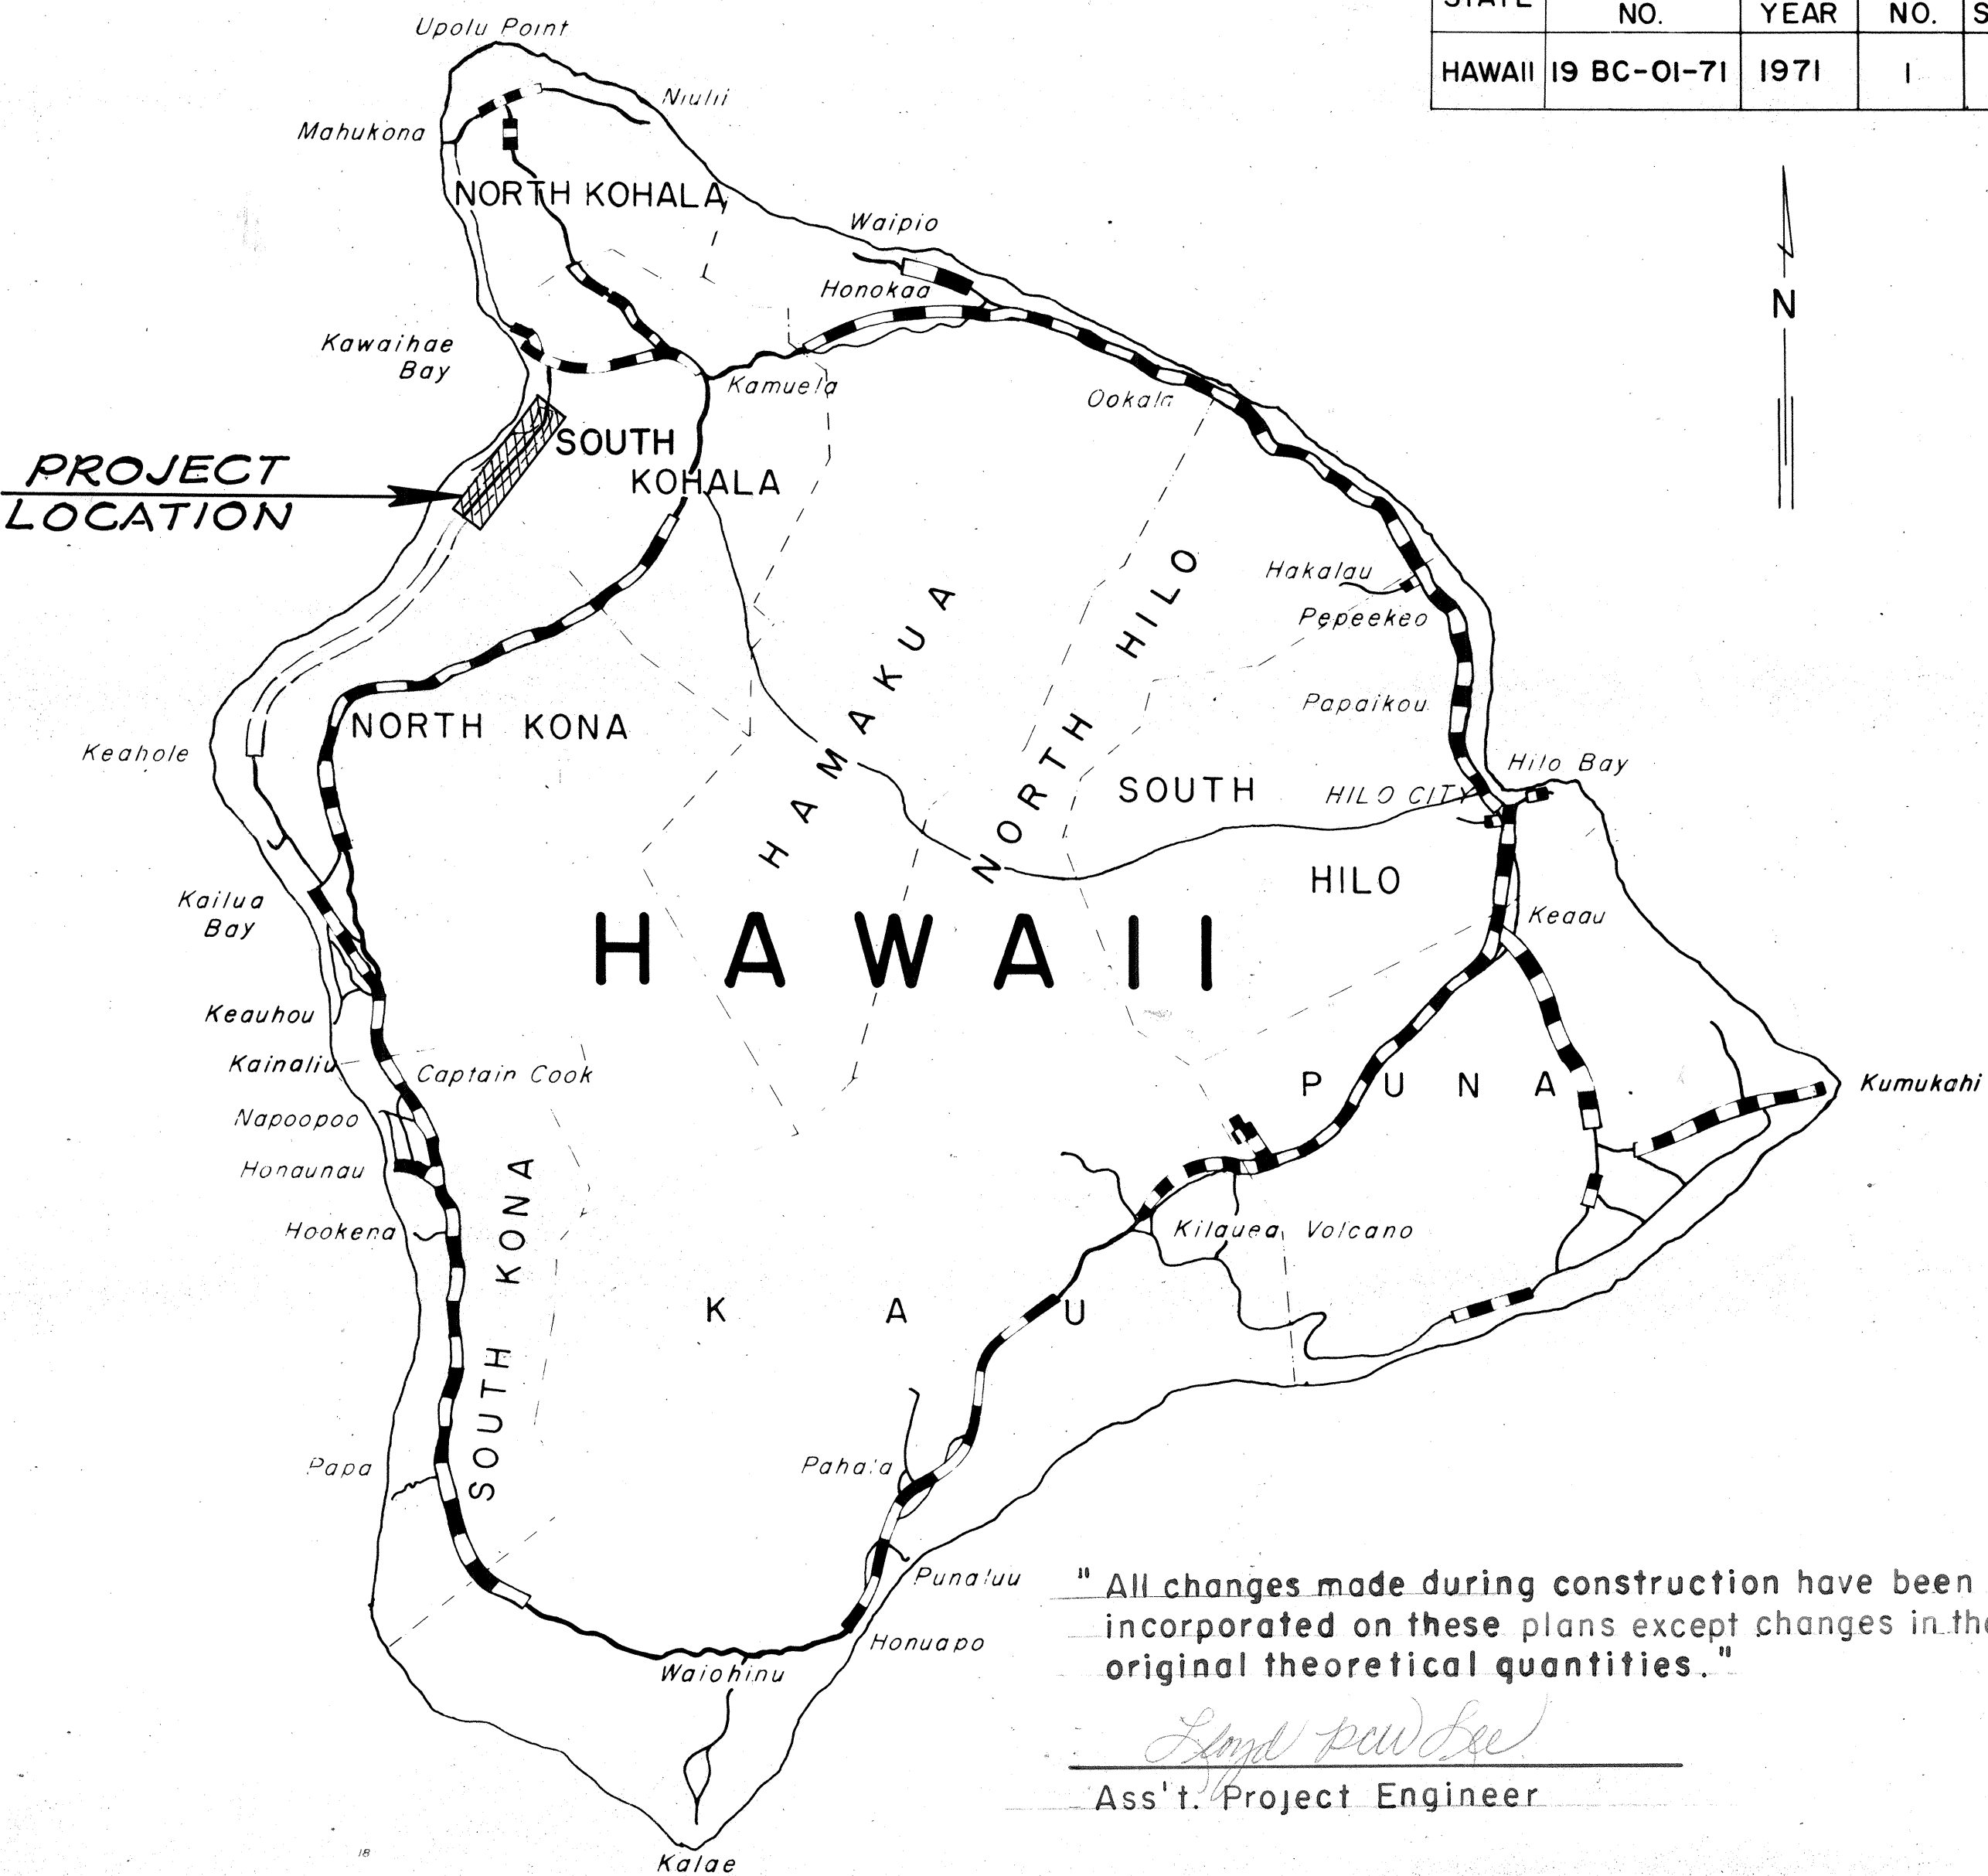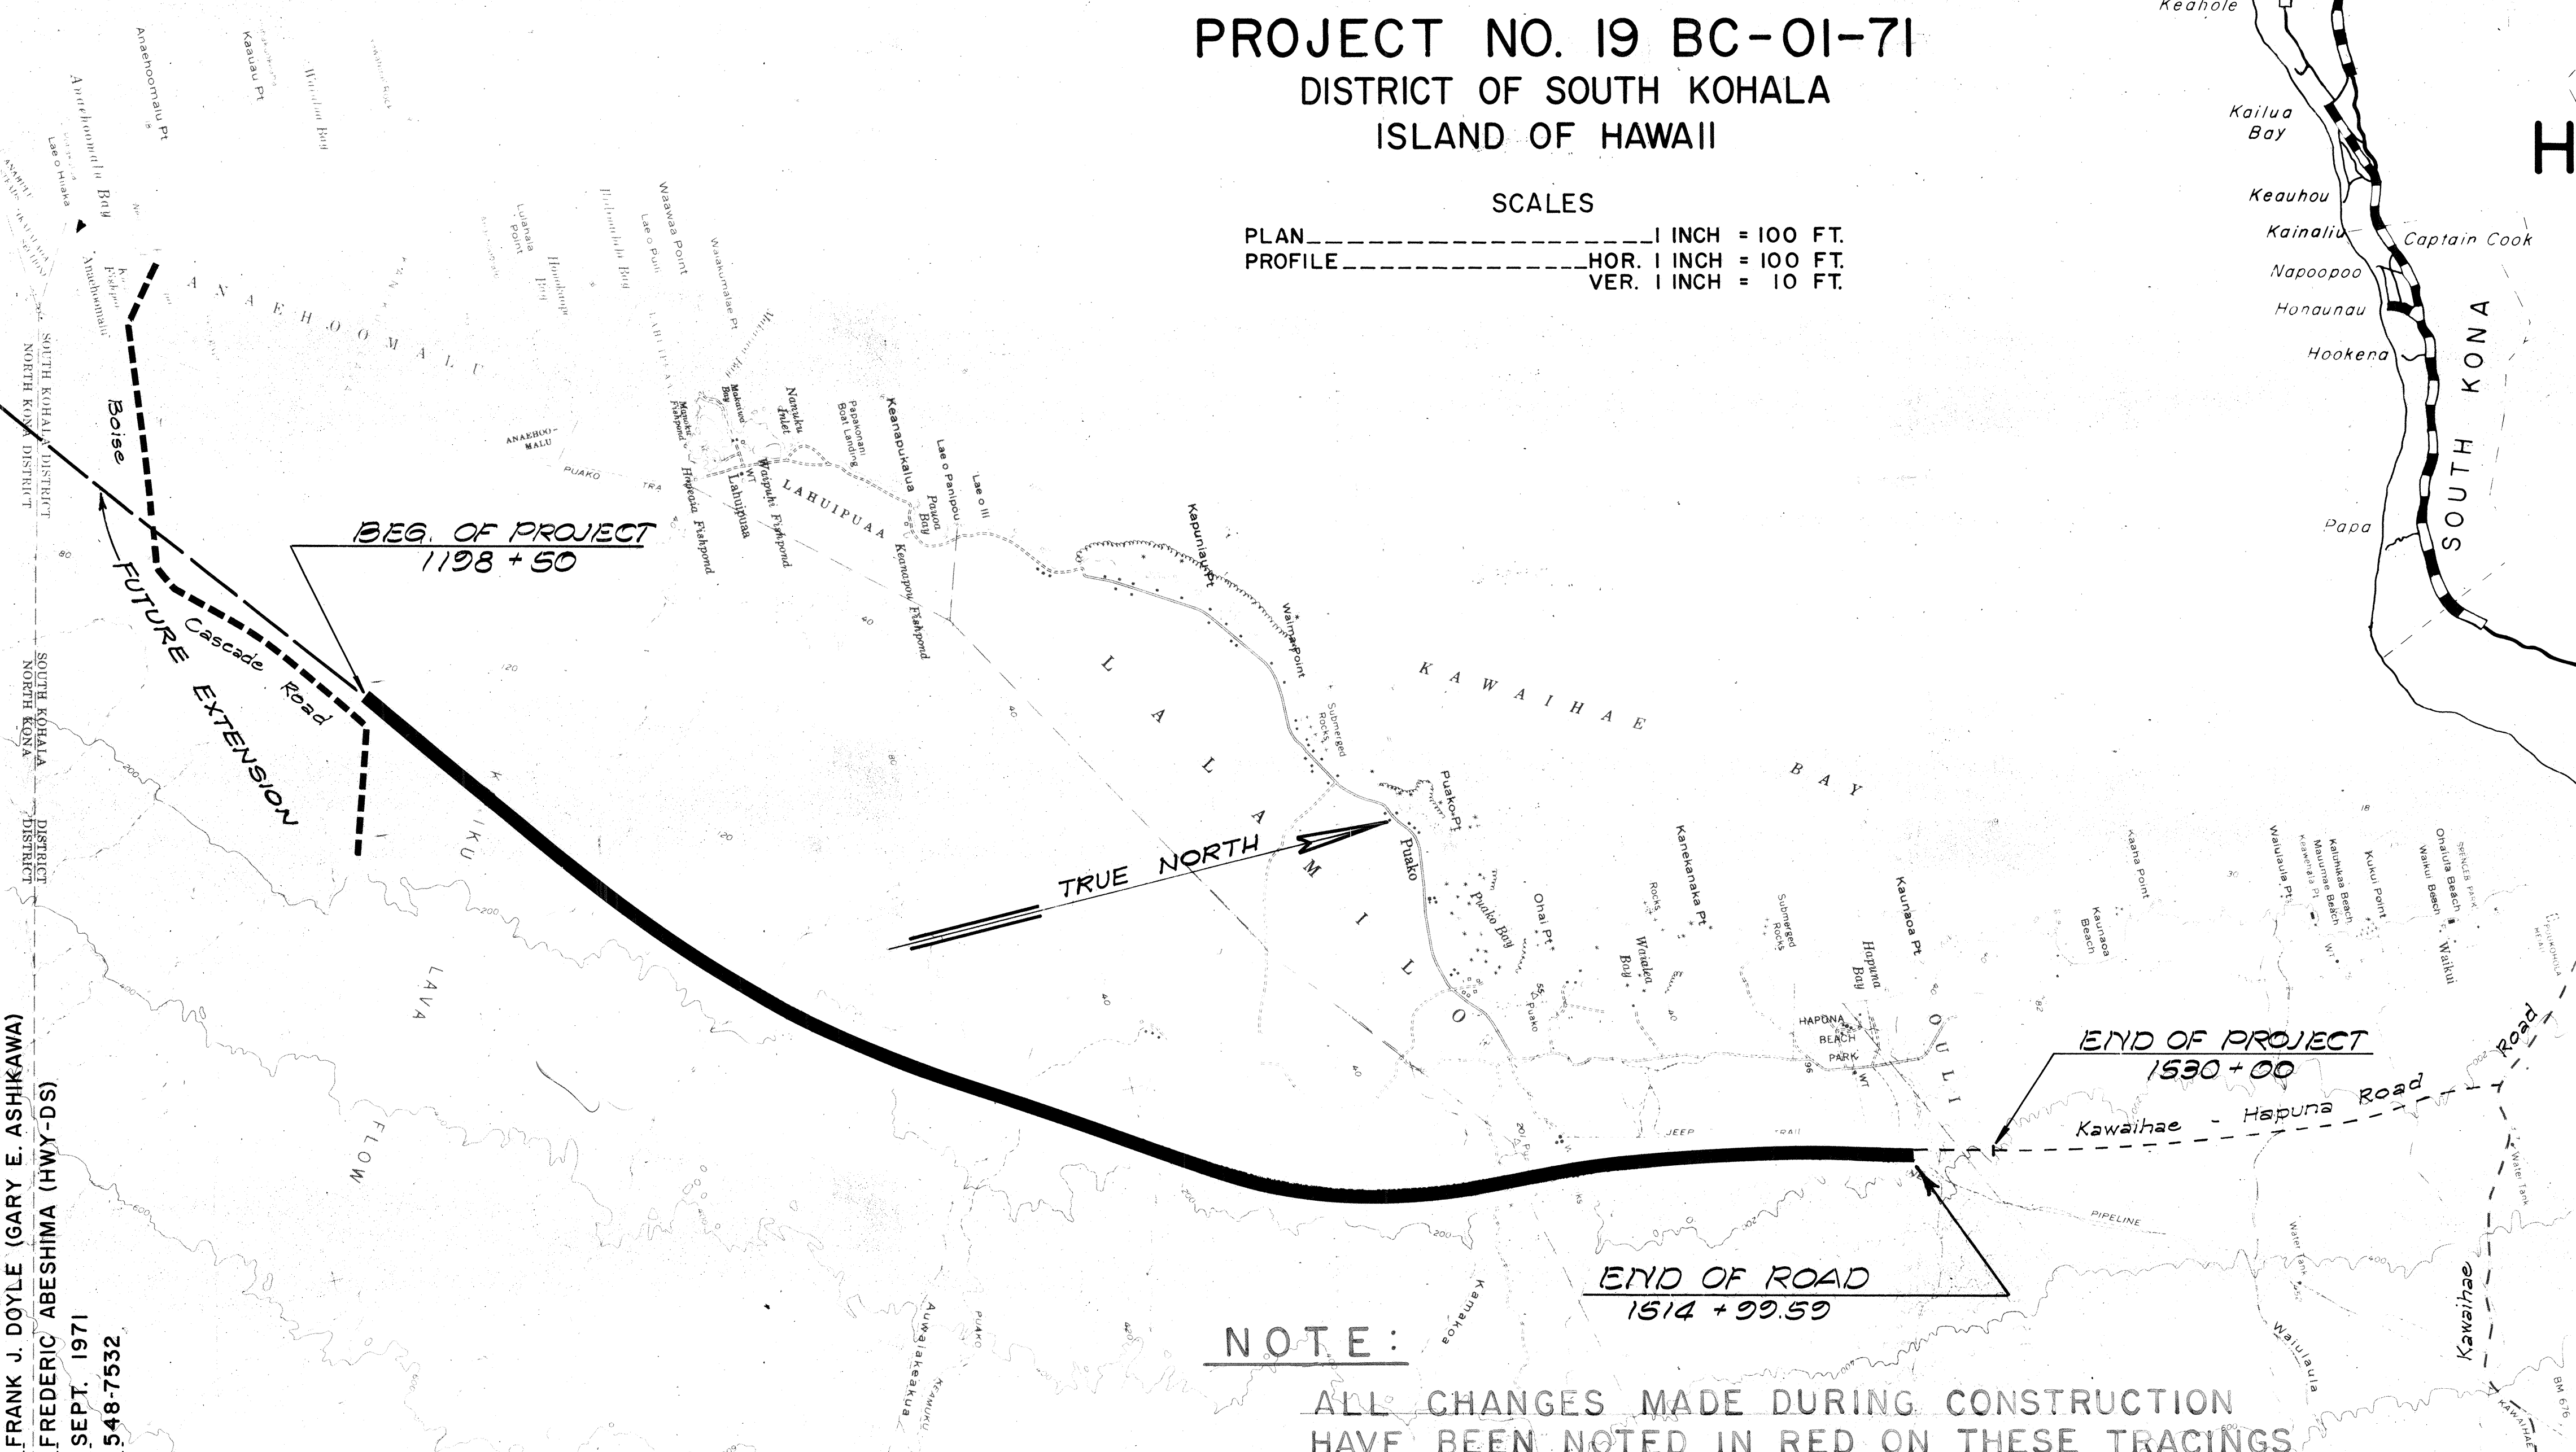

"All changes made during construction have been incorporated on these plans except changes in the original theoretical quantities."

Lloyd P. Dowd
Ass't. Project Engineer

Federal Aid Projects Previously Constructed Or Under Construction

DESIGN CLASSIFICATION

CURRENT ADT (1971)	0
DESIGN ADT (1991)	2900
DHV	10 %
D	55/45
T	10 %
T24	10 %
V	70 MPH

R.M. TOWILL CORPORATION
CIVIL ENGINEERS & SURVEYORS

NOTE:
ALL CHANGES MADE DURING CONSTRUCTION
HAVE BEEN NOTED IN RED ON THESE TRACINGS
AND CHECKED BY:

Hugh R. P. Dowd
PROJECT ENGINEER

10-4-72
DATE

GROSS LENGTH OF PROJECT - 6.278 MILES

DEPARTMENT OF TRANSPORTATION STATE OF HAWAII	
APPROVED:	
<i>Murray Lee</i>	9-8-71
DIRECTOR OF TRANSPORTATION	DATE

DESIGNED BY: FRANK J. DOYLE (GARY E. ASHIKAWA)
P.S. & E. BY: FREDERIC ABESHIMA (HWY-DS)
DATE: SEPT. 1971
PHONE: 548-7532

GENERAL LOCATION PLAN

