


P A C I F I C

O C E A N

FED. ROAD DIST. NO.	STATE	PROJ. NO.	FISCAL YEAR	SHEET NO.	TOTAL SHEETS
HAWAII	HAW.	JK-03-72	1973	4	6

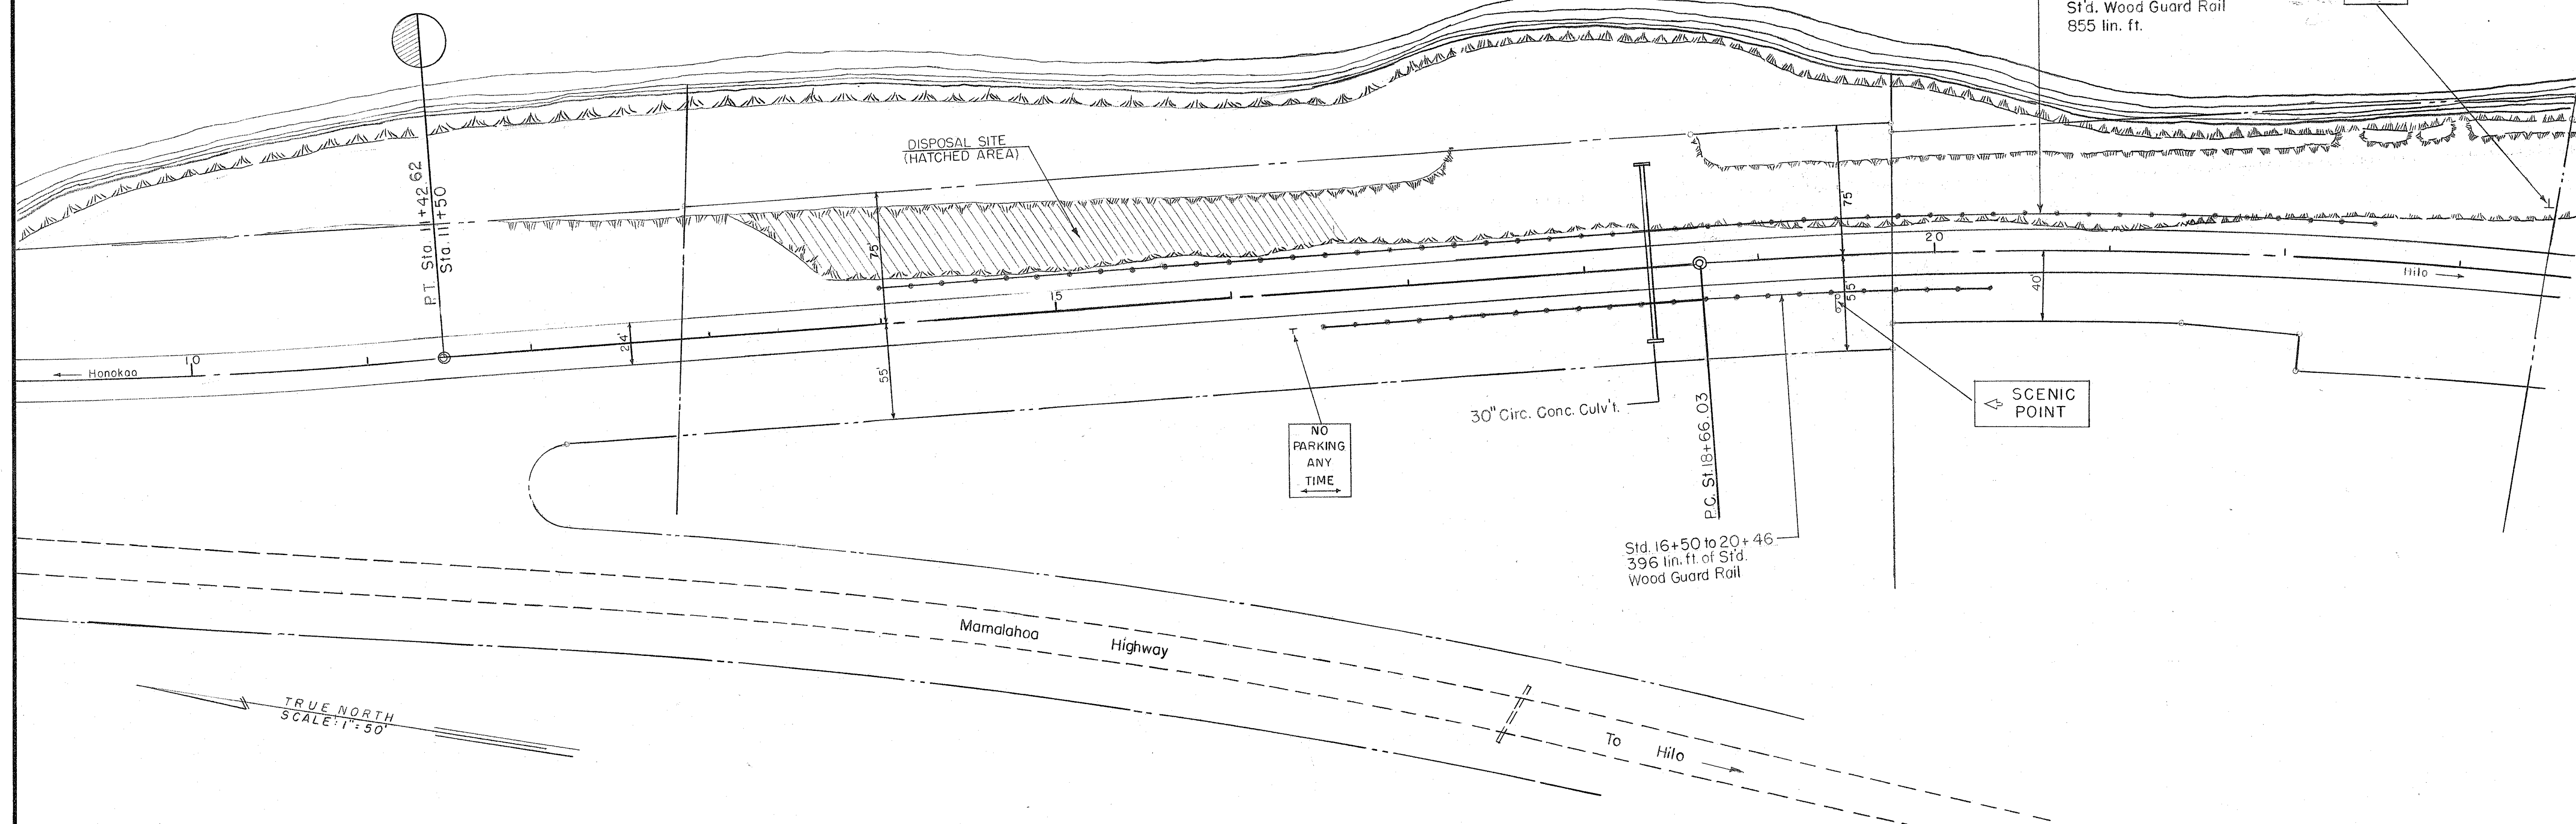

DISPOSAL SITE

Scale: 1"=50'-0"

ORIGINAL PLAN	SURVEY PLOTTED BY	DATE
NOTE BOOK	DRAWN BY	
	DESIGNED BY	
	CHECKED BY	

STATE OF HAWAII
DEPARTMENT OF TRANSPORTATION
HIGHWAYS DIVISION

DISPOSAL SITE

Sta. 13+80 to Sta. 17+00 SDR 3(1)

Removal of Cane Flume Overpasses

Project No. 19 JK-03-72

South Hilo, Hawaii

Scale: As Shown

Date: July 1972

SHEET No. 1 OF 4 SHEETS