

INDEX TO DRAWINGS	
SHEET NO.	DESCRIPTION
1	TITLE SHEET
2-3	DEMOLITION PLANS
4	DISPOSAL SITE
5-6	STRUCTURE INFORMATIONAL PLANS

STATE OF HAWAII

DEPARTMENT OF TRANSPORTATION

HIGHWAYS DIVISION

"AS BUILT"

PLANS FOR



REMOVAL OF CANE FLUME OVERPASSES

AT WAINAKU AND PAPAIKOU


PROJECT No. 19 JK - 03 - 72

DISTRICT OF SOUTH HILO

ISLAND OF HAWAII

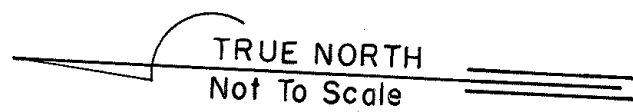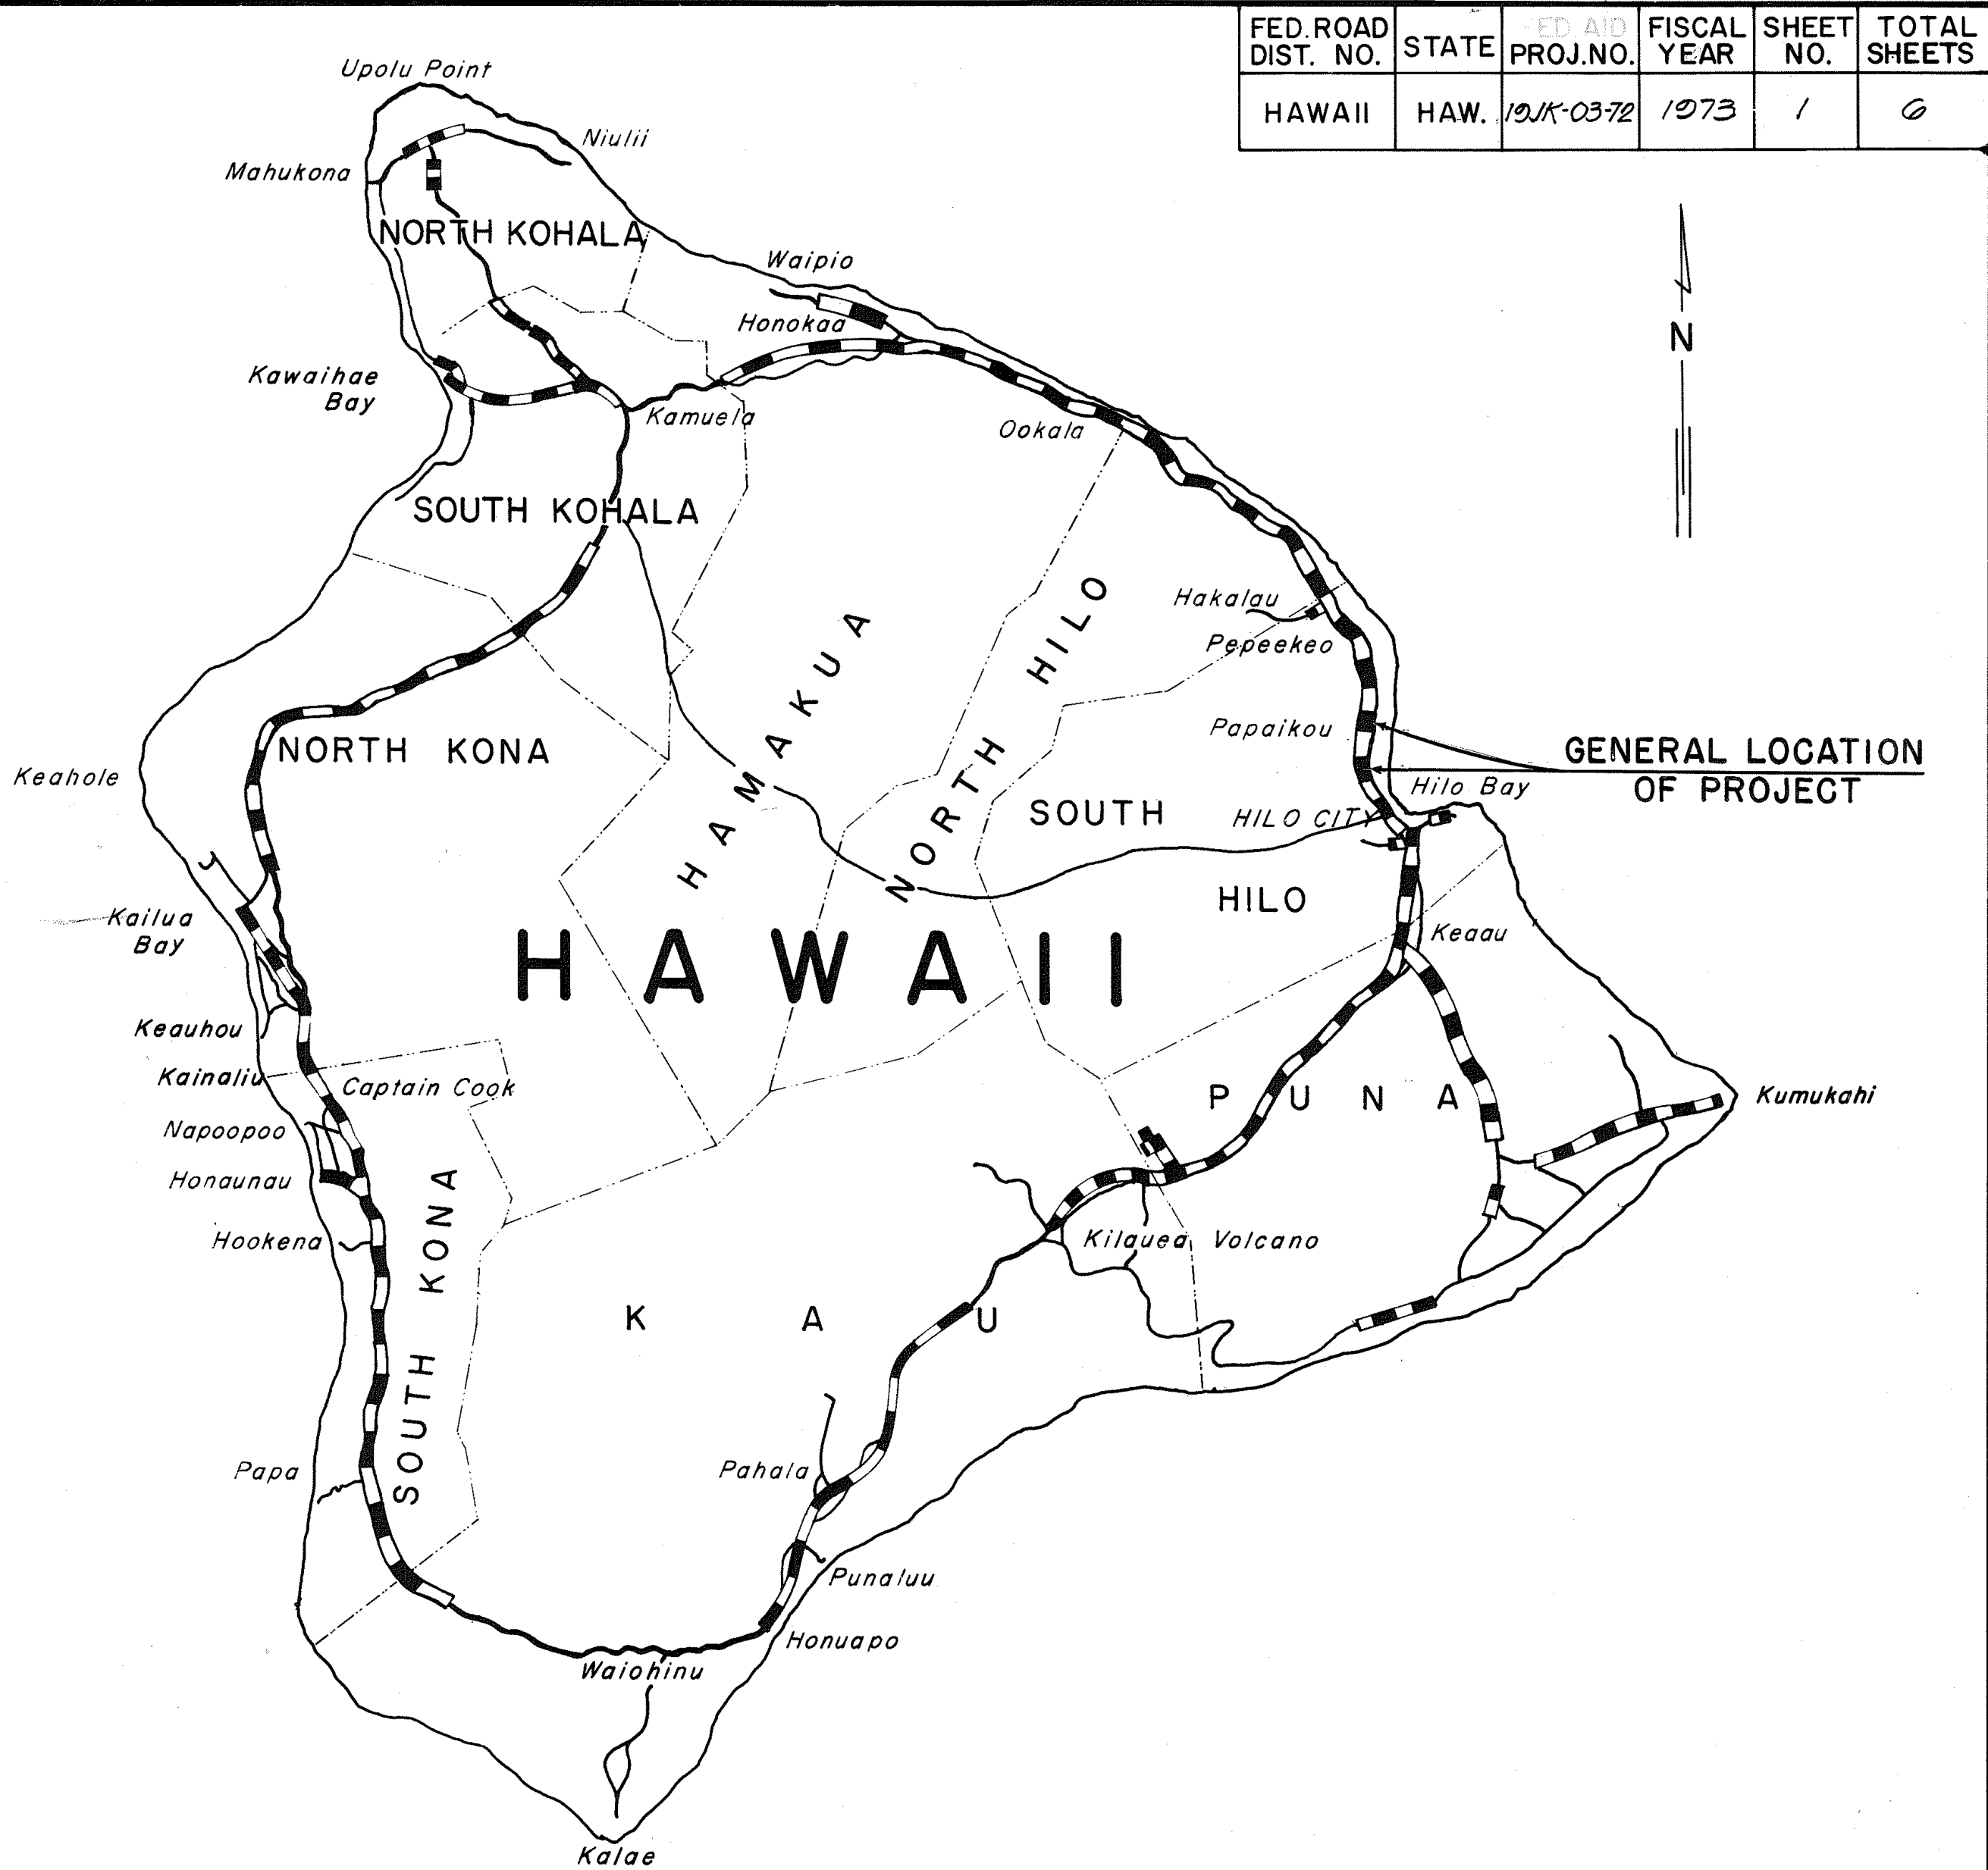

PACIFIC OCEAN

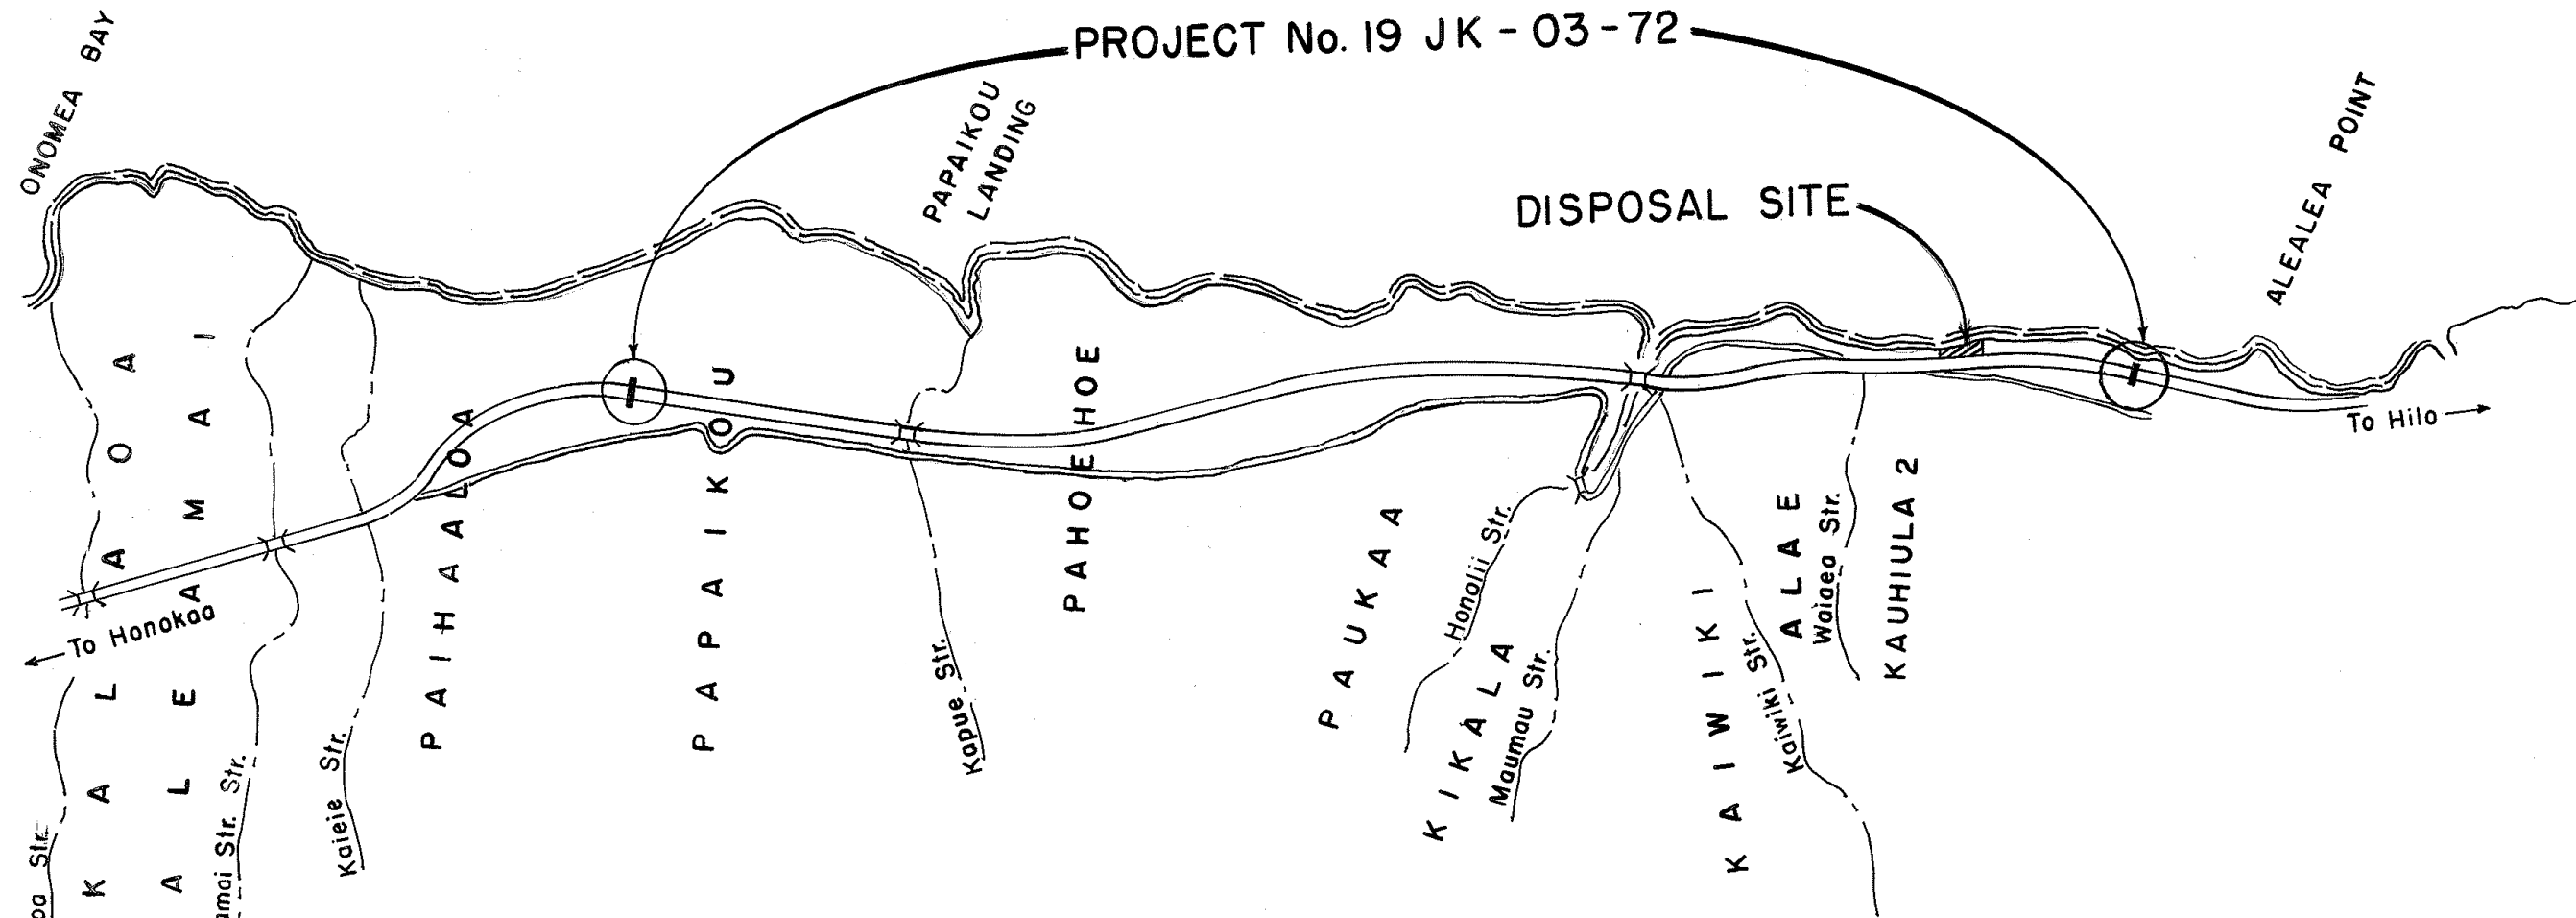

LAYOUT OF PROJECT

PROJECT No. 19 JK - 03 - 72

DISTRICT OF SOUTH HILO

ISLAND OF HAWAII

Federal Aid Projects Previously Constructed Or Under Construction

NO CHANGES WERE MADE DURING CONSTRUCTION ON THESE PLANS EXCEPT CHANGES IN THE ORIGINAL THEORETICAL QUANTITIES. FOR ACTUAL QUANTITIES, REFER TO PROJECT LEDGER AND/OR COMPUTATION BOOK.

Benji Kodani

RESIDENT ENGINEER

4-28-82

DATE

DEPARTMENT OF TRANSPORTATION STATE OF HAWAII	
APPROVED:	
For <i>Murray Lee</i>	8/28/72
DIR. OF TRANSPORTATION	DATE

DESIGNED BY: HAWAII DISTRICT

JULY 1972

DATE

548-2456

PHONE

"B"

DESIGN UNIT

RONALD F. TSUZUKI

P.S. & E. BY