


FED. ROAD DIST. NO.	STATE	FED AID PROJ. NO.	FISCAL YEAR	SHEET NO.	TOTAL SHEETS
Hawaii	Haw.	26-A	1938	35	51

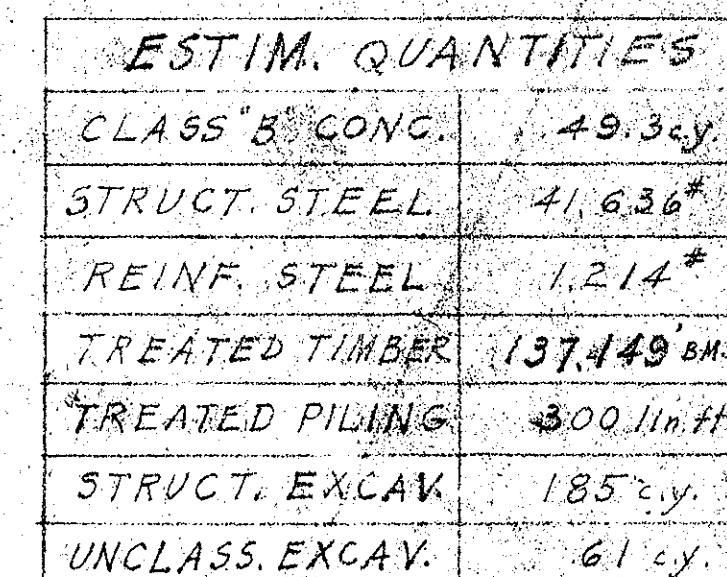

TERRITORIAL HIGHWAY DEPARTMENT
 TERRITORY OF HAWAII
 EAST PAAVULO BRIDGE
 STA. 780+11.17 TO STA. 782+40.83
 Hawaii Belt Rd.
 F.A.P. 26-A Feb. 1938
 SHEET NO. V OF 7 SHEETS

4441.35

ORIGINAL	DATE
FILED	
NOTE BOOK	
No.	
STATION IN STATE BY TRAVELED BY TRAGED BY QUANTITIES BY CHECKED BY	
M. S. Barfels W. S. Vannatta M. Vannatta W. Vannatta W. Vannatta	
Jan 1936 Feb 1937	