


INDEX TO DRAWINGS	
SHEET NO.	DESCRIPTION
1	TITLE SHEET
2	TYPICAL AND PLAN
3-4	ABUTMENT CROSS SECTION
5	PROJECT INFORMATION SIGN & REVISED TYPICAL SECTION

STATE OF HAWAII
DEPARTMENT OF TRANSPORTATION
HIGHWAYS DIVISION
"AS-BUILT"
PLANS FOR

WAILOA RIVER BRIDGE EMERGENCY REPAIR
HILO WATERFRONT ROAD
PROJECT NO. 19L-01-73
DISTRICT OF SOUTH HILO
ISLAND OF HAWAII



FED. ROAD DIST. NO.	STATE	PROJ. NO.	FISCAL YEAR	SHEET NO.	TOTAL SHEETS
HAWAII	HAW.	19L-01-73	1973	1	5

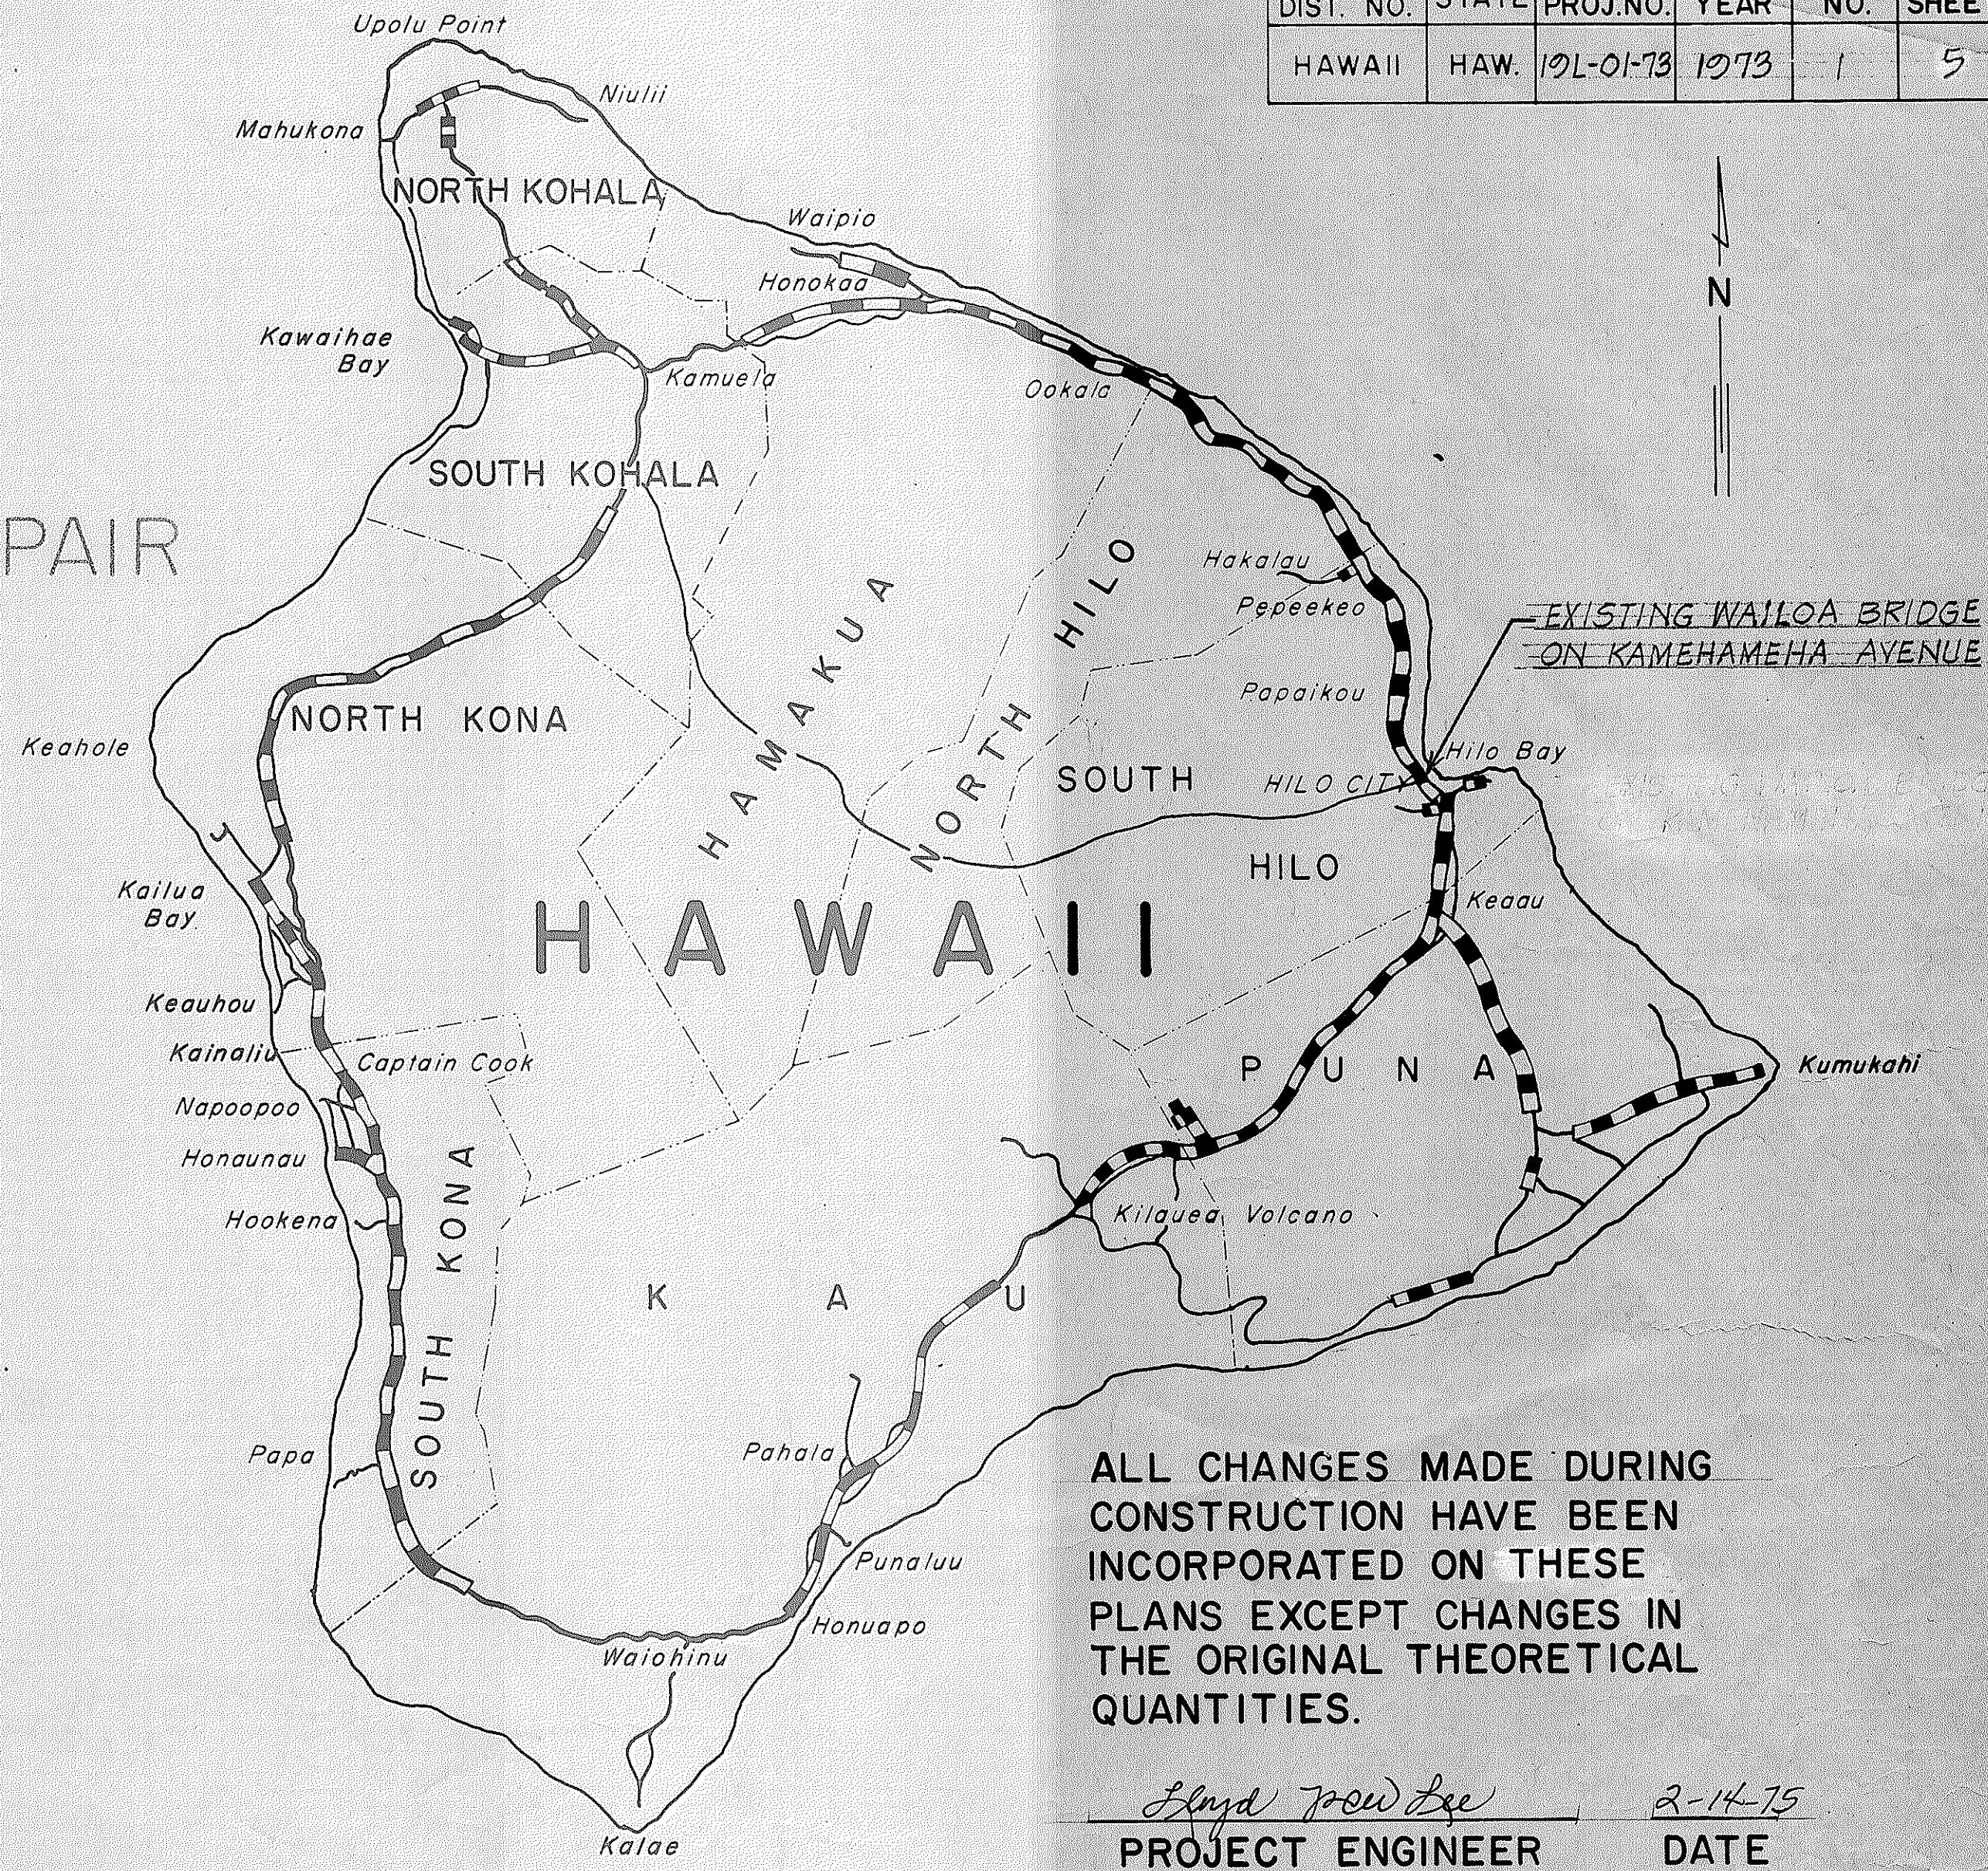

ALL CHANGES MADE DURING CONSTRUCTION HAVE BEEN INCORPORATED ON THESE PLANS EXCEPT CHANGES IN THE ORIGINAL THEORETICAL QUANTITIES.

Floyd Fred Lee 2-14-75
PROJECT ENGINEER DATE

DESIGNED BY *D. Bevier* 5487537 Nov 1972
P.S. & E. BY PHONE DATE

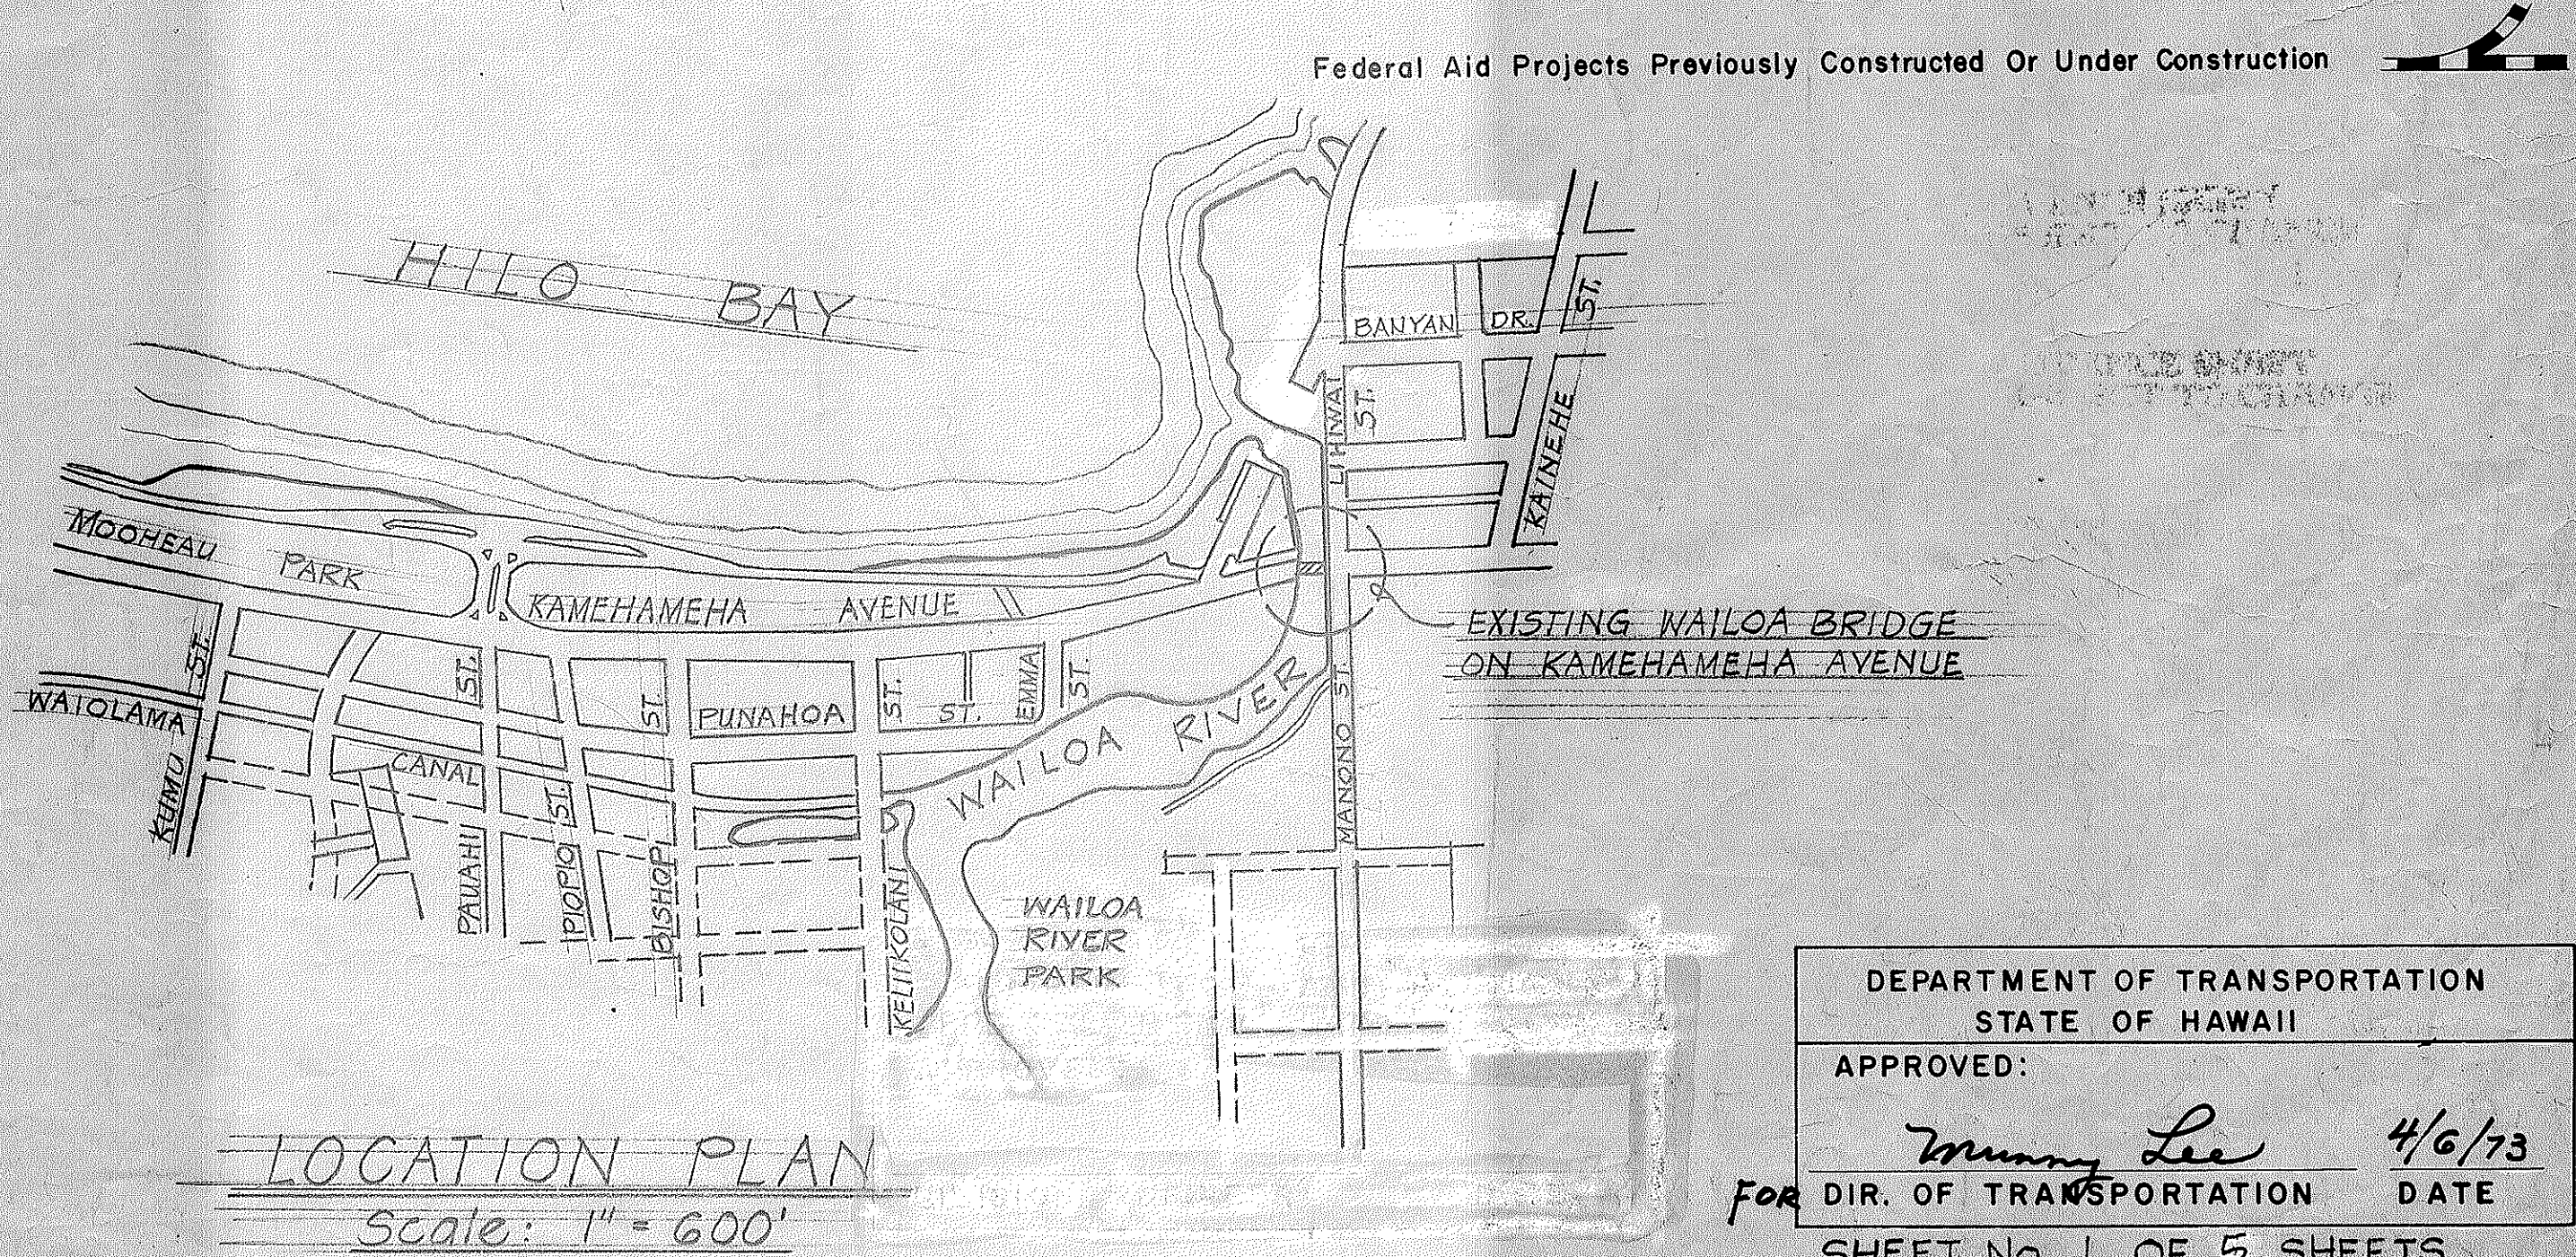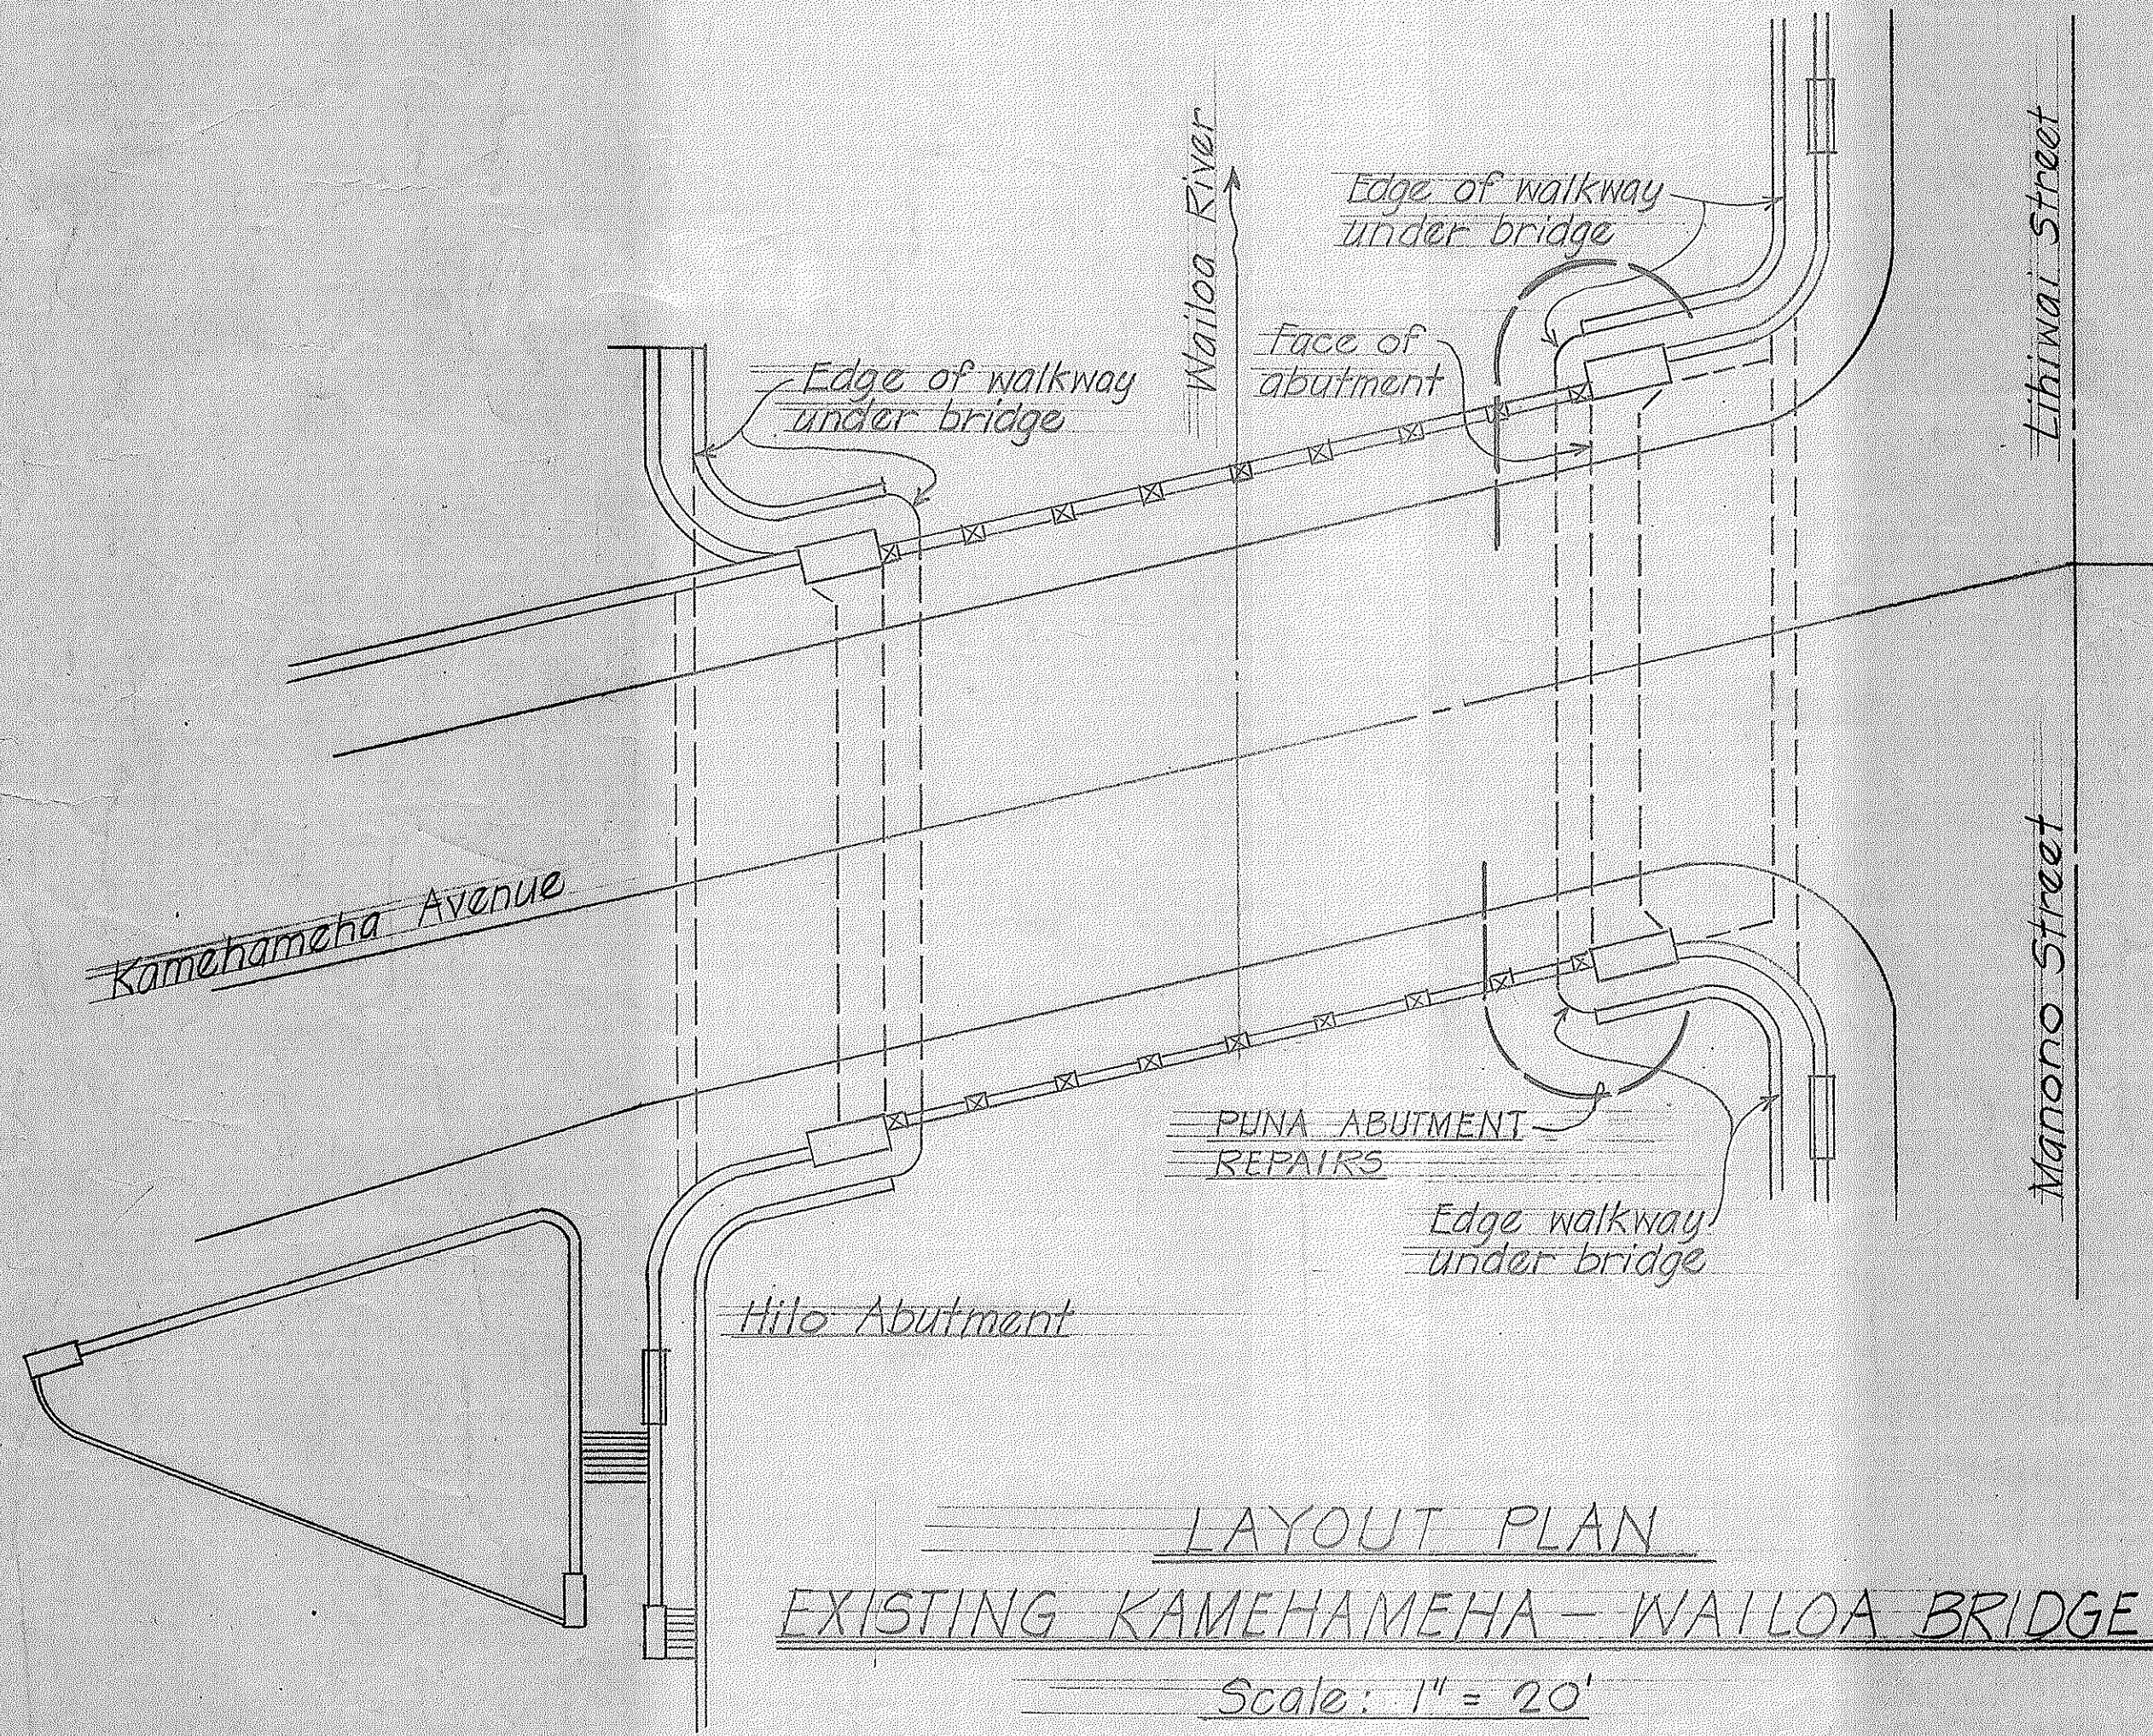

DEPARTMENT OF TRANSPORTATION STATE OF HAWAII	
APPROVED:	
<i>Murray Lee</i> 4/6/73	DATE
SHEET No. 1 OF 5 SHEETS	