



STATE	PROJ. NO.	FISCAL YEAR	SHEET NO.	TOTAL SHEETS
HAW.	19 BC-01-71	1073	50	51

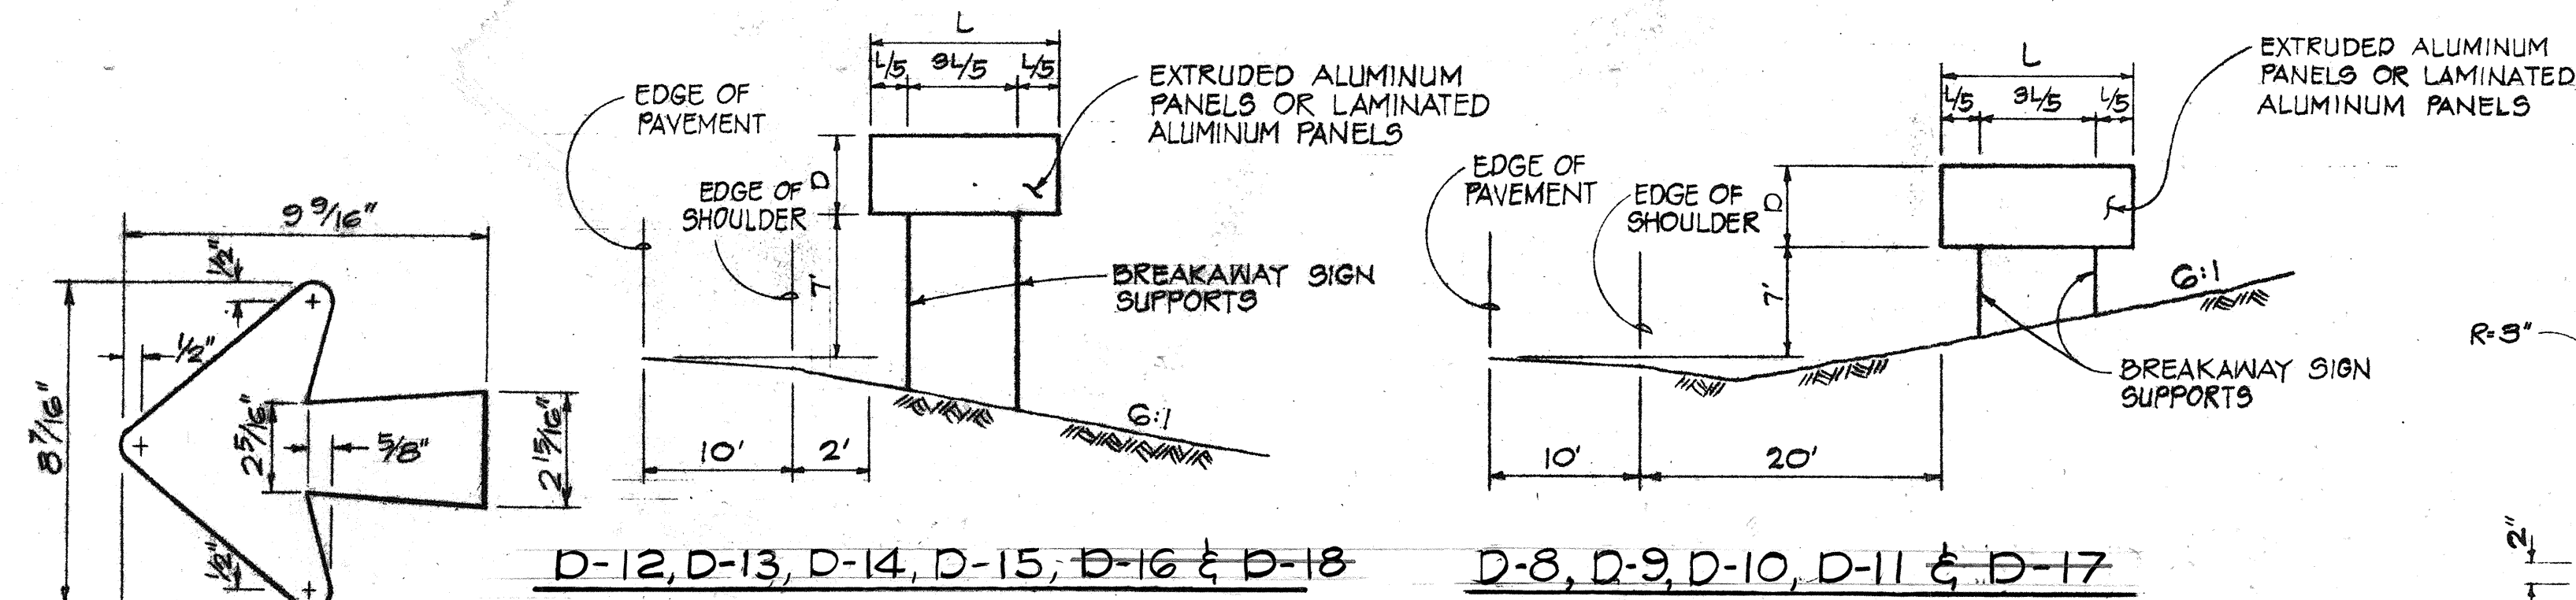

PLACEMENT OF DESTINATION SIGNS
NOT TO SCALE

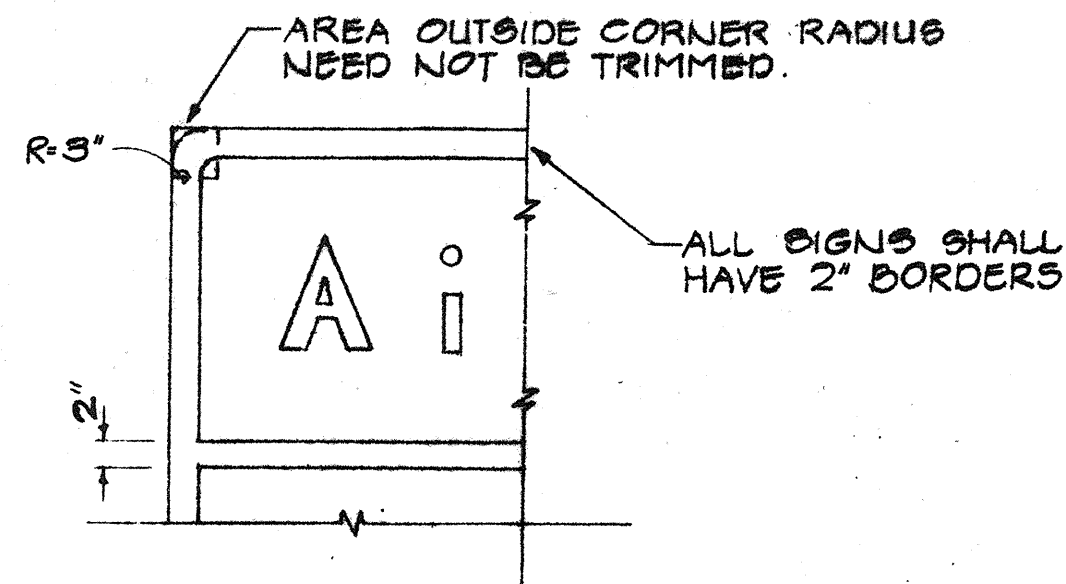

TYPICAL BORDER DETAIL
NOT TO SCALE

GENERAL NOTES:

- LETTERS & NUMERALS SHALL CONFORM TO THE MANUAL "STANDARD ALPHABETS FOR HIGHWAY SIGNS," BUREAU OF PUBLIC ROADS 1966. USE SERIES "B" MODIFIED LETTERS & NUMERALS.
- ARROWS & BORDERS SHALL CONFORM WITH DETAILS AS SHOWN ON PLANS.
- SIGN MESSAGE & BORDERS SHALL HAVE WHITE REFLECTIVE SHEETING ON DEMOUNTABLE ALUMINUM CUT-OUTS ON GREEN REFLECTIVE SHEETING BACKGROUND.
- CUT-OUTS SHALL BE FASTENED TO SIGN PANEL WITH ALUMINUM BLIND RIVETS.
- ALL DESTINATION SIGNS SHALL BE MOUNTED ON BREAKAWAY POSTS. SEE STANDARD DETAILS DT 203 AND DT 204 (SHTS. 37 & 38.)

SUMMARY OF DESTINATION SIGNS

SIGN-NO.	DESCRIPTION	SQ. FT.	TYPE POST
D-8	↑ Kawaihae 9 ← Waikoloa →	36	688.5
D-9	↑ Kailua 26 ← Waikoloa	32	688.5
D-10	← Kailua 26 Kawaihae 9 →	36	417.7
D-11	↑ Kawaihae 3 ← Hapuna	36 45	417.7
D-12	↑ Kailua 32 Hapuna →	32 40	417.7
D-13	← Kawaihae 3 Kailua 32 →	36 38	417.7
D-14	Anaehoomalu →	20	315.7
D-15	← Kawaihae 10 Kailua 25 →	38	417.7
D-16	↑ Kawaihae 4 ← Puako 1	36	417.7
D-17	← Kawaihae 4 Kailua 31 →	36	417.7
D-18	↑ Kailua 31 Puako 1 →	32	688.5


TOTAL = 370 Sq. Ft.

SUMMARY OF REGULATORY AND WARNING SIGNS			
TYPE	DESCRIPTION	WITHOUT POST	WITH POST
R1-1	STOP		2
R1-2	YIELD		2
R2-1(50)	SPEED LIMIT 55-50		2-1
R2-1(55)A	SPEED LIMIT 55		4
R2-1(65)	SPEED LIMIT 65-35		2-1
R2-1(65)A	SPEED LIMIT 65 (35)		2
R2-5b(55)A	REDUCED SPEED AHEAD(55)		2-1
R5-1	DO NOT ENTER		4-5
R5-2	WRONG WAY	4-5	1
R11-2	ROAD CLOSED	* 2	3
R11-4	ROAD CLOSED TO THRU TRAFFIC *1		1
W1-1(R)	↑		1
W1-2(R)	↑	* 1	1
W1-4(R)	↑		1
W2-4	↓		1
W3-2	YIELD AHEAD		1
W4-1(R)	MERGE		2
W4-1(L)	MERGE		1
TOTAL:		8	24

* used for Detour Road

SUMMARY OF CONSTRUCTION SIGNS

TYPE	DESCRIPTION	WITHOUT POST	WITH POST
CW20-1a	ROAD CONSTRUCTION (1500 FT.)		3

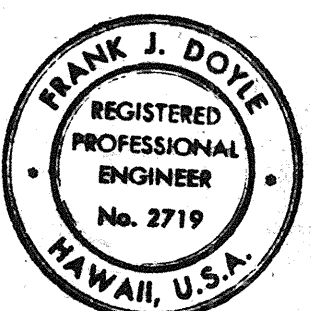

THIS WORK WAS PREPARED BY
ME OR UNDER MY SUPERVISION.
Frank J. Doherty
SIGNATURE











STATE OF HAWAII
DEPARTMENT OF TRANSPORTATION
HIGHWAYS DIVISION

DESTINATION SIGNS AND SUMMARY OF SIGNS

KAILUA - KAWAIIHAE ROAD
ANAEOHOMALU TO HAPUNA
PROJ. NO. 19 BC-01-71

SHEET No. 1 OF 2 SHEETS

STATE	PROJ. NO.	FISCAL YEAR	SHEET NO.	TOTAL SHEETS
HAW.	198C-01-71	1973	51	51

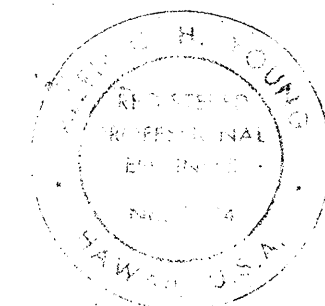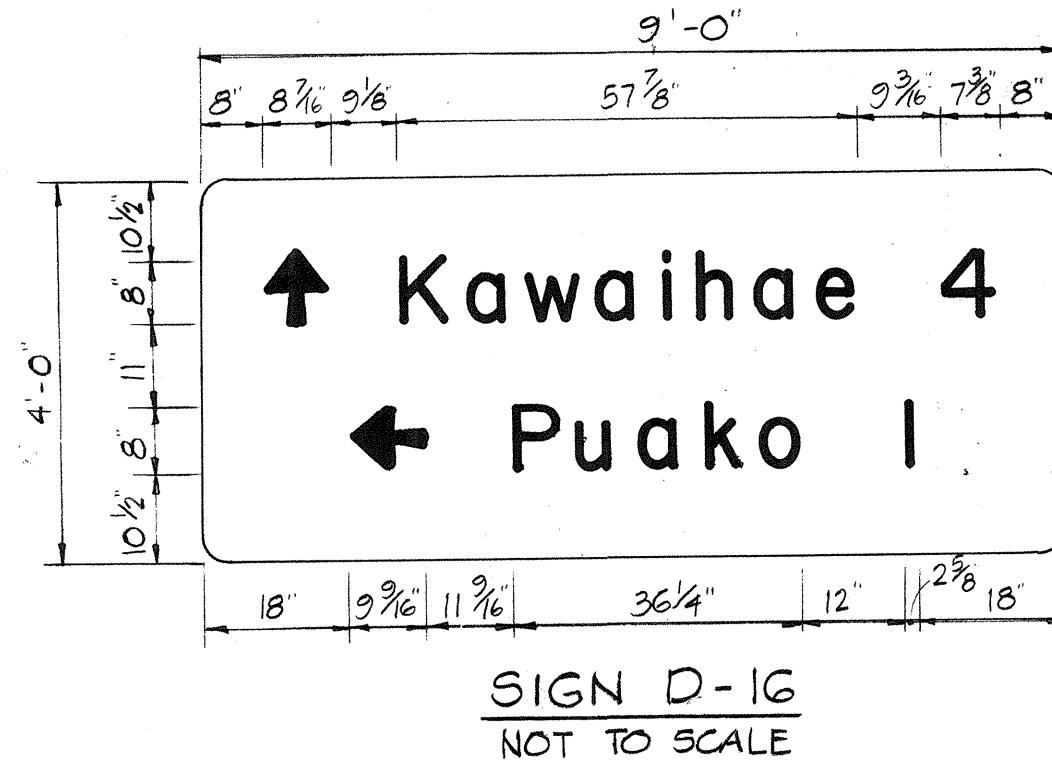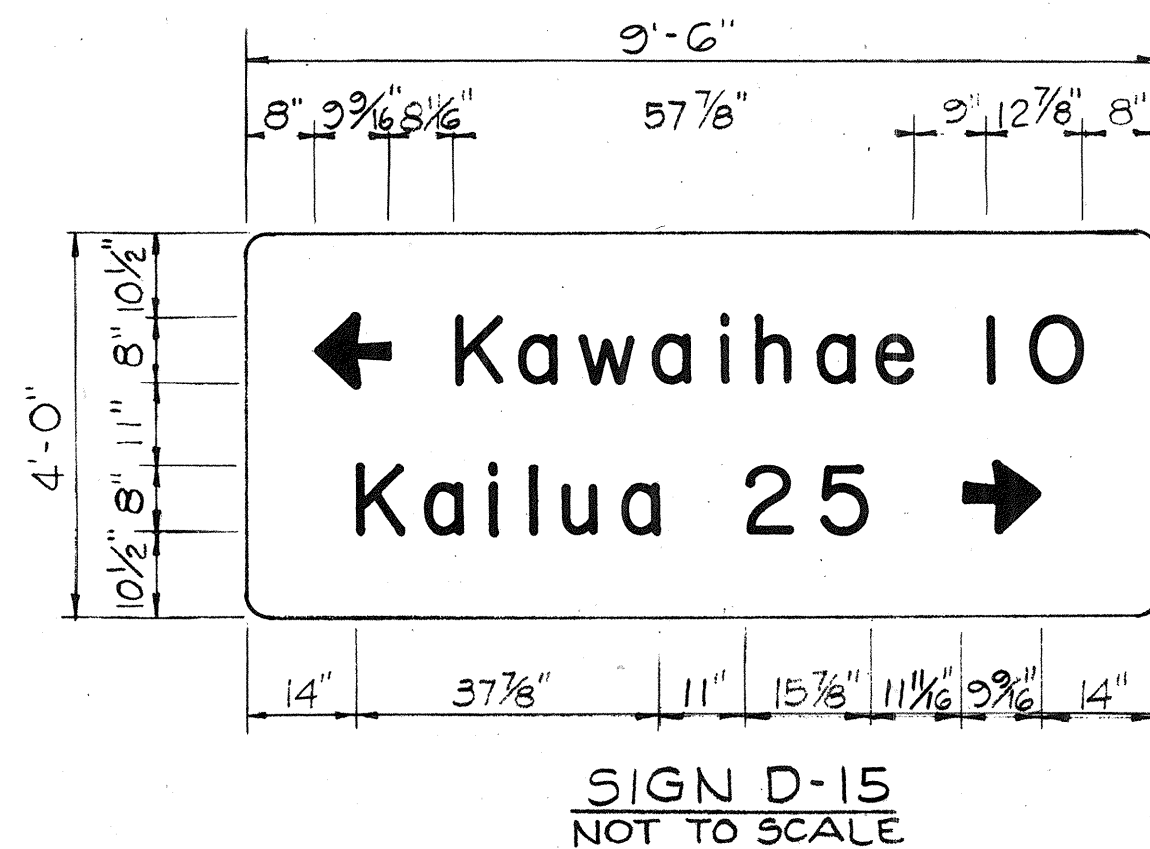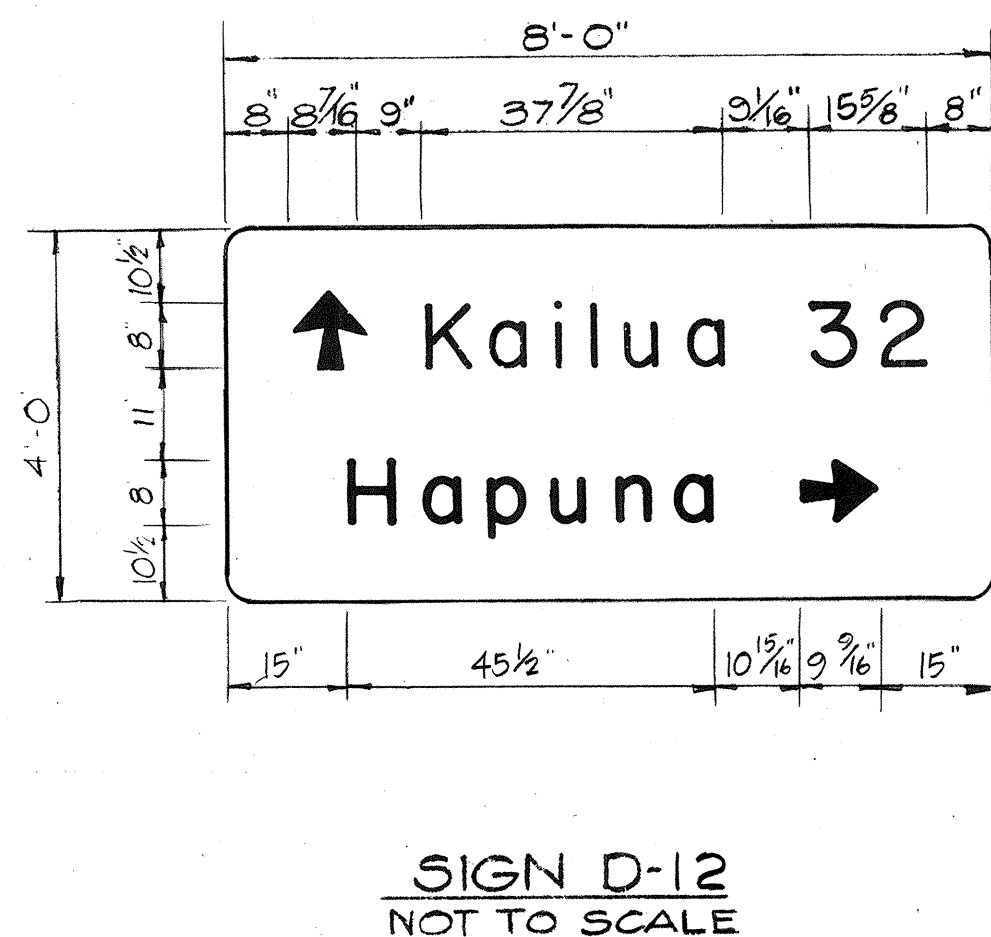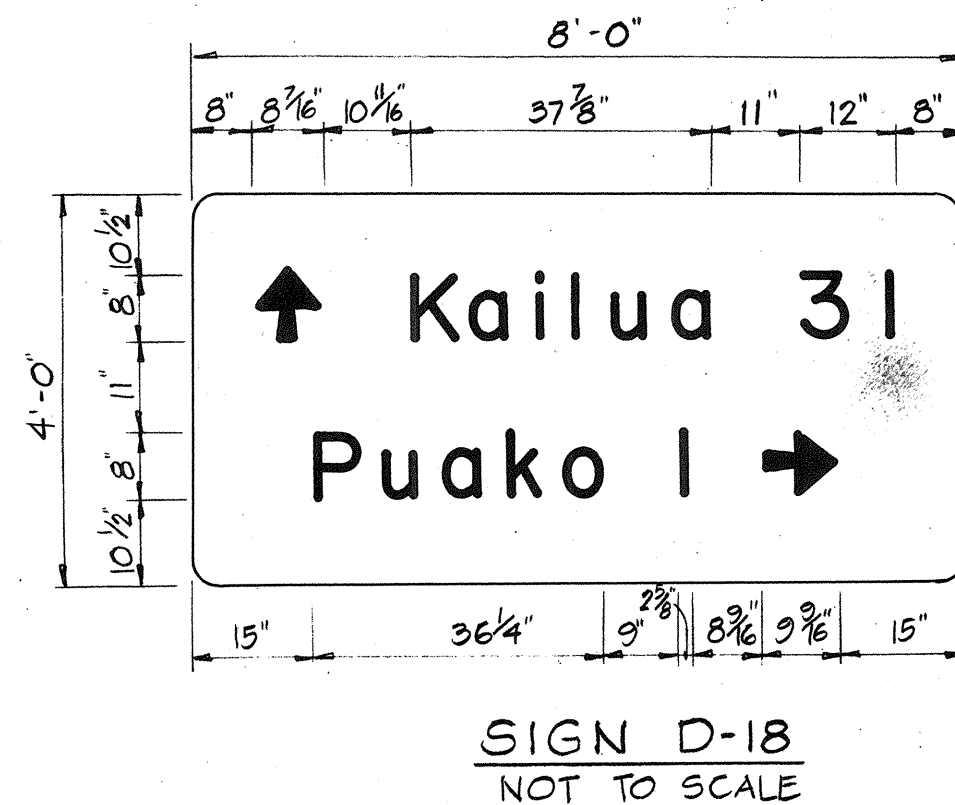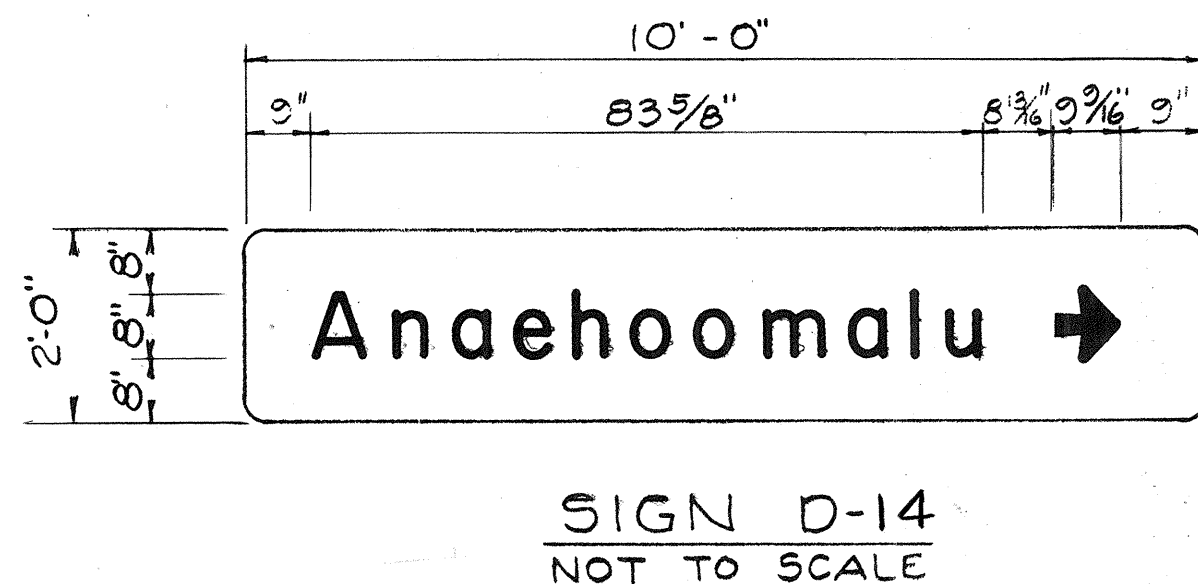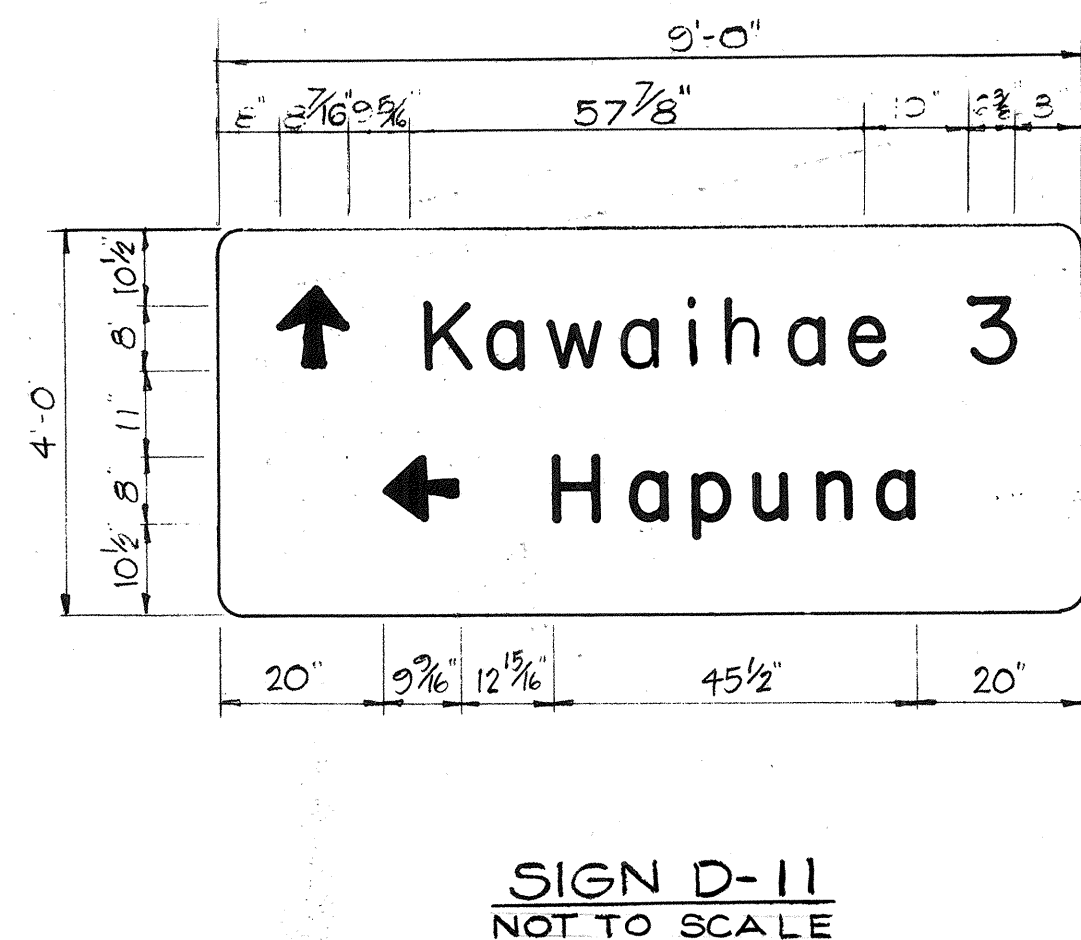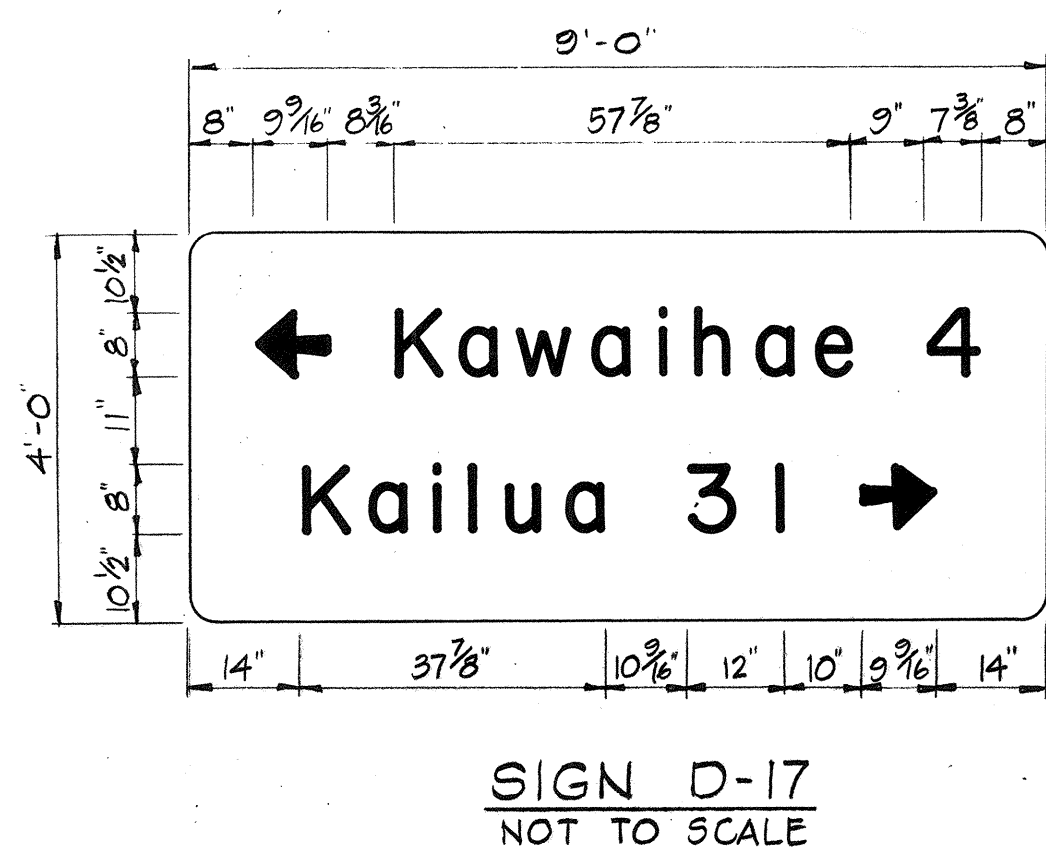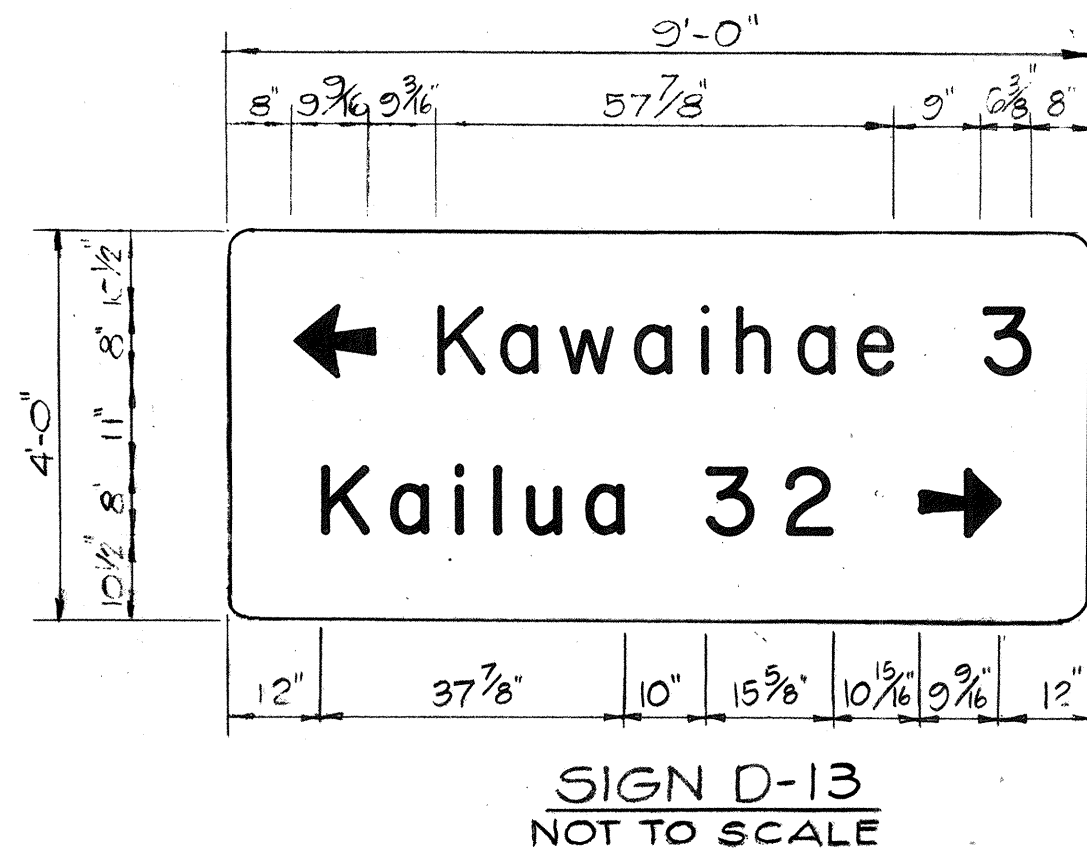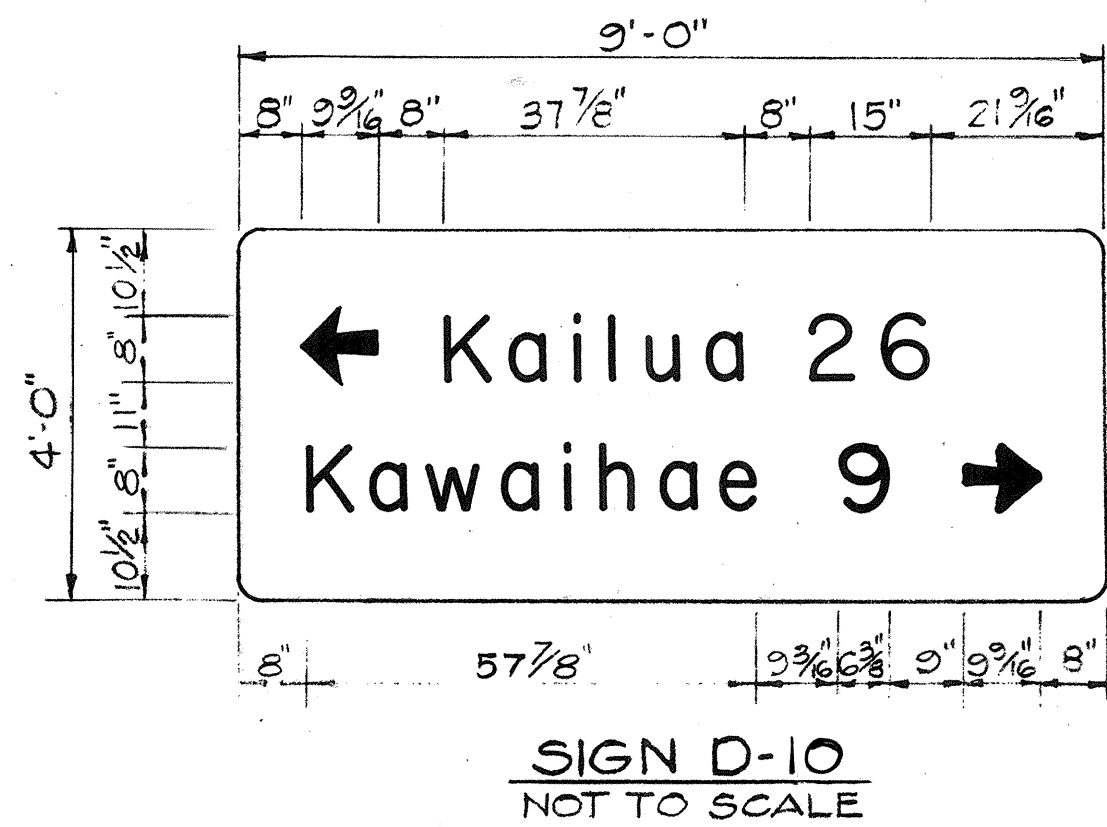

THIS WORK WAS PREPARED BY
ME OR UNDER MY SUPERVISION
[Signature]
Signature

STATE OF HAWAII
DEPARTMENT OF TRANSPORTATION
HIGHWAYS DIVISION

DESTINATION SIGNS
AND SUMMARY OF SIGNS

KAILUA - KAWAIIHAE ROAD
ANAEOOMALU TO HAPUNA
PROJ. NO. 19 BC-01-71

SHEET No. 2 OF 2 SHEETS

ORIGINAL PLAN	DATE
DRAWN BY	
TRACED BY	
QUANTITIES BY	
CHECKED BY	
No.	